




SUMMARY OF QUANTITIES (THIS SHEET)		
DESCRIPTION	UNIT	QUANTITY
ELECTRIC CABLE IN CONDUIT, LEAD-IN, NO. 18 4/C, TWISTED, SHIEDED	LF	1146
INDUCTION LOOP	LF	190

**NOTE:**  
 IDOT RECORD PLANS PROVIDED FOR INFORMATIONAL PURPOSES ONLY. THE CONTRACTOR IS RESPONSIBLE FOR VERIFYING THE LOCATION AND EXTENT OF WORK ASSOCIATED WITH REPLACEMENT OF INDUCTION LOOPS, LEAD-IN CABLE AND RELATED WORK.

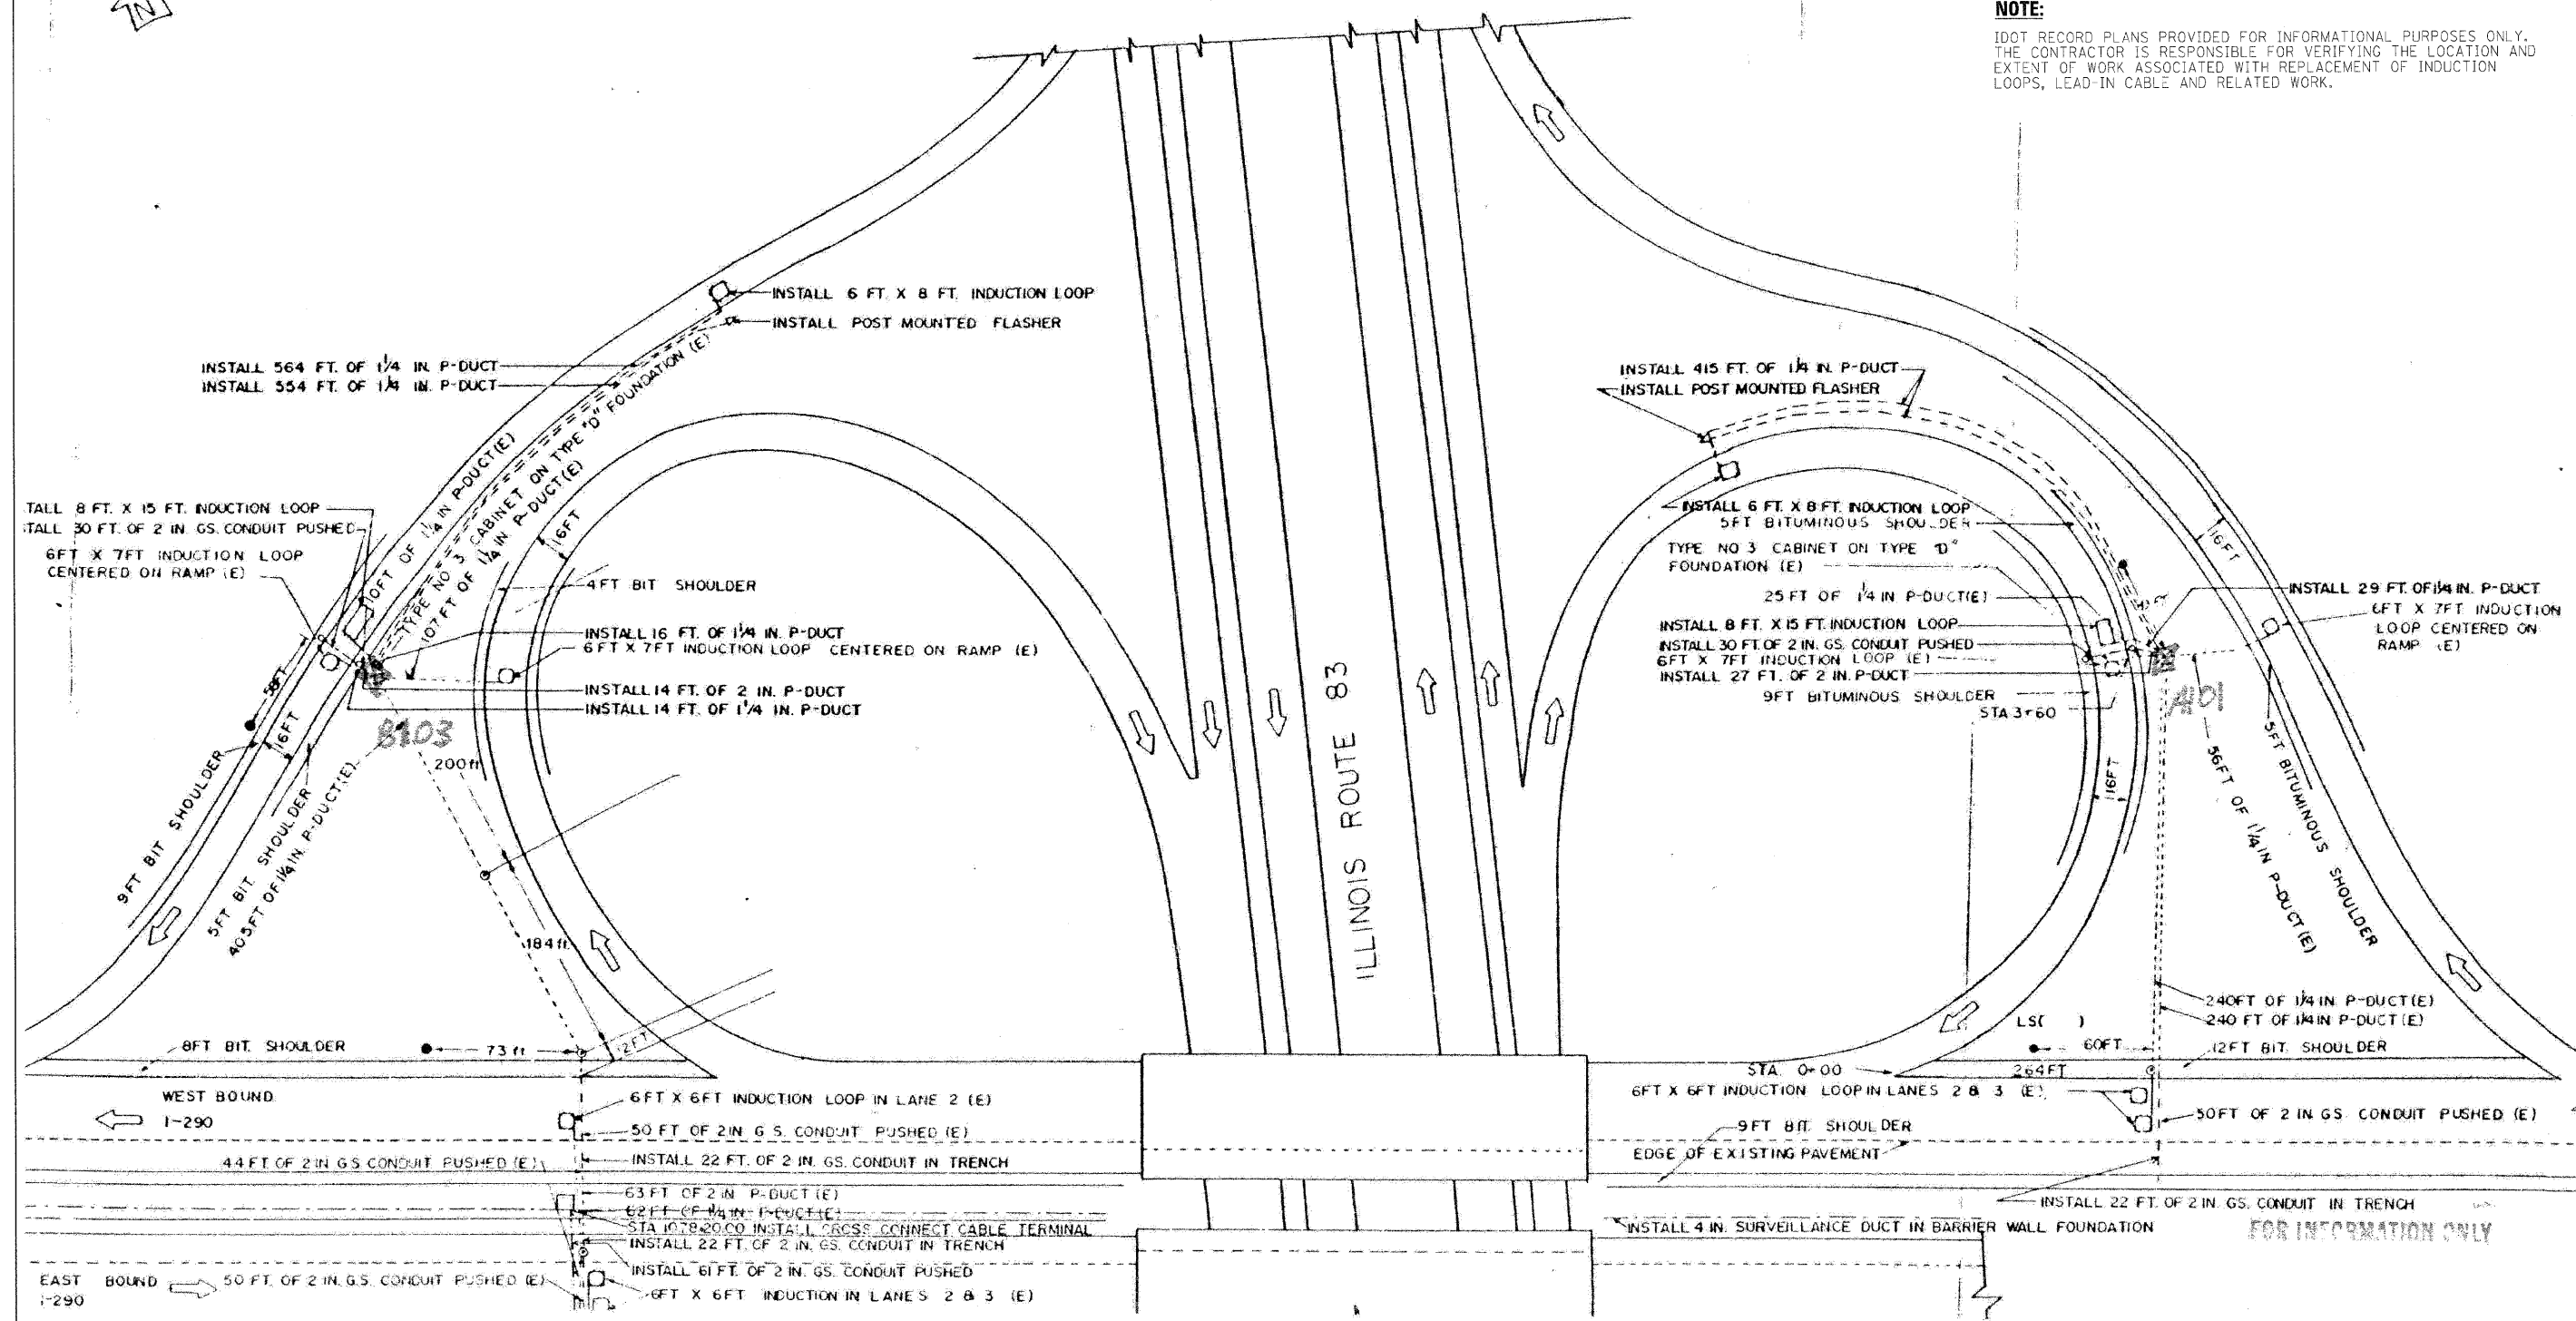

FILE NAME =	DESIGNED - GHT	REVISED -
...N:\signals\pp\in\ABC.C1.ta.14.dgn	DRAWN - TMB	REVISED -
USER NAME = tblank	CHECKED - MPV	REVISED -
PLOT DATE = 11/13/2009	DATE - 10/16/09	REVISED -

**benesch**

STATE OF ILLINOIS  
 DEPARTMENT OF TRANSPORTATION

TRAFFIC SURVEILLANCE LOOP  
 KINGERY HWY (IL-83) INSTALLATION (1 OF 2)

SCALE: N.T.S. SHEET NO. 2 OF 16 SHEETS STA. TO STA.

F.A.I. RTE.	SECTION	COUNTY	TOTAL SHEETS	SHEET NO.
220	1-1, 2&3RS-7	DUPAGE	546	503
*290,355			CONTRACT NO. 60G51	
FED. ROAD DIST. NO.	ILLINOIS FED. AID PROJECT			