



SUMMARY OF QUANTITIES (THIS SHEET)		
DESCRIPTION	UNIT	QUANTITY
ELECTRIC CABLE IN CONDUIT, LEAD-IN, NO. 18 4/C, TWISTED, SHIELDED	LF	249
INDUCTION LOOP	LF	204

NOTE:

IDOT RECORD PLANS PROVIDED FOR INFORMATIONAL PURPOSES ONLY. THE CONTRACTOR IS RESPONSIBLE FOR VERIFYING THE LOCATION AND EXTENT OF WORK ASSOCIATED WITH REPLACEMENT OF INDUCTION LOOPS, LEAD-IN CABLE AND RELATED WORK.

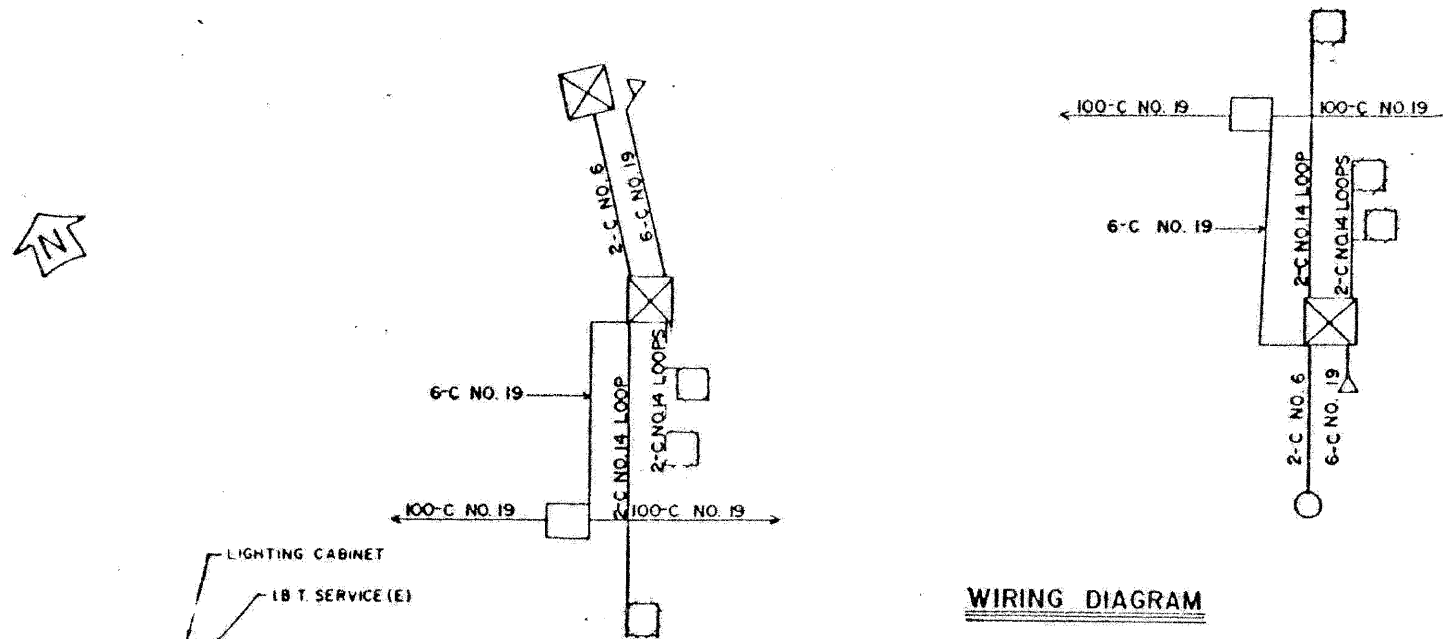

WIRING DIAGRAM

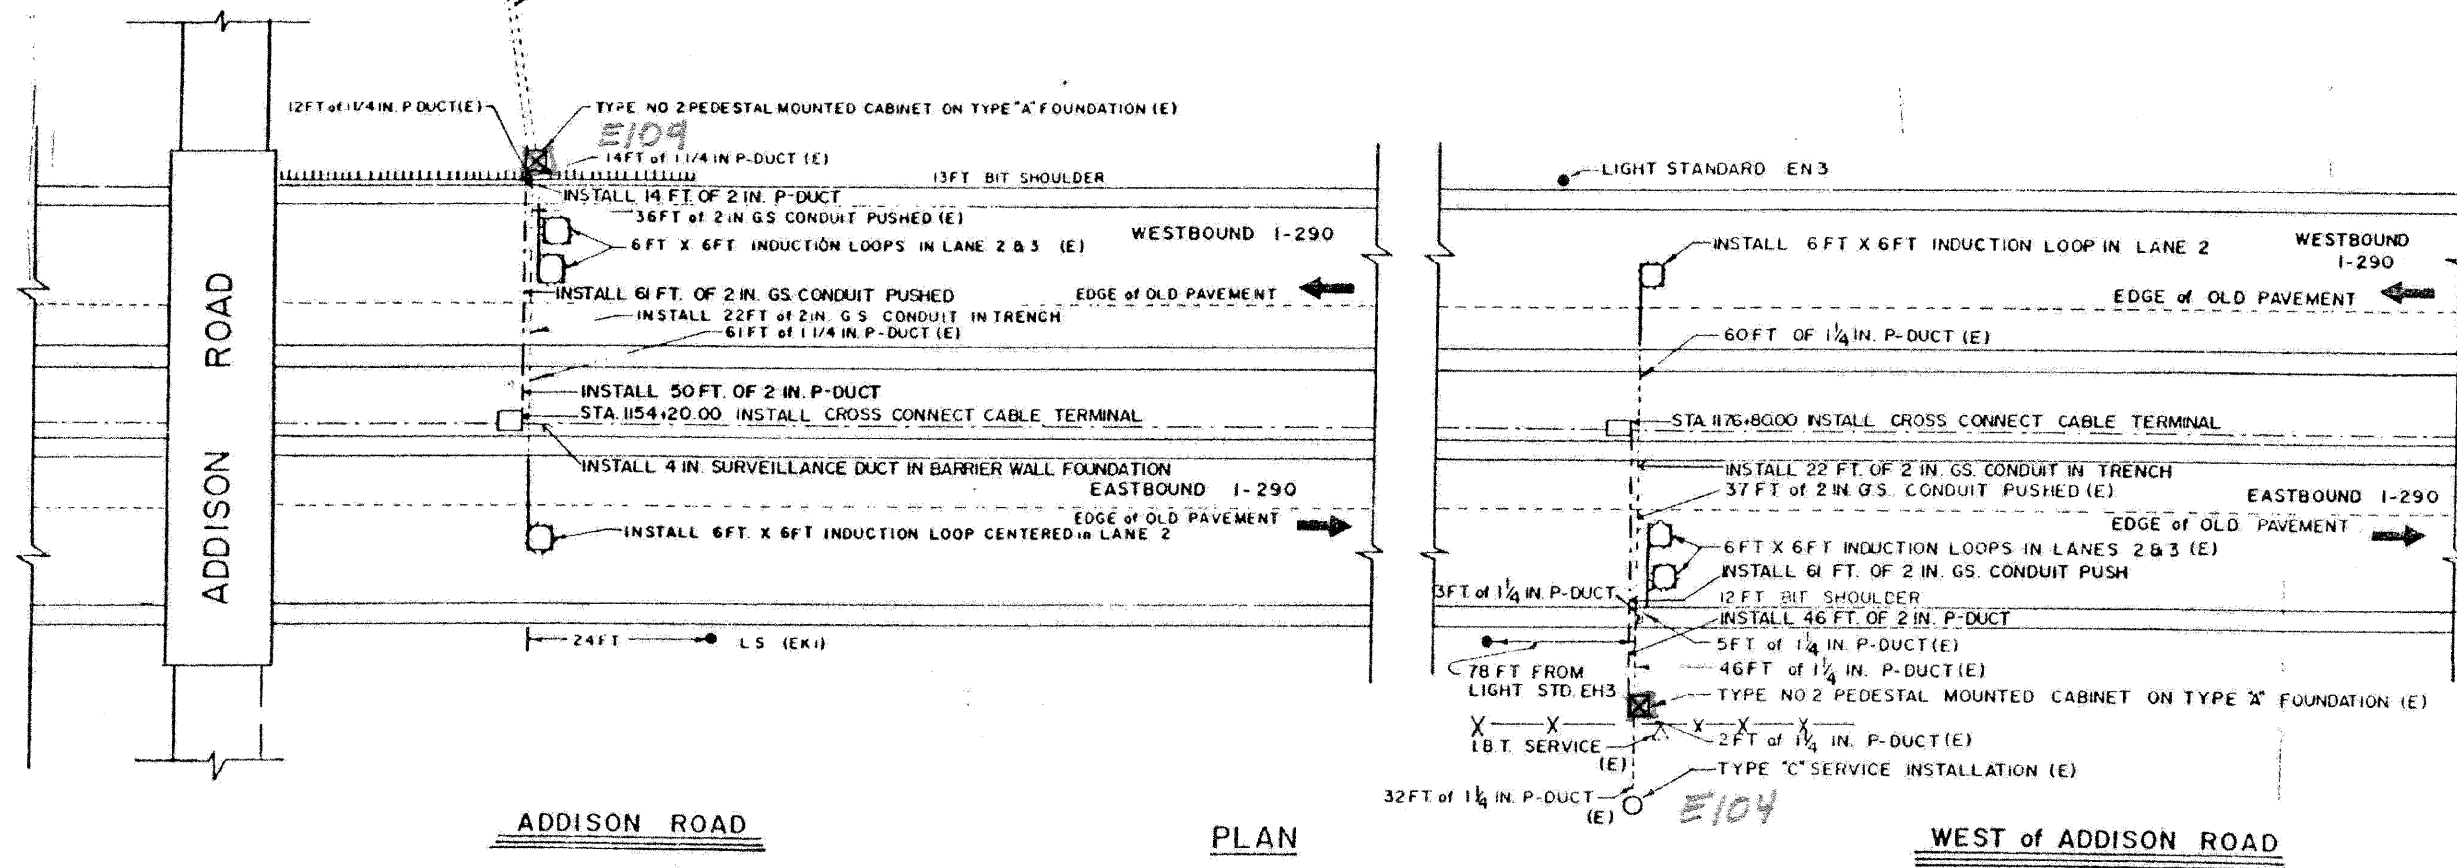

ADDISON ROAD

PLAN

WEST of ADDISON ROAD

FILE NAME =	DESIGNED - GHT	REVISED -
...\\signals\prp\in_abc\cl_ts_17.dgn	DRAWN - TMB	REVISED -
USER NAME = thblank	CHECKED - MPM	REVISED -
PLOT DATE = 11/13/2009	DATE - 10/16/09	REVISED -

benesch

**STATE OF ILLINOIS
DEPARTMENT OF TRANSPORTATION**

TRAFFIC SURVEILLANCE LOOP ADDISON RD INSTALLATION		
SCALE: N.T.S.	SHEET NO. 5 OF 16 SHEETS	STA. TO STA.

F.A.I. RTE.	SECTION	COUNTY	TOTAL SHEETS	SHEET NO.
290, 355	22(1, 1-1, 2&3)RS-7	DUPAGE	546	506
FED. ROAD DIST. NO.		ILLINOIS FED. AID PROJECT		
		CONTRACT NO. 60G51		