

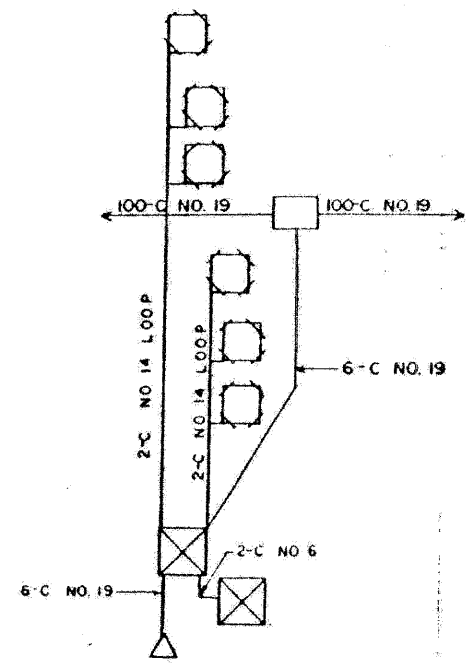


WIRING DIAGRAM

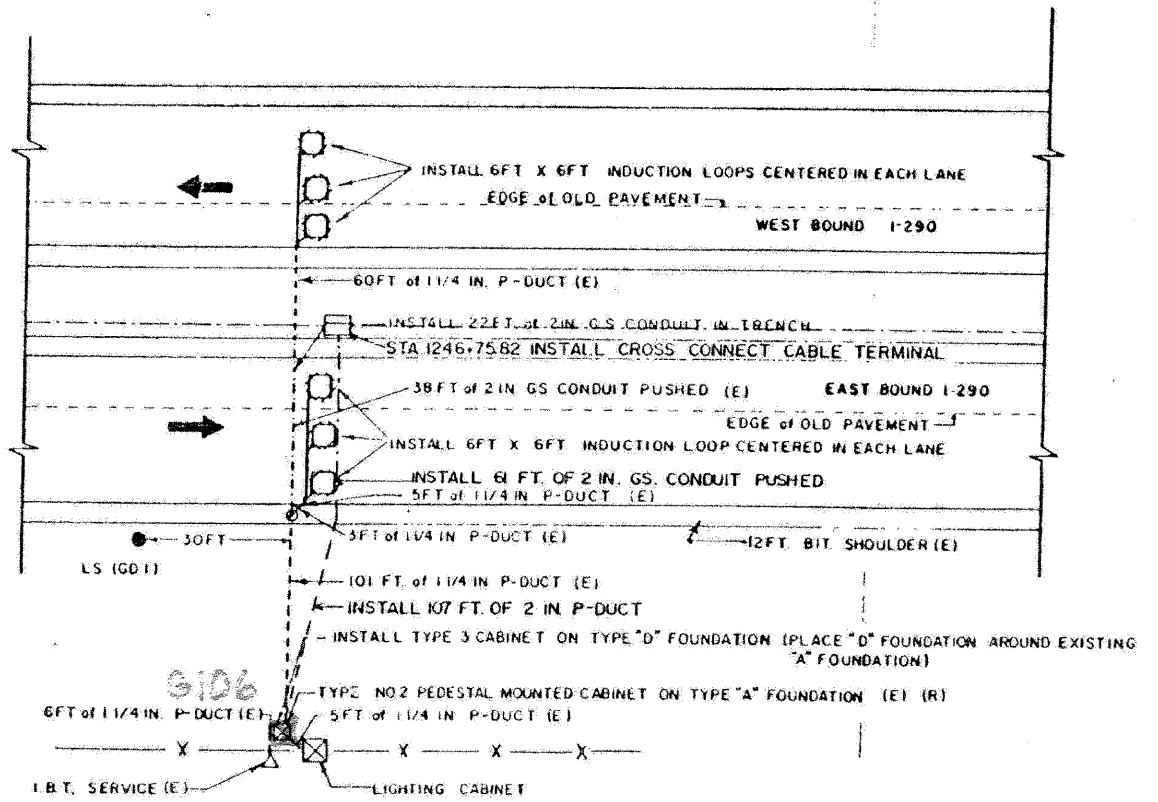

SUMMARY OF QUANTITIES (THIS SHEET)		
DESCRIPTION	UNIT	QUANTITY
ELECTRIC CABLE IN CONDUIT, LEAD-IN, NO. 18 4/C, TWISTED, SHIELDED	LF	1071
INDUCTION LOOP	LF	354

NOTE:
 IDOT RECORD PLANS PROVIDED FOR INFORMATIONAL PURPOSES ONLY. THE CONTRACTOR IS RESPONSIBLE FOR VERIFYING THE LOCATION AND EXTENT OF WORK ASSOCIATED WITH REPLACEMENT OF INDUCTION LOOPS, LEAD-IN CABLE AND RELATED WORK.

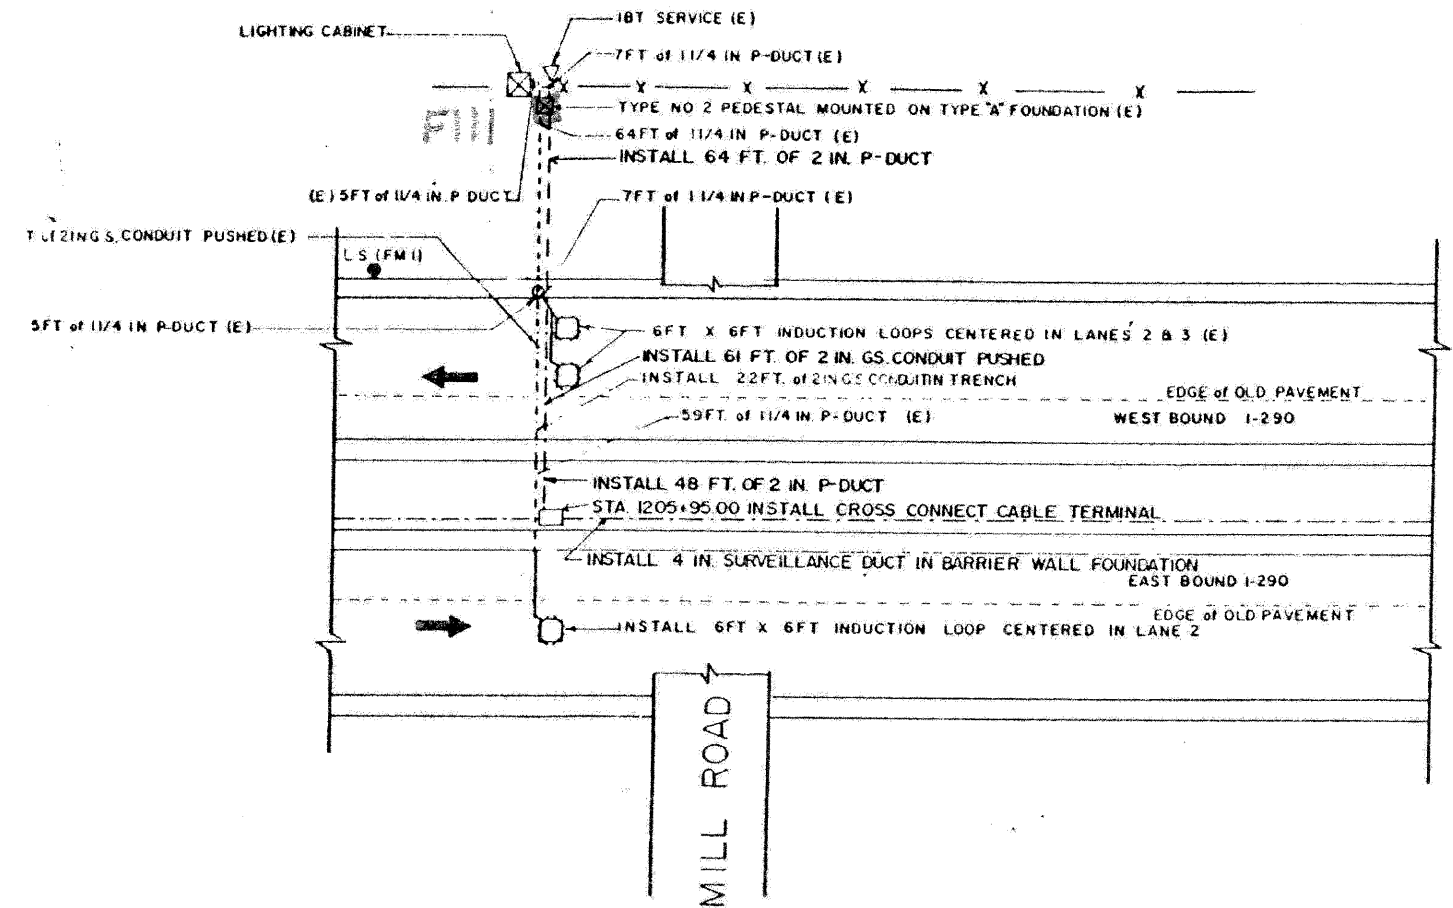

FILE NAME =	DESIGNED - GHT	REVISED -
...N:\Signs\app\In_ABC_C1-ts-18.dgn	DRAWN - TMB	REVISED -
USER NAME = tblank	CHECKED - MPM	REVISED -
PLOT DATE = 11/13/2009	DATE - 10/16/09	REVISED -

benesch

**STATE OF ILLINOIS
 DEPARTMENT OF TRANSPORTATION**

TRAFFIC SURVEILLANCE LOOP MILL RD INSTALLATION		F.A.I. RTE.	SECTION	COUNTY	TOTAL SHEETS	SHEET NO.
SCALE: N.T.S.		2201, 1-1, 2&3RS-7	DUPAGE	546	507	
SHEET NO. 6 OF 16 SHEETS		290,355	CONTRACT NO. 60G51		ILLINOIS FED. AID PROJECT	