
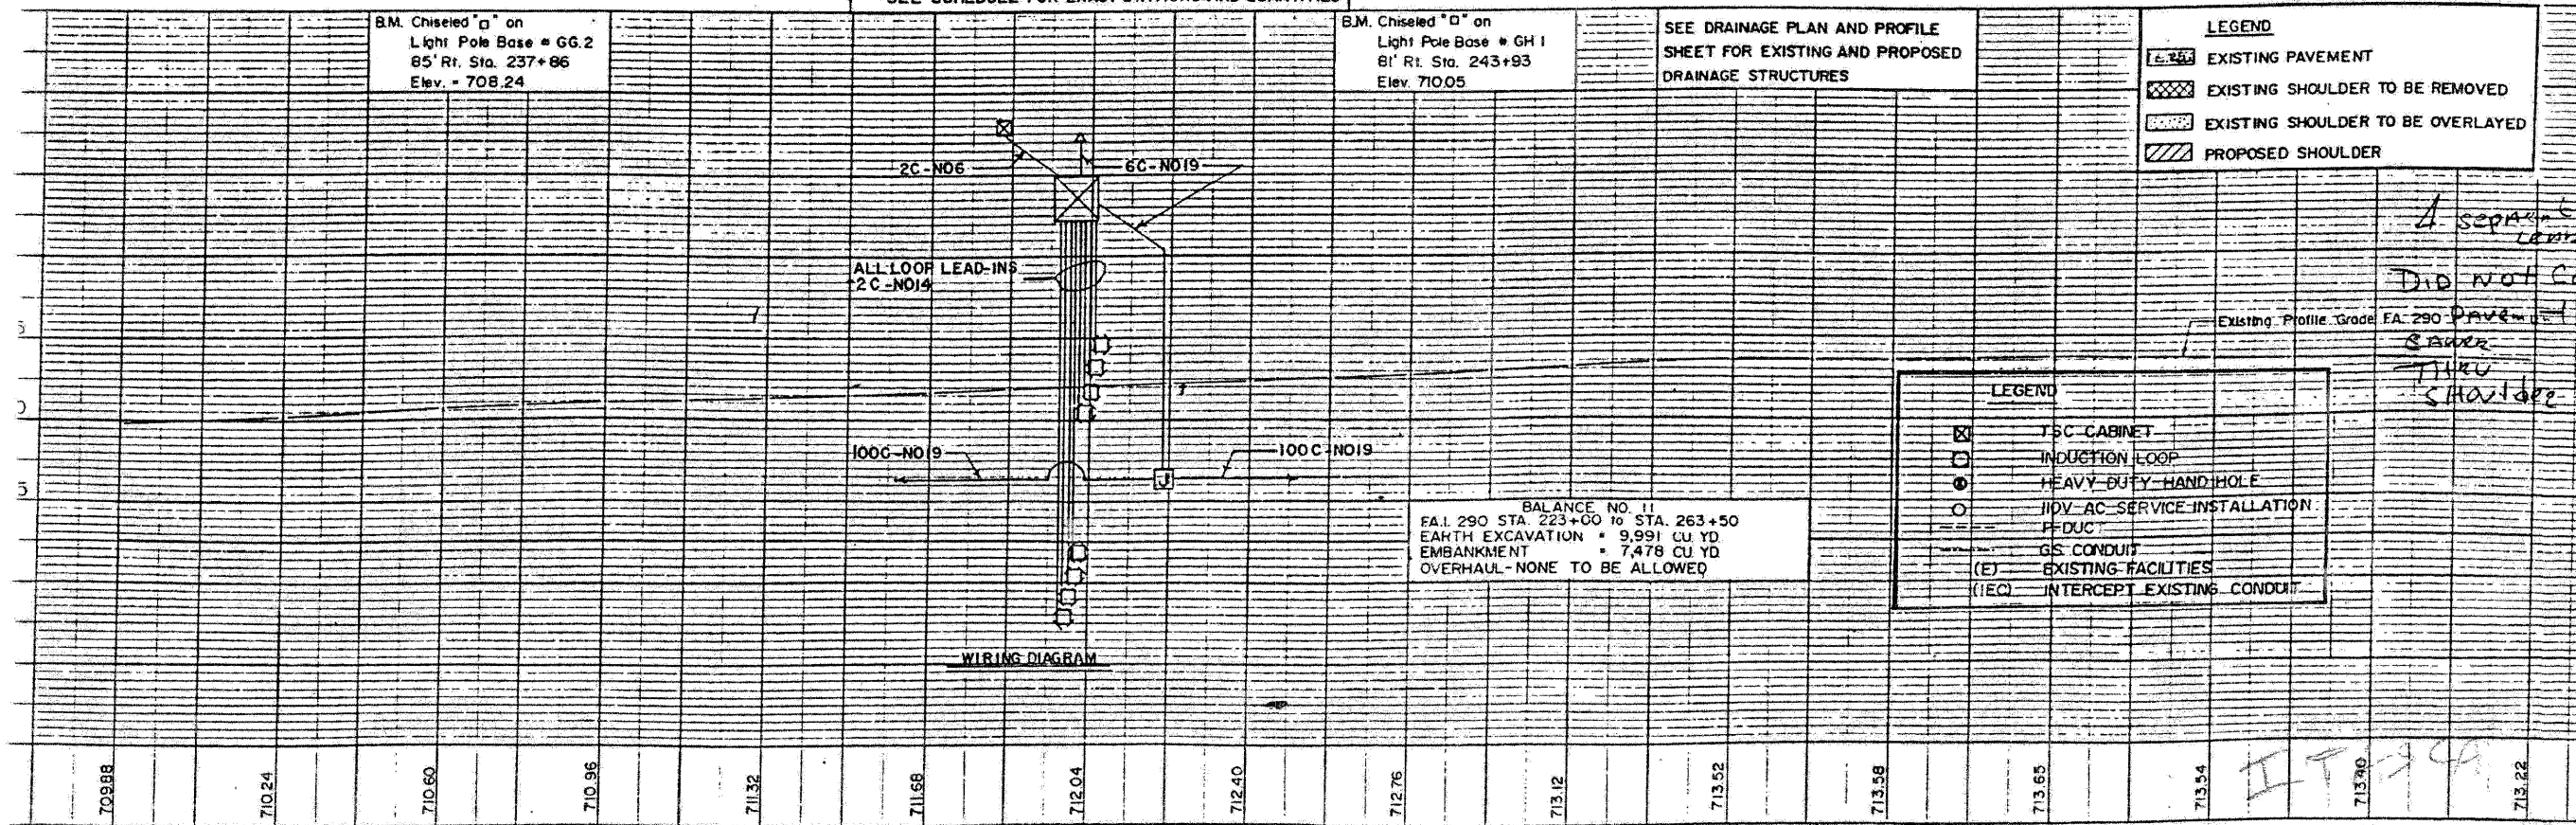


NOTE:

IDOT RECORD PLANS PROVIDED FOR INFORMATIONAL PURPOSES ONLY. THE CONTRACTOR IS RESPONSIBLE FOR VERIFYING THE LOCATION AND EXTENT OF WORK ASSOCIATED WITH REPLACEMENT OF INDUCTION LOOPS, LEAD-IN CABLE AND RELATED WORK.

SUMMARY OF QUANTITIES (THIS SHEET)		
DESCRIPTION	UNIT	QUANTITY
ELECTRIC CABLE IN CONDUIT, LEAD-IN, NO. 18 4/C, TWISTED, SHIELDED	LF	1048
INDUCTION LOOP	LF	336

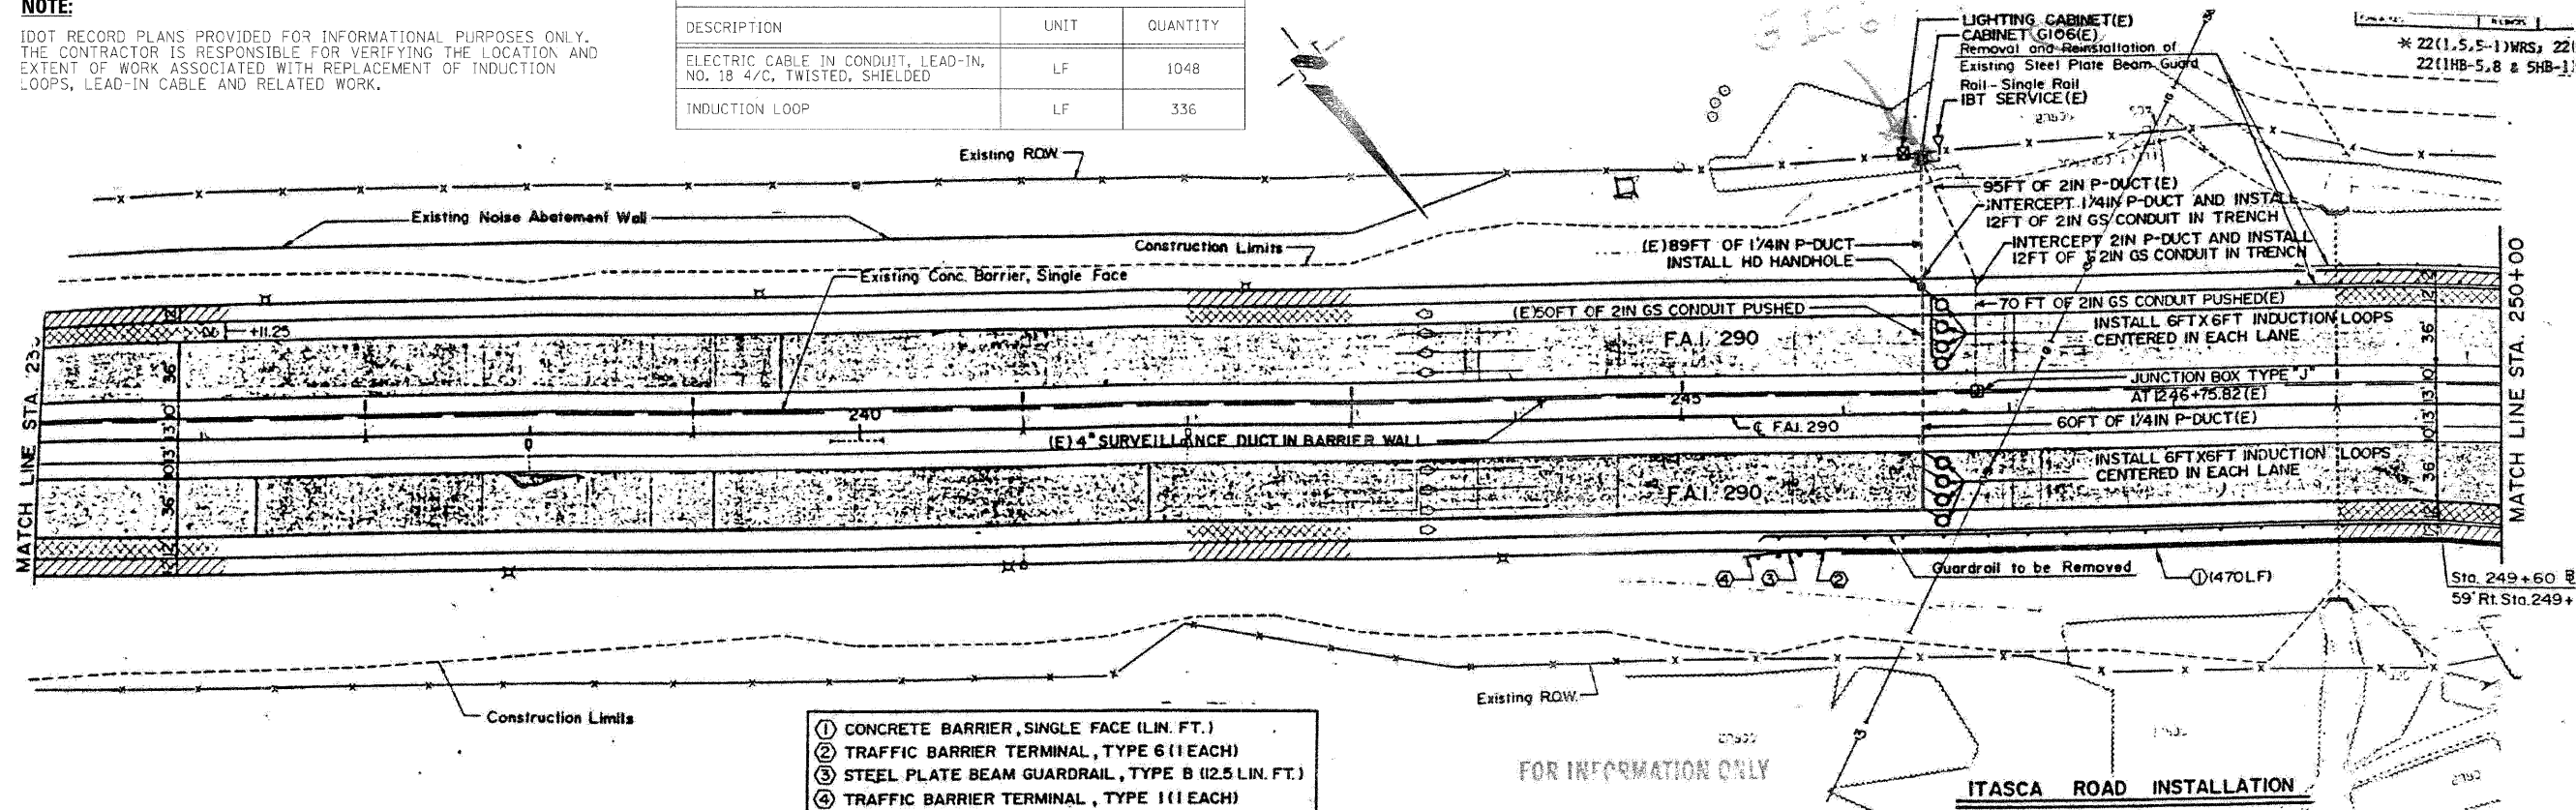

FILE NAME = ... \Signels\p\pin_abc_c1_ts_19.dgn
USER NAME = tblank
PLOT DATE = 11/13/2009

DESIGNED - GHT
DRAWN - TMB
CHECKED - MPM
DATE - 10/16/09

REVISED -
REVISED -
REVISED -
REVISED -

benesch

STATE OF ILLINOIS
DEPARTMENT OF TRANSPORTATION

TRAFFIC SURVEILLANCE LOOP
ITASCA RD INSTALLATION

SCALE: N.T.S. SHEET NO. 7 OF 16 SHEETS STA. TO STA.

F.A.I. RTE.	SECTION	COUNTY	TOTAL SHEETS	SHEET NO.
* 220, 1-1, 2&3RS-7	DUPAGE	546	508	
* 290, 355				CONTRACT NO. 60G51
FED. ROAD DIST. NO.	ILLINOIS FED. AID PROJECT			