


CURVE 53-4
 P.I. STA. 1349+35.25
 $\Delta = 7^{\circ}28'34"$
 $D = 0^{\circ}30'00"$
 $R = 11,459.16$
 $T = 748.67$
 $L = 1,495.22'$
 $E = 24.43'$
 SE = Normal Crown
 P.C. STA. 1344+86.58
 R.T. STA. 1356+81.80

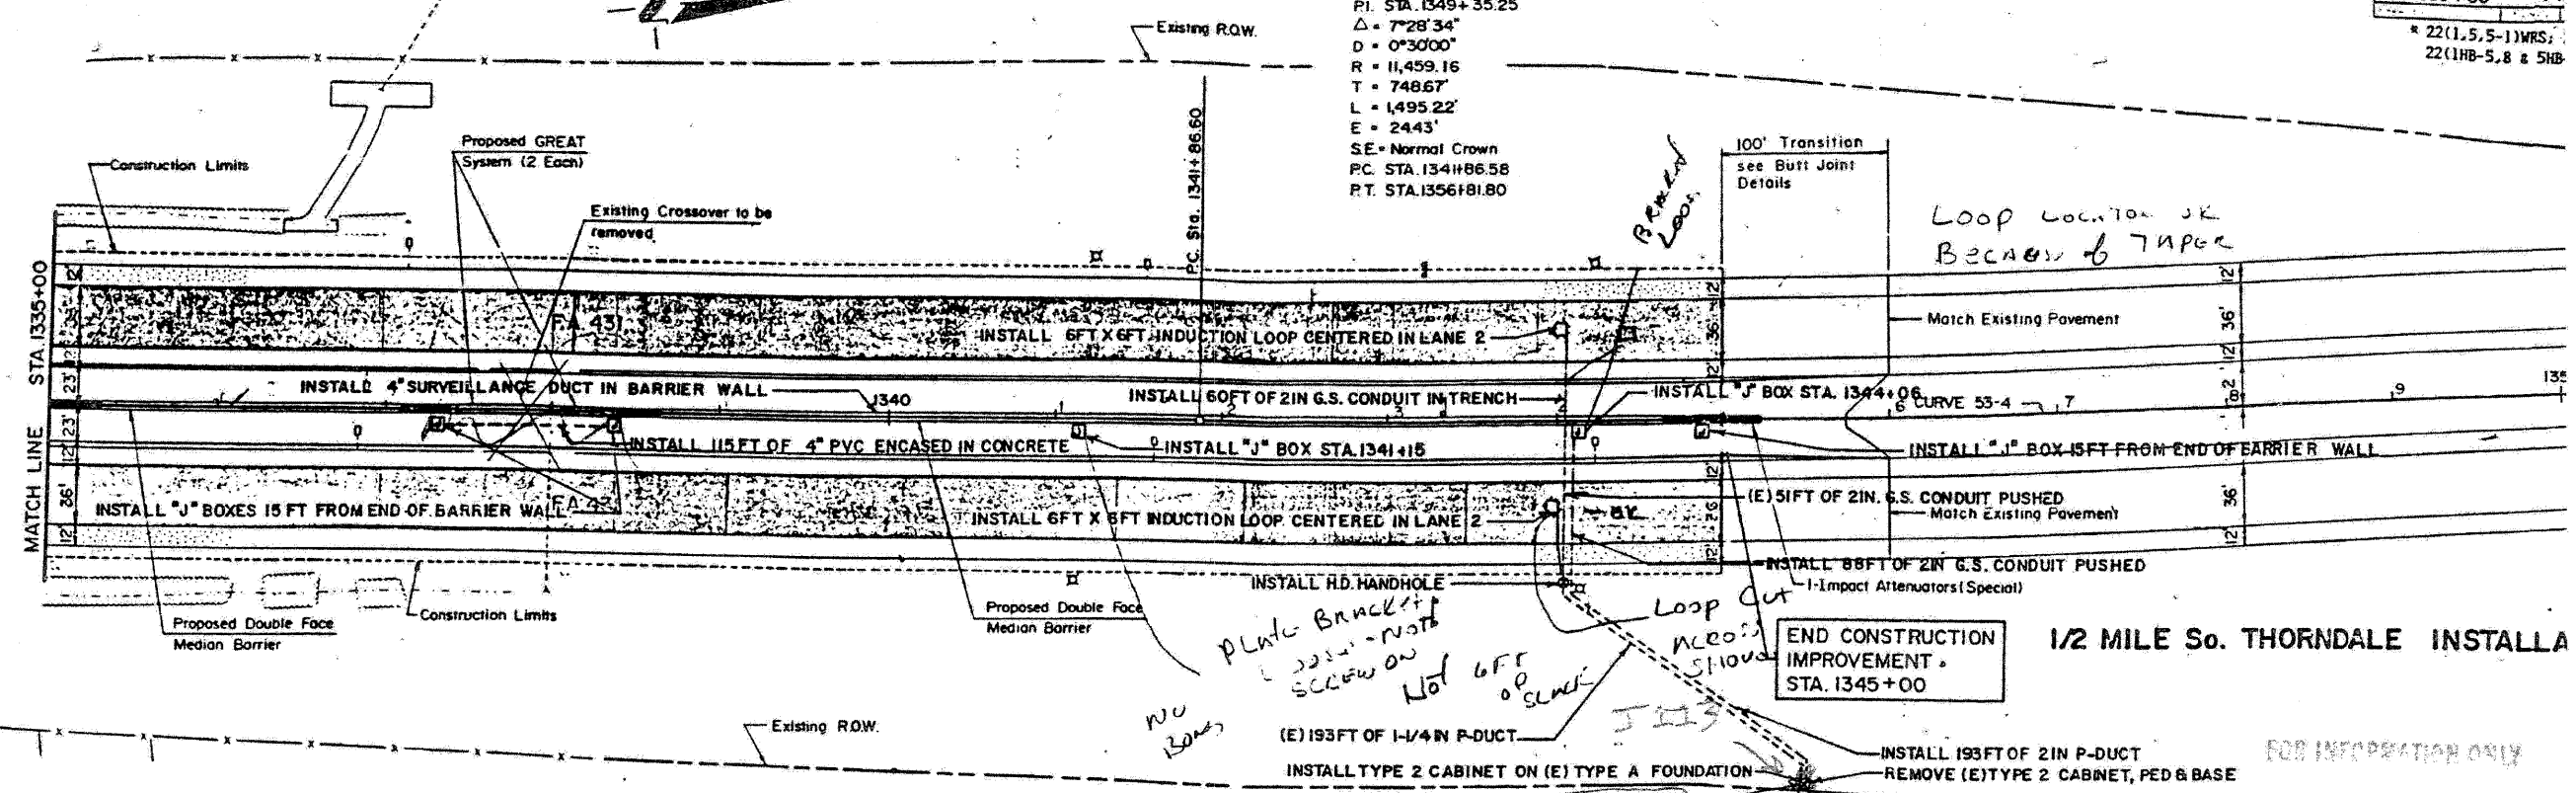


LOOP LOCATION JK
 BECAUSE OF TAPER

END CONSTRUCTION
 IMPROVEMENT
 STA. 1345+00

1/2 MILE So. THORNDALE INSTALLA

FOR INFORMATION ONLY

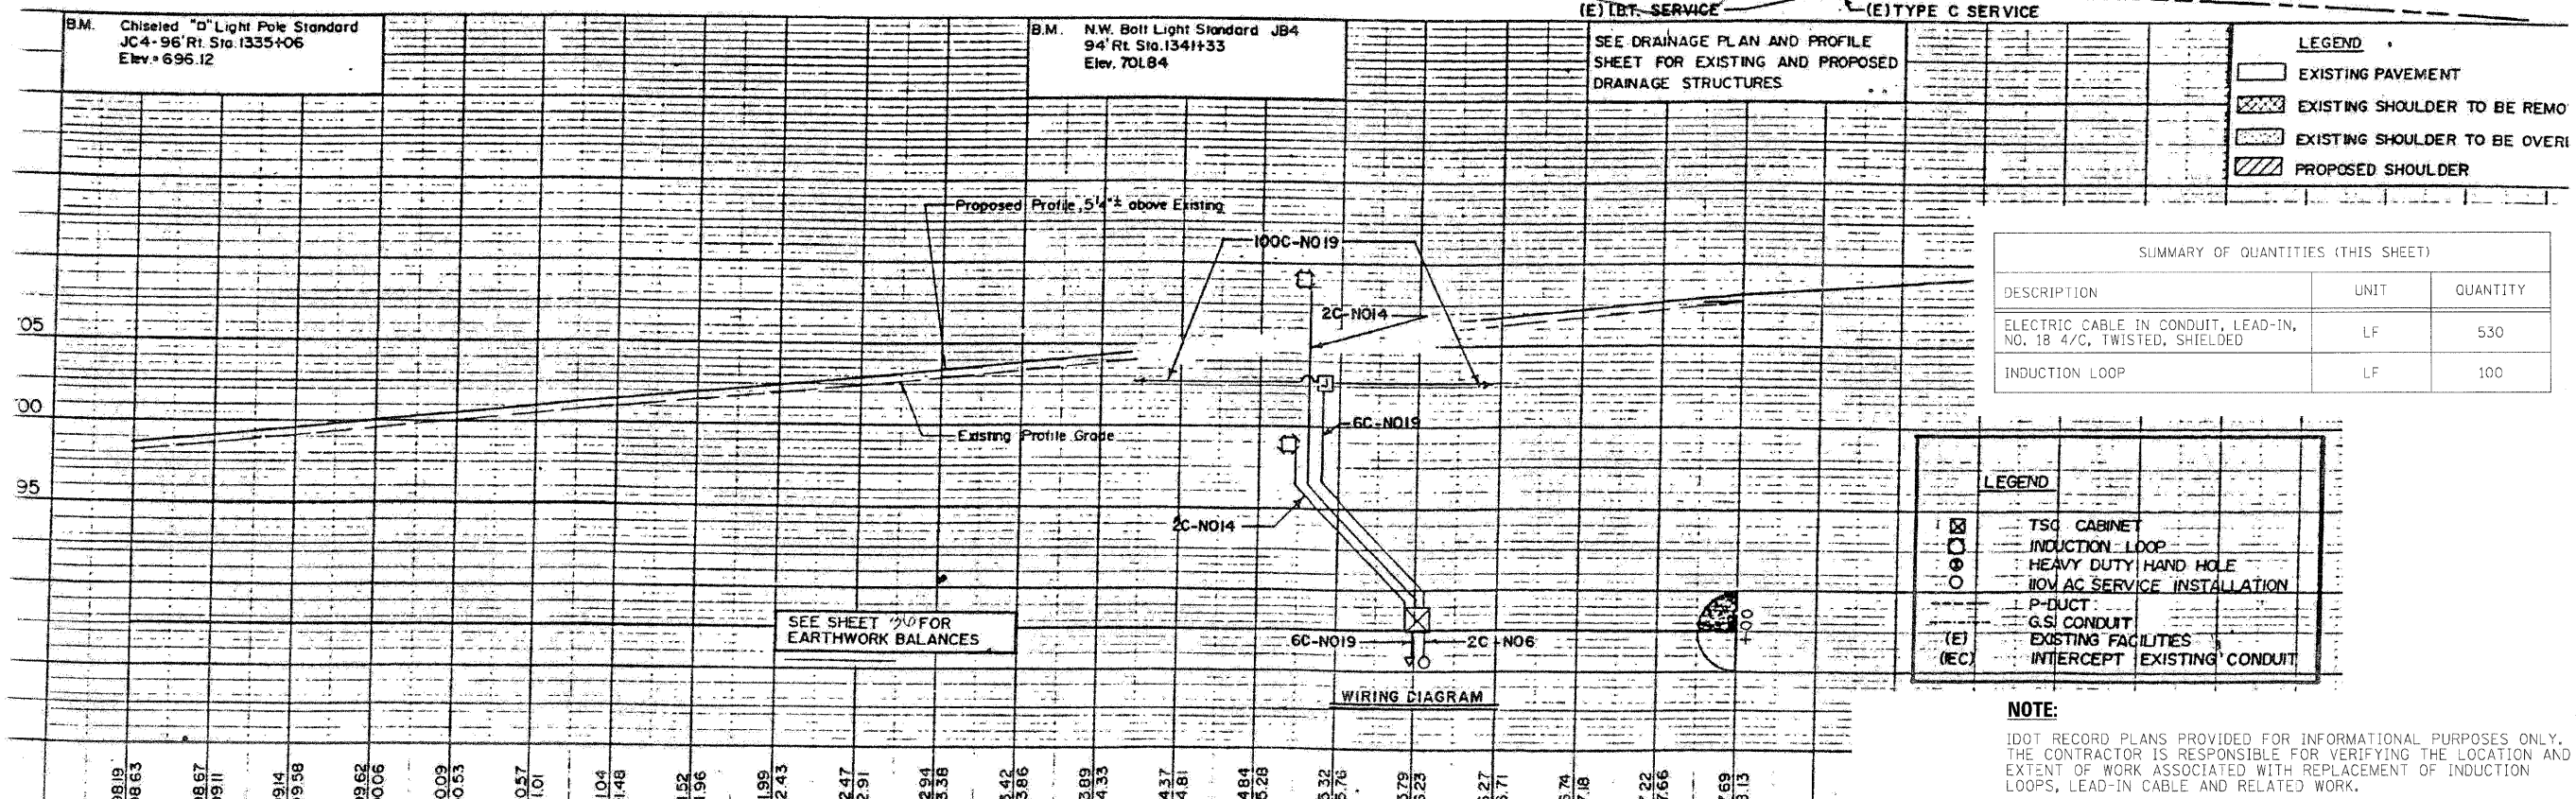

SUMMARY OF QUANTITIES (THIS SHEET)		
DESCRIPTION	UNIT	QUANTITY
ELECTRIC CABLE IN CONDUIT, LEAD-IN, NO. 18 4/C, TWISTED, SHIELDED	LF	530
INDUCTION LOOP	LF	100

LEGEND	
	TSC CABINET
	INDUCTION LOOP
	HEAVY DUTY HAND HOLE
	110V AC SERVICE INSTALLATION
	P-DUCT
	G.S. CONDUIT
	EXISTING FACILITIES
	INTERCEPT EXISTING CONDUIT

NOTE:
 IDOT RECORD PLANS PROVIDED FOR INFORMATIONAL PURPOSES ONLY. THE CONTRACTOR IS RESPONSIBLE FOR VERIFYING THE LOCATION AND EXTENT OF WORK ASSOCIATED WITH REPLACEMENT OF INDUCTION LOOPS, LEAD-IN CABLE AND RELATED WORK.