


SYMBOL	LEGEND
○	INDUCTION LOOP
—	POLYETHYLENE DUCT
---	G.S. CONDUIT
⊗	HANDHOLE
⊕	HEAVY DUTY HANDHOLE
⊙	CABINET
○	SERVICE INSTALLATION
△	RAMP SIGNAL
—X—X—	FLASHER
—X—X—	FENCE

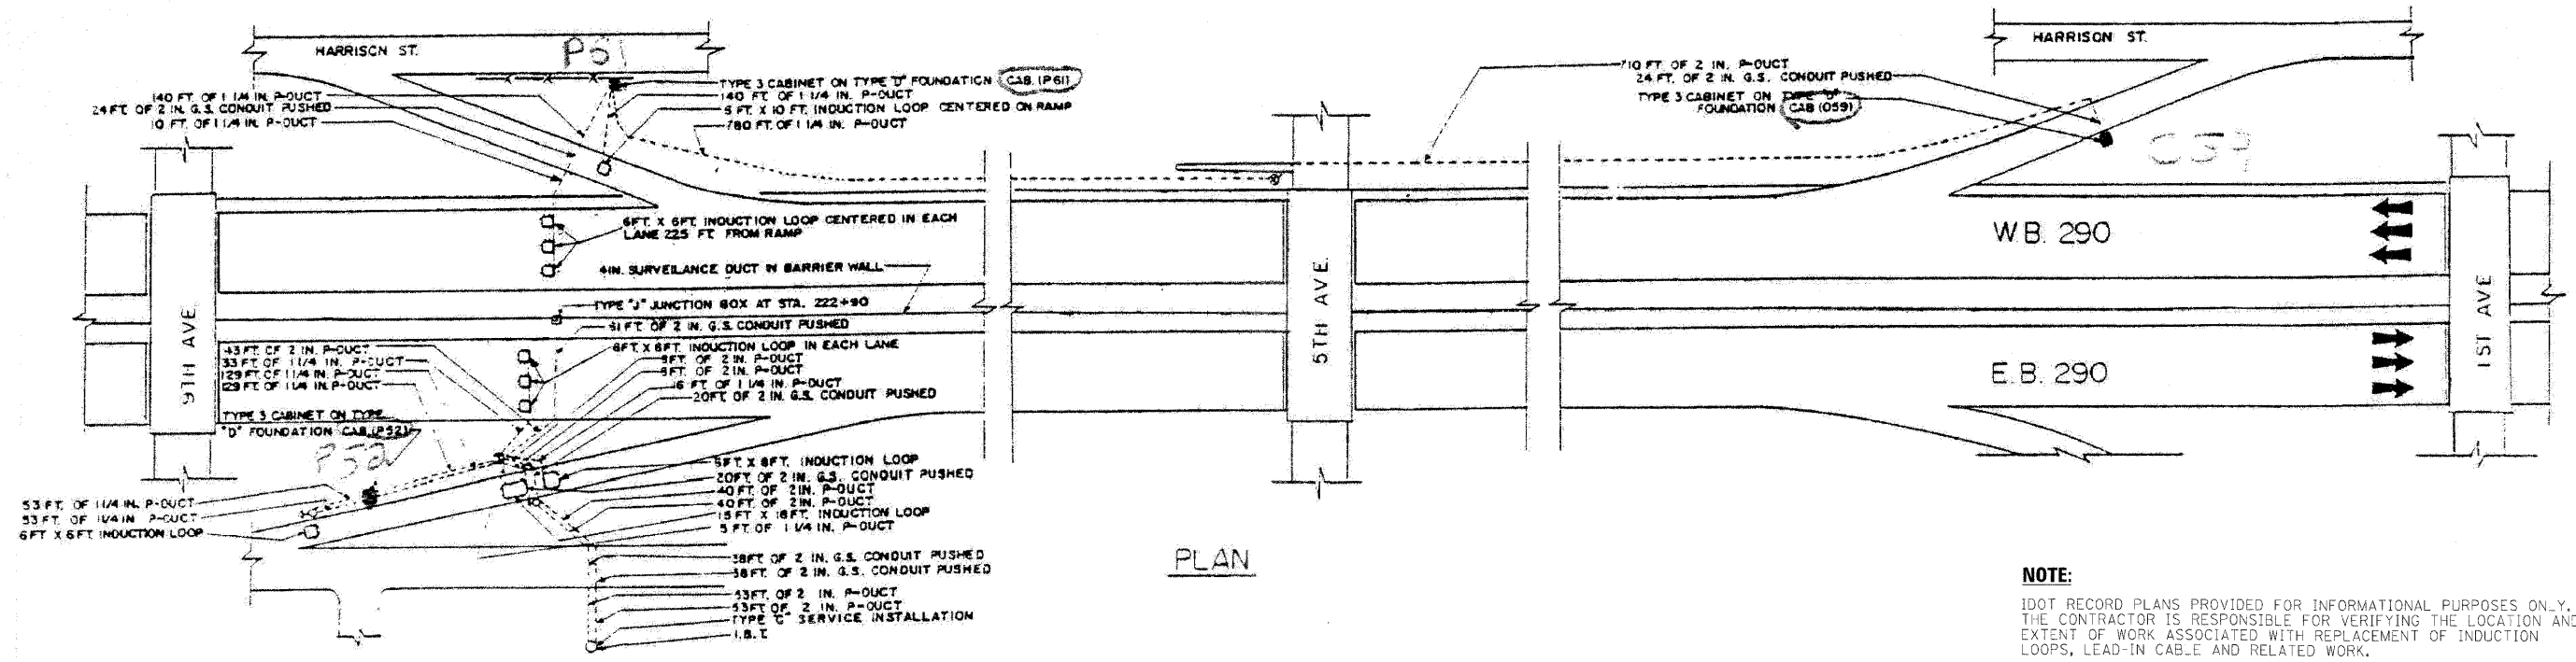

PLAN

NOTE:
 IDOT RECORD PLANS PROVIDED FOR INFORMATIONAL PURPOSES ONLY. THE CONTRACTOR IS RESPONSIBLE FOR VERIFYING THE LOCATION AND EXTENT OF WORK ASSOCIATED WITH REPLACEMENT OF INDUCTION LOOPS, LEAD-IN CABLE AND RELATED WORK.

SUMMARY OF QUANTITIES (THIS SHEET)		
DESCRIPTION	UNIT	QUANTITY
ELECTRIC CABLE IN CONDUIT, LEAD-IN, NO. 18 4/C, TWISTED, SHIELDED	LF	1316
INDUCTION LOOP	LF	378