


DATE: 11/12/2009
 DRAWN: MPM
 CHECKED: MPM
 PLOT DATE: 11/12/2009

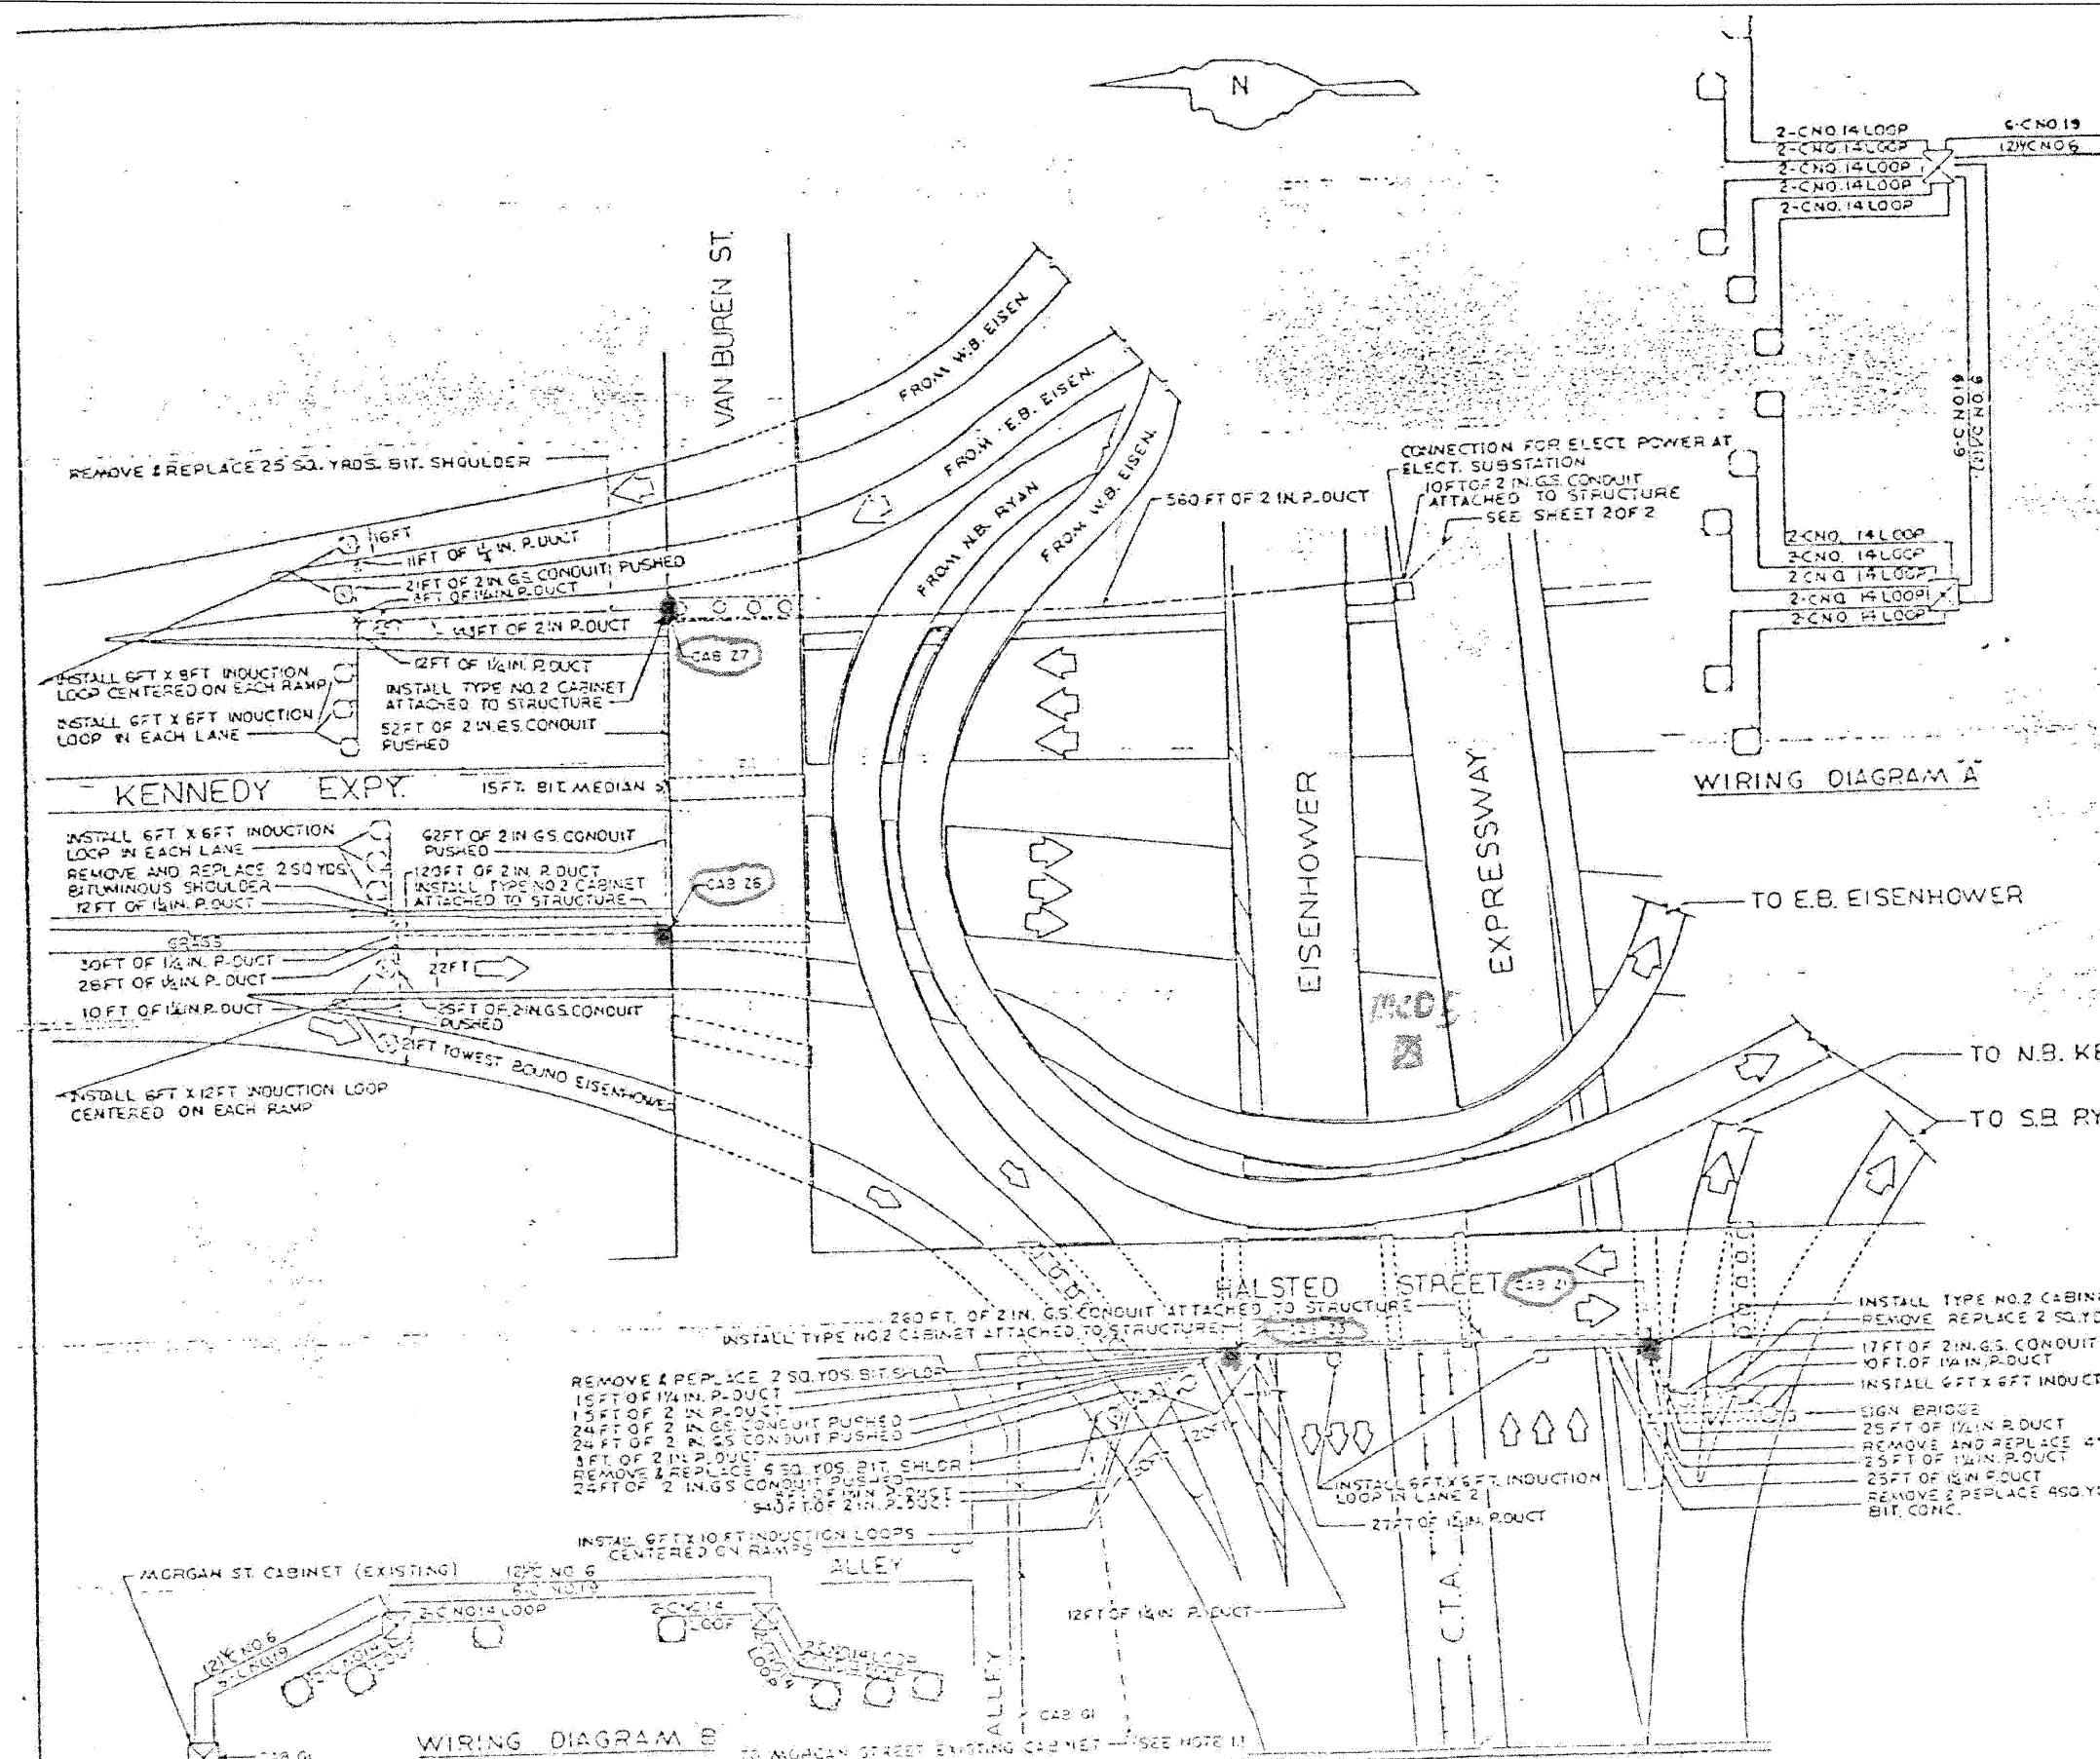

NOTE:
 IDOT RECORD PLANS PROVIDED FOR INFORMATIONAL PURPOSES ONLY. THE CONTRACTOR IS RESPONSIBLE FOR VERIFYING THE LOCATION AND EXTENT OF WORK ASSOCIATED WITH REPLACEMENT OF INDUCTION LOOPS, LEAD-IN CABLE AND RELATED WORK.

NOTE:
 1.9 SQ YARDS OF BITUMINOUS CONCRETE REMOVAL AND REPLACEMENT ALONG RIGHT SHOULDER OF EXPY. AT PEORIA ST. OVERPASS.

- LEGEND**
- INDUCTION LOOP
 - ⊠ CABINET
 - ⊕ JUNCTION BOX
 - ⊙ PULL POINT
 - SERVICE INSTALLATION
 - ⊕ HANDHOLE
 - DUCT
 - - - CONDUIT
 - FENCE
 - GUARD RAIL
 - LIGHT STANDOFF

STATE OF ILLINOIS

SUMMARY OF QUANTITIES (THIS SHEET)

DESCRIPTION	UNIT	QUANTITY
ELECTRIC CABLE IN CONDUIT, LEAD-IN, NO. 18 4/C, TWISTED, SHIELDED	LF	207
INDUCTION LOOP	LF	216

FILE NAME = ...	DESIGNED - GHT	REVISED -
USER NAME = tblank	DRAWN - DMS	REVISED -
PLOT DATE = 11/12/2009	CHECKED - MPM	REVISED -
	DATE - 10/16/09	REVISED -

benesch

STATE OF ILLINOIS
 DEPARTMENT OF TRANSPORTATION

TRAFFIC SURVEILLANCE
 EISENHOWER-KENNEDY-RYAN INSTALLATION (1 OF 2)

F.A.I. RTE.	SECTION	COUNTY	TOTAL SHEETS	SHEET NO.
290	(2828B,D, ETC., 3031, IRS-6	COOK	185	141
FED. ROAD DIST. NO. [ILLINOIS] FED. AID PROJECT			CONTRACT NO. 60G53	

SCALE: N.T.S. SHEET NO. 1 OF 15 SHEETS STA. TO STA.