


WIRING DIAGRAMS

NOTE ALL LOOP LEAD-IN WIRE IS 2C-NO 14

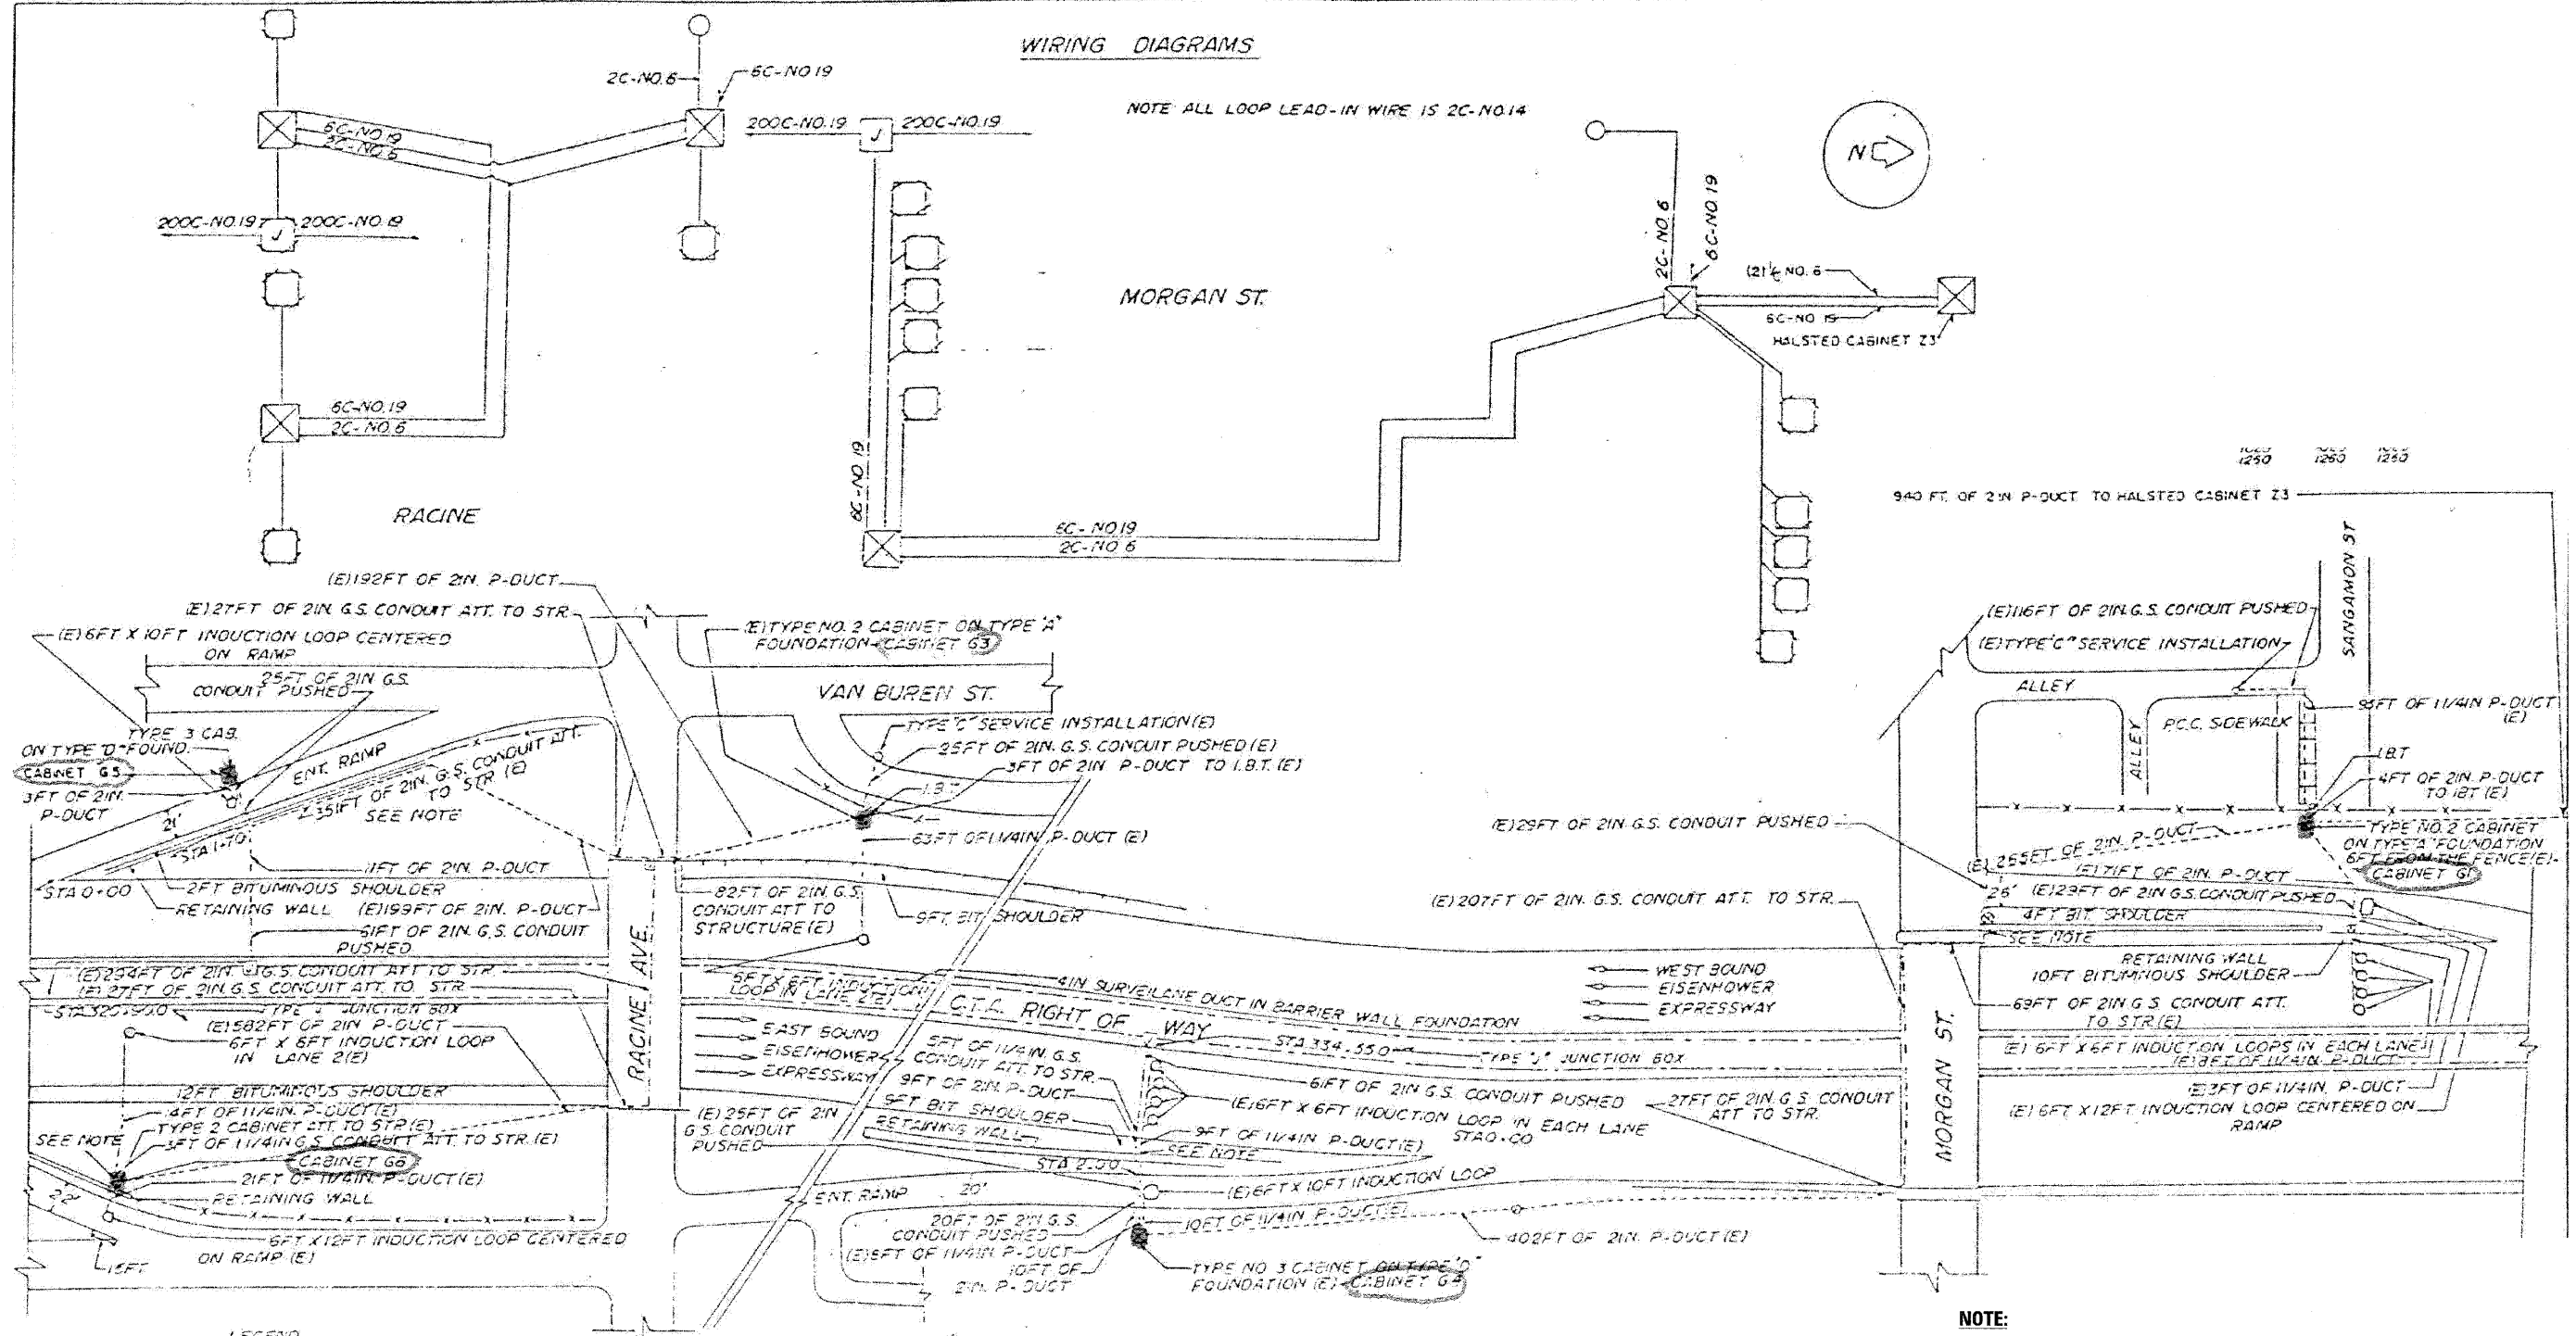

- LEGEND**
- CABINET
 - INDUCTION LOOP
 - JUNCTION BOX
 - HANDHOLE
 - PULL POINT
 - SERVICE INSTALLATION
 - DUCT
 - CONDUIT
 - x- FENCE
 - - - GUARD RAIL
 - (E) EXISTING
 - (R) RELOCATE EXISTING FACILITIES

PLAN
NO SCALE

NOTE
1. HOLES SHALL BE DRILLED THROUGH RETAINING WALLS TO ACCOMMODATE 2 IN. G.S. CONDUIT & CONDUITS PUSHED

NOTE:
IDOT RECORD PLANS PROVIDED FOR INFORMATIONAL PURPOSES ONLY. THE CONTRACTOR IS RESPONSIBLE FOR VERIFYING THE LOCATION AND EXTENT OF WORK ASSOCIATED WITH REPLACEMENT OF INDUCTION LOOPS, LEAD-IN CABLE AND RELATED WORK.

SUMMARY OF QUANTITIES (THIS SHEET)		
DESCRIPTION	UNIT	QUANTITY
ELECTRIC CABLE IN CONDUIT, LEAD-IN, NO. 18 4/C, TWISTED, SHIELDED	LF	820
INDUCTION LOOP	LF	603

FILE NAME =	DESIGNED - GHT	REVISED -
...:\Signal\corp\in_abc_c3_ts_05.dgn	DRAWN - DMS	REVISED -
USER NAME = tblank	CHECKED - MPM	REVISED -
PLOT DATE = 11/12/2009	DATE - 10/16/09	REVISED -

benesch

STATE OF ILLINOIS
DEPARTMENT OF TRANSPORTATION

TRAFFIC SURVEILLANCE
MORGAN ST & RACINE AVE INSTALLATION
SCALE: N.T.S. SHEET NO. 2 OF 15 SHEETS STA. TO STA.

F.A.I. RTE.	SECTION	COUNTY	TOTAL SHEETS	SHEET NO.
290	(2828B,D, ETC., 3031.DRS-6	COOK	185	142
FED. ROAD DIST. NO. ILLINOIS FED. AID PROJECT			CONTRACT NO. 60G53	