

1. COVER SHEET AND INDEX
  2. TYPICAL SECTION: MAINLINE, C.H. 36, PRIVATE DRIVE AND DETOUR
  3. TYPICAL SECTION: RAMPS
  4. GENERAL NOTES AND TABULATION OF QUANTITIES
  5. SUMMARY OF QUANTITIES
  - 6.-7. PLAN & PROFILE: MAINLINE STA. 270+33.00
  8. PLAN & PROFILE: C.H. 36
  9. PLAN & PROFILE: PRIVATE DRIVE
  10. PLAN: RAMP A
  11. PROFILE: RAMP A
  12. PLAN & PROFILE: DETOUR ROAD
  13. REST AREA TIES
  14. REST AREA CONTOUR MAP
  15. REST AREA - GENERAL LAYOUT - GRID COORDINATES
  16. GENERAL R.O.W. AND DRAINAGE
  17. TERMINAL SECTIONS
  18. SEEDING DETAIL, FIELD ENTRANCE, EXCELSIOR BLANKET
  19. FIELD TILE PLACEMENT
  20. SPECIAL HEADWALL DETAILS: LT. & RT. STA. 299+80 35° SKEW
  21. SPECIAL HEADWALL DETAILS: LT. STA. 4+85 (PVT. DR.) 30° SKEW
  - 21A. BARRIER DETAILS
  - 22.-79. BRIDGE PLANS: STRUCTURE 57-9HB
  - 30.-84. STATION CROSS SECTIONS: F.A.I.-55
  - 85.-89. STATION CROSS SECTIONS: C.H.-36
  90. STATION CROSS SECTIONS: RAMP A (EXTENSION OF RELOCATED C.H. 36)
  - 91.-92. STATION CROSS SECTIONS: PRIVATE ROAD
  92. STATION CROSS SECTIONS: DETOUR ROAD
- STANDARD NO. 1686-3 2113-1 2228-2 2231-3 2263-2 2310-2  
 1744-2 2102 2169-4 2230-7 2262-1 2298-3 2325-1  
 2250- 2153-9 2258-1 2299-4

STATE OF ILLINOIS  
 DEPARTMENT OF TRANSPORTATION


PLANS FOR PROPOSED  
 FEDERAL AID INTERSTATE HIGHWAY

F.A.I. ROUTE 55 SECTION 57-9HB  
 MCLEAN COUNTY  
 PROJECT 1-55-4 (102)148

C-93-047-72

FEDERAL PROJECT NO.	SEC.	COUNTY	TOTAL SHEETS	SHEET NO.
F A I - 55	57-9HB	MCLEAN	93	1

STATE JOB NO. P-93-025-67

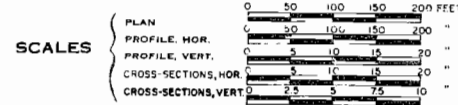


SECTION 57-9HB INCLUDES:

TWO FIVE SPAN SEPARATION STRUCTURES CARRYING  
 F.A.I. ROUTE 55 OVER RELOCATED COUNTY HIGHWAY NO.  
 36 AND RAMP A AT STA. 298+31.80 AS FOLLOWS:

**NORTHBOUND LANES:** . . . . . TWO APPROACH SPANS  
 CONSISTING OF 36 INCH PRECAST PRESTRESSED CONCRETE I BEAMS &  
 3 SPANS VARIABLE DEPTH REINFORCED CONCRETE GIRDERS,  
 REINFORCED CONCRETE DECK ON REINFORCED CONCRETE PIERS  
 AND PILE BENT ABUTMENTS, WITH SPANS ON CENTERLINE AT  
 31'-6", THREE AT 60'-0", AND ONE AT 30'-0", WIDTH VARIES  
 FROM 55'-2 1/4" TO 51'-7 1/8" OUT TO OUT OF DECK

**SOUTHBOUND LANES:** . . . . . TWO APPROACH SPANS  
 CONSISTING OF 36 INCH PRECAST PRESTRESSED CONCRETE I BEAMS &  
 3 SPANS VARIABLE DEPTH REINFORCED CONCRETE GIRDERS,  
 REINFORCED CONCRETE DECK ON REINFORCED CONCRETE PIERS  
 AND PILE BENT ABUTMENTS, WITH SPANS ON CENTERLINE AT  
 32'-6", 60'-0", 59'-0", 57'-0", AND 31'-6", WIDTH 42'-0" OUT  
 TO OUT OF DECK

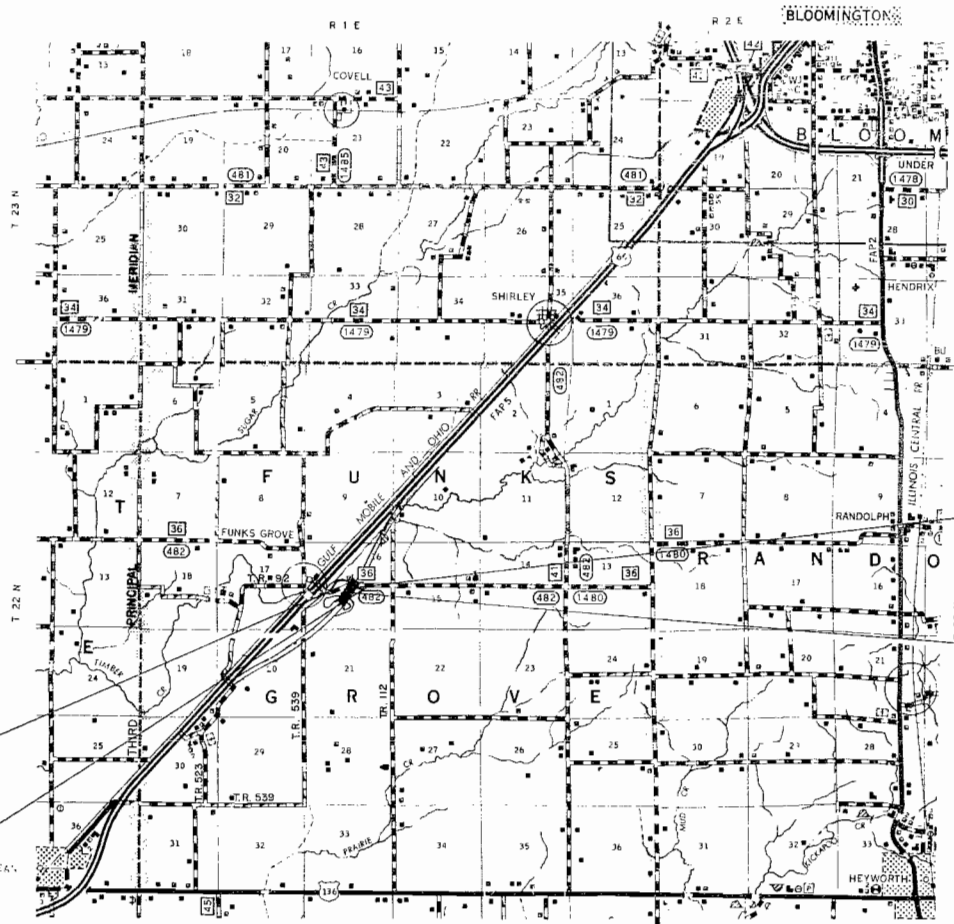

BEGIN RELOC. C.H.-36  
 STA. 33+56.79

END RELOC. C.H.-36  
 STA. 64+83.89

SECTION 57-9HB (BRIDGE)  
 PROJECT I-55-4 (102)148  
 STA. 296+56.45 TO 298+96.95 (NORTHBOUND)

STA 298+31.80 (F.A.I.-55) =  
 STA. 50+00.00 (C.H.-36)

RELOCATED C.H. 36  
 MAXIMUM GRADE = 4.00%  
 LENGTH OF MAXIMUM GRADE = 400'  
 MINIMUM STOPPING SIGHT DISTANCE = 350'  
 MINIMUM HORIZONTAL RADIUS = 763.94'

STATE OF ILLINOIS  
 DEPARTMENT OF TRANSPORTATION

DESIGNED BY: [Signature]  
 EXAMINED: [Signature]  
 PASSED: [Signature]  
 APPROVED: [Signature]  
 APPROVED: [Signature]

DEPARTMENT OF TRANSPORTATION  
 FEDERAL HIGHWAY ADMINISTRATION

APPROVED: [Signature] DATE: [ ]

DIVISION ENGINEER




HOMER L. CHASTAIN & ASSOCIATES  
 CONSULTING ENGINEERS  
 DECATUR, ILLINOIS

DESIGN DESIGNATION  
 F.A.I.-55 = 3176 (91) TRUNK 15.18 (P.C.C.-20)  
 C.H. 36 = 500 (72) LAND ACCESS 0.049 (B-20) CONTRACT NO. 29386

PE JOB NO.



STATE OF ILLINOIS  
DEPARTMENT OF TRANSPORTATION

ROUTE NO.	SECTION	COUNTY	TOTAL SHEETS	SHEET NO.	SHEET NO.
57-94B	57-94B	MCLEAN	93	21A	
FED. ROAD DIST. NO. 1		ILLINOIS	FED. AID PROJECT		SHEETS

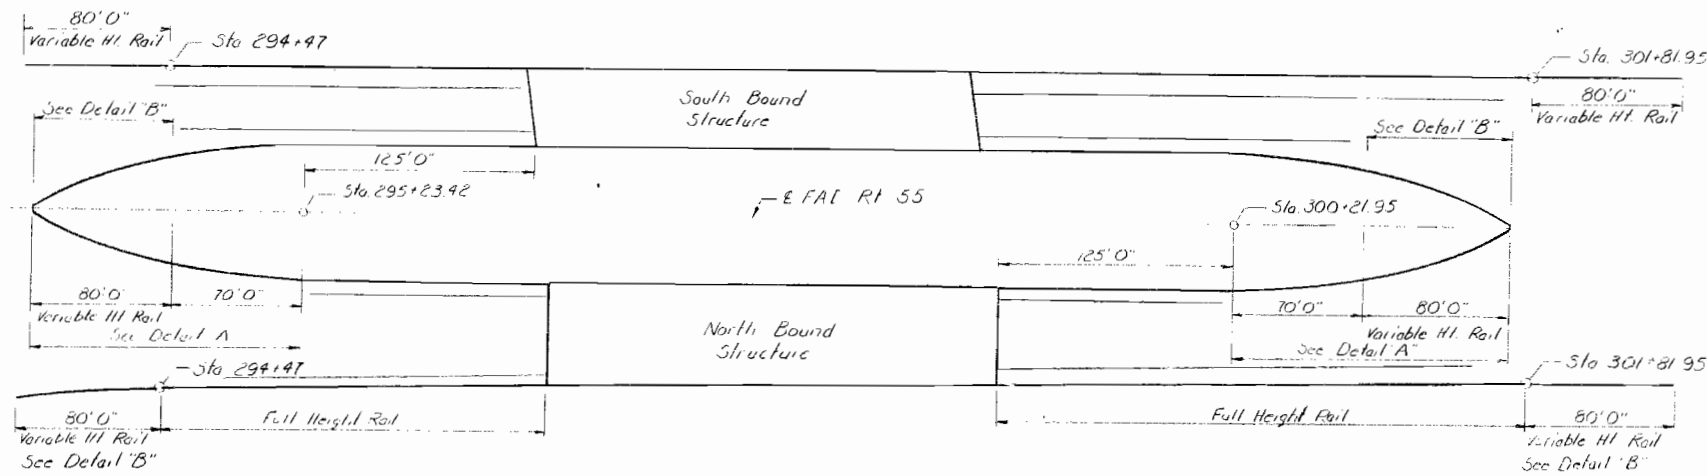





ELEVATIONS AT BASE OF MEDIAN BARRIER RAIL

Station	Distance from Median Edge of Pavement	Edge of Pavement Elevations		Elev. of Base of Median Rail	
		Left	Right	Left	Right
293+73.92	42.25	42.25	705.42	704.42	704.14
-75	41.47	41.47	706.42	706.42	704.19
294+00	30.30	30.30	706.29	706.29	704.68
+25	21.18	21.18	706.16	706.16	705.05
+50	14.11	14.11	706.03	706.03	705.32
+75	9.11	9.11	705.89	705.89	705.46
295+00	6.15	6.15	705.76	705.76	705.49
+25	5.25	5.25	705.62	705.62	705.41
+50	5.25	5.25	705.50	705.50	705.28
+75	5.25	5.25	705.36	705.36	705.16
296+00	5.25	5.25	705.23	705.23	705.01
+25	5.25	5.25	705.10	705.10	704.88
+50	5.25	5.25	704.96	704.96	704.74
299+00	5.25	5.25	703.84	703.84	703.42
+25	5.25	5.25	703.71	703.71	703.29
+50	5.25	5.25	703.58	703.58	703.16
+75	5.25	5.25	703.44	703.44	703.02
300+00	5.25	5.25	703.31	703.31	702.89
+25	5.27	5.27	702.98	702.98	702.76
+50	6.56	6.56	702.84	702.84	702.57
+75	9.88	9.88	702.71	702.71	702.23
301+00	15.37	15.37	702.58	702.58	701.80
+25	22.71	22.71	702.45	702.45	701.26
+50	32.21	32.21	702.32	702.32	700.50
+71.95	42.25	42.25	702.18	702.18	699.90

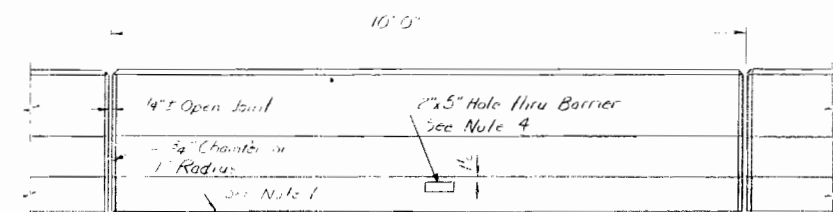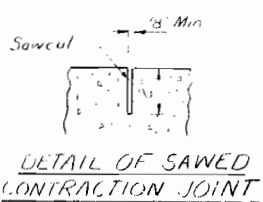

**GENERAL NOTES:**  
Where horizontal alignment of the concrete barrier is curved, the construction of the barrier may be either curved or an maximum 10 foot chords.  
Precast barrier sections shall have threaded inserts for lifting placed in barrier during fabrication. Inserts shall be placed a minimum of 1/4 inch below the surface and embedded to develop sufficient capacity to lift the section safely.  
Detail and location of the lifting device and its method of anchorage is subject to the approval of the Engineer.  
The inserts are to be filled with grout after the sections are in place.

**NOTES:**  
1) Precast barrier sections shall be placed and bed formed of dry cement to obtain proper alignment and seating.  
4) The 2"x5" holes thru barriers shall be provided where cross drainage is required. Location and number of holes shall be as shown on the plans or where required or directed by the Engineer in the field.

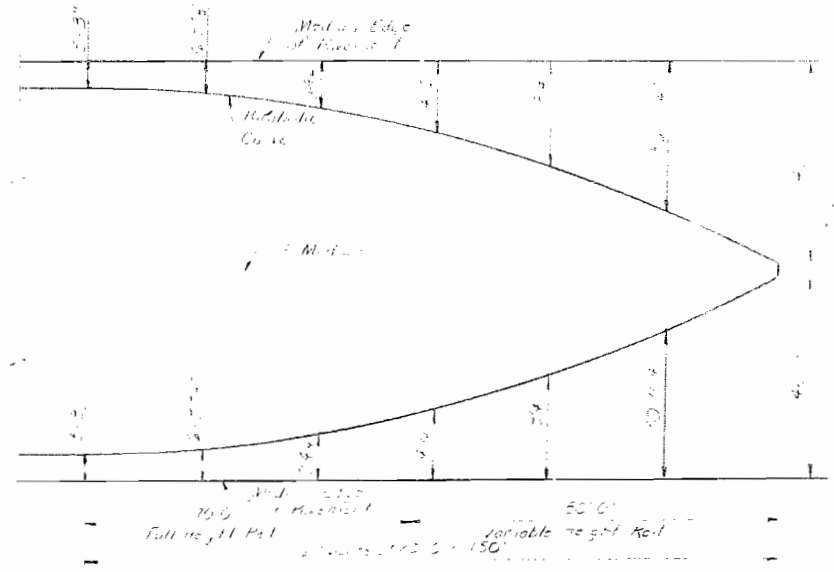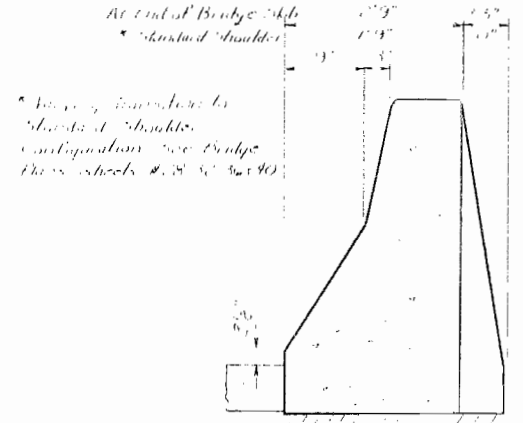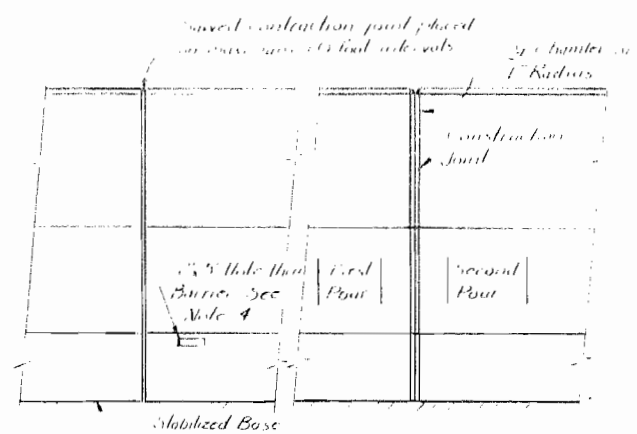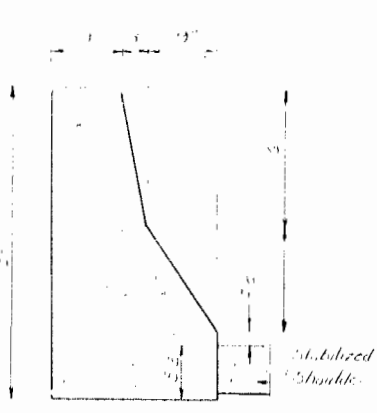

DETAIL A



TYPICAL SECTION OF BARRIER

SIDE ELEVATION OF CAST IN PLACE BARRIER

SECTION OF BARRIER AT TRANSITION

DESIGNED	A. J. Kuppert
CHECKED	S. E. Lindsey
DRAWN	S. E. Lindsey
CHECKED	

EXAMINED	[Signature]	OCT. 20 1972
PASSED	W. E. Baumann	
APPROVED	Richard H. Helterman	


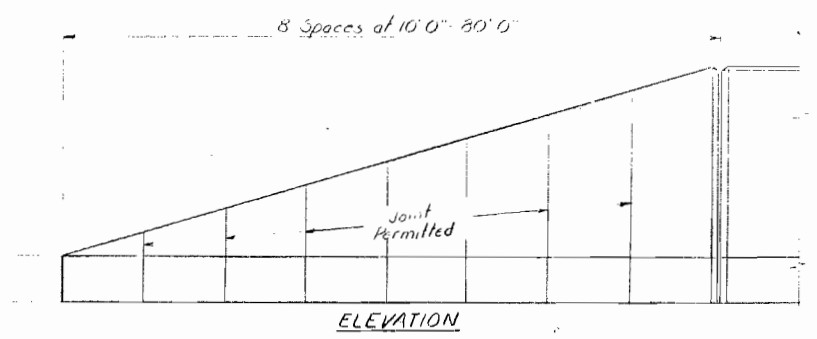
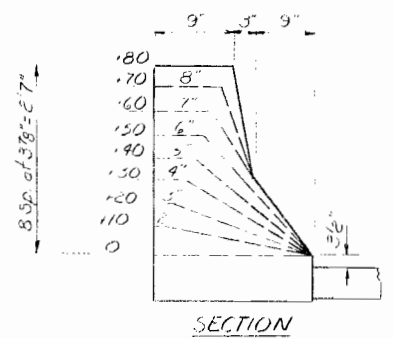


FOR INFORMATION ONLY

BARRIER DETAILS  
FAI RT 55 SEC 57-94B  
MCLEAN COUNTY  
STA 297+80.50

STATE OF ILLINOIS  
DEPARTMENT OF TRANSPORTATION

ROUTE NO.	SECTION	COUNTY	TOTAL SHEETS	SHEET NO.	SHEET NO. /
55	57-9AB	MC LEAN	93	22	58 SHEETS
FED. ROAD DIST. NO. 7	ILLINOIS	FED. AID PROJECT			

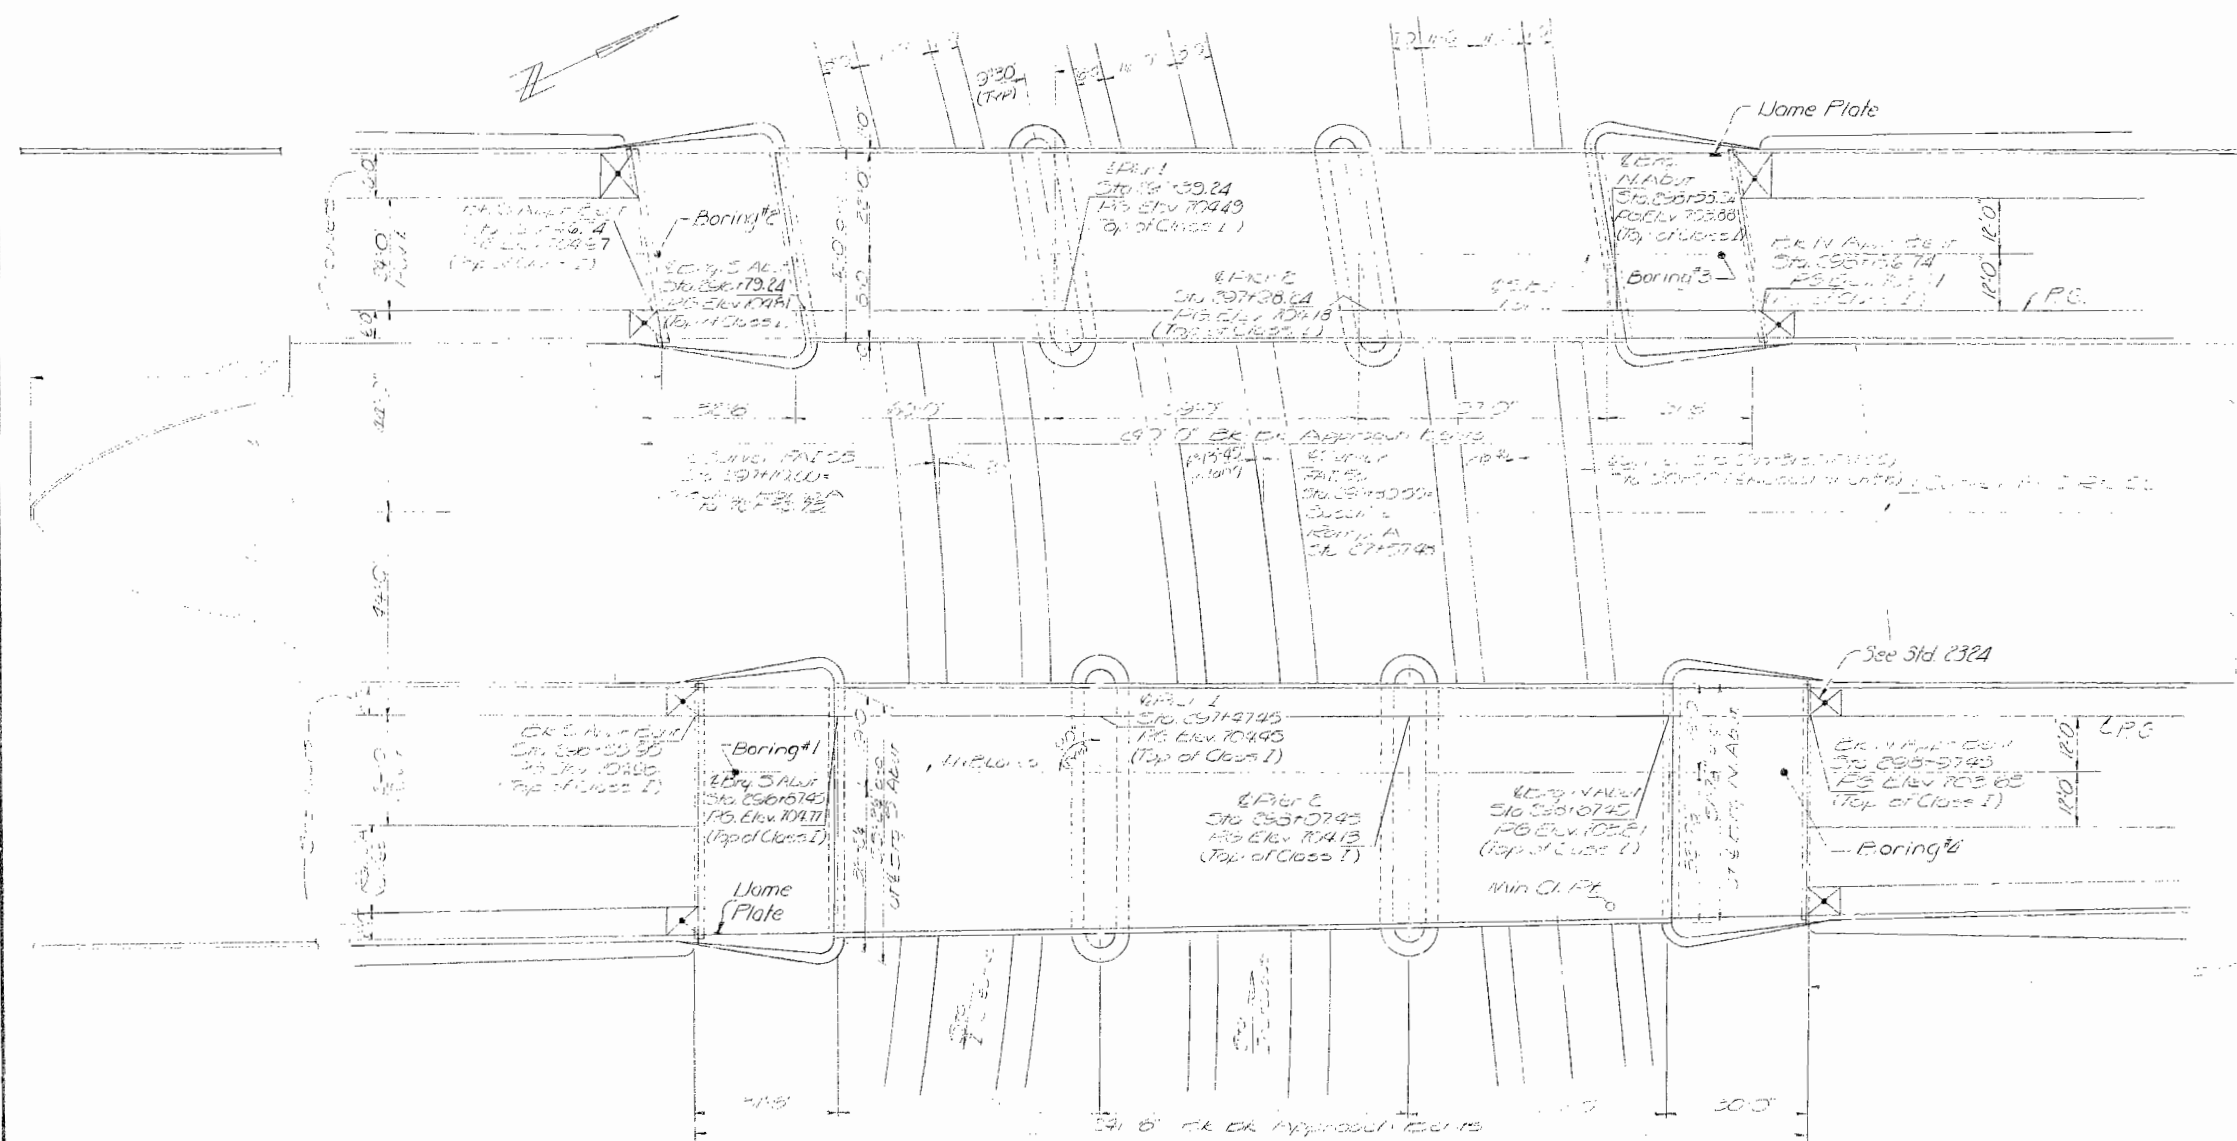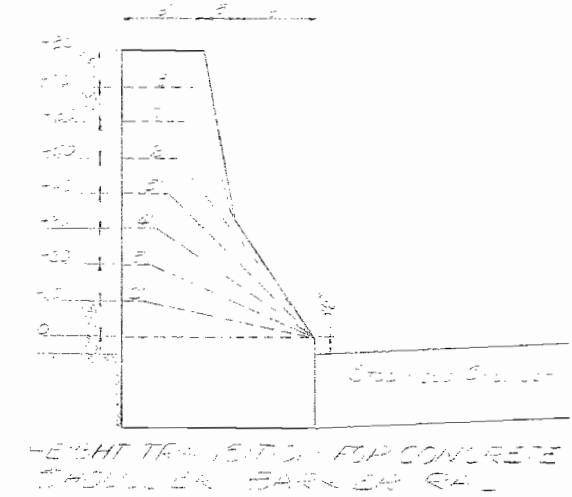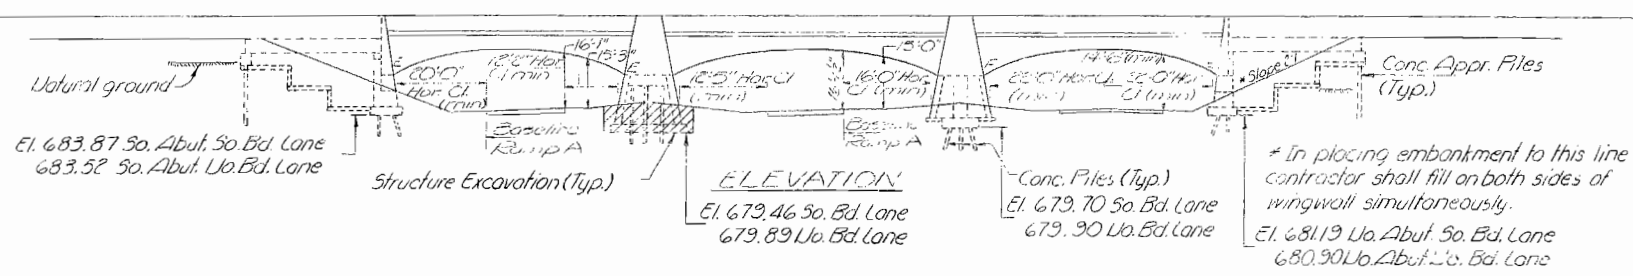

DESIGNED	A. I. Khayyat
CHECKED	
DRAWN	
CHECKED	

OCTOBER 23 1971

EXAMINED

PASSED

APPROVED

Richard A. Galtman  
CHIEF HIGHWAY ENGINEER

FD. PROJ. I-55-A(102)148

GENERAL NOTES AND ELEVATIONS

PILE 297+32 OVER CH 28

BEST AREA RAMP A

PILE 297+38 SEC 57-9AB

MC LEAN COUNTY


STATION 297+32.24

STATE OF ILLINOIS  
DEPARTMENT OF TRANSPORTATION

ROUTE NO.	SECTION	COUNTY	TOTAL SHEETS	SHEET NO.	SHEET NO.
55	57-9HB	MC LEAN	93	23	55 SHEETS
FED. ROAD DIST. NO. 7		ILLINOIS	FED. AID PROJECT		

GENERAL NOTES

- All reinforcement bars shall be lapped 24 Dia. unless otherwise shown.
- The basic lead silico chromate point system shall be used for 2 coats of snap painting of structural steel.
- The contractor shall make allowance for the deflection of forms, shrinkage & settlement of falsework, in addition to allowance for dead load deflection.
- An alternate strand pattern using Extra High Strength Prestressing Strand (270ksi) is permitted.
- The concrete rail section above the mandatory construction joint at the top of the slab shall be constructed of Class A Concrete except the aggregates shall conform to the requirements of Mandrail Concrete.
- Protective Coat shall not be applied to surfaces to which Coat for Interlayer Protective Coat is applied.
- The Contractor shall drive four Conc. test piles in permanent locations; one each of Pier 2 on South of Jctn. B. lanes and 3 on Pier 2 of South B. lanes as directed by the Engineer before ordering the remainder of piles.

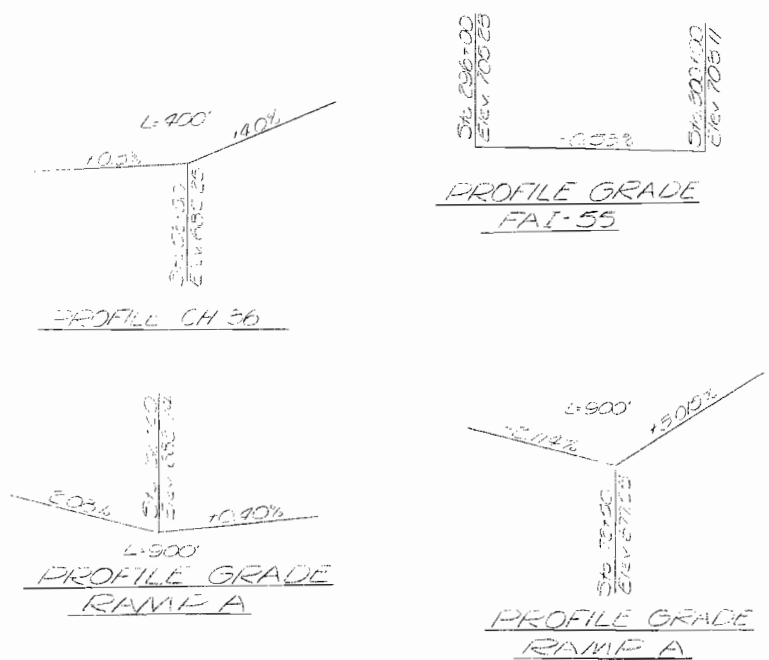

CURVE DATA RAMP A

PI. ST. 29180.22	PI. ST. 30180.22
2+83.20' 30° L	2+64.02' 112° L
2+95.00	2+79.98' 05° L
2+95.82	2+79.20'
2+94.50	2+75.34
2+77.10	2+82.10'
2+75.14	2+73.18'
PC ST. 19485.22	PT. ST. 19485.22
1+00.00 0713743	1+71.00 0713743
1+00.00	1+00.00

RAMP A OFFSET


1+00.00	2+12.50
1+00.00	2+12.50
DESIGN STRESSES

FIELD UNITS


PRECAST PRESTRESSED UNITS

LOADING H520-44 ALT

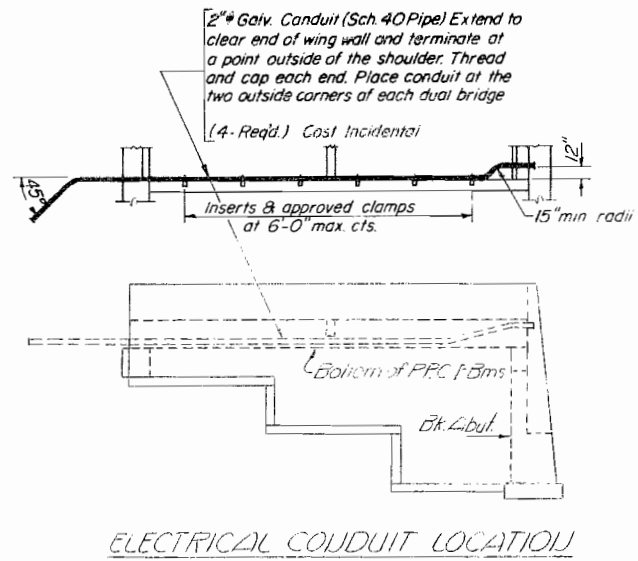

STATION 297+80.50  
BUILT 19 BY  
STATE OF ILLINOIS  
FAI RT. 55 SEC. 57-9HB  
FA PROJ. 155-4(102)  
LOADING H520 ALT.

NAME PLATE  
(See Std. 2113)

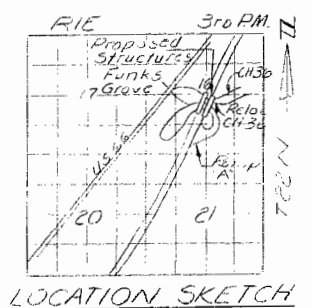

TOTAL BILL OF MATERIAL

Item	Unit	Super	Sub	Total
* Bituminous Concrete				
Surface Course Class 2	Tons	194		194
Structure Excavator 20	Cu Yds		273	273
* Protective Coat	Sq Yds	453		453
Class X Concrete	Cu Yds	1505.8	1507.2	3013.0
Furnishing Erecting P.P.C.				
I-Beams 36"	Lin. Ft.	813		813
Structural Steel	Lbs.	37670		37670
Reinforcement Bars	Lbs.	357340	52150	409490
Concrete Piles	Lin. Ft.		12637	12637
Test Pile (Concrete)	Each		4	4
Urnge Piles	Each	2		2
Preformed Joint Sealer (2")	Lin. Ft.	36		36
Preformed Joint Sealer (4")	Lin. Ft.	36		36
* Coat for Interlayer	Sq. Yds.	2365		2365
Protective Coat	Sq. Yds.	2365		2365

\* THESE ITEMS ARE TO BE CONSTRUCTED BY THE PAVING CONTRACTOR FOR SECTION 57-9.

DESIGNED	A. J. [Signature]
CHECKED	[Signature]
DRAWN	[Signature]
CHECKED	[Signature]


EXAMINED	[Signature]
PASSED	[Signature]
APPROVED	[Signature]

Note:  
For footing layout see sh # 55.

DATE SHEET FOR FAI RT. 55  
OVER 1000 AND REST AREA RAMP  
FAI RT. 55 SEC. 57-9HB  
MC LEAN COUNTY  
STATION 297+80.50


STATE OF ILLINOIS  
DEPARTMENT OF TRANSPORTATION

ROUTE NO.	SECTION	COUNTY	TOTAL SHEETS	SHEET NO.
55	51-9H8	MC LEAN	93	24
SHEETS				

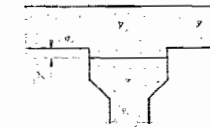





FILLET HEIGHTS

To determine "f": After all precast prestressed beams have been erected, elevations of the top flanges of the beams shall be taken at intervals shown below. These elevations subtracted algebraically from the "Theoretical Grade Elevations Adjusted for Dead Load Deflections" shown on Spcs. #4, 5 & 6, minus Deck Thickness equals the fillet heights "f". A positive value of "f" equals the fillet heights above the top of the beam. A negative value of "f" not to exceed "e", equals the embedment of the beam above the theoretical bottom of slab elevation.

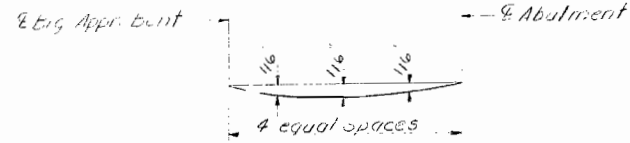

DEAD LOAD DEFLECTION DIAGRAM

(Includes weight of concrete only)  
Note: The above deflections are not to be used in the field if the engineer is working from the grade elevations adjusted for dead load deflections as shown on Spcs. #4, 5 & 6.

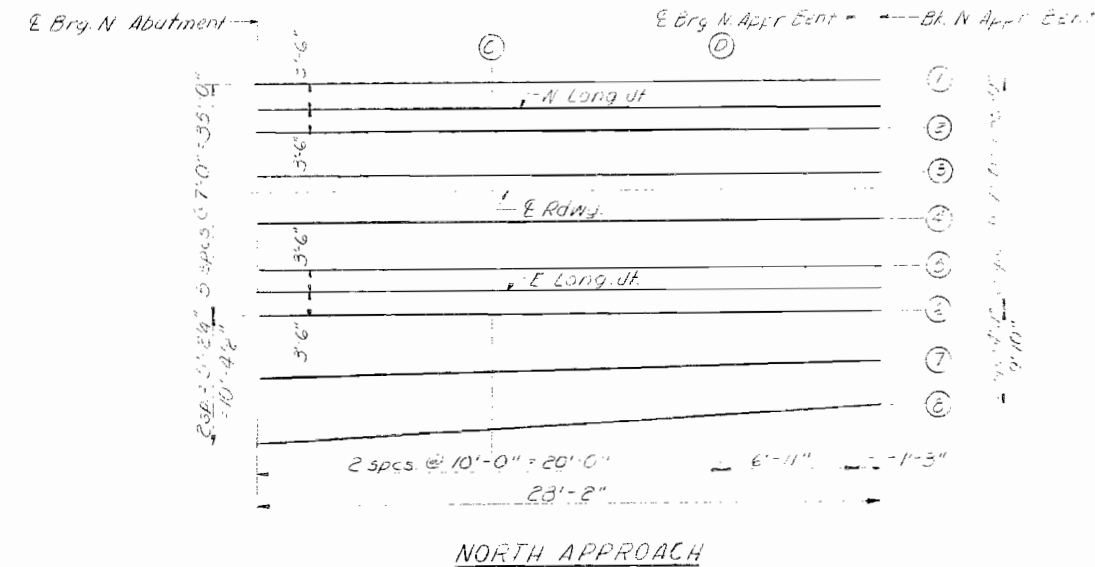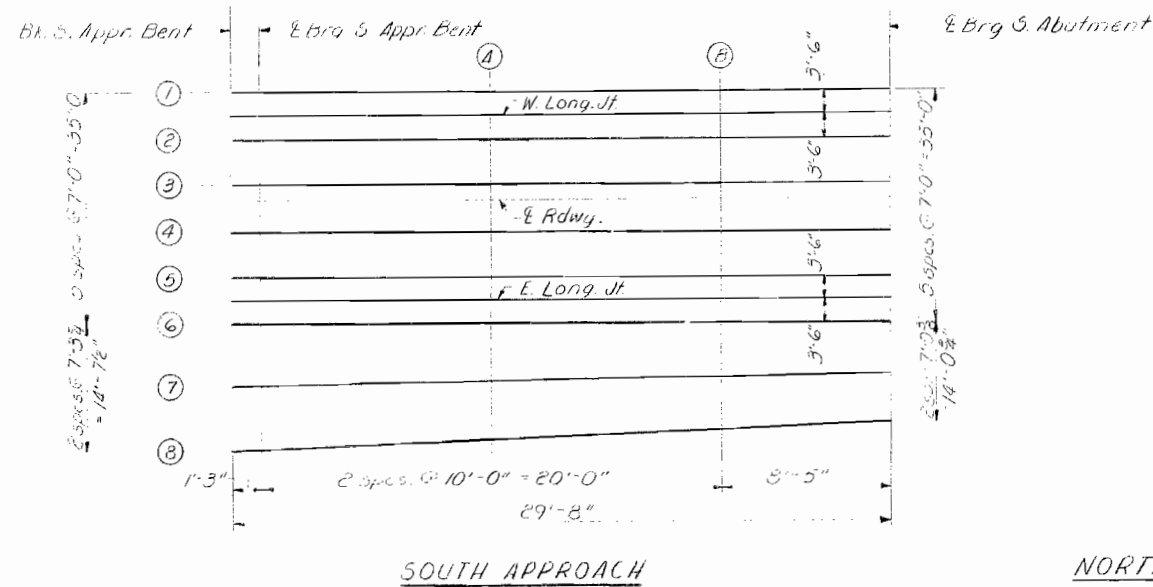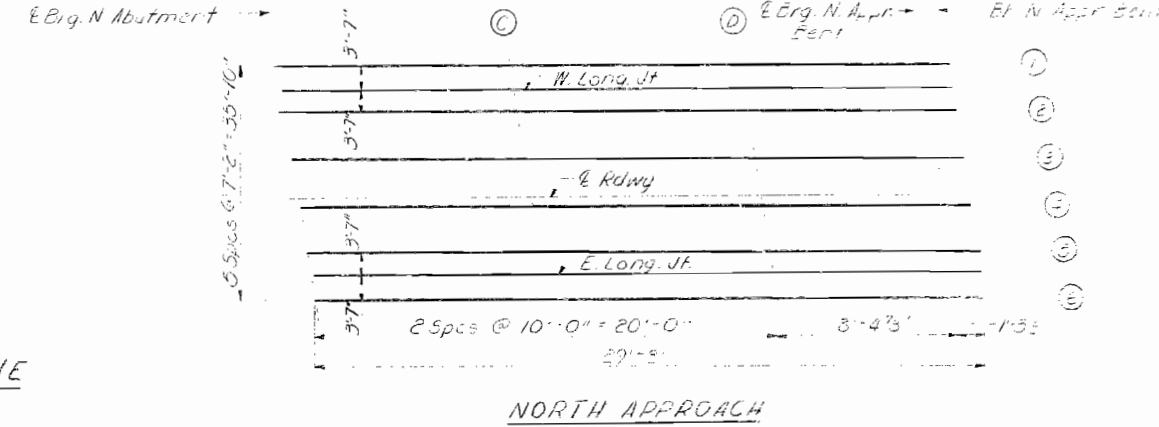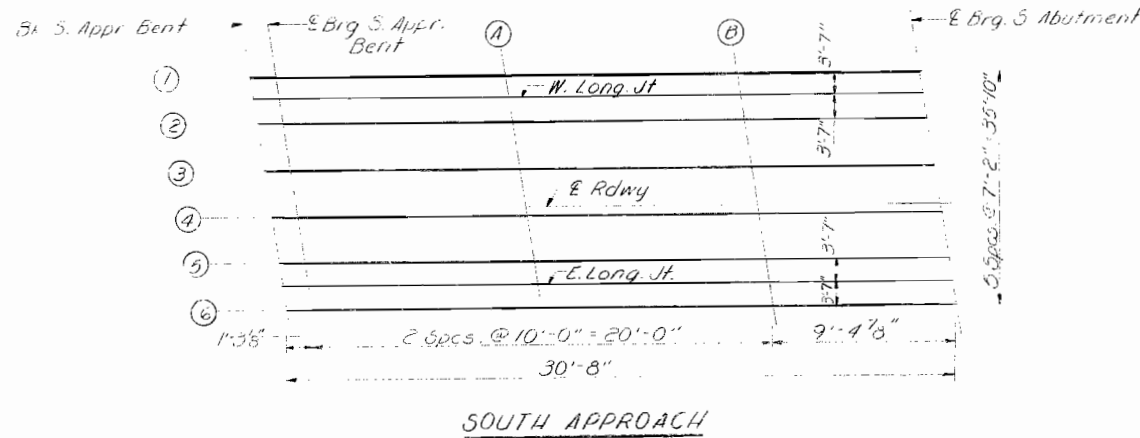

SOUTH BD LANE

NORTH BD LANE

LOCATION PLAN

DESIGNED	A. J. Khayyat
CHECKED	L. J. [Signature]
DRAWN	Ben Robinson
CHECKED	L. J. [Signature]

OCT. 20 1972  
EXAMINED [Signature]  
PASSED [Signature]  
APPROVED [Signature]

APPROACH SPANS  
TOP OF CLASS I ELEVATIONS  
FAI RT 55 SEC. 51-9H8  
MCLEAN COUNTY  
STA 297+80.50

STATE OF ILLINOIS  
DEPARTMENT OF TRANSPORTATION

ROUTE NO.	SECTION	COUNTY	TOTAL SHEETS	SHEET NO.	SHEET NO. 4
1.55	57-9NB	MC LEAN	93	25	58 SHEETS
FED. ROAD DIST. NO. 1	ILL. NO. 1	FED. AID PROJECT			

BEAM 1

Location	Station	Offset	Theoretical Grade Elevations	Theoretical Grade Elevations Adjusted For Dead Load Deflection
Bk. S. Approach Bent	29641.397	-19.917	704.846	704.846
E Brg. S. Appr. Bent	29642.664	-19.917	704.840	704.840
A	29652.664	-19.917	704.787	704.791
B	29662.664	-19.917	704.734	704.737
E Brg. S. Abutment	29672.054	-19.917	704.684	704.684
E Brg. N. Abutment	29851.740	-19.917	703.732	703.732
C	29861.740	-19.917	703.679	703.683
D	29871.740	-19.917	703.626	703.629
E Brg. N. Appr. Bent	29880.130	-19.917	703.581	703.581
Bk. N. Approach Bent	29881.397	-19.917	703.574	703.574

BEAM 3

Location	Station	Offset	Theoretical Grade Elevations	Theoretical Grade Elevations Adjusted For Dead Load Deflection
Bk. S. Approach Bent	29643.796	-5.584	705.099	705.099
E Brg. S. Appr. Bent	29645.063	-5.584	705.092	705.092
A	29655.063	-5.584	705.039	705.043
B	29665.063	-5.584	704.986	704.990
E Brg. S. Abutment	29674.453	-5.584	704.936	704.936
E Brg. N. Abutment	29854.139	-5.584	703.984	703.984
C	29864.139	-5.584	703.931	703.935
D	29874.139	-5.584	703.878	703.881
E Brg. N. Appr. Bent	29882.529	-5.584	703.833	703.833
Bk. N. Approach Bent	29883.796	-5.584	703.827	703.827

BEAM 5

Location	Station	Offset	Theoretical Grade Elevations	Theoretical Grade Elevations Adjusted For Dead Load Deflection
Bk. S. Approach Bent	29646.194	8.749	705.036	705.036
E Brg. S. Appr. Bent	29647.461	8.749	705.030	705.030
A	29657.461	8.749	704.977	704.981
B	29667.461	8.749	704.924	704.927
E Brg. S. Abutment	29676.851	8.749	704.874	704.874
E Brg. N. Abutment	29856.537	8.749	703.922	703.922
C	29866.537	8.749	703.869	703.873
D	29876.537	8.749	703.816	703.819
E Brg. N. Appr. Bent	29884.927	8.749	703.771	703.771
Bk. N. Approach Bent	29886.194	8.749	703.764	703.764

WEST LONGITUDINAL JOINT

Location	Station	Offset	Theoretical Grade Elevations	Theoretical Grade Elevations Adjusted For Dead Load Deflection
Bk. S. Approach Bent	29641.997	-16.334	704.918	704.918
E Brg. S. Appr. Bent	29643.264	-16.334	704.911	704.911
A	29653.264	-16.334	704.858	704.862
B	29663.264	-16.334	704.805	704.809
E Brg. S. Abutment	29672.654	-16.334	704.755	704.755
E Brg. N. Abutment	29852.340	-16.334	703.803	703.803
C	29862.340	-16.334	703.750	703.754
D	29872.340	-16.334	703.697	703.701
E Brg. N. Appr. Bent	29880.730	-16.334	703.652	703.652
Bk. N. Approach Bent	29881.997	-16.334	703.646	703.646

E ROADWAY

Location	Station	Offset	Theoretical Grade Elevations	Theoretical Grade Elevations Adjusted For Dead Load Deflection
Bk. S. Approach Bent	29644.730	-0.001	705.181	705.181
E Brg. S. Appr. Bent	29645.997	-0.001	705.174	705.174
A	29655.997	-0.001	705.121	705.125
B	29665.997	-0.001	705.068	705.072
E Brg. S. Abutment	29675.387	-0.001	705.018	705.018
E Brg. N. Abutment	29855.073	-0.001	704.066	704.066
C	29865.073	-0.001	704.013	704.017
D	29875.073	-0.001	703.960	703.964
E Brg. N. Appr. Bent	29883.463	-0.001	703.916	703.916
Bk. N. Approach Bent	29884.730	-0.001	703.909	703.909

EAST LONGITUDINAL JOINT

Location	Station	Offset	Theoretical Grade Elevations	Theoretical Grade Elevations Adjusted For Dead Load Deflection
Bk. S. Approach Bent	29646.794	12.332	704.976	704.976
E Brg. S. Appr. Bent	29648.061	12.332	704.969	704.969
A	29658.061	12.332	704.916	704.920
B	29668.061	12.332	704.863	704.867
E Brg. S. Abutment	29677.451	12.332	704.813	704.813
E Brg. N. Abutment	29857.137	12.332	703.861	703.861
C	29867.137	12.332	703.808	703.812
D	29877.137	12.332	703.755	703.758
E Brg. N. Appr. Bent	29885.527	12.332	703.710	703.710
Bk. N. Approach Bent	29886.794	12.332	703.704	703.704

BEAM 2

Location	Station	Offset	Theoretical Grade Elevations	Theoretical Grade Elevations Adjusted For Dead Load Deflection
Bk. S. Approach Bent	29642.596	-12.751	704.989	704.989
E Brg. S. Appr. Bent	29643.863	-12.751	704.982	704.982
A	29653.863	-12.751	704.929	704.933
B	29663.863	-12.751	704.876	704.880
E Brg. S. Abutment	29673.253	-12.751	704.827	704.827
E Brg. N. Abutment	29852.939	-12.751	703.874	703.874
C	29862.939	-12.751	703.821	703.825
D	29872.939	-12.751	703.768	703.772
E Brg. N. Appr. Bent	29881.329	-12.751	703.724	703.724
Bk. N. Approach Bent	29882.596	-12.751	703.717	703.717

BEAM 4

Location	Station	Offset	Theoretical Grade Elevations	Theoretical Grade Elevations Adjusted For Dead Load Deflection
Bk. S. Approach Bent	29644.995	1.582	705.155	705.155
E Brg. S. Appr. Bent	29646.262	1.582	705.148	705.148
A	29656.262	1.582	705.095	705.099
B	29666.262	1.582	705.042	705.046
E Brg. S. Abutment	29675.652	1.582	704.992	704.992
E Brg. N. Abutment	29855.338	1.582	704.040	704.040
C	29865.338	1.582	703.987	703.991
D	29875.338	1.582	703.934	703.938
E Brg. N. Appr. Bent	29883.728	1.582	703.890	703.890
Bk. N. Approach Bent	29884.995	1.582	703.883	703.883

BEAM 6

Location	Station	Offset	Theoretical Grade Elevations	Theoretical Grade Elevations Adjusted For Dead Load Deflection
Bk. S. Approach Bent	29647.393	15.915	704.898	704.898
E Brg. S. Appr. Bent	29648.660	15.915	704.891	704.891
A	29658.660	15.915	704.838	704.842
B	29668.660	15.915	704.785	704.789
E Brg. S. Abutment	29678.050	15.915	704.735	704.735
E Brg. N. Abutment	29857.736	15.915	703.783	703.783
C	29867.736	15.915	703.730	703.734
D	29877.736	15.915	703.677	703.681
E Brg. N. Appr. Bent	29886.126	15.915	703.633	703.633
Bk. N. Approach Bent	29887.393	15.915	703.626	703.626

DESIGNED BY	K. R. Karpel
CHECKED BY	M. J. [Signature]
DRAWN BY	M. J. [Signature]
CHECKED BY	[Signature]

EXAMINED	[Signature]	OCT. 20 1972
PASSED	[Signature]	
APPROVED	[Signature]	
CHIEF DESIGNER	[Signature]	

E. J. [Signature]  
 SOUT - ED LAKE  
 FAIRBANKS SEC. ST. P. E.  
 MCLEAN COUNTY  
 STA. 297+50.50



STATE OF ILLINOIS  
DEPARTMENT OF TRANSPORTATION

ROUTE NO.	SECTION	COUNTY	TOTAL SHEETS	SHEET NO.	SHEET NO. 6
155	57-9HB	MCLEAN	93	26	55 SHEETS

BEAM 1

Location	Station	Offset	Theoretical Grade Elevations	Theoretical Grade Elevations Adjusted For Dead Load Deflection
Bk. S. Approach Bent	29655.950	-15.917	704.852	704.852
Brig. S. Appr. Bent	29657.200	-15.917	704.846	704.846
A	29667.200	-15.917	704.793	704.797
B	29677.200	-15.917	704.740	704.743
Brig. S. Abutment	29685.627	-15.917	704.695	704.695
Brig. N. Abutment	29869.273	-15.917	703.722	703.722
C	29879.273	-15.917	703.669	703.673
D	29889.273	-15.917	703.616	703.619
Brig. N. Appr. Bent	29896.200	-15.917	703.579	703.579
Bk. N. Approach Bent	29897.450	-15.917	703.573	703.573

BEAM 3

Location	Station	Offset	Theoretical Grade Elevations	Theoretical Grade Elevations Adjusted For Dead Load Deflection
Bk. S. Approach Bent	29655.950	-1.917	705.092	705.092
Brig. S. Appr. Bent	29657.200	-1.917	705.085	705.085
A	29667.200	-1.917	705.032	705.036
B	29677.200	-1.917	704.979	704.982
Brig. S. Abutment	29685.627	-1.917	704.934	704.934
Brig. N. Abutment	29869.273	-1.917	703.961	703.961
C	29879.273	-1.917	703.908	703.912
D	29889.273	-1.917	703.855	703.858
Brig. N. Appr. Bent	29896.200	-1.917	703.818	703.818
Bk. N. Approach Bent	29897.450	-1.917	703.812	703.812

BEAM 5

Location	Station	Offset	Theoretical Grade Elevations	Theoretical Grade Elevations Adjusted For Dead Load Deflection
Bk. S. Approach Bent	29655.950	12.083	704.932	704.932
Brig. S. Appr. Bent	29657.200	12.083	704.926	704.926
A	29667.200	12.083	704.873	704.877
B	29677.200	12.083	704.820	704.823
Brig. S. Abutment	29685.627	12.083	704.775	704.775
Brig. N. Abutment	29869.273	12.083	703.802	703.802
C	29879.273	12.083	703.749	703.753
D	29889.273	12.083	703.696	703.699
Brig. N. Appr. Bent	29896.200	12.083	703.659	703.659
Bk. N. Approach Bent	29897.450	12.083	703.652	703.652

WEST LONGITUDINAL JOINT

Location	Station	Offset	Theoretical Grade Elevations	Theoretical Grade Elevations Adjusted For Dead Load Deflection
Bk. S. Approach Bent	29655.950	-12.417	704.925	704.925
Brig. S. Appr. Bent	29657.200	-12.417	704.919	704.919
A	29667.200	-12.417	704.866	704.870
B	29677.200	-12.417	704.813	704.816
Brig. S. Abutment	29685.627	-12.417	704.768	704.768
Brig. N. Abutment	29869.273	-12.417	703.795	703.795
C	29879.273	-12.417	703.742	703.746
D	29889.273	-12.417	703.689	703.692
Brig. N. Appr. Bent	29896.200	-12.417	703.652	703.652
Bk. N. Approach Bent	29897.450	-12.417	703.645	703.645

ROADWAY

Location	Station	Offset	Theoretical Grade Elevations	Theoretical Grade Elevations Adjusted For Dead Load Deflection
Bk. S. Approach Bent	29655.950	0.0	705.121	705.121
Brig. S. Appr. Bent	29657.200	0.0	705.115	705.115
A	29667.200	0.0	705.062	705.066
B	29677.200	0.0	705.009	705.012
Brig. S. Abutment	29685.627	0.0	704.964	704.964
Brig. N. Abutment	29869.273	0.0	703.991	703.991
C	29879.273	0.0	703.938	703.942
D	29889.273	0.0	703.885	703.888
Brig. N. Appr. Bent	29896.200	0.0	703.848	703.848
Bk. N. Approach Bent	29897.450	0.0	703.842	703.842

EAST LONGITUDINAL JOINT

Location	Station	Offset	Theoretical Grade Elevations	Theoretical Grade Elevations Adjusted For Dead Load Deflection
Bk. S. Approach Bent	29655.950	15.583	704.859	704.859
Brig. S. Appr. Bent	29657.200	15.583	704.853	704.853
A	29667.200	15.583	704.800	704.804
B	29677.200	15.583	704.747	704.750
Brig. S. Abutment	29685.627	15.583	704.702	704.702
Brig. N. Abutment	29869.273	15.583	703.729	703.729
C	29879.273	15.583	703.676	703.680
D	29889.273	15.583	703.623	703.626
Brig. N. Appr. Bent	29896.200	15.583	703.586	703.586
Bk. N. Approach Bent	29897.450	15.583	703.579	703.579

BEAM 2

Location	Station	Offset	Theoretical Grade Elevations	Theoretical Grade Elevations Adjusted For Dead Load Deflection
Bk. S. Approach Bent	29655.950	-8.917	704.982	704.982
Brig. S. Appr. Bent	29657.200	-8.917	704.976	704.976
A	29667.200	-8.917	704.923	704.926
B	29677.200	-8.917	704.870	704.873
Brig. S. Abutment	29685.627	-8.917	704.825	704.825
Brig. N. Abutment	29869.273	-8.917	703.852	703.852
C	29879.273	-8.917	703.799	703.803
D	29889.273	-8.917	703.746	703.749
Brig. N. Appr. Bent	29896.200	-8.917	703.709	703.709
Bk. N. Approach Bent	29897.450	-8.917	703.702	703.702

BEAM 4

Location	Station	Offset	Theoretical Grade Elevations	Theoretical Grade Elevations Adjusted For Dead Load Deflection
Bk. S. Approach Bent	29655.950	5.083	705.042	705.042
Brig. S. Appr. Bent	29657.200	5.083	705.035	705.035
A	29667.200	5.083	704.982	704.986
B	29677.200	5.083	704.929	704.933
Brig. S. Abutment	29685.627	5.083	704.885	704.885
Brig. N. Abutment	29869.273	5.083	703.911	703.911
C	29879.273	5.083	703.858	703.862
D	29889.273	5.083	703.805	703.809
Brig. N. Appr. Bent	29896.200	5.083	703.769	703.769
Bk. N. Approach Bent	29897.450	5.083	703.762	703.762

BEAM 6

Location	Station	Offset	Theoretical Grade Elevations	Theoretical Grade Elevations Adjusted For Dead Load Deflection
Bk. S. Approach Bent	29655.950	19.083	704.787	704.787
Brig. S. Appr. Bent	29657.200	19.083	704.780	704.780
A	29667.200	19.083	704.727	704.731
B	29677.200	19.083	704.674	704.678
Brig. S. Abutment	29685.627	19.083	704.629	704.629
Brig. N. Abutment	29869.273	19.083	703.656	703.656
C	29879.273	19.083	703.603	703.607
D	29889.273	19.083	703.550	703.553
Brig. N. Appr. Bent	29896.200	19.083	703.513	703.513
Bk. N. Approach Bent	29897.450	19.083	703.507	703.507

DESIGNED	L. J. Robinson
CHECKED	L. J. Robinson
DRAWN	Dev Robinson
CHECKED	L. J. Robinson

EXAMINED	[Signature]
PASSED	[Signature]
APPROVED	Richard H. Glatteman

APPROXIMATE SPANS  
TOP OF CLASS I ELEVATIONS  
NORTH ED. LINE  
FAI PT. 55 SEC. 57-74E  
MCLEAN COUNTY  
STA. 297-30.50

STATE OF ILLINOIS  
DEPARTMENT OF TRANSPORTATION

ROUTE NO.	SECTION	COUNTY	TOTAL SHEETS	SHEET NO.	SHEET NO. 6 58 SHEETS
55	57-94B	MC LEAN	93	27	
FED. ROAD DIST. NO. 1		NO. 18	FED. AID PROJECT		

BEAM 7

Location	Station	Offset	Theoretical Grade Elevations	Theoretical Grade Elevations Adjusted For Dead Load Deflection
Bk. S. Approach Bent	29655.950	26.409	704.635	704.635
E. Brg. S. Appr. Bent	29657.200	26.396	704.628	704.628
A	29667.200	26.296	704.577	704.581
B	29677.200	26.196	704.526	704.530
E. Brg. S. Abutment	29685.627	26.112	704.483	704.483
E. Brg. N. Abutment	29869.273	24.273	703.548	703.548
C	29879.273	24.173	703.497	703.501
D	29889.273	24.073	703.446	703.449
E. Brg. N. Appr. Bent	29896.200	24.003	703.411	703.411
Bk. N. Approach Bent	29897.450	23.991	703.405	703.405

BEAM 8

Location	Station	Offset	Theoretical Grade Elevations	Theoretical Grade Elevations Adjusted For Dead Load Deflection
Bk. S. Approach Bent	29655.950	33.735	704.482	704.482
E. Brg. S. Appr. Bent	29657.200	33.709	704.476	704.476
A	29667.200	33.509	704.427	704.431
B	29677.200	33.309	704.378	704.382
E. Brg. S. Abutment	29685.627	33.141	704.337	704.337
E. Brg. N. Abutment	29869.273	29.463	703.440	703.440
C	29879.273	29.263	703.391	703.395
D	29889.273	29.063	703.342	703.346
E. Brg. N. Appr. Bent	29896.200	28.923	703.308	703.308
Bk. N. Approach Bent	29897.450	28.899	703.303	703.303

DESIGNED	<i>A. J. Whappell</i>
CHECKED	<i>L. M. [unclear]</i>
DRAWN	<i>Rev Robinson</i>
CHECKED	<i>L. M. [unclear]</i>

EXAMINED	<i>[Signature]</i> OCT. 20 1971
PASSED	<i>W. E. Baumann</i> ENGINEER OF DESIGN
APPROVED	<i>Richard H. Holterman</i> CHIEF HIGHWAY ENGINEER



APPROACH GRADE  
TOP OF CLASS I ELEVATIONS  
NORTH ED LANE  
F.A.I. RT. 55 SEC. 57-94E  
MCLEAN COUNTY  
STA. 297+80.50



STATE OF ILLINOIS  
DEPARTMENT OF TRANSPORTATION

ROUTE NO.	SECTION	COUNTY	TOTAL SHEETS	SHEET NO.	SHEETS
57-9HB	MC LEAN	93	28	56	56 SHEETS

Note:  
Bars indicated thus 20x3 #5 etc.  
indicates 20 lines of bars with  
3 lengths per line.  
Min. bar lap = 24 Dia.

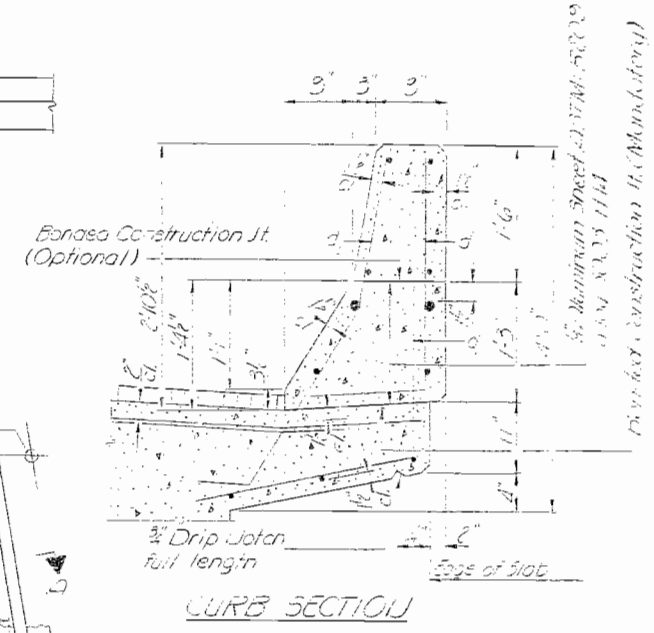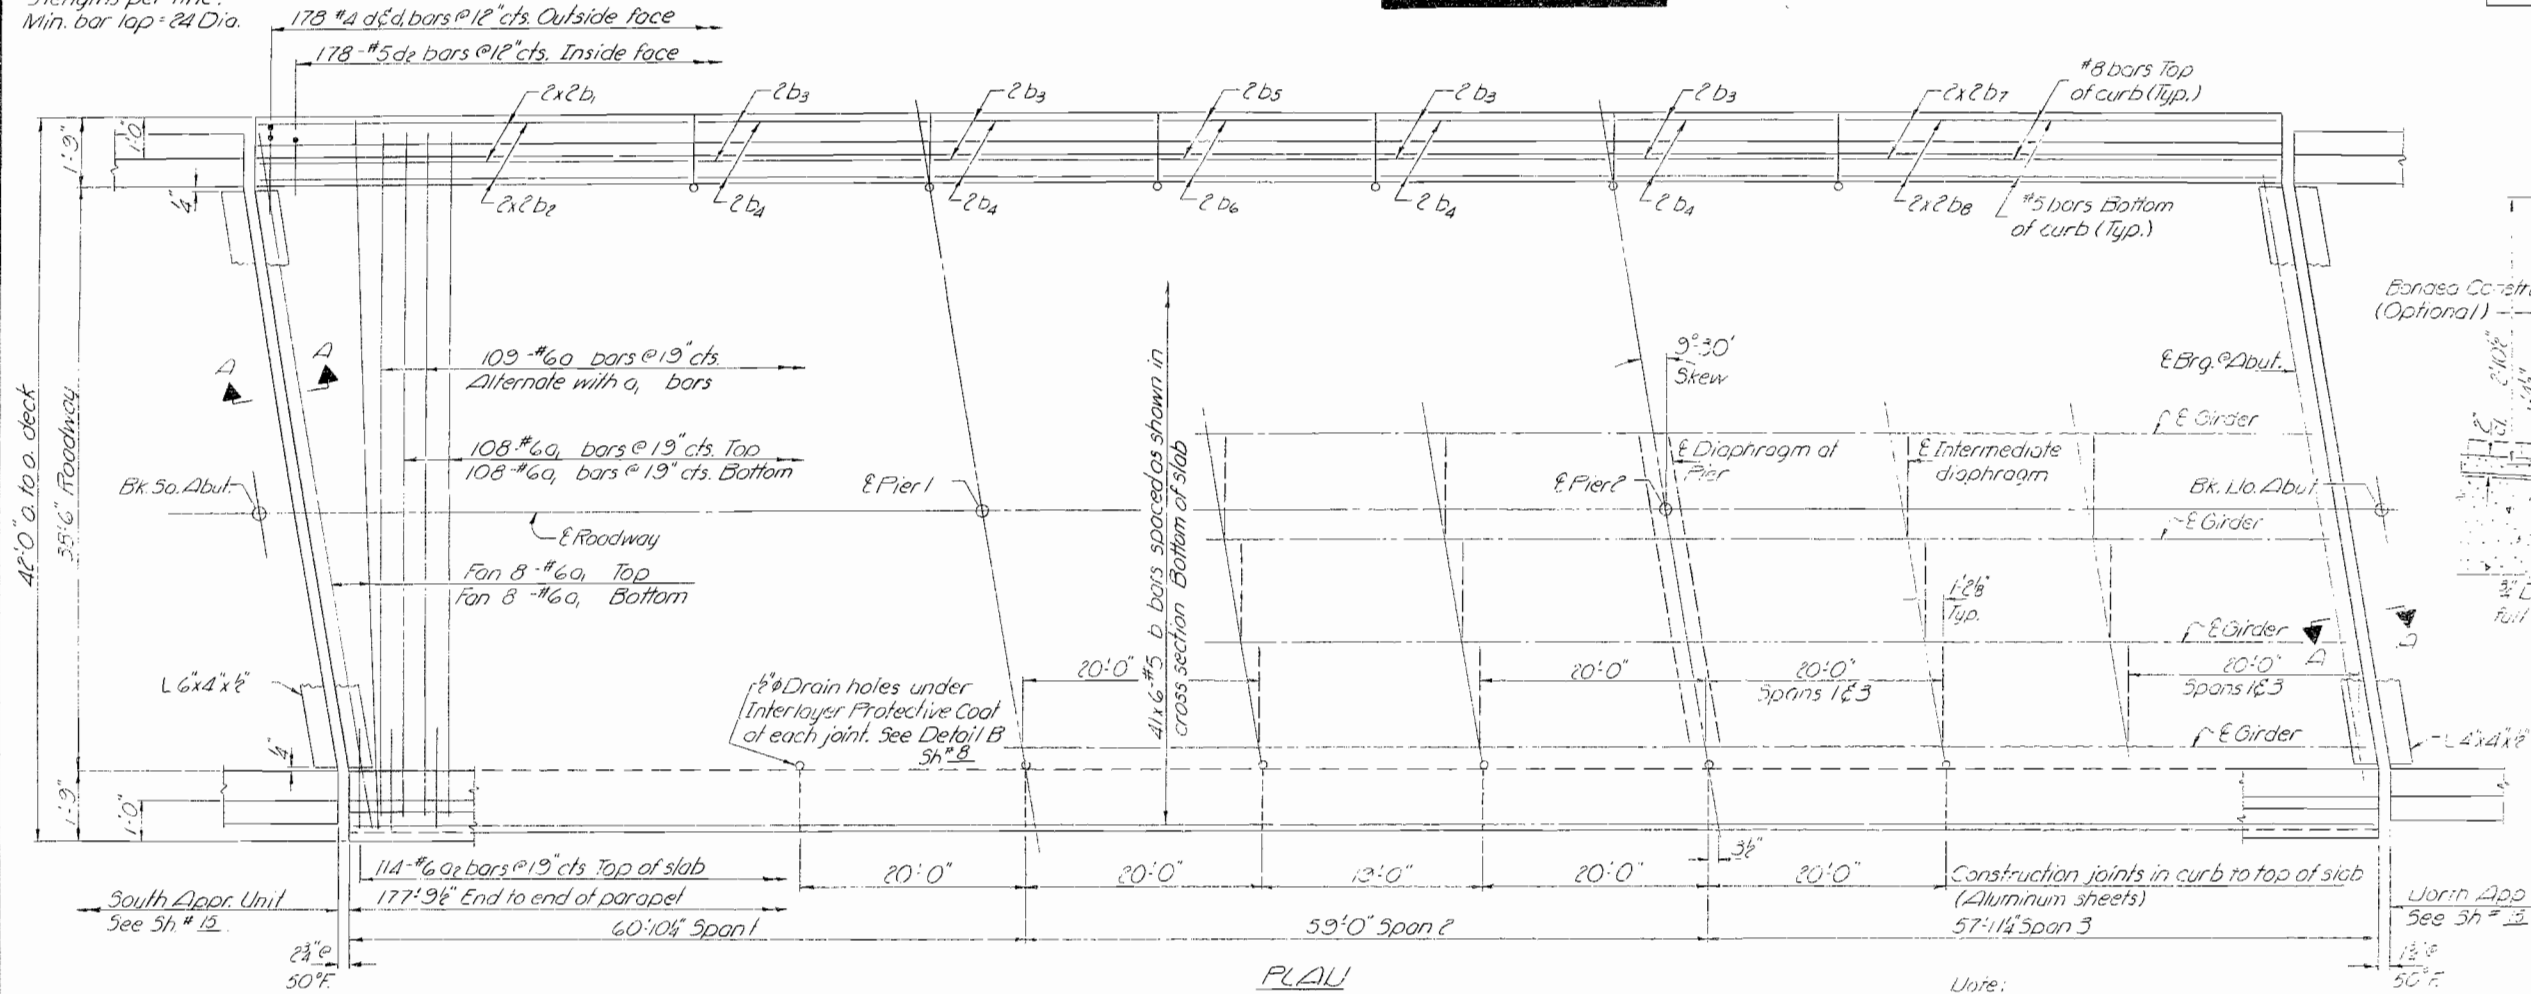

BAR LIST


Bar	No.	Size	Length	Splice
a	109	#6	41'-7"	---
a	245	#6	40'-0"	---
a	226	#6	4'-0"	---
b	246	#5	30'-3"	---
b	8	#6	21'-2"	---
b	8	#5	20'-11"	---
b	16	#5	19'-3"	---
b	16	#5	18'-2"	---
b	4	#5	15'-3"	---
b	4	#5	15'-3"	---
b	3	#6	12'-11"	---
b	8	#5	12'-2"	---
c	336	#4	3'-11"	---
c	356	#4	4'-0"	---
c	356	#5	3'-0"	---
v	16	#5	3'-0"	---

See Sheet #2 for longitudinal reinforcement in top of slab.  
For girder grouties see sheet #2.  
Reinforcement in concrete are placed on sheet #2.

SOUTH BD LANES SUPERSTRUCTURE BILL OF MATERIAL

Item	Unit	Quantity
Class I Concrete	Cu. Yds.	548.8
Reinforcement Bars	Lbs.	37770

SOUTH BD LANES SUPERSTRUCTURE  
P.L.I. RT. 55 SEC. 57-9HB  
MC LEAN COUNTY  
STA. 297+80.50


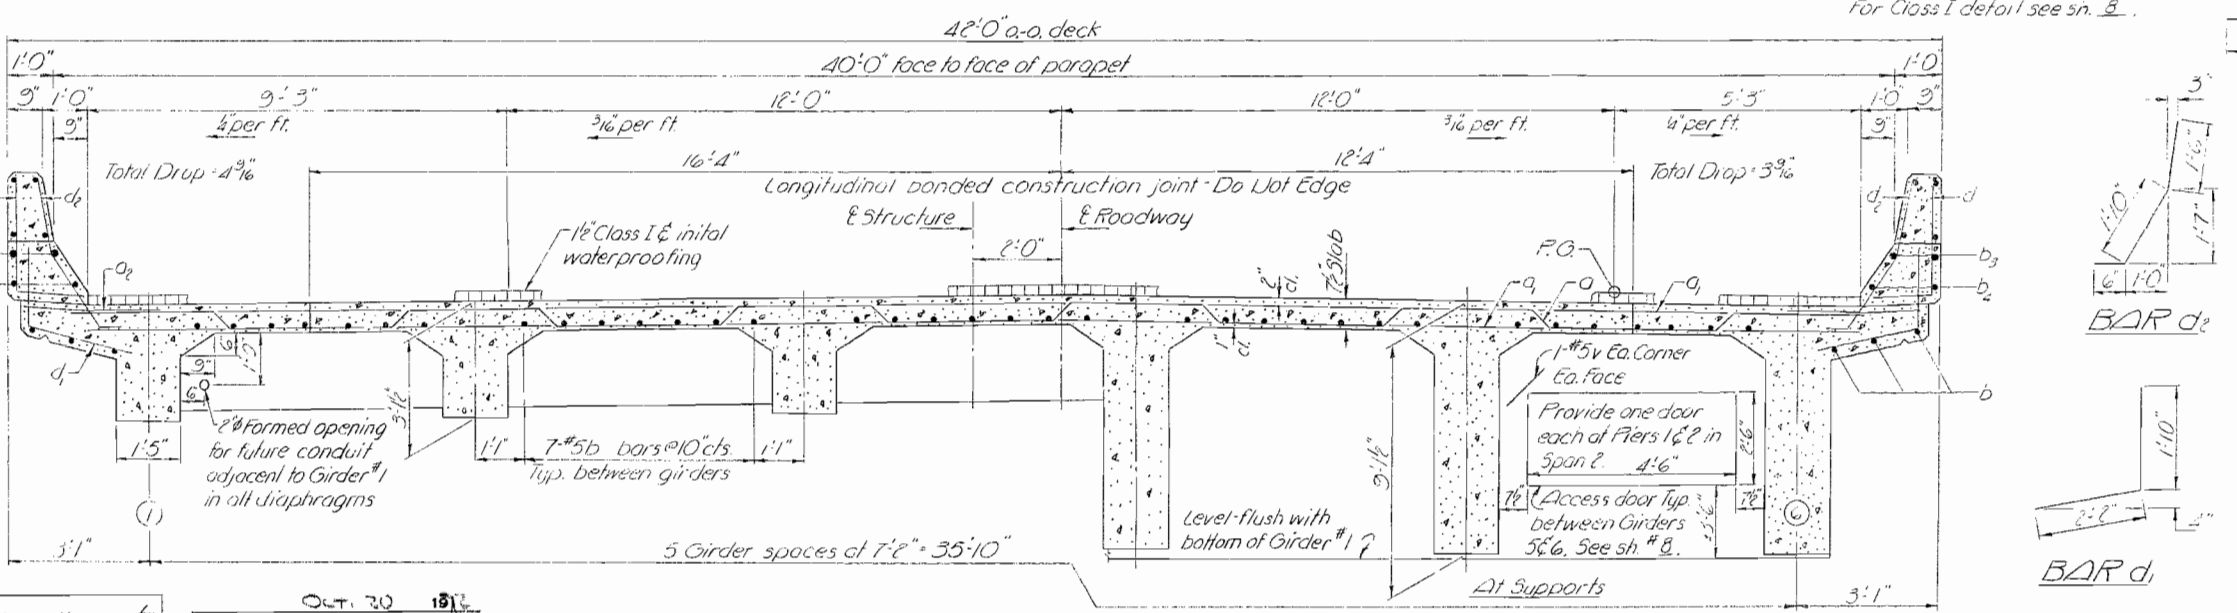


DESIGNED: J. J. Shoykhet  
CHECKED: J. J. Shoykhet  
DRAWN: J.D.  
CHECKED: J.D.

EXAMINED: [Signature]  
PASSED: [Signature]  
APPROVED: Richard A. Holtermann, Chief Highway Engineer

A1 & Span

CROSS SECTION (LOOKING NORTH)

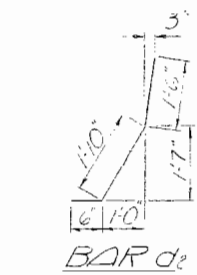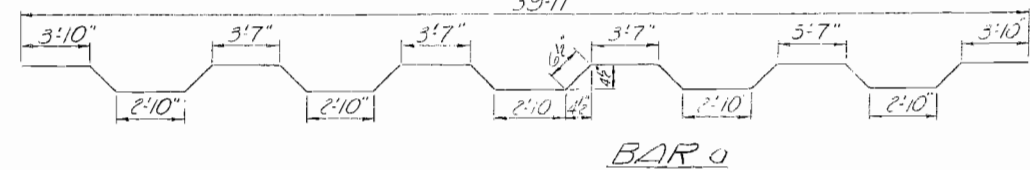










BAR a

BAR d



BAR c

STATE OF ILLINOIS  
DEPARTMENT OF TRANSPORTATION

ROUTE NO.	SECTION	COUNTY	TOTAL SHEETS	SHEET NO.	SHEET NO.
55	57-9HB	MC LEAN	93	29	58 SHEETS
FED. ROAD DIST. NO. 7		LAUNCH	FED. AID PROJECT		

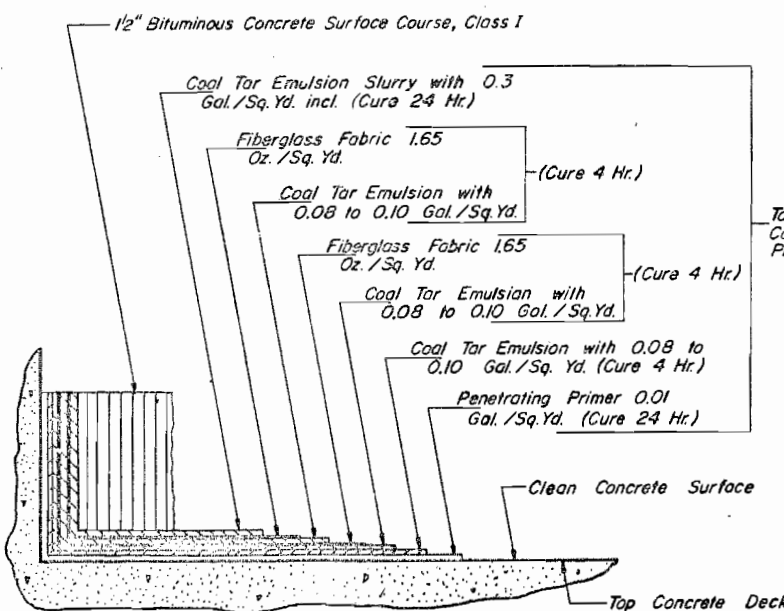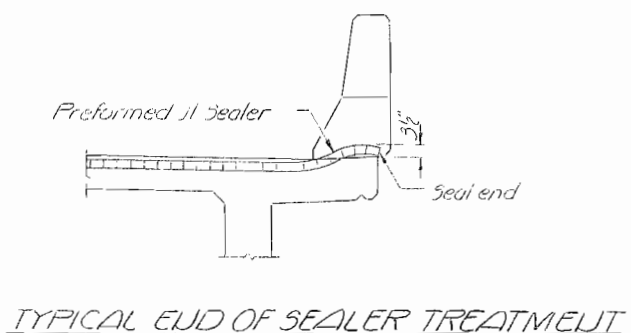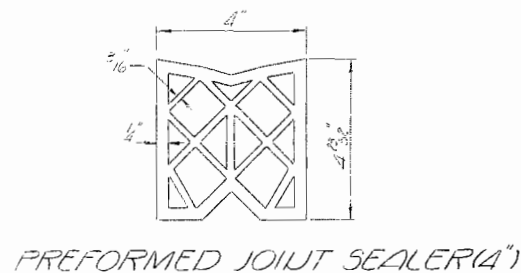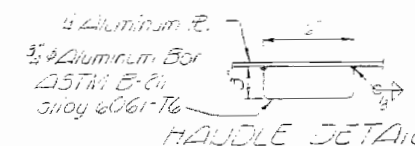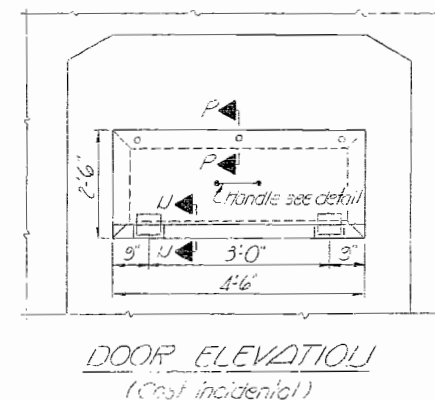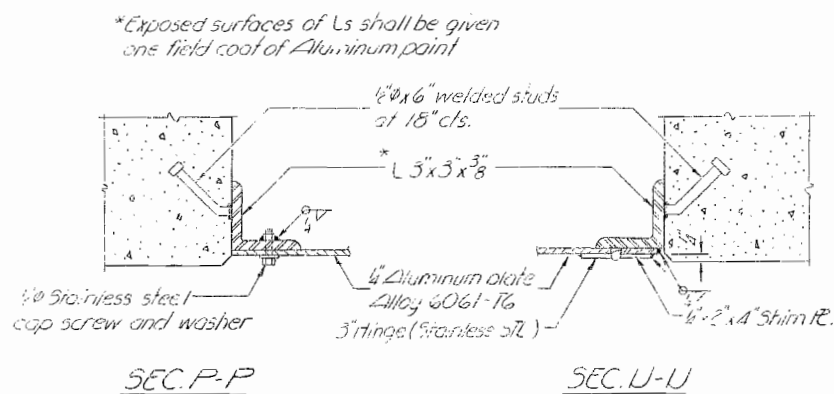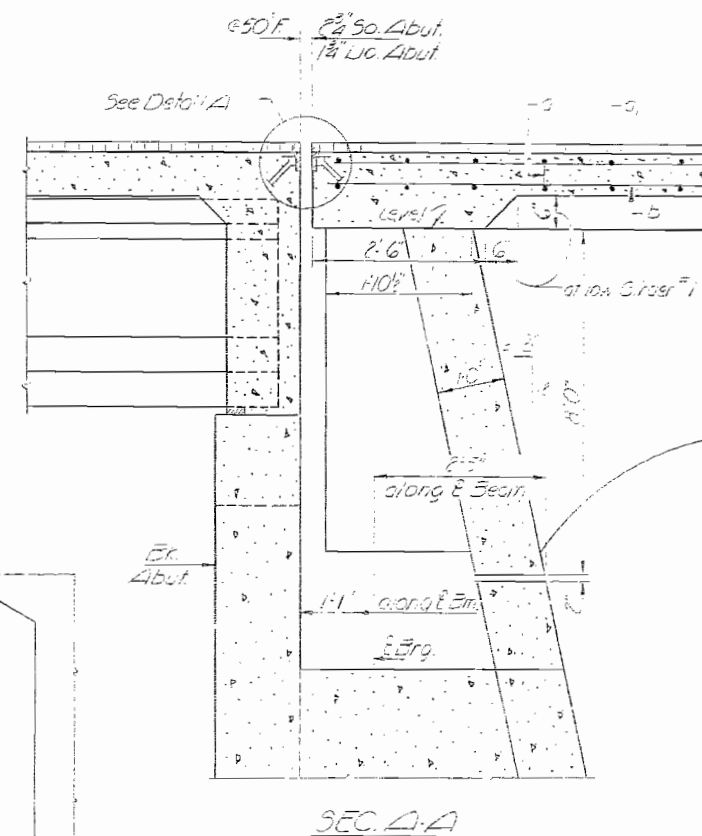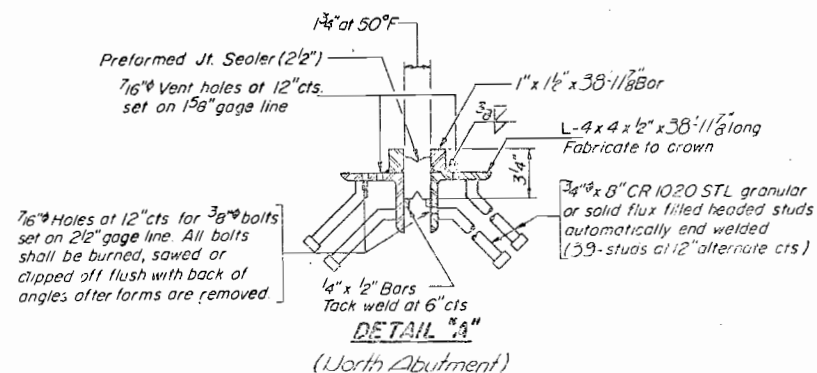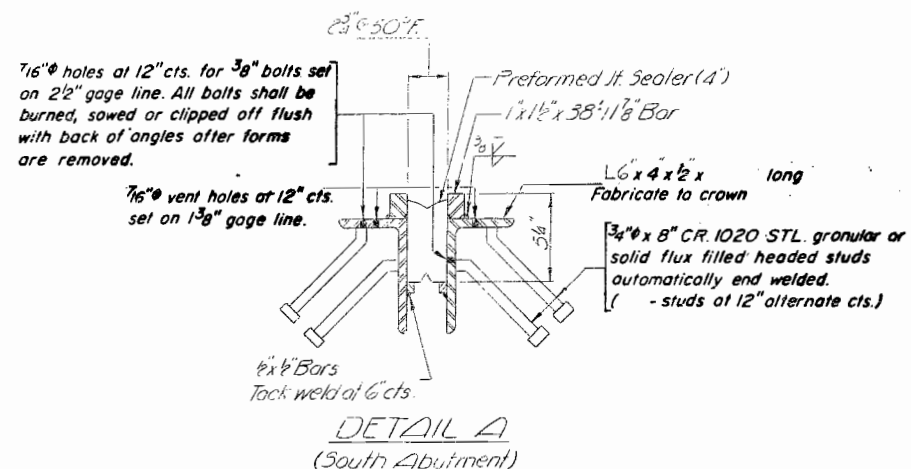

To be paid for as Coal Tar Interlayer Protective Coat.

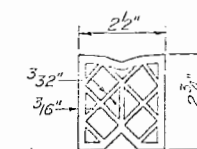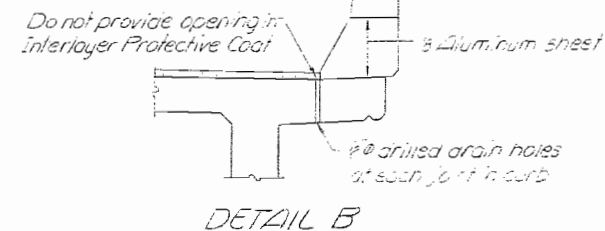


SOUTH BD. LAUES  
SUPERSTRUCTURE DETAILS  
FDR RT 55 SEC. 57-91B  
MC LEAN COUNTY  
S.D. 297+80.50

DESIGNED	17. Kharyyat	EXAMINED	20 19
CHECKED	10. 19	PASSED	10. 19
DRAWN	10. 19	APPROVED	10. 19
CHECKED	10. 19		

STATE OF ILLINOIS  
DEPARTMENT OF TRANSPORTATION

ROUTE NO.	SECTION	COUNTY	TOTAL SHEETS	SHEET NO.
55	57-9NB	MC LEAN	93	30
SHEET NO. 3				
58 SHEETS				


Note:  
Bars indicated thus 20x3#5 etc.  
indicates 20 lines of bars with 3  
lengths per line.  
Min. bar laps = 24 Dia.

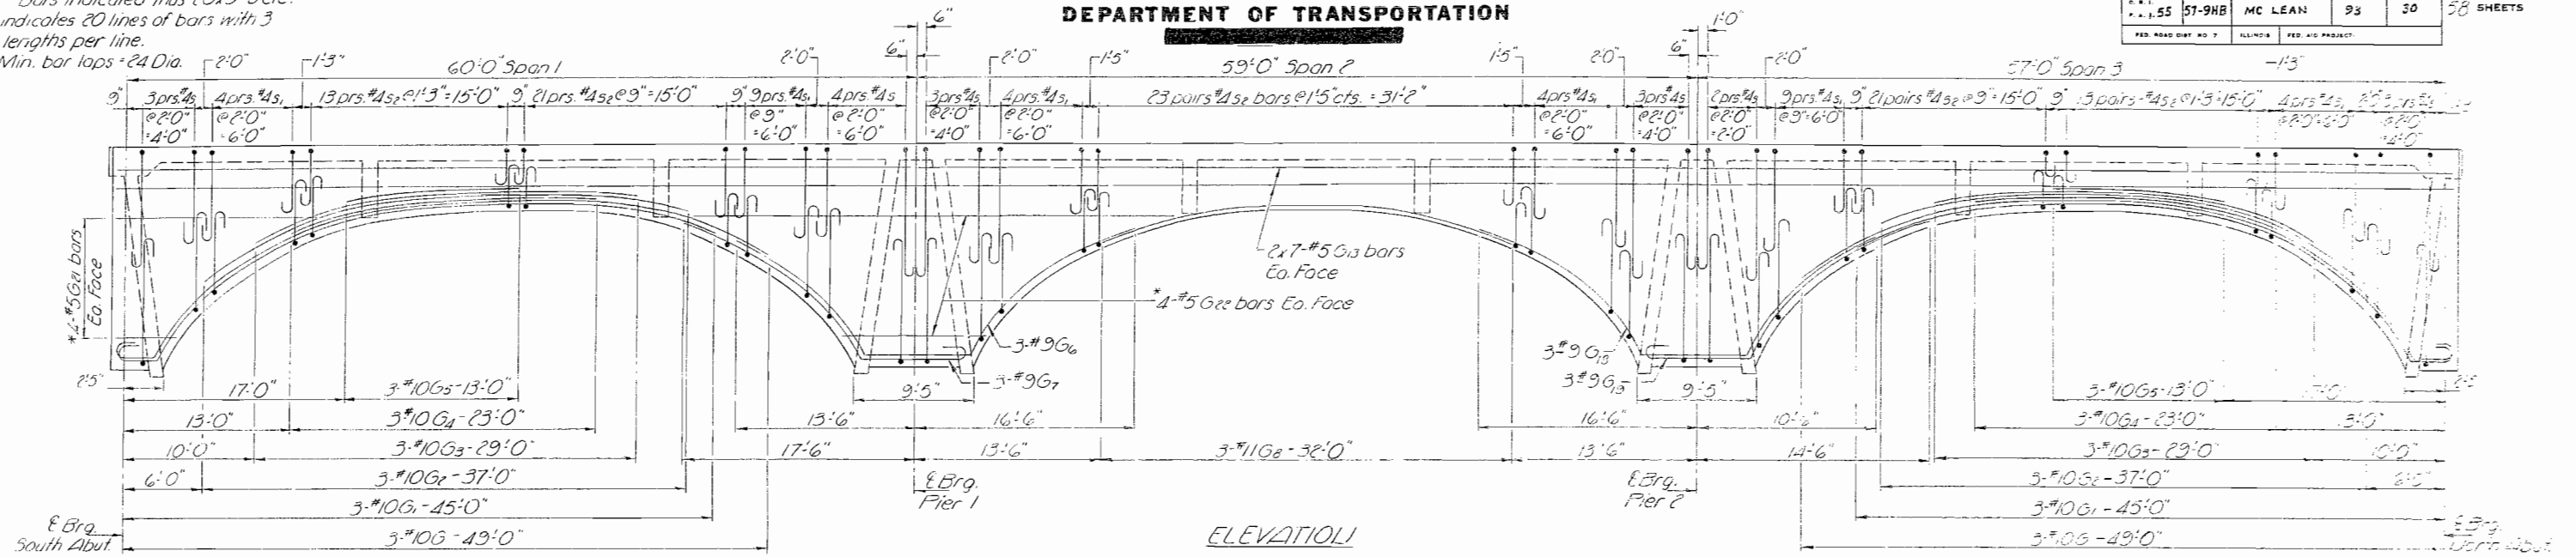

ELEVATION

\*Order G13 G22 bars full length. Cut to 10' and use the remainder of bars in similar locations of other supports.

Note:  
Lap G13 & G14 bar at E Span 2 thus → 8

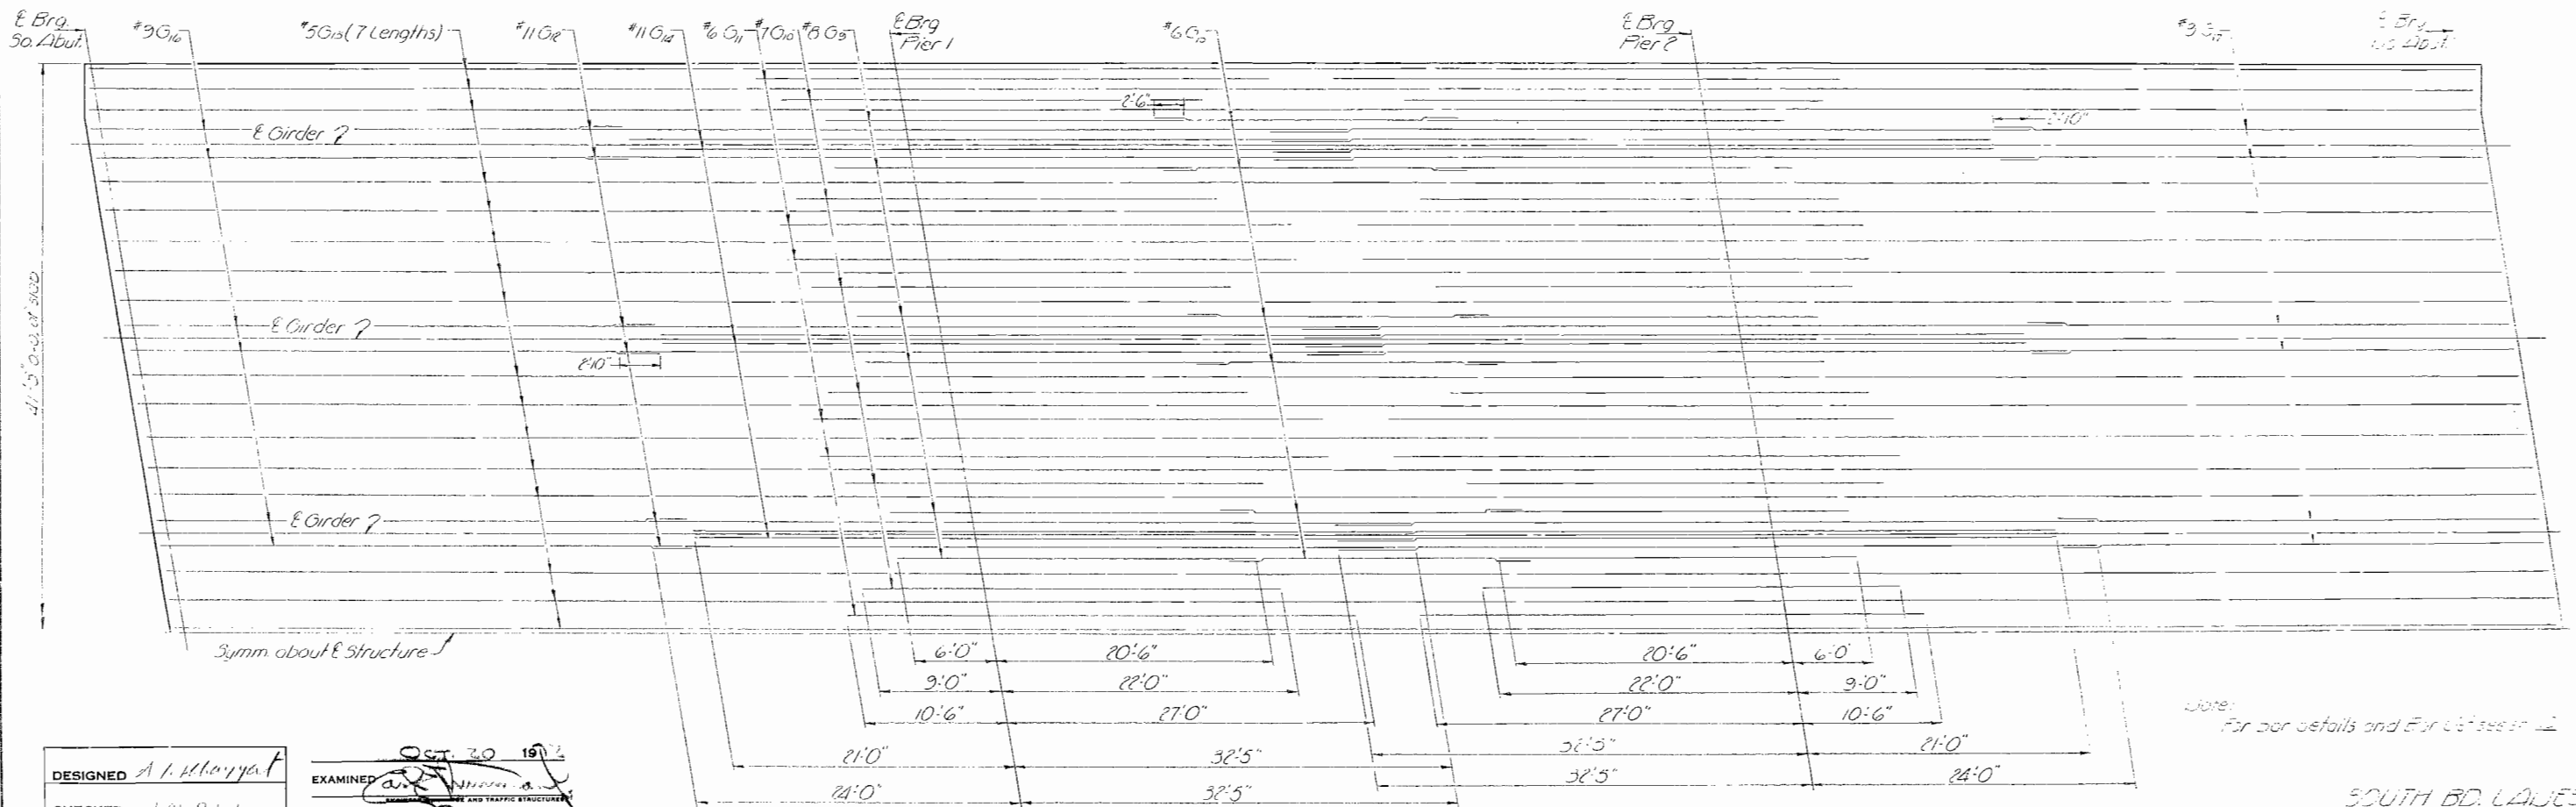

HALF PLAN  
Showing longitudinal reinforcement in top of slab.

DESIGNED	A. I. Alcharyat
CHECKED	J. M. P. J.
DRAWN	J. D.
CHECKED	J. M. P. J.


EXAMINED  
PASSED  
APPROVED  
Richard H. Hoeterman  
CHIEF HIGHWAY ENGINEER

Note:  
For bar details and Bar U's see p. 2

SOUTH BD. LANE  
GIRDER REINFORCEMENT  
P.L. RT. 55 SEC. 57-2-5  
MC LEAN COUNTY  
STA 297+80.50


STATE OF ILLINOIS  
DEPARTMENT OF TRANSPORTATION

ROUTE NO.	SECTION	COUNTY	TOTAL SHEETS	SHEET NO.
P. R. 1	57-9HB	MC LEAN	93	37
FED. ROAD DIST. NO. 7 ILLINOIS FED. AID PROJECT				

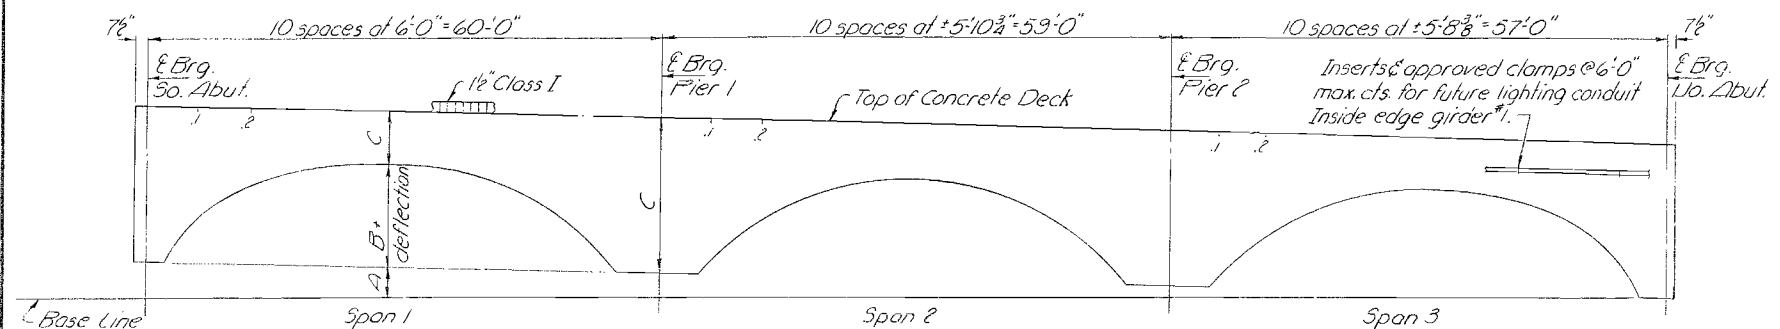

**BASE LINE ELEVATIONS**

Girder	6	5	4	3	2	1
Elevation	624.54	624.68	624.79	624.74	624.63	624.49

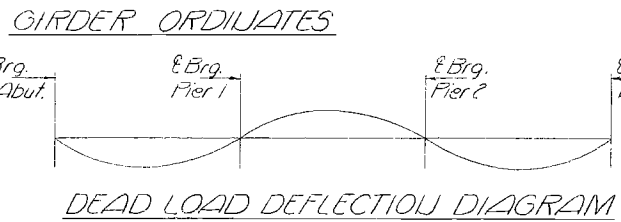



**DEAD LOAD DEFLECTION DIAGRAM**  
\* See Table below

**DIMENSION "D"**

G <sub>1</sub>	G <sub>2</sub>	G <sub>3</sub>	G <sub>4</sub>	G <sub>5</sub>	G <sub>6</sub>
8'-6"	8'-7 3/4"	8'-9"	8'-9 3/8"	8'-8 1/4"	8'-6 3/8"


**ALL GIRDERS - SOUTH BD. LANES**

Dimension	Span 1									Span 2									Span 3								
	1	2	3	4	5	6	7	8	9	1	2	3	4	5	6	7	8	9	1	2	3	4	5	6	7	8	9
A	11 1/8"	10 3/4"	10 3/8"	10"	9 3/8"	8 3/4"	8 1/2"	8 1/4"	7 3/4"	7"	6 3/8"	6 1/4"	5 3/8"	5 1/8"	4 3/4"	4 3/8"	4"	3 3/8"	3 1/4"	2 3/8"	2 1/4"	2 1/8"	1 3/4"	1 3/8"	1 1/4"	1 1/8"	1 1/4"
B + deflection	0"	2 1/4"	4 5/8"	5 7/8"	6 0 3/8"	5 11/8"	5 4"	5 3/8"	11 3/8"	0"	11 1/4"	3 1/4"	5 1/8"	5 11/8"	5 10 3/8"	5 4 1/8"	5 10 1/4"	11 1/4"	0"	10"	3 3/8"	5 3/8"	5 11"	6 0 3/8"	5 7 3/8"	4 5 3/8"	2 0 3/8"
C	9 1/8"	7 0 3/8"	4 8 3/8"	3 6 3/8"	3 2 3/8"	3 1 1/8"	3 10 3/8"	5 4"	8 2 3/8"	9 1/8"	8 2 3/8"	5 3 3/8"	3 9 3/8"	3 2 3/8"	3 9 3/8"	3 9 3/8"	5 3 3/8"	8 2 3/8"	9 1/8"	8 3 3/8"	5 4 3/8"	3 10 3/8"	3 3 3/8"	3 1 1/8"	3 6 3/8"	4 8 3/8"	7 1 1/4"
Total	10 0 3/8"	10 0 3/8"	10 0 3/8"	10 0 3/8"	9 11 3/8"	9 1 1/8"	9 11 3/8"	9 10 3/8"	9 10 3/8"	9 10 3/8"	9 8 3/8"	9 8 3/8"	9 7 3/8"	9 6 3/8"	9 6 3/8"	9 5 3/8"	9 5 3/8"	9 5 3/8"	9 4 3/8"	9 4 3/8"	9 4 3/8"	9 4 3/8"	9 3 3/8"	9 3 3/8"	9 2 3/8"	9 2 3/8"	9 1 3/8"
Deflection	0	1/4"	1/2"	3/8"	3/4"	3/2"	5/8"	1"	3/8"	0	-1/8"	-1/4"	-3/8"	-3/8"	-3/8"	-1/2"	-1/8"	0	1/8"	1/4"	3/8"	1/2"	5/8"	3/4"	1"	1/2"	

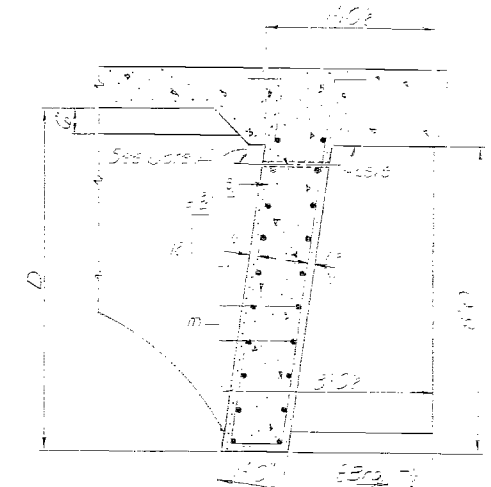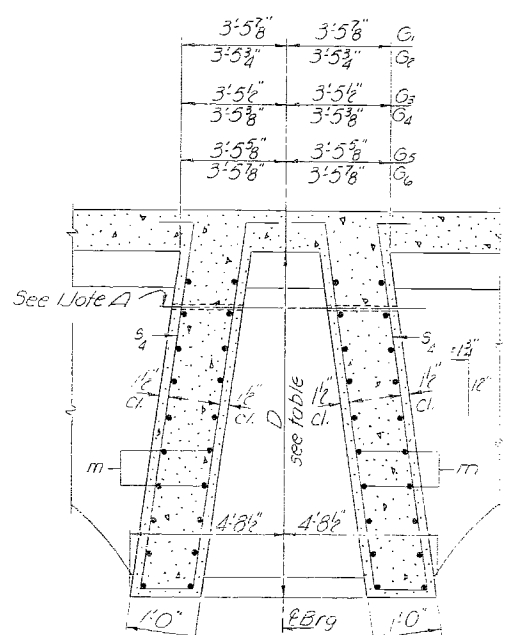


**SECTION THRU DIAPHRAGMS AT PIERS**

**SECTION THRU DIAPHRAGMS AT ABUTMENTS**

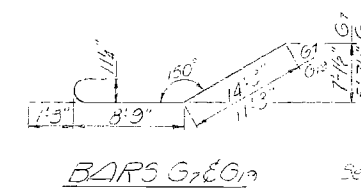

**BARS G7 & G8**

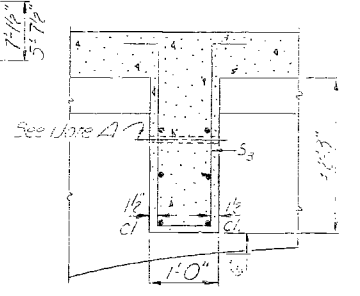


**SECTION THRU INTERIOR DIAPHRAGMS**


**SIX GIRDERS BAR LIST FOR GIRDERS**

Bar	No.	Size	Start	End
G <sub>1</sub>	36	#10	0	5
G <sub>2</sub>	36	#10	0	5
G <sub>3</sub>	36	#10	0	5
G <sub>4</sub>	36	#10	0	5
G <sub>5</sub>	36	#10	0	5
G <sub>6</sub>	36	#10	0	5
G <sub>7</sub>	12	#8	0	5
G <sub>8</sub>	12	#8	0	5
G <sub>9</sub>	24	#7	0	5
G <sub>10</sub>	24	#6	0	5
G <sub>11</sub>	24	#11	0	5
G <sub>12</sub>	355	#5	0	5
G <sub>13</sub>	32	#11	0	5
G <sub>14</sub>	12	#8	0	5
G <sub>15</sub>	12	#8	0	5
G <sub>16</sub>	12	#8	0	5
G <sub>100</sub>	12	#8	0	5

\*\* Quantity included in Bill of Materials in sh. 7.

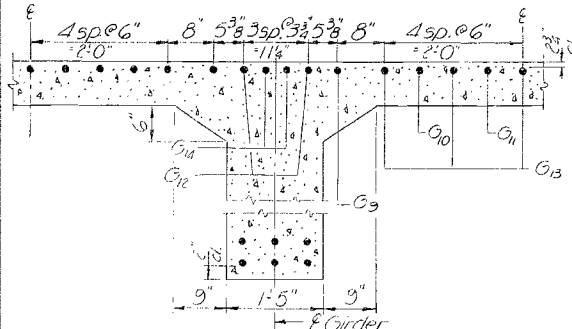


**SEC. THRU GIRDER AT PIERS**

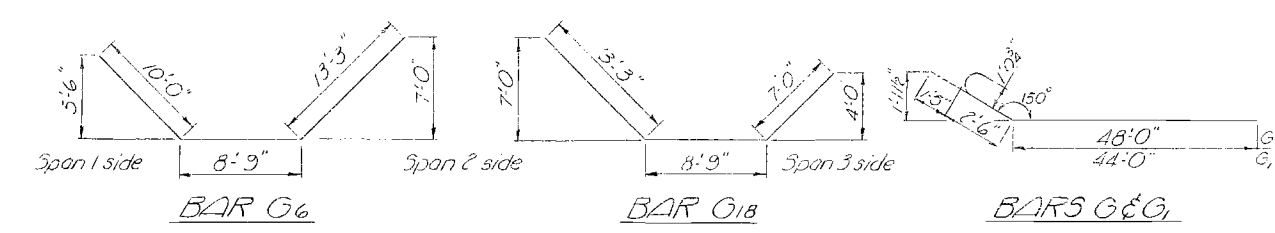

**BAR G6**

**BAR G18**


**BARS G6 & G1**

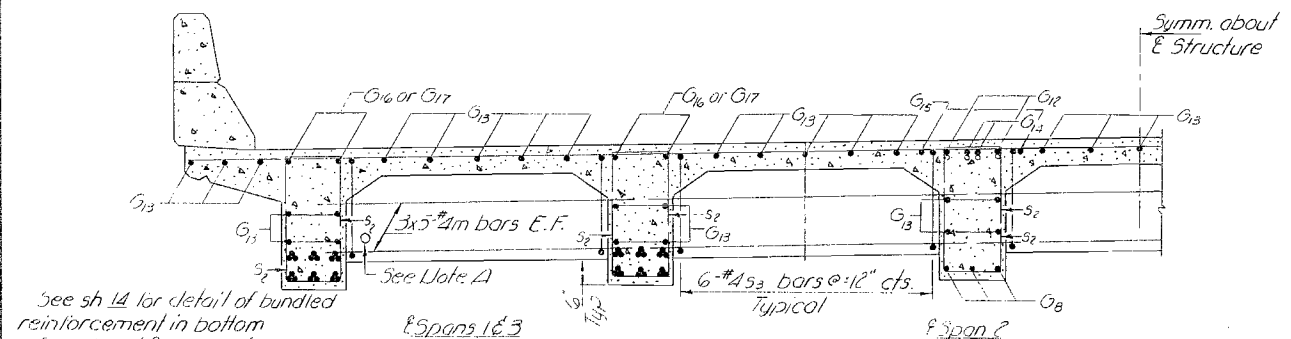

**HALF SECTION AT SPANS**

DESIGNED	A. I. Khayyat
CHECKED	J. M. Miller
DRAWN	J. D.
CHECKED	L. M. B.


EXAMINED	10/11/1972
PASSED	Richard H. Hollersma
APPROVED	Richard H. Hollersma

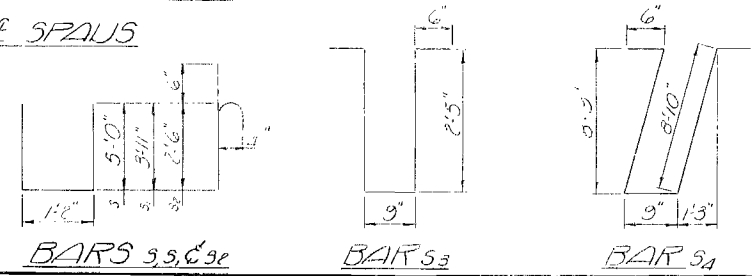

**BARS G5, G3e**

**BAR G53**

**BAR G54**

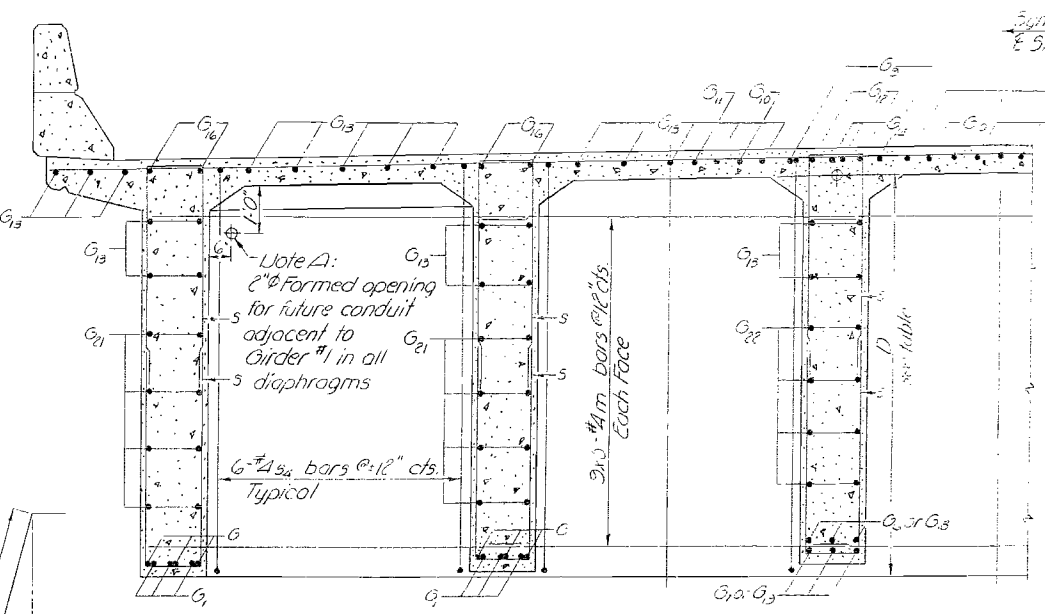

**At Abutments**

**At Piers**

**HALF SECTION AT SUPPORTS**


**SOUTH BD. LANES GIRDER REINFORCEMENT**  
P. R. RT. 55 SEC. 57-9HB  
MC LEAN COUNTY  
STA. 237+80.50

STATE OF ILLINOIS  
DEPARTMENT OF TRANSPORTATION

ROUTE NO.	SECTION	COUNTY	TOTAL SHEETS	SHEET NO.
55	57-94B	MC LEAN	93	32
ILLINOIS		SHEET NO. 11		
FED. ROAD DIST. NO. 7		58 SHEETS		

Note:

Bars indicated thus 20x3 #5 etc indicates 20 lines of bars with 3 lengths per line.  
Min. bar laps = 24 Dia.

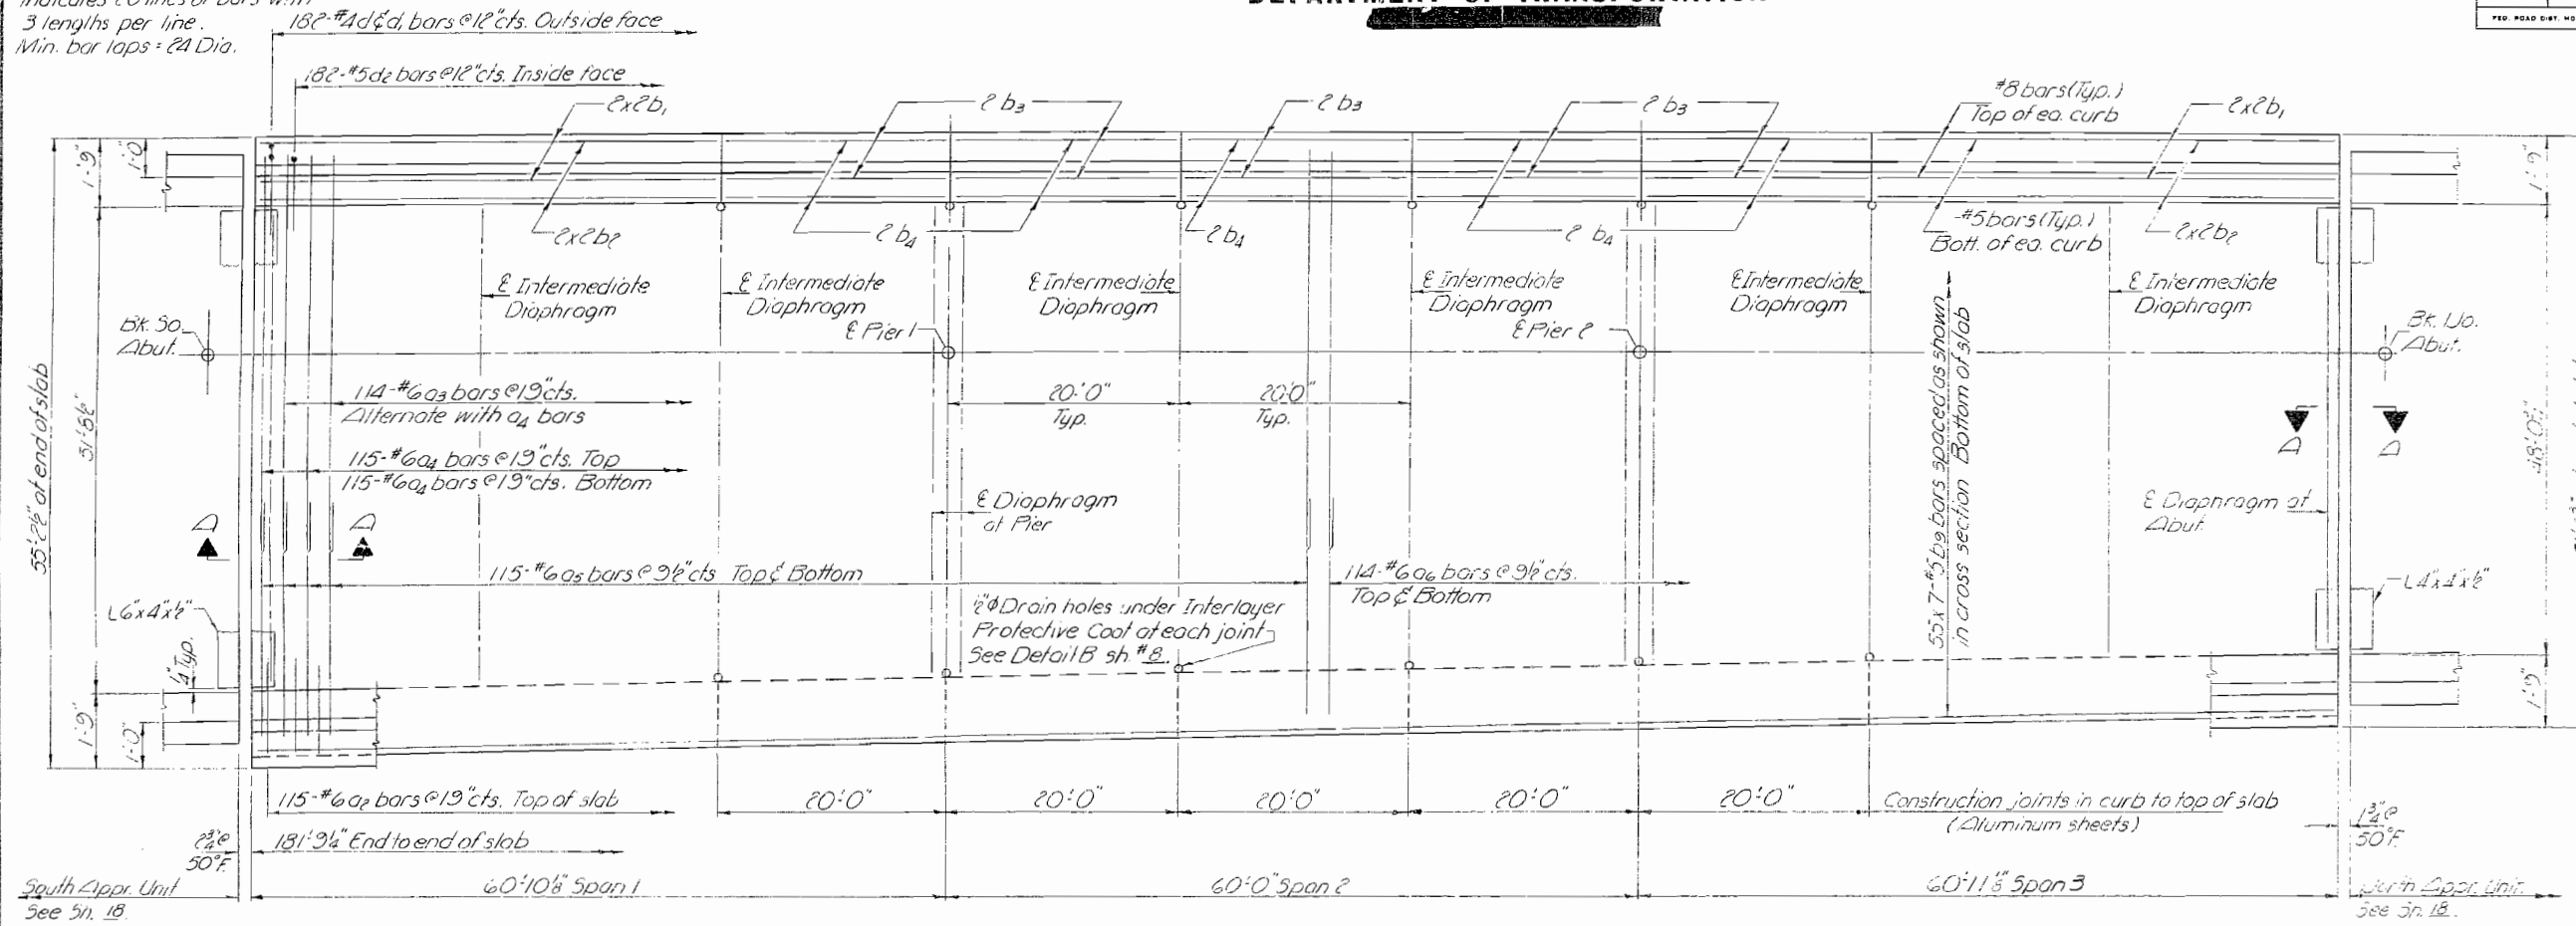

Note:  
For curb section see sh. 1.  
For Sec. A-A see sh. 14.  
For Class I detail see sh. 6.  
Parapet reinf. and Class X Conc. are billed on sh. 8.

BAR LIST


Bar	No.	Size	Length	Notes
a	230	#6	4'-0"	
b	114	#6	20'-0"	
c	230	#6	38'-4"	
d	230	#6	17'-4"	
e	228	#6	15'-6"	
f	16	#8	3'-4"	
g	16	#8	20'-0"	
h	20	#8	13'-9"	
i	20	#8	13'-9"	
j	385	#5	27'-0"	
k	364	#4	3'-11"	
l	364	#4	4'-0"	
m	364	#5	3'-11"	
n	16	#5	3'-0"	

See Sheet #13 for longitudinal reinforcement in top of slab.  
For girder ordinates see sh. 1.

NORTH BD LANES SUPERSTRUCTURE BILL OF MATERIAL

Item	Unit	Quantity
Class X Concrete	Cu. Yds.	73.7
Reinforcement Bars	Lbs.	1762.0


NORTH BD LANES SUPERSTRUCTURE  
FAI RT. 55 SEC 57-94B  
MC LEAN COUNTY  
STA. 297+80.50

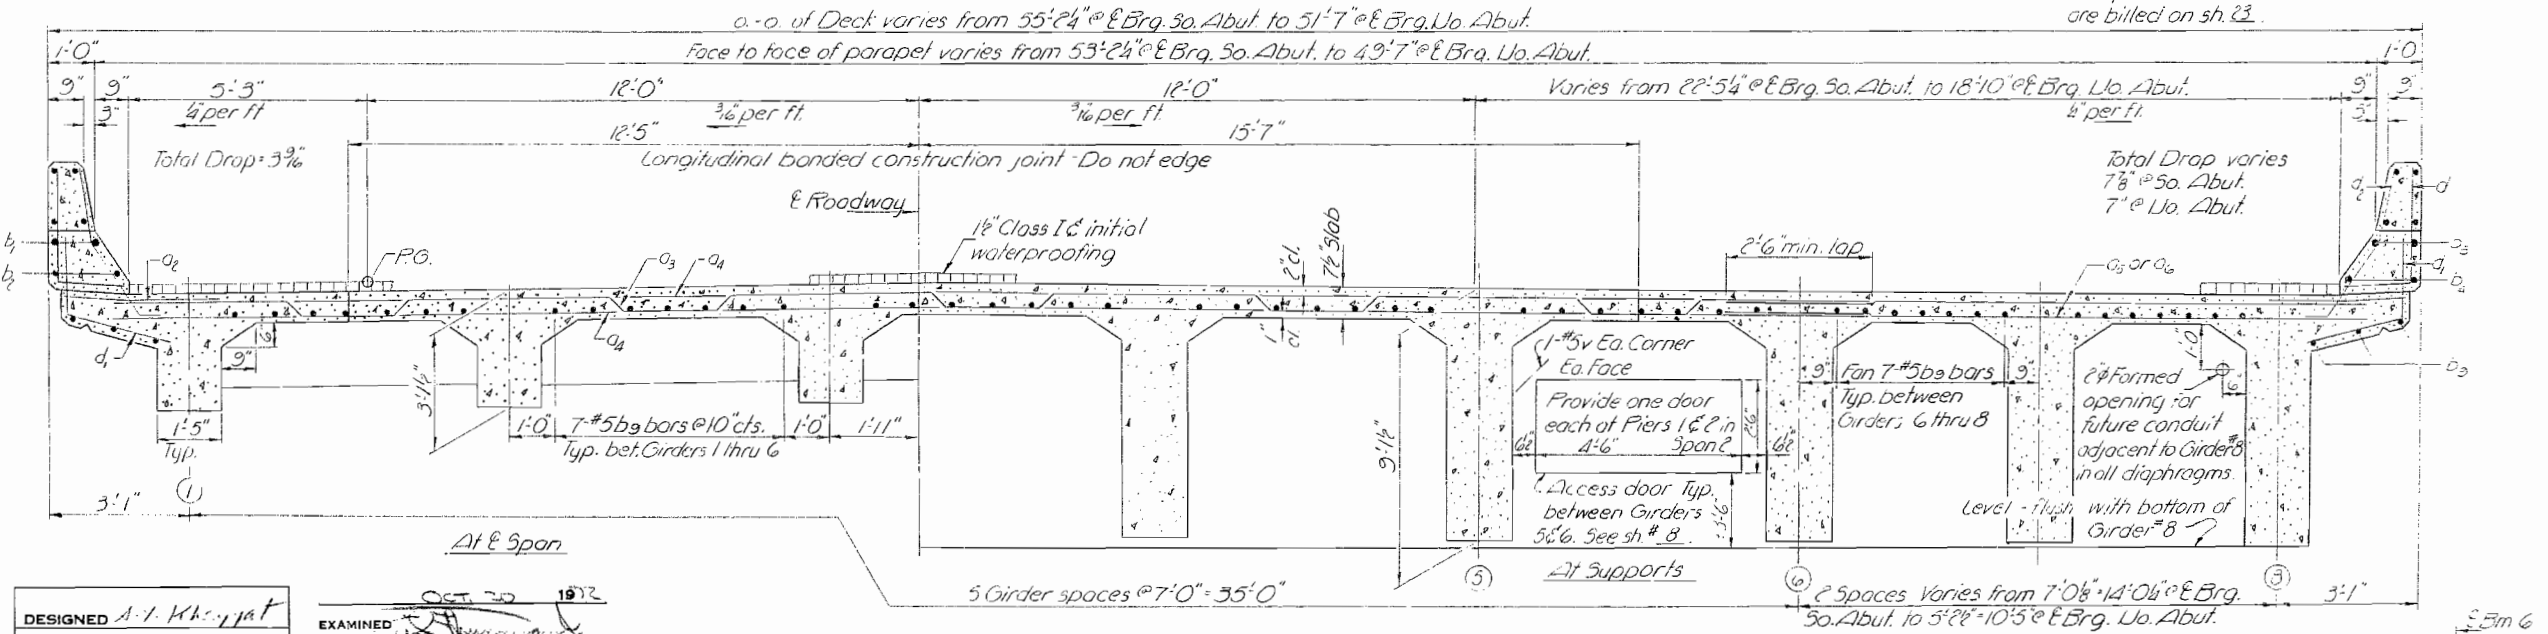

DESIGNED A. I. K...  
CHECKED J. D. ...  
DRAWN J. D. ...  
CHECKED J. D. ...

OCT 20 1972  
EXAMINED ...  
PASSED ...  
APPROVED ...

CROSS SECTION (LOOKING NORTH)

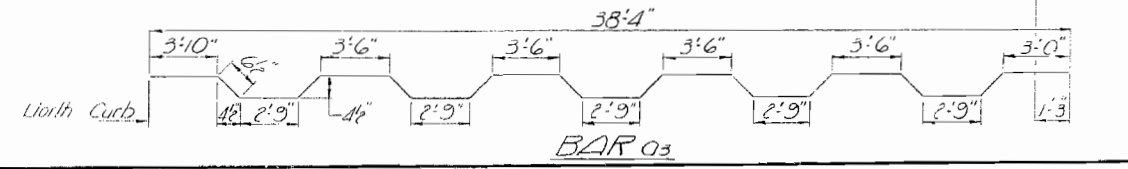


BAR o3



STATE OF ILLINOIS  
DEPARTMENT OF TRANSPORTATION


ROUTE NO.	SECTION	COUNTY	TOTAL SHEETS	SHEET NO.
155	57-9HB	MC LEAN	93	33
FED. ROAD DIST. NO. 7		ILLINOIS	FED. AID PROJECT	

58 SHEETS

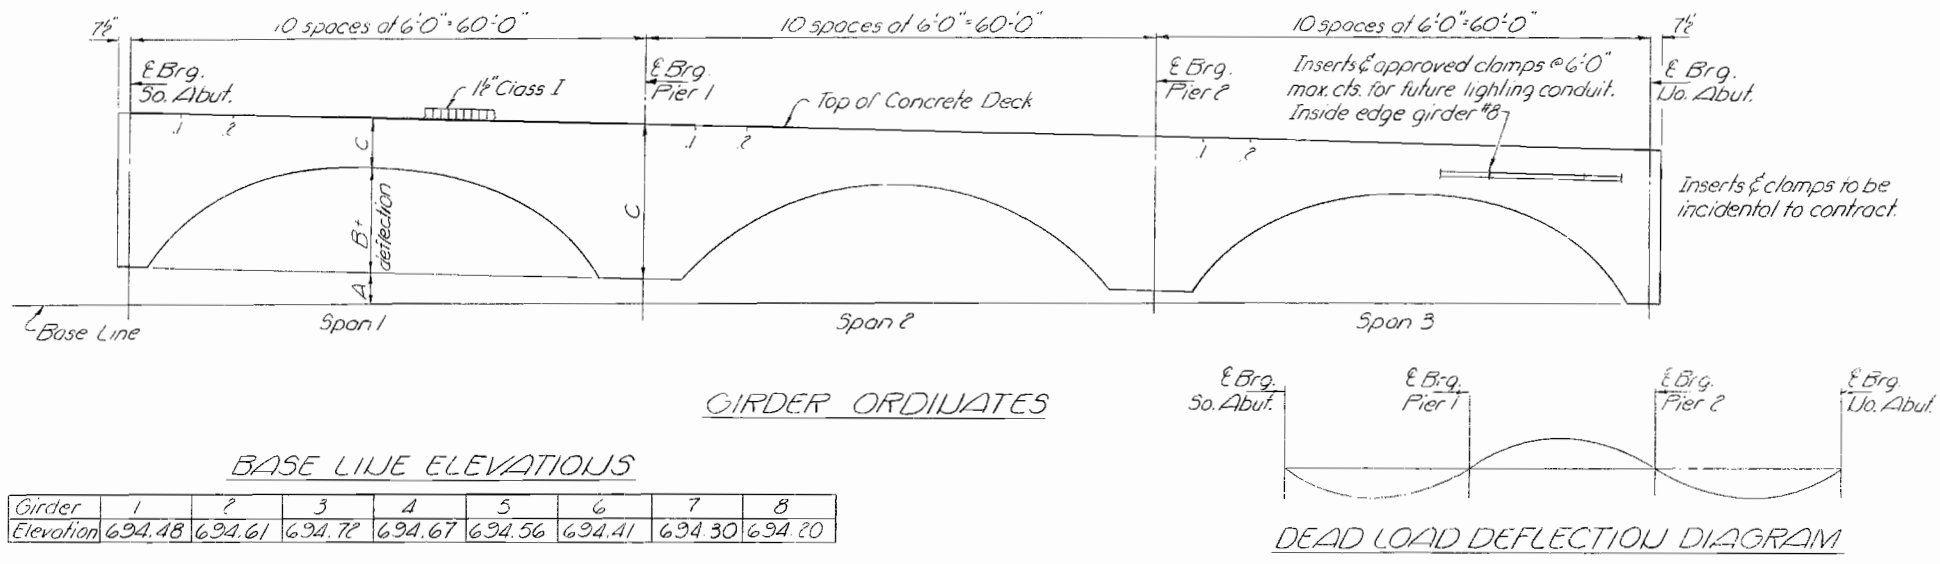

BASE LINE ELEVATIONS

Girder	1	2	3	4	5	6	7	8
Elevation	694.48	694.61	694.72	694.67	694.56	694.41	694.30	694.20

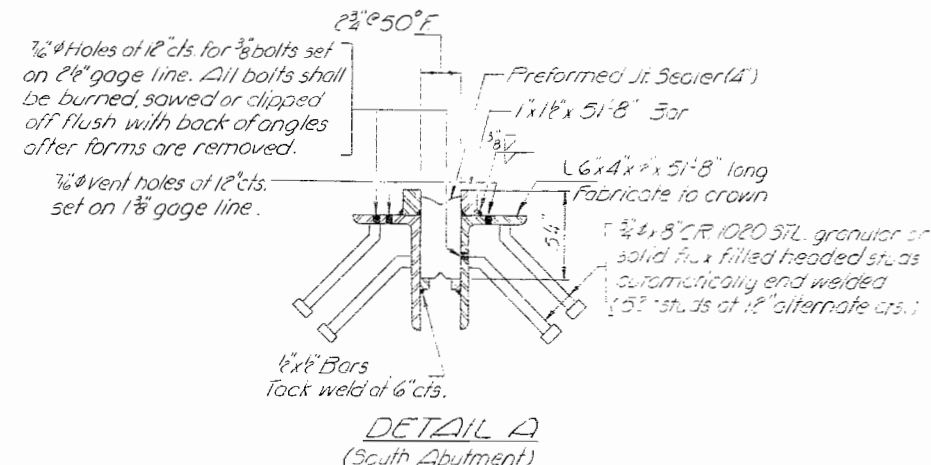

GIRDERS 1 THRU 5

Dimension	Span 1									Span 2									Span 3												
	Abut.	1	2	3	4	5	6	7	8	9	Pier 1	1	2	3	4	5	6	7	8	9	Pier 2	1	2	3	4	5	6	7	8	9	Abut.
A	11 1/8	11	10 3/8	10 1/4	9 7/8	9 1/2	8 7/8	8 1/2	8	7 3/4	7 1/2	7 1/4	6 7/8	6 1/2	6 1/8	5 3/4	5 1/2	5	4 3/4	4 1/2	3 3/4	3 3/8	3 1/4	3	2 3/4	2 1/2	2 1/8	1 3/4	1 1/2	0	
B-deflection	0	2 1/4	4 5/8	5 7/8	6 0 1/4	6 0 3/4	5 11/4	5 4	3 9/8	1 1/8	0	1 1/8	3 10/8	5 4/8	5 10/8	5 11/4	5 10/8	5 4/8	3 10/8	1 1/8	0	1 1/8	3 9/8	5 4	5 11/4	6 0 3/4	6 0 1/4	5 7/8	4 5/8	2 1/4	0
C	9 1/8	7 0 1/8	4 8 1/8	3 6 3/8	3 2	3 1 1/8	3 2 1/8	3 10	5 4	8 2	9 1/8	8 1/8	5 2 1/8	3 9	3 2 1/8	3 1 1/8	3 2 1/8	3 9	5 2 1/8	8 1/8	9 1/8	8 2	5 4	3 10	3 2 1/8	3 1 1/8	3 2	3 6 3/8	4 8 1/8	7 0 1/8	9 1/8
Total	10 0	10 0 3/8	10 0 3/8	10 0 3/8	10 0 3/8	9 11 1/8	9 11 1/8	9 10 1/8	9 10 1/8	9 9 3/8	9 9 3/8	9 8 3/8	9 8 3/8	9 7 3/8	9 7 3/8	9 6 3/8	9 6 3/8	9 5 3/8	9 5 3/8	9 5 3/8	9 5 3/8	9 4 3/8	9 4 3/8	9 4 3/8	9 4 3/8	9 4 3/8	9 3 3/8	9 3 3/8	9 2 3/8	9 2 3/8	9 1 3/8

GIRDER 6

Dimension	Span 1									Span 2									Span 3												
	Abut.	1	2	3	4	5	6	7	8	9	Pier 1	1	2	3	4	5	6	7	8	9	Pier 2	1	2	3	4	5	6	7	8	9	Abut.
A	11 1/8	11 1/8	10 3/8	10 1/4	10	9 5/8	9 1/4	8 7/8	8 1/2	8 1/8	7 3/4	7 1/4	6 7/8	6 1/2	6 1/8	5 3/4	5 1/2	5	4 3/4	4 1/2	3 3/4	3 3/8	3 1/4	3	2 3/4	2 1/2	2 1/8	1 3/4	1 1/2	0	
B-deflection	0	2 1/4	4 5/8	5 7/8	6 0 1/4	6 0 3/4	5 11/4	5 4	3 9/8	1 1/8	0	1 1/8	3 10/8	5 4/8	5 10/8	5 11/4	5 10/8	5 4/8	3 10/8	1 1/8	0	1 1/8	3 9/8	5 4	5 11/4	6 0 3/4	6 0 1/4	5 7/8	4 5/8	2 1/4	0
C	9 1/8	7 0 1/8	4 8 1/8	3 6 3/8	3 2	3 1 1/8	3 2 1/8	3 10	5 4	8 2	9 1/8	8 1/8	5 2 1/8	3 9	3 2 1/8	3 1 1/8	3 2 1/8	3 9	5 2 1/8	8 1/8	9 1/8	8 2	5 4	3 10	3 2 1/8	3 1 1/8	3 2	3 6 3/8	4 8 1/8	7 0 1/8	9 1/8
Total	10 0	10 0 3/8	10 0 3/8	10 0 3/8	10 0 3/8	9 11 1/8	9 11 1/8	9 10 1/8	9 10 1/8	9 9 3/8	9 9 3/8	9 8 3/8	9 8 3/8	9 7 3/8	9 7 3/8	9 6 3/8	9 6 3/8	9 5 3/8	9 5 3/8	9 5 3/8	9 5 3/8	9 4 3/8	9 4 3/8	9 4 3/8	9 4 3/8	9 4 3/8	9 3 3/8	9 3 3/8	9 2 3/8	9 2 3/8	9 1 3/8

GIRDER 7



Dimension	Span 1									Span 2									Span 3												
	Abut.	1	2	3	4	5	6	7	8	9	Pier 1	1	2	3	4	5	6	7	8	9	Pier 2	1	2	3	4	5	6	7	8	9	Abut.
A	10 1/2	10 3/8	10 1/4	9 7/8	9 1/2	8 7/8	8 1/2	8	7 3/4	7 1/4	7	6 7/8	6 1/2	6 1/8	5 3/4	5 1/2	5	4 3/4	4 1/2	4	3 3/4	3 3/8	3 1/4	3	2 3/4	2 1/2	2 1/8	1 3/4	1 1/2	0	
B-deflection	0	2 1/4	4 5/8	5 7/8	6 0 1/4	6 0 3/4	5 11/4	5 4	3 9/8	1 1/8	0	1 1/8	3 10/8	5 4/8	5 10/8	5 11/4	5 10/8	5 4/8	3 10/8	1 1/8	0	1 1/8	3 9/8	5 4	5 11/4	6 0 3/4	6 0 1/4	5 7/8	4 5/8	2 1/4	0
C	9 1/8	7 0 1/8	4 8 1/8	3 6 3/8	3 2	3 1 1/8	3 2 1/8	3 10	5 4	8 2	9 1/8	8 1/8	5 2 1/8	3 9	3 2 1/8	3 1 1/8	3 2 1/8	3 9	5 2 1/8	8 1/8	9 1/8	8 2	5 4	3 10	3 2 1/8	3 1 1/8	3 2	3 6 3/8	4 8 1/8	7 0 1/8	9 1/8
Total	10 0	10 0 3/8	10 0 3/8	10 0 3/8	10 0 3/8	9 11 1/8	9 11 1/8	9 10 1/8	9 10 1/8	9 9 3/8	9 9 3/8	9 8 3/8	9 8 3/8	9 7 3/8	9 7 3/8	9 6 3/8	9 6 3/8	9 5 3/8	9 5 3/8	9 5 3/8	9 5 3/8	9 4 3/8	9 4 3/8	9 4 3/8	9 4 3/8	9 4 3/8	9 3 3/8	9 3 3/8	9 2 3/8	9 2 3/8	9 1 3/8

GIRDER 8

Dimension	Span 1									Span 2									Span 3												
	Abut.	1	2	3	4	5	6	7	8	9	Pier 1	1	2	3	4	5	6	7	8	9	Pier 2	1	2	3	4	5	6	7	8	9	Abut.
A	10 1/2	10 1/8	9 3/4	9 3/8	9	8 3/4	8 3/8	8	7 3/4	7 1/4	7	6 3/8	6 1/4	5 7/8	5 3/4	5 1/2	5 1/4	4 3/4	4 1/2	4 1/8	3 3/4	3 3/8	3 1/4	3 3/8	3 1/2	3 1/8	3 1/4	3 1/8	3 3/8	3 1/4	0
B-deflection	0	2 1/4	4 5/8	5 7/8	6 0 1/4	6 0 3/4	5 11/4	5 4	3 9/8	1 1/8	0	1 1/8	3 10/8	5 4/8	5 10/8	5 11/4	5 10/8	5 4/8	3 10/8	1 1/8	0	1 1/8	3 9/8	5 4	5 11/4	6 0 3/4	6 0 1/4	5 7/8	4 5/8	2 1/4	0
C	9 1/8	7 0 1/8	4 8 1/8	3 6 3/8	3 2	3 1 1/8	3 2 1/8	3 10	5 4	8 2	9 1/8	8 1/8	5 2 1/8	3 9	3 2 1/8	3 1 1/8	3 2 1/8	3 9	5 2 1/8	8 1/8	9 1/8	8 2	5 4	3 10	3 2 1/8	3 1 1/8	3 2	3 6 3/8	4 8 1/8	7 0 1/8	9 1/8
Total	10 0	9 11 1/8	9 11 1/8	9 11 1/8	9 11 1/8	9 10 1/8	9 10 1/8	9 10 1/8	9 9 3/8	9 8 3/8	9 8 3/8	9 8 3/8	9 7 3/8	9 7 3/8	9 6 3/8	9 6 3/8	9 5 3/8	9 5 3/8	9 5 3/8	9 5 3/8	9 5 3/8	9 4 3/8	9 4 3/8	9 4 3/8	9 4 3/8	9 4 3/8	9 3 3/8	9 3 3/8	9 2 3/8	9 2 3/8	9 1 3/8

\* Deflection

0	1/4	1/2	3/8	3/4	3/4	5/8	1	3/4	1/2	1/8	0	-1/8	-1/4	-3/8	-1/2	-1/2	-3/8	-1/4	-1/8	0	1/8	3/8	1/2	5/8	3/4	3/4	1/2	1/2	1/4	0
---	-----	-----	-----	-----	-----	-----	---	-----	-----	-----	---	------	------	------	------	------	------	------	------	---	-----	-----	-----	-----	-----	-----	-----	-----	-----	---

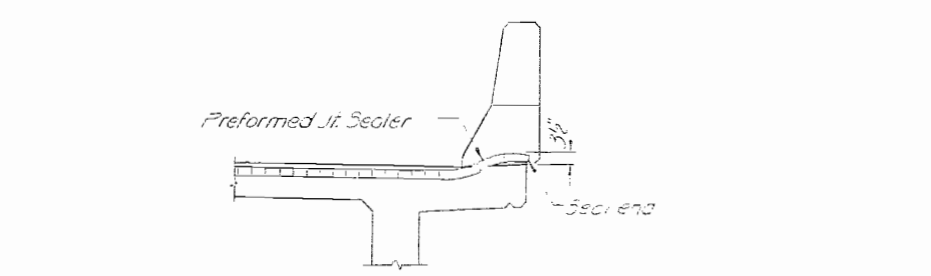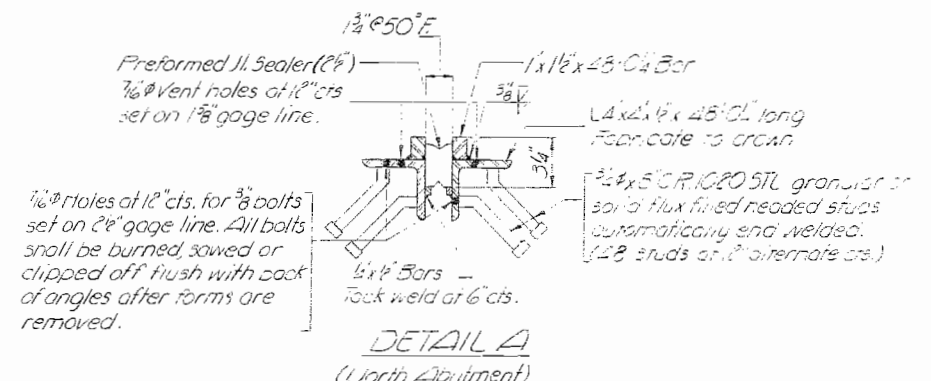

DESIGNED *A. J. Khayyat*  
 CHECKED *J. M. ...*  
 DRAWN *J. D.*  
 CHECKED *J. M. ...*

EXAMINED *[Signature]*  
 PASSED *[Signature]*  
 APPROVED *[Signature]*




NORTH BD. LANES  
 SUPERSTRUCTURE DETAILS  
 I-55 RT. 55 SEC. 57-9HB  
 MC LEAN COUNTY  
 STA. 297+80.50




STATE OF ILLINOIS  
DEPARTMENT OF TRANSPORTATION

ROUTE NO.	SECTION	COUNTY	TOTAL SHEETS	SHEET NO.
55	57-94B	MC LEAN	93	34
FED. ROAD DIST. NO. 7		ILLINOIS	FED. AID PROJECT	56 SHEETS

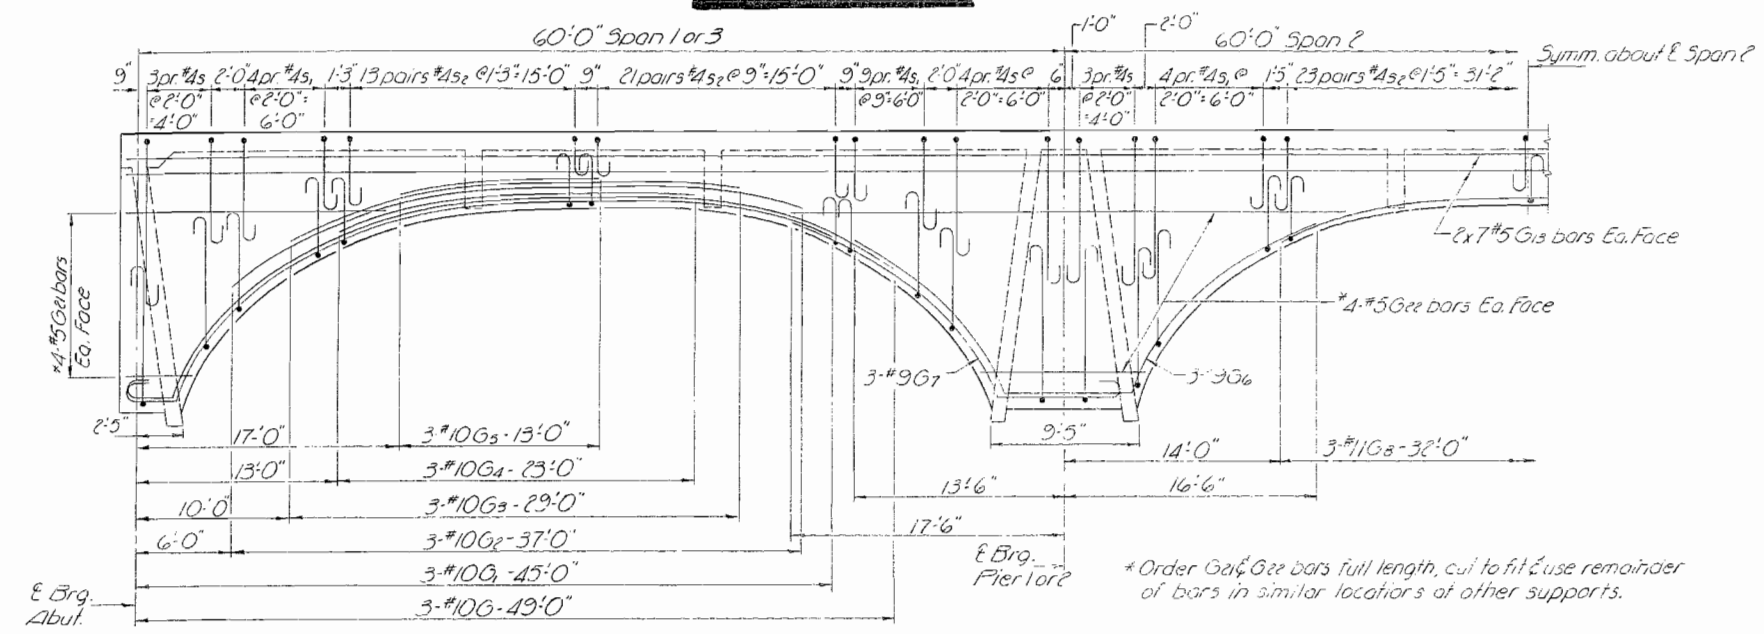

Note:  
Lap G<sub>13</sub> G<sub>14</sub> bars of E Span 2 thus → 8

ELEVATION

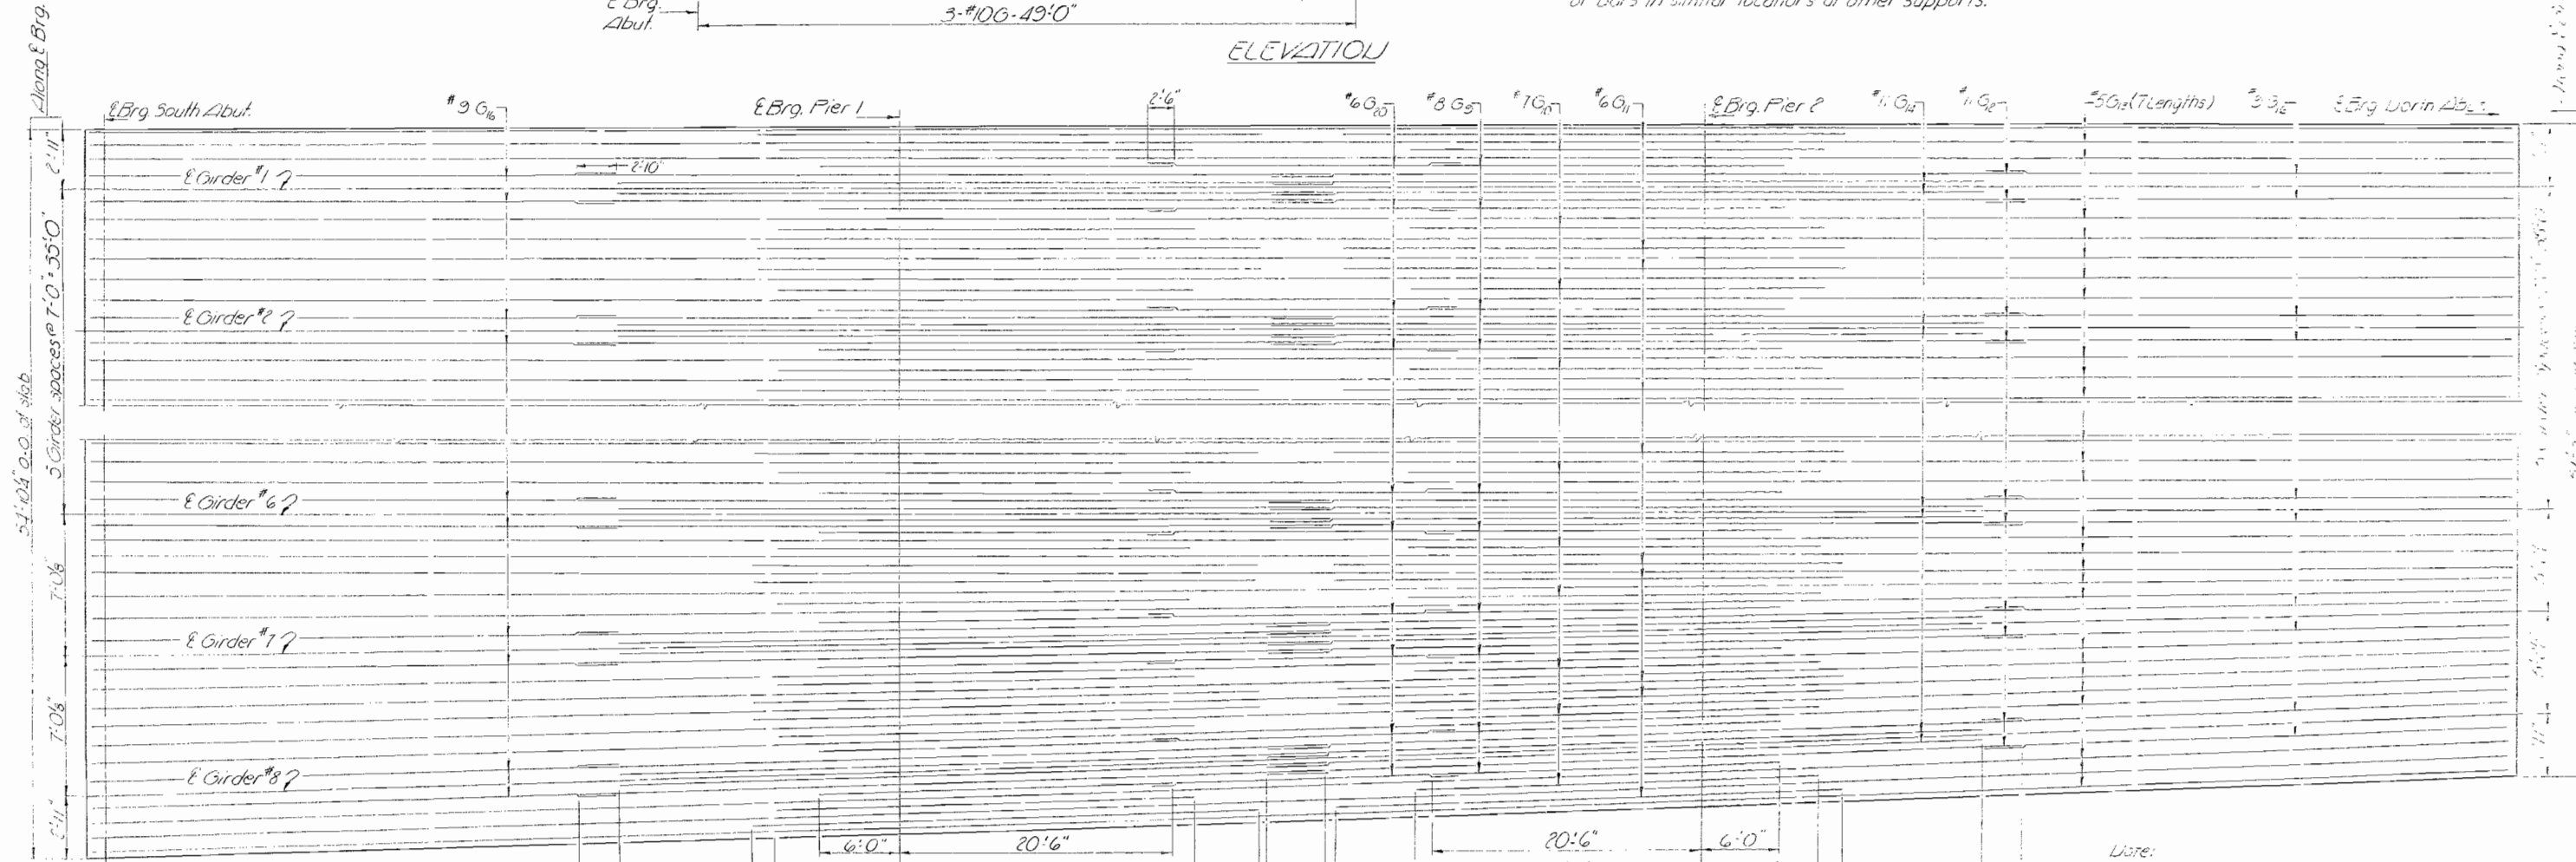

DESIGNED	A. I. KHAYAT
CHECKED	J. D. H. H.
DRAWN	J. D. H.
CHECKED	J. D. H.

OCT. 20 19 52

EXAMINED *[Signature]*  
PASSED *[Signature]*  
APPROVED *[Signature]*  
CHIEF HIGHWAY ENGINEER


PLAN  
Showing longitudinal reinforcement in top of slab.

Note:  
For bar details and Bar List see sheet 33.


NORTH BD. LAJES  
GIRDER REINFORCEMENT  
FAI RT. 55 SEC 57-94B  
MC LEAN COUNTY  
STA. 297+80.50

STATE OF ILLINOIS  
DEPARTMENT OF TRANSPORTATION


ROUTE NO.	SECTION	COUNTY	TOTAL SHEETS	SHEET NO.
55	57-98B	MC LEAN	99	35
SHEETS 58				

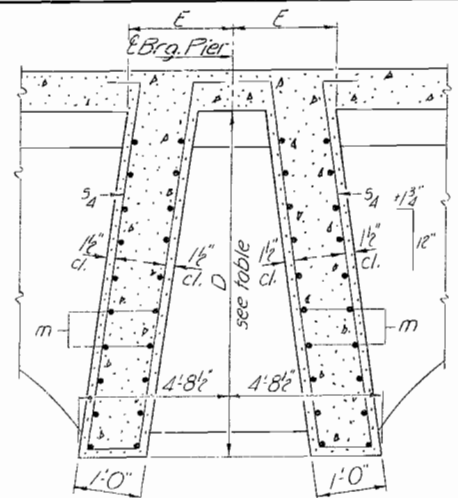

SECTION THRU DIAPHRAGMS AT PIERS

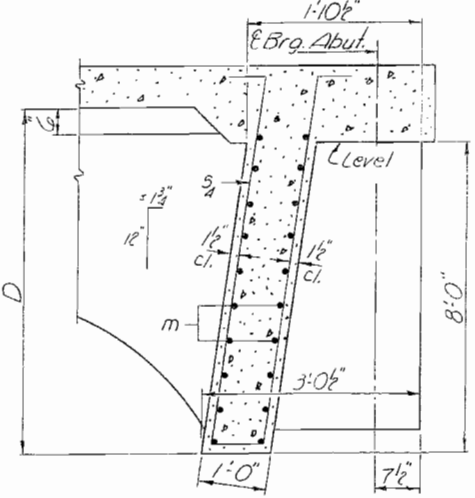


SECTION THRU DIAPHRAGMS AT ABUTMENTS

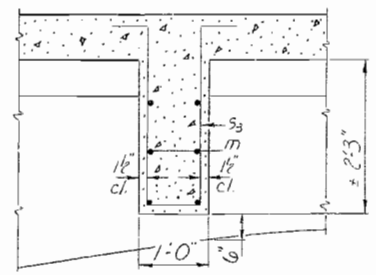

SECTION THRU INTERIOR DIAPHRAGMS


DIMENSIONS D & E

	D		E	
	S. Abut.	Pier 1	Pier 2	W. Abut. Pier 1 & 2
G <sub>1</sub>	8'-10 3/8"	8'-10"	8'-9 3/4"	8'-9 3/8"
G <sub>2</sub>	8'-11 1/8"	8'-11 1/8"	8'-11 1/4"	8'-10 5/8"
G <sub>3</sub>	9'-1 1/4"	9'-0 1/8"	9'-0 1/8"	9'-0 1/4"
G <sub>4</sub>	9'-0 3/8"	9'-0 1/4"	9'-0"	8'-11 3/8"
G <sub>5</sub>	8'-11 1/4"	8'-10 3/8"	8'-10 3/8"	8'-10 3/8"
G <sub>6</sub>	8'-9 3/8"	8'-9 1/4"	8'-8 3/8"	8'-8 1/8"
G <sub>7</sub>	8'-7 3/8"	8'-7 1/8"	8'-7 1/8"	8'-7 1/4"
G <sub>8</sub>	8'-6"	8'-6"	8'-6"	8'-6"

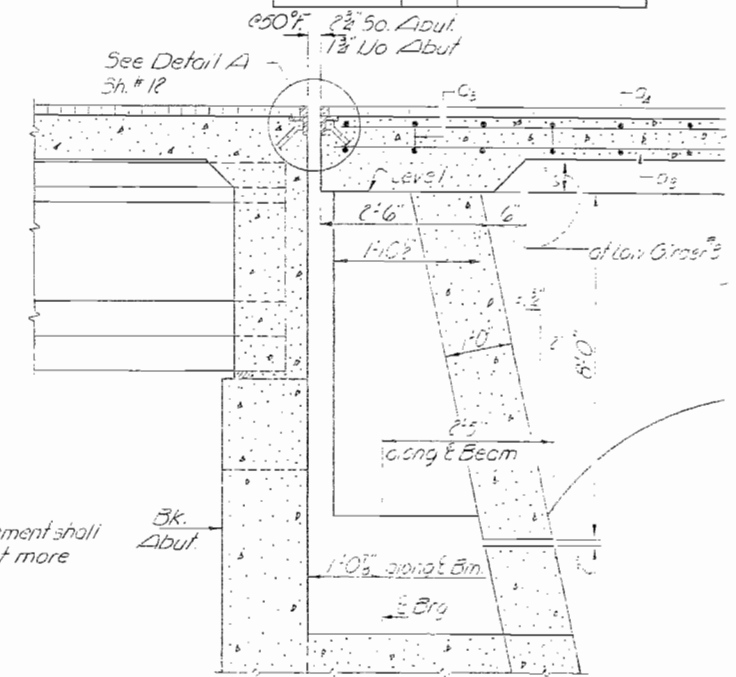


SEC. A-A


Note:  
Bundled reinforcement shall be tied together at not more than 6'-0" cts.

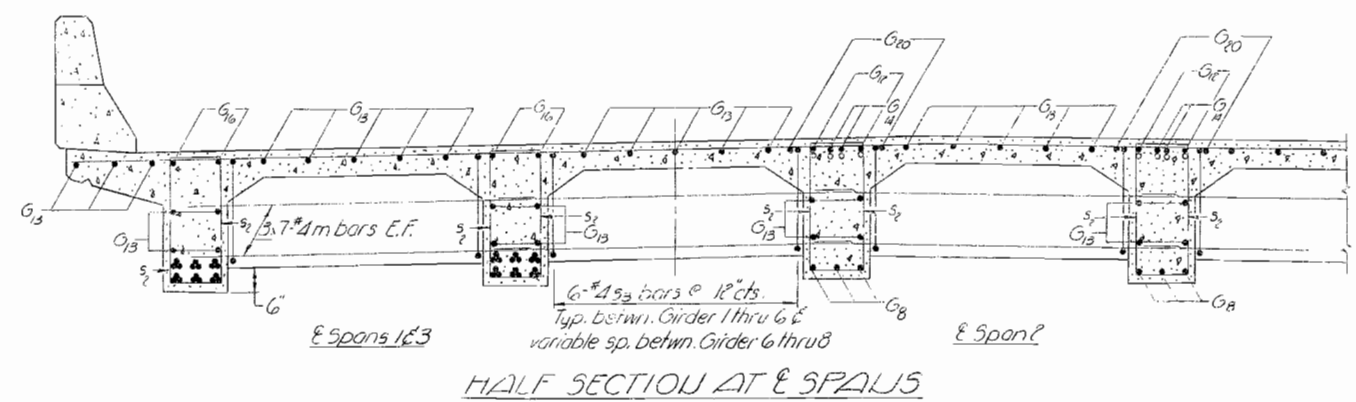

HALF SECTION AT SPANS 1&3

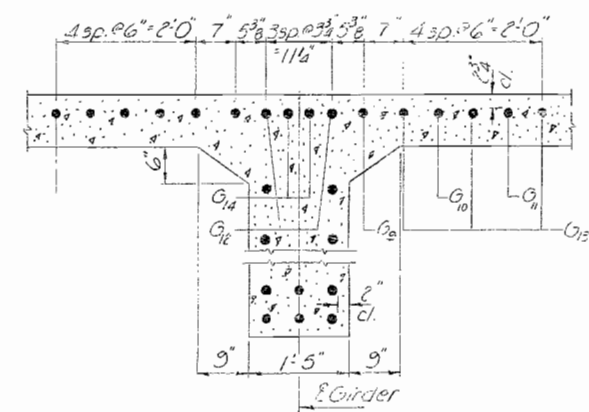

SEC. THRU GIRDER AT PIERS  
Showing typ. spacing between Girders 1 thru 6. For the variable spacing between Girders 6 thru 8 for G<sub>9</sub>, G<sub>10</sub>, G<sub>11</sub> & G<sub>13</sub> bars to fit.

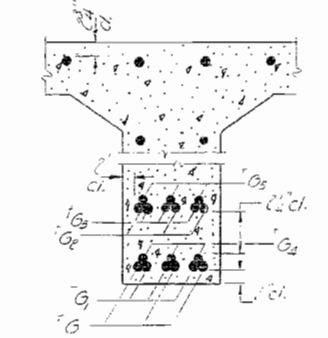


SEC. THRU GIRDER AT SPANS 1&3


BAR LIST FOR EIGHT GIRDERS

Bar No.	Size	Length (ft)	Notes
G <sub>1</sub>	#10	51'-3"	
G <sub>2</sub>	#10	47'-1"	
G <sub>3</sub>	#10	36'-0"	
G <sub>4</sub>	#10	29'-8"	
G <sub>5</sub>	#10	23'-6"	
G <sub>6</sub>	#9	22'-0"	
G <sub>7</sub>	#9	22'-5"	
G <sub>8</sub>	#9	22'-0"	
G <sub>9</sub>	#6	22'-2"	
G <sub>10</sub>	#7	31'-0"	
G <sub>11</sub>	#6	37'-6"	
G <sub>12</sub>	#11	36'-5"	
G <sub>13</sub>	#5	17'-0"	
G <sub>14</sub>	#4	33'-5"	
G <sub>15</sub>	#9	33'-0"	
G <sub>16</sub>	#6	24'-0"	
G <sub>17</sub>	#5	12'-0"	
G <sub>18</sub>	#5	23'-0"	
G <sub>19</sub>	#4	11'-0"	
G <sub>20</sub>	#4	10'-0"	
G <sub>21</sub>	#4	7'-0"	
G <sub>22</sub>	#4	9'-5"	
m	#4	11'-0"	

\*\* Quantity included in Bill of Materials sp. sh. 11.

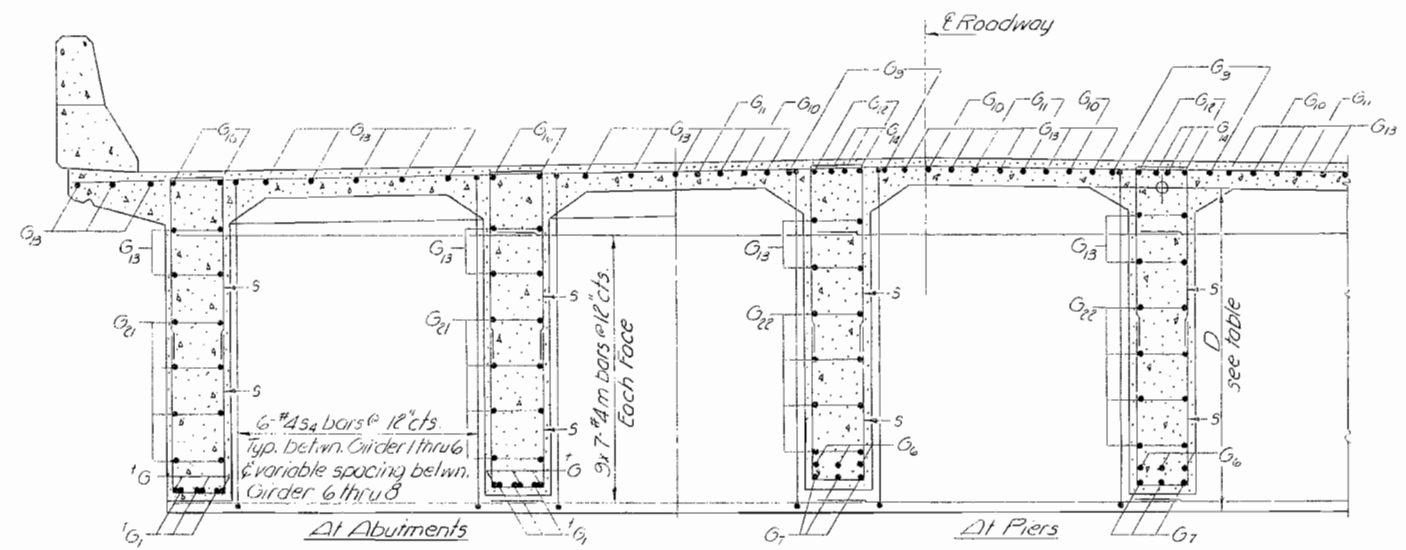


HALF SECTION AT SUPPORTS

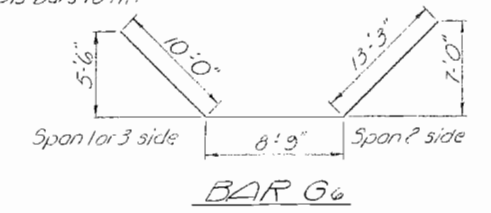


BAR G6




BARS G9, G10, G11

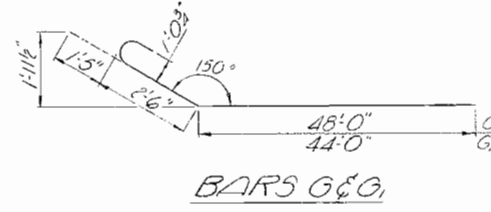


BARS G6, G7

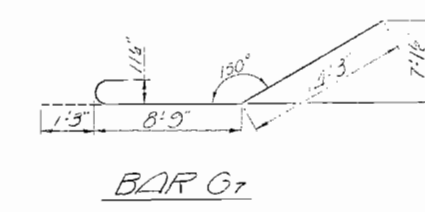

BAR G7

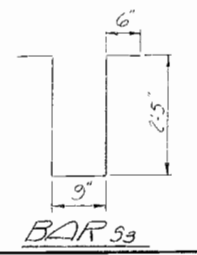

BAR G9

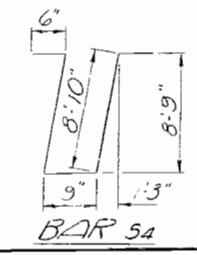

BAR G10

DESIGNED	A. I. Khayyat
CHECKED	J. M. P. ...
DRAWN	J. D.
CHECKED	J. M. P.


EXAMINED	Richard A. Hoetterman
PASSED	Richard A. Hoetterman
APPROVED	Richard A. Hoetterman

Note:  
Bars indicated thus 20x3 #5 etc. indicates 20 lines of bars with 3 lengths per line. Min. bar laps = 24 Dia.


NORTH BD LAVES  
GIRDER REINFORCEMENT  
FAI RT. 55 SEC. 57-98B  
MC LEAN COUNTY  
STA. 297+80.50

STATE OF ILLINOIS  
DEPARTMENT OF TRANSPORTATION

ROUTE NO.	SECTION	COUNTY	TOTAL SHEETS	SHEET NO.	SHEET NO. 15
P.A. 55	57-9HB	MCLEAN	93	36	15 SHEETS
FED. ROAD DIST. NO. 7	ILLINOIS	FED. AID PROJECT			

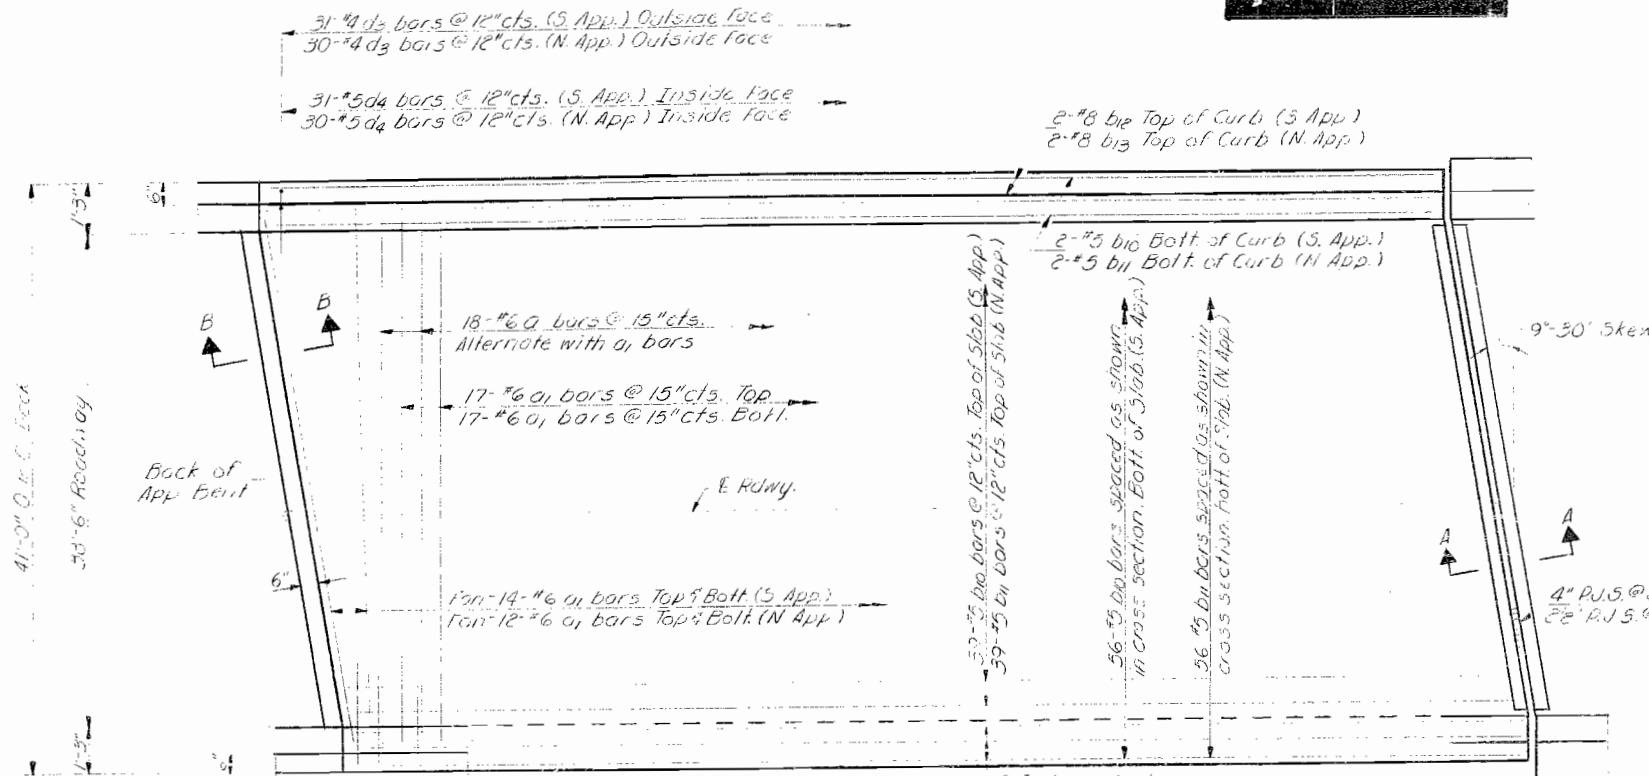


PLAN

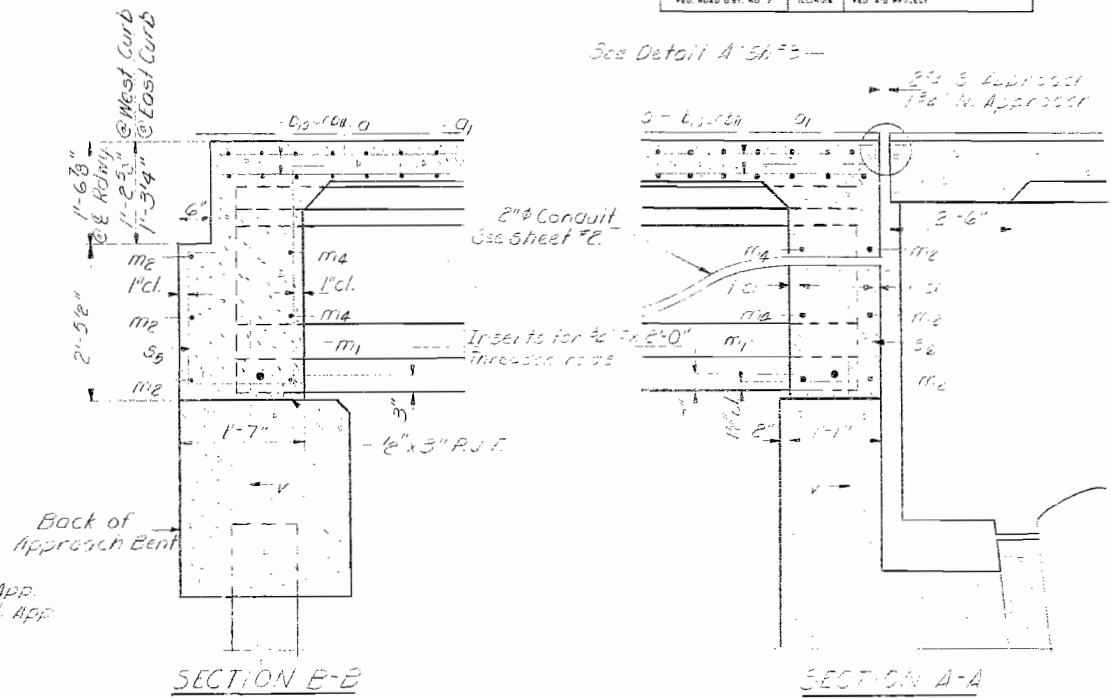


SECTION B-B

SECTION A-A

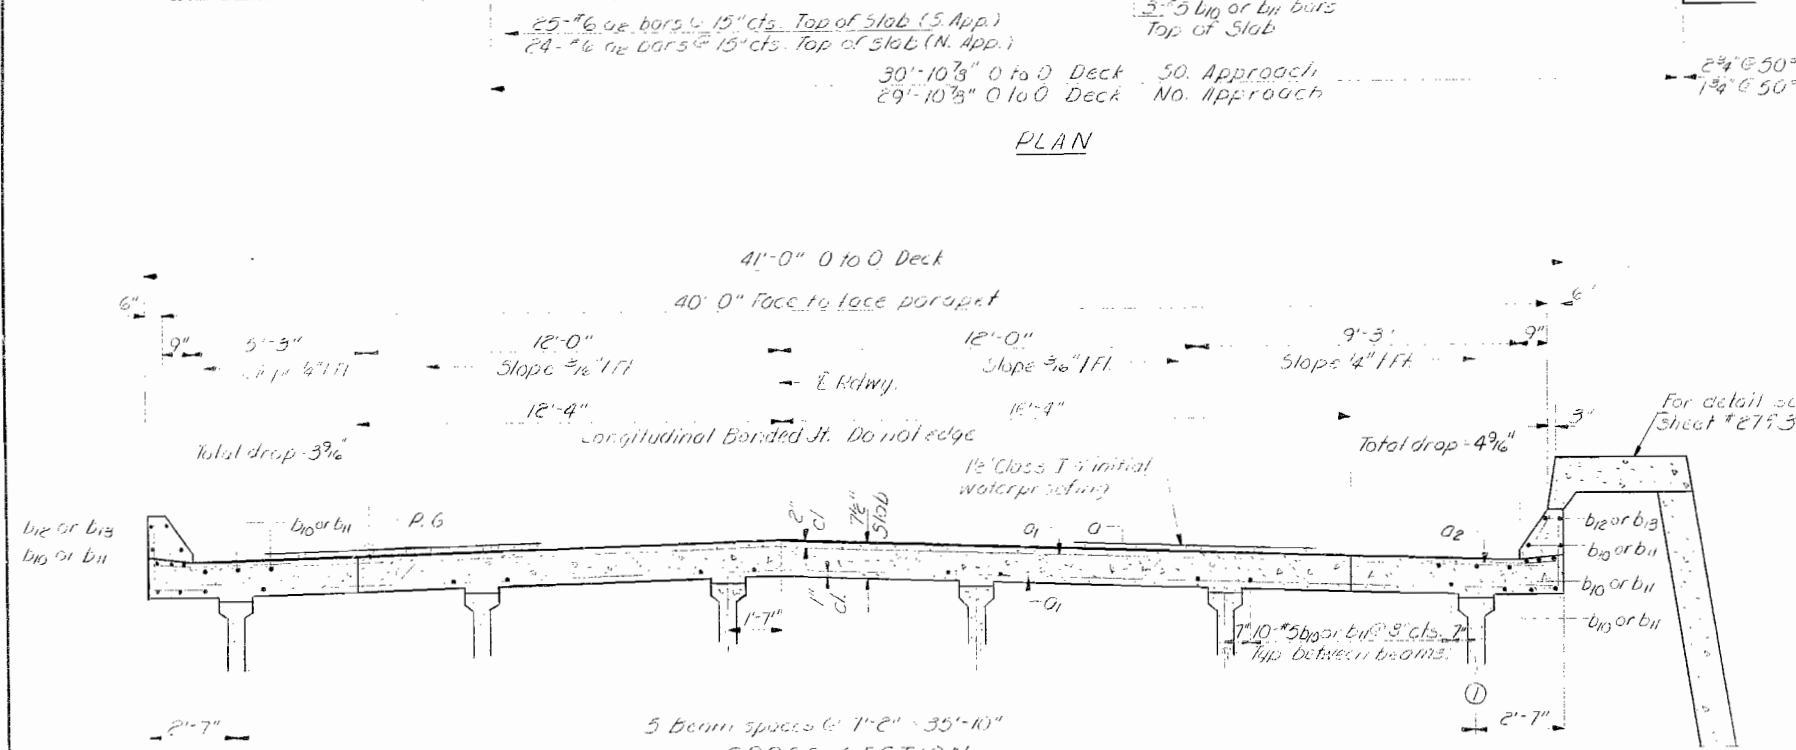

CROSS SECTION  
Looking South

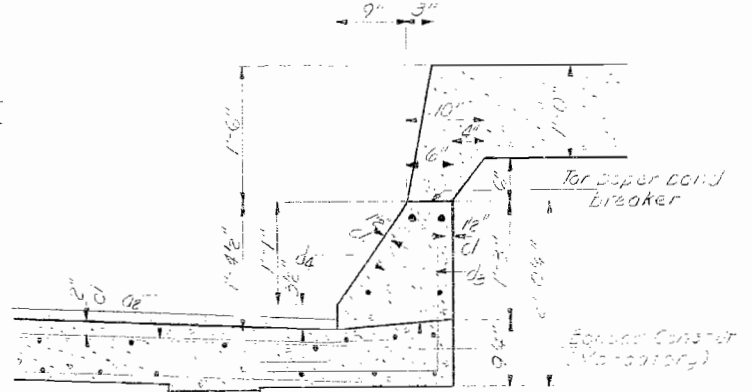

CURB SECTION

TWO APPROACH SPANS  
BILL OF MATERIAL

Bar	Qty	Size	Length	Weight
a1	36	#6	21'-7"	1100
a2	72	#6	40'-0"	2200
a3	96	#6	1'-0"	100
b1	108	#6	55'-7"	5000
b2	72	#6	33'-7"	2700
b3	72	#6	33'-7"	2700
b4	128	#4	3'-6"	1000
b5	128	#4	2'-4"	800
m1	50	#4	10'-0"	400
m2	36	#4	10'-0"	300
m3	20	#4	10'-0"	200
m4	20	#4	10'-0"	200
m5	20	#4	10'-0"	200
m100	20	#4	10'-0"	200


For bar m1, m2, m3, m99, m100

SOUTH 50 LANE  
SOUTH 40 LANE  
SOUTH 30 LANE  
SOUTH 20 LANE  
SOUTH 10 LANE  
SOUTH 0 LANE  
SOUTH 10 LANE  
SOUTH 20 LANE  
SOUTH 30 LANE  
SOUTH 40 LANE  
SOUTH 50 LANE


STA 297+80.00

DESIGNED A. J. [Signature]  
CHECKED J. M. [Signature]  
DRAWN Rex Robinson  
CHECKED J. M. [Signature]

EXAMINED [Signature] Oct 20 1964  
PASSED [Signature]  
APPROVED [Signature]  
[Signature] CHIEF HIGHWAY ENGINEER

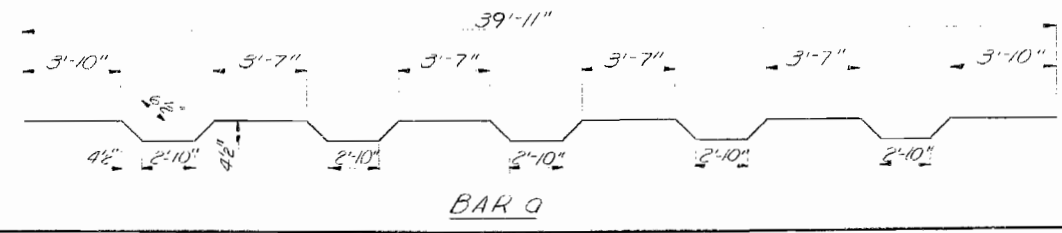

BAR Q

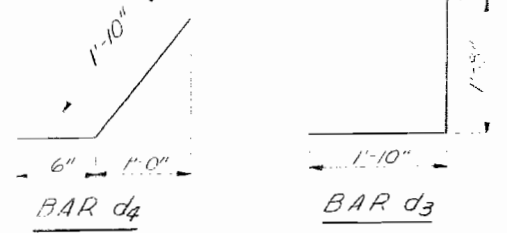


BAR d4


BAR d3

STATE OF ILLINOIS  
DEPARTMENT OF TRANSPORTATION



ROUTE NO.	SECTION	COUNTY	TOTAL SHEETS	SHEET NO.	SHEET NO. OF SHEETS
155	57-9HB	MCLEAN	93	37	36
FED. ROAD DIST. NO. 7	ILLINOIS	FED. AID PROJECT			

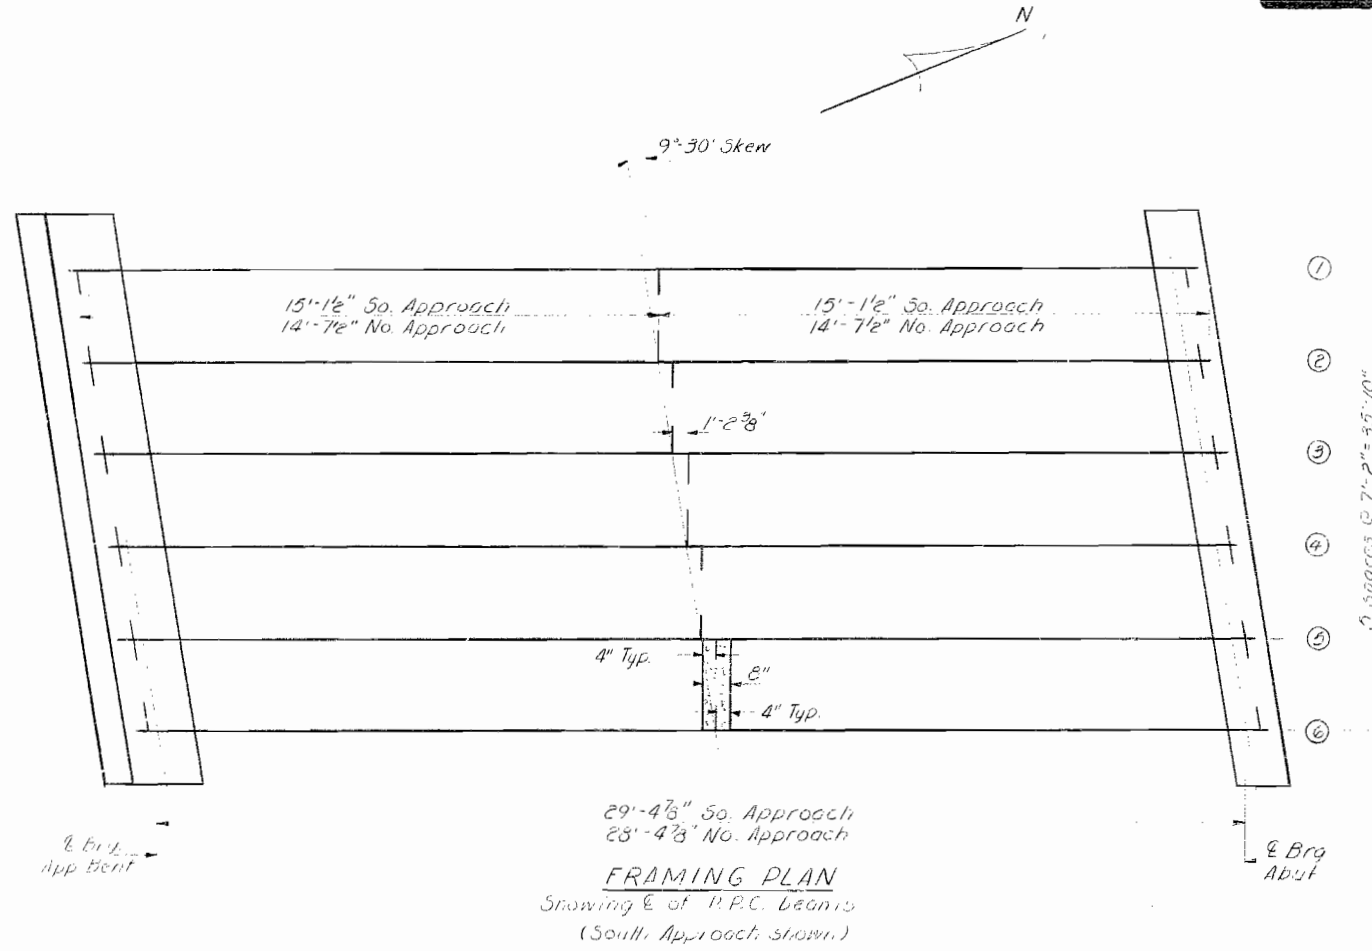


**FRAMING PLAN**  
Showing  $\epsilon$  of P.C. Beams  
(South Approach shown.)

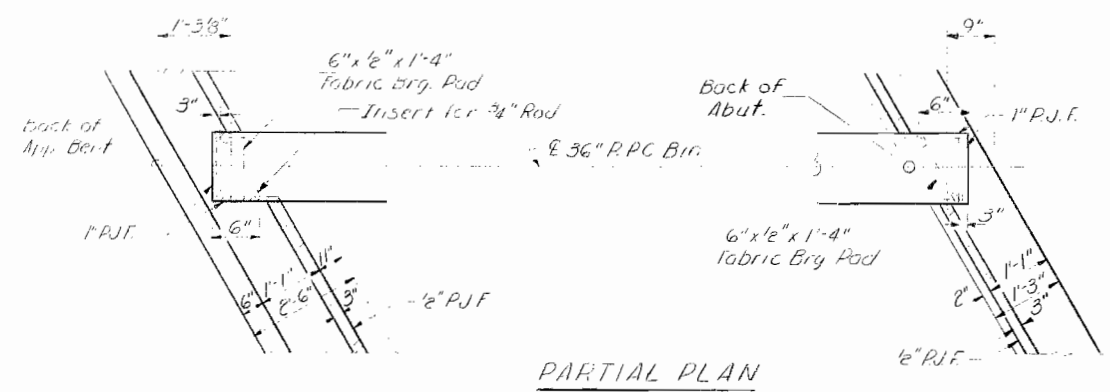


**PARTIAL PLAN**

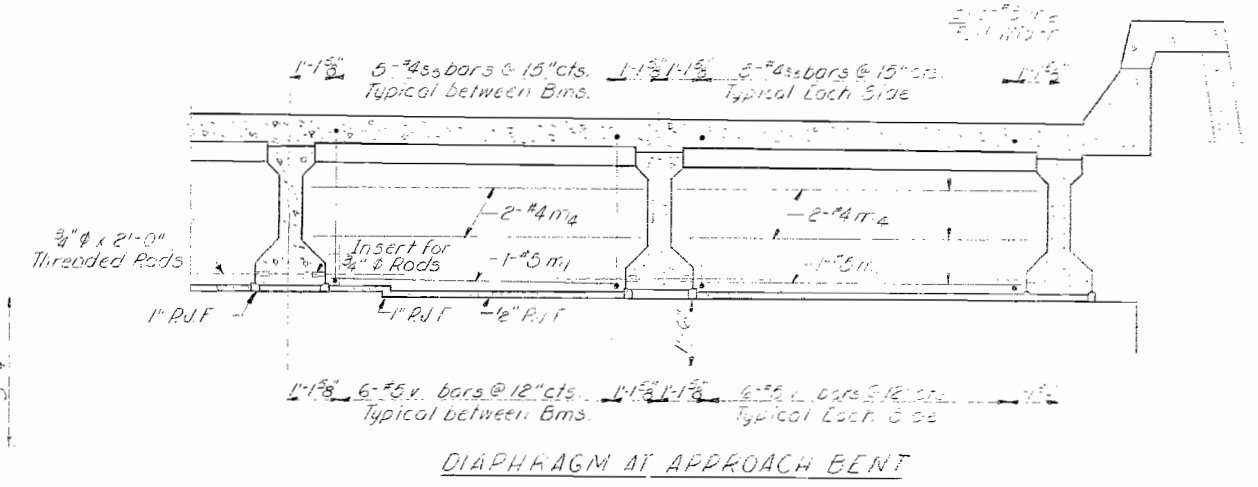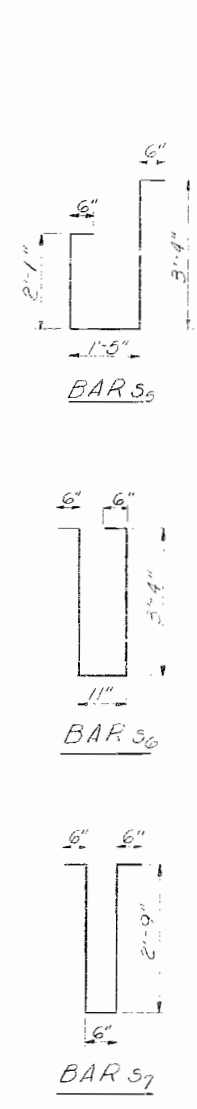


**DIAPHRAGM AT APPROACH BENT**

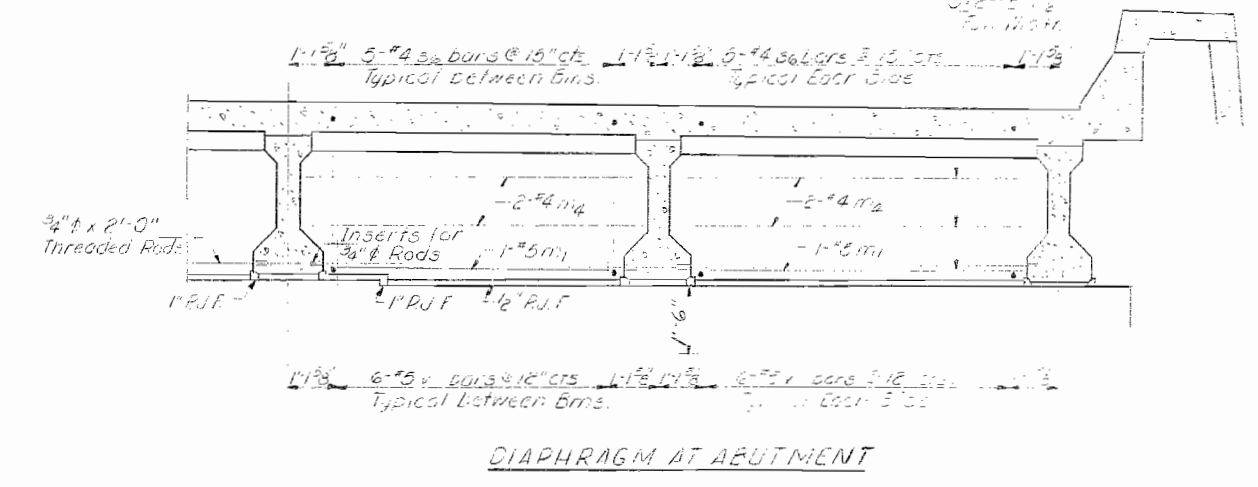

**DIAPHRAGM AT ABUTMENT**

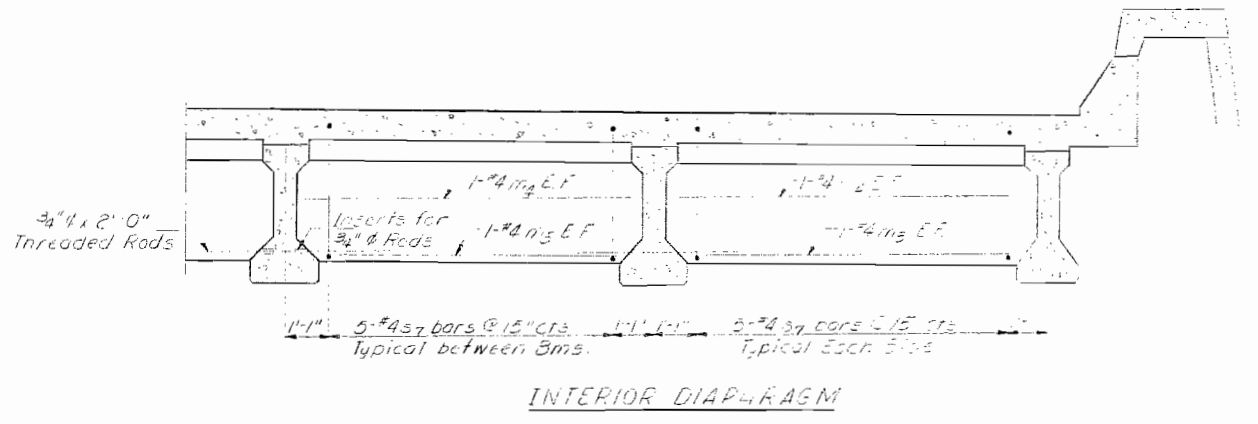

**INTERIOR DIAPHRAGM**

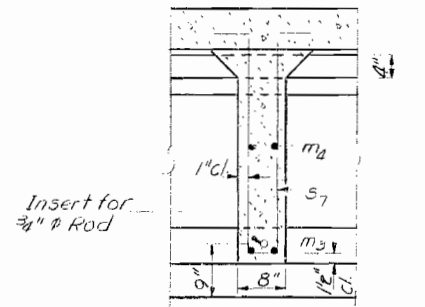

**SECTION THRU INTERIOR DIAPHRAGM**

**NOTES:**  
Bars S5, S6, S7 and m4, m5, m6 are filled with Approach Slab fill of Material on sheet #18.  
Bar v is filled with Abutment Fill of Material on sheet #28 and c.  
See sheet #15 for sections thru abutment and approach bent diaphragms.


**APPROACH DIAPHRAGM DETAILS**  
SOUTH BD. LANE  
EAT RT 55 SEC 57-9HB  
MCLEAN COUNTY  
STA 297+80.50

DESIGNED <i>J. M. Pate</i>	EXAMINED <i>[Signature]</i>
CHECKED <i>J. M. Pate</i>	PASSED <i>[Signature]</i>
DRAWN <i>Bry Robinson</i>	APPROVED <i>[Signature]</i>
CHECKED <i>J. M. Pate</i>	CHIEF HIGHWAY ENGINEER


OCT. 20 1972

STATE OF ILLINOIS  
DEPARTMENT OF TRANSPORTATION


ROUTE NO.	SECTION	DATE	TOTAL SHEETS	SHEET NO.	SHEET NO.
55	57-9RB	M. LEAN	93	38	38 SHEETS
FED. ROAD DIST. NO. ILLINOIS FED. AID PROJECT					

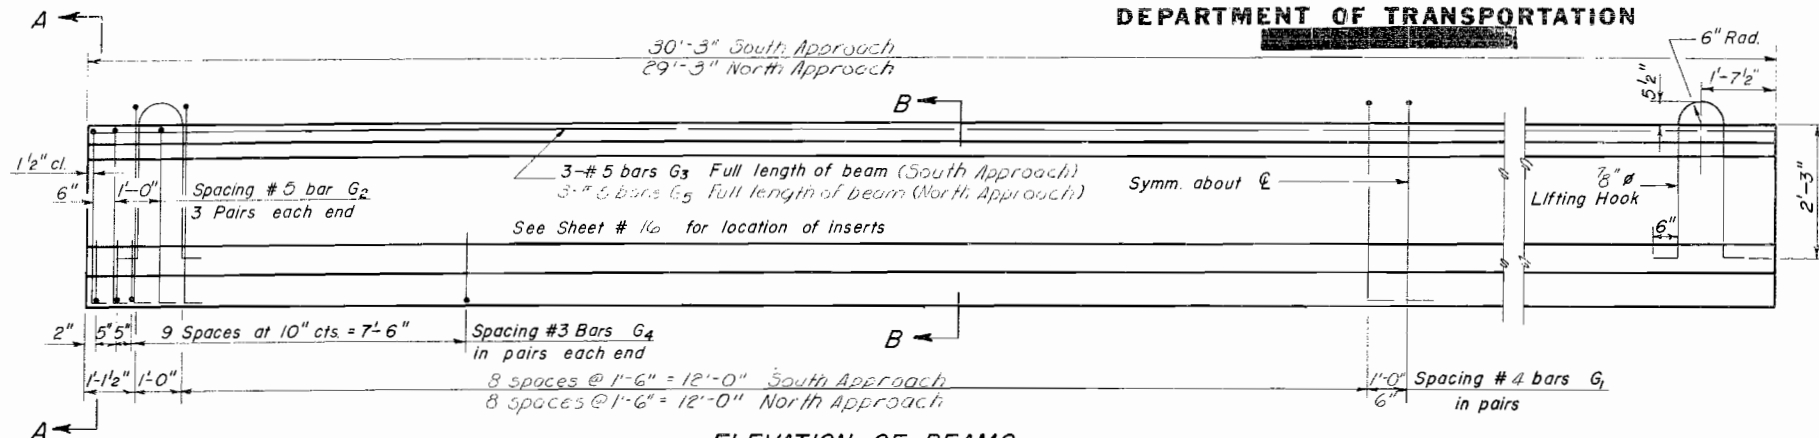

**ELEVATION OF BEAMS**  
Showing Reinforcement & Dimensions

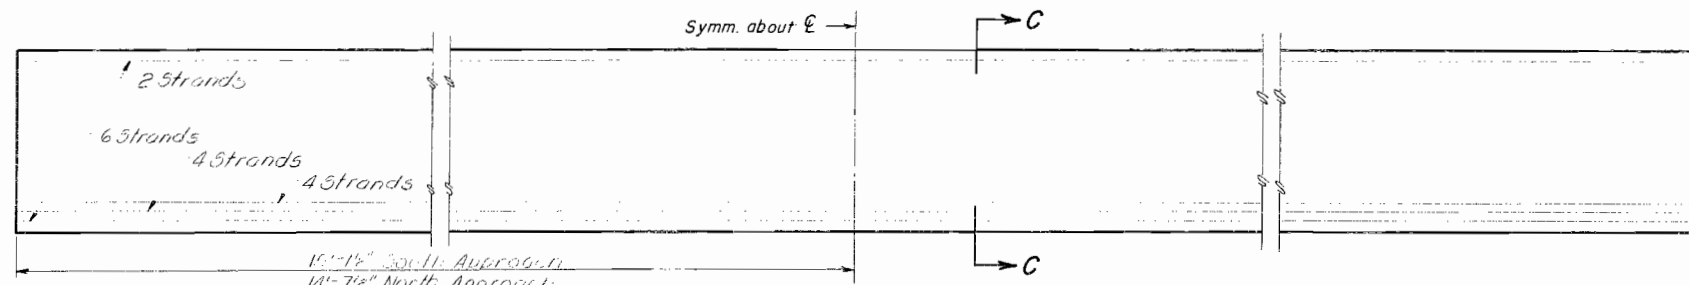


**ELEVATION OF BEAMS**  
Showing Prestressing Steel

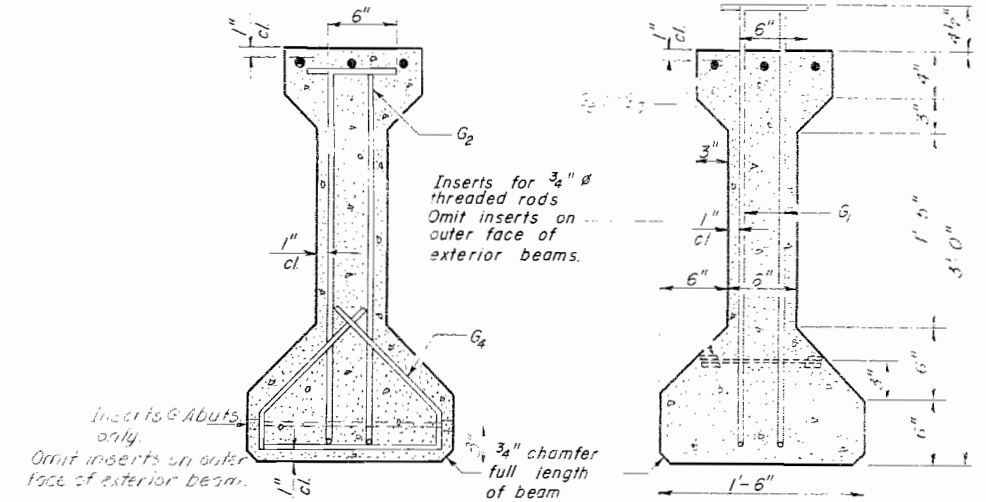

**SECTION A-A**

**SECTION B-B**

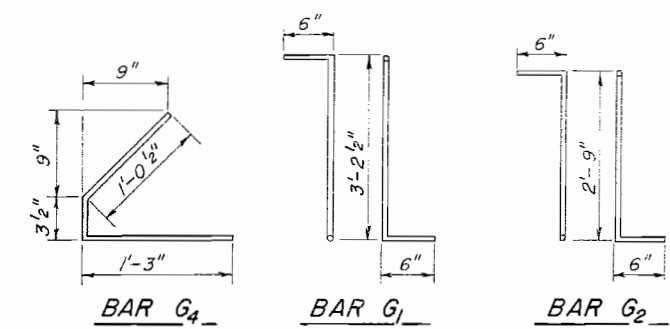

**BAR G4**

**BAR G1**

**BAR G2**

**NOTES**

All inserts and threaded rods for inserts, reinforcing and Prestressing Steel, and other items which are cast into the Precast Concrete I-Beams shall be included in the contract unit price per lineal foot of "Furnishing And Erecting Precast Prestressed Concrete I-Beams, 36 In."

**BAR LIST**

Item	Qty	Unit	Total
1	42	42	42
2	12	12	12
3	42	42	42
4	5	5	5

**BILL OF MATERIAL**

Item	Unit	Total
Furnishing & Erecting Precast Prestressed Concrete I-Beams, 36"	Lin Ft	227


Prestressing Steel shall have a nominal diameter of 7/16".  
Inserts for 3/4" threaded rods are to be two strut, coil type for interior I-Beams and single coil, flared loop type for exterior I-Beams.  
Steel for lifting hooks shall be non-deformed bars

SOUTH BD LANES  
50' NO. APPROACH EE  
FAH. RT. 55 SEC 27-9-48  
MCLEAN COUNTY  
STA 297-80.50


DESIGNED	J. J. Kline	EXAMINED	[Signature]
CHECKED	[Signature]	PASSED	[Signature]
DRAWN	T.B. Fuller	APPROVED	[Signature]
CHECKED	[Signature]		

STATE OF ILLINOIS  
DEPARTMENT OF TRANSPORTATION


ROUTE NO.	SECTION	COUNTY	TOTAL SHEETS	SHEET NO.	SHEET NO.
157-94B	MC LEAN	93	39	68	68 SHEETS

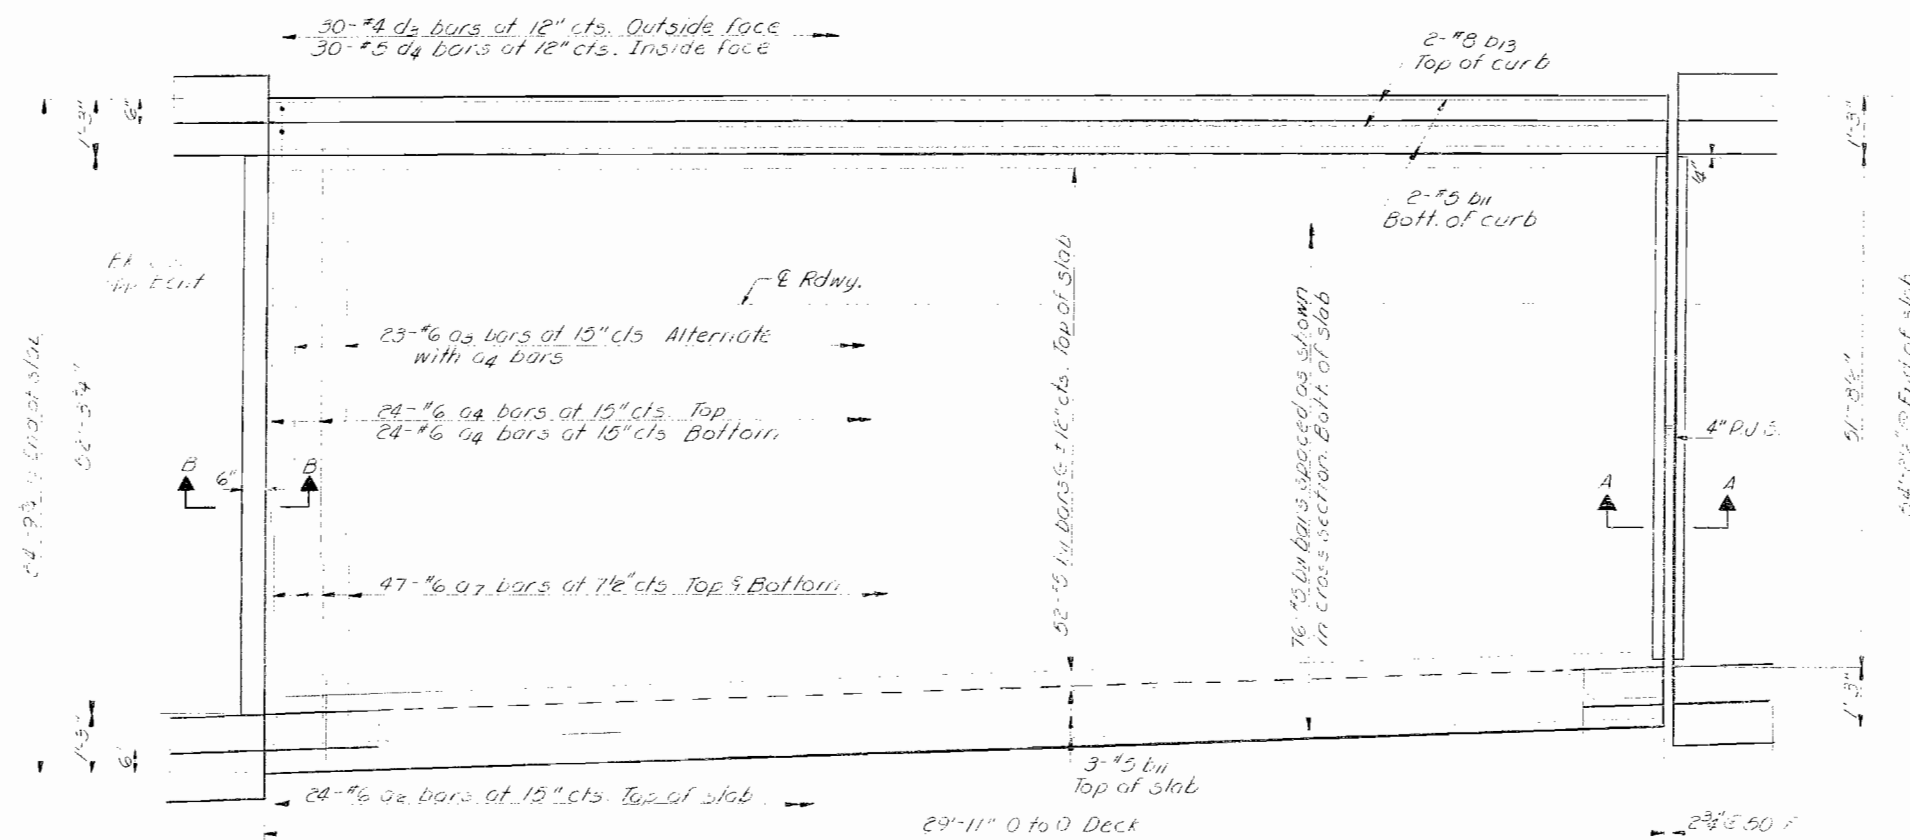


PLAN  
South Approach

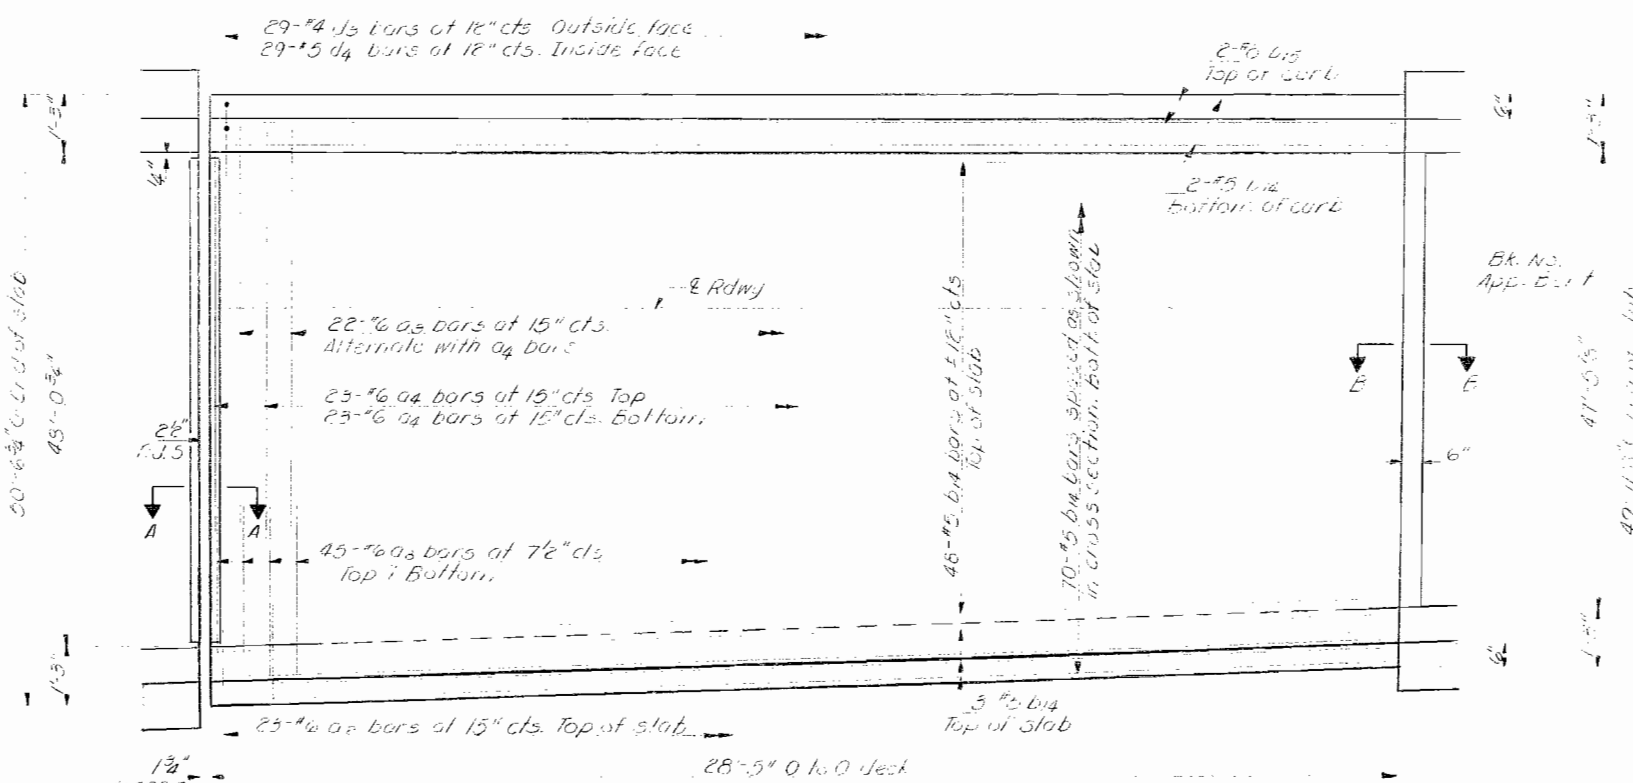

PLAN  
North Approach

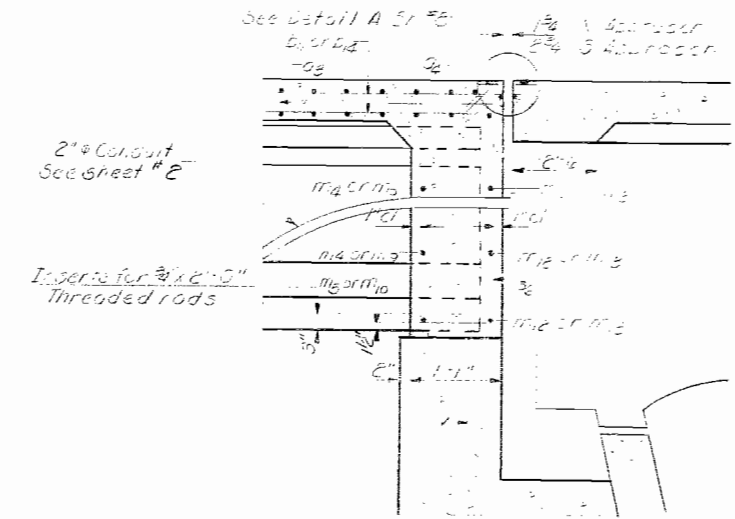

SECTION A-A

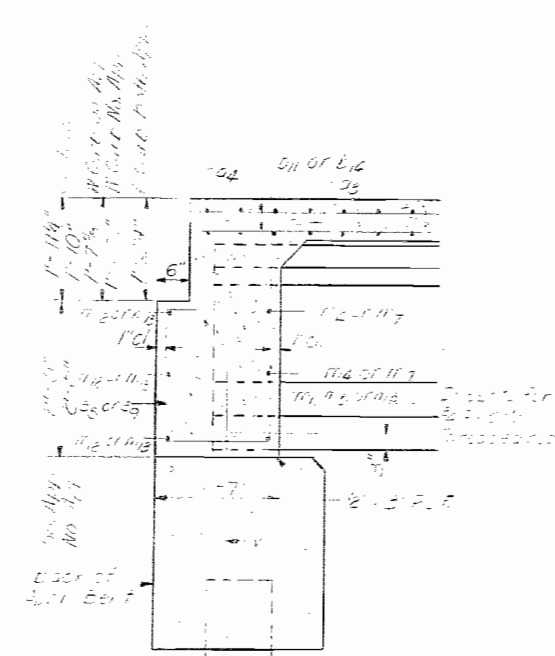

SECTION B-B

DESIGNED	J. W. Johnson
CHECKED	J. W. Johnson
DRAWN	Bob Robinson
CHECKED	J. W. Johnson


OCT. 20 1972  
EXAMINER  
PASSED  
APPROVED  
Richard A. Holterman  
CHIEF HIGHWAY ENGINEER

NORTH BD LANES  
SOUTH NORTH APPROACH SLABS  
FAI. R. 155 SEC. 27-24E  
MC LEAN COUNTY  
STA. 297+80.50




STATE OF ILLINOIS  
DEPARTMENT OF TRANSPORTATION





ROUTE NO.	SECTION	COUNTY	TOTAL SHEETS	SHEET NO.
155	57-94B	MC LEAN	93	40
SHEET NO. 58 SHEETS				

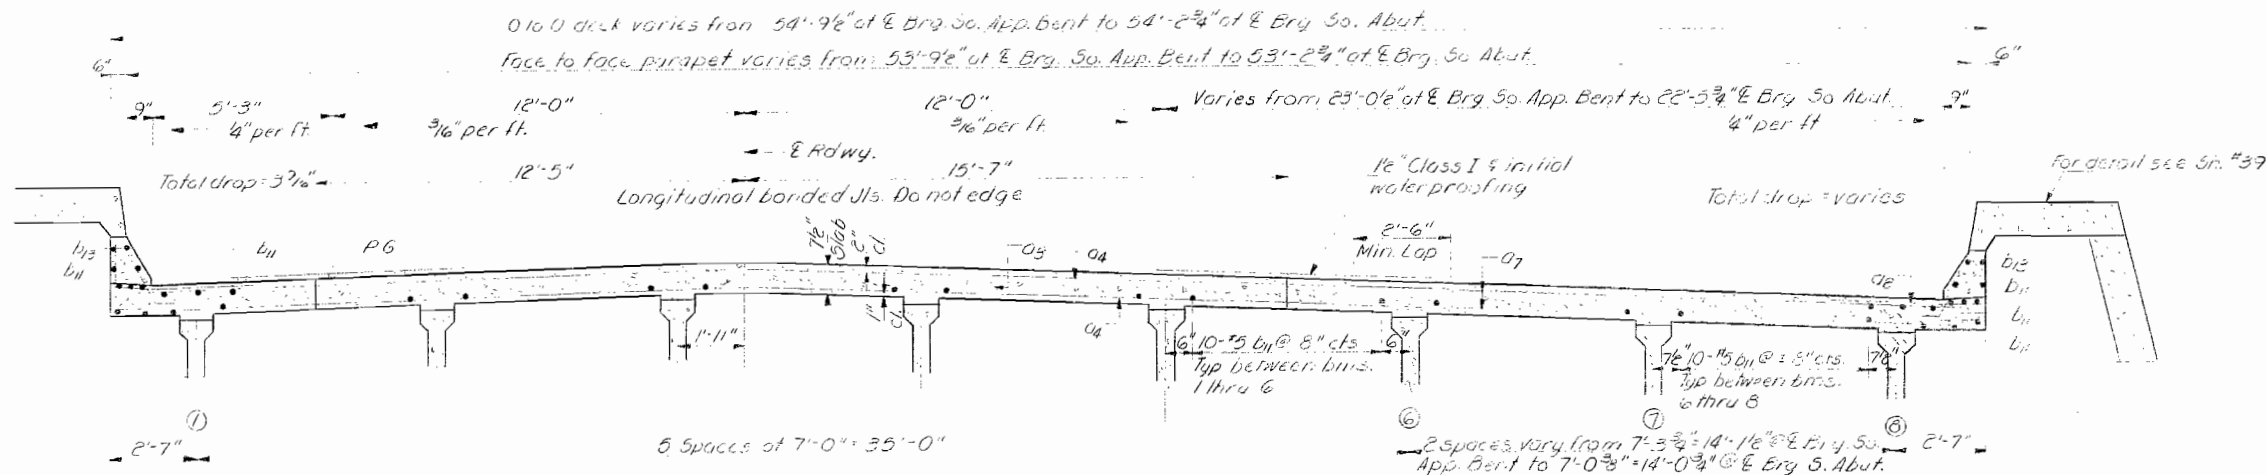

CROSS SECTION  
South Approach  
Looking North

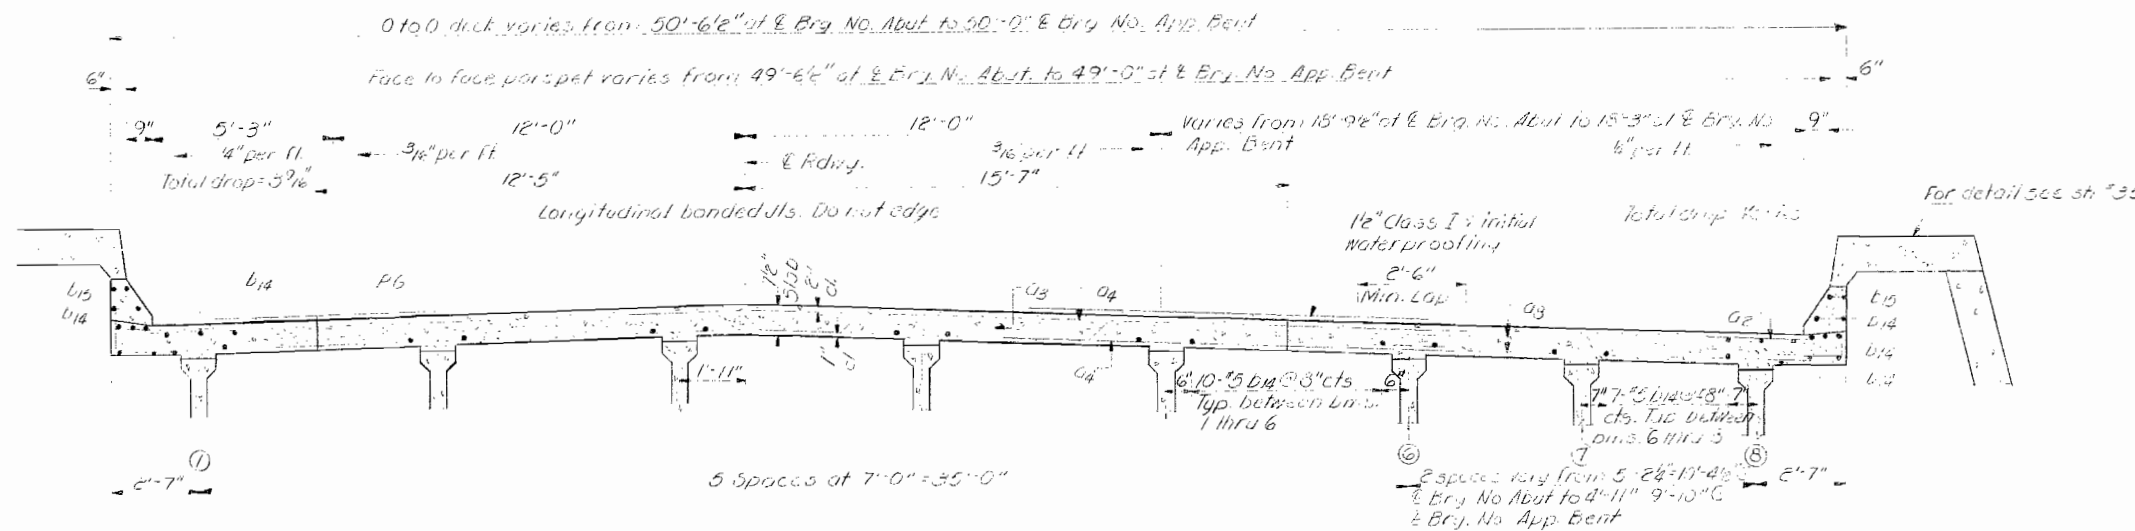

CROSS SECTION  
North Approach  
Looking North

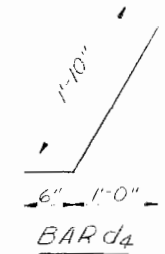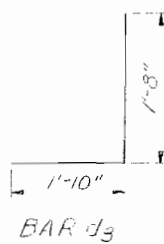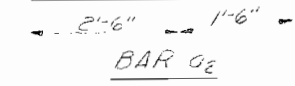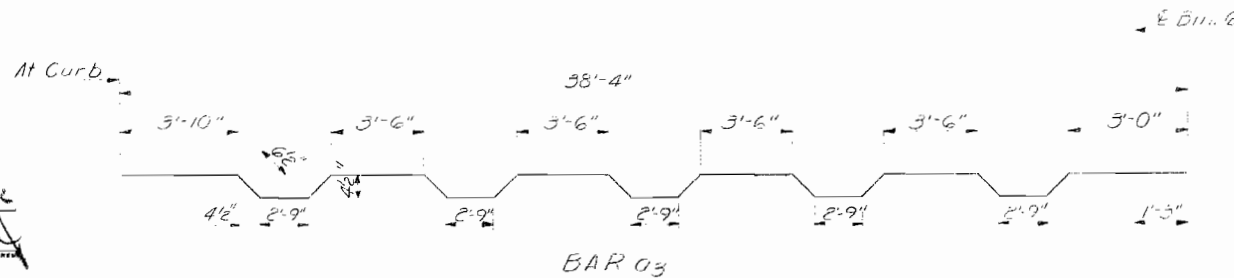

TWO APPROACH SPANS  
BILL OF MATERIAL

Bar	No.	Size	Length	Weight
02	32	#4	4'-0"	1.10
02	42	#4	4'-0"	1.10
02	52	#4	4'-0"	1.10
02	1002	#4	4'-0"	1.10

For curb section see sh. #15.  
For bar details see sh. #14, #16, #17, #18, #99, #100.

NORTH ED LANE'S  
APPROACH SLAB'S  
PART 55 300 57-94B  
MCLEAN COUNTY  
STA 297+80.00


DESIGNED	A. J. Whizzart
CHECKED	J. M. Baird
DRAWN	Ben Robinson
CHECKED	L. M. P.

OCT. 20 1976  
EXAMINED  
PASSED  
APPROVED


STATE OF ILLINOIS  
DEPARTMENT OF TRANSPORTATION

ROUTE NO.	SECTION	COUNTY	TOTAL SHEETS	SHEET NO.
55	57-94B	MC LEAN	93	41
FED. ROAD DIST. NO. 7		ILLINOIS	FED. AID PROJ. EST.	


SHEET NO. 23  
55 SHEETS

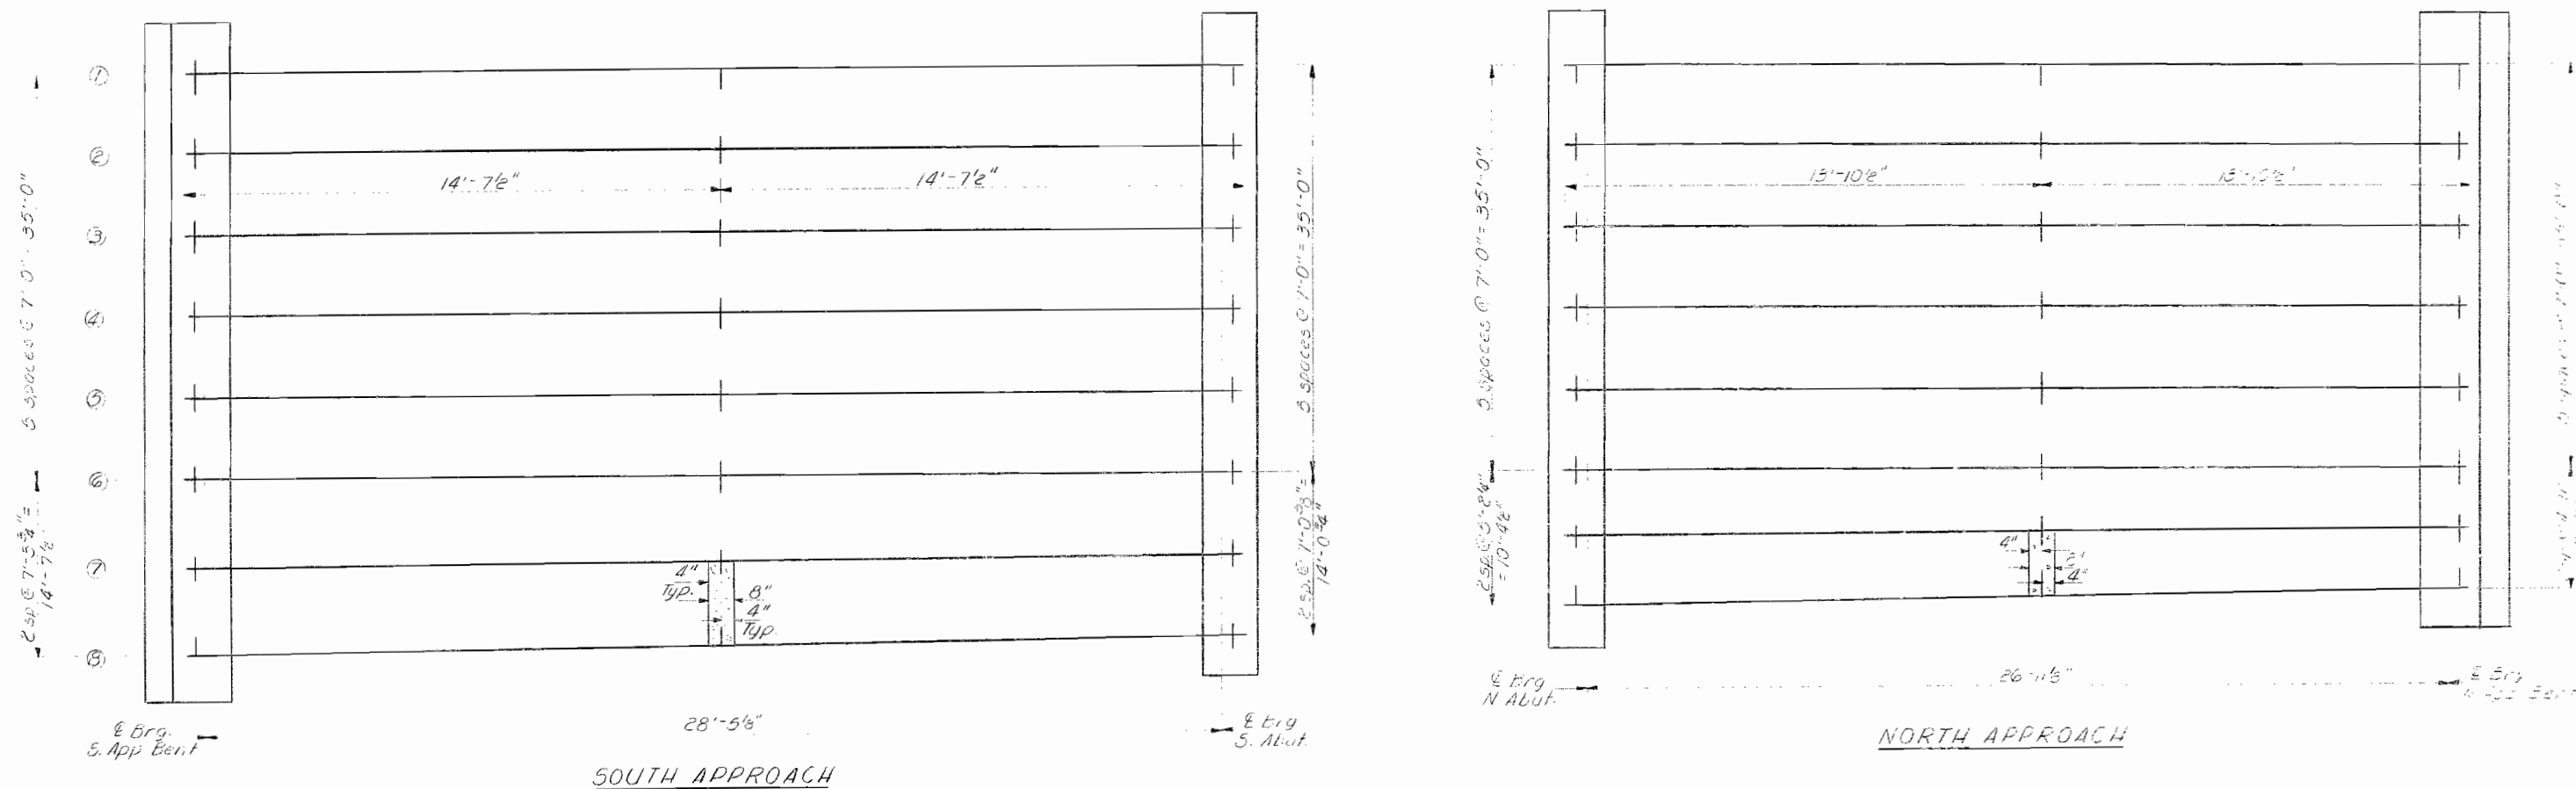


FRAMING PLAN  
Showing E P.C. Beams

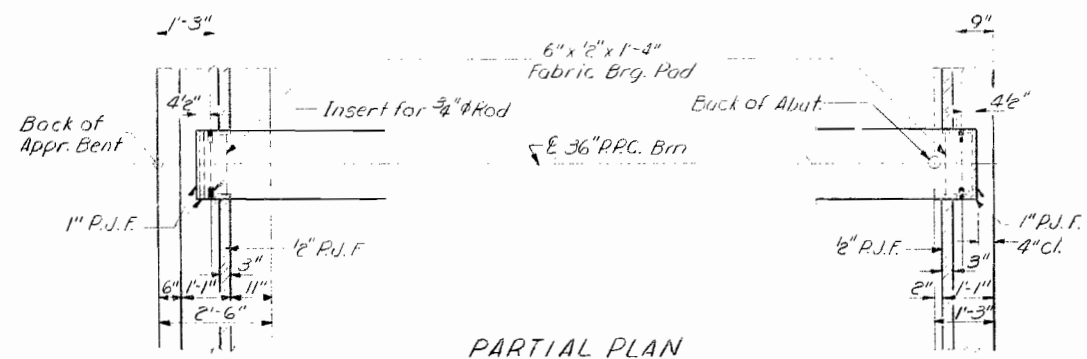

PARTIAL PLAN

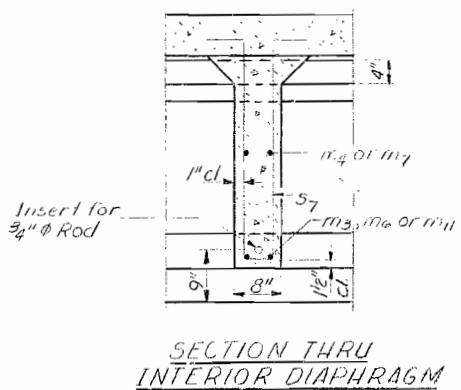

SECTION THRU  
INTERIOR DIAPHRAGM

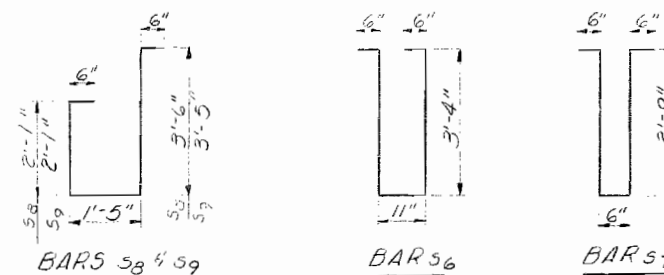










APPROACH BEAMS LAYOUT  
NORTH ED. LANES  
FAI RT 55 SEC. 57-94B  
MCLEAN COUNTY  
STA E97+80.50

DESIGNED	A. J. Whappert
CHECKED	J. M. Patel
DRAWN	Dev Robinson
CHECKED	J. M. B.

OCT. 20 1972  
EXAMINED  
PASSED  
APPROVED  
Richard H. Hoffer  
CHIEF HIGHWAY ENGINEER

STATE OF ILLINOIS  
DEPARTMENT OF TRANSPORTATION

ROUTE NO.	SECTION	COUNTY	TOTAL SHEETS	SHEET NO.	SHEET NO. 21
1.55	57-9HB	MC LEAN	93	42	58 SHEETS
FED. ROAD DIST. NO. 7	ILLINOIS	FED. AID PROJECT			

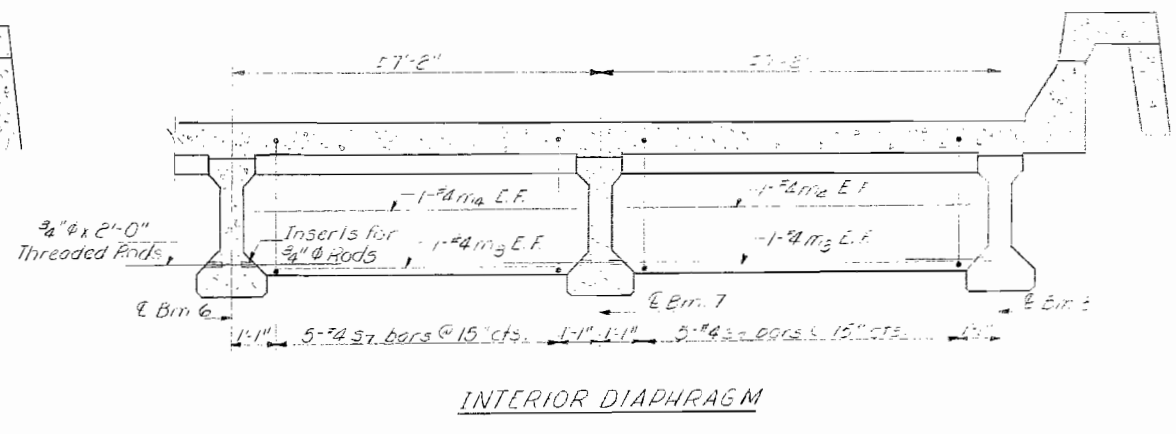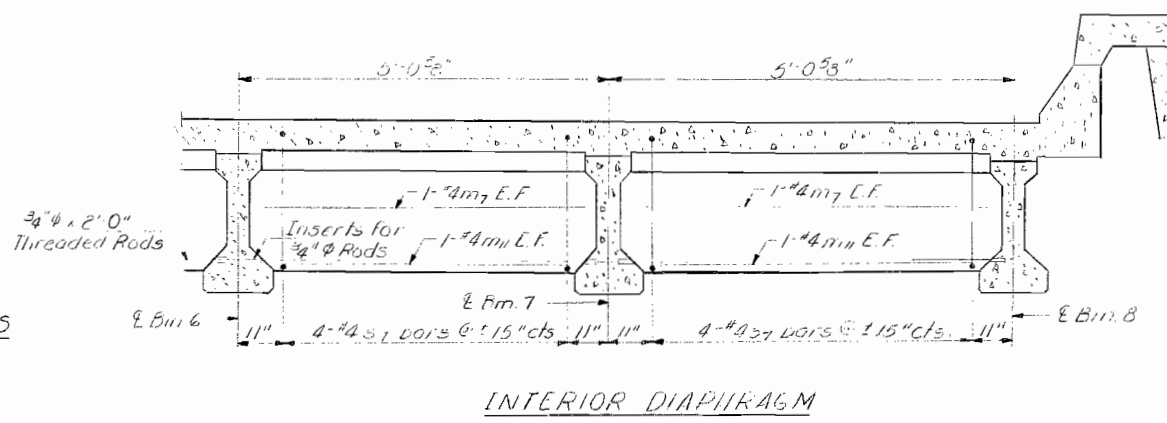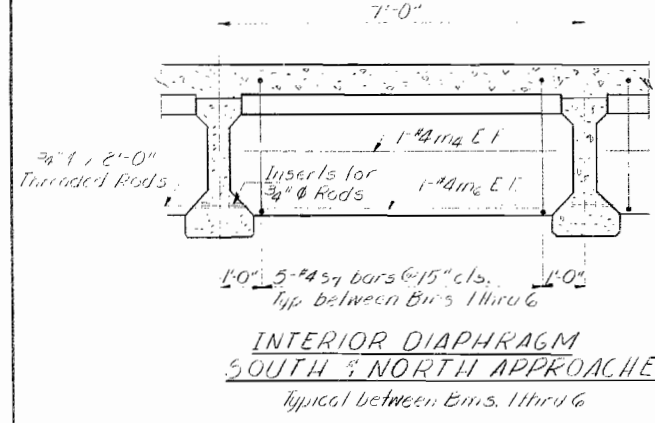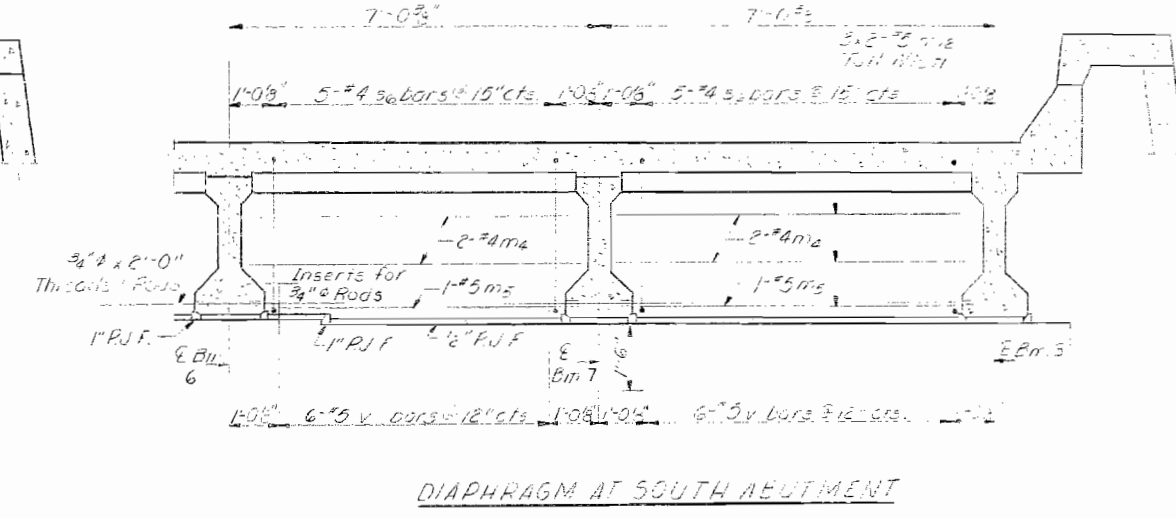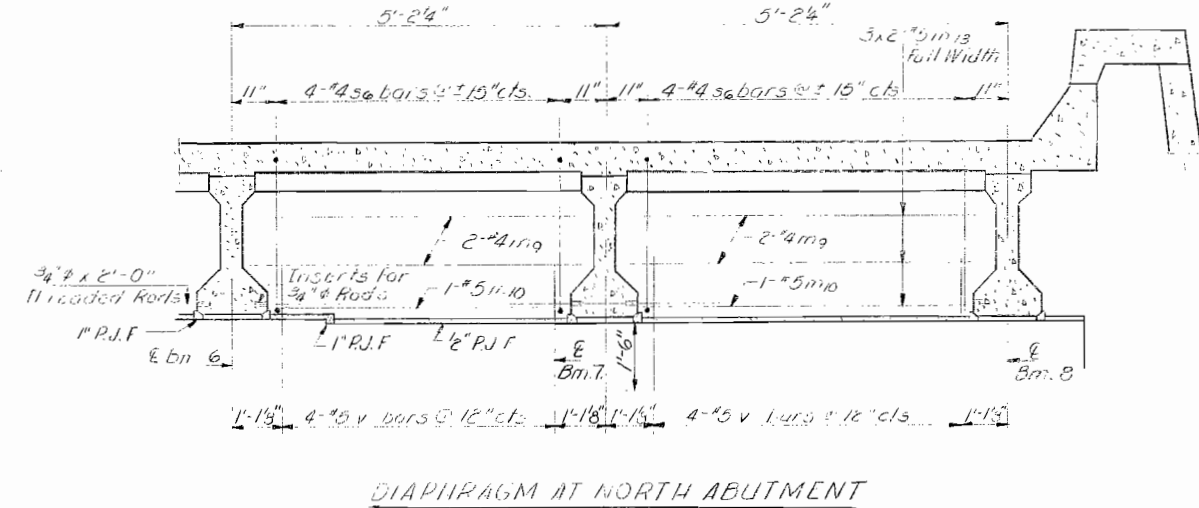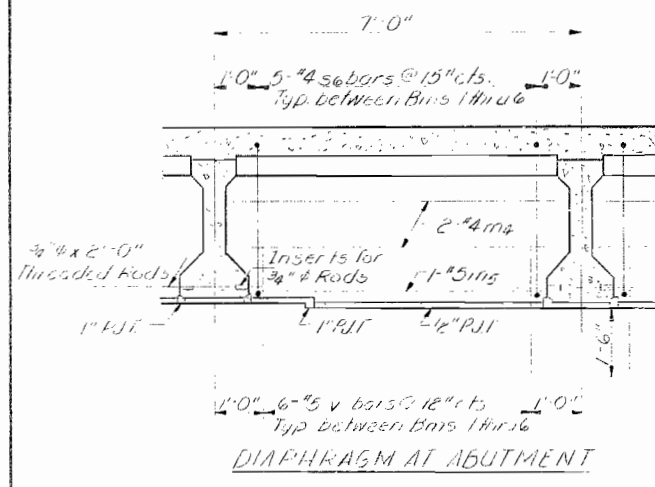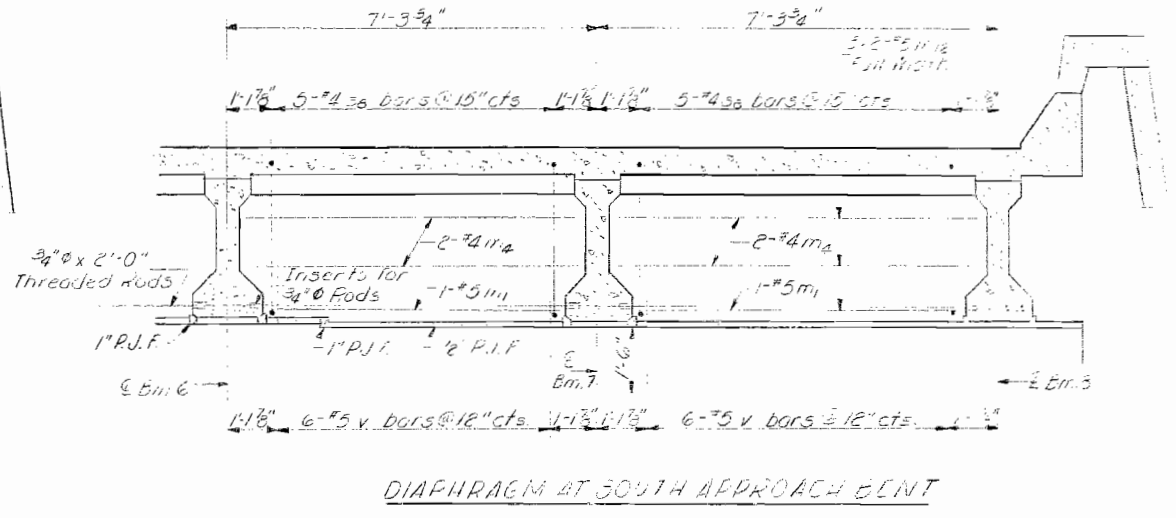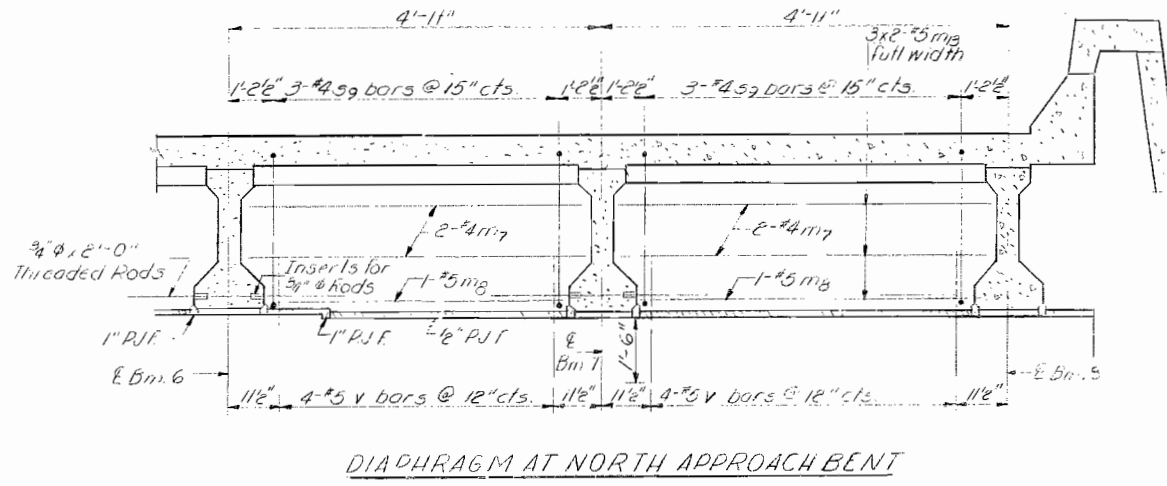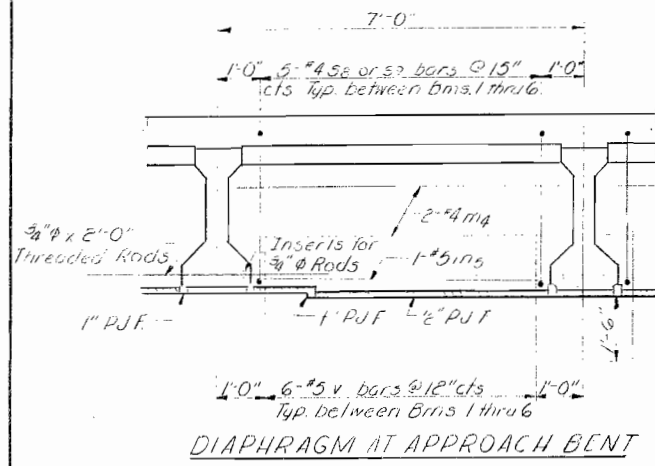

INTERIOR DIAPHRAGM

NORTH APPROACH

Diaphragm details between 6, 7 & 8 only.

INTERIOR DIAPHRAGM

SOUTH APPROACH

Diaphragm details between Beams 6, 7 & 8 only

APPROACH  
DIAPHRAGM DETAILS  
NORTH & SOUTH  
TAI RT 55 SEC 57-9HB  
MCLEAN COUNTY  
STA 297+80.50

DESIGNED	A. J. Marya
CHECKED	J. J. P. J.
DRAWN	Dev Robinson
CHECKED	J. J. P. J.

OCT. 20 1972

EXAMINED

PASSED


APPROVED

W. B. Baumann  
ENGINEER OF DESIGN


Richard H. Hollerbach  
CHIEF HIGHWAY ENGINEER

STATE OF ILLINOIS  
DEPARTMENT OF TRANSPORTATION



ROUTE NO.	SECTION	COUNTY	TOTAL SHEETS	SHEET NO.	SHEET NO.
55	57-9HB	MC-LEAN	93	43	55 SHEETS

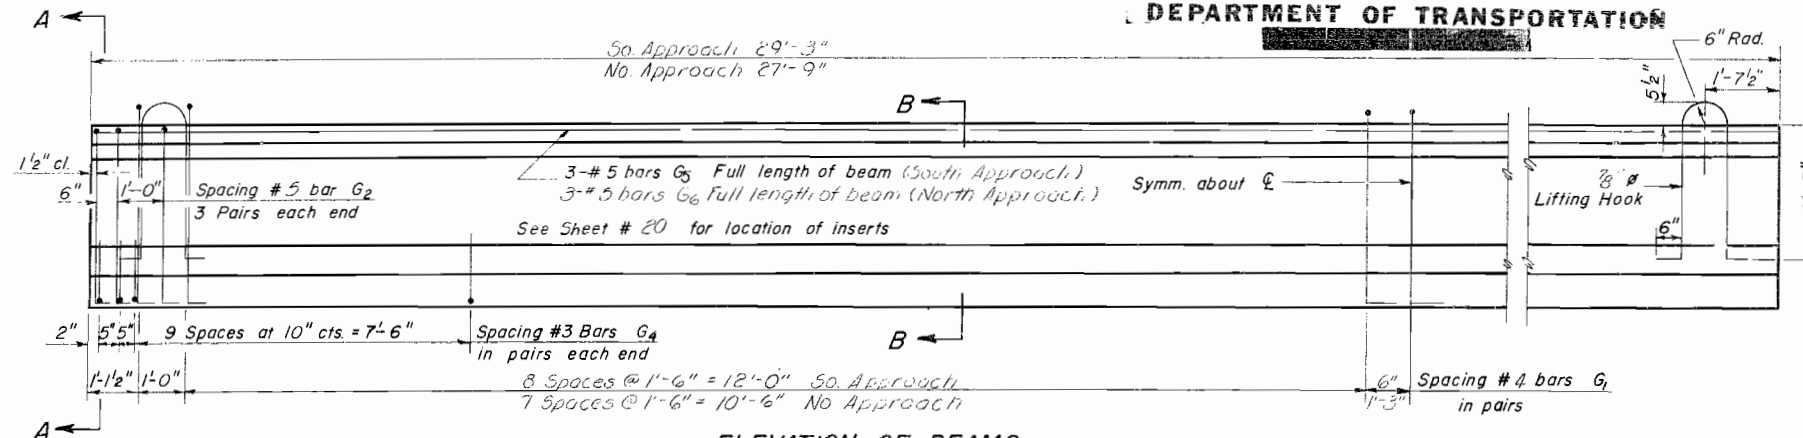

**ELEVATION OF BEAMS**  
Showing Reinforcement & Dimensions

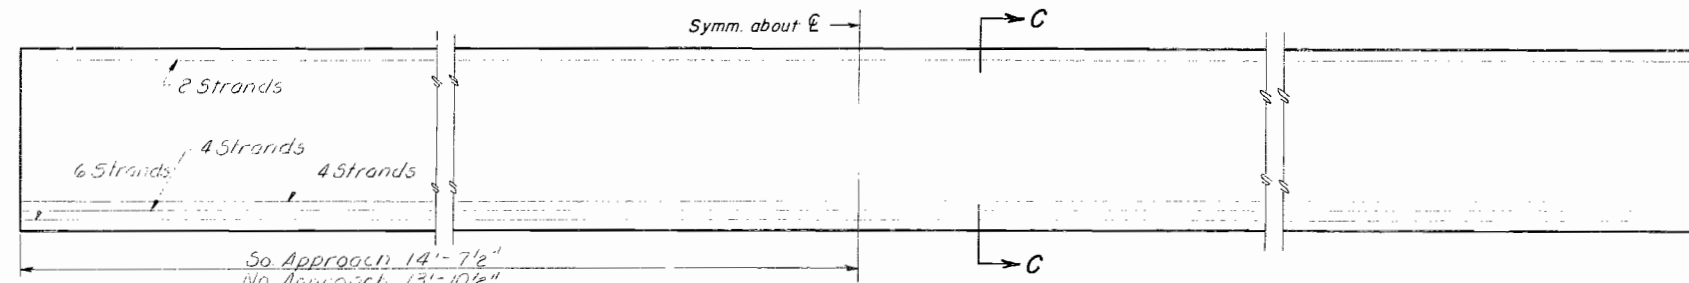

**ELEVATION OF BEAMS**  
Showing Prestressing Steel

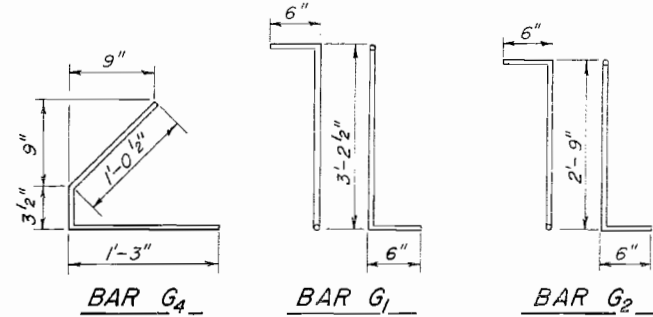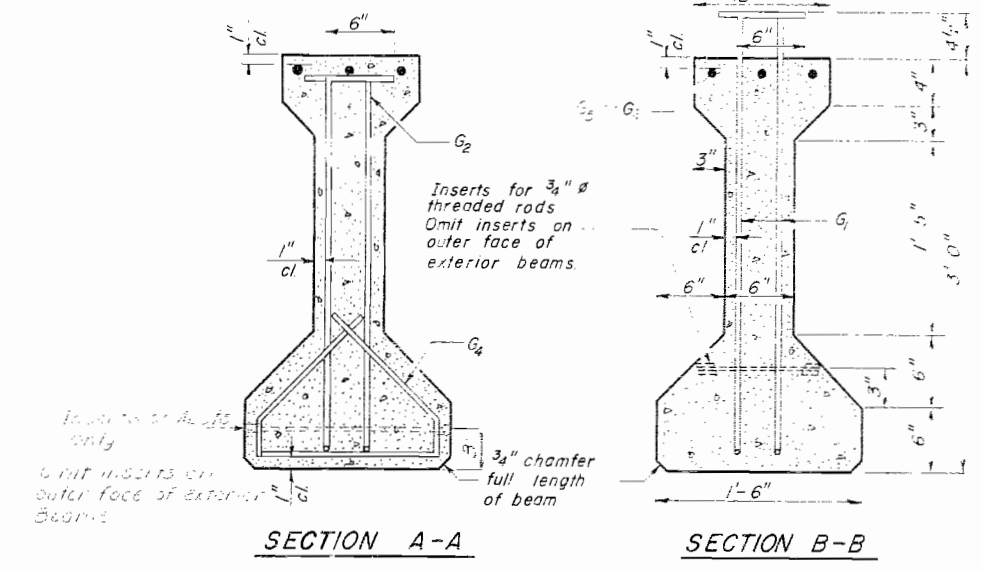

**NOTES**

All inserts and threaded rods for inserts, reinforcing and Prestressing Steel, and other items which are cast into the Precast Concrete I-Beams shall be included in the contract unit price per lineal foot of "Furnishing And Erecting Precast Prestressed Concrete I-Beams, 36 In."

Prestressing Steel shall have a nominal diameter of 7/16"  
Inserts for 3/4"  $\phi$  threaded rods are to be two strut, coil type for interior I-Beams and single coil, flared loop type for exterior I-Beams.  
Steel for lifting hooks shall be non-deformed bars

\* For the team only

**TWO APPROACHES**

**BILL OF MATERIAL**

Item	Unit	Total
Furnishing & Erecting Precast Prestressed Concrete I-Beams, 36"	Lin. Ft.	100


Item	Unit	Total
Furnishing & Erecting Precast Prestressed Concrete I-Beams, 36"	Lin. Ft.	100

DESIGNED <i>J. J. Maggart</i>	EXAMINED <i>[Signature]</i> OCT 20 1972
CHECKED <i>J. G. B. W.</i>	PASSED <i>[Signature]</i>
DRAWN <i>T.B. Fuller</i>	APPROVED <i>Richard H. Holterman</i>
CHECKED <i>[Signature]</i>	

NORTH ED LANE  
55 AND NO. APPROACH BLVD.  
FAI ET 55 SEC 27-9-E  
MCLEAN COUNTY  
I74 297-3333


STATE OF ILLINOIS  
DEPARTMENT OF TRANSPORTATION

ROUTE NO. P.A.L. 55	SECTION 57-9HB	COUNTY MC LEAN	TOTAL SHEETS 93	SHEET NO. 44	SHEET NO. 2 OF 58 SHEETS
FED. ROAD DIST. NO. 7		ILLINOIS	FED. AID PROJECT		

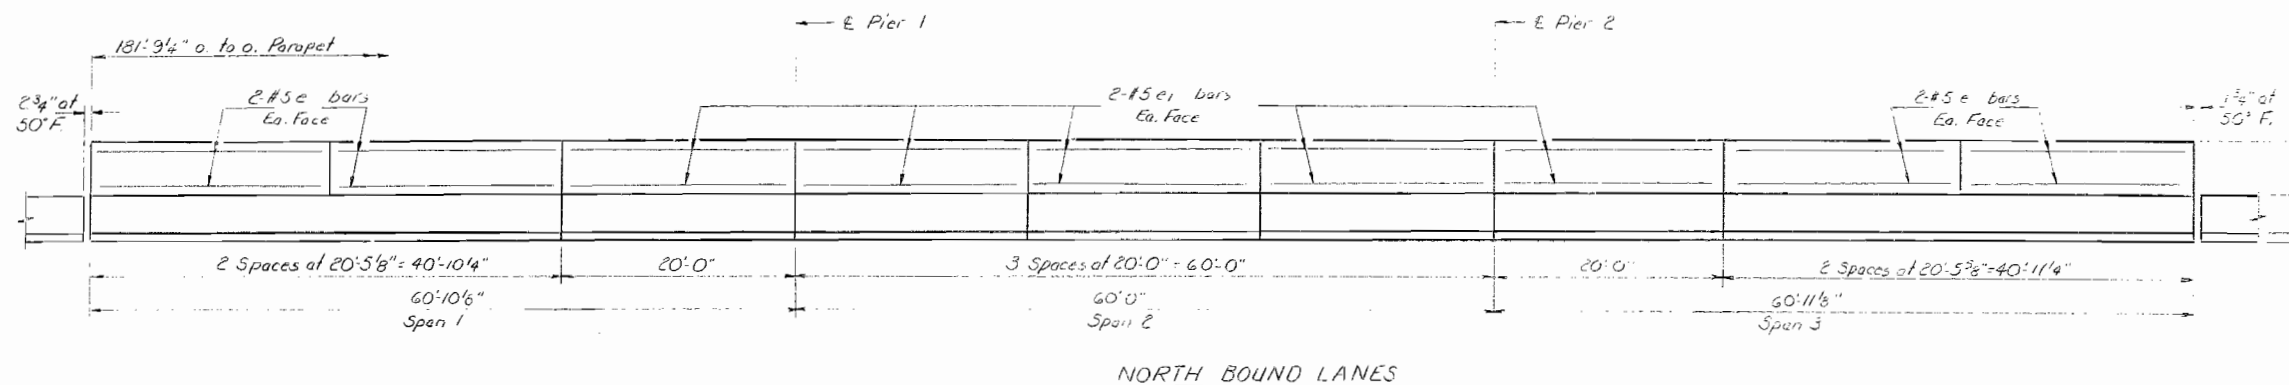


South Abutment

North Abutment

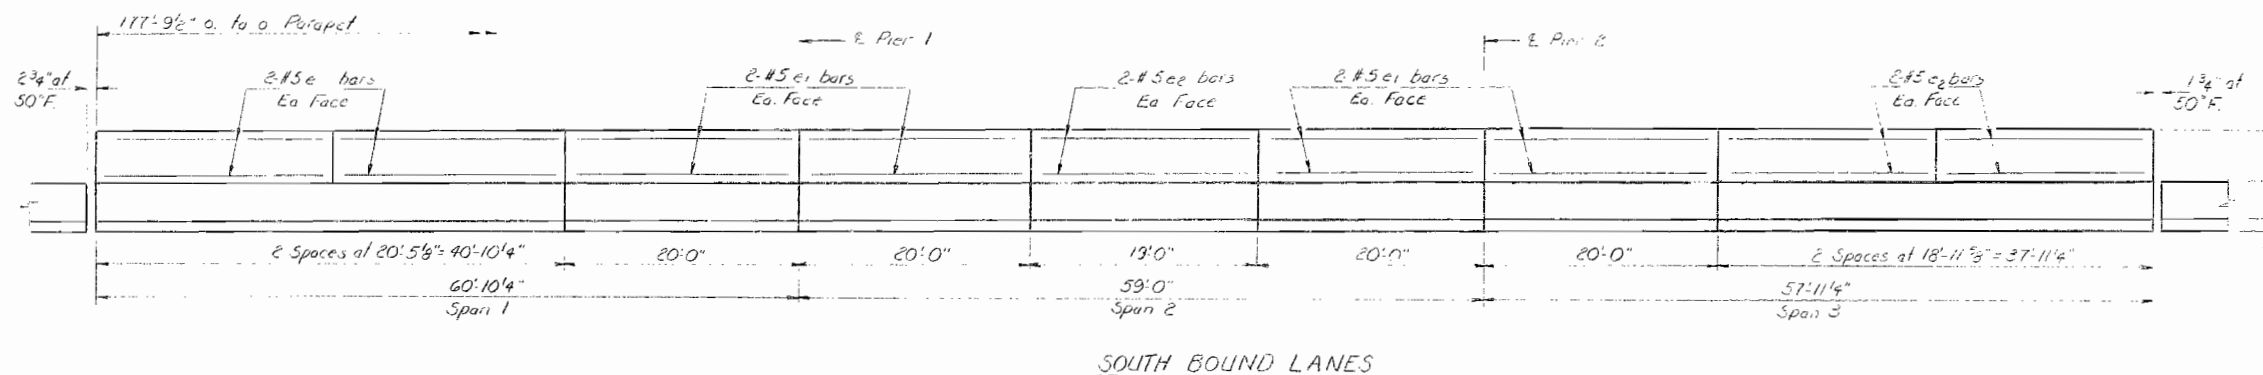

INSIDE ELEVATION

Two component non-staining gray sealing compound with polysulfide liquid polymers - gun grade with primer.

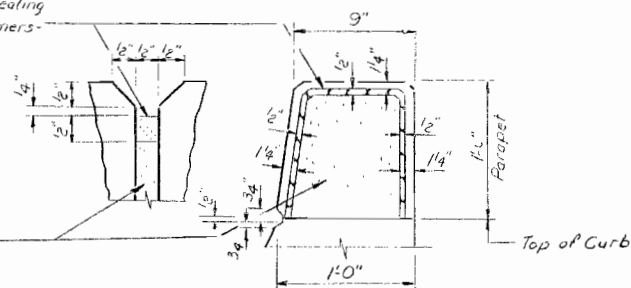

1/2" Preformed Cork Asphalt Joint Filler. (meets qualifications for ASTM: Designation D 1751) Cast incidental.

PARAPET JOINT DETAIL

BILL OF MATERIAL

Bar	No	Size	Length	Weight	
	45	#5	20'-2"		
	72	#5	19'-9"		
	24	#5	16'-8"		
Class A Concrete				Cu. Yds	55.7
Reinforcement Bars				Lbs.	2825


DESIGNED	<i>A. J. H. [Signature]</i>
CHECKED	<i>[Signature]</i>
DRAWN	<i>J. C. Lindsey</i>
CHECKED	<i>[Signature]</i>

EXAMINED	<i>[Signature]</i> OCT. 20 1972
PASSED	<i>[Signature]</i>
APPROVED	<i>[Signature]</i> CHIEF HIGHWAY ENGINEER

PARAPET  
FAI RT. 55 SEC. 57-9 HB  
MC LEAN COUNTY  
STA. 297+80.50


STATE OF ILLINOIS  
DEPARTMENT OF TRANSPORTATION

ROUTE NO.	SECTION	COUNTY	TOTAL SHEETS	SHEET NO.	SHEET NO.
P.A.L. 55	57-9HB	MC LEAN	93	45	58 SHEETS
FED. ROAD DIST. NO. 7		ILLINOIS	FED. AID PROJECT		

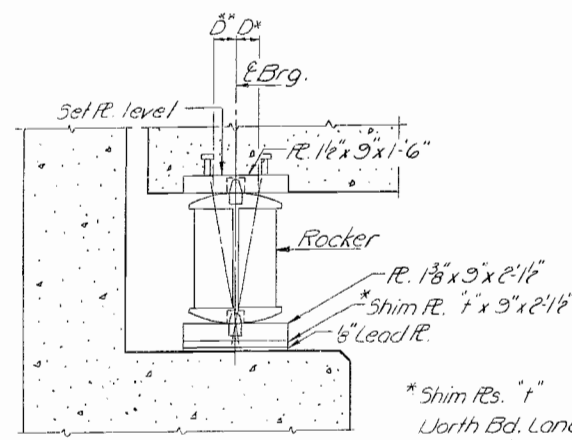

ELEVATION

\* Shim R's. "t"  
North Bd. Lanes  
No. Abut. So. Abut. & Pier 2 - 3/8" R. Beam 3 only  
South Bd. Lanes  
No. Abut. So. Abut. & Pier 2 - 3/8" R. Beam 6 only.

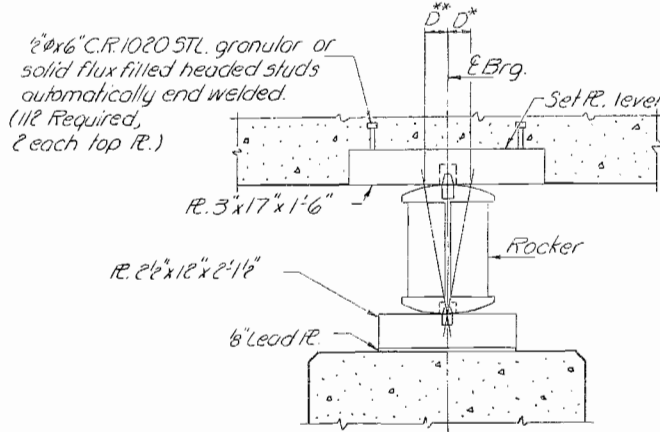


ELEVATION


2" x 6" C.R. 1020 STL granular or solid flux filled headed studs automatically end welded.  
(11# Required, 2 each top R.)

NOTES FOR POSITIONING OF TOP R. AT EXPANSION BEARINGS


D\* (Side of bearing toward fixed bearing)  
D\* = 1/8" per each 100' of expansion for every 15° fall below normal Temp. of 50°F  
D\*\* (Side of bearing away from fixed bearing)  
D\*\* = 1/8" per each 100' of expansion for every 15° rise above the normal Temp. of 50°F

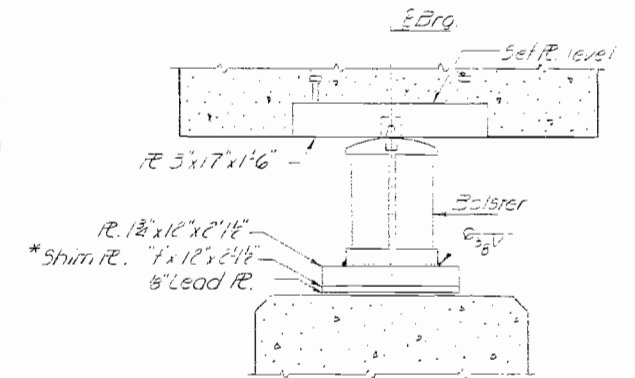


ELEVATION

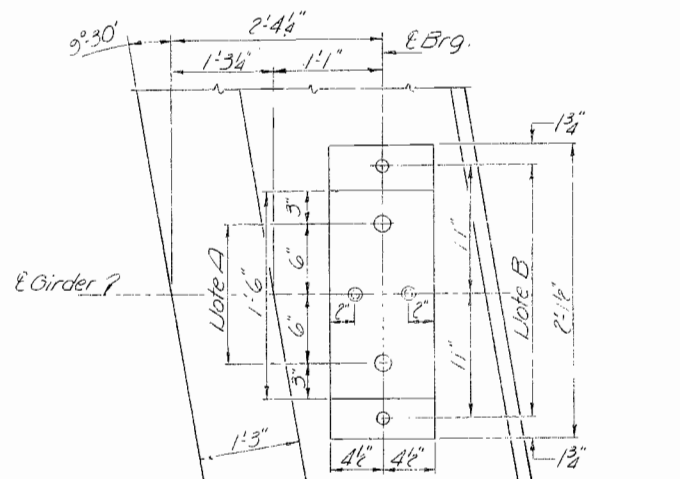


PLAN-ABUTMENT-SO. BD. LANES

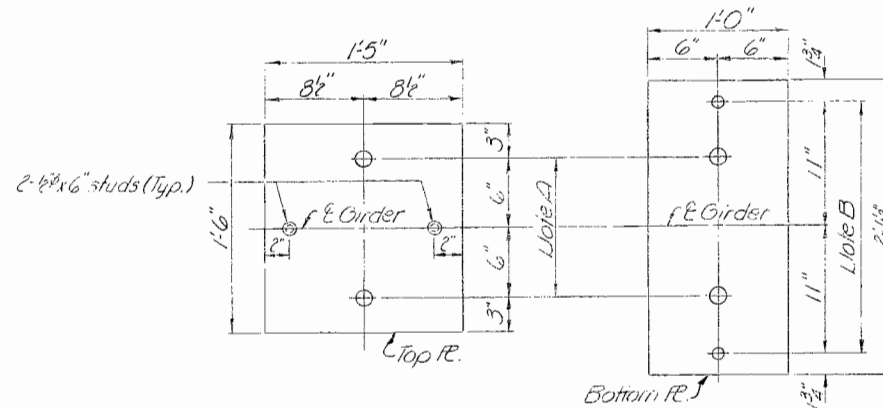


PLAN  
PIER 1

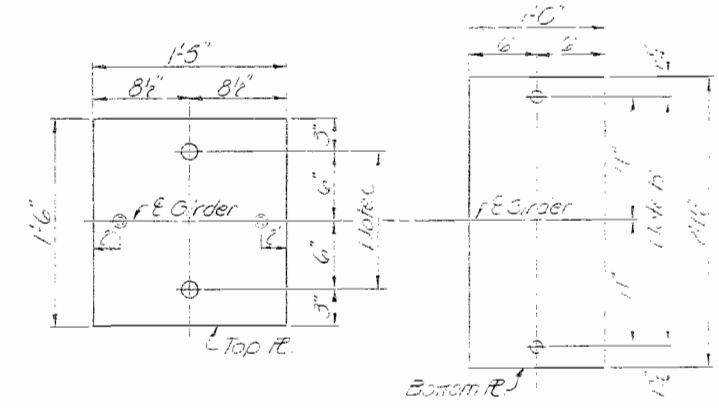

PLAN  
PIER 2

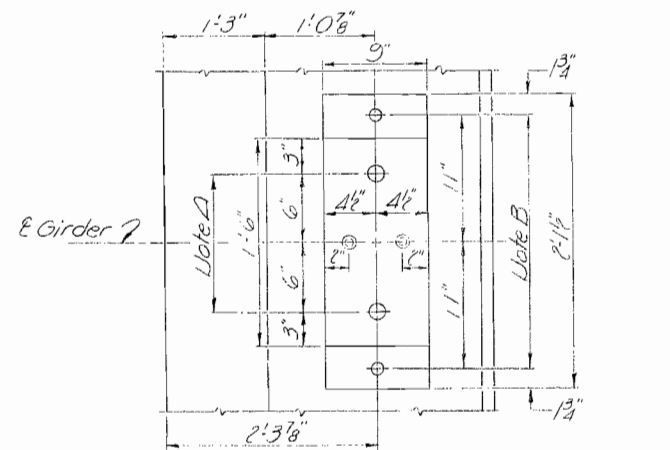

PLAN-ABUTMENT-NO. BD. LANES

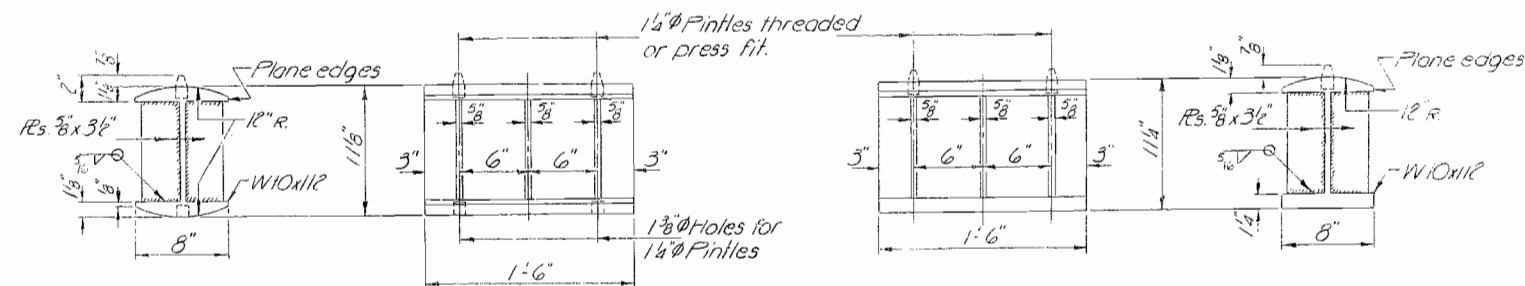

ROCKER

BOLSTER



PINTLE

DESIGNED	J. M. P.
CHECKED	J. M. P.
DRAWN	J. D.
CHECKED	J. M. P.

EXAMINED	Richard Z. Holterman
PASSED	Richard Z. Holterman
APPROVED	Richard Z. Holterman

Note A  
1 1/2" Holes - 1" deep in top R. for pintles.  
Thread or press fit pintles into bottom R.

Note B  
1 1/4" Holes for 1" x 1/4" anchor bolts.  
3/16" x 2 1/2" x 2 1/2" R. Washers under nut.


Note C  
1 1/8" Holes 1" deep in top R. only for 1 1/4" pintles.

BEARING DETAILS  
P.A.L. RT. 55 SEC. 57-9HB  
MC LEAN COUNTY  
STA. 297+80.50



STATE OF ILLINOIS  
DEPARTMENT OF TRANSPORTATION

ROUTE NO.	SECTION	COUNTY	TOTAL SHEETS	SHEET NO.	SHEET NO. 25
55	57-9HB	MC LEAN	93	46	58 SHEETS
FED. ROAD DIST. NO. 7	ILLINOIS	FED. AID PROJECT			

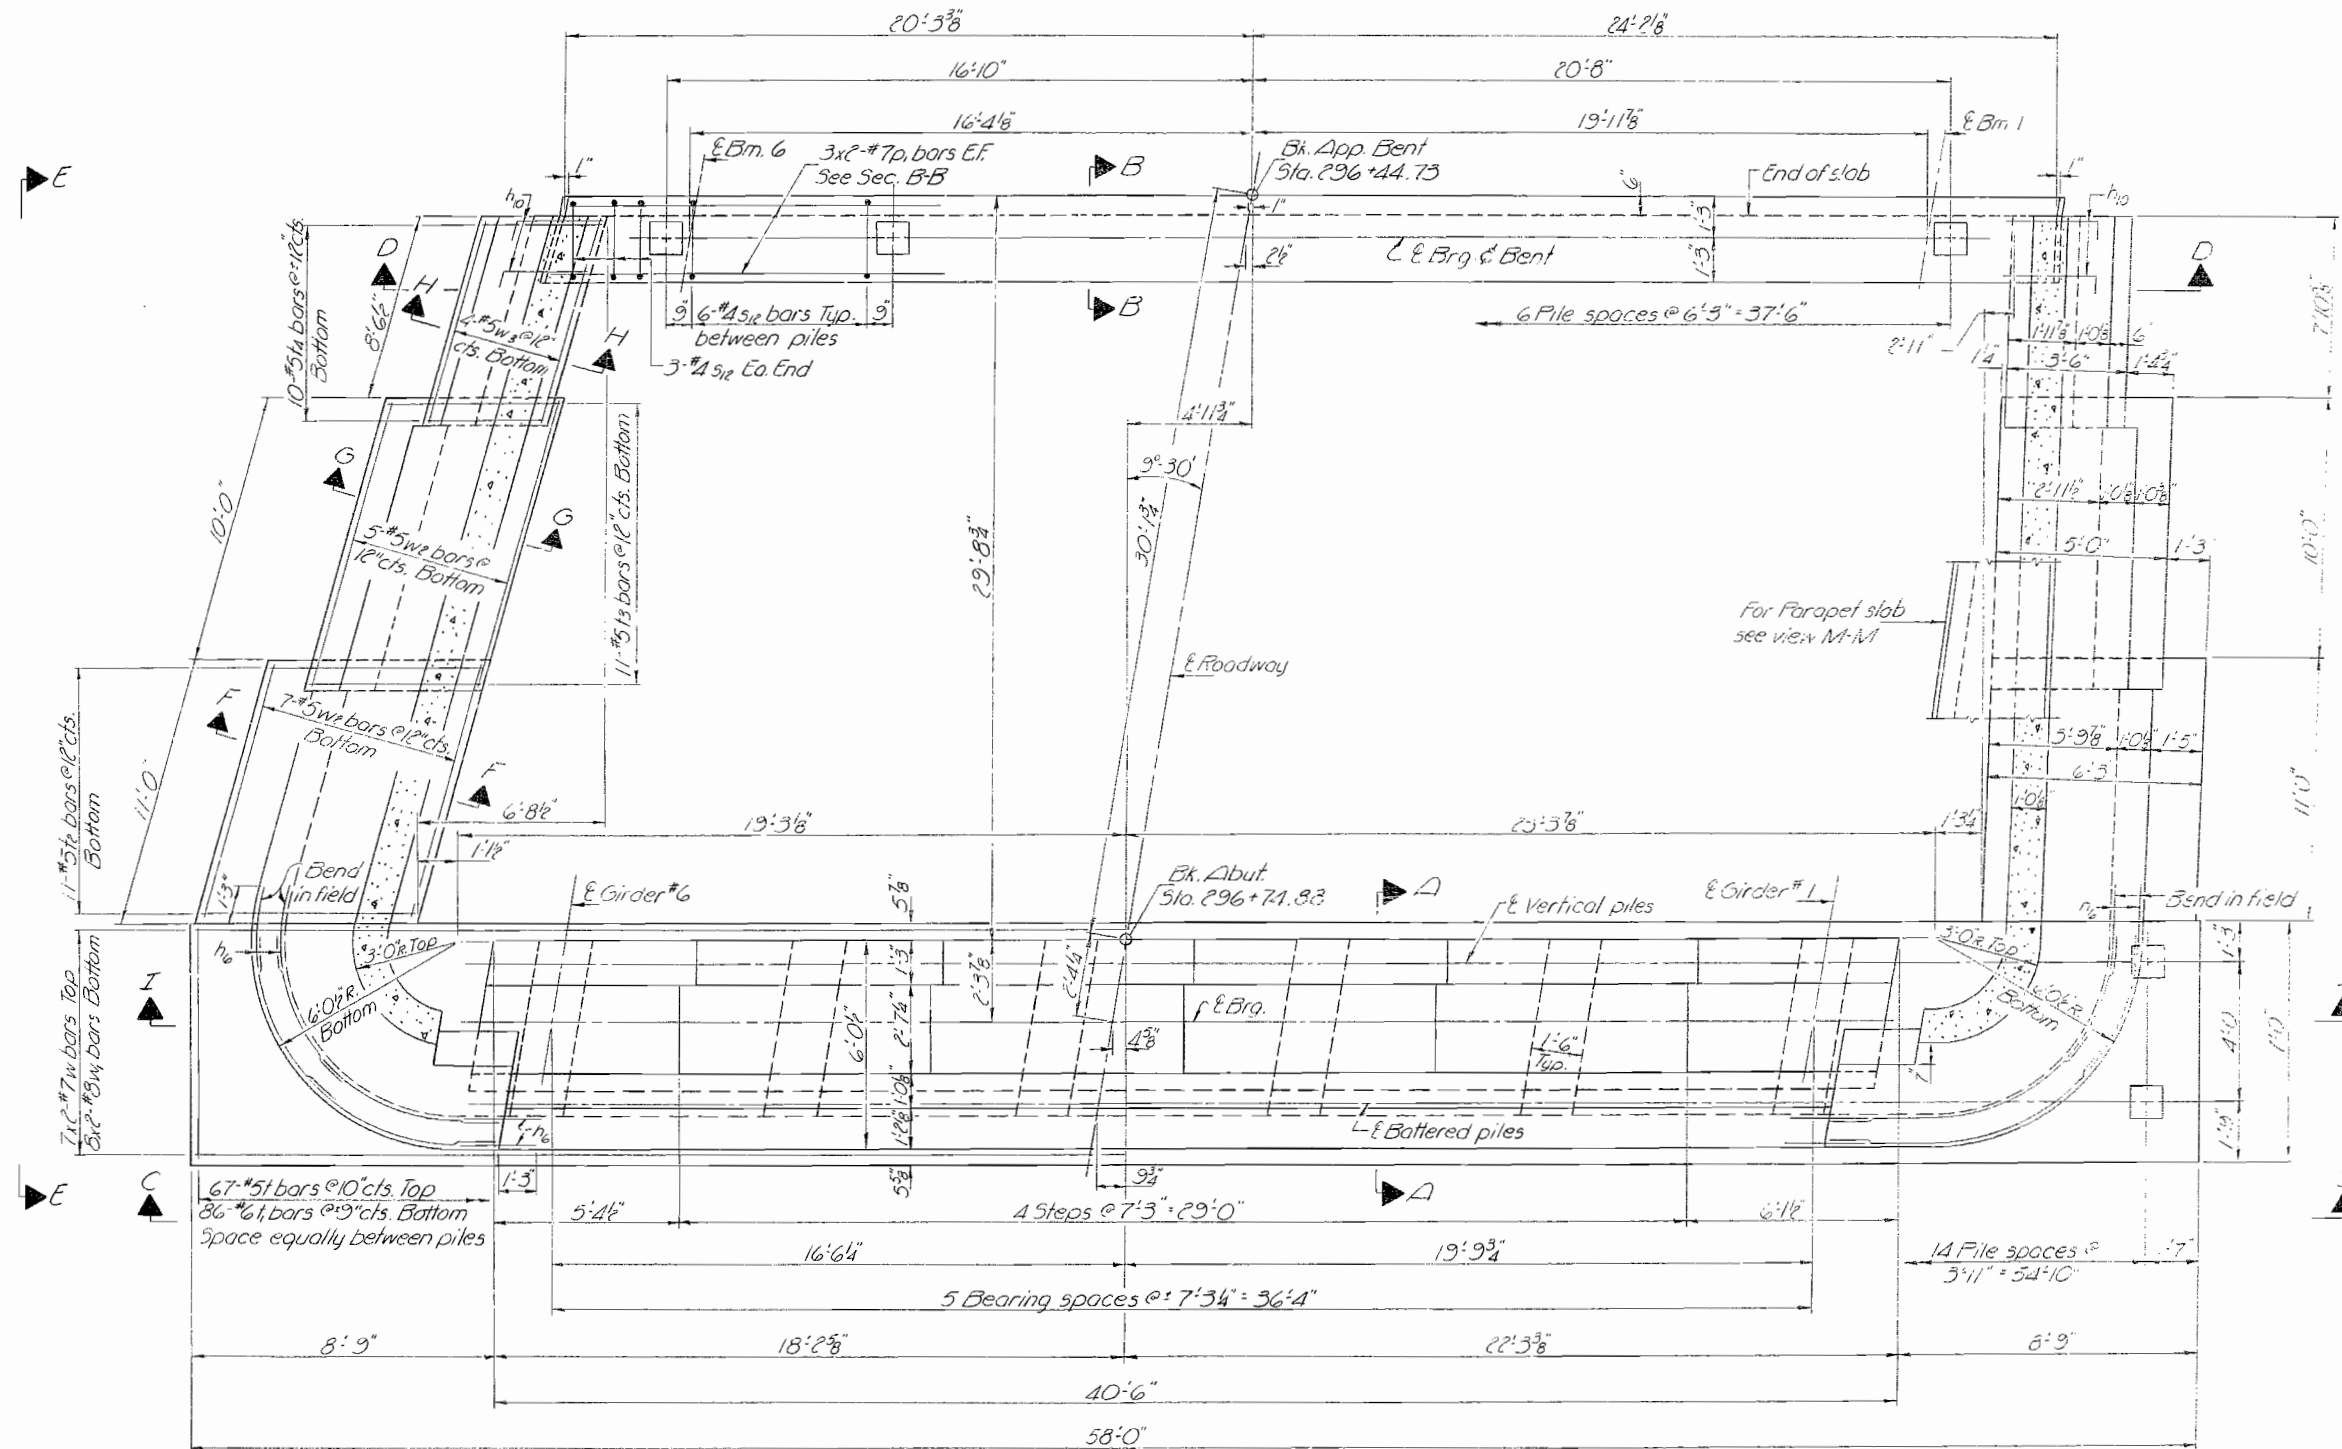

PLAN

DESIGNED	J. M. Pate
CHECKED	J. M. Pate
DRAWN	J. D.
CHECKED	J. D.


OCT. 20 1972  
 EXAMINED  
 PASSED  
 APPROVED  
 Chief Highway Engineer

Note:  
Work this sheet with sheets # 26, 27 & 28.


SOUTH ABUTMENT  
SOUTH BRIDGE LAUES  
F&I RT 55 SEC 57-9HB  
MC LEAN COUNTY  
STA. 297+80.50

STATE OF ILLINOIS  
DEPARTMENT OF TRANSPORTATION


ROUTE NO.	SECTION	COUNTY	TOTAL SHEETS	SHEET NO.
57-94B	MC LEAN	93	47	58 SHEETS
SHEET NO. 22				

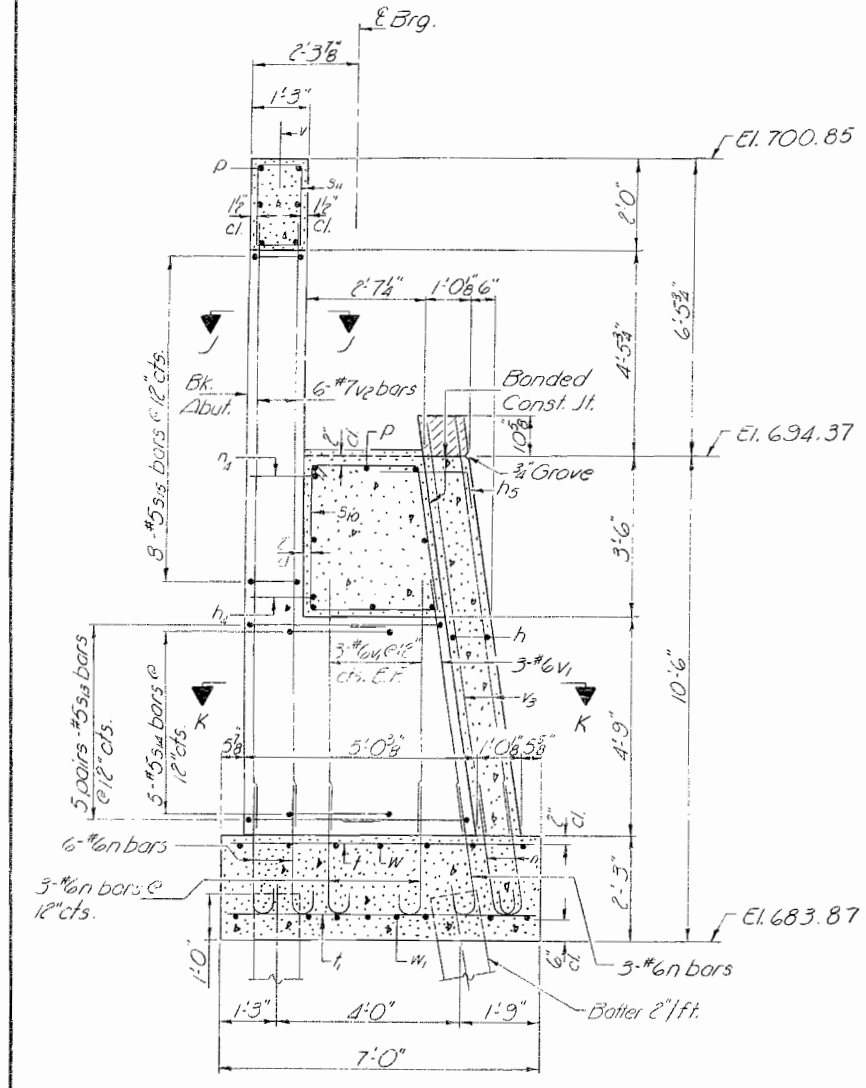


SEC. A-A

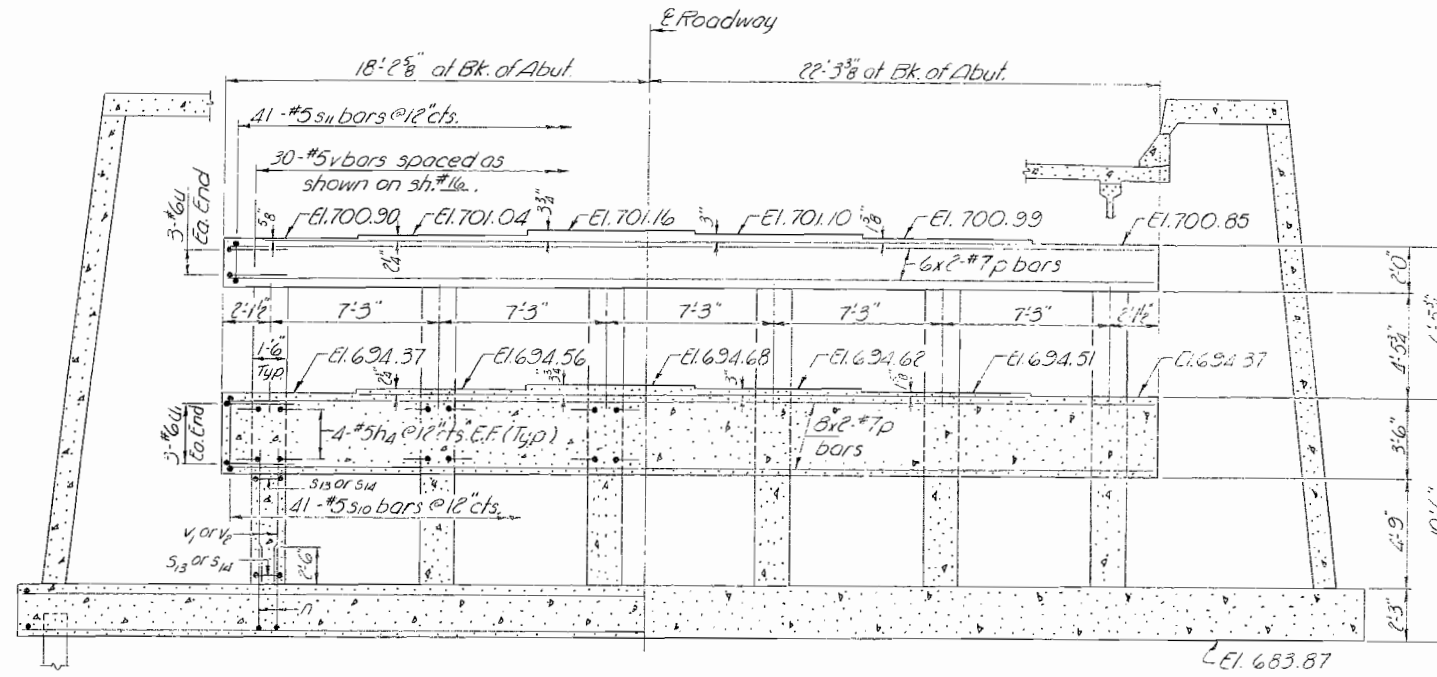

SECTION I-I

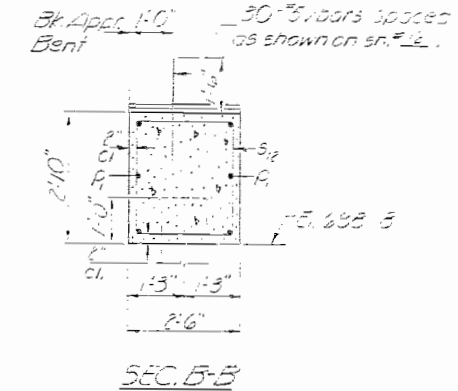


SEC. B-B

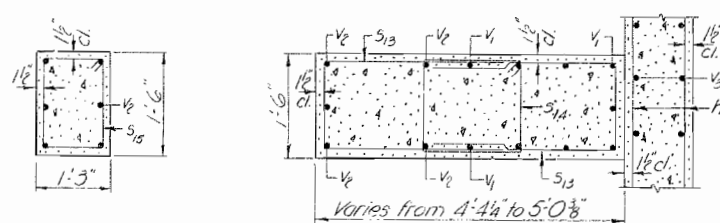

SEC. J-J

SEC. K-K

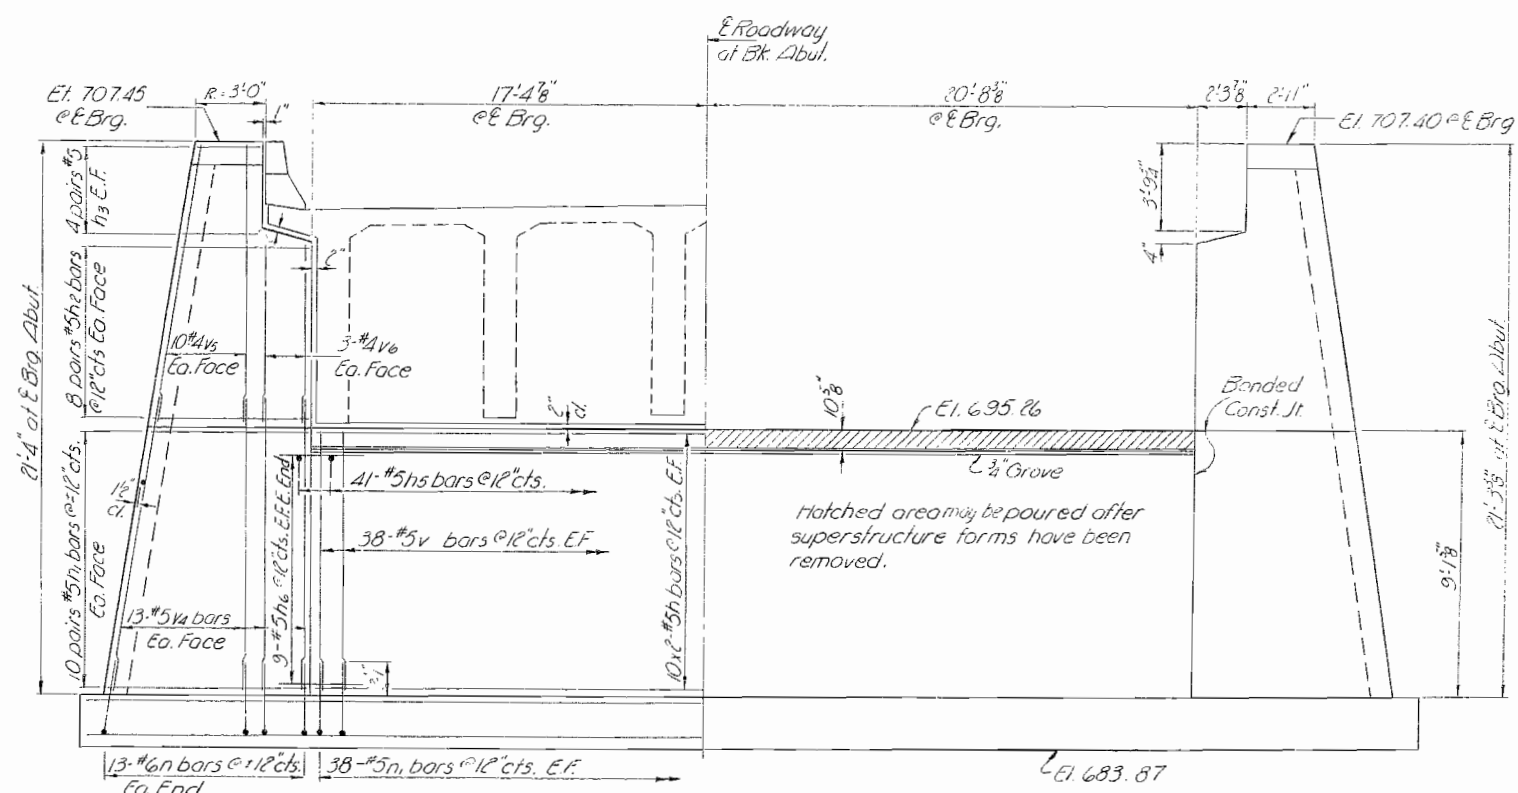

VIEW C-C


DESIGNED	J. J. [Signature]
CHECKED	J. J. [Signature]
DRAWN	J.D.
CHECKED	J. J. [Signature]

OCT 20 1972  
EXAMINED [Signature]  
PASSED [Signature]  
APPROVED [Signature]  
CHIEF HIGHWAY ENGINEER


SOUTH ABUTMENT  
SOUTH BD. LAJES  
F.D.I. RT. 55 SEC. 57-94B  
MC LEAN COUNTY  
STA. 297+80.50

STATE OF ILLINOIS  
DEPARTMENT OF TRANSPORTATION


ROUTE NO.	SECTION	COUNTY	TOTAL SHEETS	SHEET NO.	SHEET NO.
1. 55	57-9NB	MC LEAN	93	48	58 SHEETS
FED. ROAD DIST. NO. 7	ILLINOIS	FED. AID PROJECT			

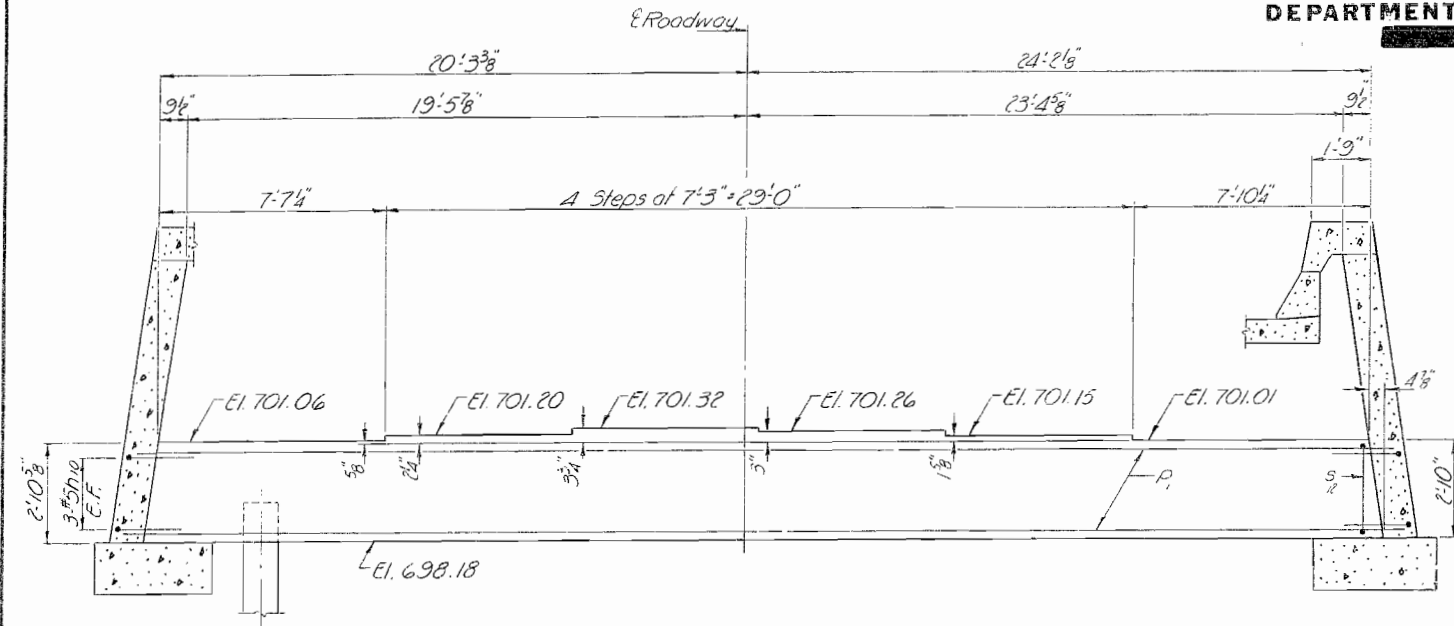


VIEW D-D

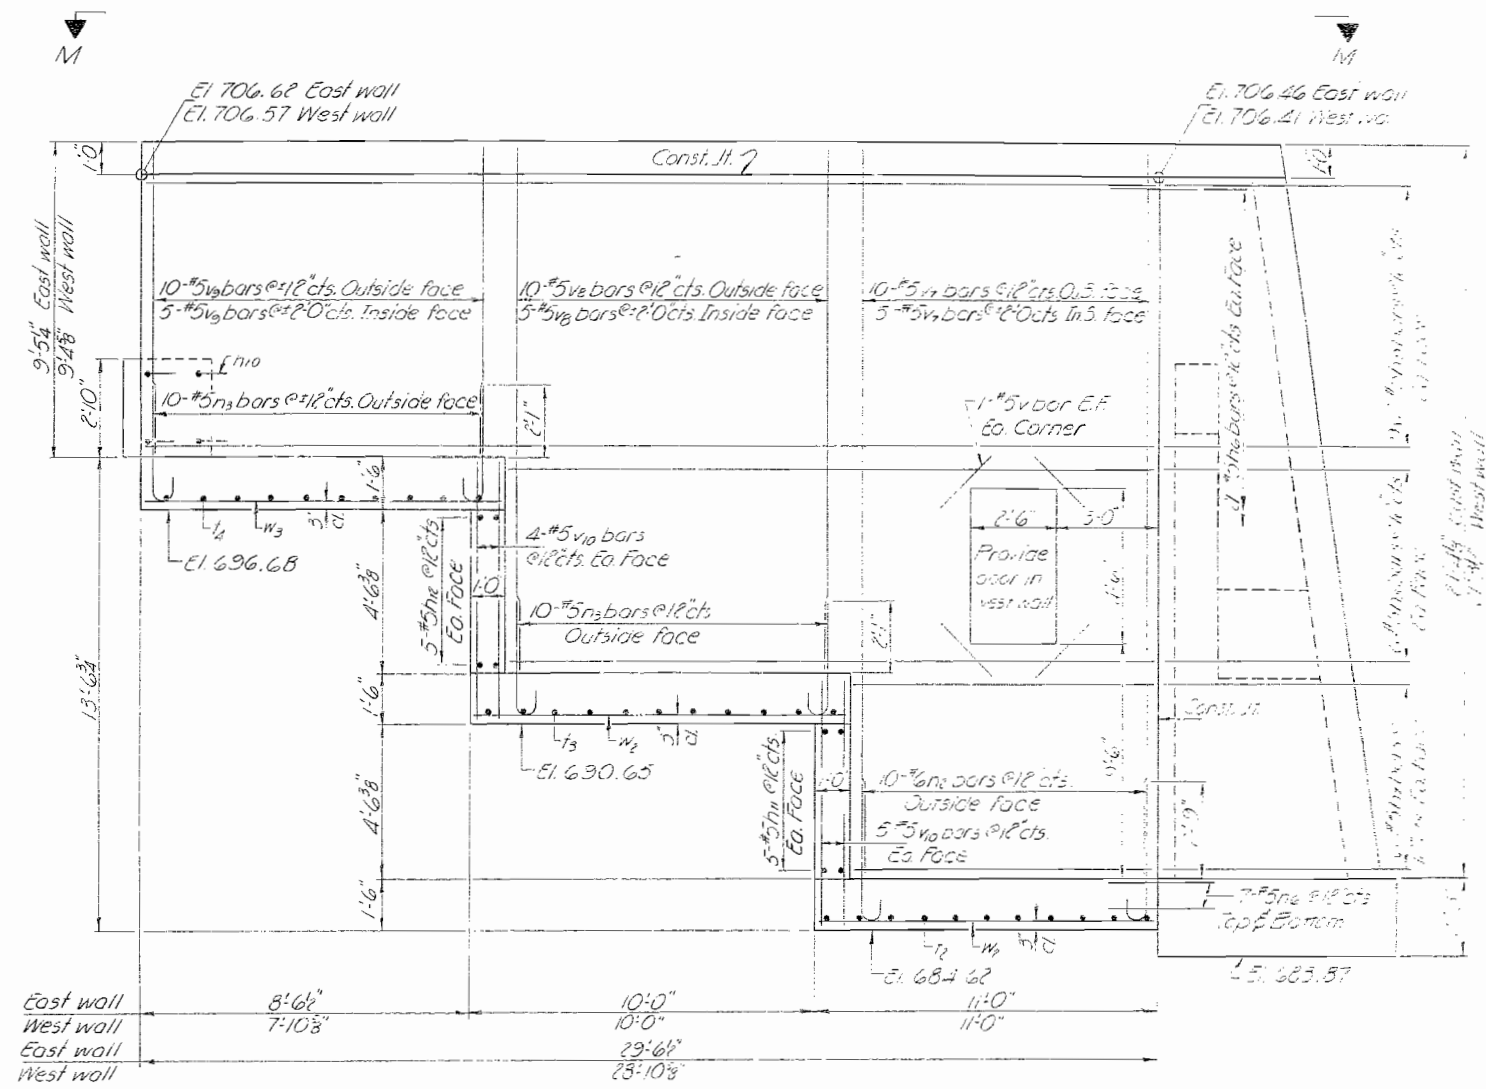


VIEW E-E

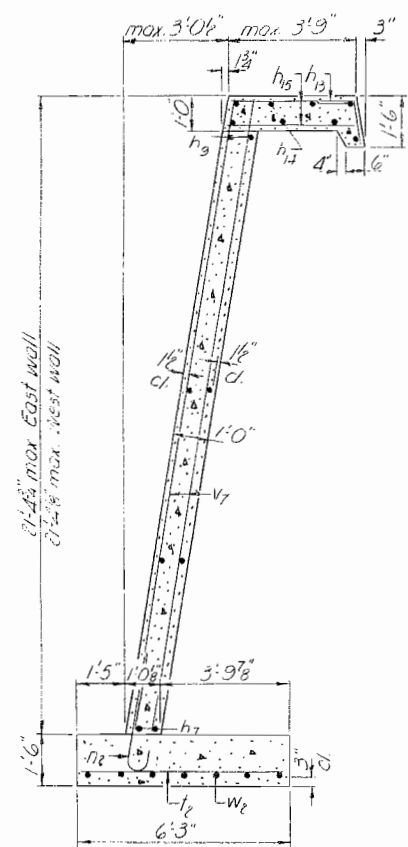


SEC. F-F

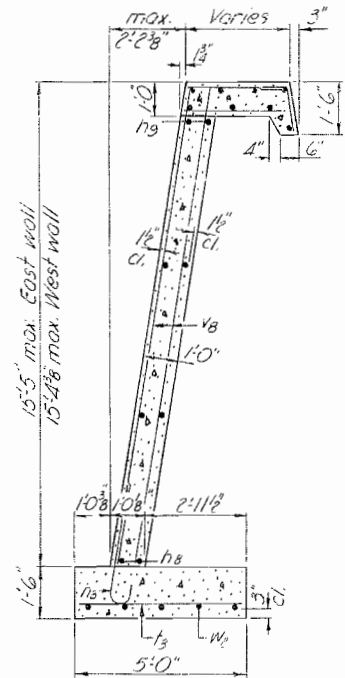


SEC. G-G

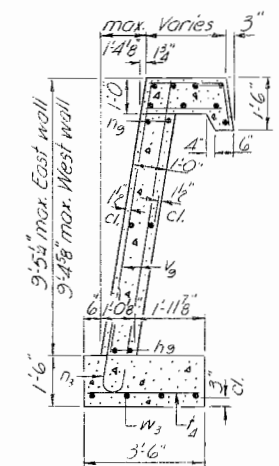

SEC. H-H

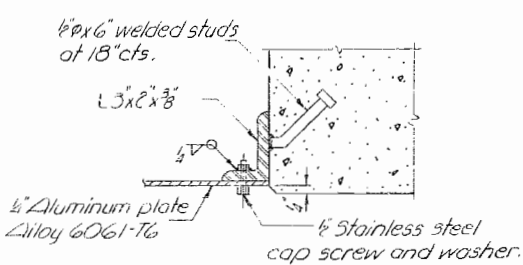

SEC. L-L

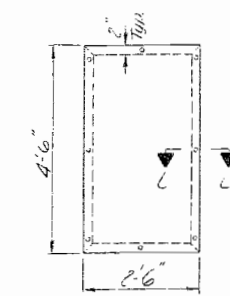

DOOR ELEVATION  
(Cost of door & frame are incidental)

NOTE:  
DOOR TO BE SET WITH BRACKETS TO BE SUPPLIED BY CONTRACTOR AND WELDED BARS TO BE AS NECESSARY.

SOUTH ABUTMENT  
SOUTH BD. LAUES  
FAIRFAX SEC 57-9NB  
MC LEAN COUNTY  
STA. 237+80.50


DESIGNED	J. J. Miller
CHECKED	J. J. Miller
DRAWN	J.D.
CHECKED	J.D.

EXAMINED	2/27/76
PASSED	J. J. Miller
APPROVED	Richard J. Miller

STATE OF ILLINOIS  
DEPARTMENT OF TRANSPORTATION

ROUTE NO.	SECTION	COUNTY	TOTAL SHEETS	SHEET NO.
155	57-9MB	MC LEAN	93	49
FED. ROAD DIST. NO. 7		ILLINOIS	FED. AID PROJECT	

SHEET NO. 49  
58 SHEETS

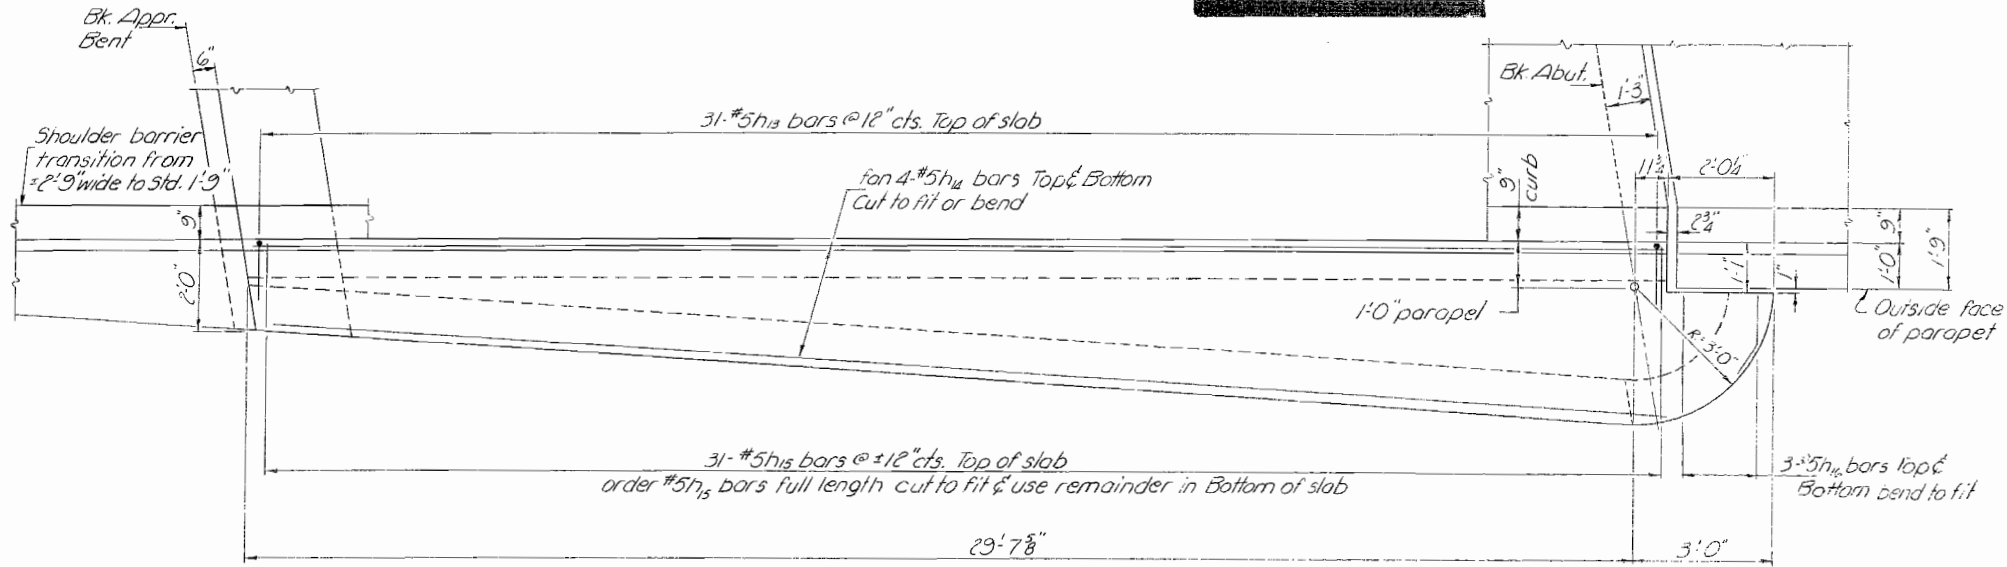

VIEW M-M

Showing reinforcement in slab above walls  
Typ. for both walls

APPR. BENT  
PILE DATA

Type: Concrete  
Capacity: 35 Tons  
Est. Length: 37'  
No. Required: 7

ABUTMENT  
PILE DATA


Type: Concrete  
Capacity: 35 Tons  
Est. Length: 23'  
Including 1 Test pile

BILL OF MATERIAL

Bar	Uo.	Size	Length	Grade
n	40	#5	19'-8"	---
r	80	#5	7'-0"	---
n2	6	#5	6'-0"	---
n3	32	#5	3'-0"	---
n4	48	#5	2'-2"	---
n5	41	#5	2'-8"	---
n6	148	#5	2'-0"	---
n7	24	#5	9'-3"	---
n8	24	#5	18'-9"	---
n9	72	#5	15'-3"	---
n10	12	#5	2'-6"	---
n11	20	#5	4'-3"	---
n12	20	#5	3'-3"	---
n13	62	#5	2'-6"	---
n14	16	#5	32'-3"	---
n15	62	#5	3'-3"	---
n16	12	#5	2'-2"	---
r	142	#6	2'-11"	---
r	76	#5	2'-5"	---
r2	20	#6	2'-3"	---
r3	40	#5	3'-1"	---
r	28	#7	21'-3"	---
r2	6	#7	34'-2"	---
s1	41	#5	12'-3"	---
s1	41	#5	2'-2"	---
s2	42	#4	10'-1"	---
s3	60	#5	7'-5"	---
s4	30	#5	7'-6"	---
s5	48	#5	3'-2"	---
r	67	#5	6'-5"	---
r	86	#6	2'-3"	---
r2	22	#5	2'-0"	---
r3	22	#5	2'-8"	---
r4	20	#5	3'-2"	---
u	6	#6	5'-1"	---
u	6	#6	7'-2"	---
v	68	#5	3'-0"	---
v1	54	#6	6'-5"	---
v2	36	#7	12'-5"	---
v3	76	#5	8'-10"	---
v4	52	#5	2'-3"	---
v5	20	#4	11'-0"	---
v6	2	#4	7'-9"	---
v7	30	#5	2'-2"	---
v8	30	#5	3'-0"	---
v9	36	#5	7'-3"	---
w	4	#7	30'-2"	---
w1	16	#8	30'-6"	---
w2	24	#5	12'-3"	---
w3	8	#5	2'-2"	---
Class X Concrete	cu. Yds.	153.9		
Reinforcement Bars	Lbs.	10570		
Concrete Piles	Lin. Ft.	1506		
Test Piles (Concrete)	Ess.			


4'-3"	6" n
5'-0"	7" n
4'-0"	5" n2
3'-2"	7" n3

BARS n thru n3

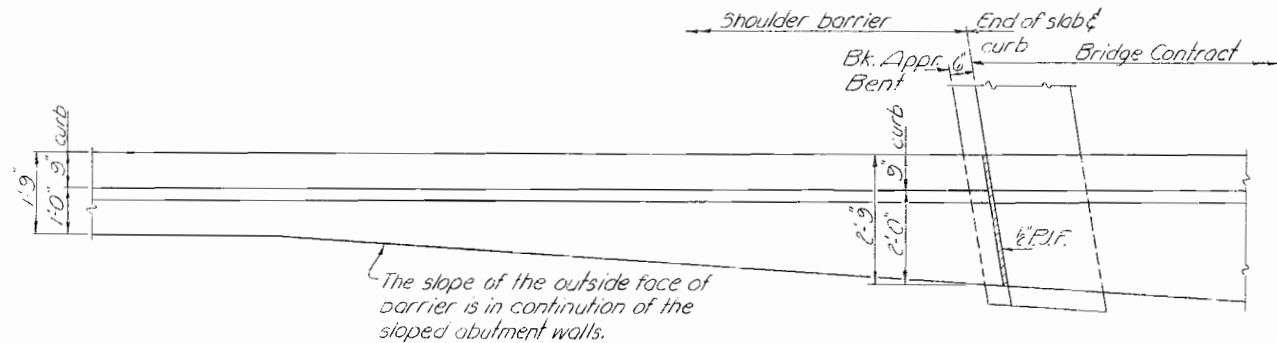


PLAN


Showing transition of shoulder barrier

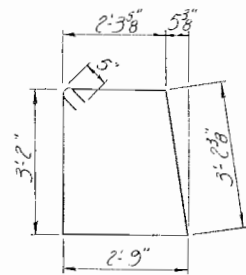


BAR S10

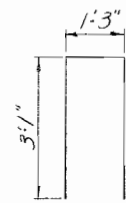


BAR S13

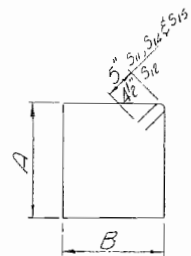


BARS S11, S12, S14 & S15

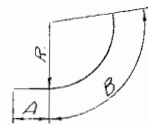


BARS h1, h2 & h3

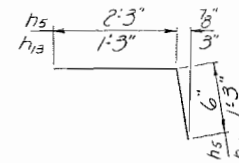

BARS h5 & h13

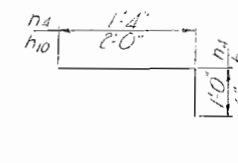

BARS h4 & h10

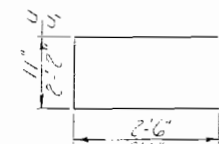

BARS u & u1

Bar	A	B
S11	1'-9"	1'-0"
S12	2'-6"	2'-2"
S14	2'-1"	1'-3"
S15	1'-3"	1'-0"

Bar	R	A	B
h1	5'-9"	2'-0"	5'-0"
h2	4'-5"	2'-0"	4'-0"
h3	3'-2"	0	3'-0"

Cut h1, h2 & h3 in the field to fit if necessary.


DESIGNED	J. D. [Signature]
CHECKED	J. D. [Signature]
DRAWN	J. D.
CHECKED	J. D.

EXAMINED	[Signature]	OCT 20 1912
PASSED	[Signature]	
APPROVED	[Signature]	

SOUTH ABUTMENT  
SOUTH BD. LAUES  
F.D.I. RT 55 SEC. 57-9MB  
MC LEAN COUNTY  
STA. 297+80.50

STATE OF ILLINOIS  
DEPARTMENT OF TRANSPORTATION

ROUTE NO.	SECTION	COUNTY	TOTAL SHEETS	SHEET NO.	SHEET NO.
57-9HB	MC LEAN	93	50	58	58 SHEETS

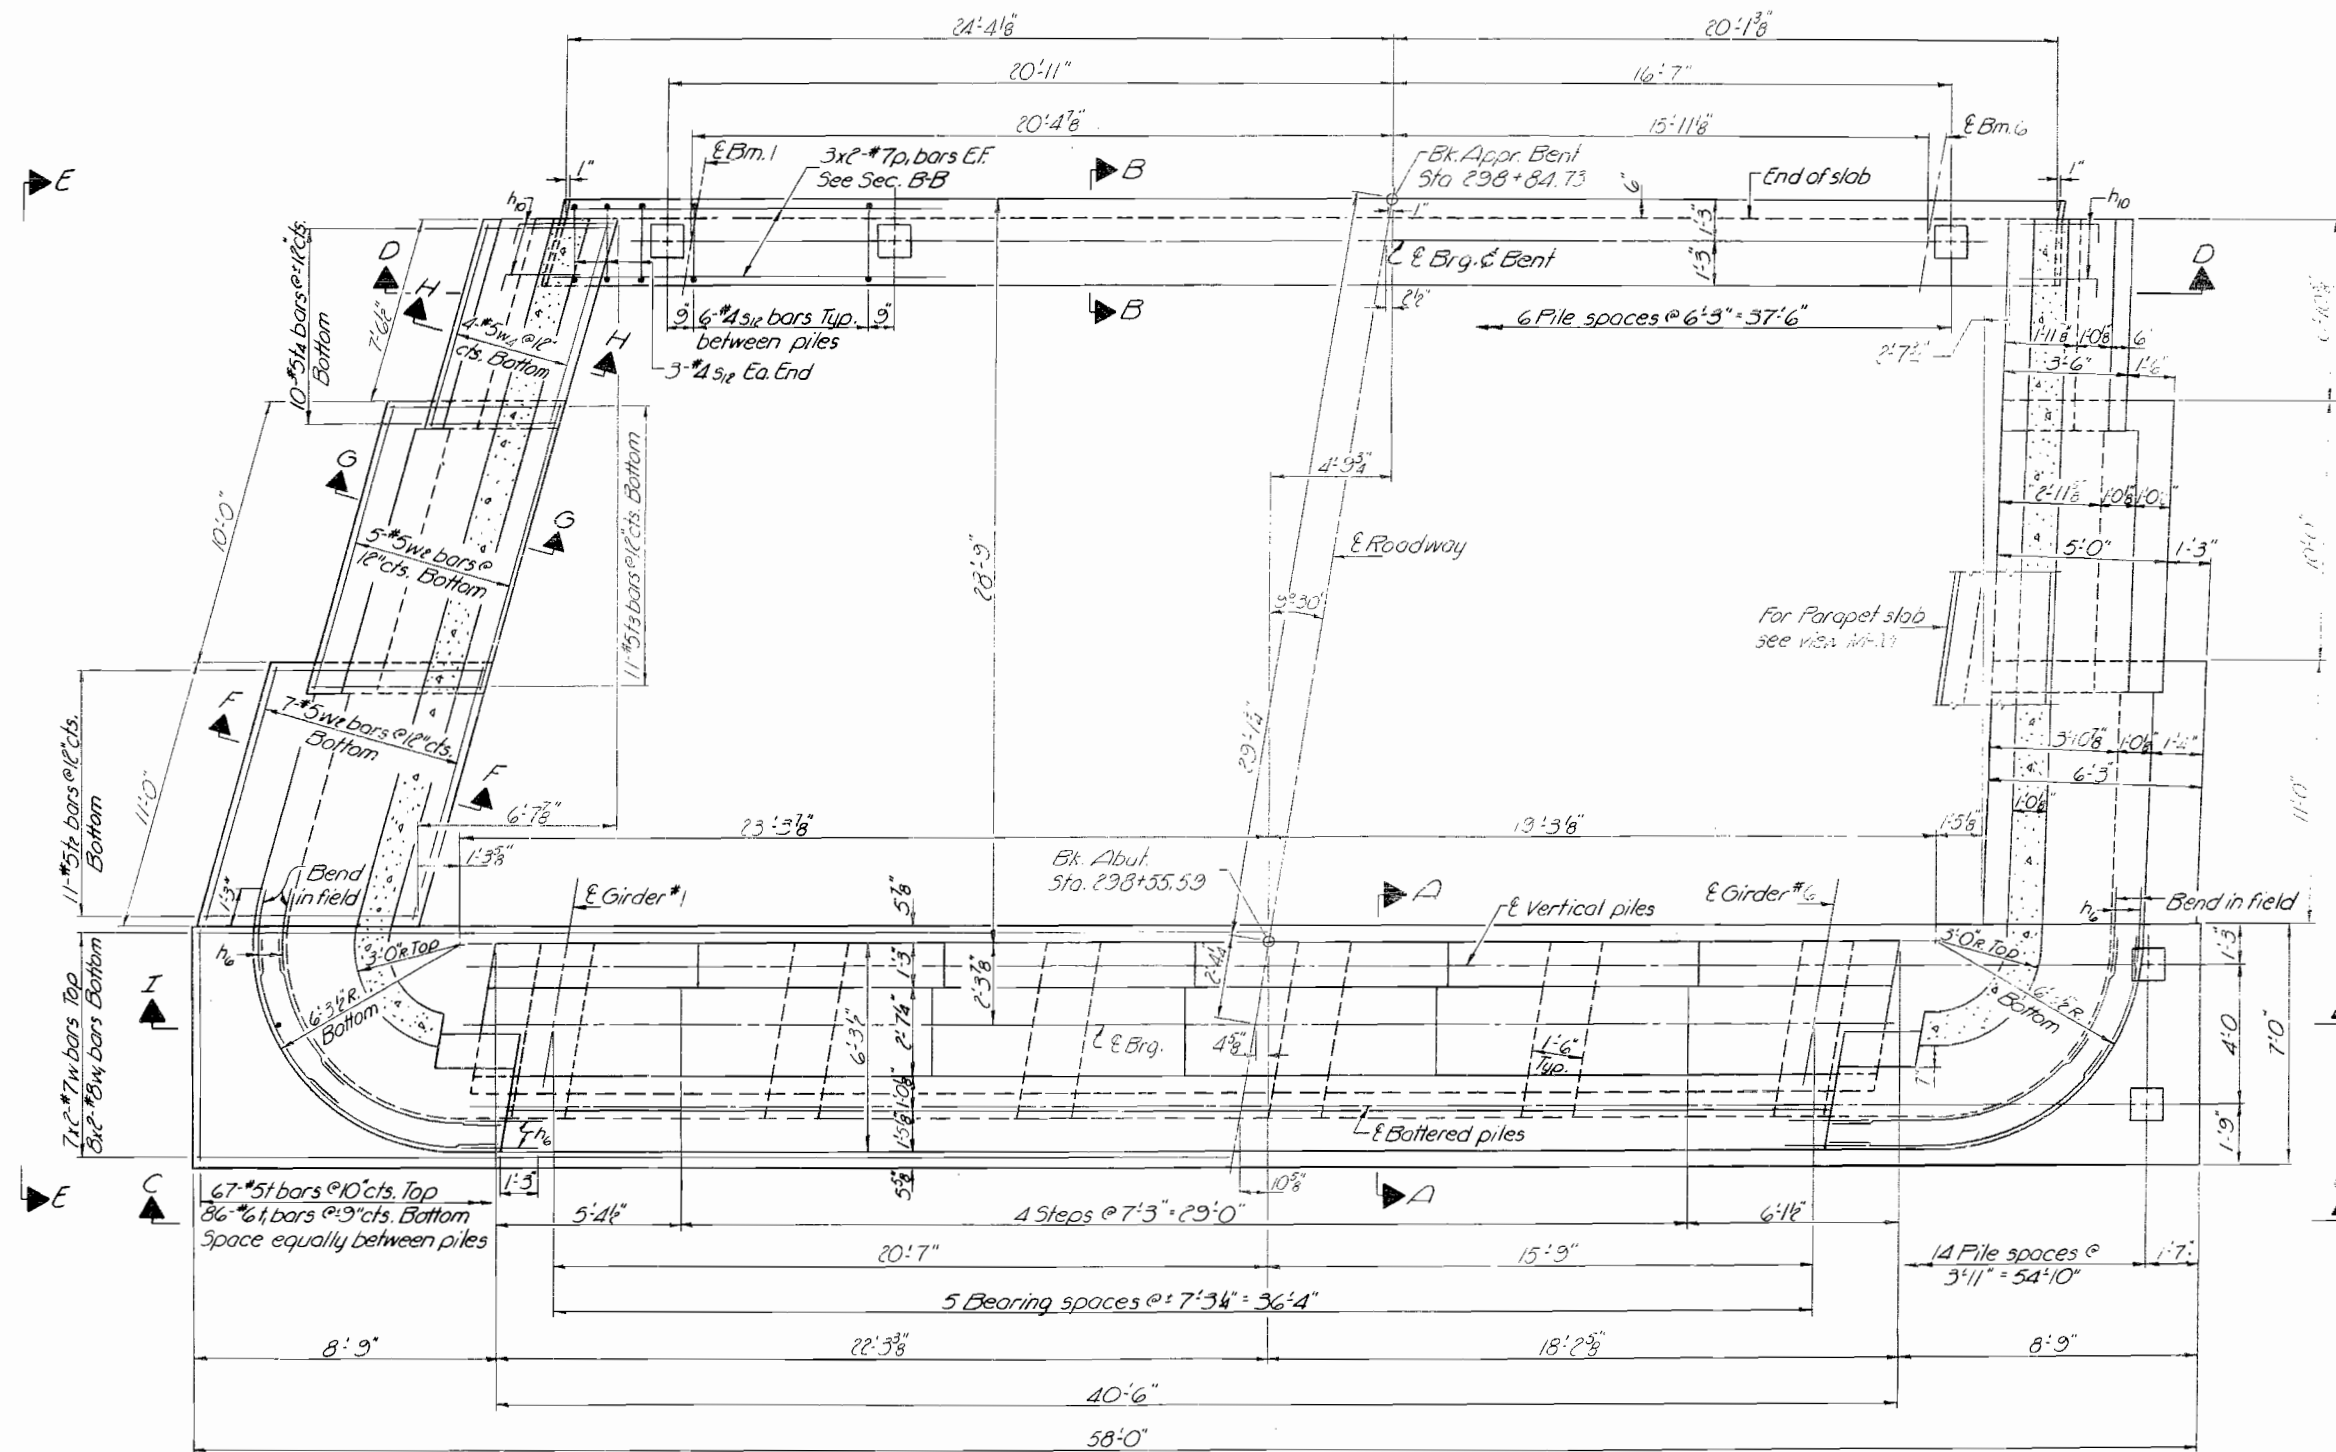

PLAN

DESIGNED	<i>L. H. Haggart</i>
CHECKED	<i>L. H. Haggart</i>
DRAWN	<i>J. D.</i>
CHECKED	<i>L. H. Haggart</i>


EXAMINED	<i>[Signature]</i> OCT 20 1912
PASSED	<i>[Signature]</i>
APPROVED	<i>[Signature]</i> CHIEF HIGHWAY ENGINEER

Note:  
Work this sheet with sheets # 30, 31 & 32.


NORTH ABUTMENT  
SOUTH BD. LAUES  
FAI. RT. 55 SEC. 57-9HB  
MC LEAN COUNTY  
STA. 297+80.50

STATE OF ILLINOIS  
DEPARTMENT OF TRANSPORTATION


ROUTE NO.	SECTION	COUNTY	TOTAL SHEETS	SHEET NO.	SHEET NO.
57-94B	57-94B	MC LEAN	93	51	51
PER. ROAD DIST. NO. 7	CLINING	PER. AID PROJ. NO.			

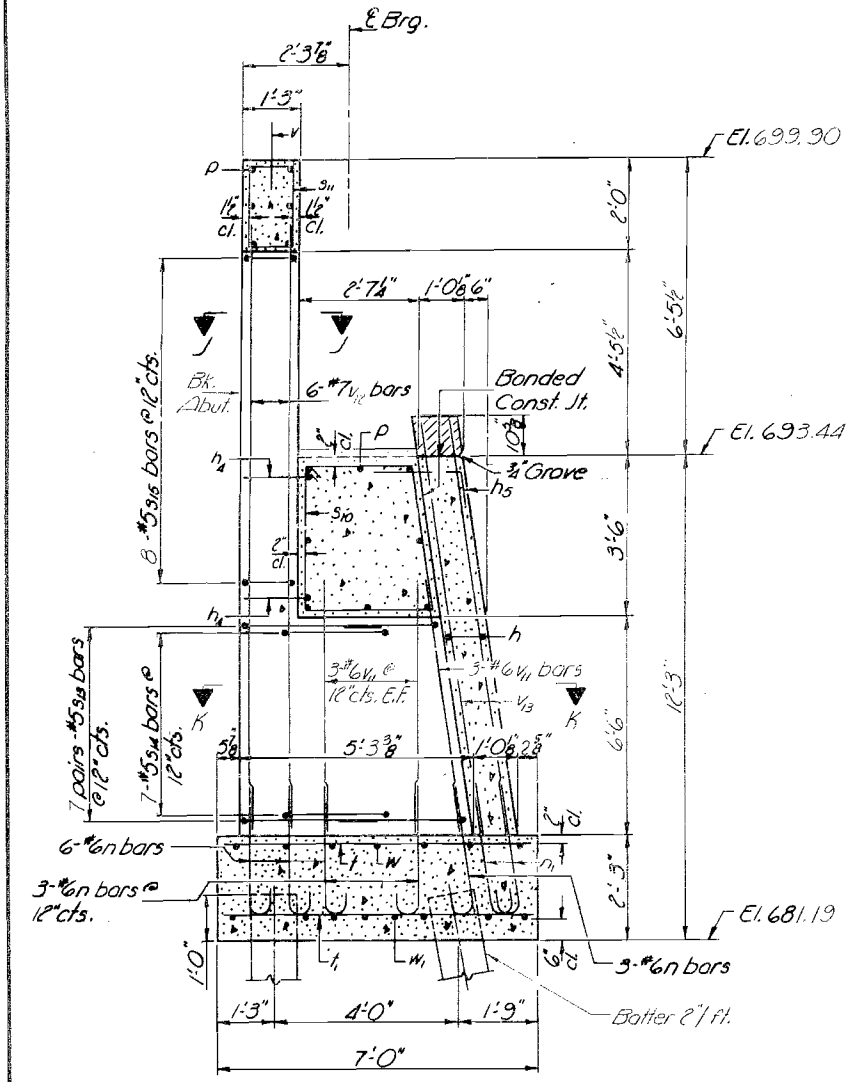


SEC. A-A

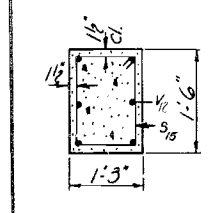


SEC. J-J

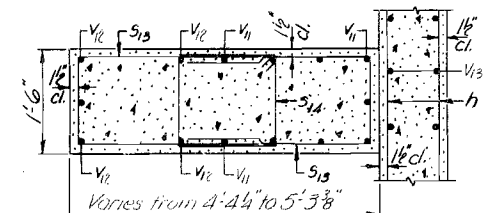


SEC. K-K

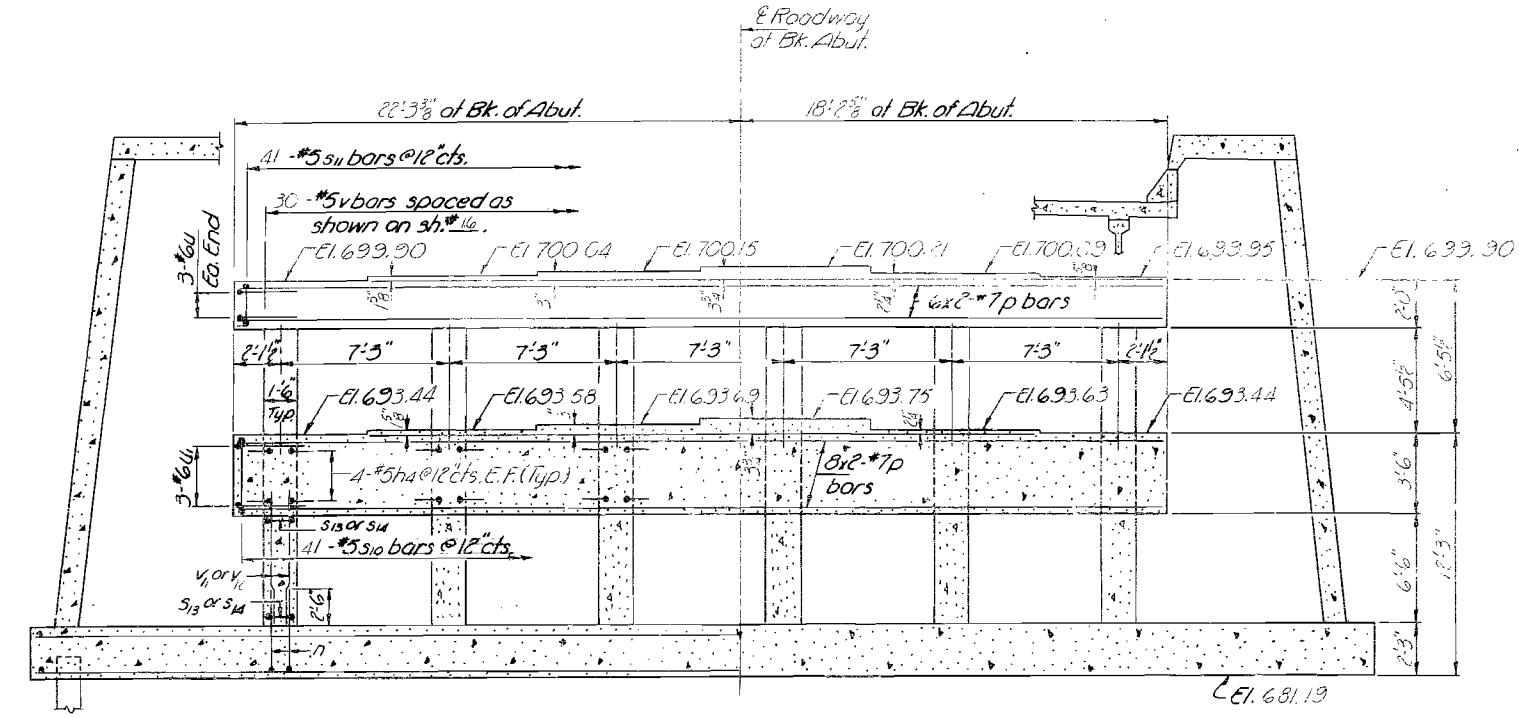

SECTION I-I

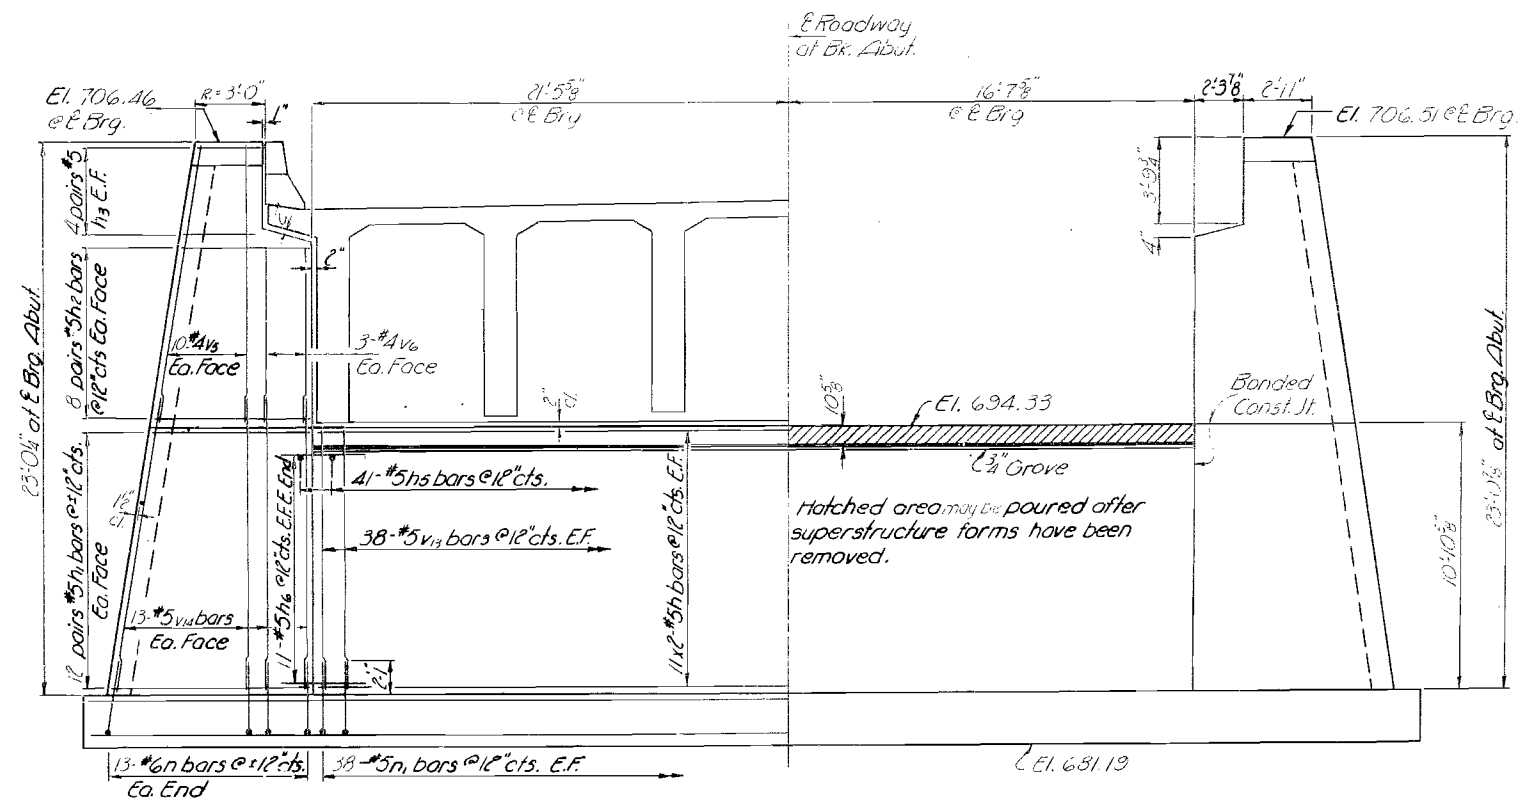

VIEW C-C

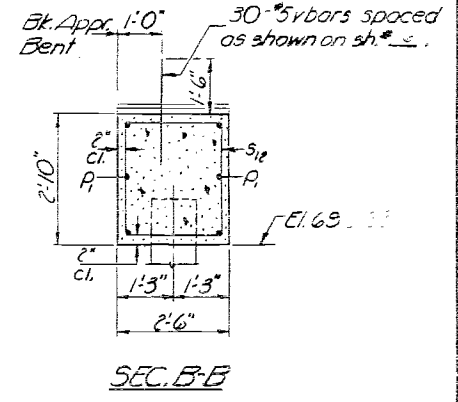

SEC. B-B

DESIGNED	J.D.
CHECKED	J.D.
DRAWN	J.D.
CHECKED	J.D.


EXAMINED	OCT 20 1972
PASSED	J.G. Paumann
APPROVED	Richard J. Holtzman

NORTH ABUTMENT  
SOUTH BD. LAUES  
F.A.I. RT. 55 SEC. 57-94B  
MC LEAN COUNTY  
STA. 297+80.50




STATE OF ILLINOIS  
DEPARTMENT OF TRANSPORTATION


ROUTE NO.	SECTION	COUNTY	TOTAL SHEETS	SHEET NO.	SHEET NO.
P.A.I. 55	57-9HB	MC LEAN	93	52	58 SHEETS
FED. ROAD DIST. NO. 7	ILLINOIS	FED. AID PROJECT			

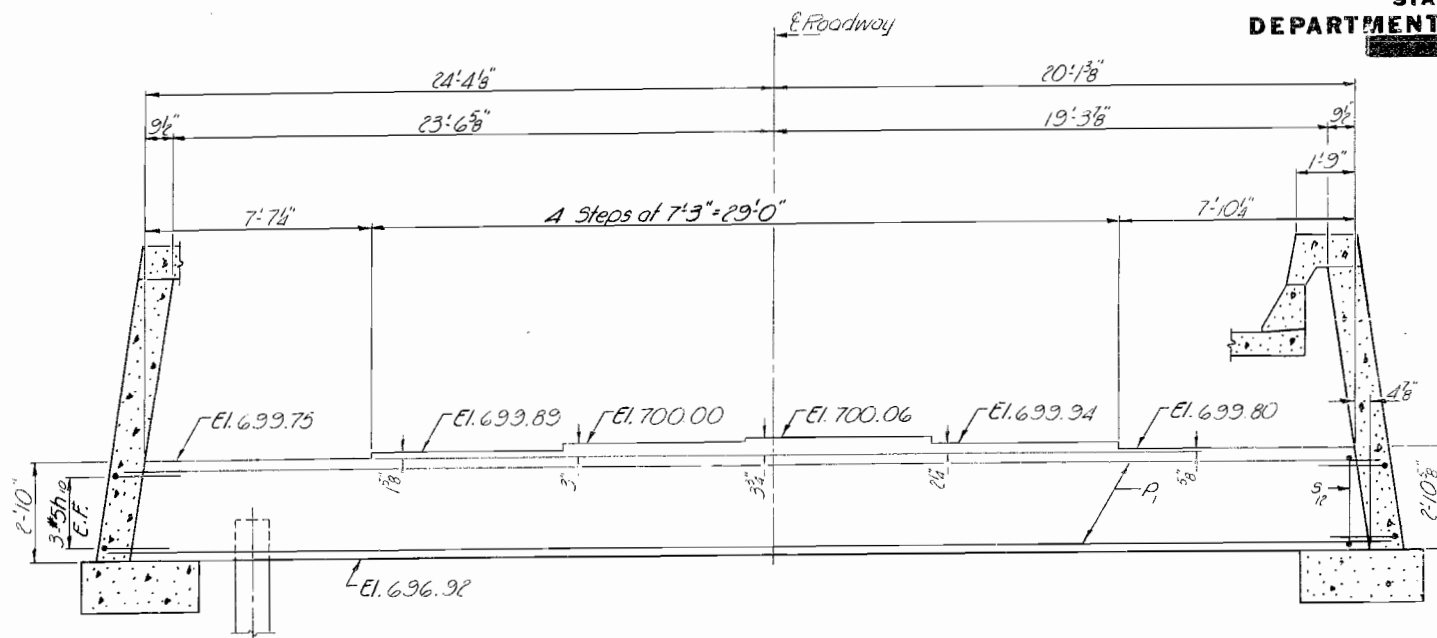


VIEW D-D

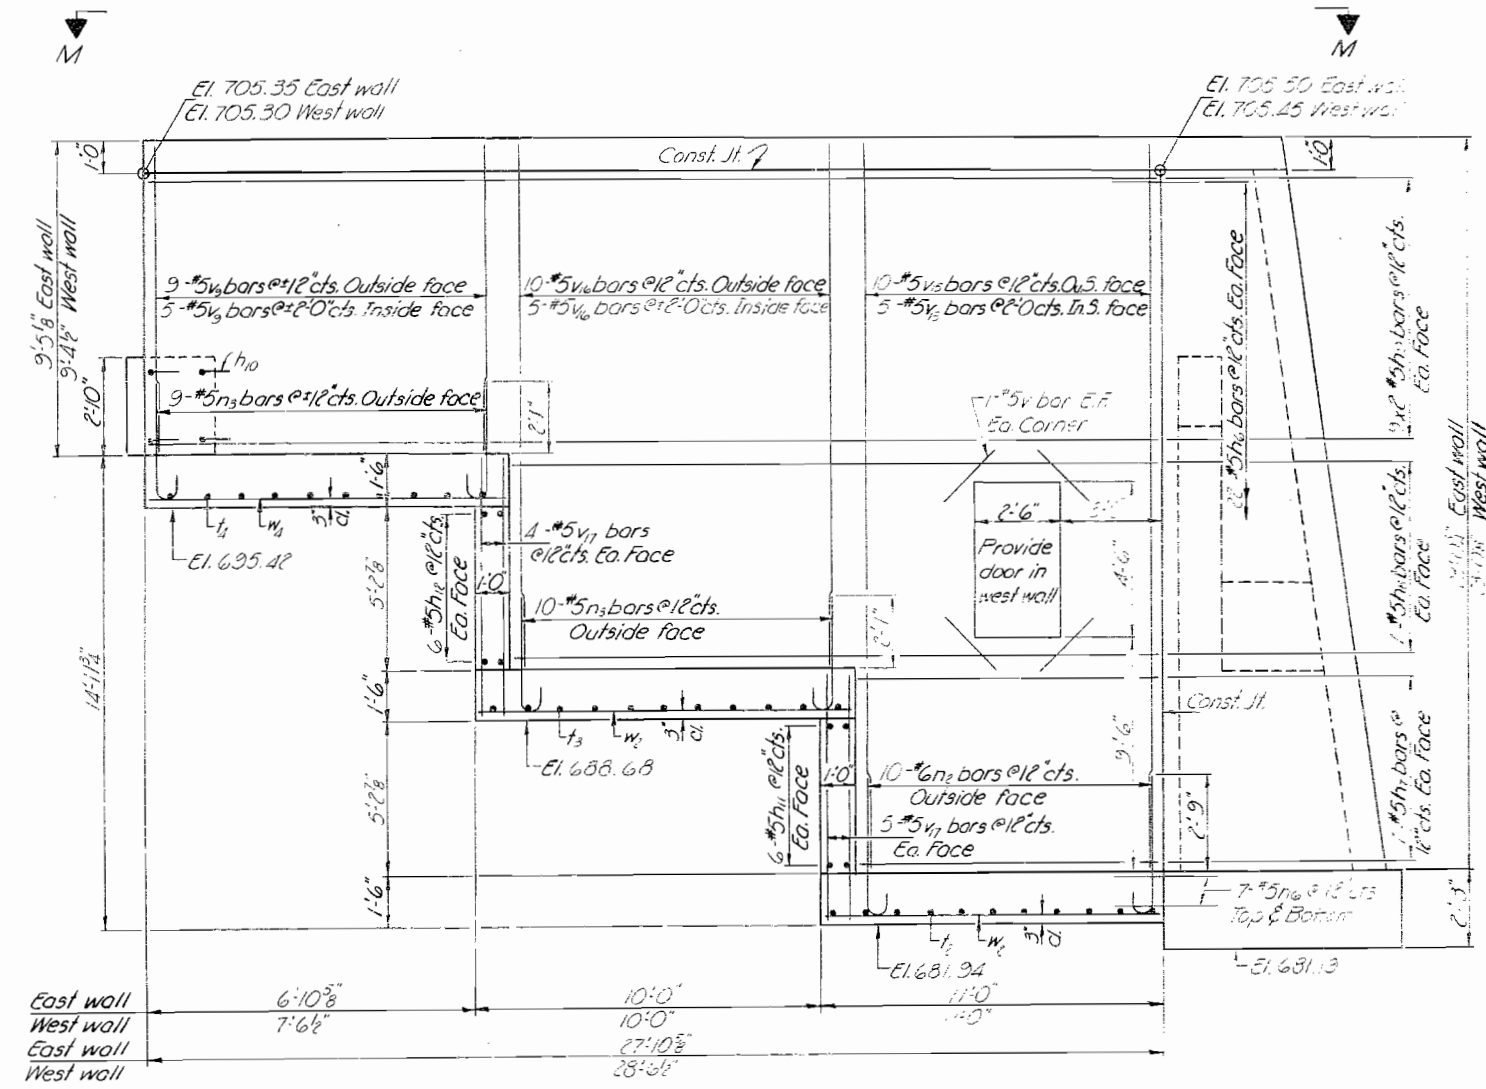


VIEW E-E

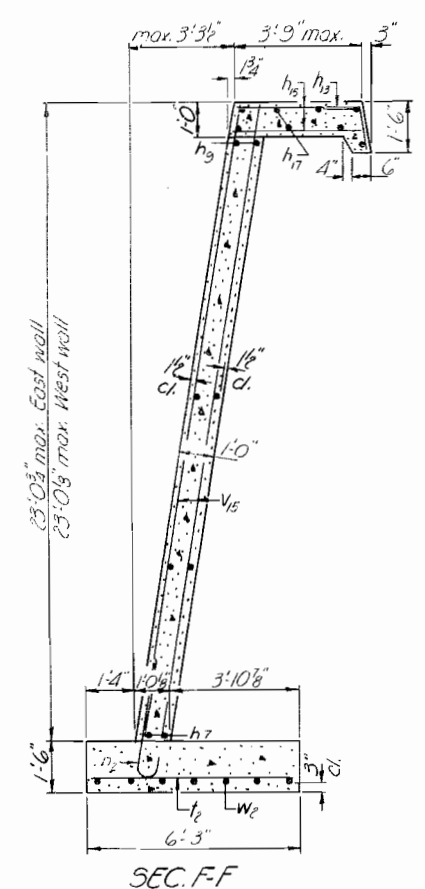


SEC. F-F

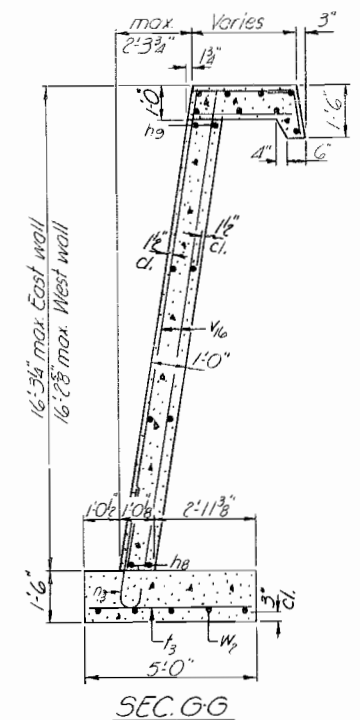


SEC. G-G

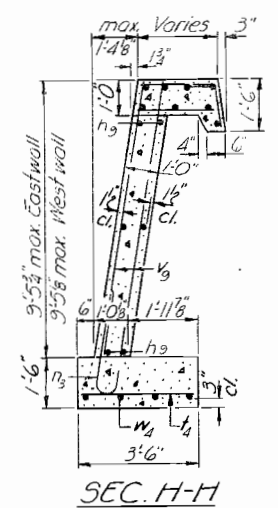

SEC. H-H

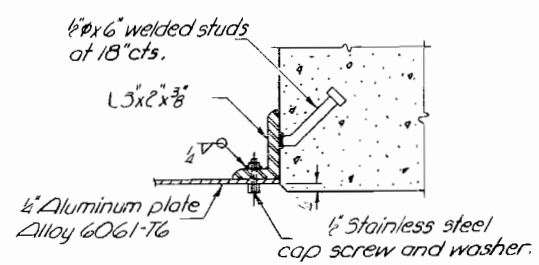

SEC. L-L

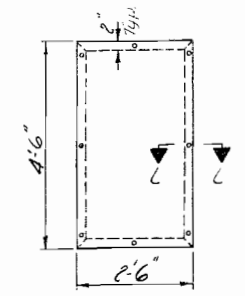

DOOR ELEVATION  
(Cost of door & frame are incidental)

Work this sheet with sheets #29, 30 & 31.  
Cut or bend rebar to fit if necessary.


DESIGNED	J. J. Mayhew
CHECKED	J. J. Mayhew
DRAWN	J.D.
CHECKED	J.m.v.

OCT 20 1952  
EXAMINED  
PASSED  
APPROVED  
Chief Highway Engineer

NORTH ABUTMENT  
SOUTH BD. LAUES  
P.A.I. RT. 55 SEC. 57-9HB  
MC LEAN COUNTY  
STA. 297+80.50

STATE OF ILLINOIS  
DEPARTMENT OF TRANSPORTATION

ROUTE NO.	SECTION	COUNTY	TOTAL SHEETS	SHEET NO.	SHEET NO.
RT. 55	57-9HB	MC LEAN	93	53	58 SHEETS
FEDERAL DIST. NO. 7		ILLINOIS	FED. AID PROJECT		

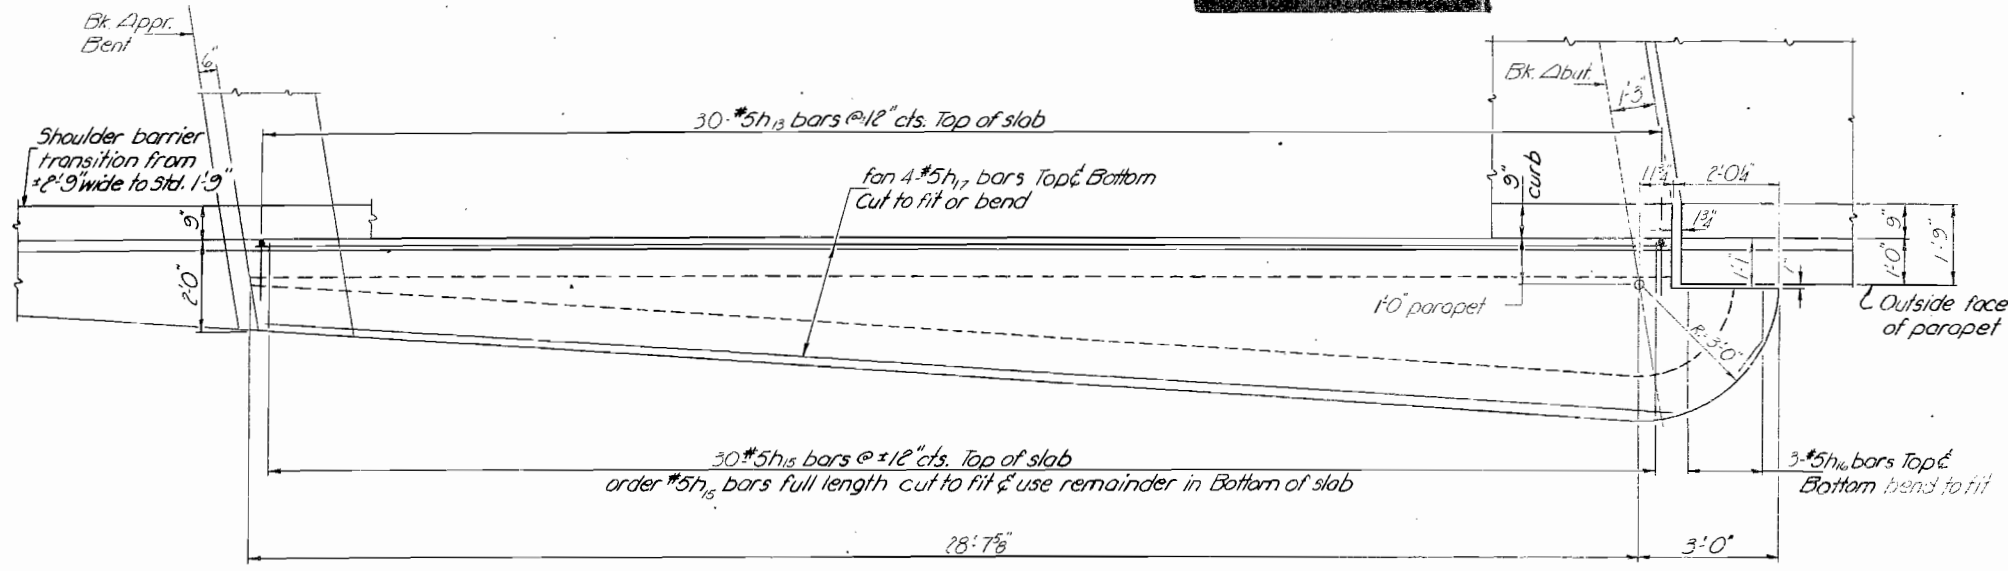

APPR. BENT  
PILE DATA


Type: Concrete  
Capacity: 35 Tons  
Est. Length: 56'  
No. Required: 7

ABUTMENT  
PILE DATA

Type: Concrete  
Capacity: 35 Tons  
Est. Length: 42'  
No. Required: 30

BILL OF MATERIAL


Bar	Qty.	Size	Length	Shape
n	44	#5	19'-8"	---
r	96	#5	7'-0"	---
r	64	#5	2'-0"	---
n2	32	#5	3'-0"	---
n2	48	#5	2'-4"	---
n2	41	#5	2'-3"	---
n2	160	#5	2'-0"	---
n2	28	#5	9'-3"	---
n2	28	#5	19'-3"	---
n2	72	#5	15'-3"	---
n2	2	#5	2'-0"	---
n1	24	#5	4'-9"	---
n1	24	#5	3'-3"	---
n13	60	#5	2'-0"	---
n15	60	#5	5'-3"	---
n16	12	#5	2'-8"	---
n17	12	#5	3'-2"	---
r	142	#6	4'-11"	---
r	76	#5	4'-5"	---
r1	20	#6	4'-8"	---
r2	25	#5	5'-11"	---
r	28	#7	2'-3"	---
r	6	#7	2'-3"	---
s2	41	#5	12'-3"	---
s1	41	#5	2'-3"	---
s1	21	#4	10'-1"	---
s2	84	#5	7'-5"	---
s2	42	#5	7'-5"	---
s2	28	#5	5'-11"	---
r	67	#5	2'-3"	---
r	86	#6	2'-3"	---
r	22	#5	2'-0"	---
r	5	#5	2'-3"	---
n	6	#5	5'-11"	---
n	6	#6	7'-2"	---
r	68	#5	3'-0"	---
n2	20	#4	1'-0"	---
n2	12	#4	7'-3"	---
n3	28	#5	2'-3"	---
n3	52	#6	3'-3"	---
n3	26	#7	13'-2"	---
n3	76	#5	10'-7"	---
n3	22	#5	2'-0"	---
n3	20	#5	2'-3"	---
n3	20	#5	2'-3"	---
n3	28	#5	3'-0"	---
n3	12	#7	50'-2"	---
n3	10	#8	50'-6"	---
n3	24	#5	10'-3"	---
n3	5	#5	8'-5"	---
Class A Concrete		Qty. Yds.	16.32	
Reinforcement Bars		Lbs.	21512	
Concrete Piles		Lin. Ft.	1632	

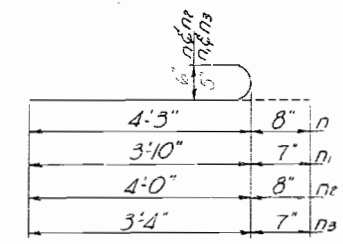

BARs n thru n3


VIEW M-M

Showing reinforcement in slab above walls  
Typ. for both walls

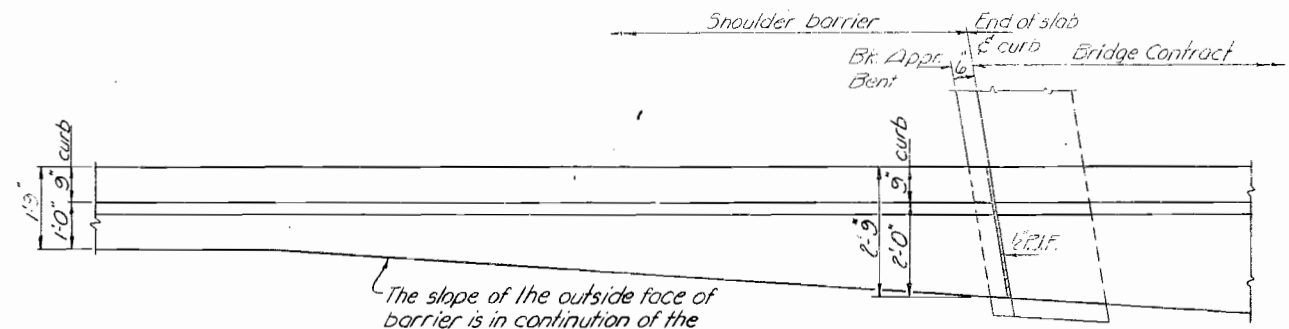


PLAN


Showing transition of shoulder barrier

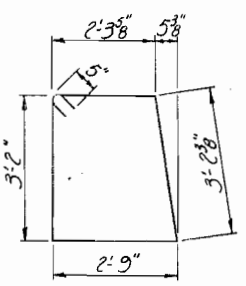


BAR S10

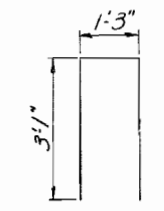


BAR S13

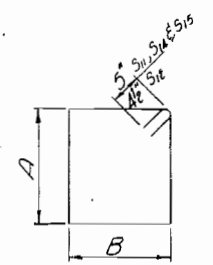


BARS S11, S12, S14 & S15

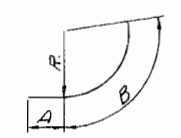


BARS h1, h2 & h3

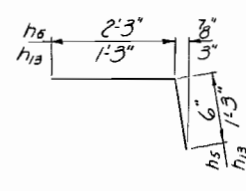

BARS h5 & h13

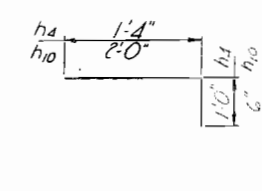

BARS h4 & h10

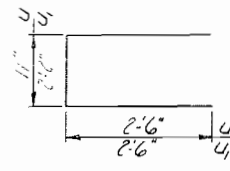

BARS u & u1

Bar	A	B
S11	1'-9"	1'-0"
S12	2'-6"	2'-2"
S14	2'-1"	1'-3"
S15	1'-3"	1'-0"

Bar	R	A	B
h1	5'-9"	2'-0"	5'-0"
h2	4'-5"	2'-0"	4'-0"
h3	3'-2"	0	3'-0"

Cut h1, h2 & h3 in the field to fit if necessary.


DESIGNED: J.D. [Signature]  
CHECKED: [Signature]  
DRAWN: J.D.  
CHECKED: [Signature]

EXAMINED: [Signature]  
PASSED: [Signature]  
APPROVED: Richard H. Gatterman, CIVIL ENGINEER

NORTH ABUTMENT  
SOUTH BD. LAJES  
FAI. RT. 55 SEC. 57-9HB  
MC LEAN COUNTY  
STA. 297+80.50

STATE OF ILLINOIS  
DEPARTMENT OF TRANSPORTATION

ROUTE NO.	SECTION	COUNTY	TOTAL SHEETS	SHEET NO.
1.55	57-9HB	MC LEAN	93	54
SHEET NO. 33				
58 SHEETS				

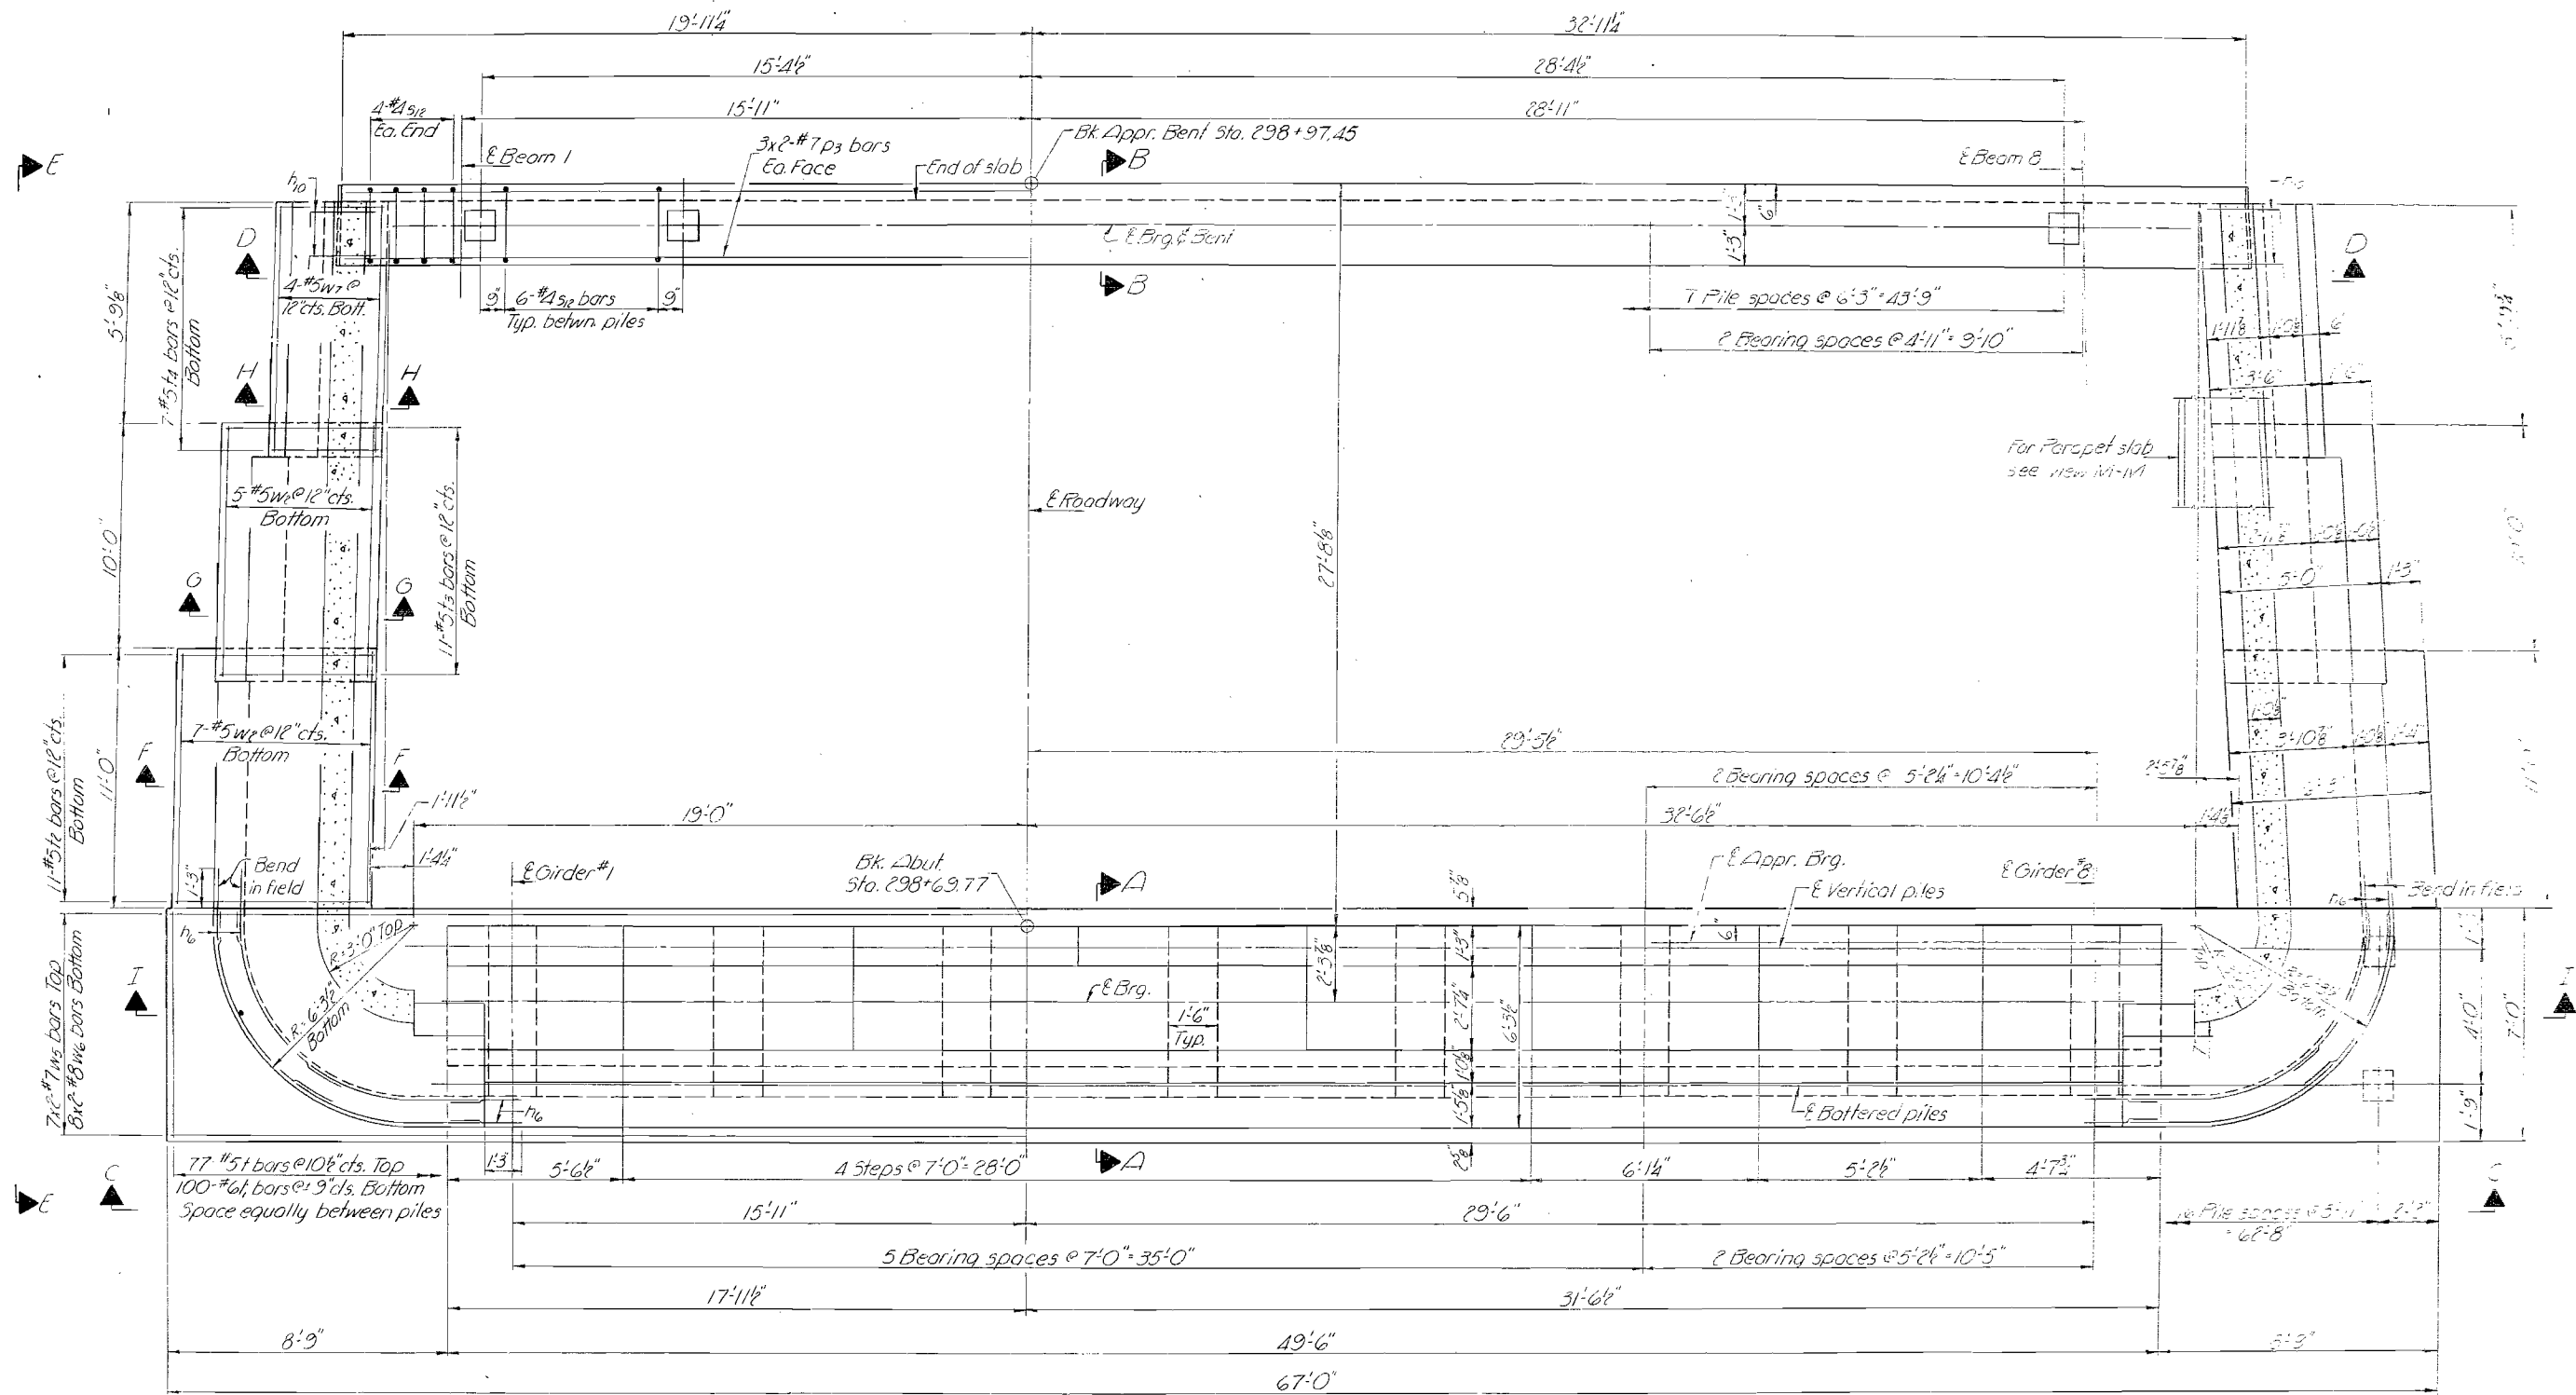

PLAN

DESIGNED	<i>J. J. Haggart</i>
CHECKED	<i>J. M. Patel</i>
DRAWN	LD
CHECKED	LD


OCT. 20 1972  
 EXAMINED *[Signature]*  
 PASSED *[Signature]*  
 APPROVED *[Signature]*  
 RICHARD A. GOLTERMAN  
 CHIEF HIGHWAY ENGINEER

Note:  
Work this sheet with sheets # 34, 35 & 36


NORTH ABUTMENT  
 NORTH BD. LAJES  
 FDI RT. 55 SEC. 57-9HB  
 MC LEAN COUNTY  
 STA. 297+80.50

STATE OF ILLINOIS  
DEPARTMENT OF TRANSPORTATION


ROUTE NO.	SECTION	COUNTY	TOTAL SHEETS	SHEET NO.	SHEET NO.
155	57-9HB	MC LEAN	93	55	55 SHEETS
FED. ROAD DIST. NO. 7		ILLINOIS	FED. AID PROJECT:		

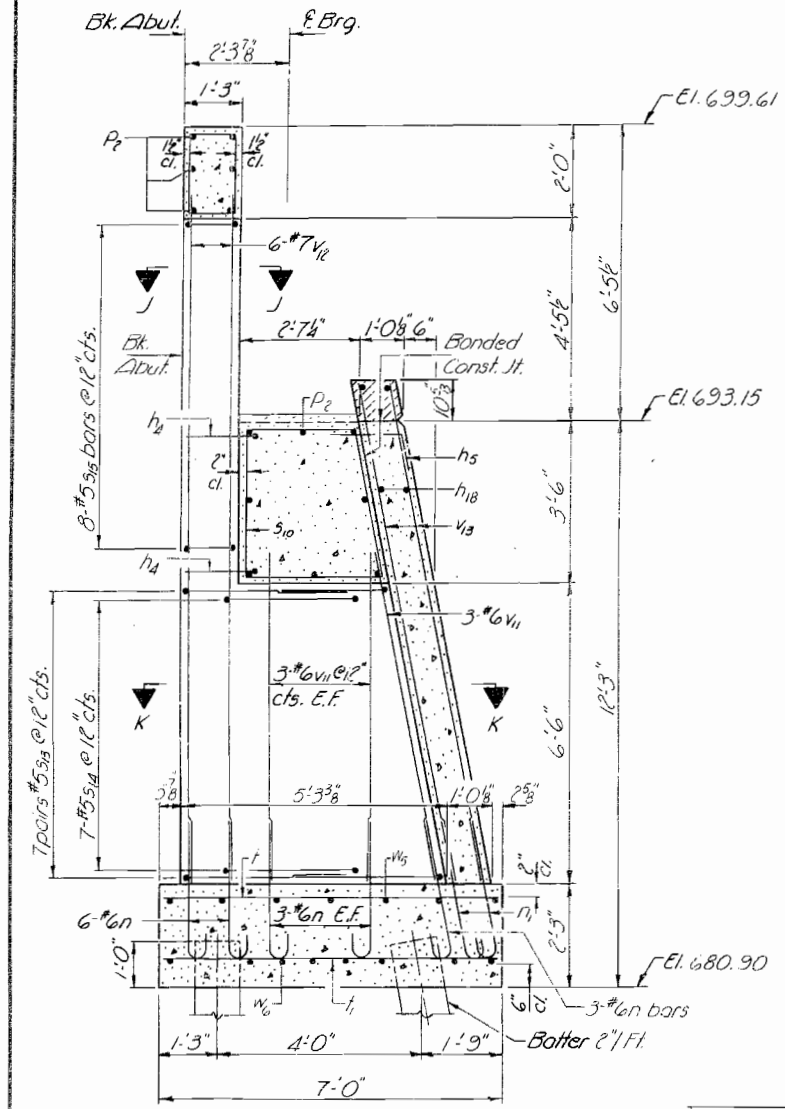


SEC. A-A

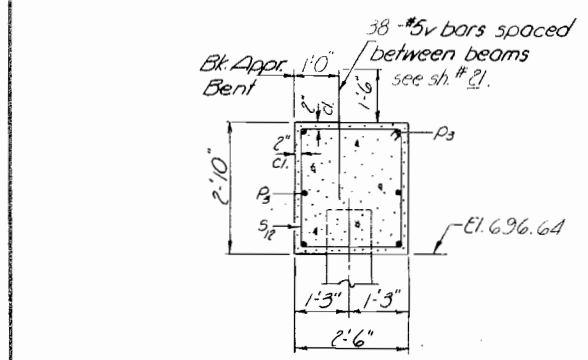


SEC. B-B

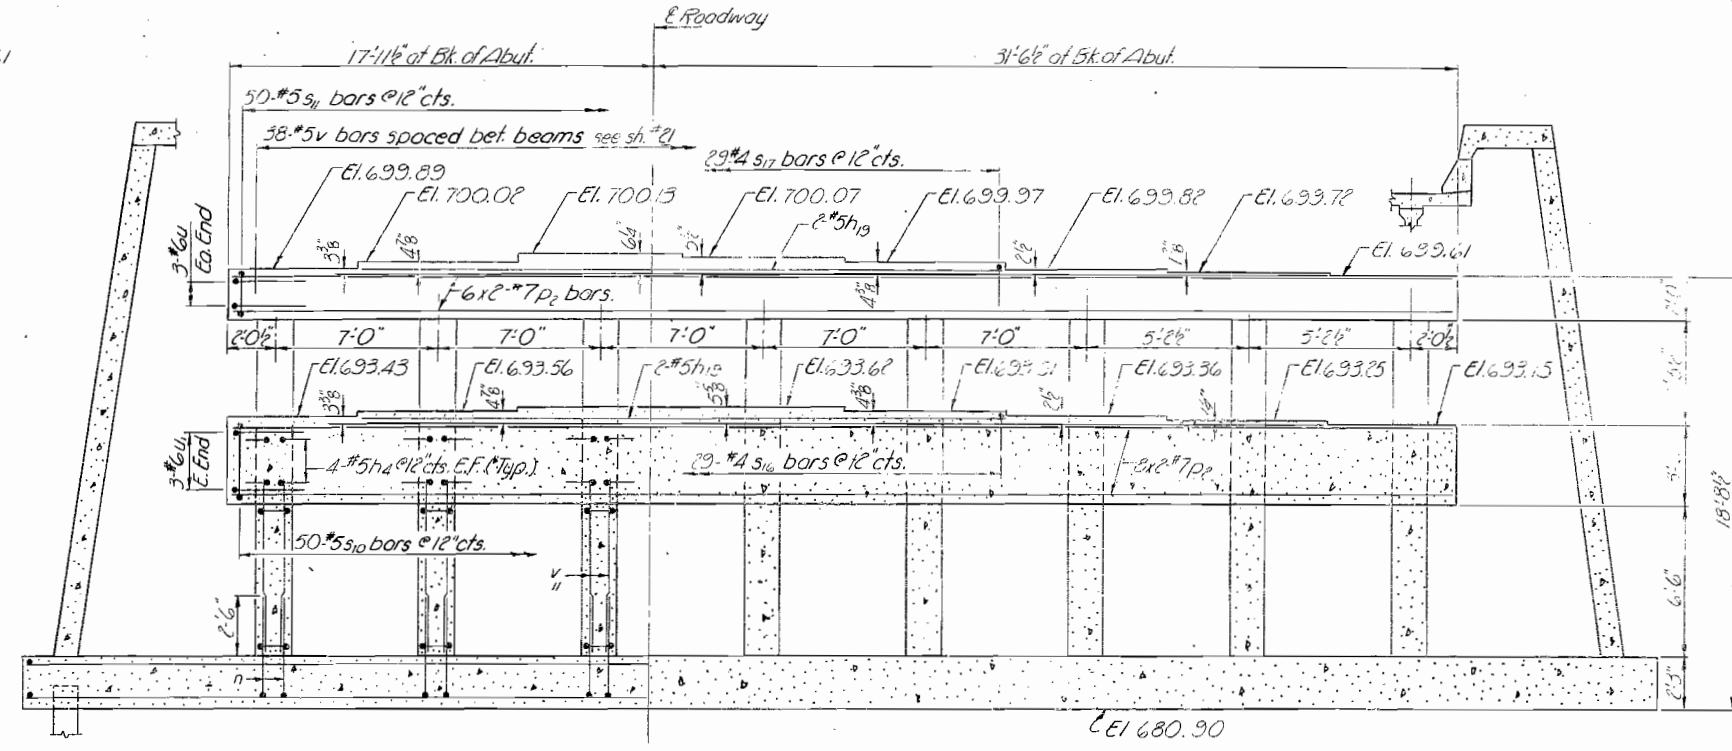


SECTION I-I

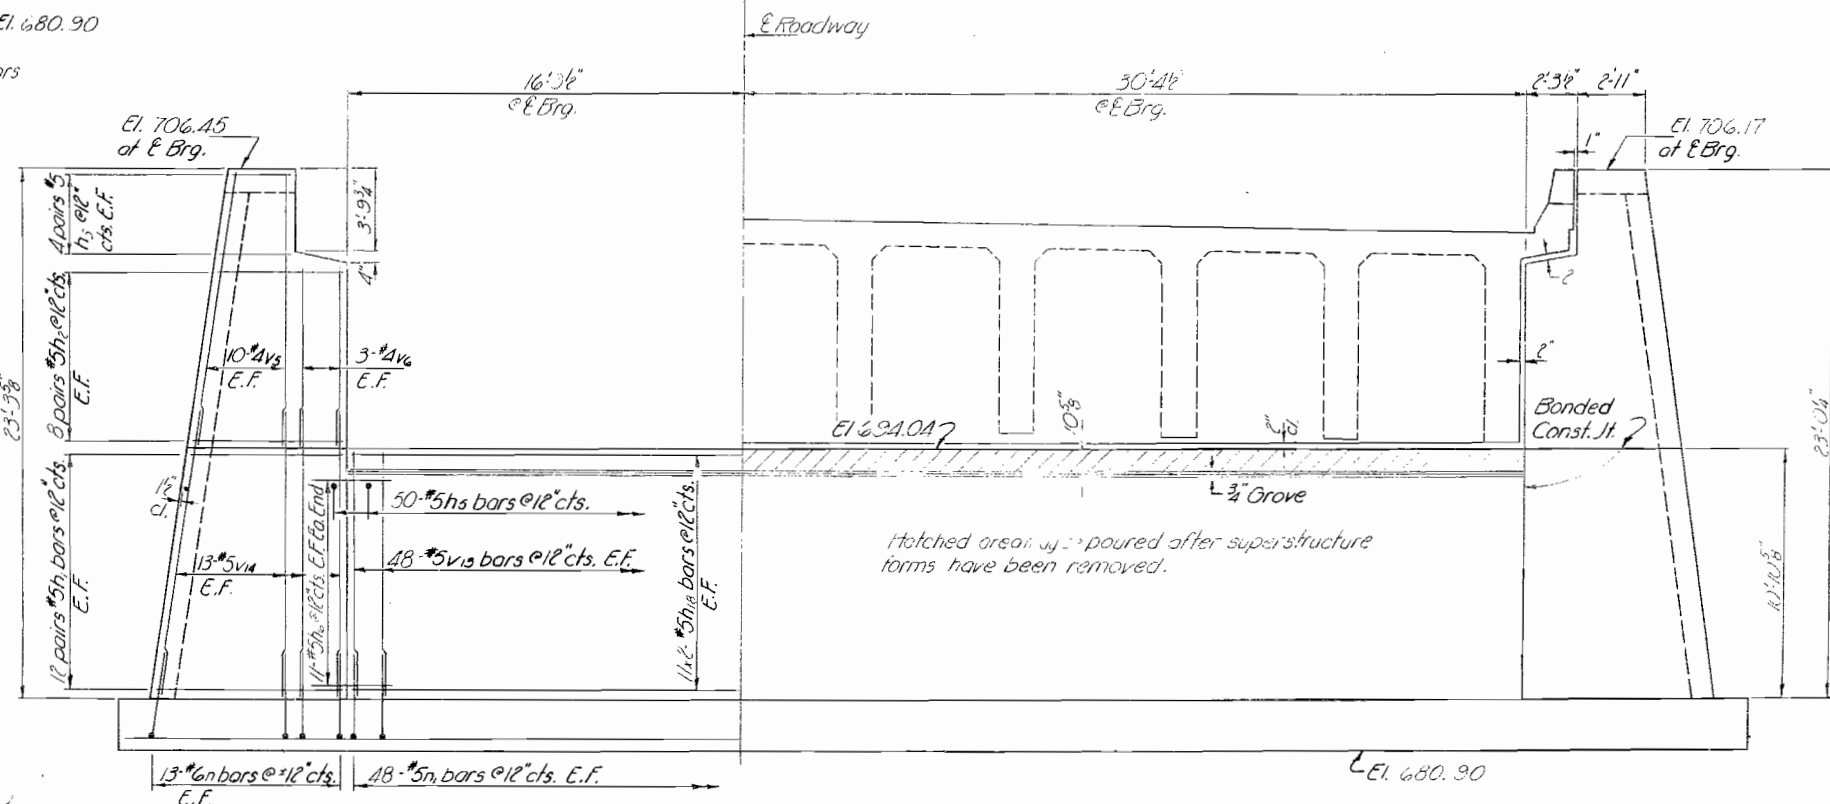

VIEW C-C

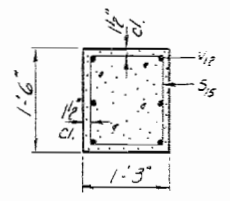

SEC. J-J

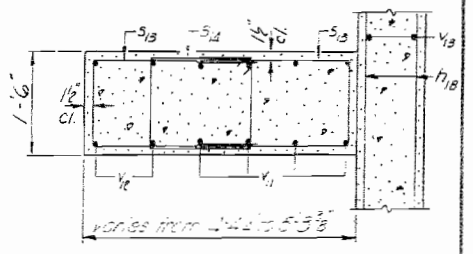

SEC. K-K


DESIGNED	J. J. [Signature]
CHECKED	[Signature]
DRAWN	J.D.
CHECKED	[Signature]

EXAMINED	[Signature]	OCT. 20 1972
PASSED	[Signature]	
APPROVED	[Signature]	


NORTH ABUTMENT  
NORTH BD. LAUES  
F.A.I. RT. 55 SEC. 57-9HB  
MC LEAN COUNTY  
STA. 297+80.50

STATE OF ILLINOIS  
DEPARTMENT OF TRANSPORTATION


ROUTE NO.	SECTION	COUNTY	TOTAL SHEETS	SHEET NO.	SHEET NO.
155	57-9HB	MC LEAN	93	56	56 SHEETS
FED. ROAD DIST. NO. 7	ILLINOIS	FED. AID PROJECT			

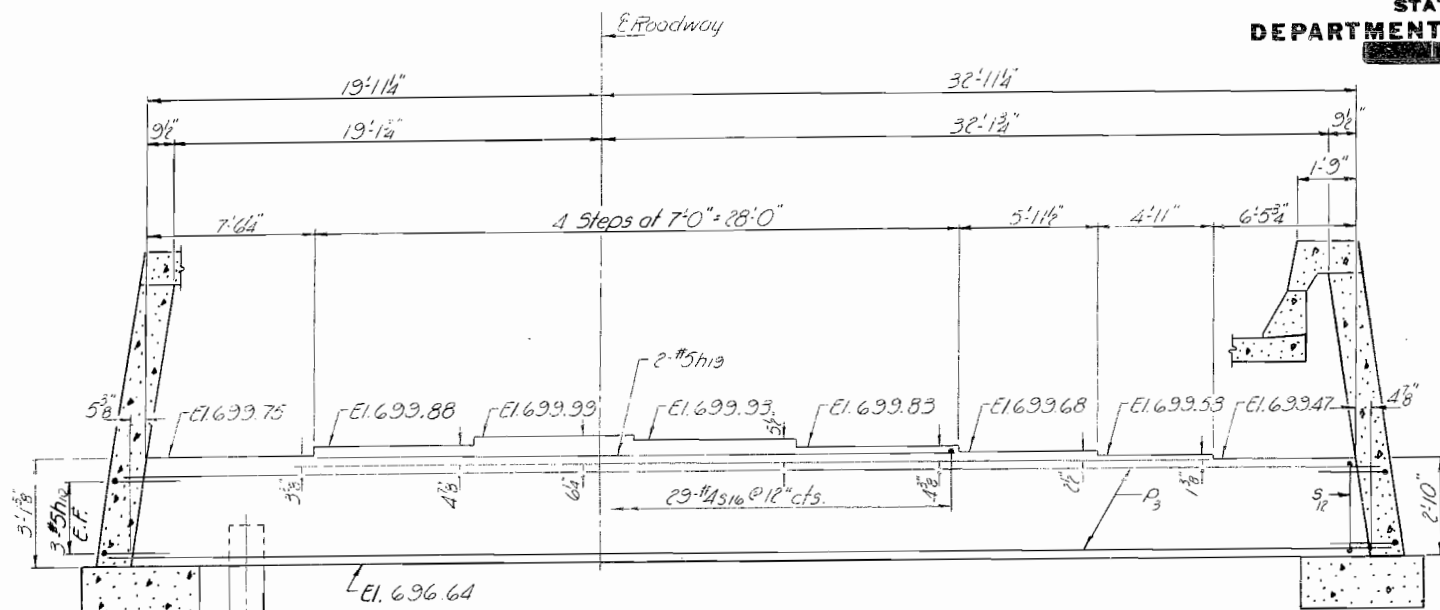


VIEW D-D

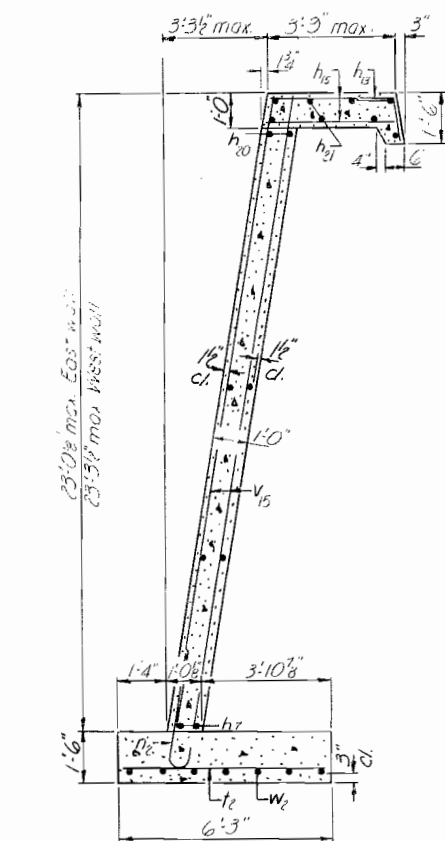


SEC. F-F

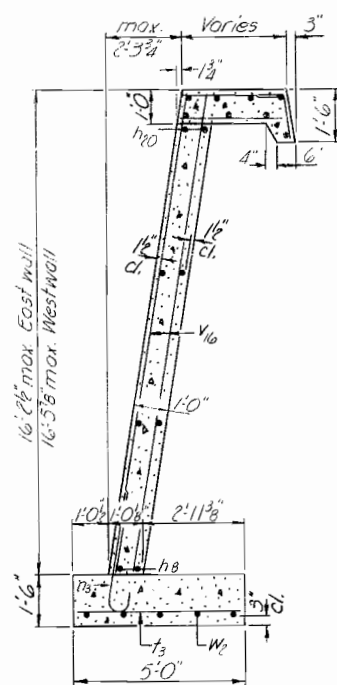

SEC. G-G

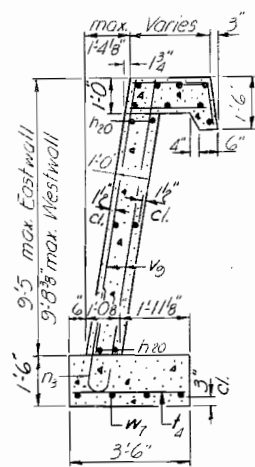


SEC. H-H

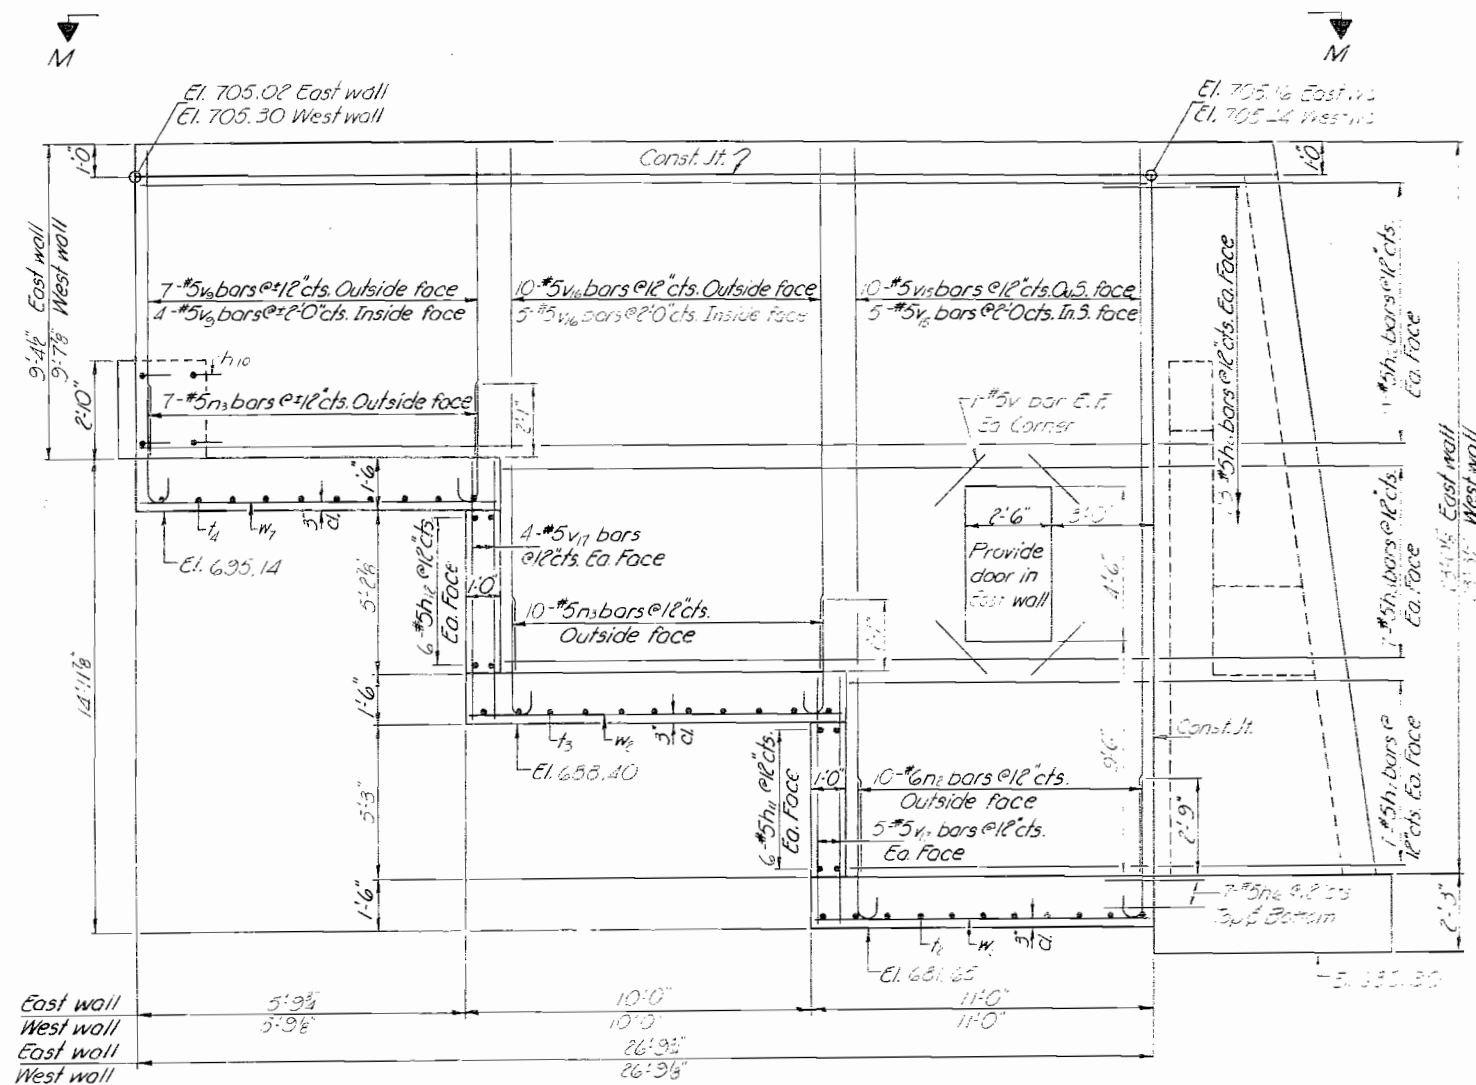


VIEW E-E

Work this sheet with sheets # 55, 54, 53.

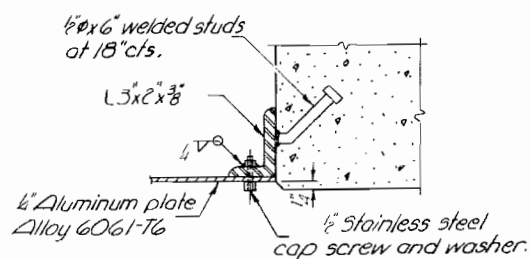

SEC. L-L

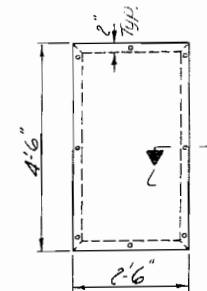

DOOR ELEVATION  
(Cost of door & frame are incidental)


DESIGNED	J. J. Wharpp
CHECKED	J. J. Wharpp
DRAWN	J. J. Wharpp
CHECKED	J. J. Wharpp

OCT 20 1916  
EXAMINED  
PASSED  
APPROVED  
Richard H. Holterman  
CHIEF HIGHWAY ENGINEER

NORTH ABUTMENT  
NORTH BD. LAUES  
FAIR 155 SEC. 57-9HB  
MC LEAN COUNTY  
STA. 297+80.50


STATE OF ILLINOIS  
DEPARTMENT OF TRANSPORTATION

ROUTE NO.	SECTION	COUNTY	TOTAL SHEETS	SHEET NO.	SHEET NO.
RT. 55	57-94B	MC LEAN	93	57	55 SHEETS
PERFORMED BY: NO. 7	ILLINOIS	PERMANENT PROJECT			

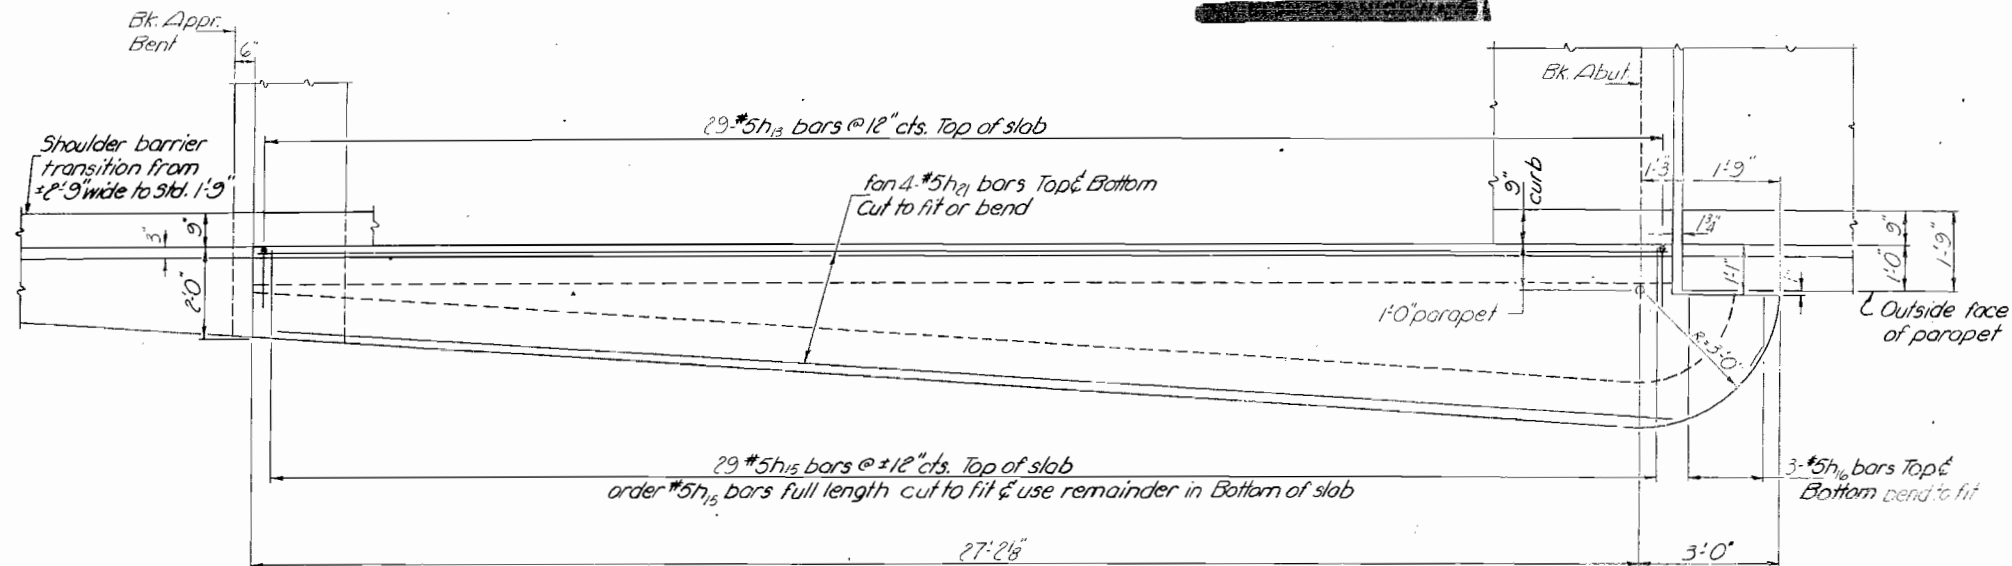


VIEW M-M

Showing reinforcement in slab above walls  
Typ. for both walls

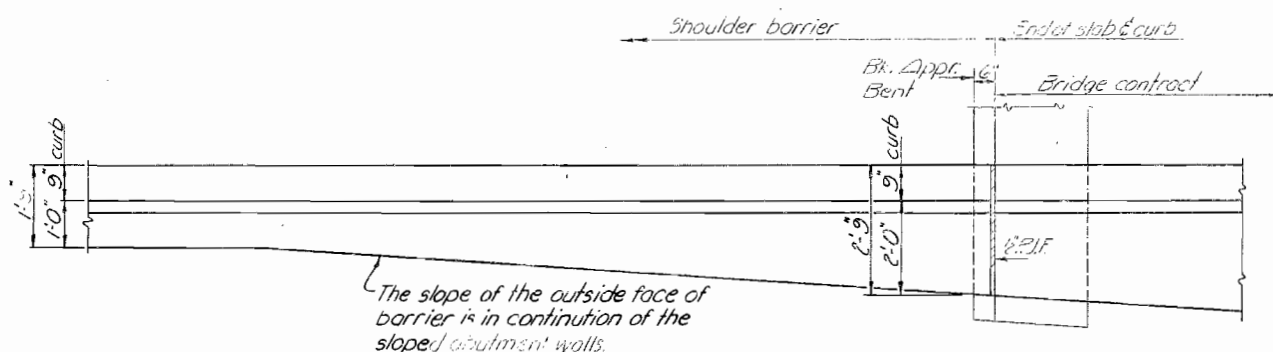

PLAN

Showing transition of shoulder barrier

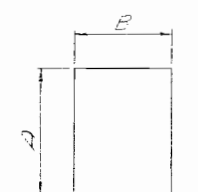

BARS S13, S14 & S17

Bar	A	B
S13	3'-1"	1'-3"
S14	1'-3"	2'-2"
S17	1'-3"	1'-0"

APPR. BEUT  
PILE DATA


Type: Concrete  
Capacity: 35 Tons  
Est. Length: 54'  
No. Required: 8

ABUTMENT  
PILE DATA


Type: Concrete  
Capacity: 35 Tons  
Est. Length: 33'  
Including 1 Test pile

4'-3"	8"	n
3'-0"	7"	n
4'-0"	8"	n2
3'-4"	7"	n3

BARS n thru n3

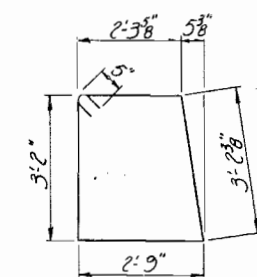


BAR S10

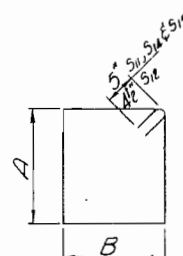

BARS S11, S12, S14 & S16


Bar	A	B
S11	1'-9"	1'-0"
S12	2'-6"	2'-2"
S14	2'-1"	1'-3"
S16	1'-3"	1'-0"

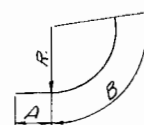


BARS h1, h2 & h3

Bar	R	A	B
h1	5'-9"	2'-0"	5'-0"
h2	4'-5"	2'-0"	4'-0"
h3	3'-2"	0	3'-0"


Cut h1, h2 & h3 in the field  
to fit if necessary.

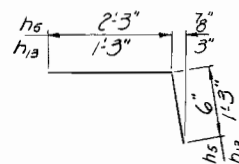

BARS h5 & h13

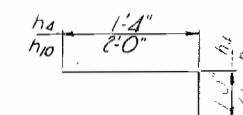

BARS h4 & h10

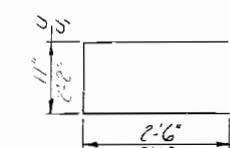

BARS u & u1

BILL OF MATERIAL

Bar	Qty.	Size	Length	Shape
n1	36	#5	7'-0"	---
n2	64	#5	6'-0"	---
n3	32	#5	3'-0"	---
n4	64	#5	2'-4"	---
n5	32	#5	2'-3"	---
n6	164	#5	4'-0"	---
n7	28	#5	9'-9"	---
n8	28	#5	19'-3"	---
n9	12	#5	2'-6"	---
n10	24	#5	4'-9"	---
n11	24	#5	3'-3"	---
n12	52	#5	2'-6"	---
n13	36	#5	5'-3"	---
n14	12	#5	2'-0"	---
n15	44	#5	24'-1"	---
n16	6	#5	27'-9"	---
n17	36	#5	26'-6"	---
n18	16	#5	23'-10"	---
n19	172	#6	4'-0"	---
n20	32	#5	4'-0"	---
n21	20	#6	2'-8"	---
n22	34	#5	3'-11"	---
n23	35	#7	26'-0"	---
n24	6	#7	28'-2"	---
n25	50	#5	2'-3"	---
n26	50	#5	2'-4"	---
n27	50	#4	10'-1"	---
n28	118	#5	7'-5"	---
n29	56	#5	7'-6"	---
n30	62	#5	3'-4"	---
n31	58	#4	4'-8"	---
n32	29	#4	3'-2"	---
n33	77	#5	6'-9"	---
n34	100	#6	6'-9"	---
n35	22	#5	6'-0"	---
n36	22	#5	4'-9"	---
n37	2	#5	3'-3"	---
n38	6	#6	5'-11"	---
n39	6	#6	7'-8"	---
n40	32	#5	3'-0"	---
n41	40	#5	1'-0"	---
n42	12	#5	7'-9"	---
n43	22	#5	9'-2"	---
n44	72	#6	3'-5"	---
n45	42	#7	10'-2"	---
n46	32	#5	10'-7"	---
n47	32	#5	12'-0"	---
n48	20	#5	23'-9"	---
n49	30	#5	5'-10"	---
n50	36	#5	8'-0"	---
n51	24	#5	10'-3"	---
n52	12	#7	34'-10"	---
n53	16	#8	33'-0"	---
n54	8	#5	3'-6"	---
Class X Concrete		cu. yds.	50.6	
Reinforcement Bars		Lbs.	24920	
Concrete Piles		Lin. Ft.	17.2	
Test Piles (Concrete)		cu. yd.	1	

NORTH ABUTMENT  
NORTH BD. LAUES  
FAI. RT. 55 SEC. 57-94B  
MC LEAN COUNTY  
STA. 297+80.50


DESIGNED	J. D. [Signature]
CHECKED	[Signature]
DRAWN	J. D.
CHECKED	[Signature]

EXAMINED	[Signature]
PASSED	[Signature]
APPROVED	[Signature]



STATE OF ILLINOIS  
DEPARTMENT OF TRANSPORTATION

ROUTE NO.	SECTION	COUNTY	TOTAL SHEETS	SHEET NO.	SHEET NO.
55	57-9HB	MC LEAN	93	58	58 SHEETS
FED. ROAD DIST. NO. 7		ILLINOIS	FED. AID PROJECT		

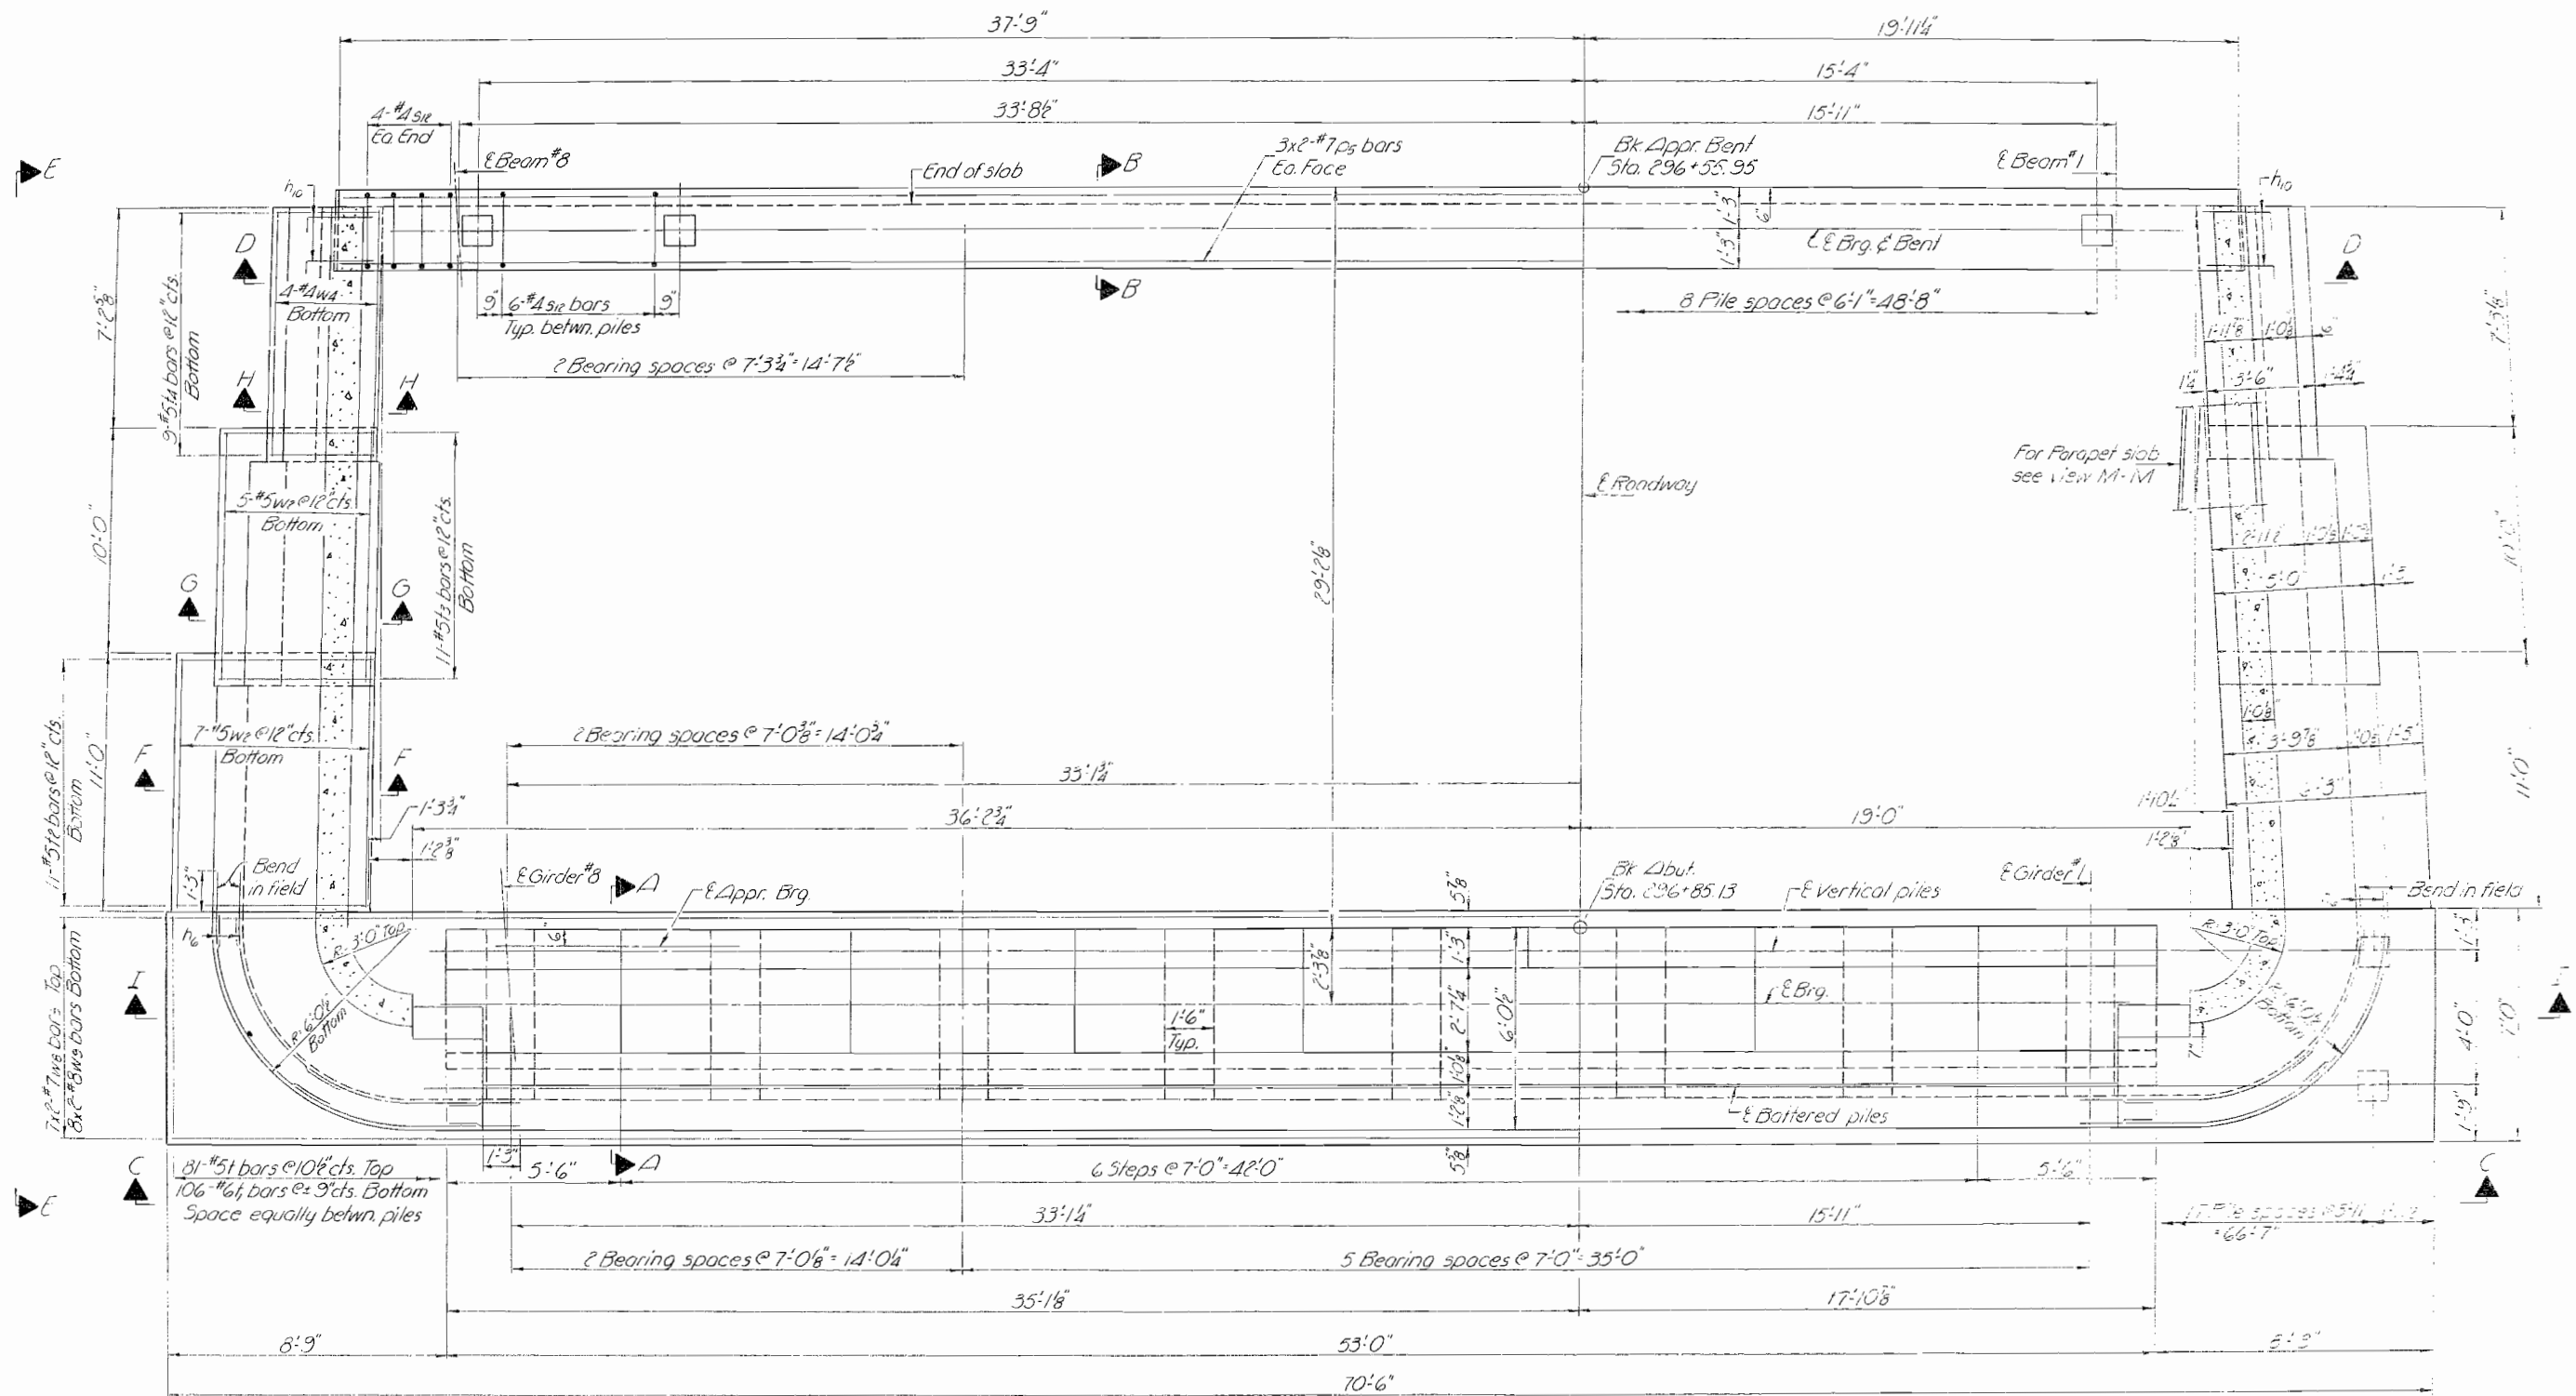

PLAN

DESIGNED	<i>A. J. Wherry</i>	EXAMINED	<i>[Signature]</i>
CHECKED	<i>[Signature]</i>	PASSED	<i>[Signature]</i>
DRAWN	<i>[Signature]</i>	APPROVED	<i>[Signature]</i>
CHECKED	<i>[Signature]</i>		

OCT. 20 1973


Note: Work this sheet with sheets #38, 39 & 40.

SOUTH ABUTMENT  
NORTH 5D. LANES  
F.D.I. RT. 55 SEC. 57-9HB  
MC LEAN COUNTY  
STA. 297+80.50


STATE OF ILLINOIS  
DEPARTMENT OF TRANSPORTATION

ROUTE NO.	SECTION	COUNTY	TOTAL SHEETS	SHEET NO.
155	57-94B	MC LEAN	93	59
FED. ROAD DIST. NO. 7		ILLINOIS	FED. AID PROJECT	


SHEET NO. 38  
58 SHEETS

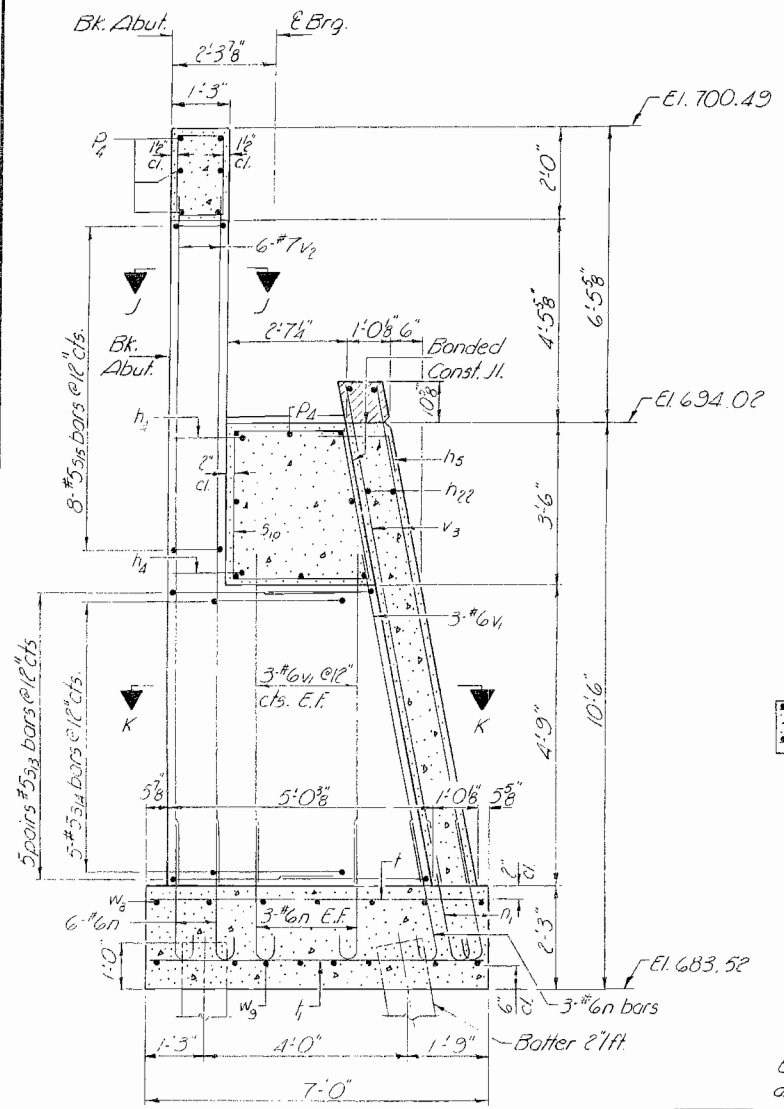


SEC. A-A

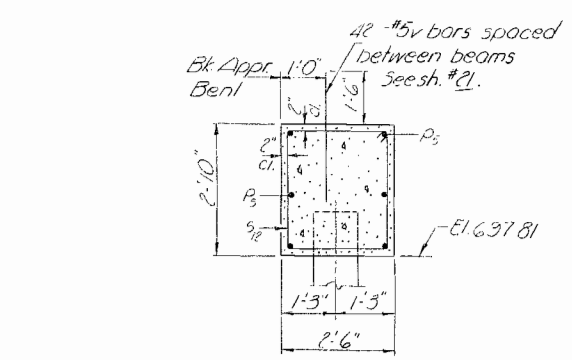


SEC. B-B

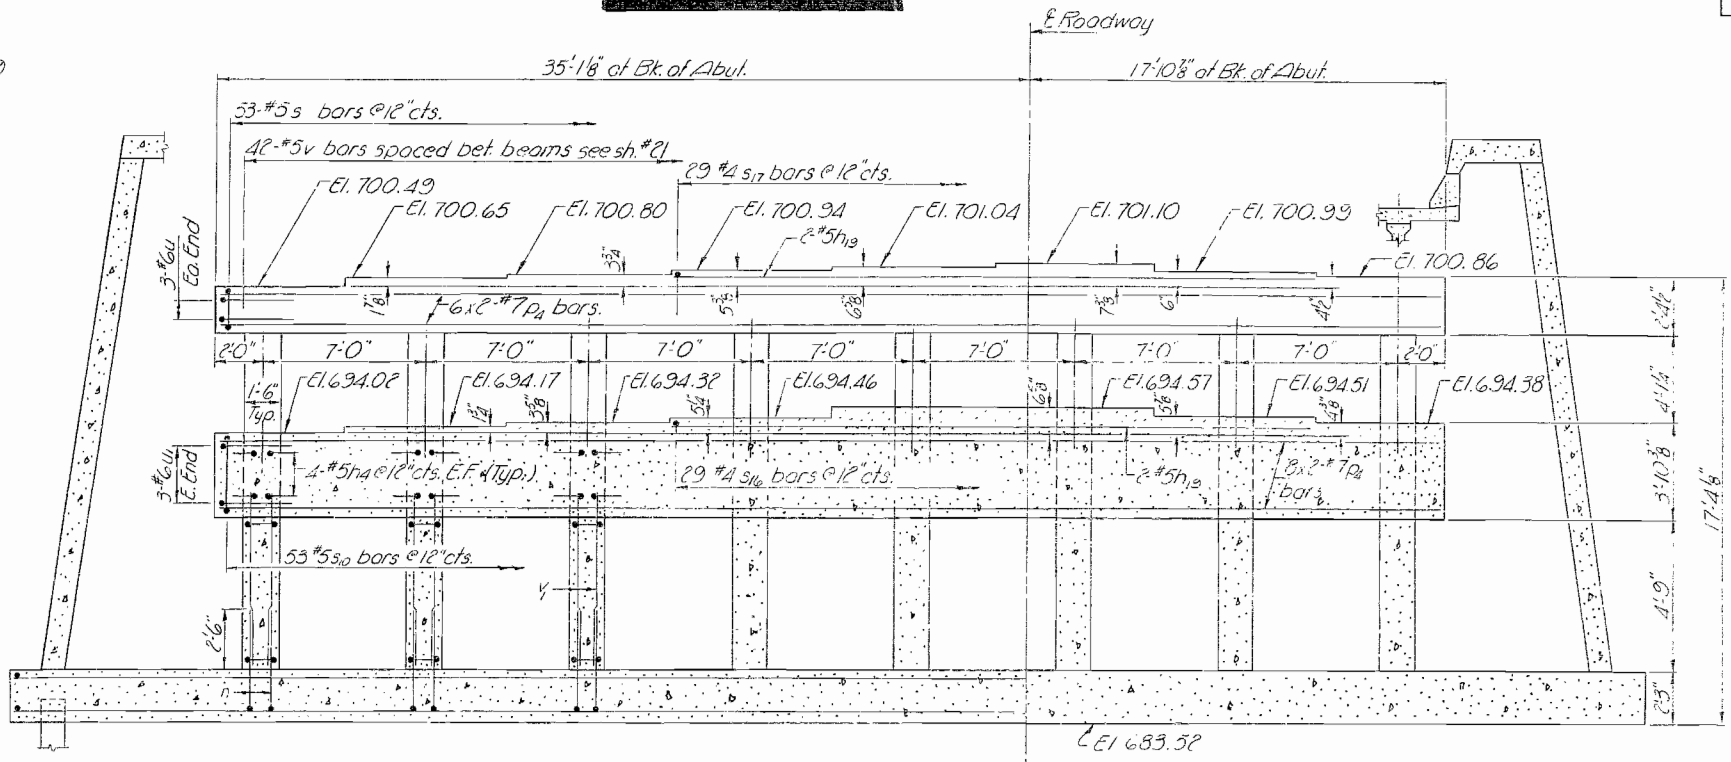

SECTION I-I

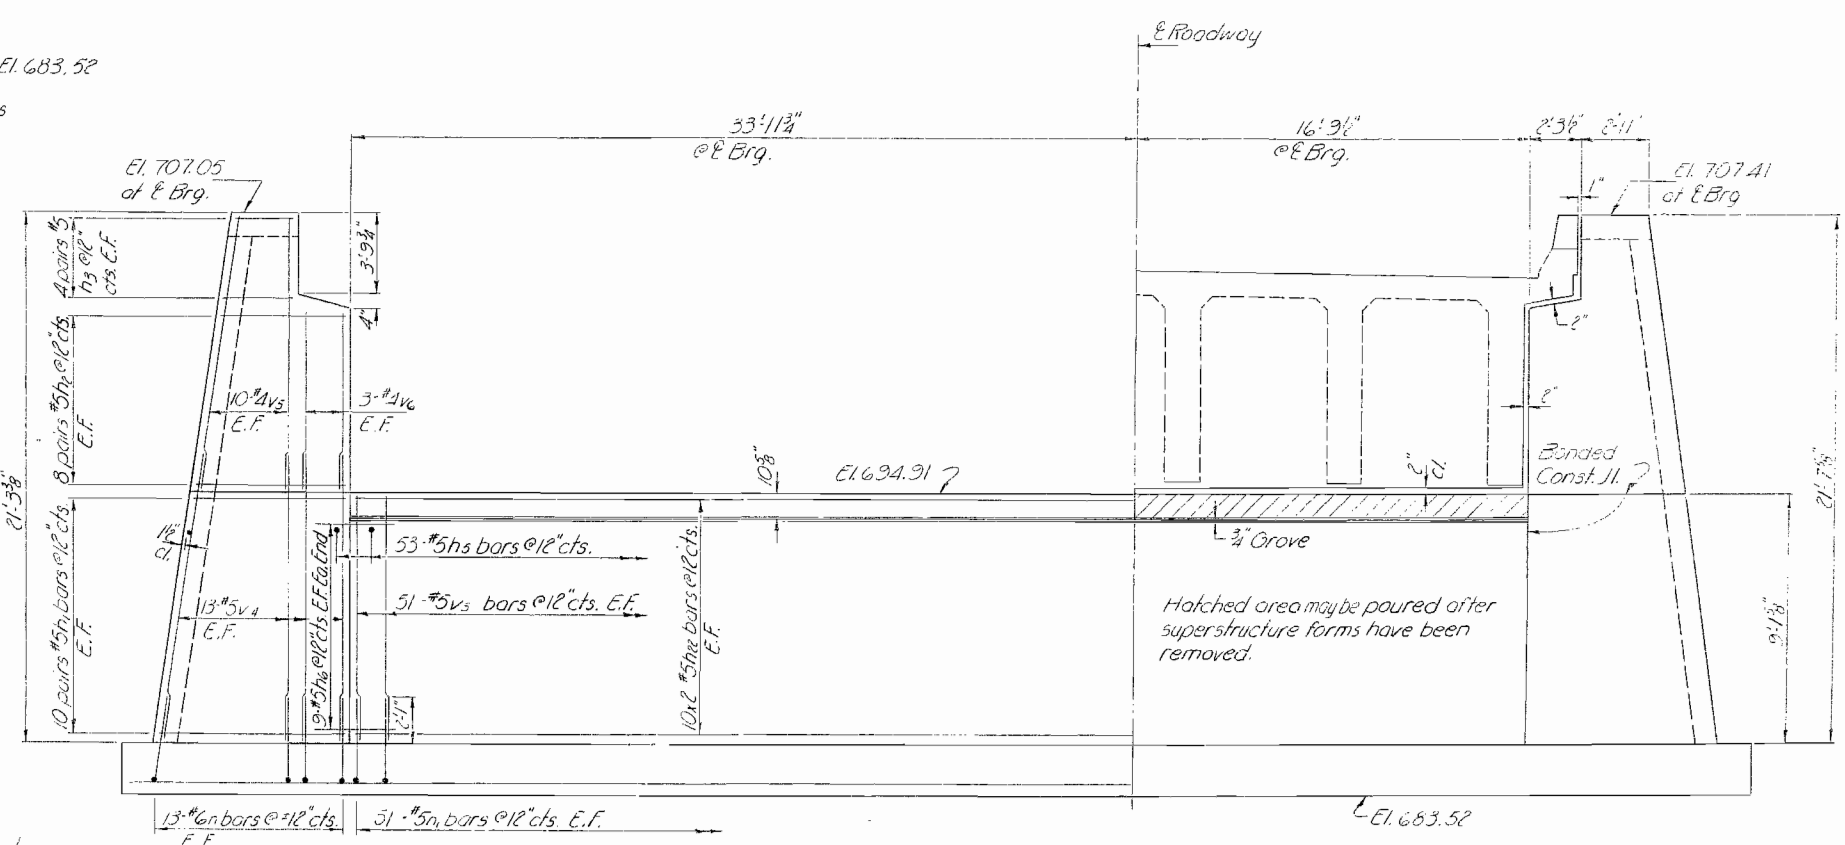

VIEW C-C

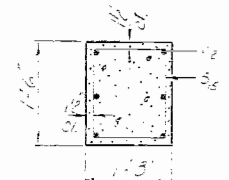

SEC. J-J



SEC. K-K

DESIGNED	A. J. Huggert
CHECKED	J. M. ...
DRAWN	J.D.
CHECKED	J.M.

EXAMINED  
PASSED  
APPROVED

*W. C. Baumann*  
ENGINEER OF DESIGN


*John H. Hollerman*  
CHIEF HIGHWAY ENGINEER

OCT 20 1952


SOUTH ABUTMENT  
NORTH BD. LAJES  
F.A.I. RT 55 SEC. 57-94B  
MC LEAN COUNTY  
STA. 297+80.50

STATE OF ILLINOIS  
DEPARTMENT OF TRANSPORTATION

ROUTE NO.	SECTION	COUNTY	TOTAL SHEETS	SHEET NO.	SHEET NO. 33
P.A.T. 55	57-9HB	MC LEAN	93	60	58 SHEETS
FED. ROAD DIST. NO. 7	ILLINOIS	FED. AID PROJECT			

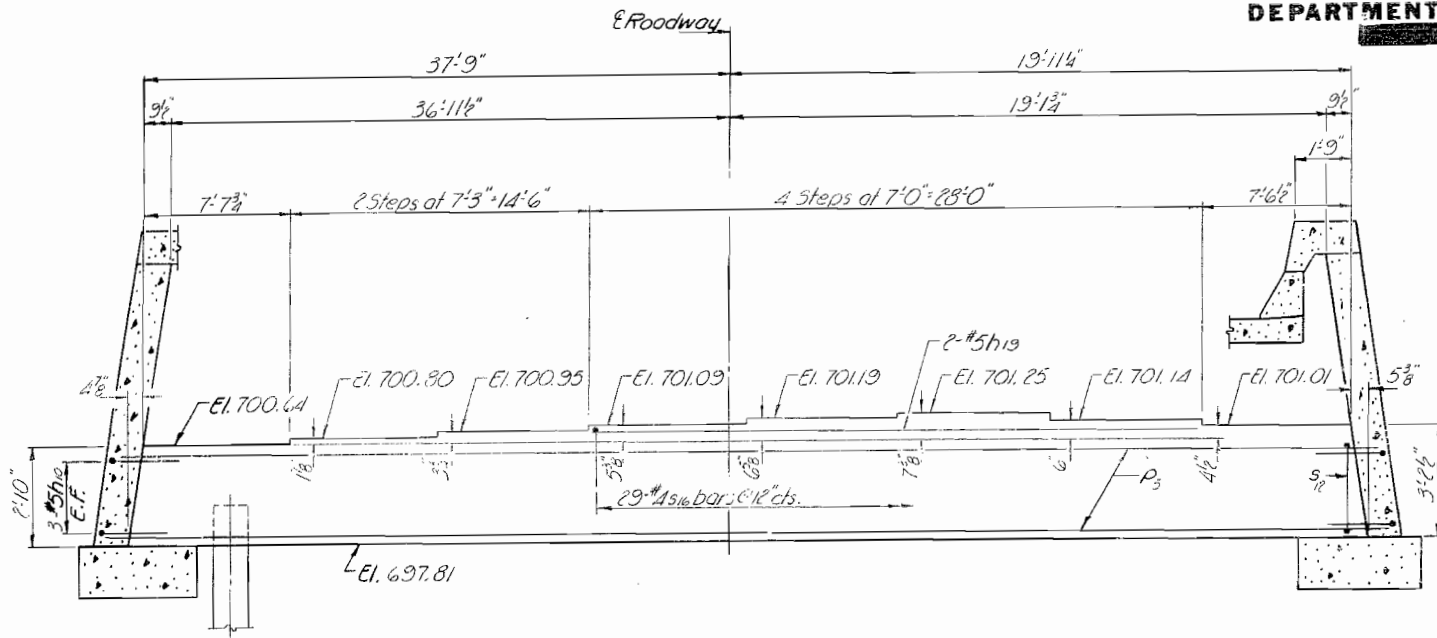


VIEW D-D

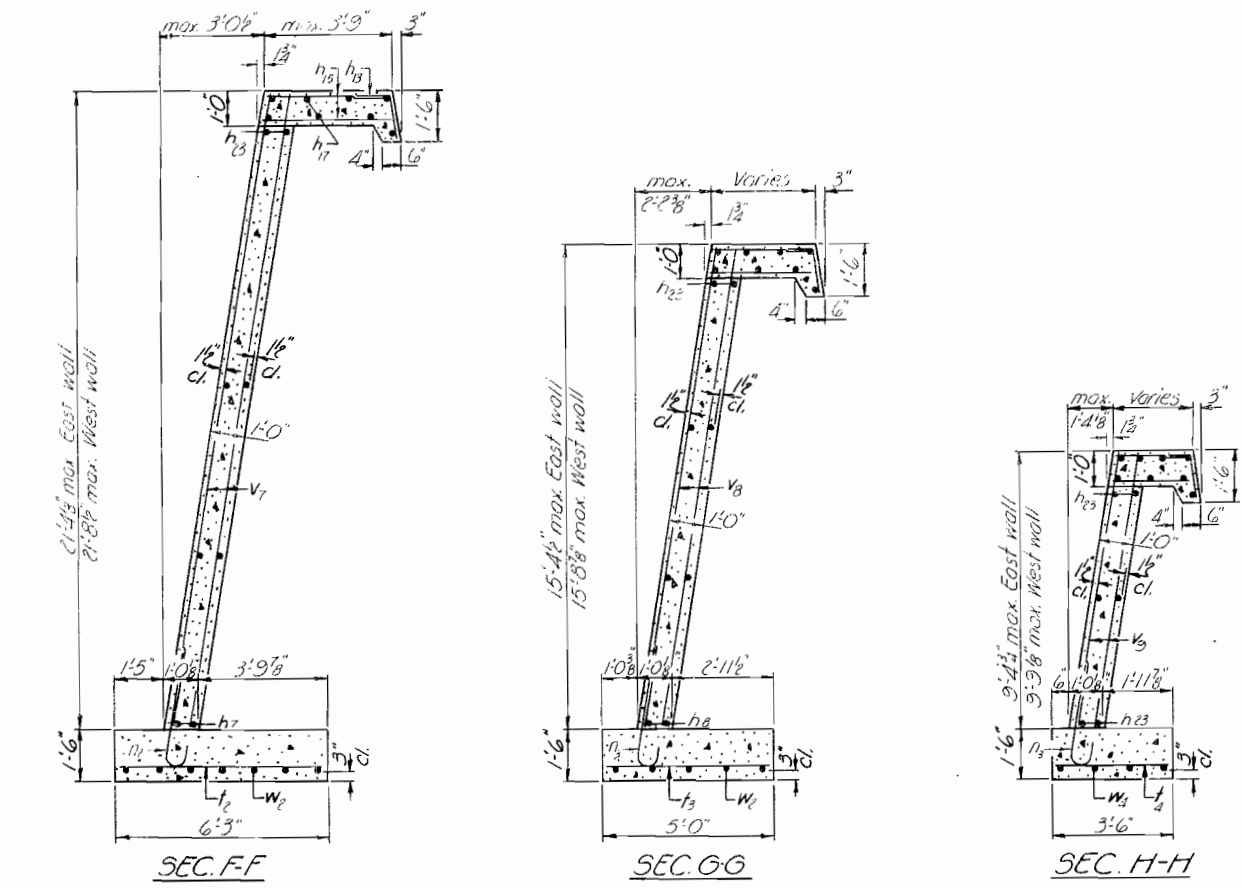


DESIGNED A.J. [Signature]  
CHECKED [Signature]  
DRAWN J.D.  
CHECKED [Signature]

EXAMINED [Signature]  
PASSED [Signature]  
APPROVED [Signature]


OCT 20 1972

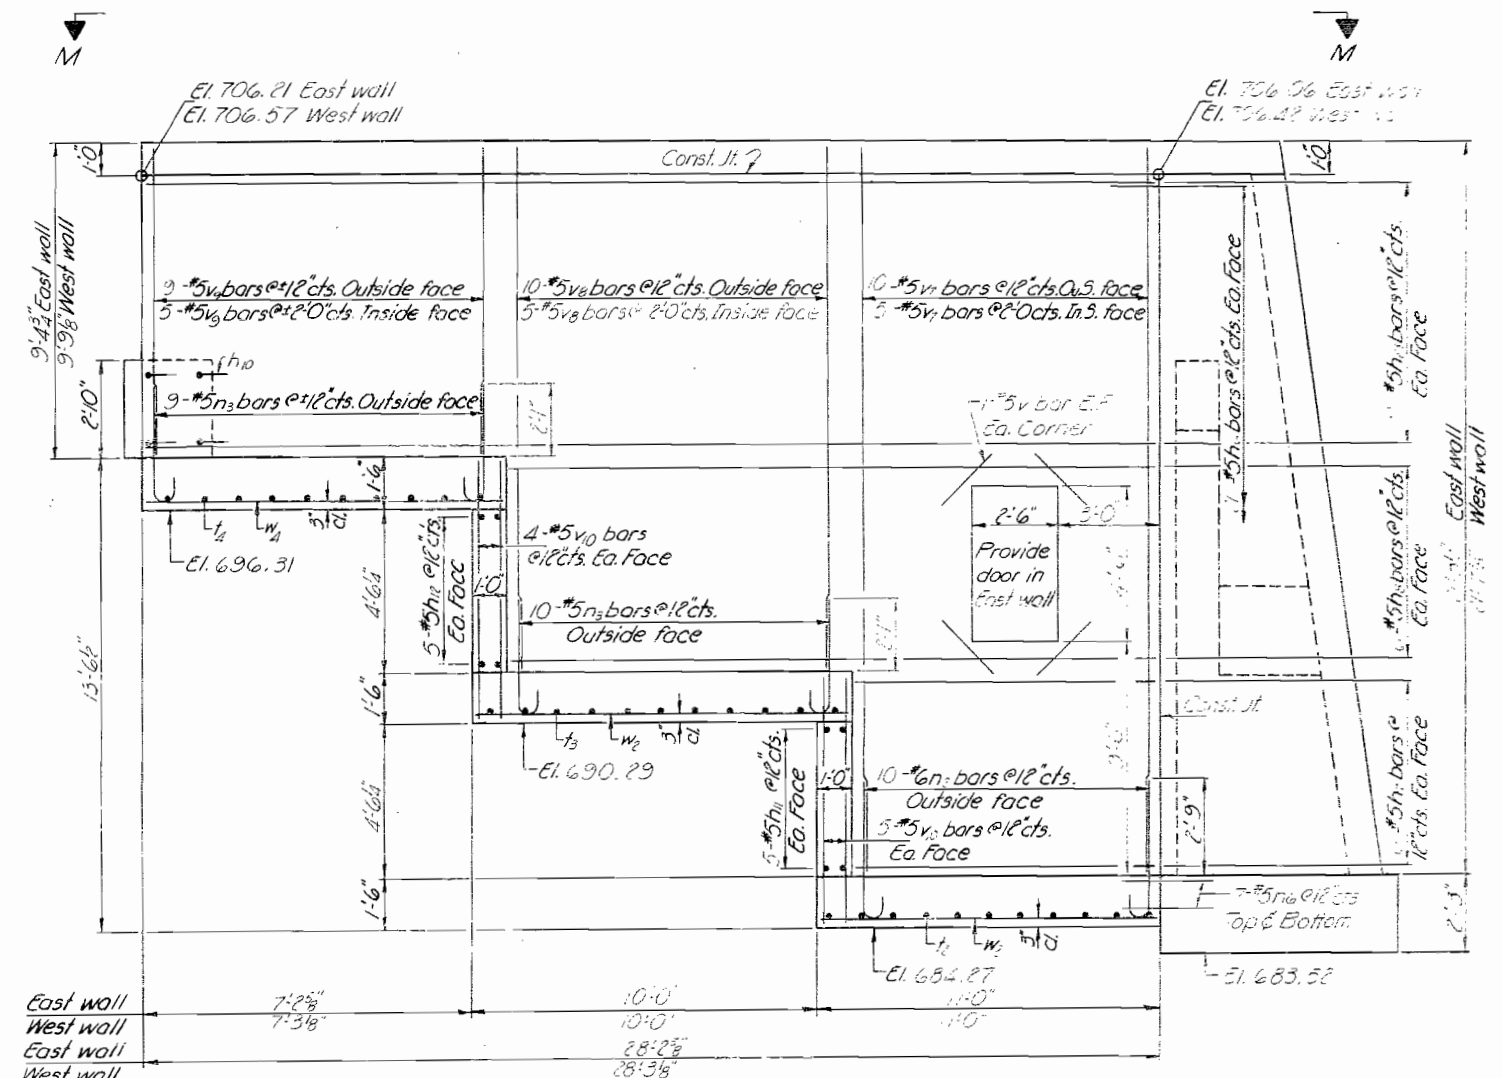

VIEW E-E

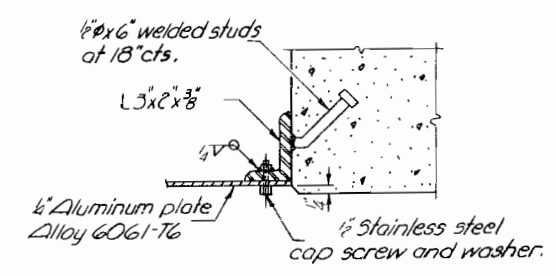

SEC. L-L

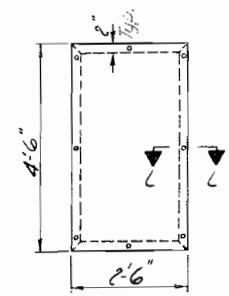


DOOR ELEVATION  
(Cost of door & frame are incidental)

Work this sheet with sheets #37, 38 & 40.

SOUTH ABUTMENT  
NORTH BD. LAUES  
P.A.T. 55 SEC. 57-9HB  
MC LEAN COUNTY  
STA. 297+80.50

STATE OF ILLINOIS  
DEPARTMENT OF TRANSPORTATION

ROUTE NO.	SECTION	COUNTY	TOTAL SHEETS	SHEET NO.
RT. 55	57-9HB	MC LEAN	93	61
PERMANENT NO. 7		ILLINOIS	PERMANENT NO.	

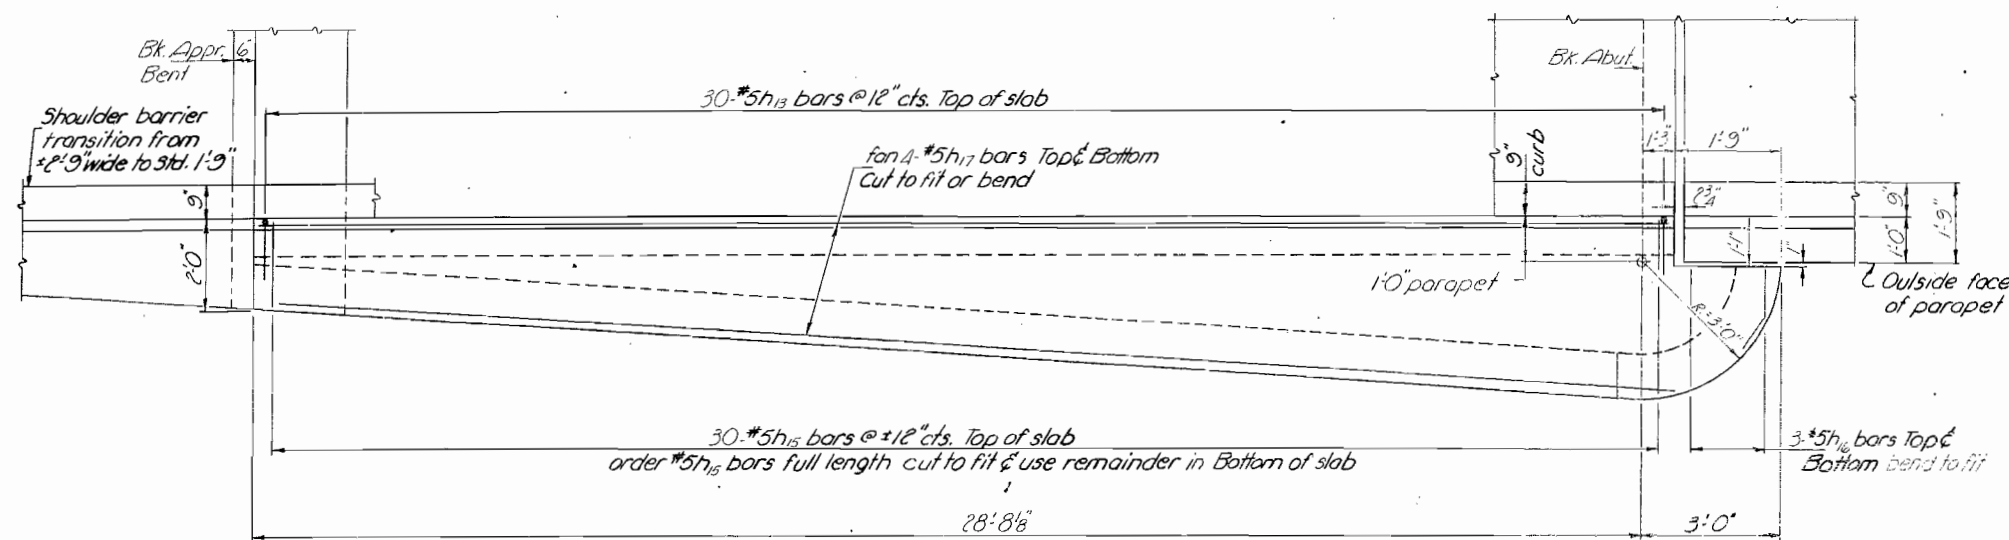

**APPR. BENT  
PILE DATA**

Type: Concrete  
Capacity: 35 Tons  
Est. Length: 38'  
No. Required: 9

**ABUTMENT  
PILE DATA**


Type: Concrete  
Capacity: 35 Tons  
Est. Length: 43'  
No. Required: 36

**BILL OF MATERIAL**

Bar	No.	Size	Length	Shape
n1	80	#5	7'-0"	—
n2	64	#5	6'-0"	—
n3	32	#5	3'-0"	—
n4	64	#5	2'-4"	—
n5	53	#5	2'-9"	—
n6	148	#5	2'-0"	—
n7	24	#5	3'-3"	—
n8	24	#5	3'-2"	—
n9	12	#5	2'-6"	—
n10	20	#5	2'-9"	—
n11	20	#5	2'-2"	—
n12	60	#5	2'-6"	—
n13	60	#5	2'-3"	—
n14	12	#5	2'-5"	—
n15	16	#5	3'-4"	—
n16	6	#5	2'-3"	—
n17	40	#5	2'-5"	—
n18	36	#5	2'-0"	—
n19	172	#6	4'-1"	—
n20	102	#5	2'-2"	—
n21	20	#6	2'-3"	—
n22	38	#5	3'-1"	—
n23	28	#7	2'-10"	—
n24	18	#7	3'-2"	—
n25	53	#5	12'-2"	—
n26	53	#5	6'-2"	—
n27	36	#4	10'-1"	—
n28	80	#5	7'-5"	—
n29	40	#5	7'-6"	—
n30	64	#5	5'-2"	—
n31	38	#4	2'-3"	—
n32	29	#4	2'-3"	—
n33	81	#5	2'-2"	—
n34	106	#6	3'-3"	—
n35	22	#5	6'-1"	—
n36	22	#5	2'-3"	—
n37	18	#5	3'-3"	—
n38	6	#6	5'-1"	—
n39	6	#6	7'-2"	—
n40	92	#5	3'-0"	—
n41	72	#6	6'-3"	—
n42	28	#7	4'-5"	—
n43	102	#5	8'-0"	—
n44	52	#5	10'-3"	—
n45	40	#4	11'-0"	—
n46	2	#4	7'-3"	—
n47	30	#3	2'-2"	—
n48	30	#5	15'-2"	—
n49	26	#5	3'-2"	—
n50	36	#5	7'-2"	—
n51	24	#5	0'-3"	—
n52	8	#5	8'-0"	—
n53	14	#7	3'-7"	—
n54	16	#8	3'-10"	—
Class X Concrete		Cu.Yds.	153.2	
Reinforcement Bars		Lbs.	23580	
Concrete Piles		Lin. Ft.	1830	

**VIEW M-M**

Showing reinforcement in slab above walls  
Typ. for both walls

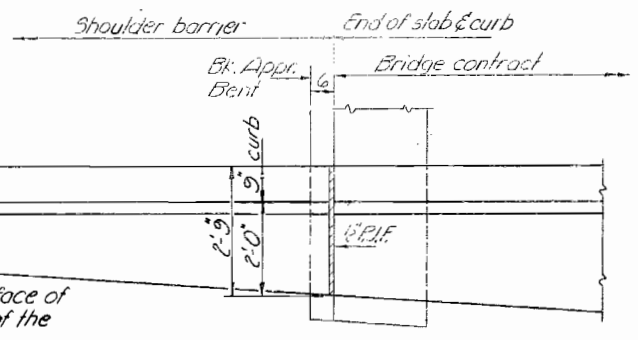

The slope of the outside face of barrier is in continuation of the sloped abutment walls.

**PLAN**


Showing transition of shoulder barrier

**BARS S12, S16 & S17**


Bar	A	B
S12	3'-1"	1'-3"
S16	1'-3"	2'-2"
S17	1'-3"	1'-0"

**BARS n thru n3**


4'-3"	8"	n
3'-10"	7"	n1
4'-0"	8"	n2
3'-4"	7"	n3

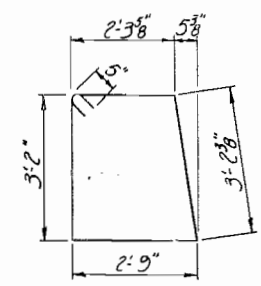


BAR S10

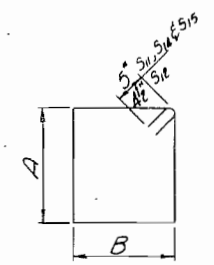


BARS S14, S12, S16 & S15

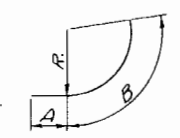


BARS h1, h2 & h3

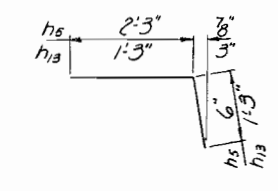

BARS h5 & h13

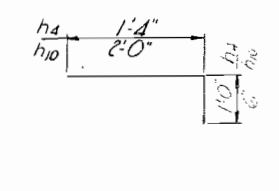

BARS h4 & h10

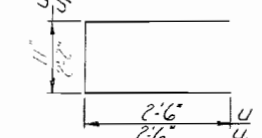

BARS U & U1

Bar	A	B
S11	1'-9"	1'-0"
S12	2'-6"	2'-2"
S14	2'-1"	1'-3"
S15	1'-3"	1'-0"

Bar	R	A	B
h1	5'-9"	2'-0"	5'-0"
h2	4'-5"	2'-0"	4'-0"
h3	3'-2"	0	3'-0"

Cut h1, h2 & h3 in the field to fit if necessary.

DESIGNED: A. J. [Signature]  
CHECKED: [Signature]  
DRAWN: J. D. [Signature]  
CHECKED: [Signature]


OCT. 20 1972  
EXAMINED: [Signature]  
PASSED: H. E. Baumann  
APPROVED: Richard A. Hollerman

**SOUTH ABUTMENT  
NORTH BD. LAUES  
FAI. RT. 55 SEC. 57-9HB  
MC LEAN COUNTY  
STA. 297+80.50**




STATE OF ILLINOIS  
DEPARTMENT OF TRANSPORTATION

ROUTE NO.	SECTION	COUNTY	TOTAL SHEETS	SHEET NO.	SHEETS
55	57-9AB	MCLEAN	93	63	93
FED. ROAD DIST. NO. 7	ILLINOIS	FED. AID PROJECT			

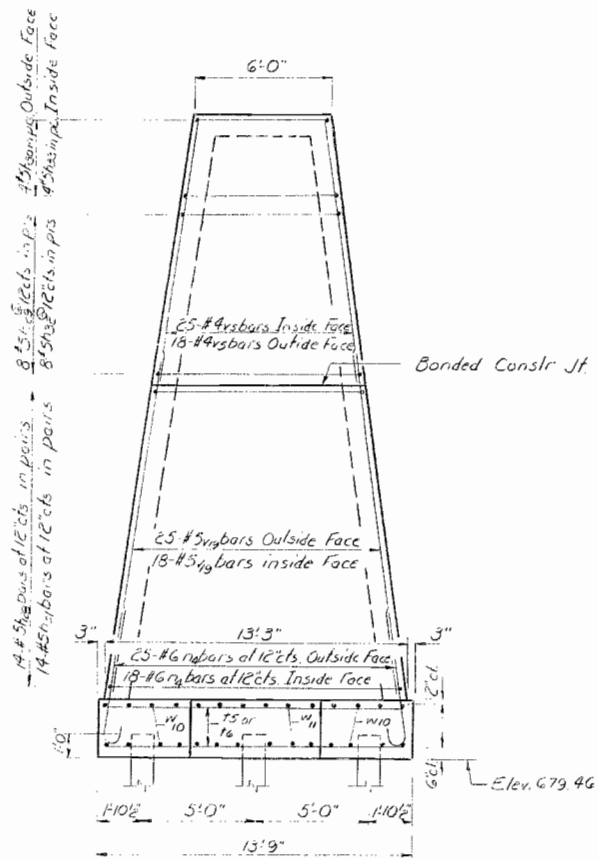


END VIEW


\* Order w/d of top bars full length  
Cut to fit and use remainder of bars  
in top of footing

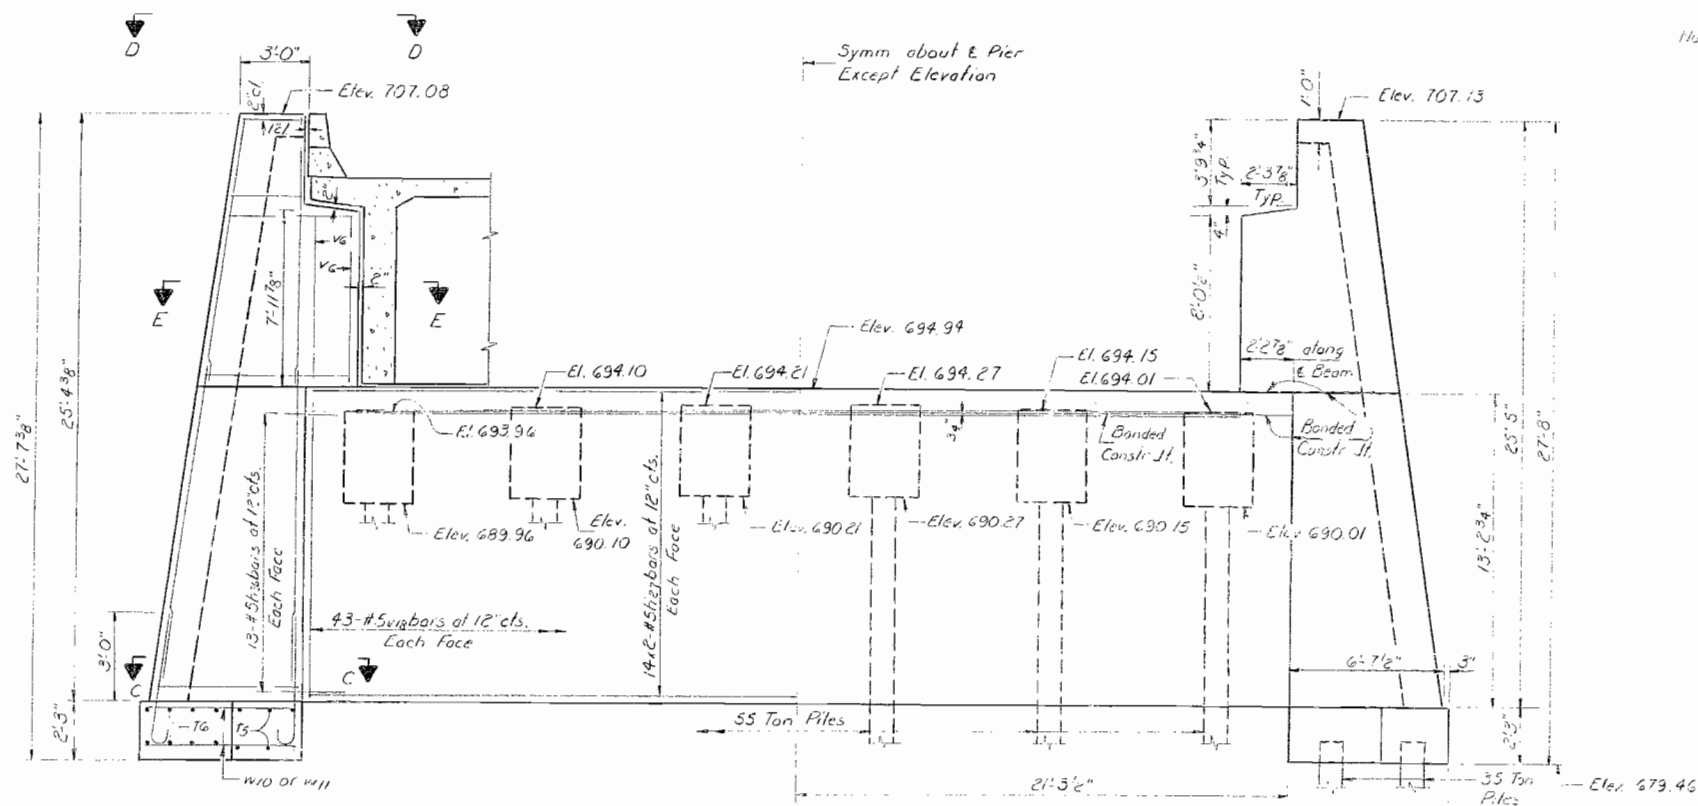


ELEVATION  
Looking North

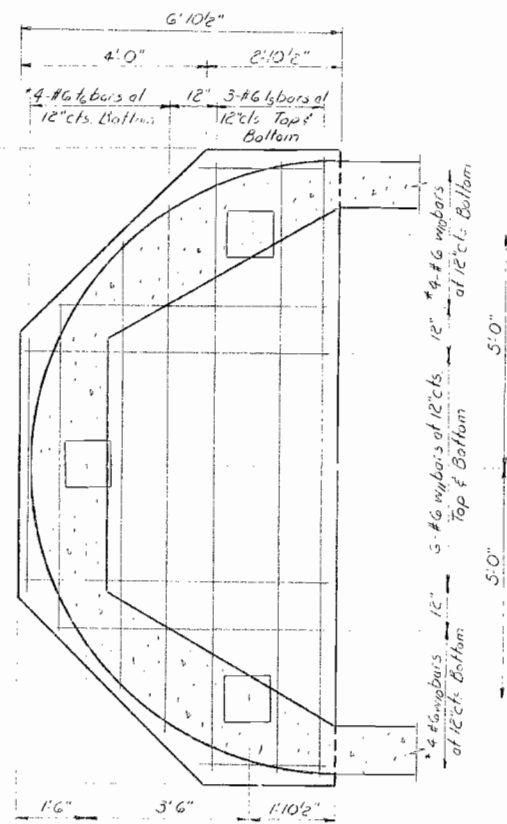

SECTION C-C

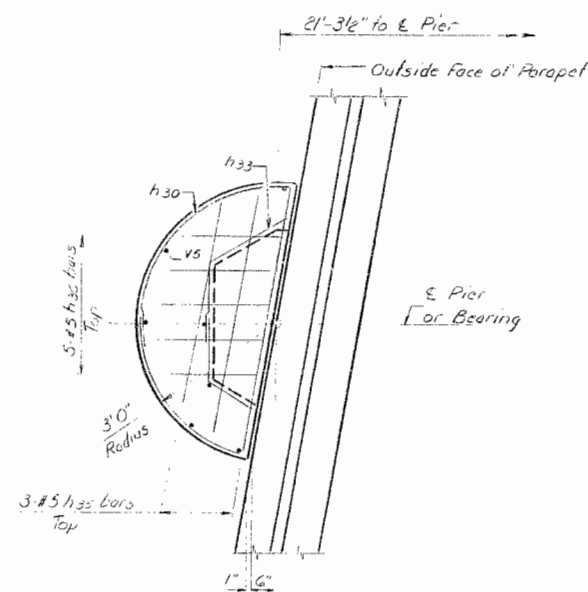

VIEW D-D

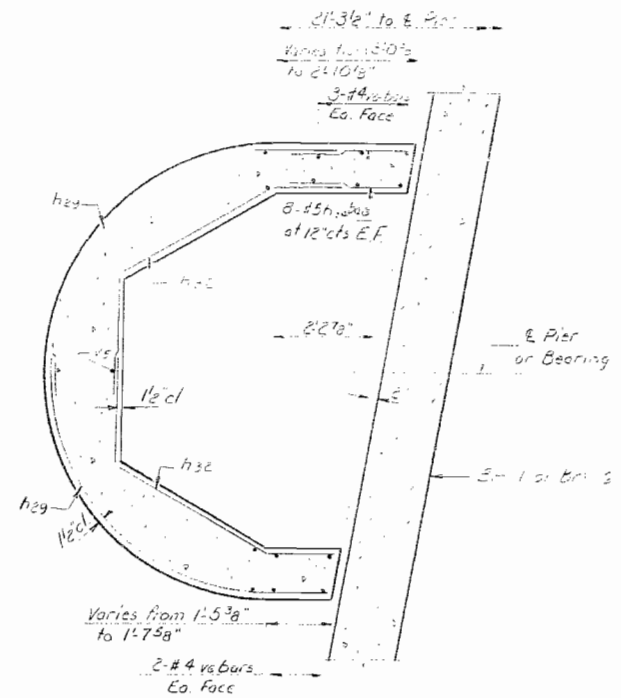

SECTION E-E

Note:  
Hatched area to be poured after forms  
of Superstructure have been removed.

Note:  
For Bars h30 thru h33 of na see sheet # 63

DESIGNED	J. Lindsey
CHECKED	J. Lindsey
DRAWN	S.E. Lindsey
CHECKED	J. Lindsey

EXAMINED	Richard A. Holzman
PASSED	Richard A. Holzman
APPROVED	Richard A. Holzman

PIER 1  
SOUTH BOUND LANE  
FAI RT. 55 SEC. 37-9 AB  
MCLEAN COUNTY  
STA. 297+80.50



STATE OF ILLINOIS  
DEPARTMENT OF TRANSPORTATION

ROUTE NO.	SECTION	COUNTY	TOTAL SHEETS	SHEET NO.
55	57-9HB	MC LEAN	93	64
SHEETS				


FILE DATA

PILE BENT

Type: Concrete  
Capacity: 55 Tons  
Length: 54'  
No. Reg'd: 18

SHELL FOOTING


Type: Concrete  
Capacity: 55 Tons  
Length: 41'  
No. Reg'd: 6

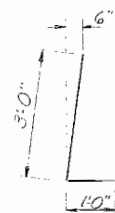


BAR h24




BAR h24

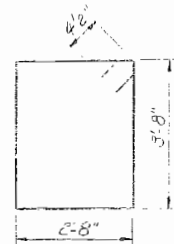


BAR s18

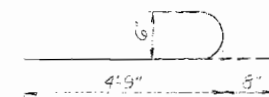


BAR r4

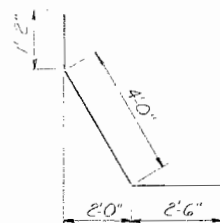

BAR h32

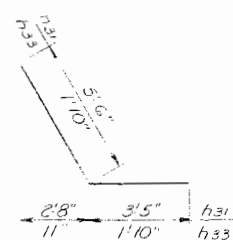

BARS h31 & h33

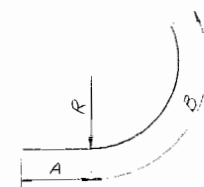

BARS h28, h29, & h30

BILL OF MATERIAL

Bar	No.	Size	Length	Notes
h24	60	#7	4'-0"	
h24	60	#7	4'-0"	
h24	104	#5	2'-6"	
h27	112	#5	2'-10"	
h28	56	#5	10'-9"	
h29	32	#5	8'-11"	
h30	18	#5	6'-0"	
r4	54	#5	8'-11"	
h32	16	#5	7'-5"	
h32	16	#5	3'-8"	
h33	32	#5	2'-9"	
h33	6	#5	5'-0"	
h33	10	#5	2'-3"	
s18	24	#6	5'-5"	
r4	36	#7	7'-8"	
s18	48	#4	17'-5"	
r4	12	#6	13'-0"	
r4	8	#6	17'-6"	
s18	80	#4	11'-10"	
v6	20	#4	7'-2"	
v12	170	#5	15'-5"	
v12	80	#5	4'-4"	
v12	10	#6	9'-0"	
v12	24	#6	5'-7"	

Concrete  
Reinforcement Bars  
Surch. Area

Note: Cut or bend bars h31, h32 & h33 to fit if necessary.

Bar	R	A	B
h28	6'-4"	0"	10'-9"
h29	4'-7"	1'-2"	7'-9"
h30	3'-5"	0"	6'-0"


DESIGNED	J. H. Lindsey
CHECKED	J. H. Lindsey
DRAWN	J. H. Lindsey
CHECKED	J. H. Lindsey

OCT. 20 1972  
EXAMINED  
PASSED  
APPROVED


PIER 1  
SOUTH BOUND LANE  
FAI RT. 55 SEC 57-9 HE  
MCLEAN COUNTY  
STA 297+80.50

STATE OF ILLINOIS  
DEPARTMENT OF TRANSPORTATION

ROUTE NO.	SECTION	COUNTY	TOTAL SHEETS	SHEET NO.	SHEET NO.
55	57-9HB	MC LEAN	93	65	28 SHEETS
FED ROAD DIST. NO. 7		ILLINOIS	FED AID PROJECT		

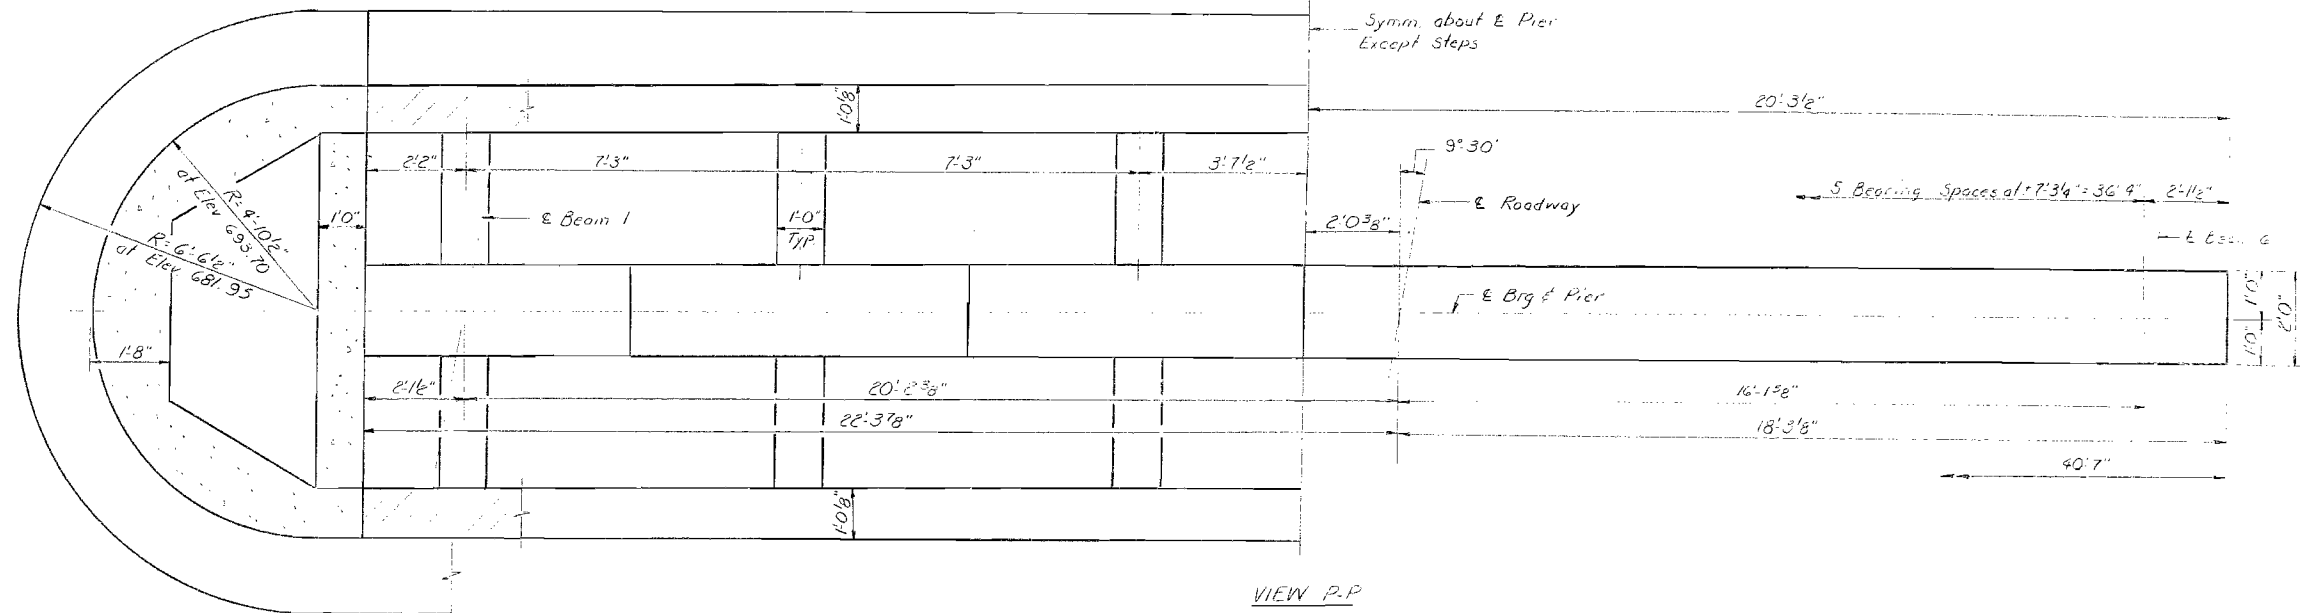

Notes:  
All edges shall have standard 3/4 concrete unless otherwise noted.  
For bars see sheet #47.  
For Bill of Material see sheet #47.  
For Sec. A-A see sheet #45.

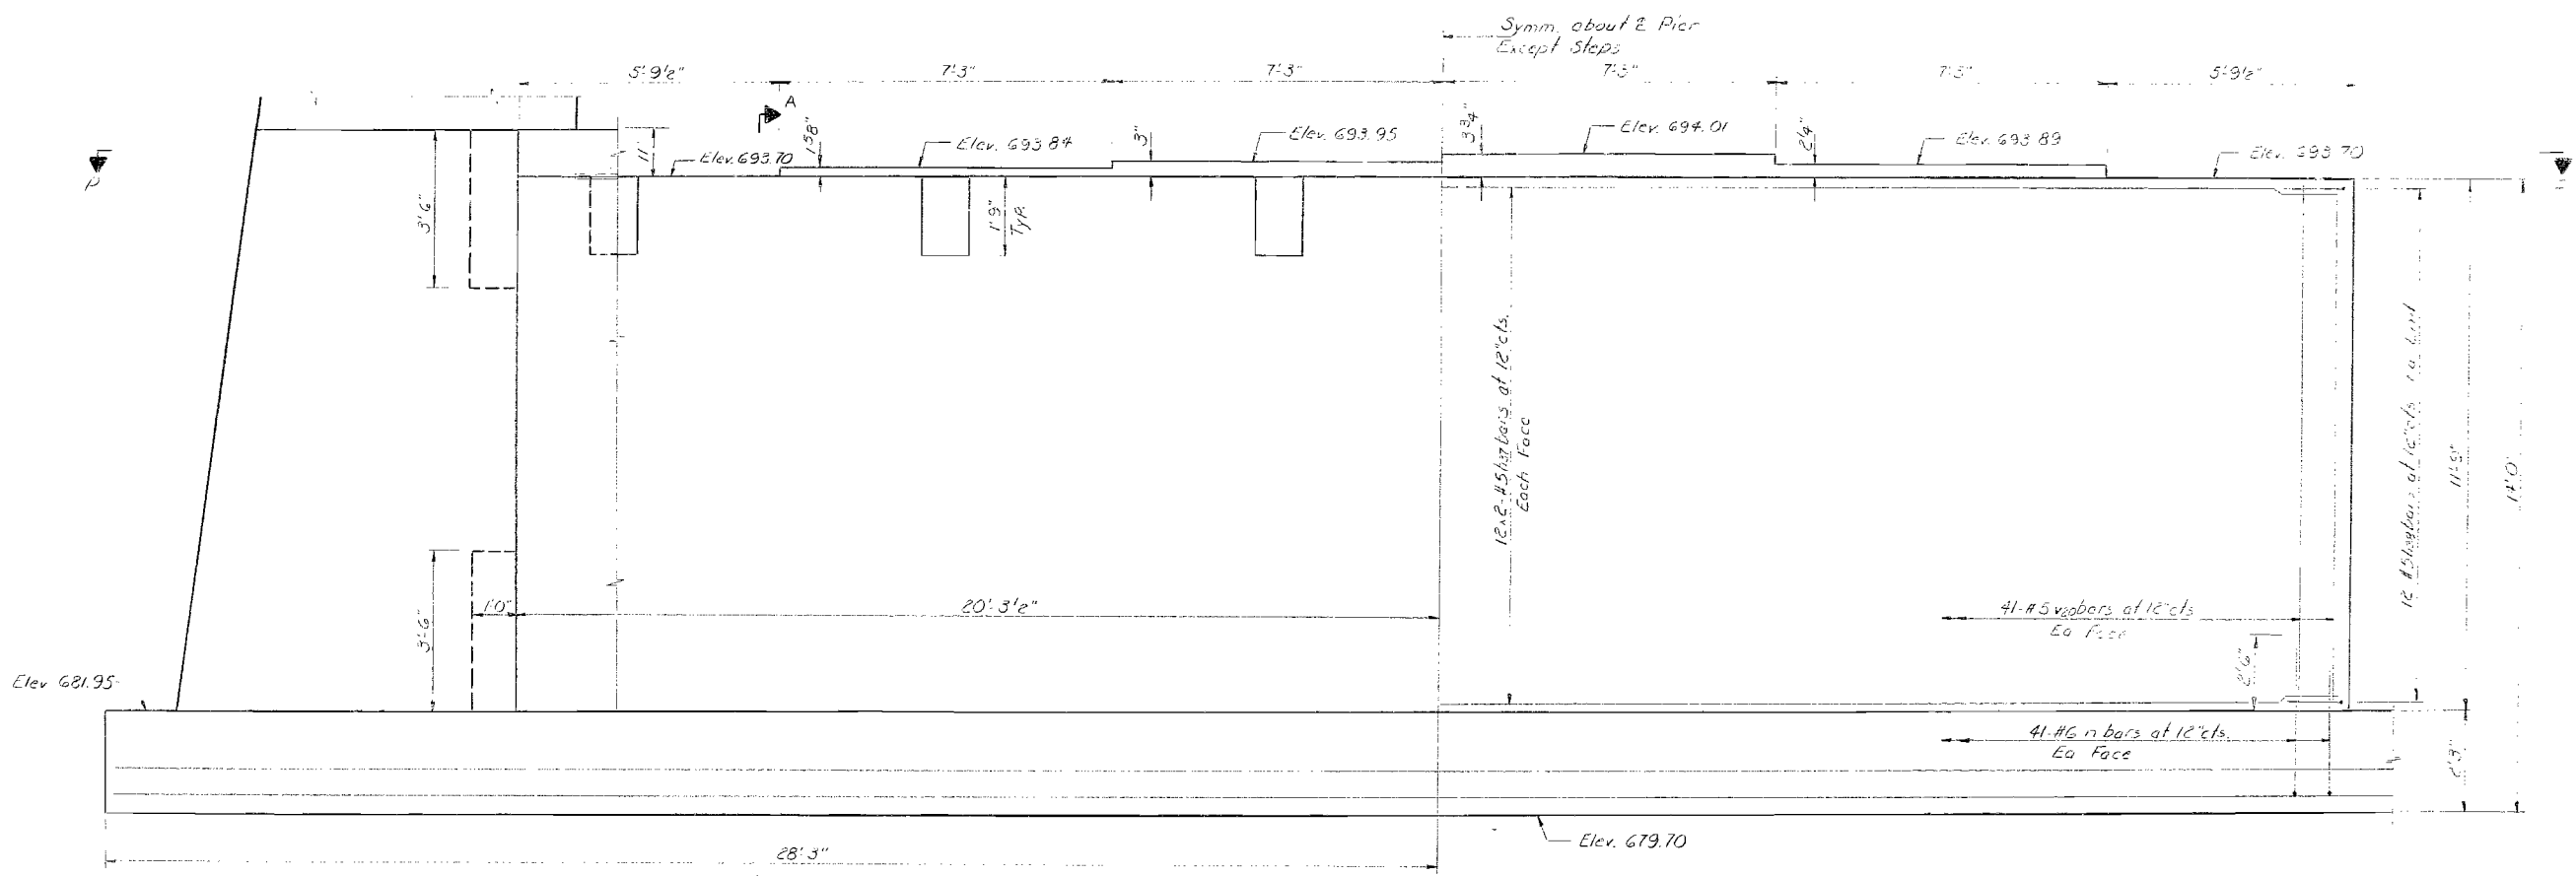


STEM  
ELEVATION  
Looking North

DESIGNED	A. J. Blazynski	EXAMINED	[Signature]
CHECKED	J. M. V. [Signature]	PASSED	[Signature]
DRAWN	S. E. Lindsey	APPROVED	[Signature]
CHECKED	L. M. P.		

PIER E  
SOUTH BOUND LANE  
FAI. RT. 55 SEC. 57-9 HB  
MCLEAN COUNTY  
STA 297+80.50


STATE OF ILLINOIS  
DEPARTMENT OF TRANSPORTATION

ROUTE NO.	SECTION	COUNTY	TOTAL SHEETS	SHEET NO.	SHEET NO.
55	57-9HB	MC LEAN	93	66	56 SHEETS
FED. ROAD DIST. NO. 7	ILLINOIS	FED. AID PROJ. EST.			

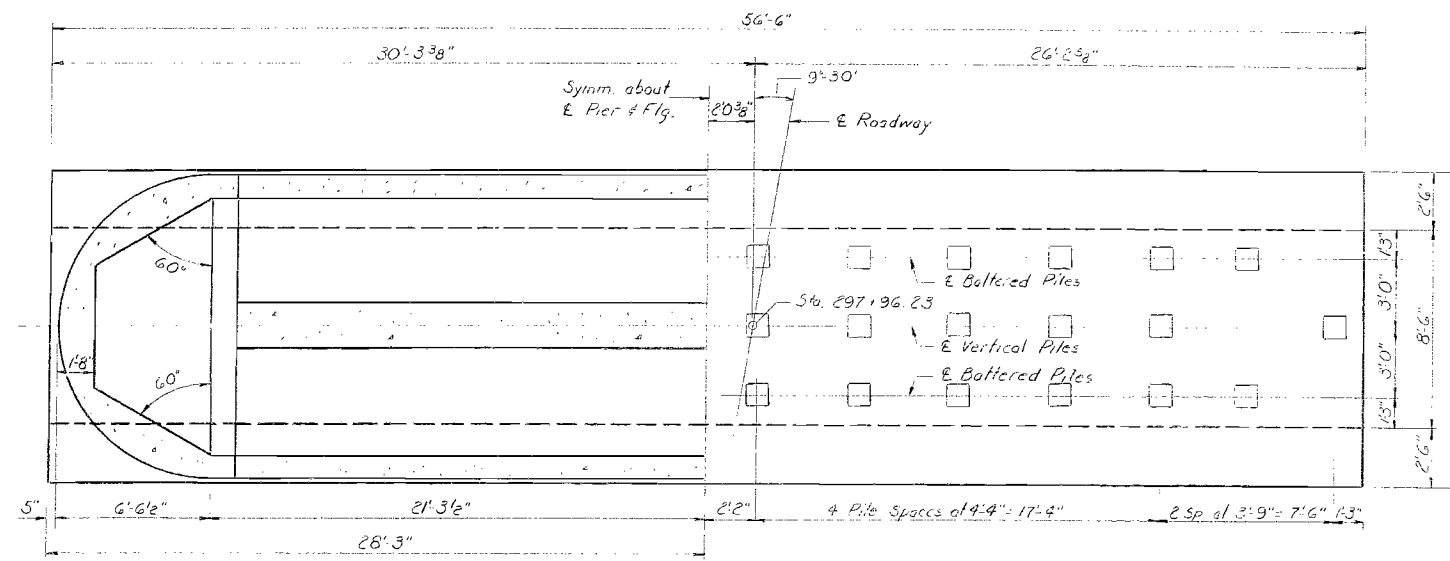


FOOTING PLAN  
Showing dimensions & pile layout

Notes:  
 Hatched area may be poured after forming of  
 superstructure have been removed.  
 For small elevation details see sheet #45  
 For bars h29, h32, h40, h42, n8, s19, s22, etc.  
 see sheet #47  
 For Section D-D see sheet #47

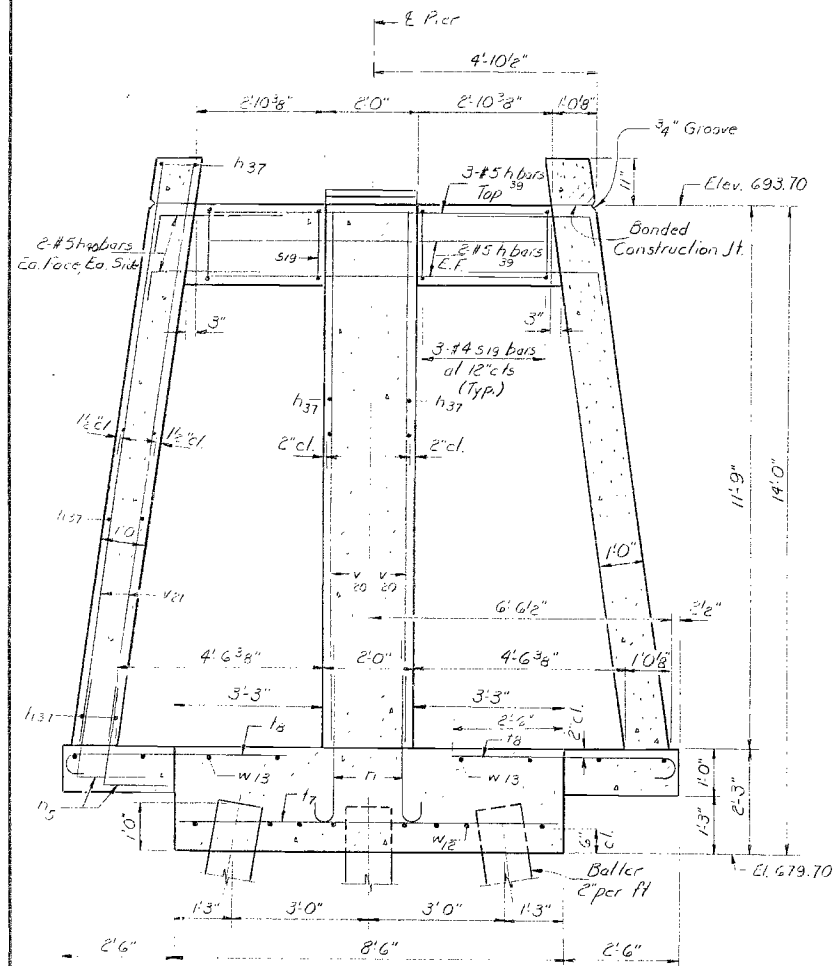

SECTION A-A

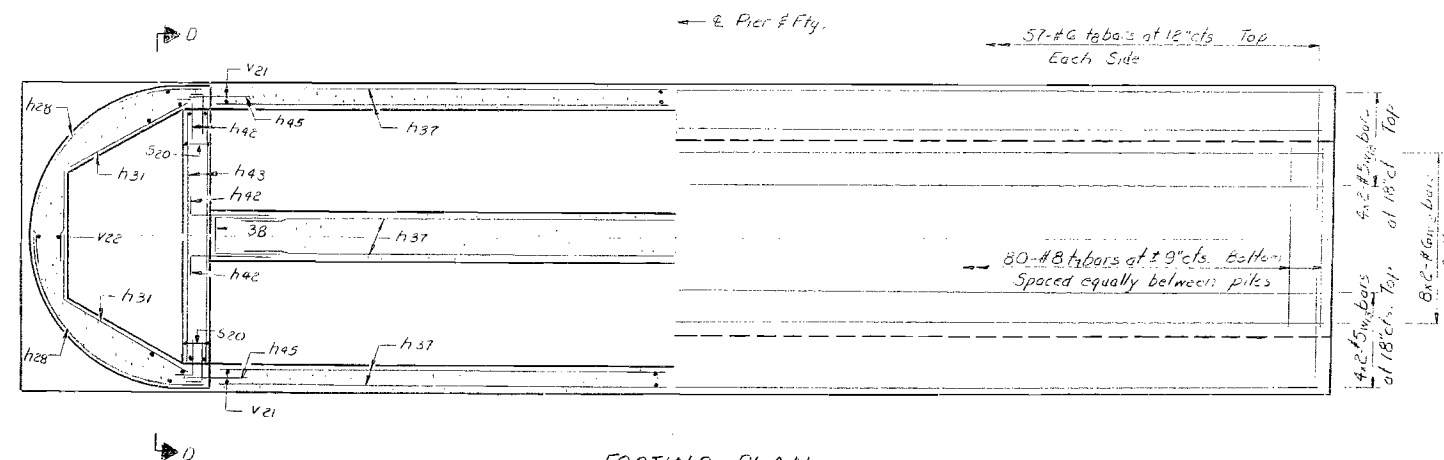

FOOTING PLAN  
Showing Reinforcement



DESIGNED: M. Mayjat
CHECKED: J. M. Ridel
DRAWN: S.E. Lindsey
CHECKED: J. M. Ridel

OCT. 20 1972  
 EXAMINED: [Signature]  
 PASSED: [Signature]  
 APPROVED: Richard J. Holterman  
 CHIEF HIGHWAY ENGINEER



PIER 2  
 SOUTH BOUND LANE  
 FAT RT. 55 SEC. 57-9HB  
 MC LEAN COUNTY  
 STA. 297+60.50

STATE OF ILLINOIS  
DEPARTMENT OF TRANSPORTATION

ROUTE NO.	SECTION	COUNTY	TOTAL SHEETS	SHEET NO.
RT. 55	57-9HB	MCLEAN	93	47
SHEETS				

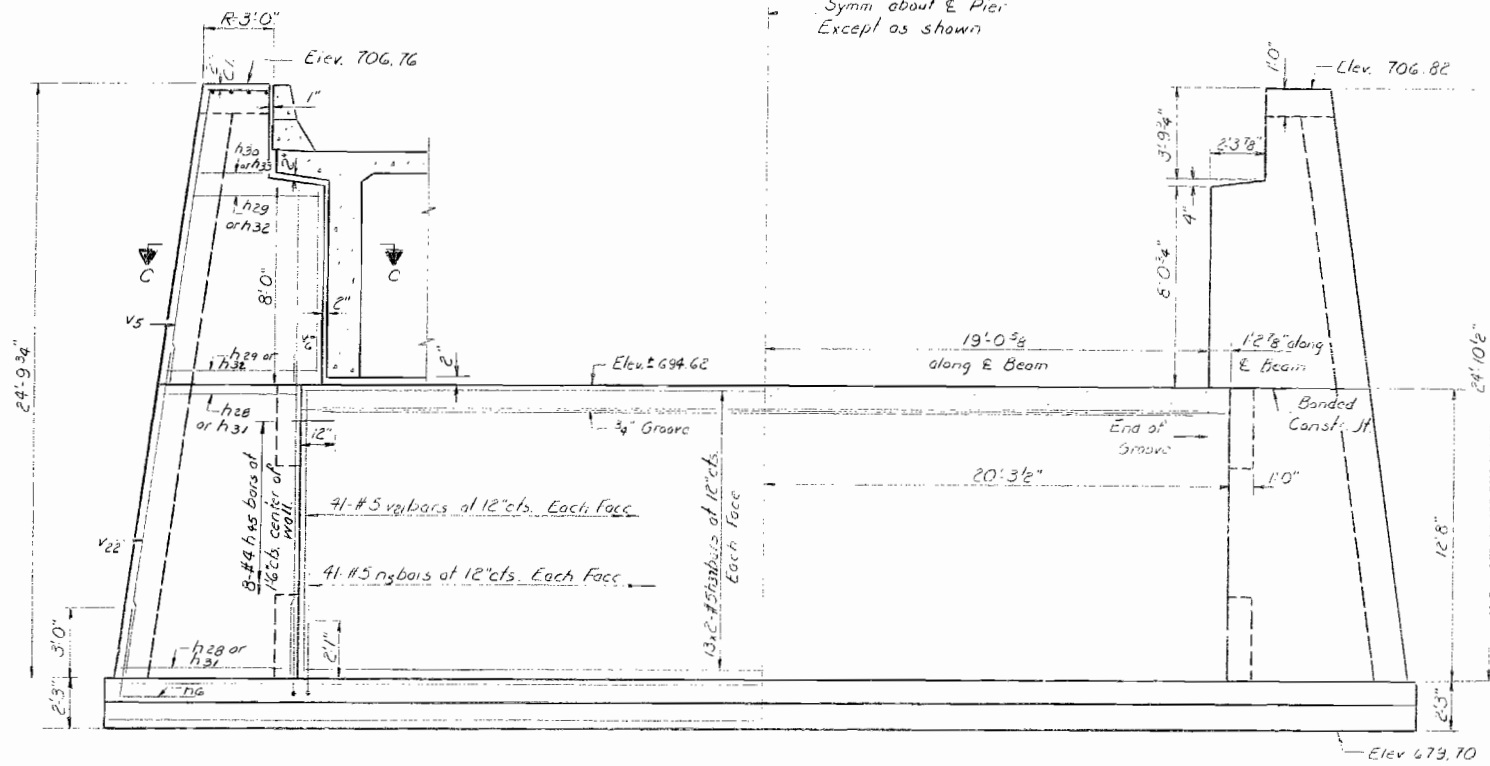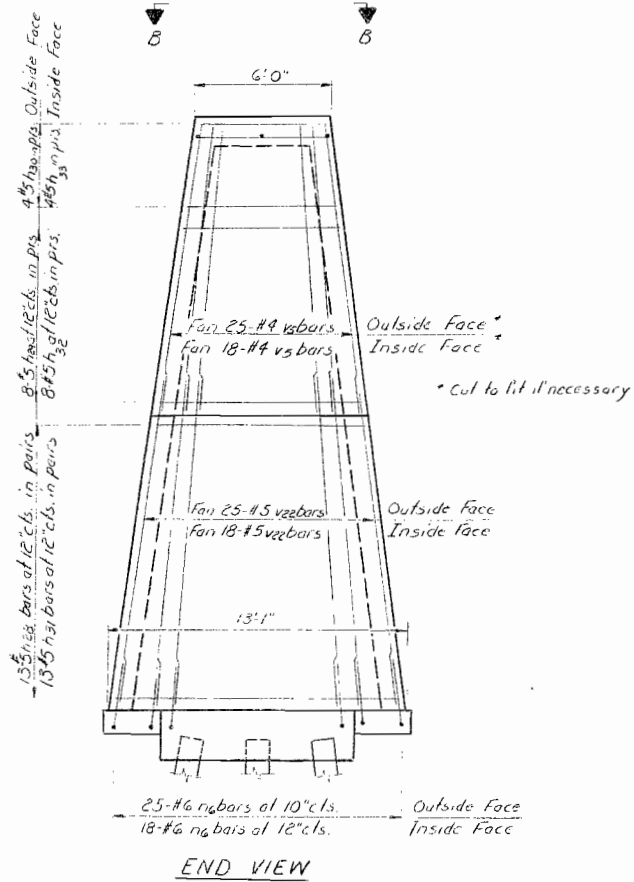

SHELL  
ELEVATION  
Looking North

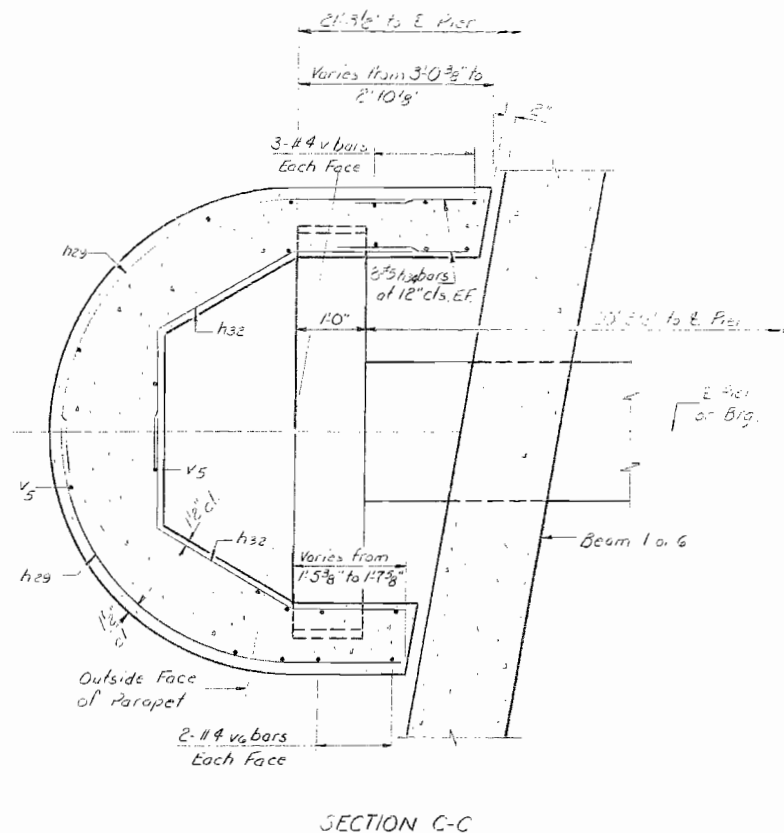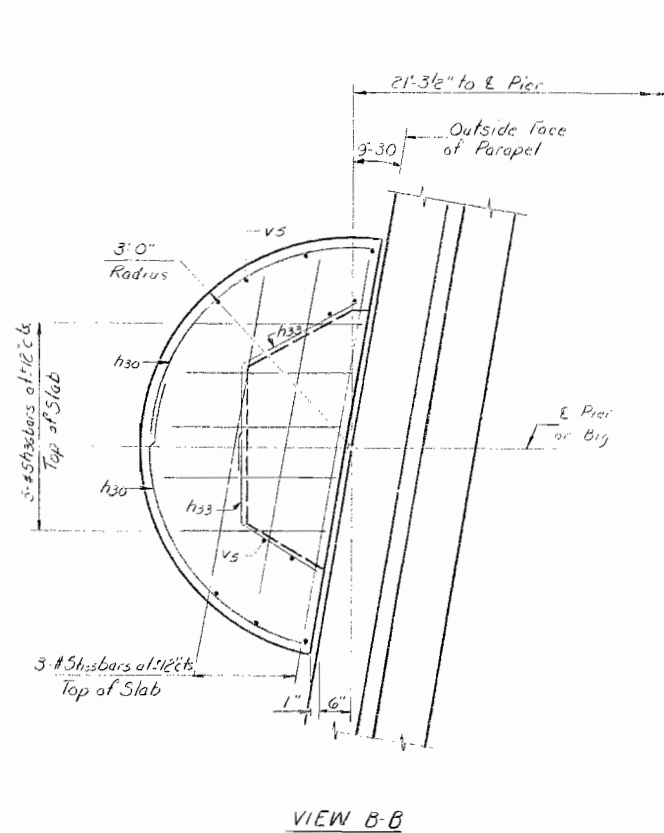

Notes:  
Work to sheet with sheets 44 thru 47

DESIGNED	A. J. Lindsey
CHECKED	L. P. J.
DRAWN	S. E. Lindsey
CHECKED	L. P. J.

OCT 20 1972  
EXAMINED  
PASSED  
APPROVED  
Richard J. Holterman  
CHIEF HIGHWAY ENGINEER


PIER 2  
SOUTH BOUND LANE  
FAI. RT. 55 SEC 57-9HB  
MCLEAN COUNTY  
STA. 297+80.50

STATE OF ILLINOIS  
DEPARTMENT OF TRANSPORTATION


ROUTE NO.	SECTION	COUNTY	TOTAL SHEETS	SHEET NO.
55	57-9HB	MC LEAN	93	68
FED. ROAD DIST. NO. 7		ALIND'S	FED. AID PROJECT	SHEET NO. 47
				55 SHEETS

PILE DATA

Type: Concrete  
Capacity: 35 Tons  
Length: 41'  
No. Req'd: 36 including one test pile

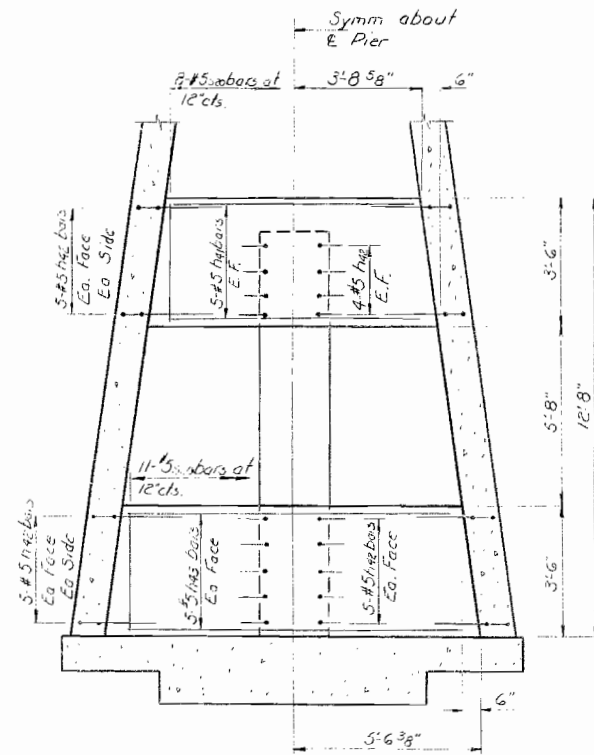

SECTION D-D

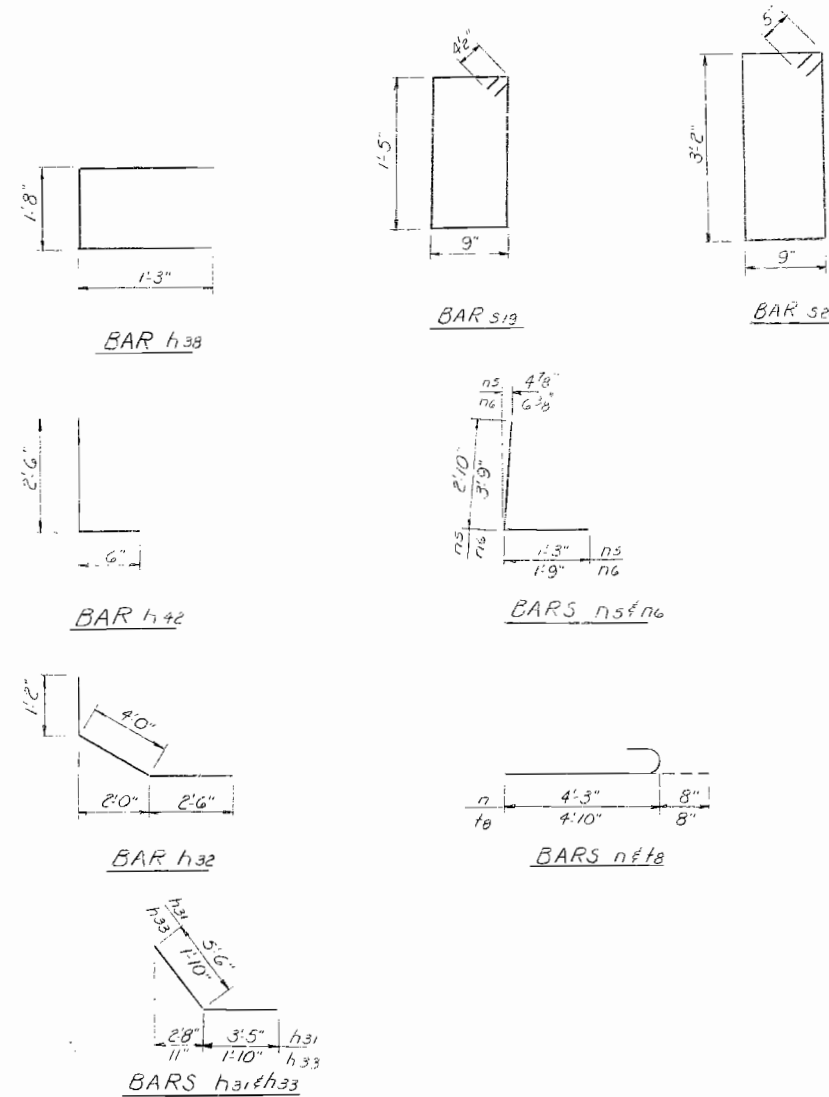

BILL OF MATERIAL

Bar No.	Size	Length	Shape
h16	#5	10'9"	
h18	#5	5'11"	
h20	#5	6'0"	
h21	#5	5'11"	
h22	#5	7'5"	
h23	#5	5'8"	
h24	#5	2'8"	
h25	#5	3'10"	
h26	#5	2'3"	
h27	#5	20'10"	
h28	#5	4'2"	
h29	#5	7'6"	
h30	#5	8'5"	
h31	#5	7'3"	
h32	#5	3'0"	
h33	#5	9'9"	
h34	#5	2'0"	
h35	#5	2'0"	
h36	#5	4'1"	
h37	#5	5'0"	
h38	#5	6'8"	
h39	#5	5'3"	
h40	#5	5'2"	
h41	#5	11'10"	
h42	#5	7'3"	
h43	#5	11'6"	
h44	#5	12'5"	
h45	#5	13'9"	
h46	#5	29'0"	
h47	#5	25'9"	
h48	#5	10'9"	
h49	#5	7'3"	
h50	#5	11'6"	
h51	#5	12'5"	
h52	#5	13'9"	
h53	#5	29'0"	
h54	#5	25'9"	

Bar	R	A	B
h28	6'4"	0"	10'9"
h29	4'7"	1'2"	7'9"
h30	3'5"	0"	6'0"

Class 1 Concrete	Cu. Yds.	105
Reinforcement Bars	Lbs.	2070
Concrete Piles	Lin. Ft.	425
Exp. Pile Concrete	Each	


DESIGNED	A. J. Lindsey
CHECKED	J. M. ...
DRAWN	S. E. Lindsey
CHECKED	April

EXAMINED	[Signature]	Oct. 20 1972
PASSED	H. E. Bauman	ENGINEER OF DESIGN
APPROVED	Richard H. Hutterman	CHIEF HIGHWAY ENGINEER


PIER 2  
SOUTH BOUND LANE  
FAI, RT. 55 SEC. 57-9 HB  
MC LEAN COUNTY  
STA 297+80.50

STATE OF ILLINOIS  
DEPARTMENT OF TRANSPORTATION

ROUTE NO.	SECTION	COUNTY	TOTAL SHEETS	SHEET NO.	SHEET NO. 45
57-9WB	MCLEAN	93	60	60	58 SHEETS
FED. ROAD DIST. NO. 7	ILLINOIS	FED. AID PROJECT			

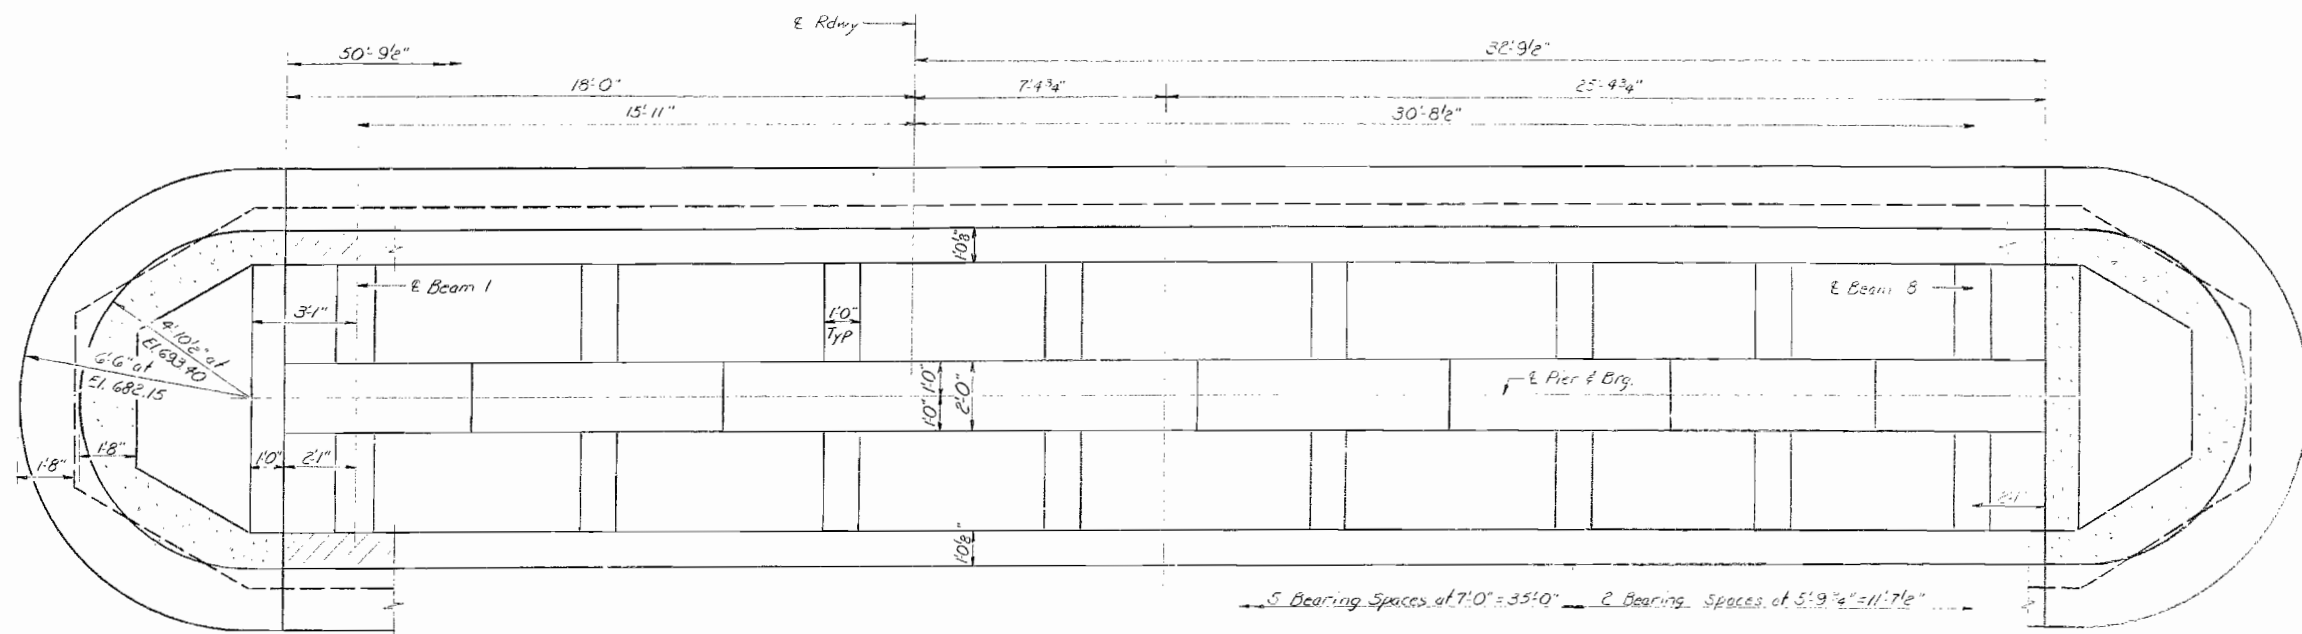

VIEW P-P

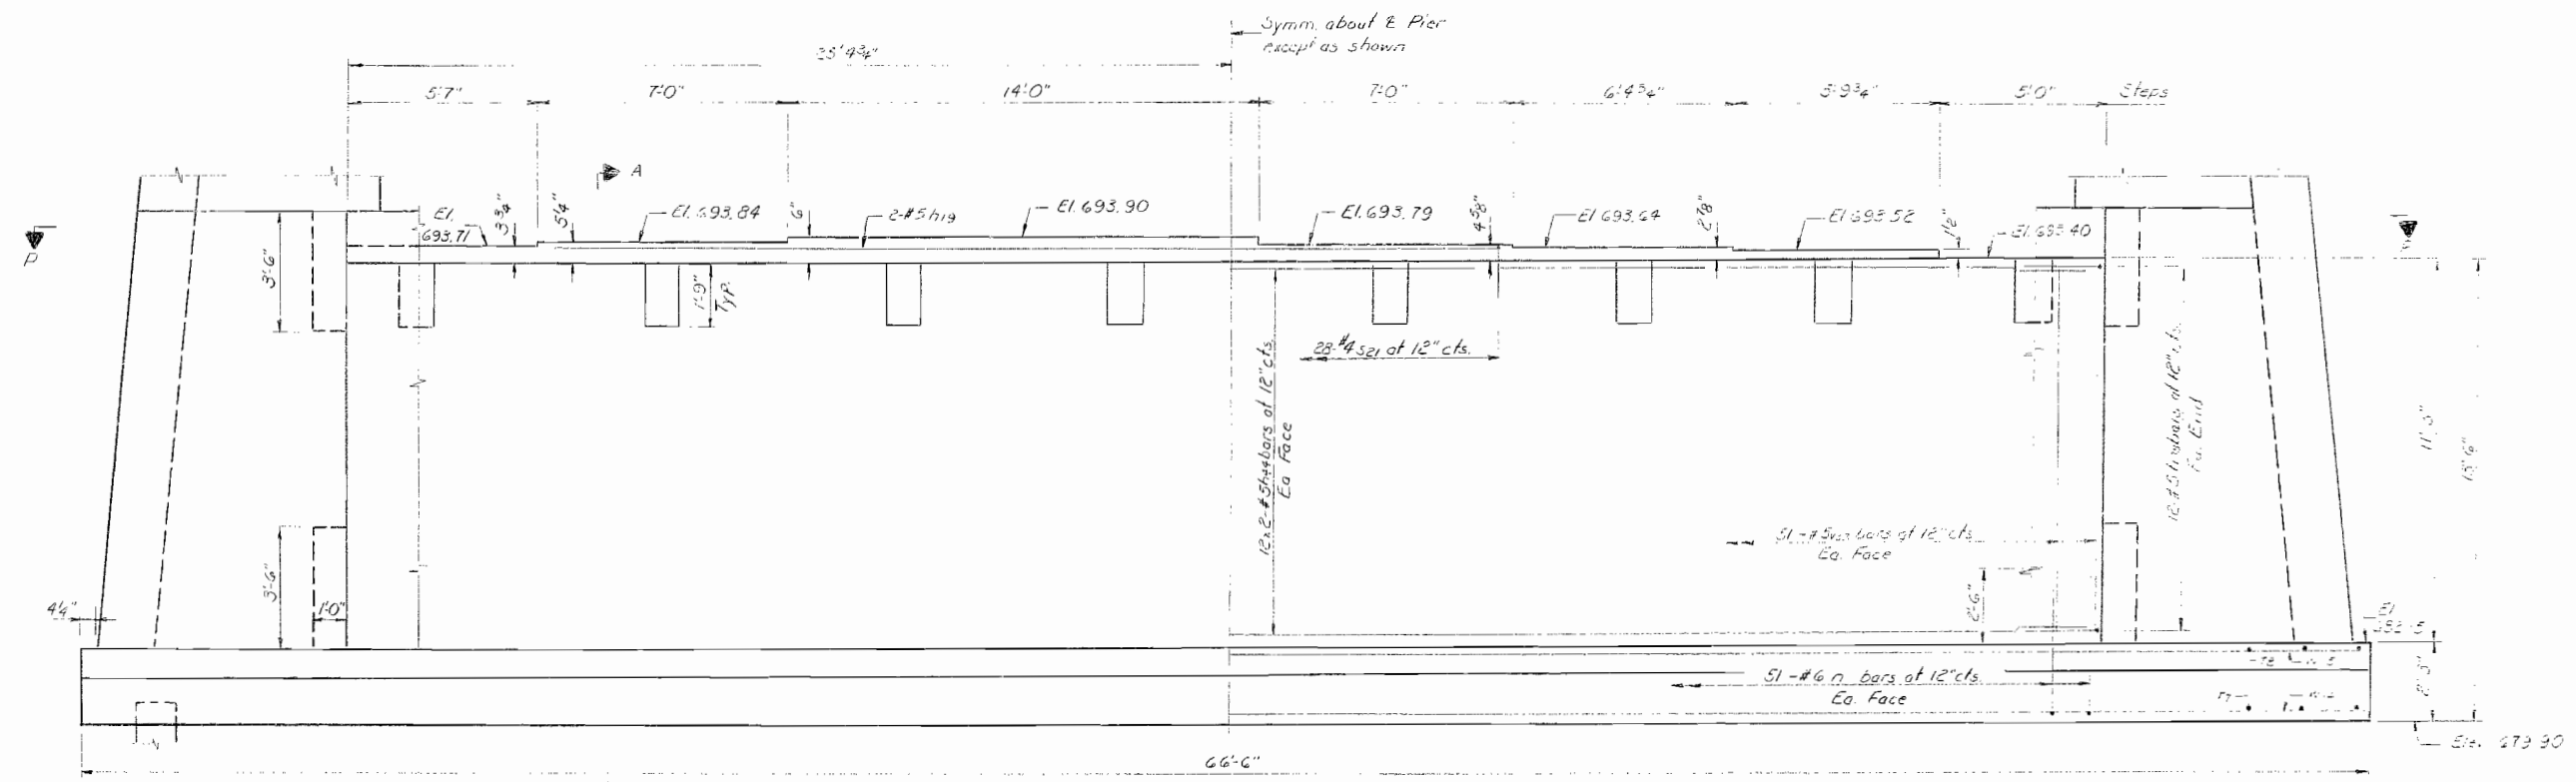

STEM  
ELEVATION  
Looking North

Notes:  
All edges shall have standard 3/4" chamfers unless otherwise noted.  
For Bill of Material see sheet #51.  
For Sec. A-A see sheet #49.  
For bars #3, #5, #6, #8, #9 see sheet #51.

DESIGNED	A. J. Maypat
CHECKED	J. M. Patel
DRAWN	S. L. Lindsey
CHECKED	J. M. Patel


EXAMINED  
PASSED  
APPROVED  
Richard F. Hollerman  
CHIEF HIGHWAY ENGINEER

PIER E  
NORTH BOUND LANES  
FAI, RT. 55 SEC. 57-9 WB  
MCLEAN COUNTY  
STA. 297+80.50




STATE OF ILLINOIS  
DEPARTMENT OF TRANSPORTATION

ROUTE NO.	SECTION	COUNTY	TOTAL SHEETS	SHEET NO.	SHEET NO. 45
A. 1. 55	57-9HB	MC LEAN	93	70	58 SHEETS
FED. ROAD DIST. NO. 7	ILLINOIS	FED. AID PROJECT			

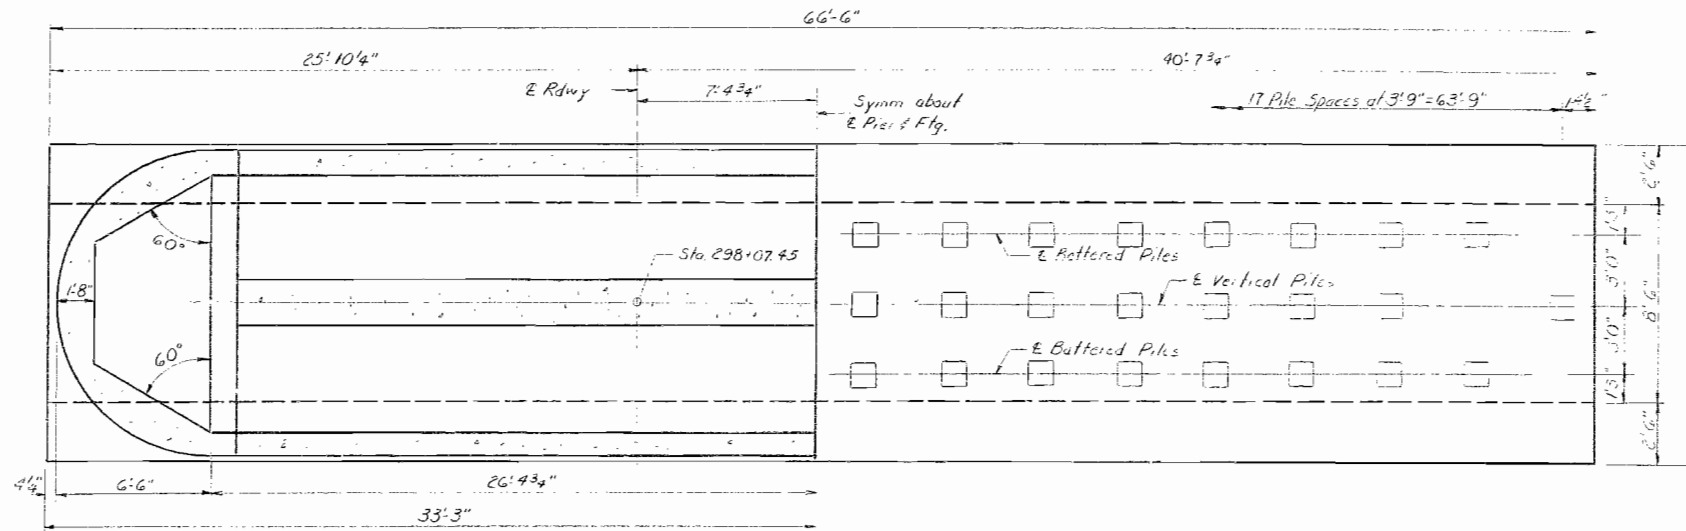


FOOTING PLAN

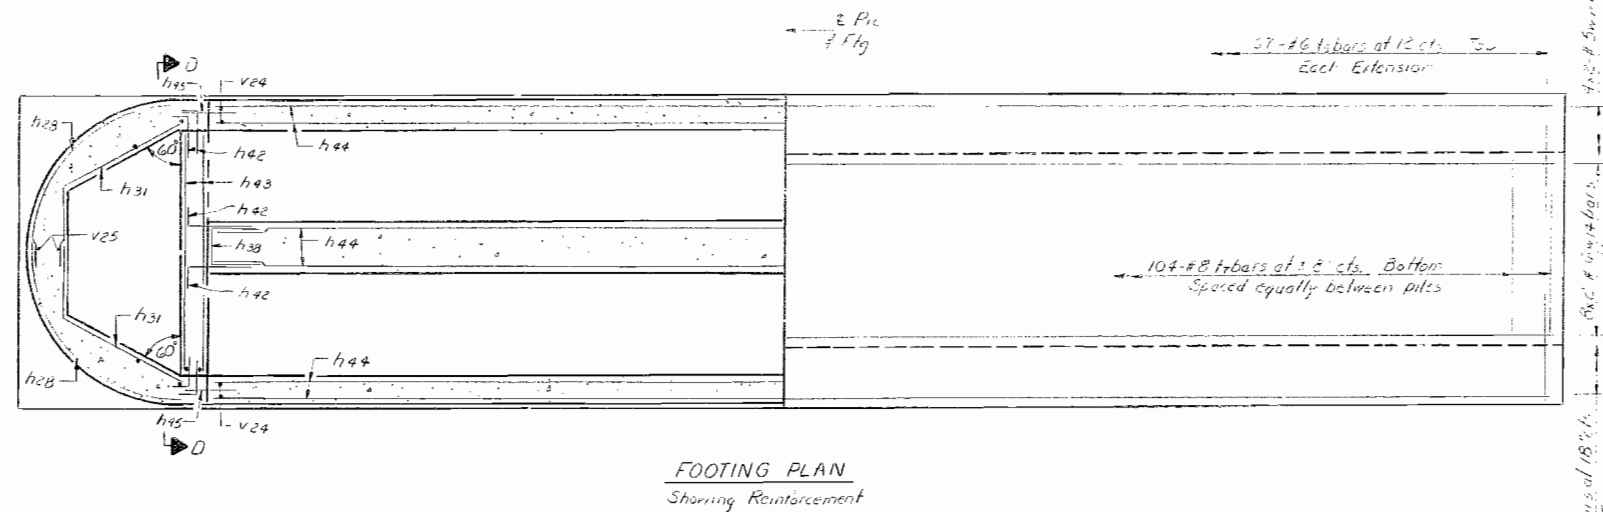

FOOTING PLAN  
Showing Reinforcement

Notes:  
Hatched area may be poured after forms of superstructure have been removed.  
For shell Elevation & Details see sheet #50  
For bars h40 & s19 see sheet #50  
For Section D-D see sheet #51.

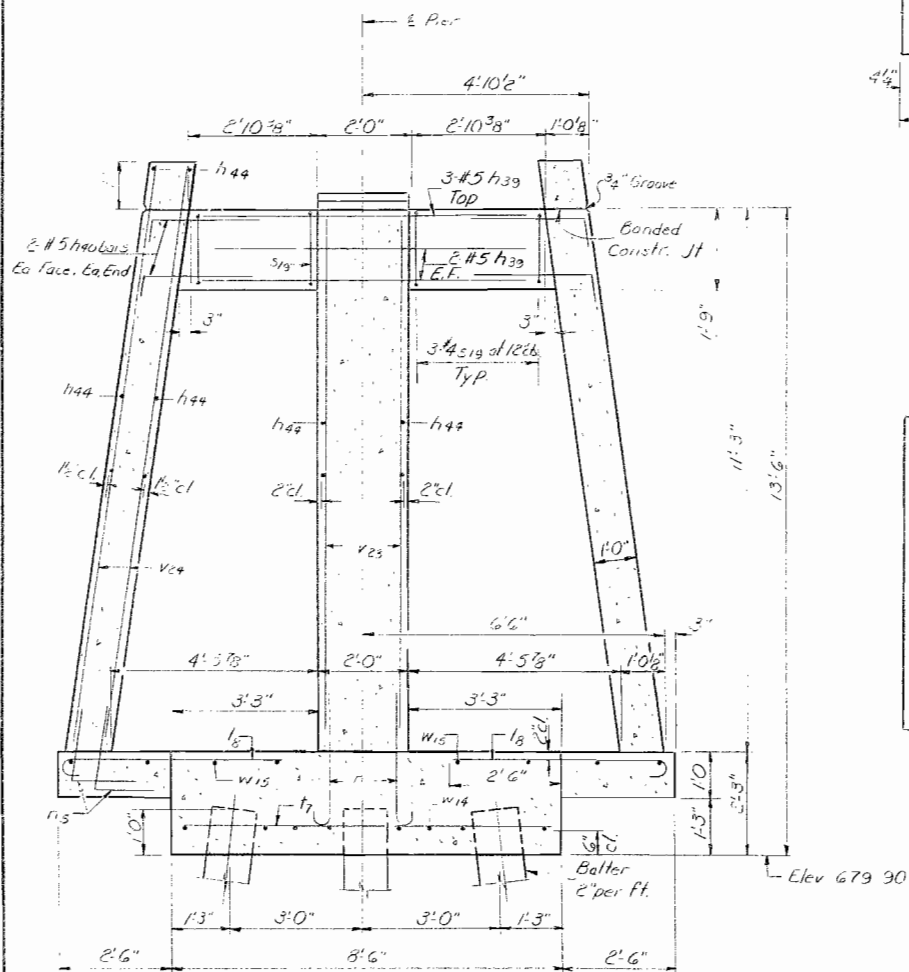

SECTION A-A

DESIGNED	A. I. Whiggat
CHECKED	L. M. P.
DRAWN	S. E. Lindsey
CHECKED	L. M. P.


OCT 20 1972  
EXAMINED  
PASSED  
APPROVED  
Richard J. Hollerman  
CHIEF HIGHWAY ENGINEER

PIER E  
NORTH BOUND LANES  
FAI RT 55 SEC 57-9-H-E  
MCLEAN COUNTY  
STA 297+80.50


STATE OF ILLINOIS  
DEPARTMENT OF TRANSPORTATION

ROUTE NO.	SECTION	COUNTY	TOTAL SHEETS	SHEET NO.
1.55	57-9MB	MC LEAN	93	71
FED. ROAD DIST. NO. 7		ILLINOIS	FED. AID PROJECT	


SHEET NO. 71  
93 SHEETS

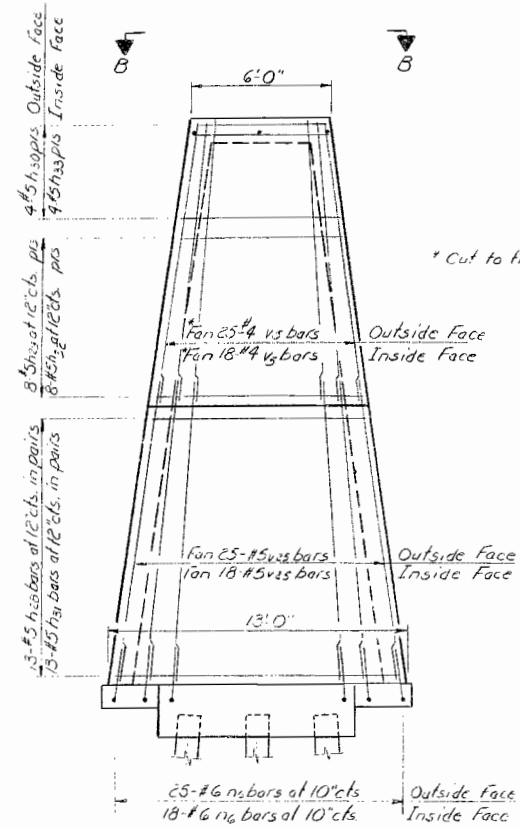


END VIEW

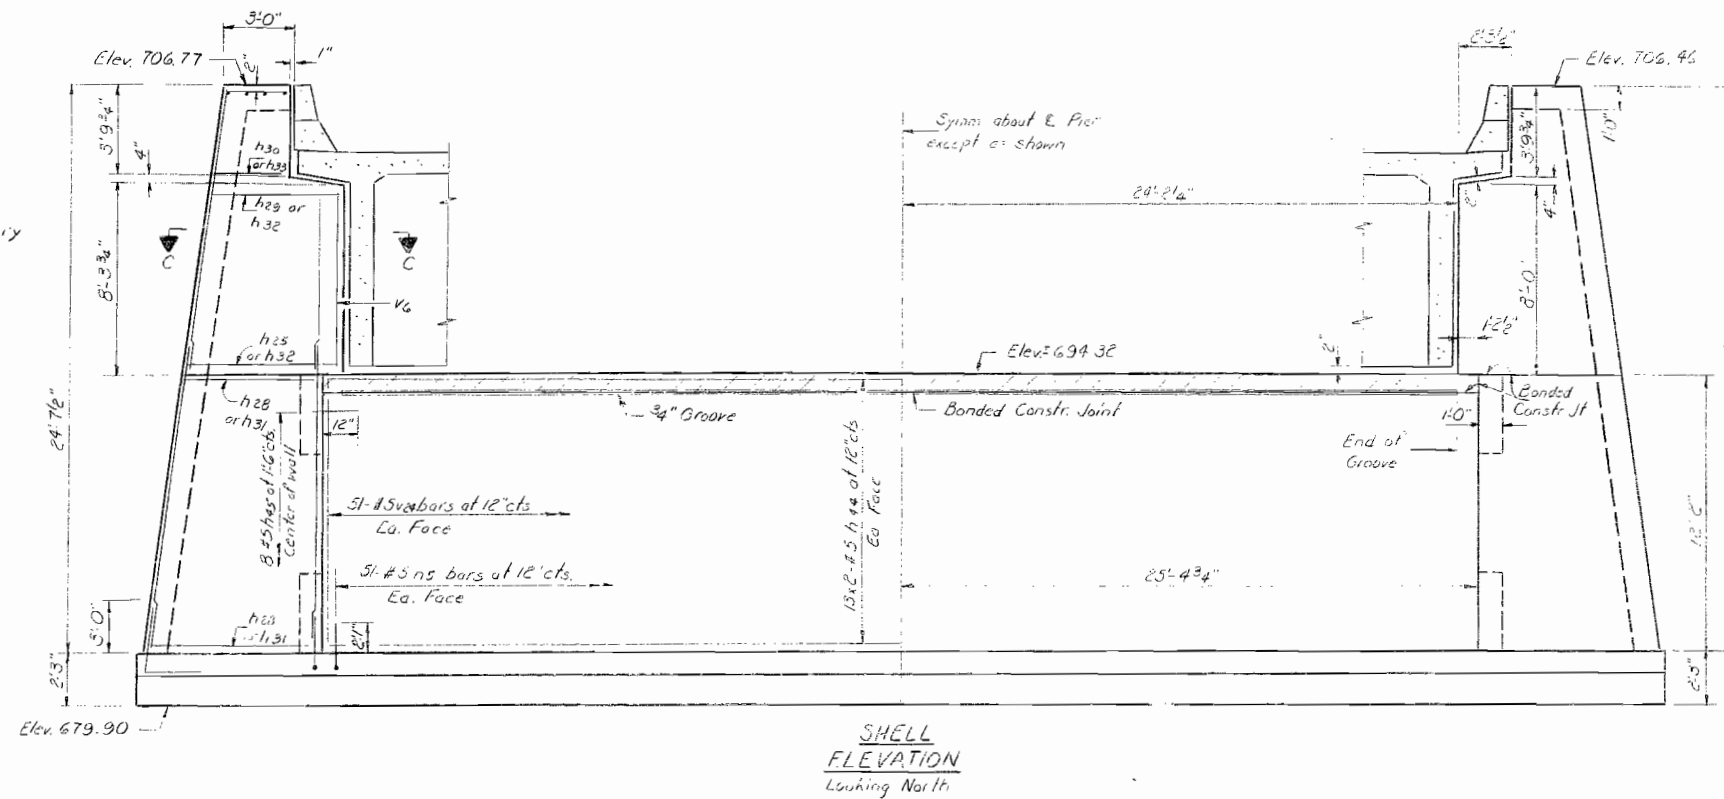

SHELL  
ELEVATION  
Looking North

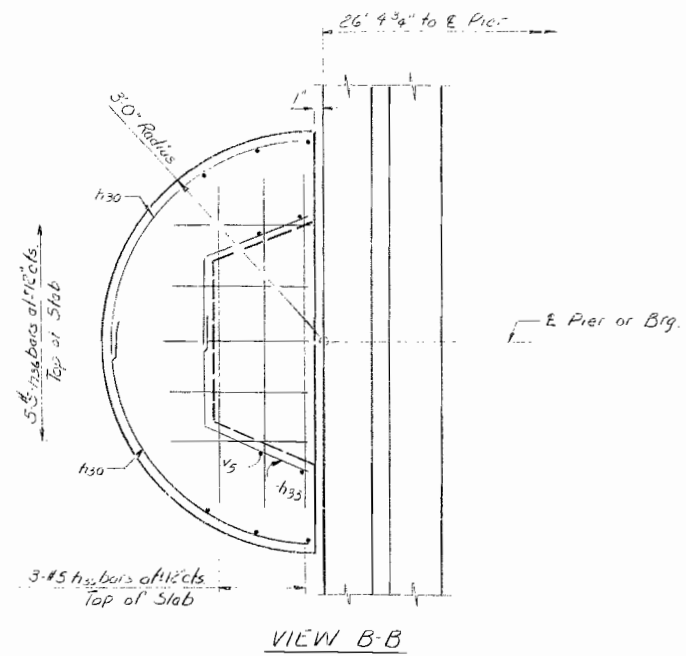

VIEW B-B

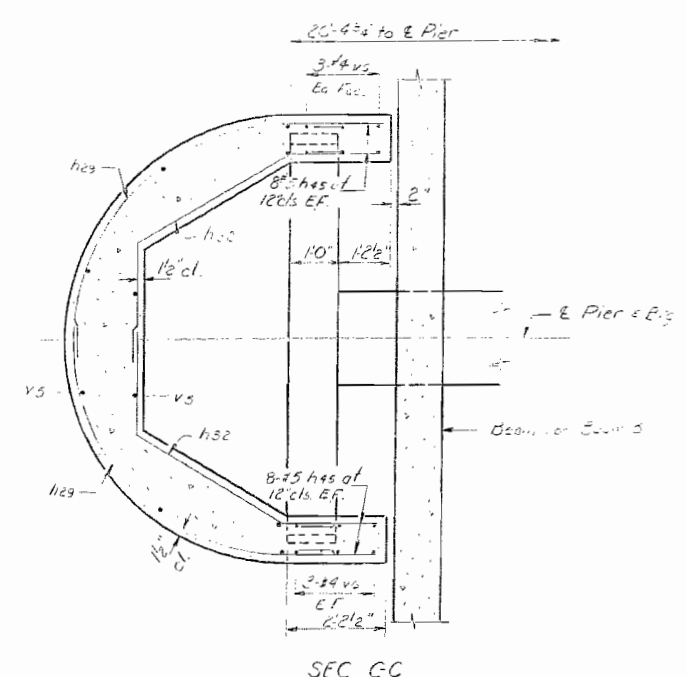

SEC CC

DESIGNED	A. J. Hays
CHECKED	L. M. Hays
DRAWN	S. E. Lindsey
CHECKED	L. M. Hays

OCT. 20 1972  
EXAMINED  
PASSED  
APPROVED  
Richard H. Holterman  
CHIEF HIGHWAY ENGINEER


PIER 2  
NORTH BOUND LANES  
FAI RT. 55 SEC. 57-3-1-E  
MCLEAN COUNTY  
STA. 297+80.50

STATE OF ILLINOIS  
DEPARTMENT OF TRANSPORTATION


ROUTE NO.	SECTION	COUNTY	TOTAL SHEETS	SHEET NO.	SHEET NO.
55	57-9HB	MC LEAN	93	72	58 SHEETS
FED. ROAD DIST. NO. 1	ILLINOIS	FED. AID PROJECT			

PILE DATA


Type: Concrete  
Capacity: 35 Tons  
Length: 37'  
No. Req'd: 48

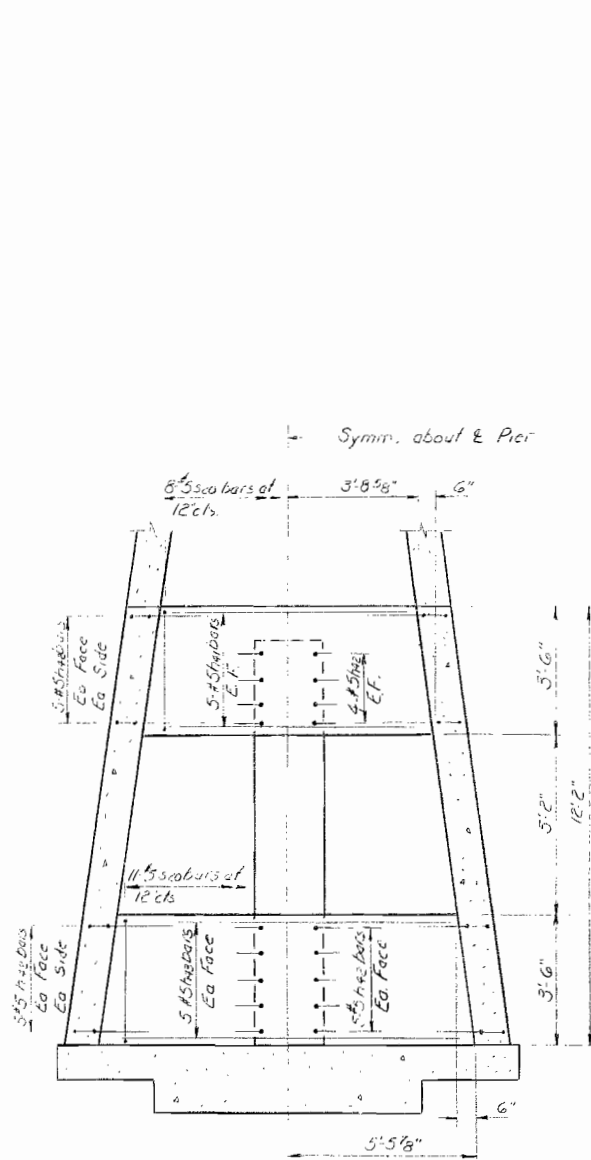


SECTION D-D

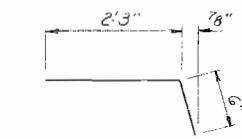


BAR h40

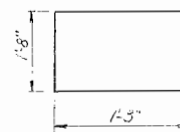


BAR h38

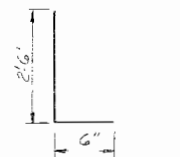


BAR h42

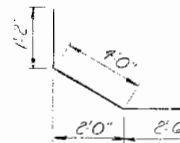

BAR h32

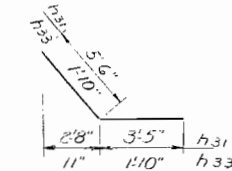


BARS h31 & h33

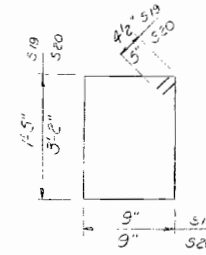


BARS s19 & s20




BAR s21

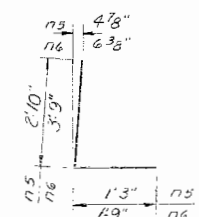

BARS n5 & n6

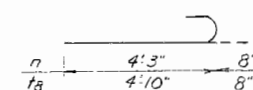

BARS n & n8

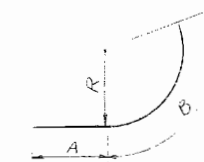

BARS h28, h29 & h30

Bar	R	A	B
h28	6'4"	0"	10'9"
h29	4'7"	1'2"	7'9"
h30	3'5"	0"	6'0"

BILL OF MATERIAL

Bar	No.	Size	Length	Shape
n12	2	#5	37.0'	—
n22	52	#5	10.0'	—
n32	30	#5	8.0'	—
h30	16	#5	6.0'	—
h28	52	#5	6.0'	—
h29	32	#5	7.9'	—
n33	16	#5	3.8'	—
n35	6	#5	5.0'	—
n36	10	#5	2.8'	—
n38	24	#5	4.1'	—
n33	56	#5	7.0'	—
h40	64	#5	2.3'	—
h41	20	#5	7.5'	—
n42	116	#5	3.0'	—
h43	20	#5	5.0'	—
h44	152	#5	2.0'	—
n45	96	#5	2.0'	—
n	102	#6	4.1'	—
n5	204	#5	2.1'	—
n6	24	#5	3.3'	—
s19	48	#4	—	U
s20	58	#5	—	U
s21	28	#4	—	U
n7	104	#5	5.3'	—
n8	124	#5	5.3'	—
n9	26	#4	11.0'	—
n10	24	#4	7.5'	—
n11	132	#5	11.0'	—
n12	204	#5	12.0'	—
n13	86	#5	3.5'	—
n14	16	#6	33.1'	—
n15	16	#5	33.1'	—

Class I Concrete Cu Yds 4.5  
Reinforcement Bars Lbs. 2085  
Concrete Piles Lin. Ft. 1776

DESIGNED	A. J. [Signature]
CHECKED	J. [Signature]
DRAWN	S. E. Lindsey
CHECKED	J. [Signature]


OCT 20 1972  
EXAMINED [Signature]  
PASSED [Signature]  
APPROVED [Signature]  
CHIEF HIGHWAY ENGINEER

PIER 2  
NORTH BOUND LANES  
FAI, RT 55 SEC. 57-9HB  
MCLEAN COUNTY  
STA. 297+80.50


STATE OF ILLINOIS  
DEPARTMENT OF TRANSPORTATION

ROUTE NO.	SECTION	COUNTY	TOTAL SHEETS	SHEET NO.	SHEET NO.
55	57-9NB	MC LEAN	93	73	73


ILLINOIS FED. AID PROJECT

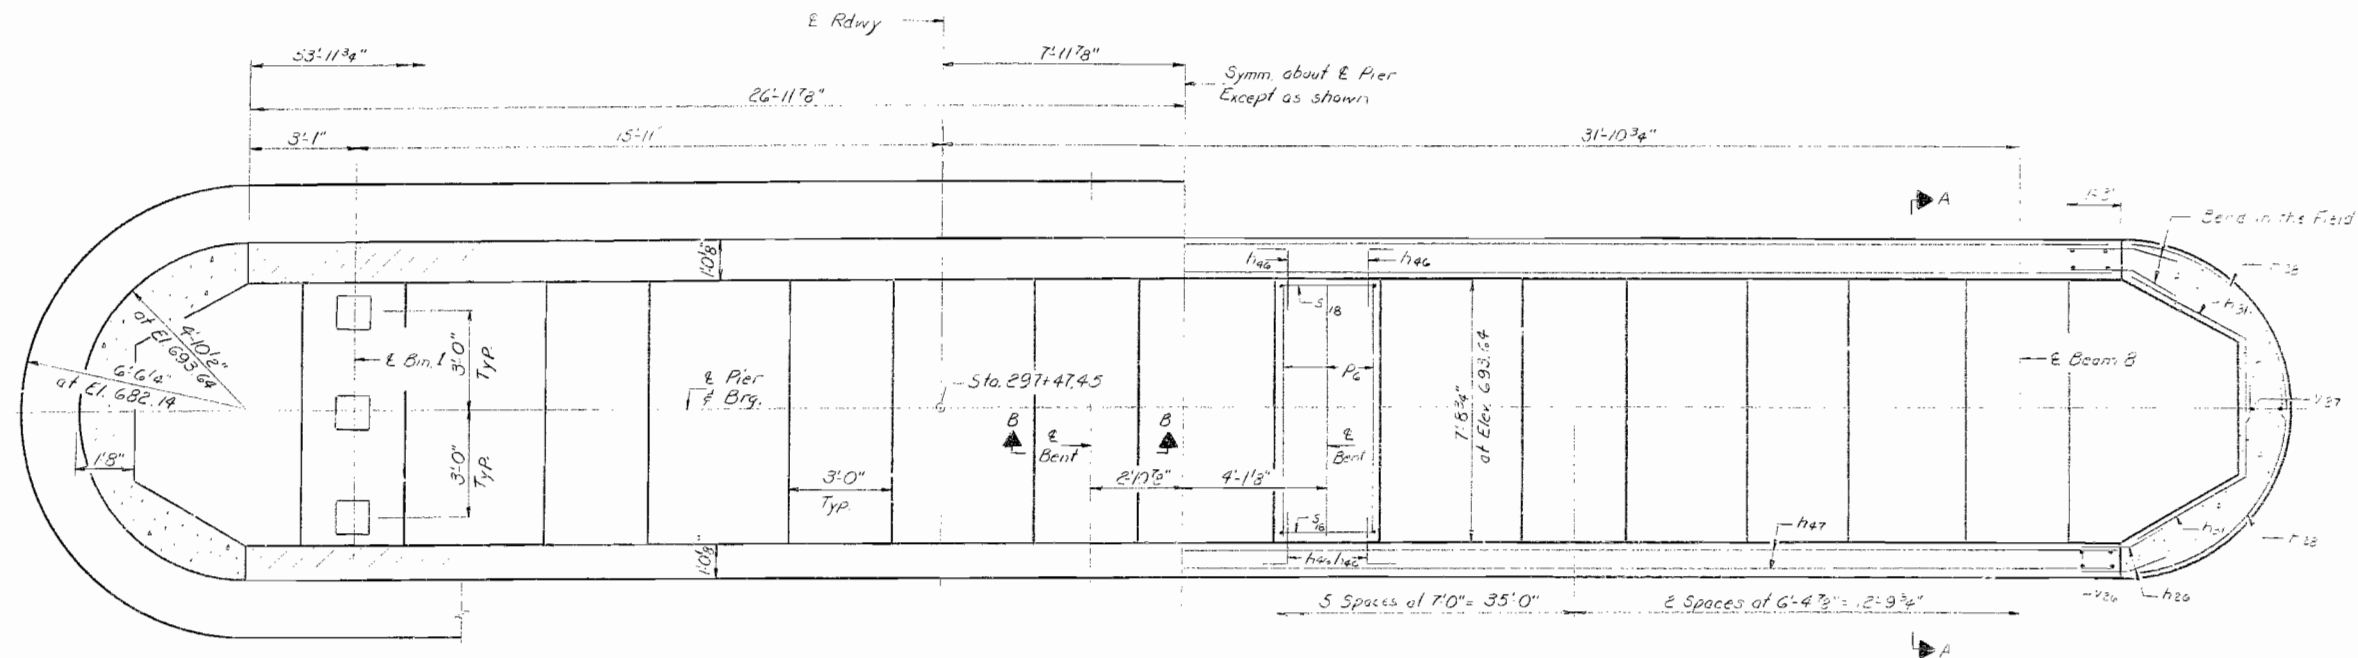

TOP PLAN

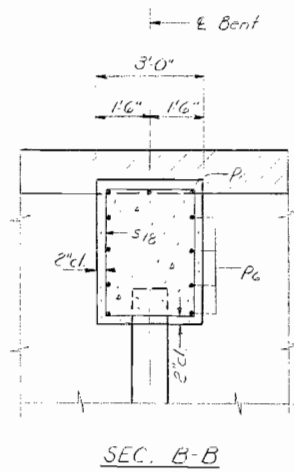

SEC. B-B

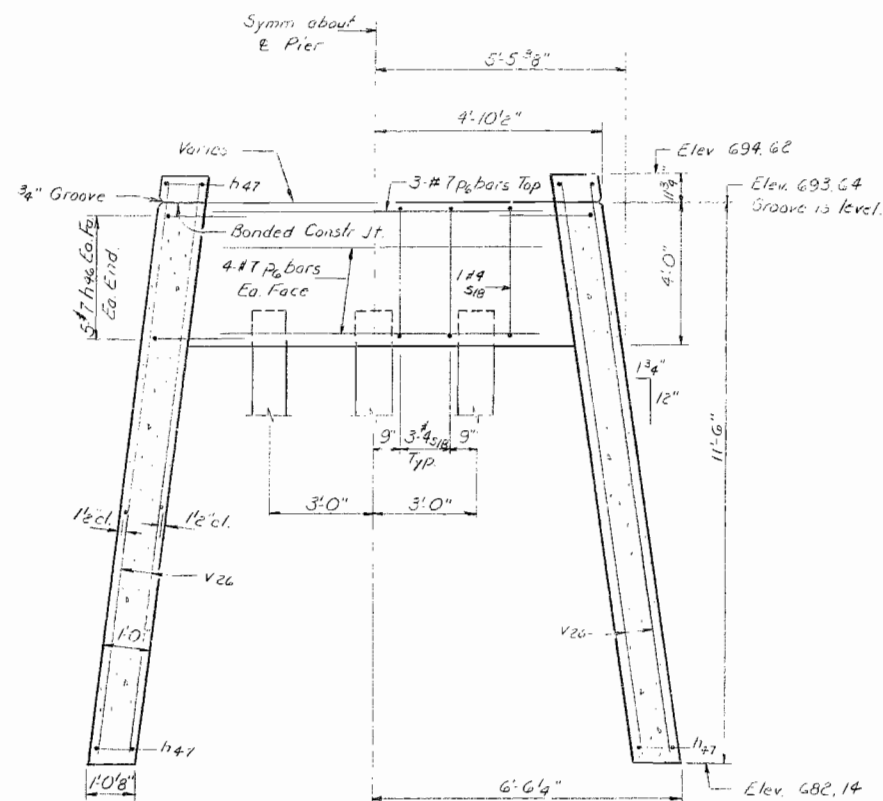

SEC. A-A

Notes:  
 For Elevation see sheet #53  
 For Bars h23 h24 h25 see sheet #54  
 For Bill of Material see sheet #54  
 Hatched area may be poured after forms of substructure have been removed.  
 All edges shall have standard 3/4" chamfers unless otherwise noted.  
 If metal shell piles are used the exposed pile tops shall be painted with a zinc rich paint. Coat 2 coats.

DESIGNED	A. J. H. 11/11/72
CHECKED	J. P. Patel
DRAWN	S. E. Lindsey
CHECKED	J. A. B.



OCT. 20 1972  
 EXAMINED  
 PASSED  
 APPROVED  
 Chief Highway Engineer

PIER 1  
 NORTH BOUND LANES  
 ILL. RT. 55 SEC 57-9 NB  
 MC LEAN COUNTY  
 STA. 297+80.50




STATE OF ILLINOIS  
DEPARTMENT OF TRANSPORTATION

ROUTE NO.	SECTION	COUNTY	TOTAL SHEETS	SHEET NO.
55	57-9HB	MC LEAN	93	74
FED. ROAD DIST. NO. 7		ILLINOIS	FED. AID PROJECT	

SHEET NO. 53  
58 SHEETS

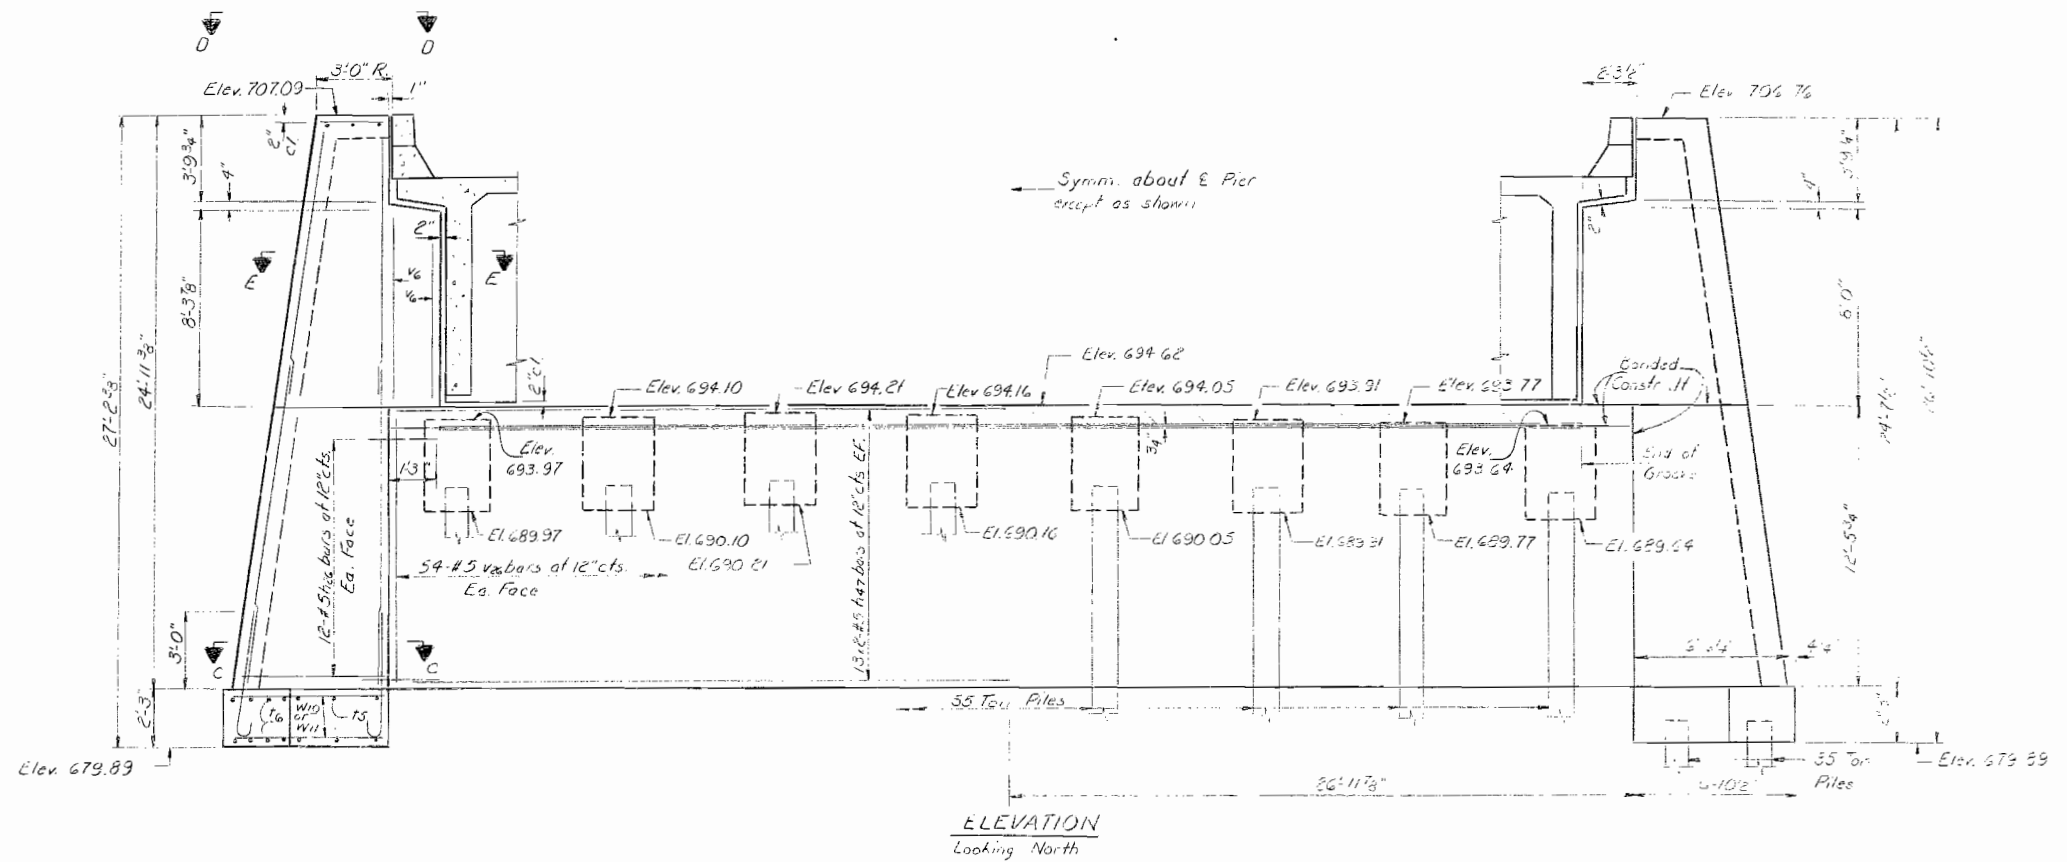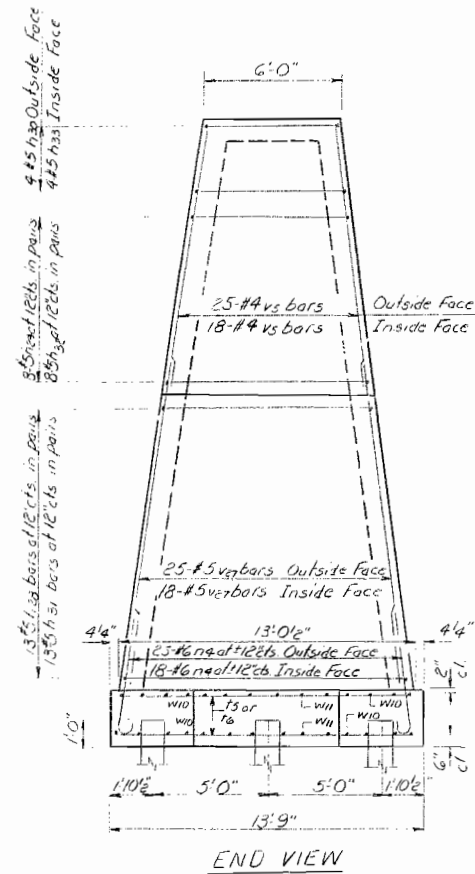

\*Order w/d & to bars full length, cut to fit & use remainder of bars in top of footing.

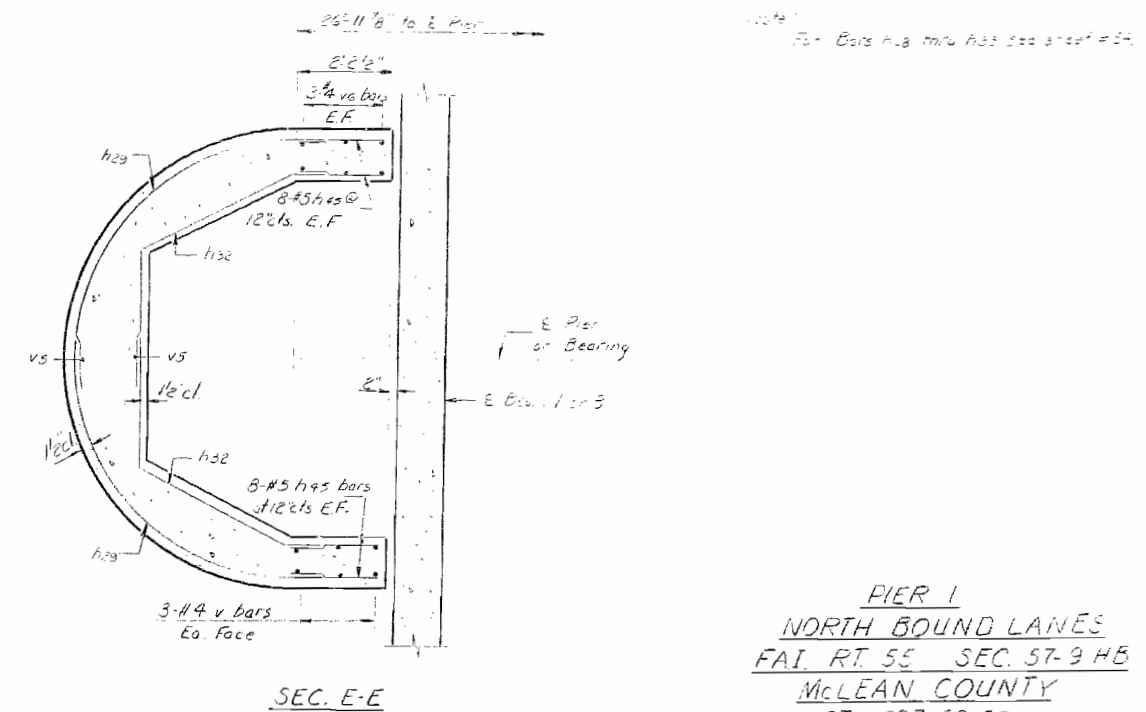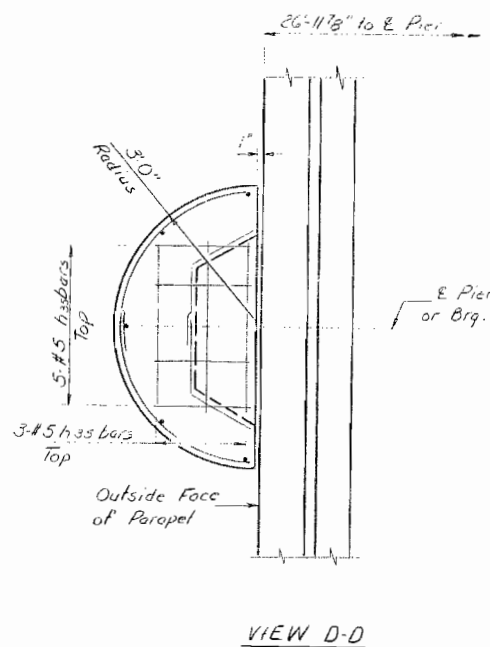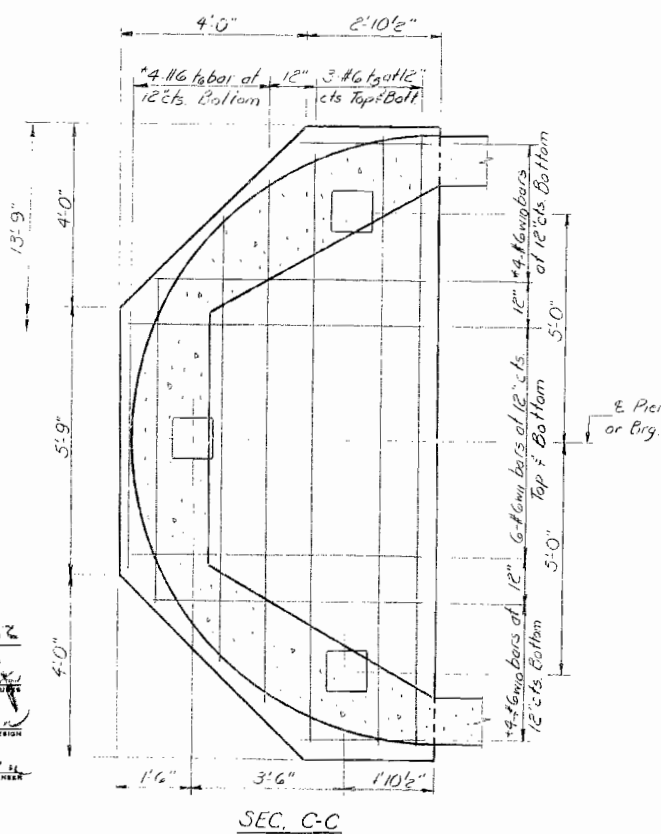

DESIGNED	J. M. Lindsey
CHECKED	J. M. Lindsey
DRAWN	S. E. Lindsey
CHECKED	J. M. Lindsey

EXAMINED	[Signature]
PASSED	[Signature]
APPROVED	[Signature]

OCT. 20 1912

PIER 1  
NORTH BOUND LANES  
FAI. RT. 55 SEC. 57-9 HB  
MCLEAN COUNTY  
STA. 297+80.50

STATE OF ILLINOIS  
DEPARTMENT OF TRANSPORTATION

ROUTE NO.	SECTION	COUNTY	TOTAL SHEETS	SHEET NO.
FAI RT. 55	57-9HB	MC LEAN	93	75
FED. ROAD DIST. NO. 7	ILLINOIS	FED. AID PROJECT		

SHEET NO. 26  
58 SHEETS

PILE DATA

PILE BENT


Type: Concrete  
Capacity: 55 Tons  
Length: 53'  
No. Req'd: 24 including  
1 Test Pile

SHELL FOOTING


Type: Concrete  
Capacity: 35 Tons  
Length: 37'  
No. Req'd: 6



BAR h46

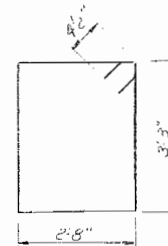


BAR s18

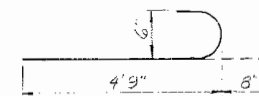


BAR n4


Note: Cut or bend bars h31, h32, h33 to fit if necessary

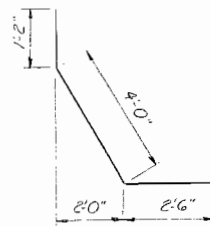

BAR h32

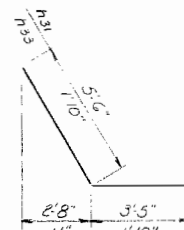

BARS h31 & h33

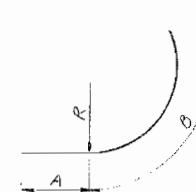

BAR h30, h31 & h33

Bar	R	A	B
h28	6'-4"	0"	10'-9"
h29	4'-7"	1'-2"	7'-3"
h30	3'-5"	0"	6'-0"

BILL OF MATERIAL

Bar	No.	Size	Length	Notes
h28	36	#5	2'-6"	
h28	32	#5	10'-9"	
h29	32	#5	8'-11"	
h30	16	#5	6'-0"	
h31	52	#5	8'-11"	
h32	32	#5	7'-8"	
h33	16	#5	3'-6"	
h33	5	#5	5'-0"	
h36	10	#5	2'-3"	
n45	64	#5	2'-0"	
n46	160	#7	4'-0"	
n47	104	#5	2'-6"	
n4	86	#6	5'-5"	
s18	32	#4	13'-5"	
s15	12	#6	13'-0"	
t6	8	#6	17'-6"	
t5	20	#4	11'-10"	
v6	24	#6	7'-3"	
w6	216	#5	12'-3"	
w7	32	#5	3'-3"	
w8	13	#5	9'-5"	
w9	24	#5	6'-7"	

Class A Concrete Cu Yds. 27.9  
Reinforcement Bars Lbs. 2250  
Concrete Piles Lin. Ft. 54  
Test Pile Concrete Each

DESIGNED	J. M. Lindsey
CHECKED	J. M. Lindsey
DRAWN	S. E. Lindsey
CHECKED	J. M. Lindsey



OCT. 20 1972  
EXAMINED  
PASSED  
APPROVED  
Richard F. Holterman  
CHIEF HIGHWAY ENGINEER

PIER 1  
NORTH BOUND LANE  
FAI RT 55 SEC. 57-9 HB  
MCLEAN COUNTY  
STA. 297+80.50



STATE OF ILLINOIS  
DEPARTMENT OF TRANSPORTATION

ROUTE NO.	SECTION	COUNTY	TOTAL SHEETS	SHEET NO.	SHEET NO.
55	57-9H	MC LEAN	93	76	55 SHEETS
FED. ROAD DIST. NO. 7		ILLINOIS	FED. AID PROJECT		

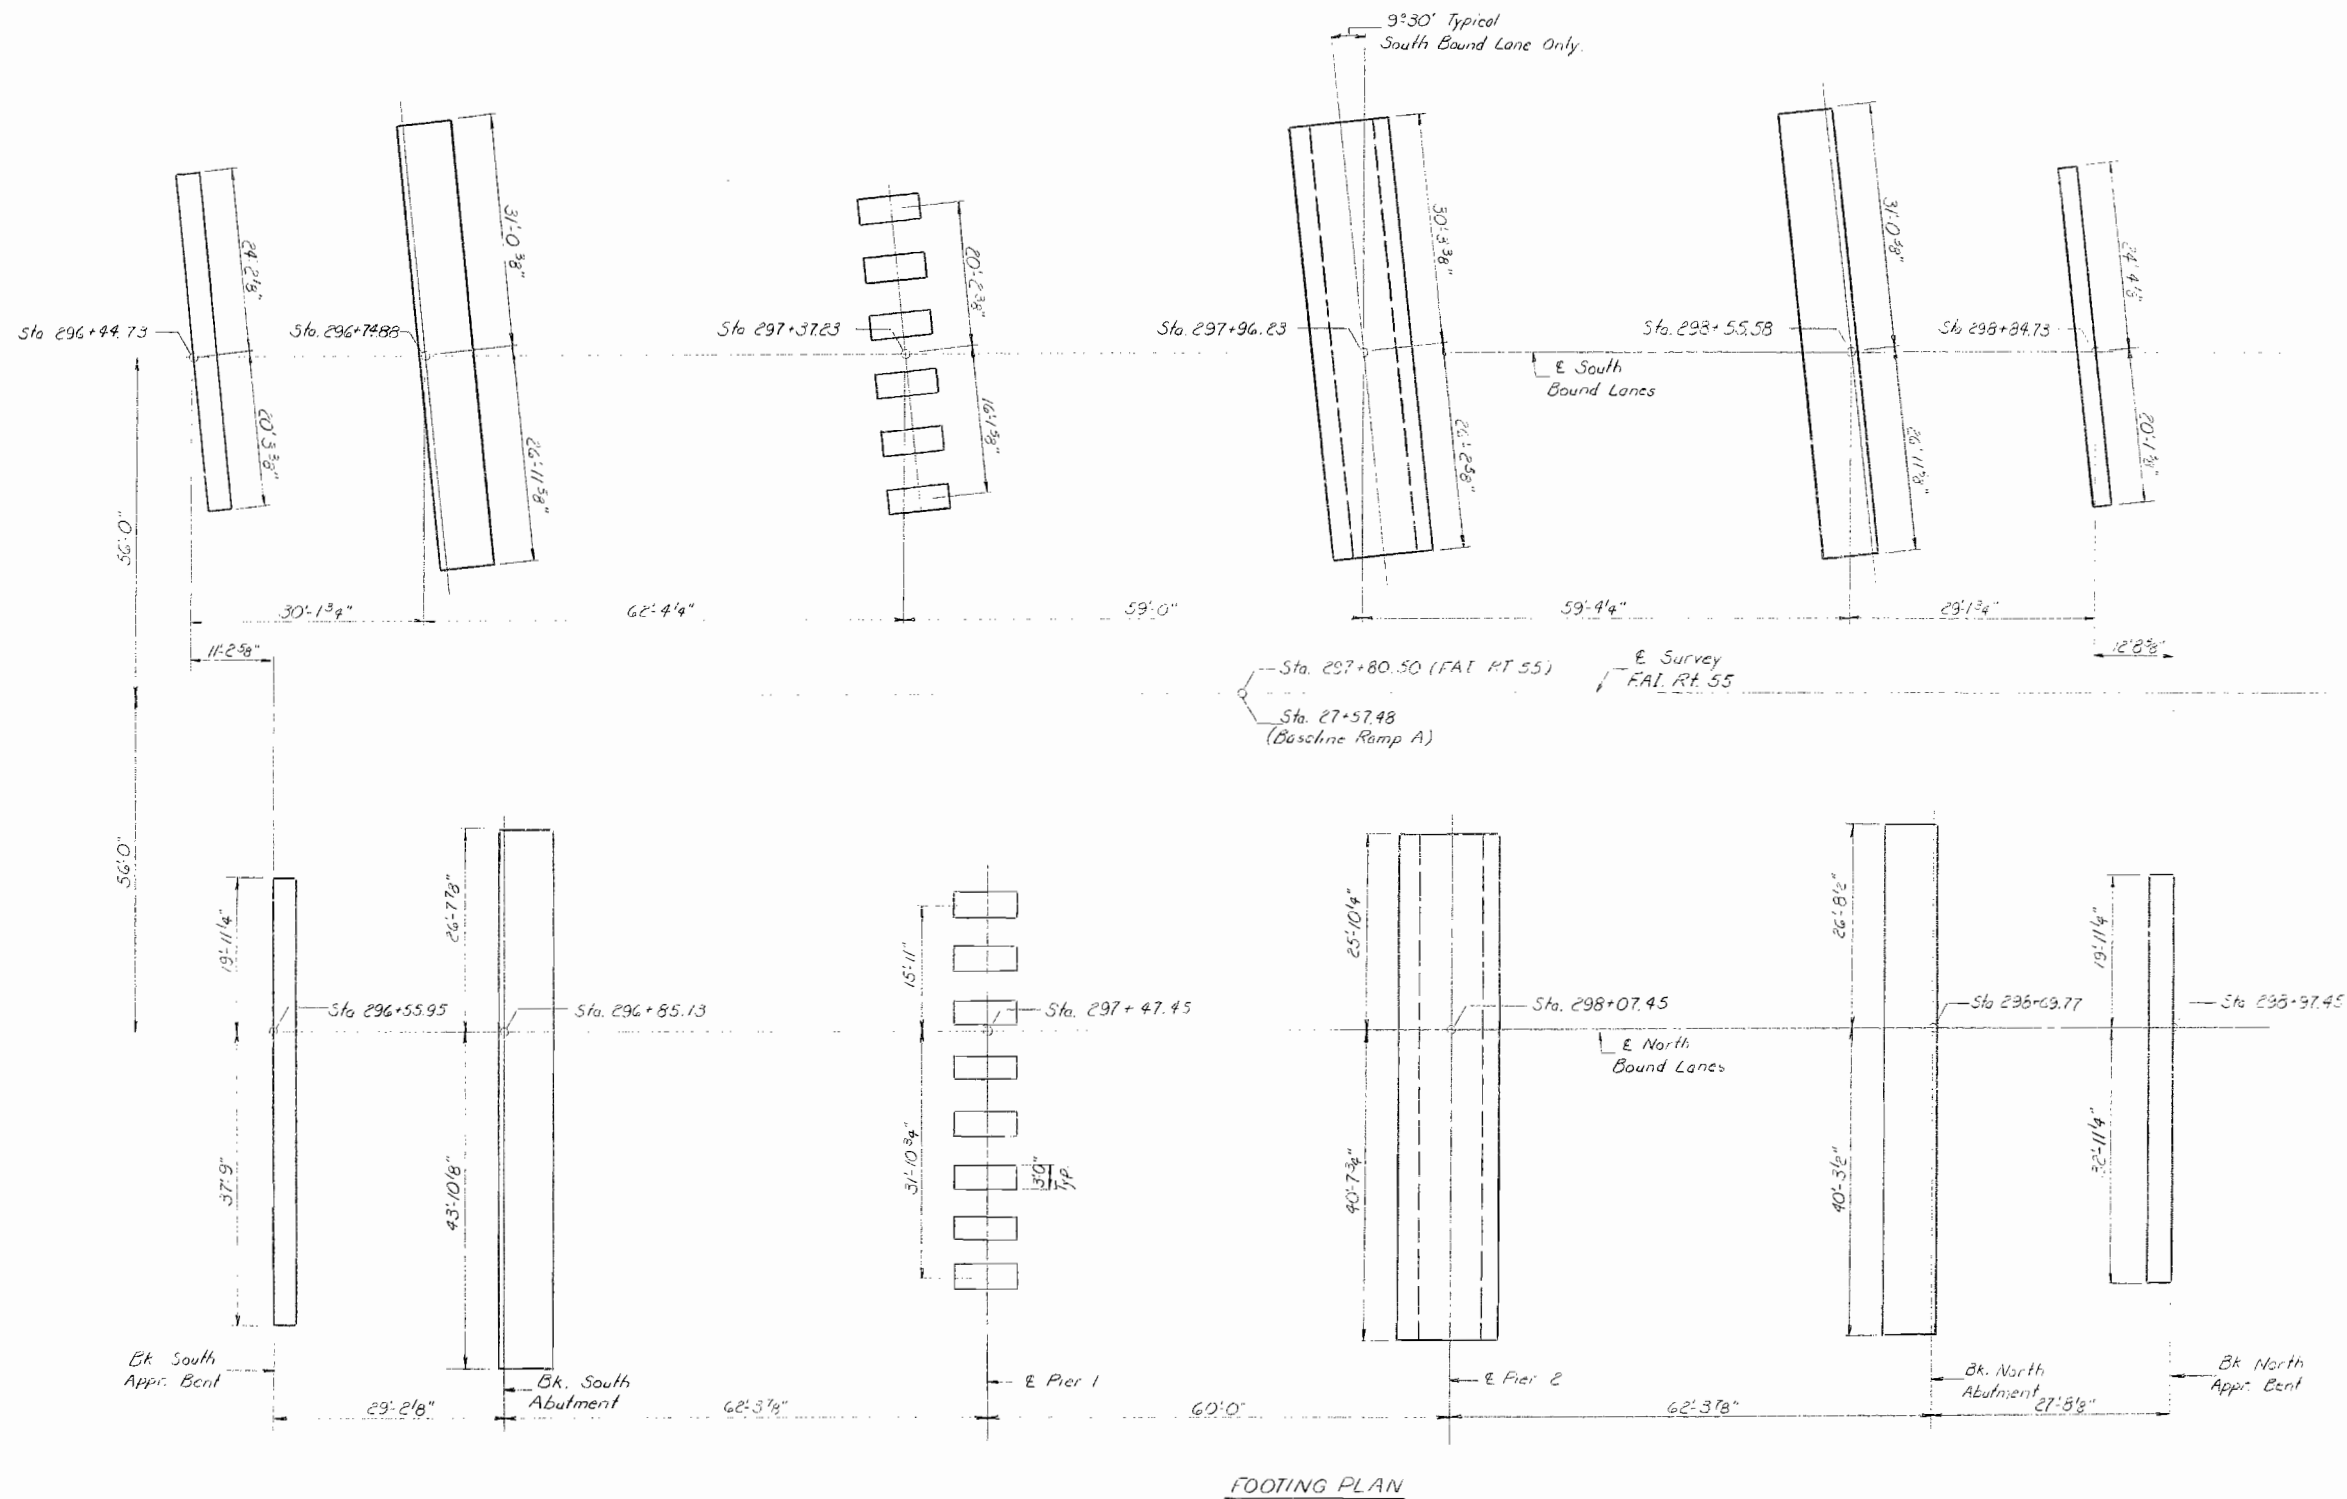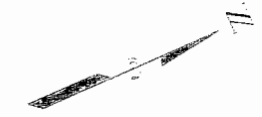

FOOTING PLAN

DESIGNED	A. J. Khayyat
CHECKED	J. M. ...
DRAWN	S. E. Lindsey
CHECKED	L. ...

OCT. 20 1977  
 EXAMINED  
 PASSED  
 APPROVED  
 Richard A. ...  
 CHIEF HIGHWAY ENGINEER

FOOTING LAYOUT  
 FAI, RT 55 SEC. 57-9 HE.  
 MC LEAN COUNTY  
 STA 297+80.50






STATE OF ILLINOIS  
DEPARTMENT OF TRANSPORTATION

ROUTE NO.	SECTION	COUNTY	TOTAL SHEETS	SHEET NO.
155	57-9HB	MC LEAN	93	79
FED. ROAD DIST. NO.	ILLINOIS	FED. AID PROJECT		


22 SHEETS

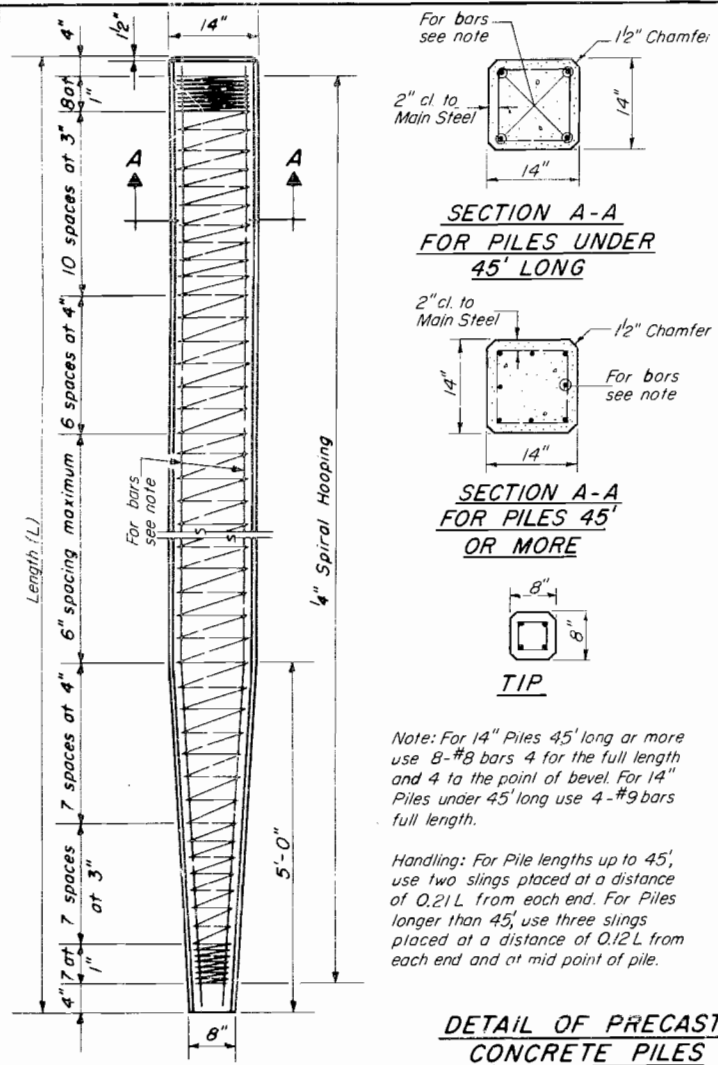

Note: For 14" Piles 45' long or more use 8-#9 bars 4 for the full length and 4 to the point of bevel. For 14" Piles under 45' long use 4-#9 bars full length.


Handling: For Pile lengths up to 45', use two slings placed at a distance of 0.21 L from each end. For Piles longer than 45', use three slings placed at a distance of 0.12 L from each end and at mid point of pile.

DETAIL OF PRECAST CONCRETE PILES

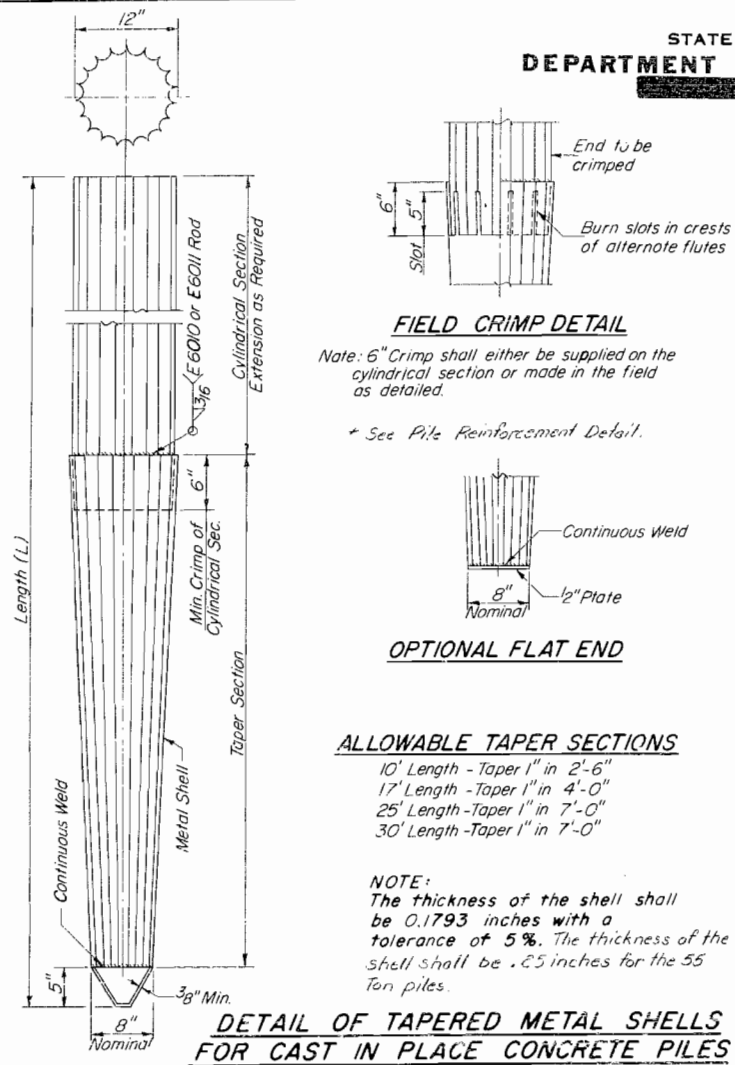


NOTE: The thickness of the shell shall be 0.1793 inches with a tolerance of 5%. The thickness of the shell shall be .25 inches for the 55 Ton piles.

DETAIL OF TAPERED METAL SHELLS FOR CAST IN PLACE CONCRETE PILES

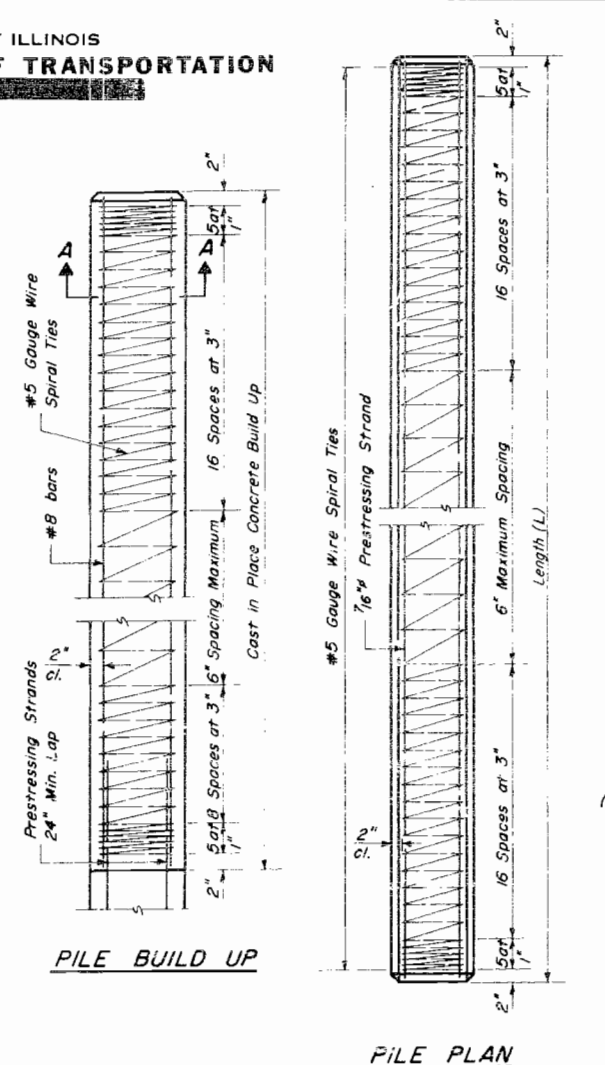

PILE BUILD UP

PILE PLAN

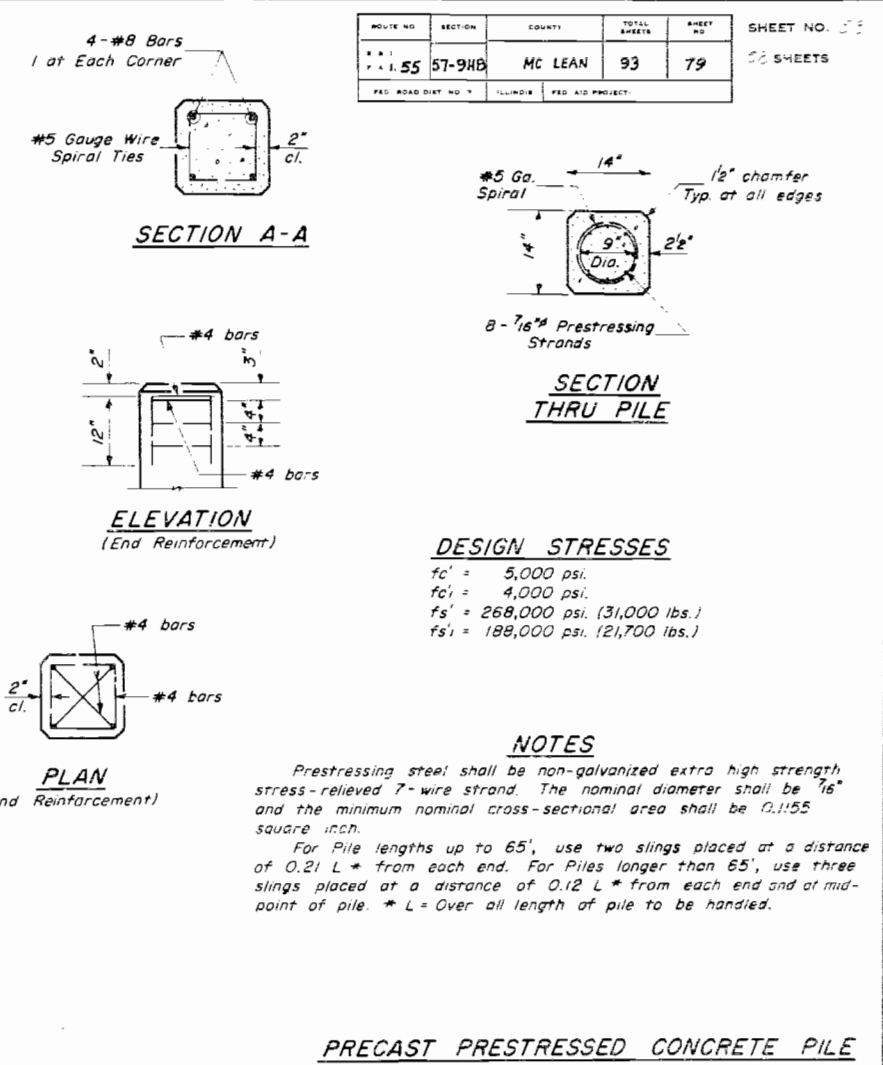


DESIGN STRESSES  
fc' = 5,000 psi.  
fc' = 4,000 psi.  
fs' = 268,000 psi. (31,000 lbs.)  
fs' = 188,000 psi. (21,700 lbs.)

NOTES

Prestressing steel shall be non-galvanized extra high strength stress-relieved 7-wire strand. The nominal diameter shall be 7/16 inch and the minimum nominal cross-sectional area shall be 0.1155 square inch.

For Pile lengths up to 65', use two slings placed at a distance of 0.21 L from each end. For Piles longer than 65', use three slings placed at a distance of 0.12 L from each end and at mid-point of pile. \* L = Over all length of pile to be handled.

PRECAST PRESTRESSED CONCRETE PILE

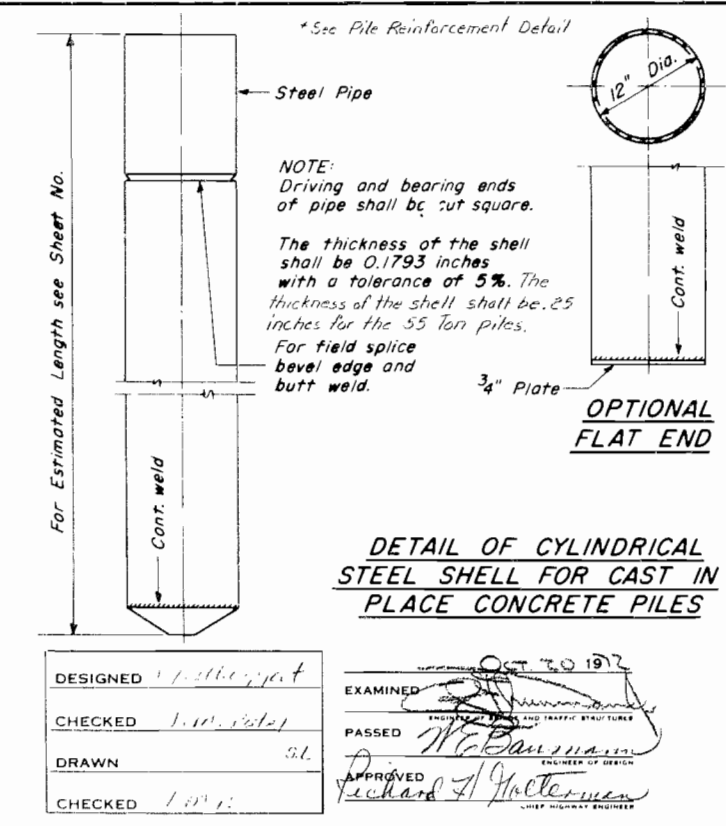


NOTE: Driving and bearing ends of pipe shall be cut square.


The thickness of the shell shall be 0.1793 inches with a tolerance of 5%. The thickness of the shell shall be .25 inches for the 55 Ton piles.

For field splice bevel edge and butt weld.


DETAIL OF CYLINDRICAL STEEL SHELL FOR CAST IN PLACE CONCRETE PILES

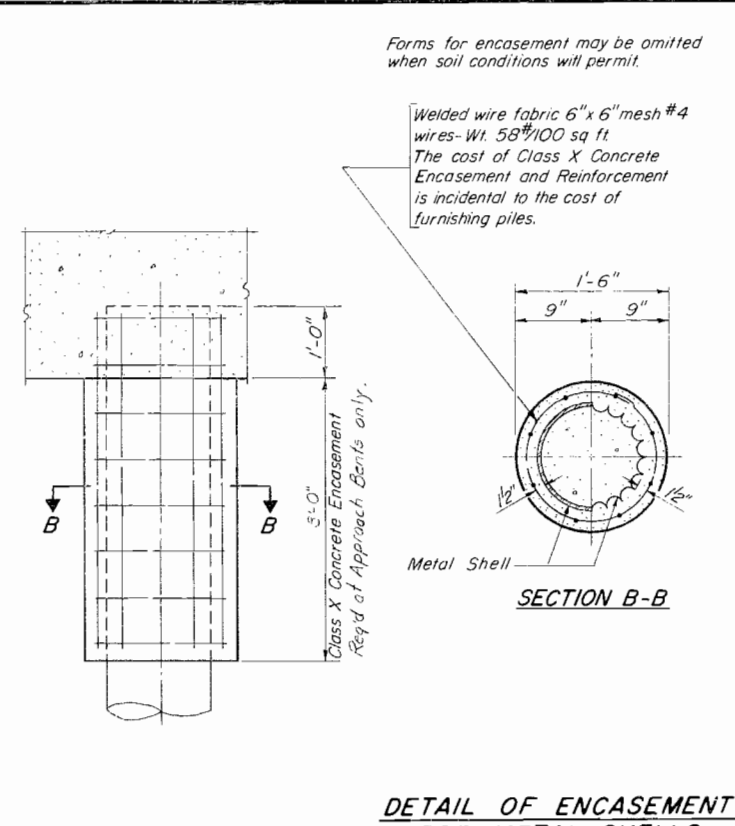

DETAIL OF ENCASEMENT FOR METAL SHELLS

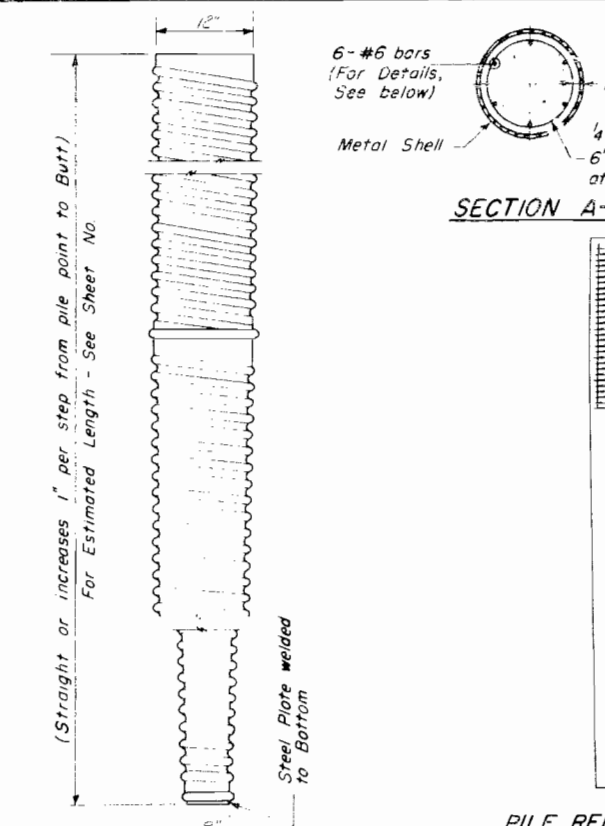

PILE REINFORCEMENT

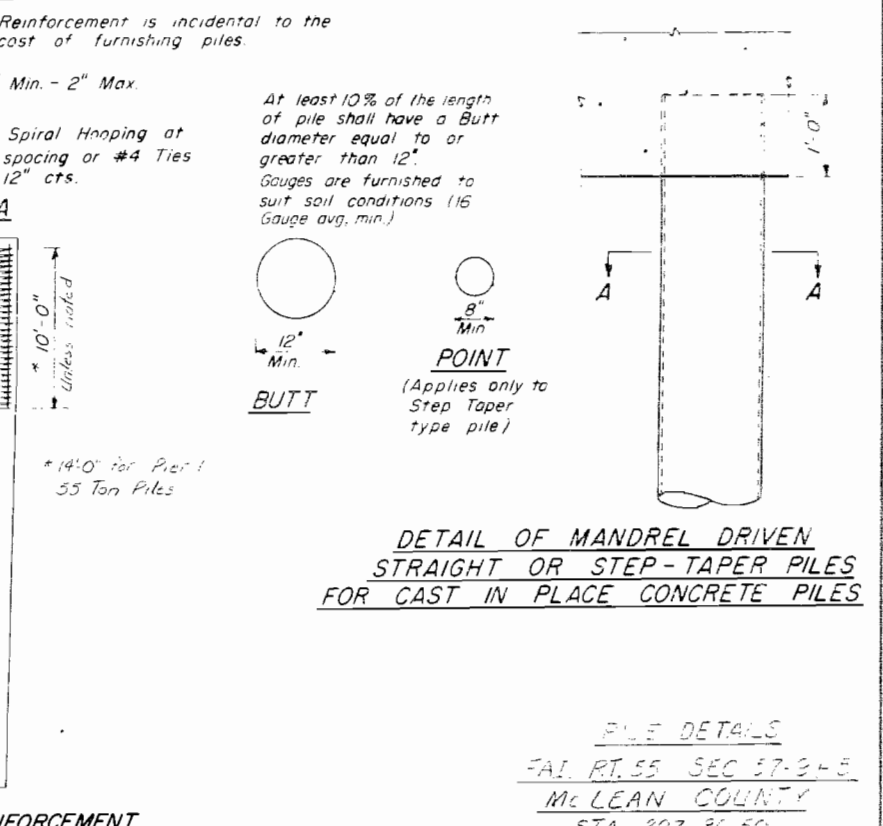

DETAIL OF MANDREL DRIVEN STRAIGHT OR STEP-TAPER PILES FOR CAST IN PLACE CONCRETE PILES

DESIGNED	10/20/67	EXAMINED	10/20/67
CHECKED	10/20/67	PASSED	10/20/67
DRAWN	SL	APPROVED	Richard J. Halterman
CHECKED	10/20/67		

P.L.E. DETAILS  
FAI. RT. 55 SEC 57-9-B  
MC LEAN COUNTY  
STA 297-80.50