


SCALES	{	PLAN	1 INCH	100 FT.
		PROFILE, HOR.	1 INCH	100 FT.
		PROFILE, VERT.	1 INCH	10 FT.
		CROSS-SECTIONS	1 INCH	5 FT.

- SEC. 10 W-1, (11, 12) W
- • SEC. 11 RS, (10, 12) RS-1

BOND ISSUE ROUTE NO.	SEC.	COUNTY	TOTAL SHEETS	SHEET NO.
FAS. 540 (SBI. 10)	● ● ●	MACON & PIATT	107 22	1
FED. ROAD DIST. NO. 1		ILLINOIS	PROJECT S-835(A). (A)	



DESIGN CLASSIFICATION
275 - P - 55




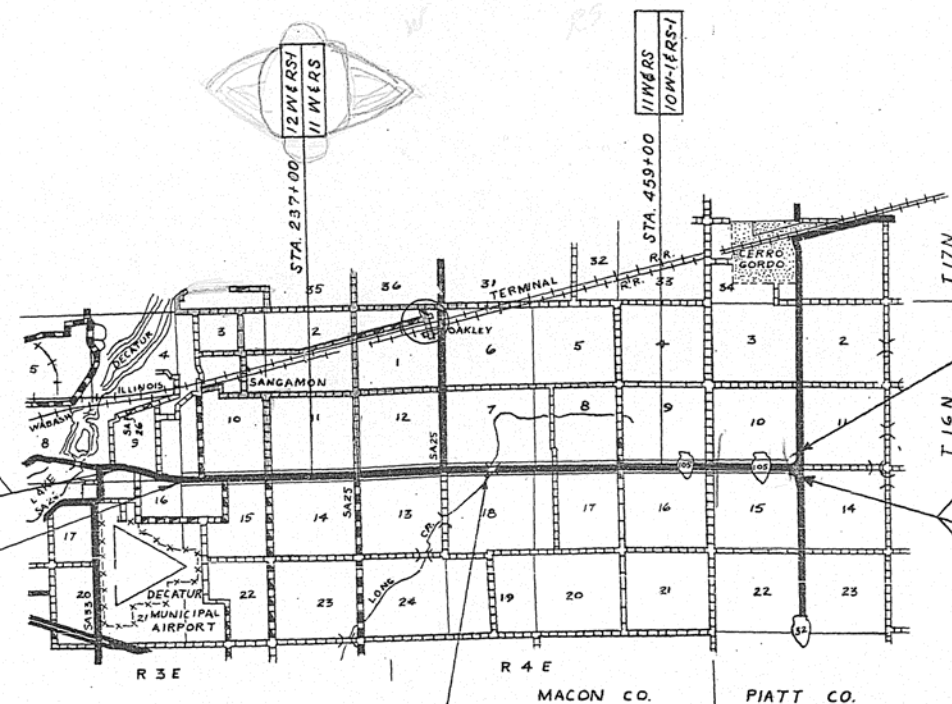


SCALE: 1" = 1 MILE

OMISSION FROM RESURFACING & WIDENING
STA. 349+13.88 TO STA. 349+46.13


Bridge included in Proj. 5-835(6)

TOTAL LENGTH OF SECTION 10W-1(11,12) W	=	40,996.65 FEET	=	7.765 MILES
NET LENGTH OF SECTION 10W-1(11,12) W	=	40,964.40 FEET	=	7.758 MILES
TOTAL LENGTH OF SECTION 11RS(10,12)RS-1	=	40,996.65 FEET	=	7.765 MILES
NET LENGTH OF SECTION 11RS(10,12)RS-1	=	40,964.40 FEET	=	7.758 MILES
NET LENGTH OF PROJECT	=	36,706.40 FEET	=	6.952 MILES

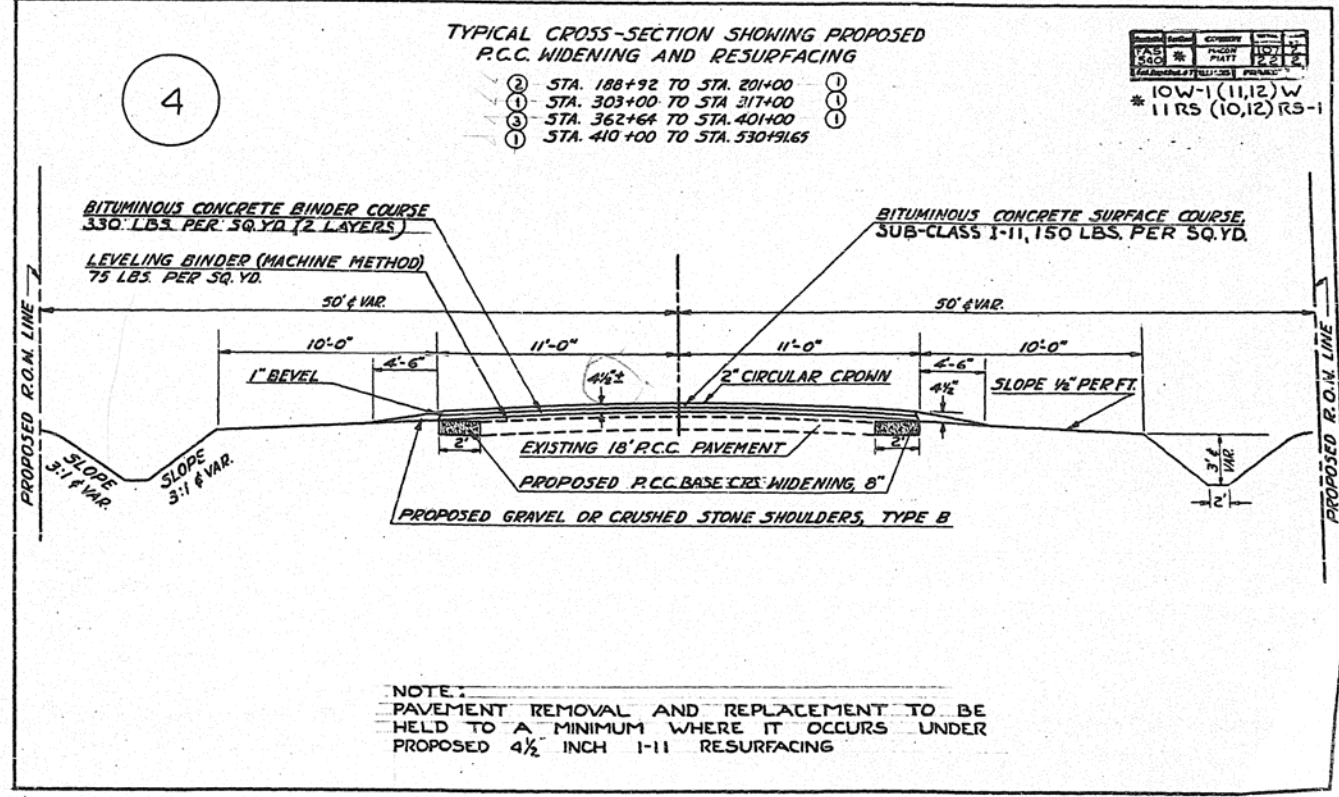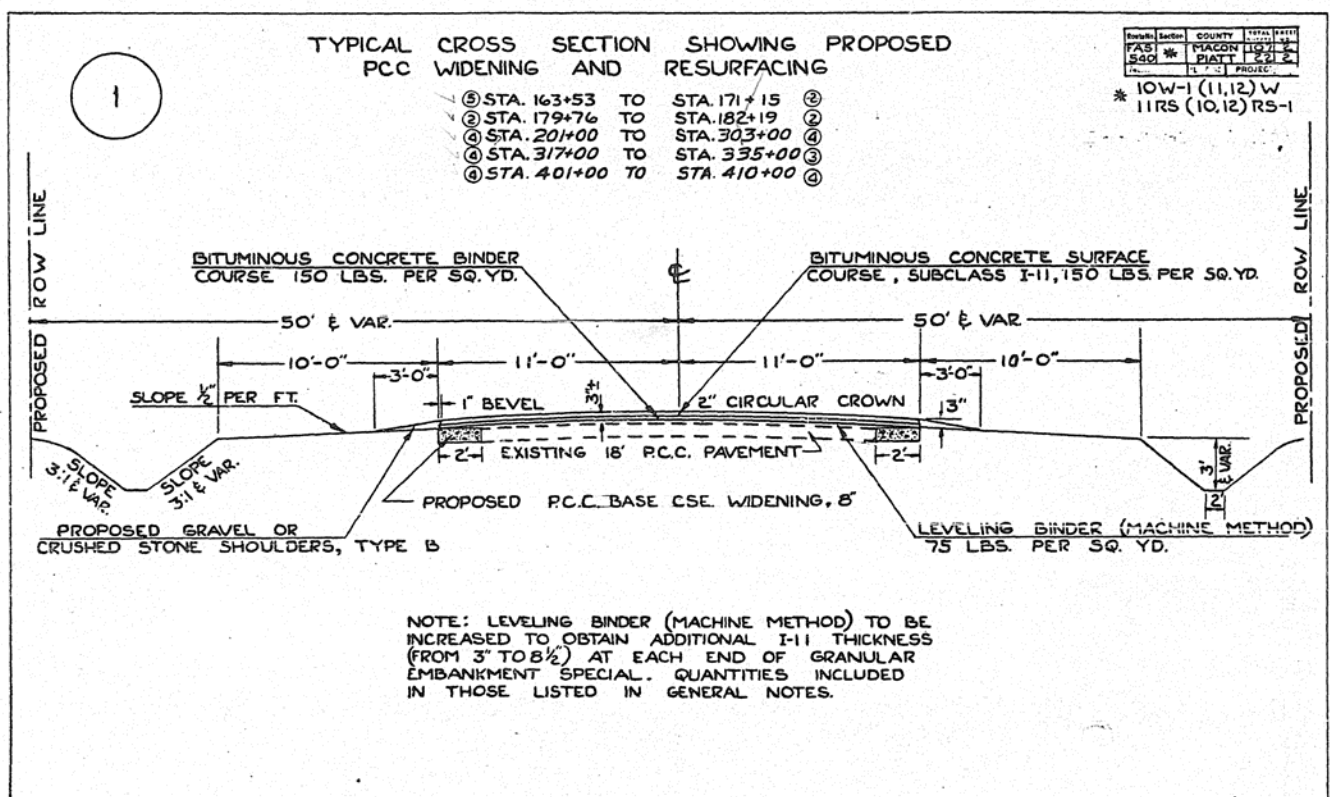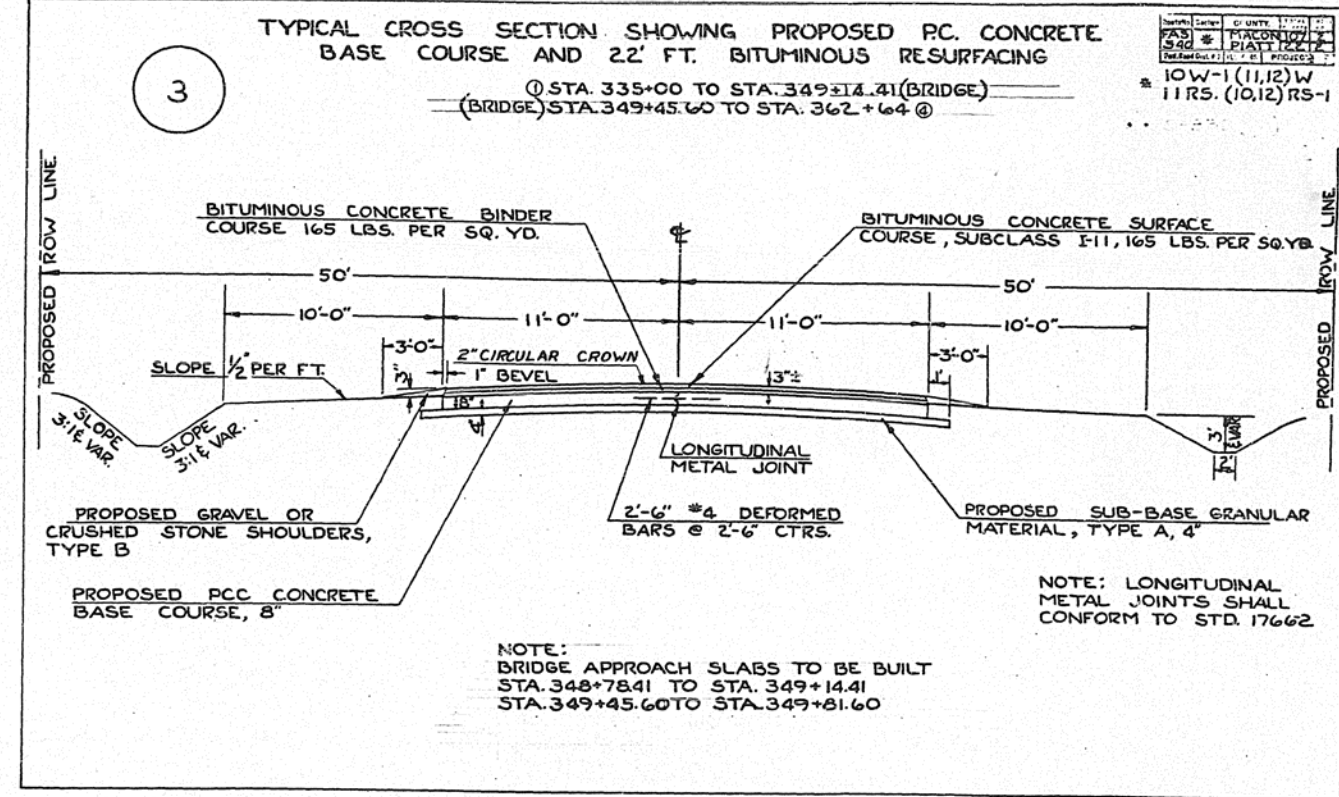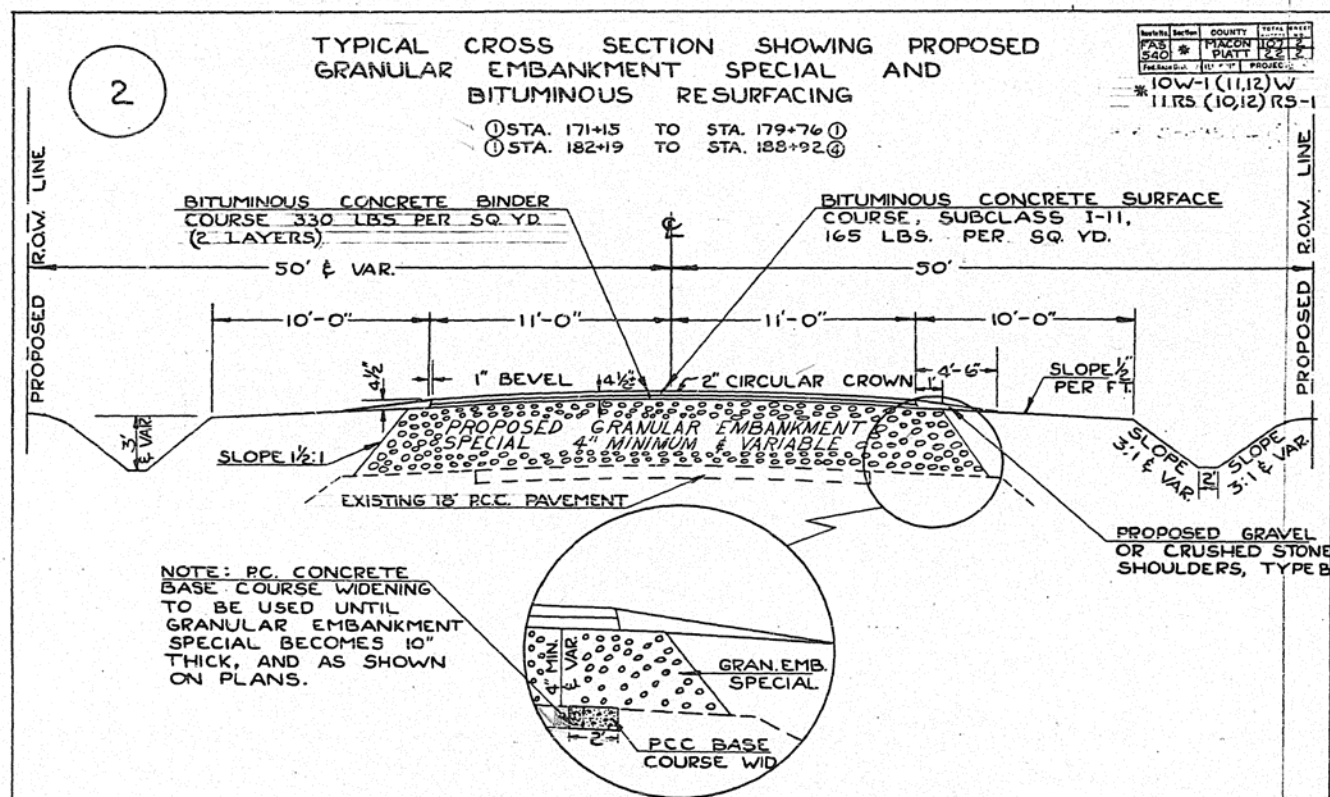


TYPICAL CROSS SECTION FOR INTERSECTING
SIDEROADS AND PRIVATE ENTRANCES
STA. 163+53 TO STA 530+91.65

Project: Section: COUNTY: TOTAL SHEET: 10
FAS: # PIATT 12213
S40: # PIATT 12213
Sheet No.: 10 of 11 PROJECT: 10W-1 (11,12)W
11 RS (10,12) RS-1

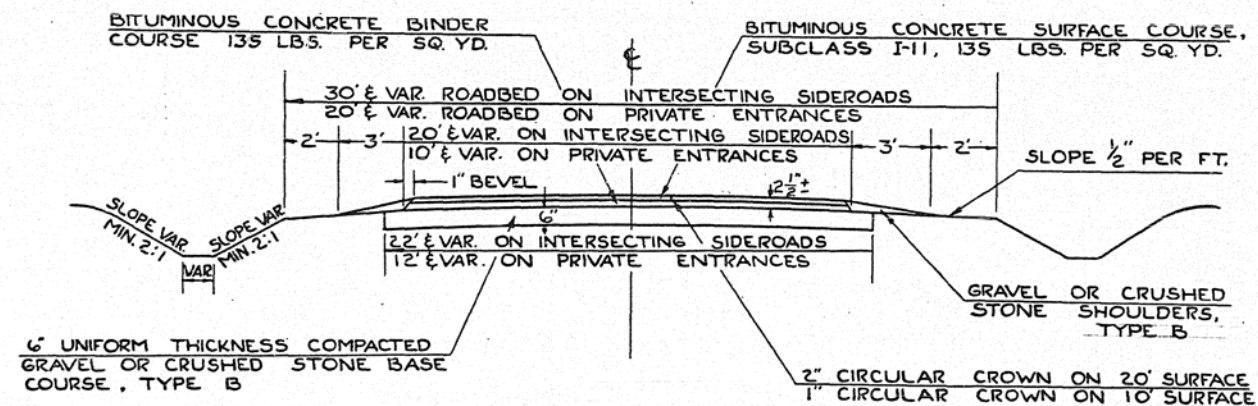

TYPICAL CROSS SECTION OF EXISTING 18' P.C.
CONCRETE PAVEMENT
STA. 120+95 TO STA 530+91.65


Project: Section: COUNTY: TOTAL SHEET: 10
FAS: # PIATT 12213
S40: # PIATT 12213
Sheet No.: 10 of 11 PROJECT: 10W-1 (11,12)W
11 RS (10,12) RS-1

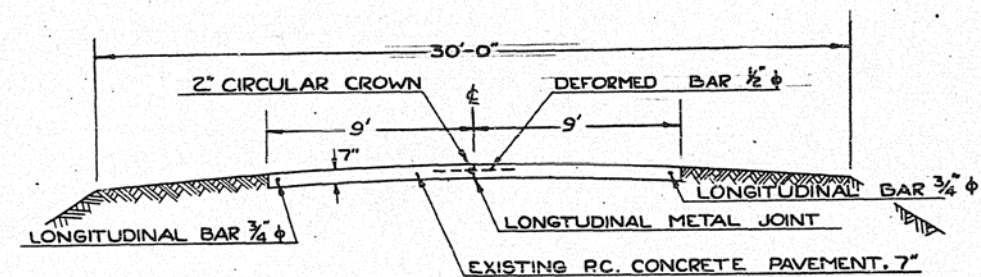

TYPICAL CROSS-SECTION SHOWING PROPOSED I-II
RESURFACING OF EXISTING 18' P.C. PAVEMENT

5 STA. 120+95 TO STA. 163+53 ①

Project: Section: COUNTY: TOTAL SHEET: 10
FAS: # PIATT 12213
S40: # PIATT 12213
Sheet No.: 10 of 11 PROJECT: 10W-1 (11,12)W
11 RS (10,12) RS-1

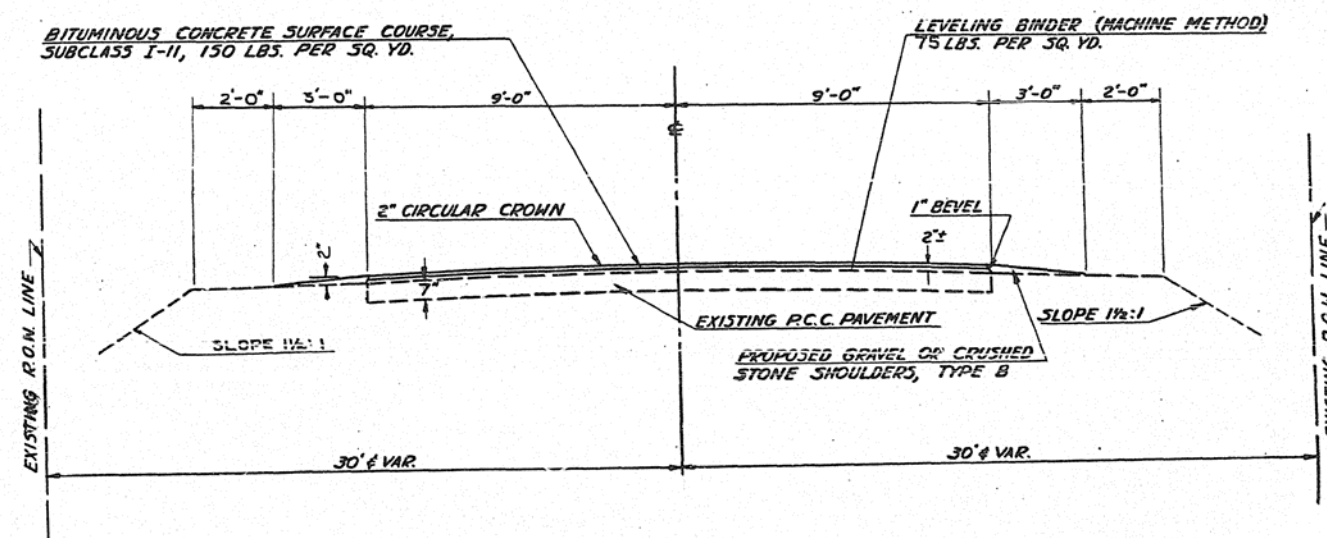

Section	County	Project
100-1 (11,12)W	MACON	107-4

Section	County	Project
100-1 (11,12)W	MACON	107-4

SHEET NO.	INDEX OF SHEETS
1	Cover Sheet
2	Typical Cross-sections Nos. 1, 2, 3 & 4, etc. and etc.
3	Typical Cross-section No. 5, Typical Cross-section of Existing Pavement, Typical Cross-section for Intersecting Sideroads and Private Entrances
4	Summary of Quantities, Index of Sheets
5	Summary of Existing Culverts to be Removed, Tabulation of Concrete Patching & I-11 Resurfacing
6	General Notes, Summary of Class X Concrete
7 - 19 (Incl.)	Plan & Profile Sheets (Sta. 120-95 to Sta. 530-91.65)
20	Detail of Intersection of F.A.S. 540 and S.A. 25 (Oakley Road)
21	Typical Detail of Intersecting Sideroads & Private Entrances (Sta. 120-95 to Sta. 153-53), Typical Detail of Intersection Sideroads & Private Entrances (Sta. 153-53 to Sta. 530-91.65)
22	Special Tile Outlet Headwall, Detail of Special Inlet for Comb. Conc. Curb & Gutter, Type 6, Detail of Special Outlet for Comb. Conc. Curb & Gutter, Type 5
23	Special Design for Paved Ditch & Transition from Pipe Culvert to Paved Ditch, Special Design for Paved Ditch Inlets
24	Special Culvert Extension, 2' x 1.5' Box, Sta. 151-32
25	Special Culvert Extension, 2' x 1.5' Box, Sta. 235-95
26	Special Culvert Extension, 2' x 1.5' Box, Sta. 281-53
27	Special Culvert Extension, 2' x 2' Box, Sta. 327-69.5
28	Special Culvert Extension, 2' x 2' Box, Sta. 342-24
29	Special Culvert Design, 4' x 4' Box, Rt. Sta. 351-40.5
30	Special Culvert Design, 4' x 3' Box, Rt. Sta. 352-23
31	Special Culvert Design, 4' x 3' Box, Rt. Sta. 353-25
32	Special Culvert Design, 4' x 3' Box, Rt. Sta. 378-10
33	Special Culvert Extension 3' x 1.5' Box, Sta. 383-54
34	Special Culvert Extension, 2' x 2' Box, Sta. 410-54
35	Special Culvert Extension, 2' x 2' Box, Sta. 498-35
36	Special Culvert Extension, 2' x 1.5' Box, Sta. 530-11
37 - 99 (Incl.)	Station Cross-sections (Sta. 153-00 to Sta. 530-91.65)
100	Standards 15165-1, 1517
101	Standards 15388, 1976 & 1744-1
102	Standard 2051
103	Standards 1765-1 & 1790
104	Standard for Bridge Approach Slabs, Base Course
105	Standards 1989-1, 2135, 1971-2 & 2114
106	Standards 1972-1, 2116, 2143 & 1775R
107	Standards 1977-4 & 2122

Total As Built

PROJ.S-835(4)

QUANTITY	UNITS	SUMMARY OF QUANTITIES	ITEM	CODE
State Work				NUMBER
600	In.Dia.	Tree Removal (6 to 15 inch diameter)		010001
1,200	In.Dia.	Tree Removal (Over 15 inch diameter)		010002
77,937	Cu.Yds.	Earth Excavation		011001
2,827	Tons	Granular Embankment - Special		017001
90	Cu.Yds.	Trench Backfill		020001
1,900	Tons	Sub-base-Granular Material, Type A		024001
1,600	Tons	Gravel or Crushed Stone Base Course, Type B		029003
7,433	Sq.Yds.	Portland Cement Concrete Base Course (8")		032005
176	Sq.Yds.	Portland Cement Concrete Base Course 10 1/2" - 10 3/4"		032009
14,744	Sq.Yds.	Portland Cement Concrete Base Course Widening (8")		033005
126.8	Cu.Yds.	Class X Concrete		052003
44.3	Cu.Yds.	Class X Concrete (Headwall)		052016
496	Lin.Ft.	Pipe Culverts, Type 1A, 18"		058005
140	Lin.Ft.	Pipe Culverts, Type 1A, 24"		058007
132	Lin.Ft.	Pipe Culverts, Type 1A, (Reinforced Concrete Culvert Class III), 18"		058074
48	Lin.Ft.	Pipe Culverts, Type 1A, (Reinforced Concrete Culvert Class III), 24"		058076
1,584	Lin.Ft.	Pipe Culverts, Type 1, 15"		058199
336	Lin.Ft.	Pipe Culverts, Type 1, 18"		058200
164	Lin.Ft.	Pipe Culverts, Type 1, 24"		058202
46	Lin.Ft.	Pipe Culverts, Type 2, 15"		058222
48	Lin.Ft.	Pipe Culverts, Type 2, 24"		058225
23,875	Lbs.	Reinforcement Bars		059001
100	Lin.Ft.	Storm Sewers, Type 1, 10"		066002
234	Lin.Ft.	Storm Sewers, Type 1, 12"		066003
100	Lin.Ft.	Storm Sewers, Type 2, 8"		066024
225	Lin.Ft.	Storm Sewers, Type 2, 10"		066025
100	Lin.Ft.	Storm Sewers, Type 2, 12"		066026
106	Lin.Ft.	Storm Sewers, Type 2, 6"		066392
52	Lin.Ft.	Copper Service Pipe, 3/4 Inch		073001
2	Each	Catch Basins, Type C, Type II Frame		075027
1	Each	Catch Basins, Type C, with Type I Frame, Closed Lid		075146
1	Each	Filling Existing Catch Basins		079002
275	Lin.Ft.	Combination Concrete Curb and Gutter, Type 6		080006
160	Lin.Ft.	Combination Concrete Curb and Gutter, Type 10		080010
30	Sq.Yds.	P.C. Concrete Median, Type 3, Special		081018
1,157	Sq.Yds.	Pavement Removal		082001
189	Sq.Ft.	Sidewalk Removal		082006
230	Sq.Yds.	Pavement Removal and Replacement, Type I (5")		085001
490	Sq.Yds.	Pavement Removal and Replacement, Type IA (8")		085002
1,065	Sq.Yds.	Pavement Removal and Replacement, Type II (5")		085003
550	Sq.Yds.	Pavement Removal and Replacement, Type III (5")		085004
290	Sq.Yds.	Pavement Removal and Replacement, Type IV (8")		085005
291	Sq.Ft.	Portland Cement Concrete Sidewalk (5")		085003
2,752	Lin.Ft.	Paved Ditch, 6 Feet		091005
115	Lin.Ft.	Paved Ditch, 9 Feet		091008
24	Each	Guard Post Removal		095003
6.2	Tons	Calcium Chloride Applied		102001
177	Each	Furnishing and Erecting Right of Way Markers		104001
2	Each	Re-erecting Right of Way Markers		104002
24.1	Acres	Temporary Seeding		110001
24.1	Acres	Complete Seeding		110004
68	Tons	Straw for Asphalt-Coated Mulch		111002
6,800	Gals.	Emulsified Asphalt		111003
1,050	Sq.Yds.	Sodding		112001
4	Units	Supplemental Watering		112002
1	Each	Furnishing and Erecting Drainage Markers		200125
		Building Removal		200126
		Removal Existing Structures		

NO.	SECTION	COUNTY	TOTAL
10	10	10	10
11	11	11	11
12	12	12	12
100	100	100	100

TABULATION OF CONCRETE PATCHING AND I-11 RESURFACING

PAVEMENT REMOVAL AND REPLACEMENT					THICKNESS OF I-11 RESURFACING	STA. TO STA.	REMARKS
Type I	Type IA	Type II	Type III	Type IV			
70	260	635	250	160	2 inches	120+95 - 163+53	
25	40	100			3 inches	163+53 - 171+15	
	25				4-1/2 inches	171+15 - 179+76	Grade Change - Granular Embankment
					3 inches	179+76 - 182+19	
					4-1/2 inches	182+19 - 188+92	Grade Change - Granular Embankment
	10		30		4-1/2 inches	188+92 - 201+00	
140	330	640	375	70	3 inches	201+00 - 303+00	
					4-1/2 inches	303+00 - 317+00	
10	25	30			3 inches	317+00 - 335+00	
					3 inches	335+00 - 362+64	Grade Change - P.C.C. Base Course
10	10	75			4-1/2 inches	362+64 - 401+00	
10	10				3 inches	401+00 - 410+00	
10	15	180	110	200	4-1/2 inches	410+00 - 530+91.65	
275	725	1650	765	430	TOTALS - SQ. YDS.		
300	750	1700	800	450	USE: TOTALS - SQ. YDS.		

NOTE:

PAVEMENT REMOVAL AND REPLACEMENT TO BE HELD TO A MINIMUM WHERE IT OCCURS UNDER PROPOSED 4-1/2 INCH I-11 RESURFACING

NO.	SECTION	COUNTY	TOTAL
10	10	10	10
11	11	11	11
12	12	12	12
100	100	100	100

SUMMARY OF EXISTING CULVERTS TO BE REMOVED

LOCATION	SIZE	TYPE
Lt. 176+81.5	15" x 30'	Pipe Culvert
Rt. 176+96	15" x 20'	Pipe Culvert
Lt. 189+98	18" x 16'	Pipe Culvert
Rt. 190+18.5	18" x 30'	Pipe Culvert
Rt. 203+63	12" x 16'	Pipe Culvert
Lt. 203+64	12" x 18'	Pipe Culvert
Lt. 216+87	18" x 33'	Pipe Culvert
Rt. 216+87	18" x 33'	Pipe Culvert
Rt. 218+08.5	12" x 25'	Pipe Culvert
Rt. 242+17	15" x 17.5'	Pipe Culvert
Lt. 243+64.5	15" x 17'	Pipe Culvert
Lt. 250+39	12" x 34'	Pipe Culvert
Rt. 250+42	12" x 16.5'	Pipe Culvert
Lt. 252+83	12" x 16'	Pipe Culvert
Rt. 256+63.5	12" x 17'	Pipe Culvert
Rt. 263+21	12" x 20'	Pipe Culvert
Lt. 277+80	12" x 17.5'	Pipe Culvert
Rt. 286+05	12" x 17'	Pipe Culvert
Rt. 288+09	12" x 16'	Pipe Culvert
Lt. 297+37	12" x 16.5'	Pipe Culvert
Rt. 297+54	12" x 15'	Pipe Culvert
Lt. 310+62.5	12" x 17'	Pipe Culvert
Rt. 310+68	12" x 18'	Pipe Culvert
Lt. 315+26	12" x 17'	Pipe Culvert
Rt. 318+22	12" x 24'	Pipe Culvert
Rt. 323+94	15" x 31'	Pipe Culvert
Rt. 325+99.5	15" x 18'	Pipe Culvert
Rt. 328+57	15" x 18'	Pipe Culvert
Lt. 329+20	12" x 20'	Pipe Culvert
Rt. 337+14	12" x 19.5'	Pipe Culvert
Lt. 337+77	12" x 13.5'	Pipe Culvert
Rt. 339+60	15" x 17'	Pipe Culvert
Rt. 351+40.5	18" x 2' (21')	Box Culvert
Lt. 354+21.5	18" x 17'	Pipe Culvert
Lt. 358+82	18" x 17.5'	Pipe Culvert
Lt. 362+22	18" x 17.5'	Pipe Culvert
Rt. 362+23	4' x 2' (21')	Box Culvert
Rt. 363+54.5	4' x 2' (31')	Box Culvert
Lt. 367+90	18" x 17'	Pipe Culvert
Rt. 378+00.5	4' x 2' (21')	Box Culvert
Lt. 378+33.5	18" x 17'	Pipe Culvert
Lt. 388+97	18" x 17.5'	Pipe Culvert
Rt. 391+57	18" x 32'	Pipe Culvert
Lt. 391+57	18" x 31.5'	Pipe Culvert
Lt. 398+41.5	18" x 15'	Pipe Culvert
Rt. 400+44	15" x 17.5'	Pipe Culvert
Lt. 405+13	12" x 122'	Pipe Culvert
Rt. 418+00.5	12" x 17'	Pipe Culvert
Rt. 424+49	12" x 17'	Pipe Culvert
Lt. 431+21	18" x 32'	Pipe Culvert
Rt. 431+24	18" x 32'	Pipe Culvert
Rt. 437+75	15" x 18'	Pipe Culvert
Lt. 444+35.5	15" x 17'	Pipe Culvert
A.R. 444+50	2' x 2'	Box Culvert

SUMMARY OF EXISTING CULVERTS TO BE REMOVED (Cont'd.)

LOCATION	SIZE	TYPE
Lt. 451+84	12" x 14'	Pipe Culvert
Rt. 454+22	12" x 27.5'	Pipe Culvert
Lt. 454+30.5	12" x 17'	Pipe Culvert
Rt. 470+72	15" x 18.5'	Pipe Culvert
Lt. 484+00	18" x 31.5'	Pipe Culvert
Rt. 484+00	18" x 31.5'	Pipe Culvert
Rt. 497+49	18" x 19'	Pipe Culvert
Lt. 506+02	12" x 19'	Pipe Culvert
Lt. 519+10	18" x 20'	Pipe Culvert
Lt. 524+36	18" x 18'	Pipe Culvert
Lt. 524+62	18" x 16'	Pipe Culvert

NOTE: ALL EXISTING CULVERTS TO BE REMOVED, EXCEPT AS OTHERWISE NOTED, SHALL BE REMOVED AND DISPOSED OF IN ACCORDANCE WITH SECTION 49 OF THE STANDARD SPECIFICATIONS.

GENERAL NOTES

All notes in these plans apply to Section 10W-1(11,12)W unless otherwise specified.

Trees that interfere with construction operations shall be removed as directed by the Engineer.

ESTIMATED QUANTITIES:

500 Inch Dia. TREE REMOVAL (6" to 15" Dia.)
1,200 Inch Dia. TREE REMOVAL (Over 15" Dia.)

Earthwork quantities for the entire section:
EARTH EXCAVATION EARTH EMENDMENT WASTE
77,937 Cu. Yds. 32,346 Cu. Yds. 35,837 Cu. Yds.
77,937 Cu. Yds. EARTH EXCAVATION

Granular Embankment Special shall be placed over the existing pavement at locations shown on the plans and to a depth sufficient to raise the grade to 4-1/2 inches below the elevations shown on the plans.

ESTIMATED QUANTITY:

2,827 Tons GRANULAR EMBANKMENT - SPECIAL

Trench Backfill shall be placed in all trenches made in the subgrade of the proposed improvement and in all trenches outside of the subgrade where the inner edge of the trench is closer than 2 feet to the edge of the proposed pavement.

ESTIMATED QUANTITY:

90 Cu. Yds. TRENCH BACKFILL

Sub-base Granular Material shall be placed 4 inches thick compacted, under the proposed P.C. Concrete Base Course in accordance with the typical cross sections included in the plans and as directed by the Engineer.

ESTIMATED QUANTITY:

1,900 Tons SUB-BASE GRANULAR MATERIAL, TYPE A

Gravel or Crushed Stone Base Course, Type B shall be placed 6 inches thick compacted on private entrances and side roads, and 4 inches thick compacted on mail box turnouts.

ESTIMATED QUANTITY:

1,600 Tons GRAVEL OR CRUSHED STONE BASE COURSE, TYPE B

The proposed Portland Cement Concrete Base Course, and Base Course Widening shall be constructed as shown on the typical cross sections and special details and as directed by the Engineer.

ESTIMATED QUANTITIES:

7,433 Sq. Yds. P.C. CONCRETE BASE COURSE, 8 INCH
14,744 Sq. Yds. P.C. CONCRETE BASE COURSE WIDENING, 8 INCH

The existing pavement shall be removed and replaced in accordance with Standard 211c at locations where in the opinion of the Engineer it is necessary to patch the existing pavement.

ESTIMATED QUANTITIES:

300 Sq. Yds. PAVEMENT REMOVAL AND REPLACEMENT, TYPE I (3")
750 Sq. Yds. PAVEMENT REMOVAL AND REPLACEMENT, TYPE II (4")
1,700 Sq. Yds. PAVEMENT REMOVAL AND REPLACEMENT, TYPE III (5")
800 Sq. Yds. PAVEMENT REMOVAL AND REPLACEMENT, TYPE IV (6")
450 Sq. Yds. PAVEMENT REMOVAL AND REPLACEMENT, TYPE V (7")

Calcium chloride is to be applied on the Granular Embankment Special as directed by the Engineer.

ESTIMATED QUANTITY:

6.2 Tons CALCIUM CHLORIDE APPLIED

Shoulders, ditches, side slopes, backlopes, and other portions of the right of way having insufficient vegetation shall be seeded as directed by the Engineer.

ESTIMATED QUANTITIES:

24.1 Acres TEMPORARY SEEDING
24.1 Acres COMPLETE SEEDING

Side slopes and backlopes having a slope of 4 to 1 or greater and all shoulders shall be mulched as directed by the Engineer.

ESTIMATED QUANTITIES:

68 Tons STRAW FOR ASPHALT-COATED MULCH
6,800 Gals. EMULSIFIED ASPHALT

A strip of sod 18 inches wide shall be placed on each side of paved ditches, paved ditch transitions, and as directed by the Engineer.

ESTIMATED QUANTITIES:

1,050 Sq. Yds. SODDING
4 Units SUPPLEMENTAL WATERING

Existing Guard Posts shall be removed from the ends of culverts and at other locations as designated by the Engineer. They shall be stored along the right of way as directed by the Engineer.

ESTIMATED QUANTITY:

24 Each GUARD POST REMOVAL

APPROACHES:

Dotted Lines indicate earth roadbed, without surfacing material.

Solid Lines indicate approaches to be surfaced with Gravel or Crushed Stone Base Course, Type B.

Right of way markers shall be set at locations indicated on the plans and as directed by the Engineer. All right of way markers shall be made to the dimensions of, and constructed in accordance with, Standard 1744-1, Method A.

Symbols for right of way markers:

- Indicates right of way marker to remain in place.
- ⊠ Indicates right of way marker to be removed and reset at another location.
- Indicates right of way marker to be set at this location.

GENERAL NOTES (Cont'd.)

Symbols for power line poles:

- ⊕ Indicates present location of power line pole.
- ⊙ Indicates proposed location of power line pole.

Symbols for telephone or telegraph poles:

- ⊕ Indicates present location of telephone or telegraph poles.
- ⊙ Indicates proposed location of telephone or telegraph poles.

Before ordering storm sewers and pipe culverts the Contractor shall consult the Engineer for exact lengths.

The elevations shown on the plans and cross sections are based on U.S.G.S. M. datum.

Elevations shown on the plans and station cross sections are the elevations for the top of the existing pavement along the existing centerline except as listed below:

1. From Sta. 170+00 to 193+00; Sta. 335+00 to Sta. 349+14.41 and; Sta. 349+15.69 to Sta. 362+64.
The elevations shown are to the top of the proposed I-11 Resurfacing along the centerline.

The minimum stopping sight distance is 442 feet at the vertical curve at Sta. 399+00.

The maximum grade is 3.57% at Sta. 390+00 and extends for 100 feet.

The minimum radius of horizontal curves within the limits of sections is at Sta. 121+35 with a radius of 829.34 feet.

The horizontal clearance of the proposed bridge at Sta. 349+30 is 41 feet with unlimited vertical clearance.

The boundary between Macon and Piatt Counties is at Sta. 434+00.

Two signs conforming to Standard 2136 shall be erected at locations designated by the Engineer. The cost of these shall be considered as incidental to the contract.

SUMMARY OF CLASS X CONCRETE


SECTION TO STATION	TYPE OF STRUCTURE	CU. YDS.
L 174-81.5	Std. 2051-DS18-2	3.1*
LAR 181-32	Special Culvert Extension 2' x 1.5' Box	4.1
R 190-20	Std. 2051-DS18-2	3.1*
L 216-87	Std. 2051-DS18-2	3.1*
R 216-87	Std. 2051-DS18-2	3.1*
L 217+29	Std. 1976-D18-2 (1 Hdw.)	0.65*
R 217+29	Std. 1976-D18-2 (1 Hdw.)	0.65*
LAR 235+95	Special Culvert Extension 2' x 1.5' Box	4.0
L 262-15	Std. 1976-D18-2 (1 Hdw.)	0.65*
R 262-15	Std. 1976-D18-2 (1 Hdw.)	0.65*
AR 270-50	Std. 1976-D18-2	1.3*
L 270-96.9	Std. 2051-DS18-2	2.6*
LAR 281-53	Special Culvert Extension 2' x 1.5' Box	4.6
L 294-24	Std. 1976-D18-2 (1 Hdw.)	0.65*
R 294-24	Std. 1976-D18-2 (1 Hdw.)	0.65*
L 303-72	Std. 1976-D18-2 (1 Hdw.)	0.65*
R 303-72	Std. 1976-D18-2 (1 Hdw.)	0.65*
L 322-88.98	Special Inlet for Comb. Conc. C. & G., Type 6	0.5
L 323-44	Special Tile Outlet Headwall	0.3*
R 323-90.8	Std. 2051-DS18-2	2.6*
L 324-56	Special Tile Outlet Headwall	0.3*
L 325-10.70	Special Outlet for Comb. Conc. C. & G., Type 6	1.5
LAR 327-69.5	Special Culvert Extension 2' x 2' Box	5.9
LAR 342-24	Special Culvert Extension 2' x 2' Box	10.0
L 343-50 - 343-65	Paved Ditch Inlet	2.1
R 343-50 - 343-65	Paved Ditch Inlet	2.1
AR 348+98 & 349+62	Reinforced Concrete Piling Caps	3.2
L 350-35 - 350-50	Paved Ditch Inlet	2.1
R 350-35 - 350-50	Paved Ditch Inlet	3.0
R 351+40.5	Special Culvert Design 4' x 4' Box	16.3
R 351-60	Special Tile Outlet Headwall	0.2*
R 352+23	Special Culvert Design 4' x 3' Box	11.2
R 353+25	Special Culvert Design 4' x 3' Box	11.2
R 378-10	Special Culvert Design 4' x 3' Box	11.2
LAR 383-84	Special Culvert Extension 3' x 1.5' Box	5.4
L 388-59 - 388+84	Transition from Pipe Culvert to Paved Ditch	1.3
L 389-10 - 389+25	Transition from Pipe Culvert to Paved Ditch	1.3
L 391-15 - 391+31	Transition from Pipe Culvert to Paved Ditch	1.3
R 391-15 - 391+31	Transition from Pipe Culvert to Paved Ditch	1.6
L 391-83 - 391+98	Transition from Pipe Culvert to Paved Ditch	1.3
R 391-83 - 391+98	Transition from Pipe Culvert to Paved Ditch	1.6
L 398-14 - 398+29	Transition from Pipe Culvert to Paved Ditch	1.3
R 399-50 - 399+65	Paved Ditch Inlet	2.3
LAR 410-54	Special Culvert Extension 2' x 2' Box	4.9
L 431-21	Std. 2051-DS18-2	2.6*
R 431-24	Std. 2051-DS18-2	2.6*
LAR 444-60	Std. 1976-D24-2	2.0*
L 484-00	Std. 2051-DS24-2	4.1*
R 484-00	Std. 2051-DS24-2	4.1*
LAR 498-35	Special Culvert Extension 2' x 2' Box	4.8
LAR 530-11	Special Culvert Extension 2' x 1.5' Box	3.9
L 50+45	Std. 2051-DS24-2 (1 Hdw.)	1.6*
R 50+45	Std. 2051-DS24-2 (1 Hdw.)	1.7*
L 50+84.32	Special Outlet for Comb. Conc. C. & G., Type 6	1.4
R 50+98.81	Special Outlet for Comb. Conc. C. & G., Type 6	1.4



*CLASS X CONCRETE (HEADWALL) = 44.3 CU. YDS. O.K.

CLASS X CONCRETE = 126.6 CU. YDS. O.K.

R 318+15	Special Tile Outlet Headwall	0.4
R 478+00	Special Tile Outlet Headwall	0.4

ENTIRE SECTION INSPECTED AND
APPROVED AS TO POLICY
DISTRICT ENGINEER *J. J. C. C.*
DATE *June 24, 1960*

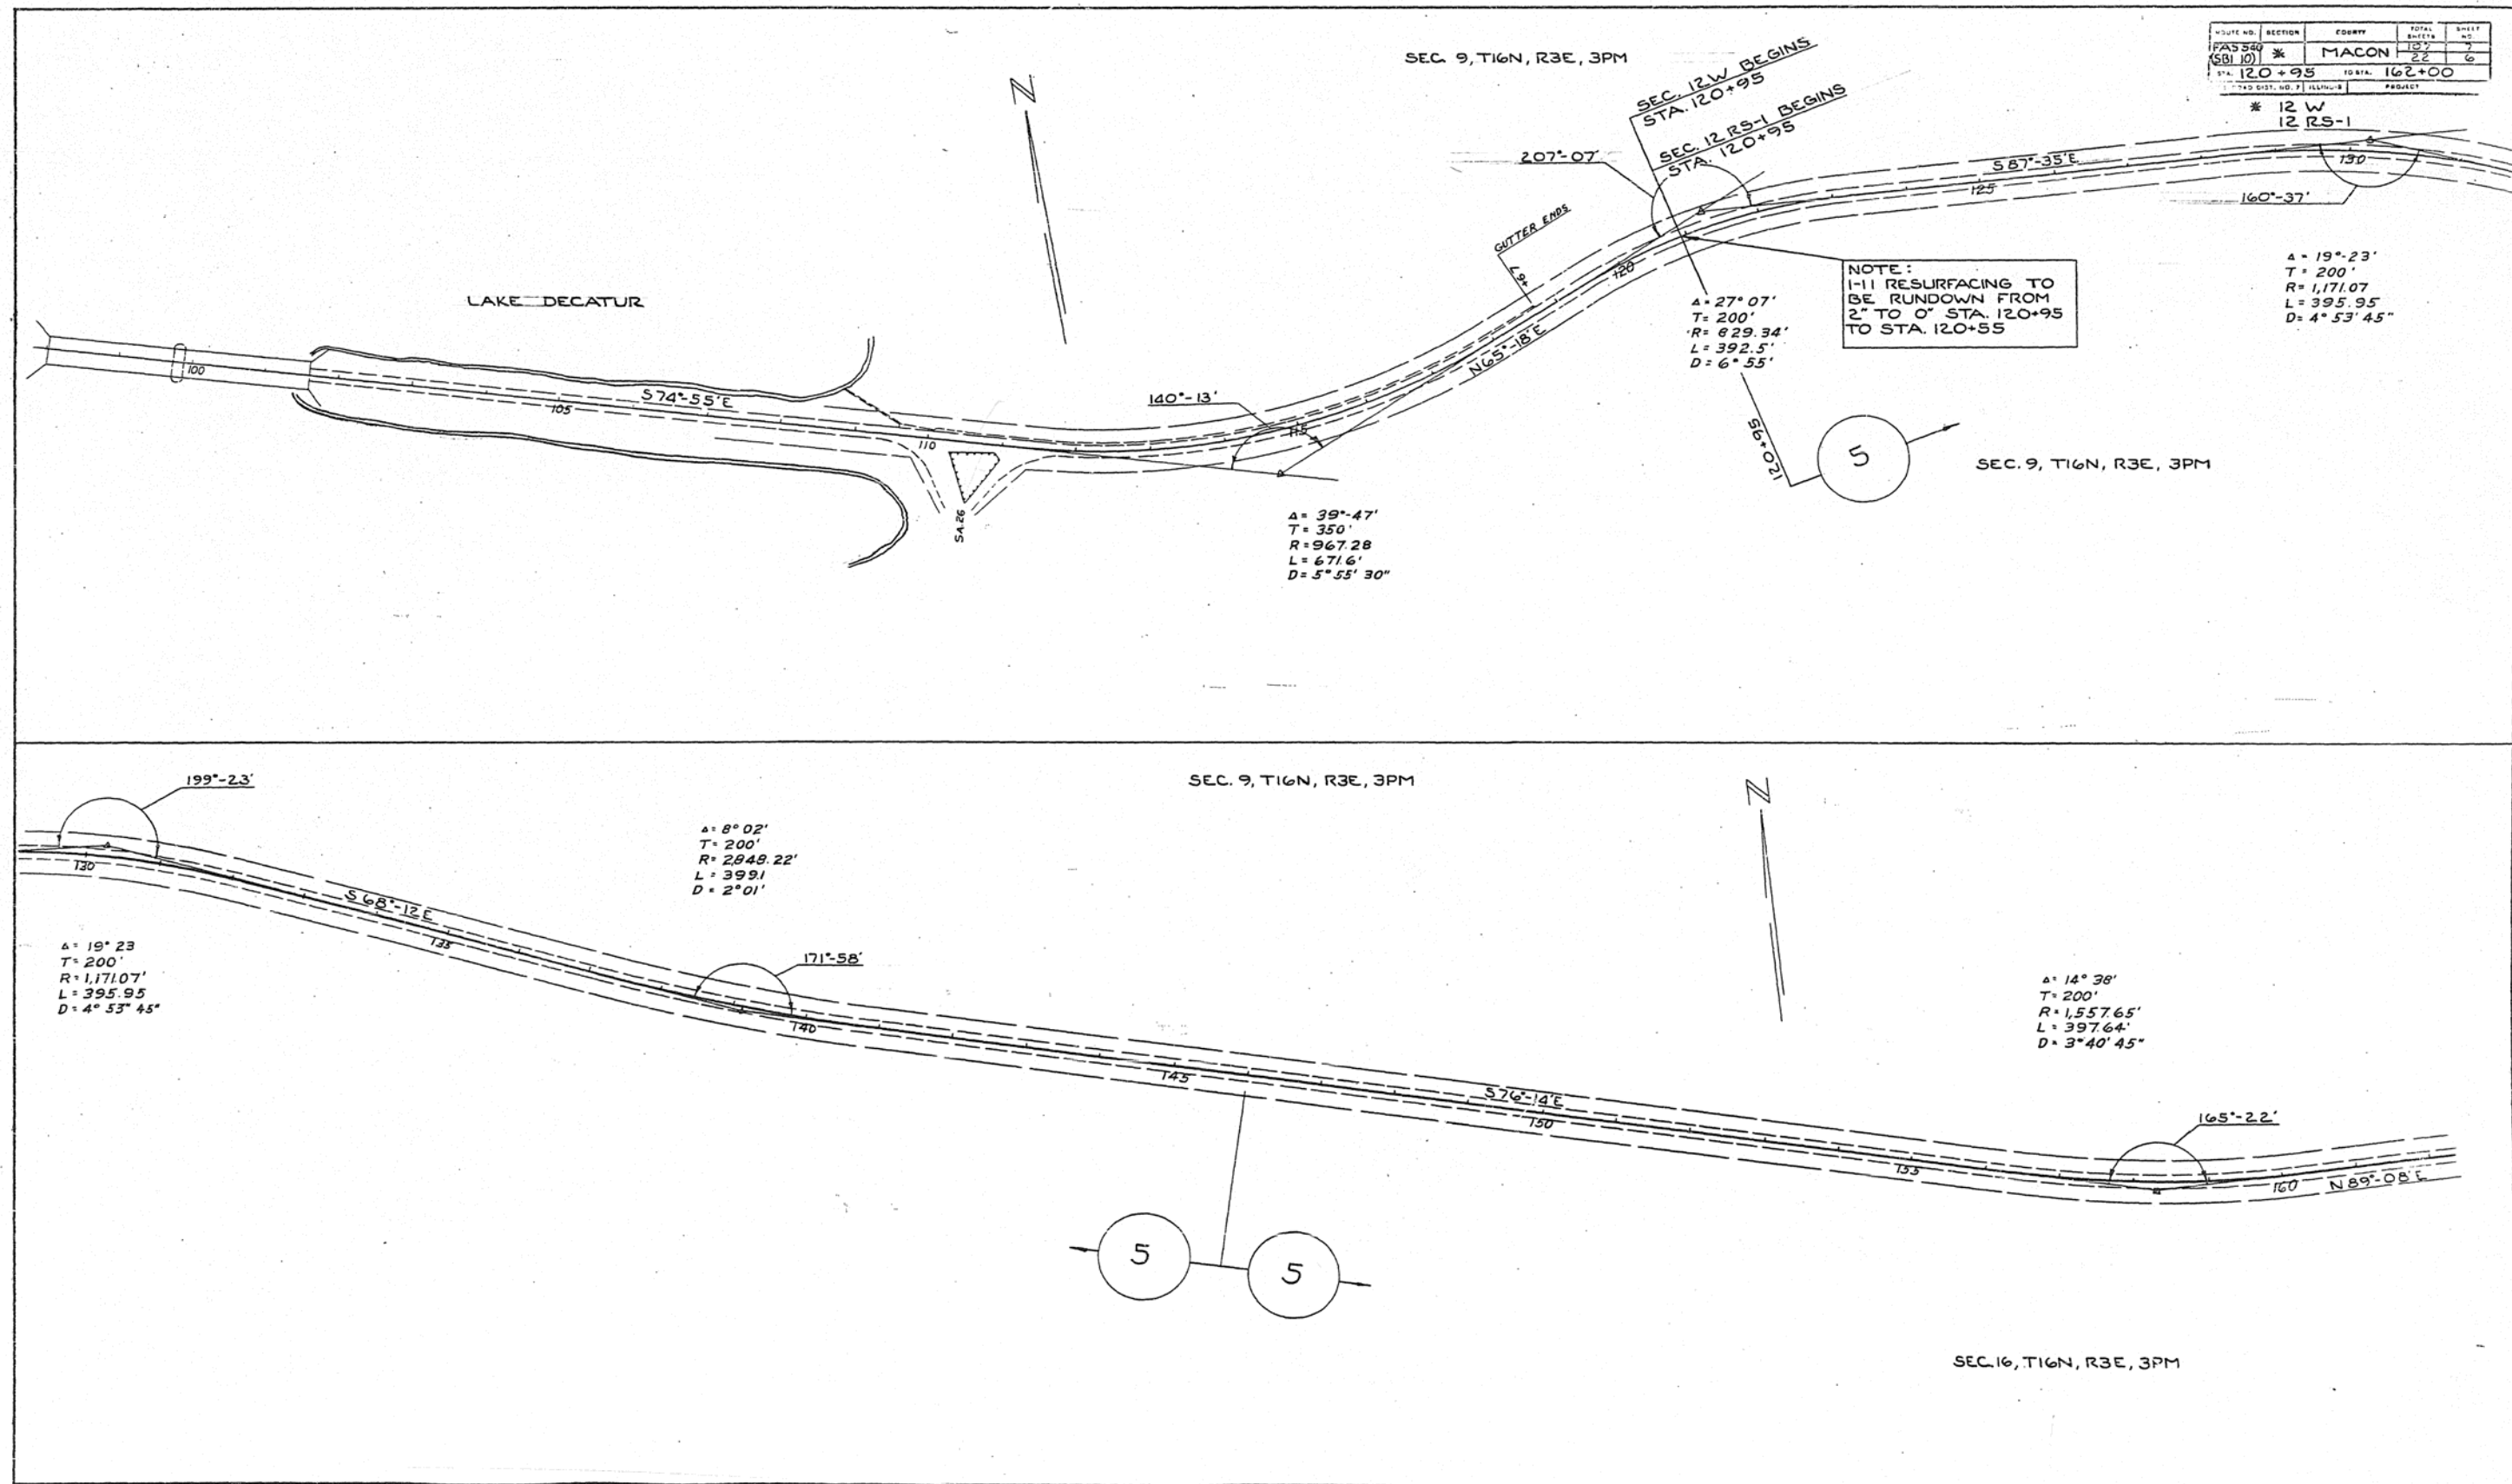

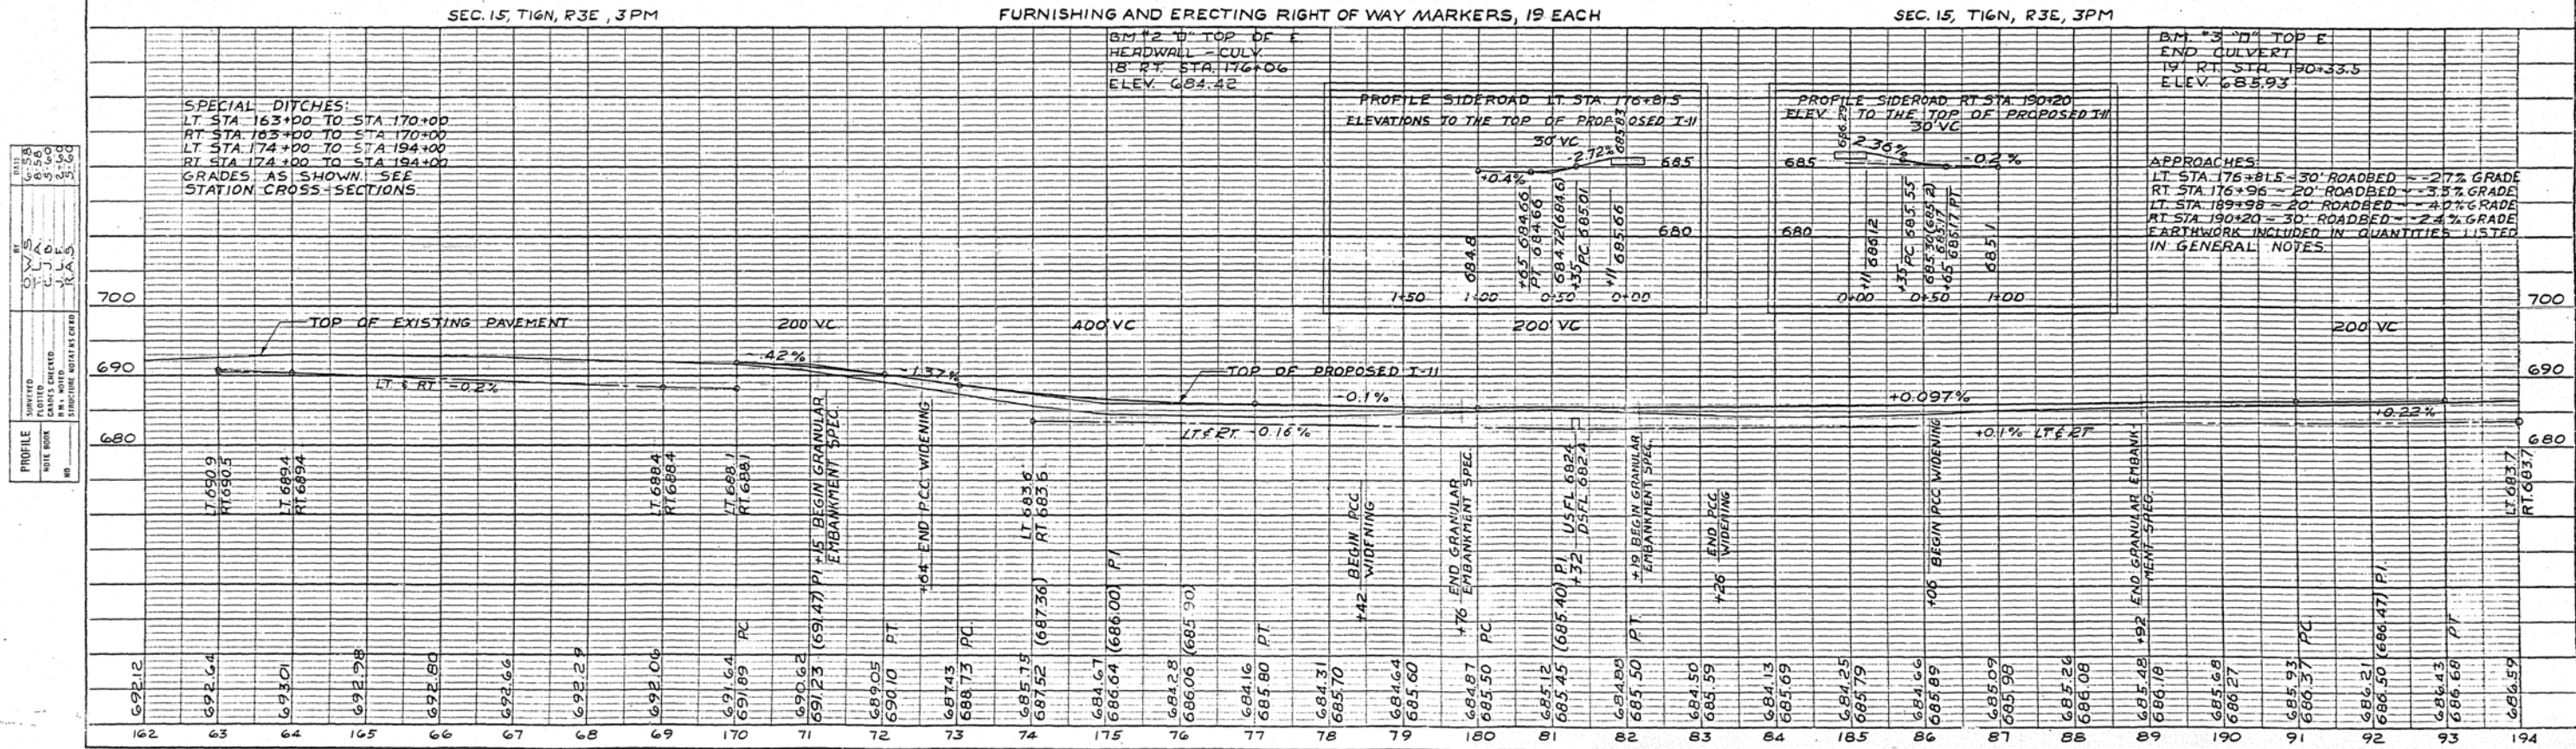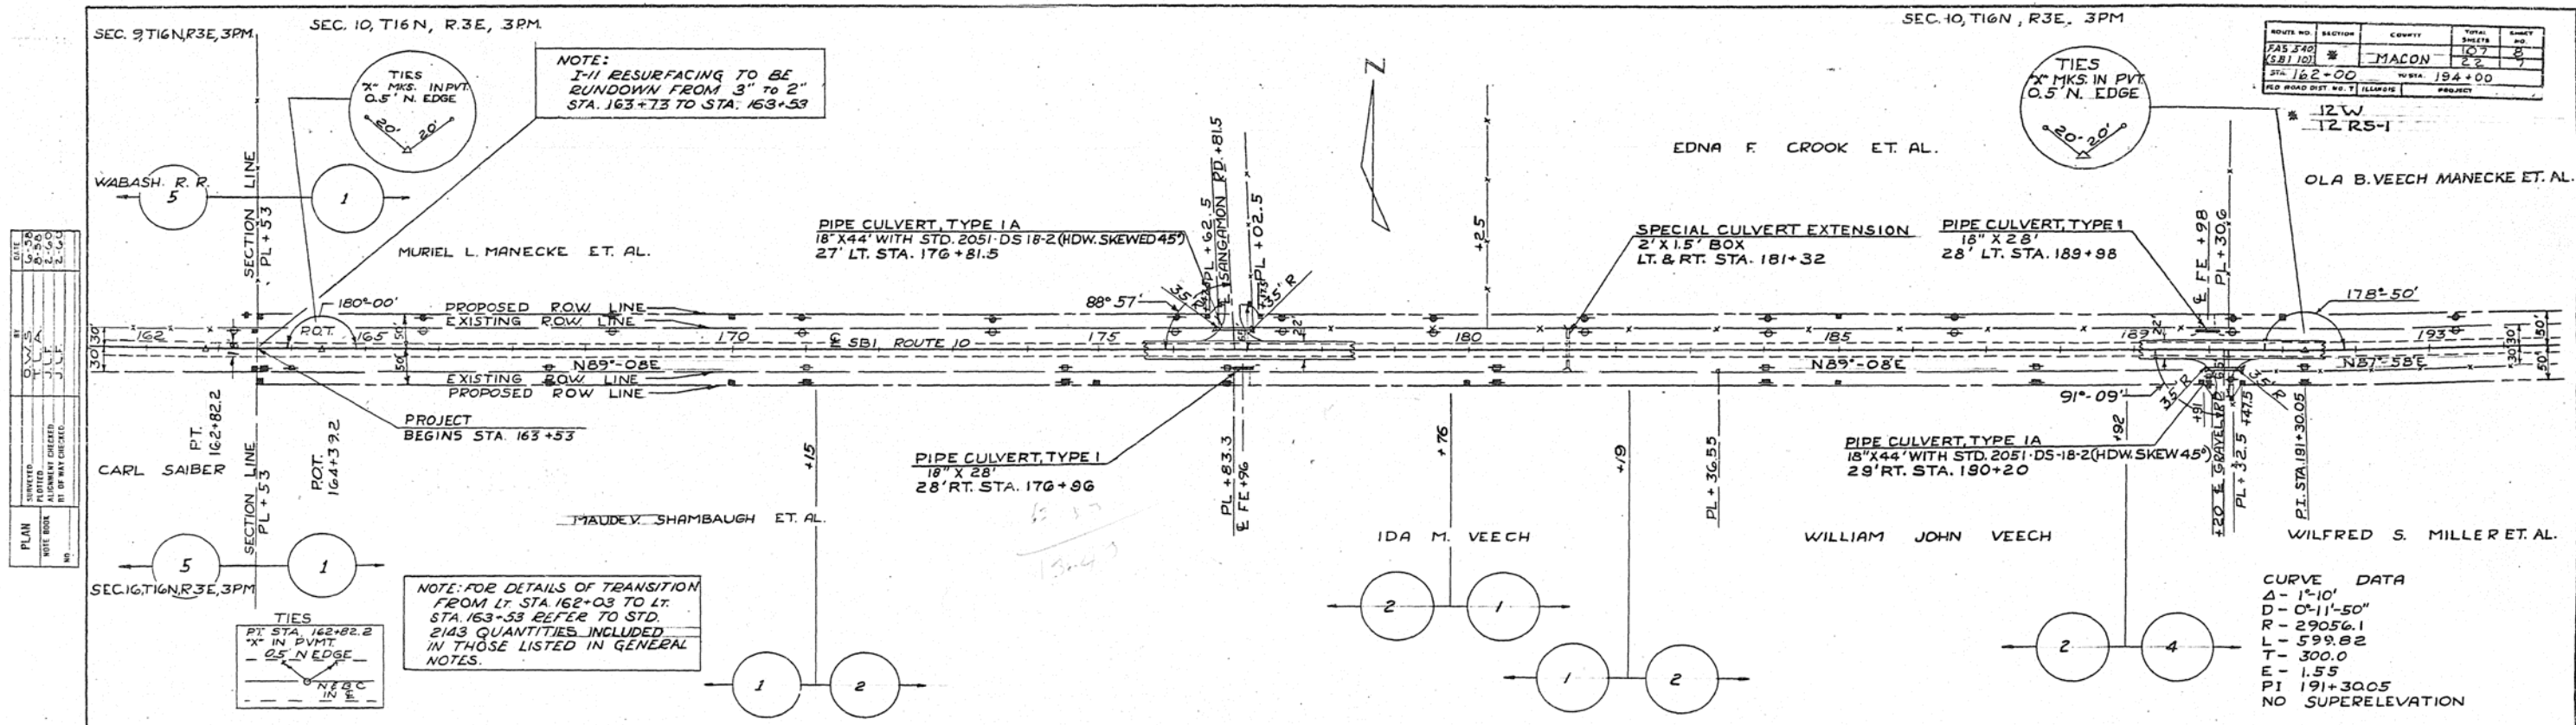

DATE	5-2-60
BY	J. J. J.
REVIEWED	J. J. J.
DATE	5-2-60
BY	J. J. J.
REVIEWED	J. J. J.
SEC. 10, T16N, R3E, 3PM

SEC. 11, T16N, R3E, 3PM

DATE	SECTION	COUNTY	TOTAL	DATE
FAS 540	101	MACON	22	10/1
STA 194+00			STA 226+00	
10' TILE +67				

* 12 W
12 RS-1

OLA B. VEECH MANECKE ET. AL.

MURIEL L. MANECKE ET. AL.

WILFRED S. MILLER ET. AL.

WILFRED S. MILLER ET. AL.

ROSE HARPSTRITE ET. AL.

NOTE:
I-11 RESURFACING TO BE
RUNDOWN FROM 4 1/2" TO
3" STA. 201+00 TO STA.
201+30

CURVE DATA
Δ = 0° 46'
T = 300.0'
R = 1.000'
L = 448.400'
D = 0° 75'
L = 599.9'


SEC. 15, T16N, R3E, 3PM

FURNISHING AND ERECTING RIGHT OF WAY MARKERS, 18 EACH

SEC. 14, T16N, R3E, 3PM

SPECIAL DITCHES:
LT STA 194+00 TO STA 209+00
RT STA 194+00 TO STA 209+00
LT STA 210+00 TO STA 226+00
RT STA 210+00 TO STA 226+00
GRADES AS SHOWN SEE
STATION CROSS SECTIONS.

STORM SEWERS TYPE 1, 10"
LT & RT STA. 216+67 = 100 LIN. FT.
TOTAL 100 LIN. FT.

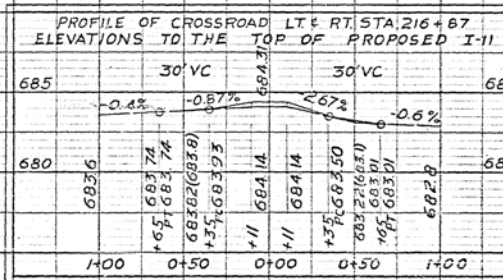

APPROACHES:
RT STA 203+63 - 20' ROADBED - 1.4% GRADE
LT STA 203+64 - 20' ROADBED - 2.4% GRADE
LT STA 216+67 - 30' ROADBED - 0.9% GRADE
RT STA 216+67 - 30' ROADBED - 2.7% GRADE
RT STA 218+08.5 - 20' ROADBED - 2.3% GRADE
EARTHWORK INCLUDED IN QUANTITIES
LISTED IN GENERAL NOTES

TOP OF EXISTING PAVEMENT

LT & RT +0.1%


LT & RT -0.2%

TOP OF EXISTING PAVEMENT

LT & RT +0.2%


DATE	SECTION	COUNTY	TOTAL	DATE
FAS 540	101	MACON	22	10/1
STA 194+00			STA 226+00	
10' TILE +67				

DATE	SECTION	COUNTY	TOTAL	DATE
FAS 540	101	MACON	22	10/1
STA 194+00			STA 226+00	
10' TILE +67				

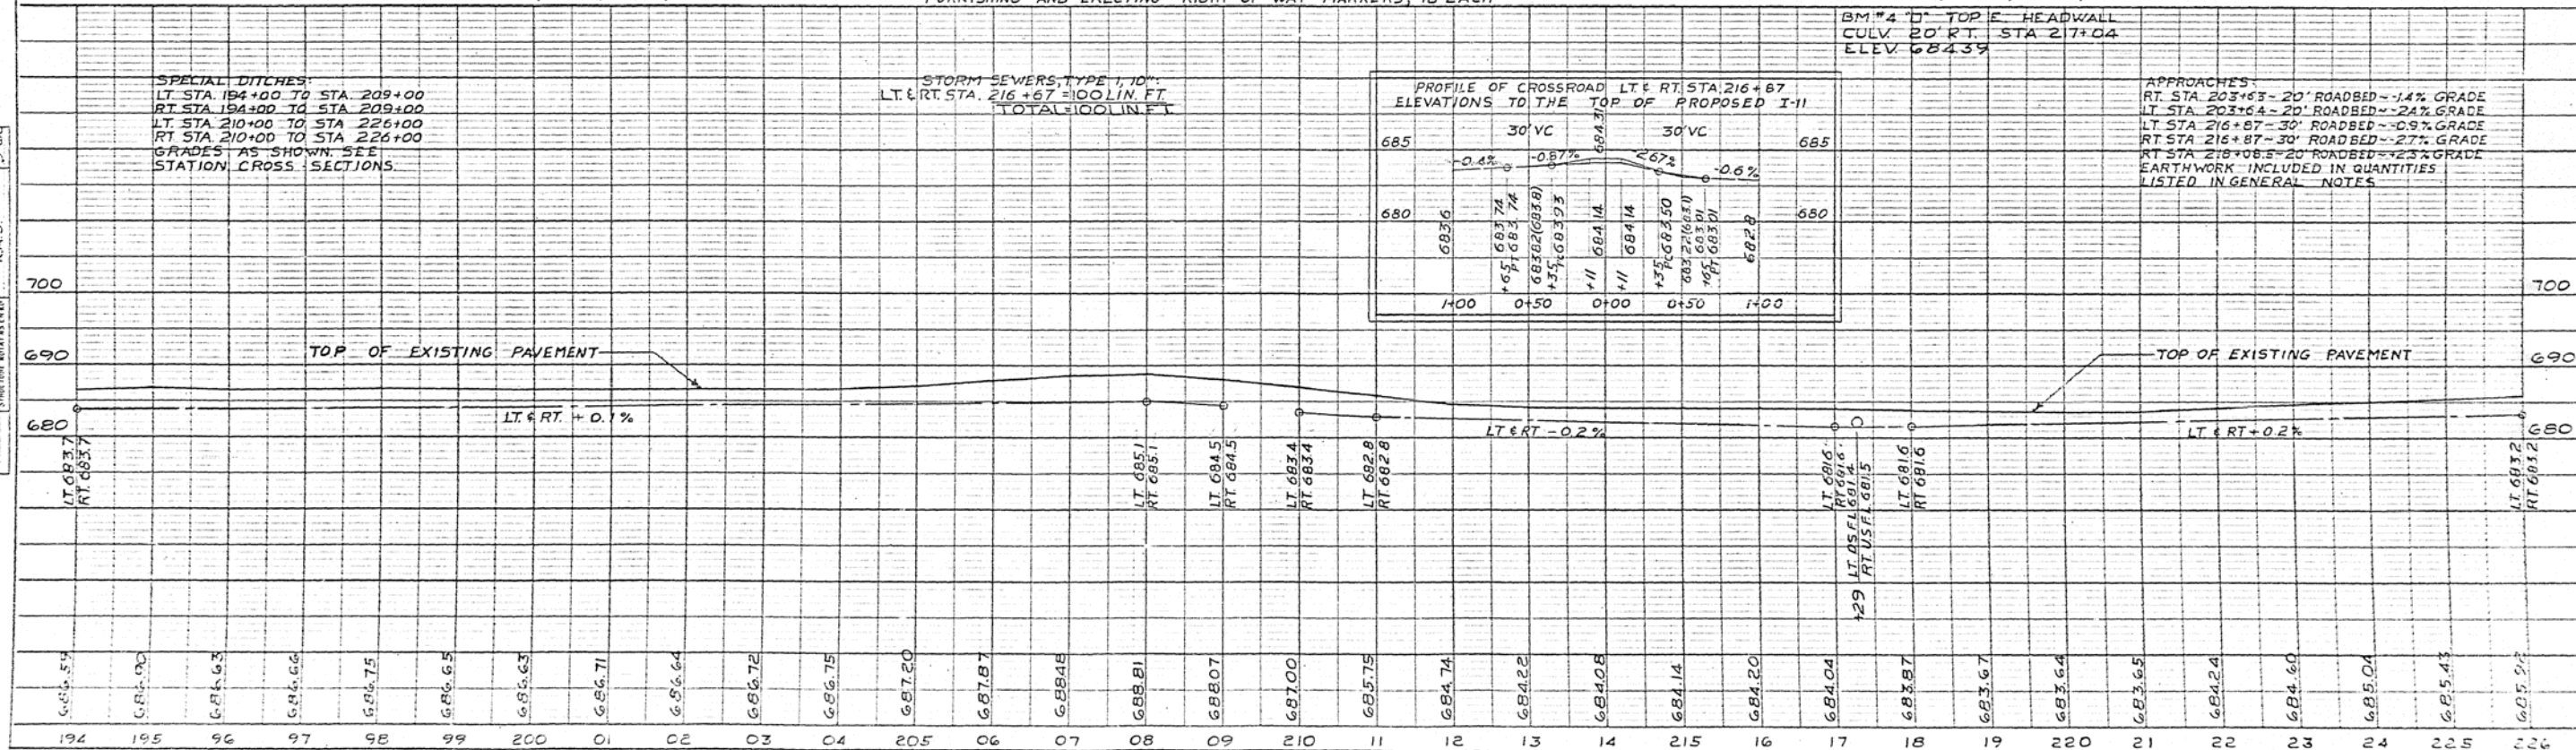



PLAN
DATE 10/1/00
BY J. L. MANECKE
CHECKED J. L. MANECKE
NO. 1000


PROFILE
DATE 10/1/00
BY J. L. MANECKE
CHECKED J. L. MANECKE
NO. 1000

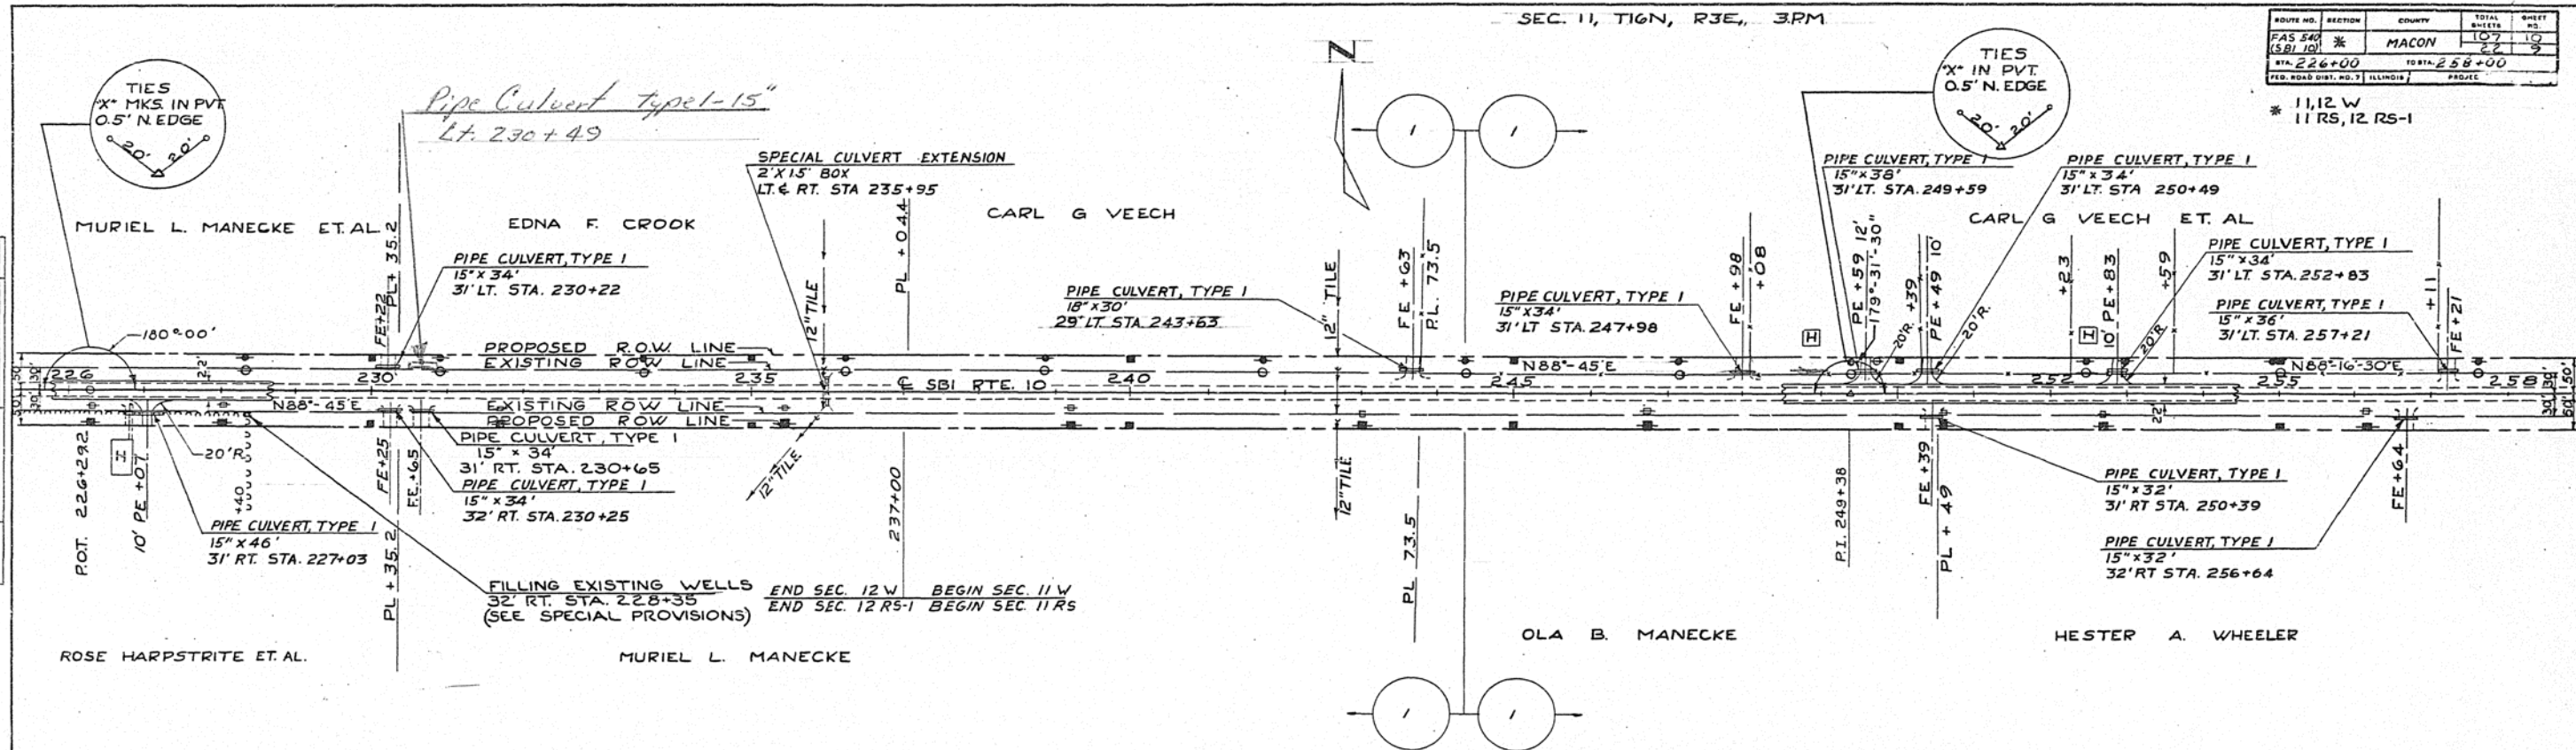

ROUTE NO.	SECTION	COUNTY	TOTAL SHEETS	SHEET NO.
11, 12 W	11 RS, 12 RS-1	MACON	107	10

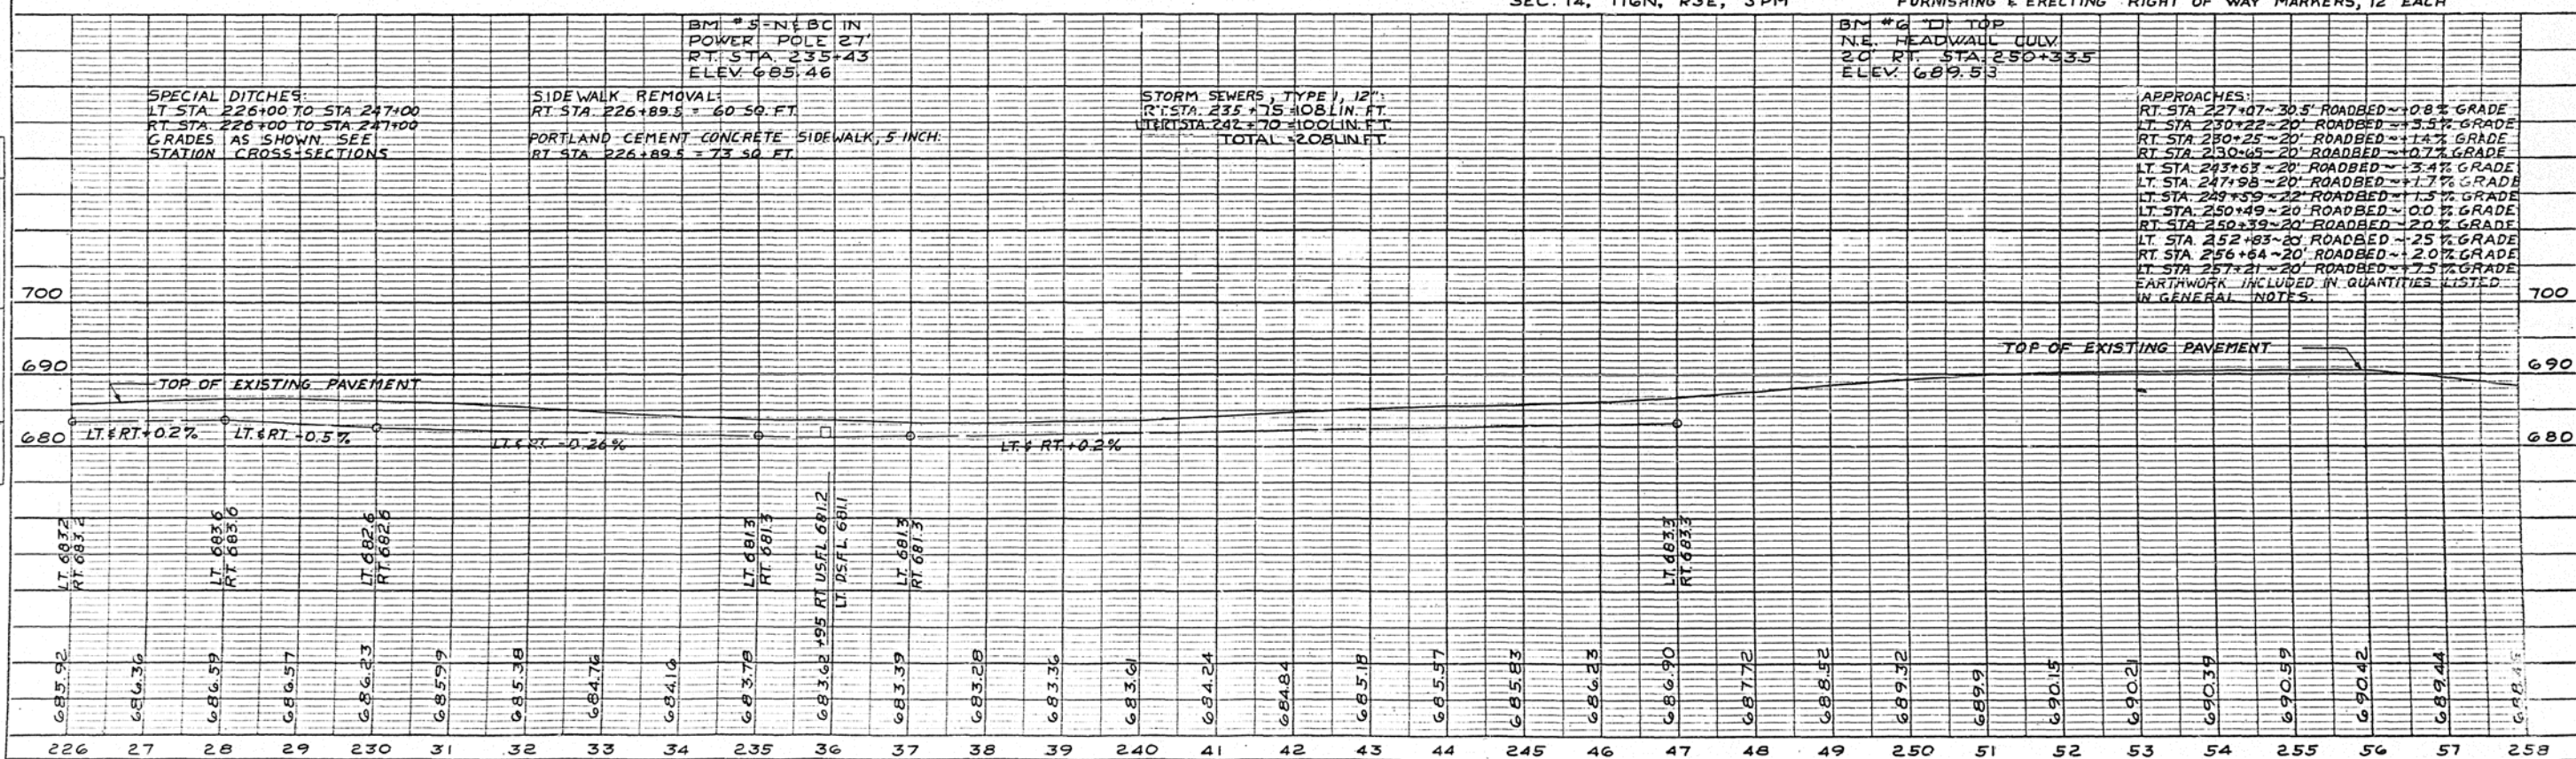

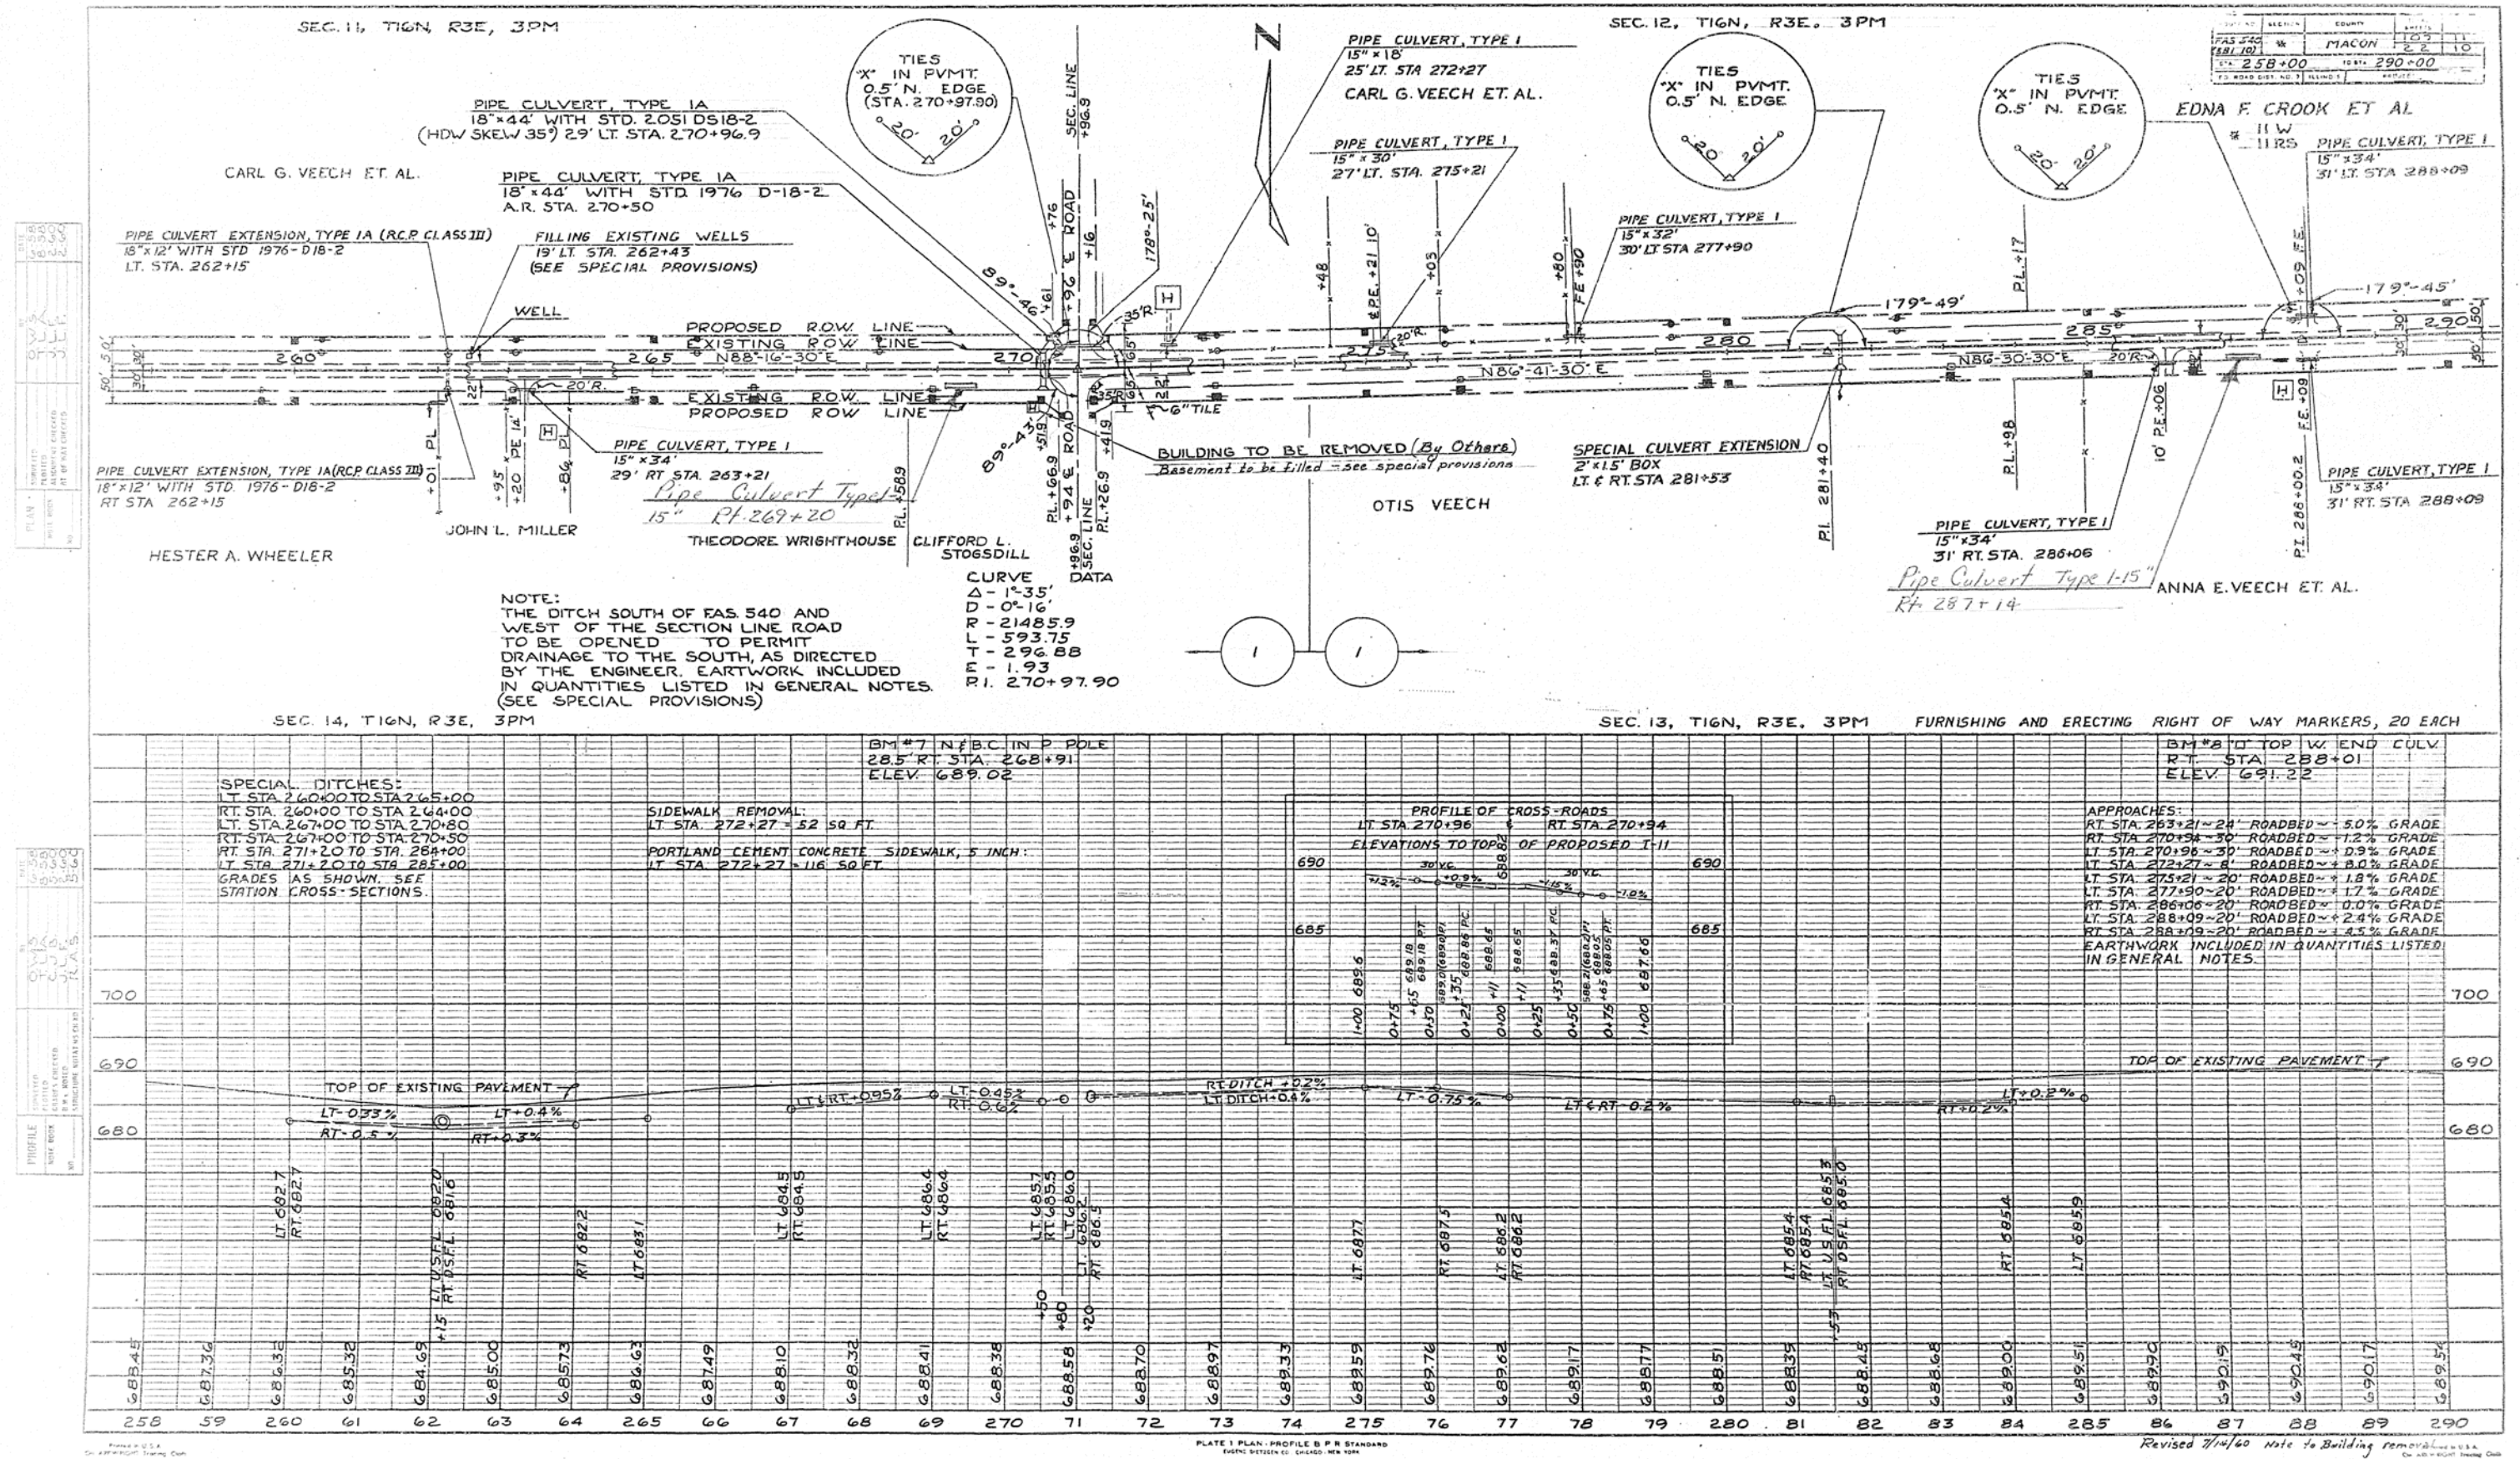

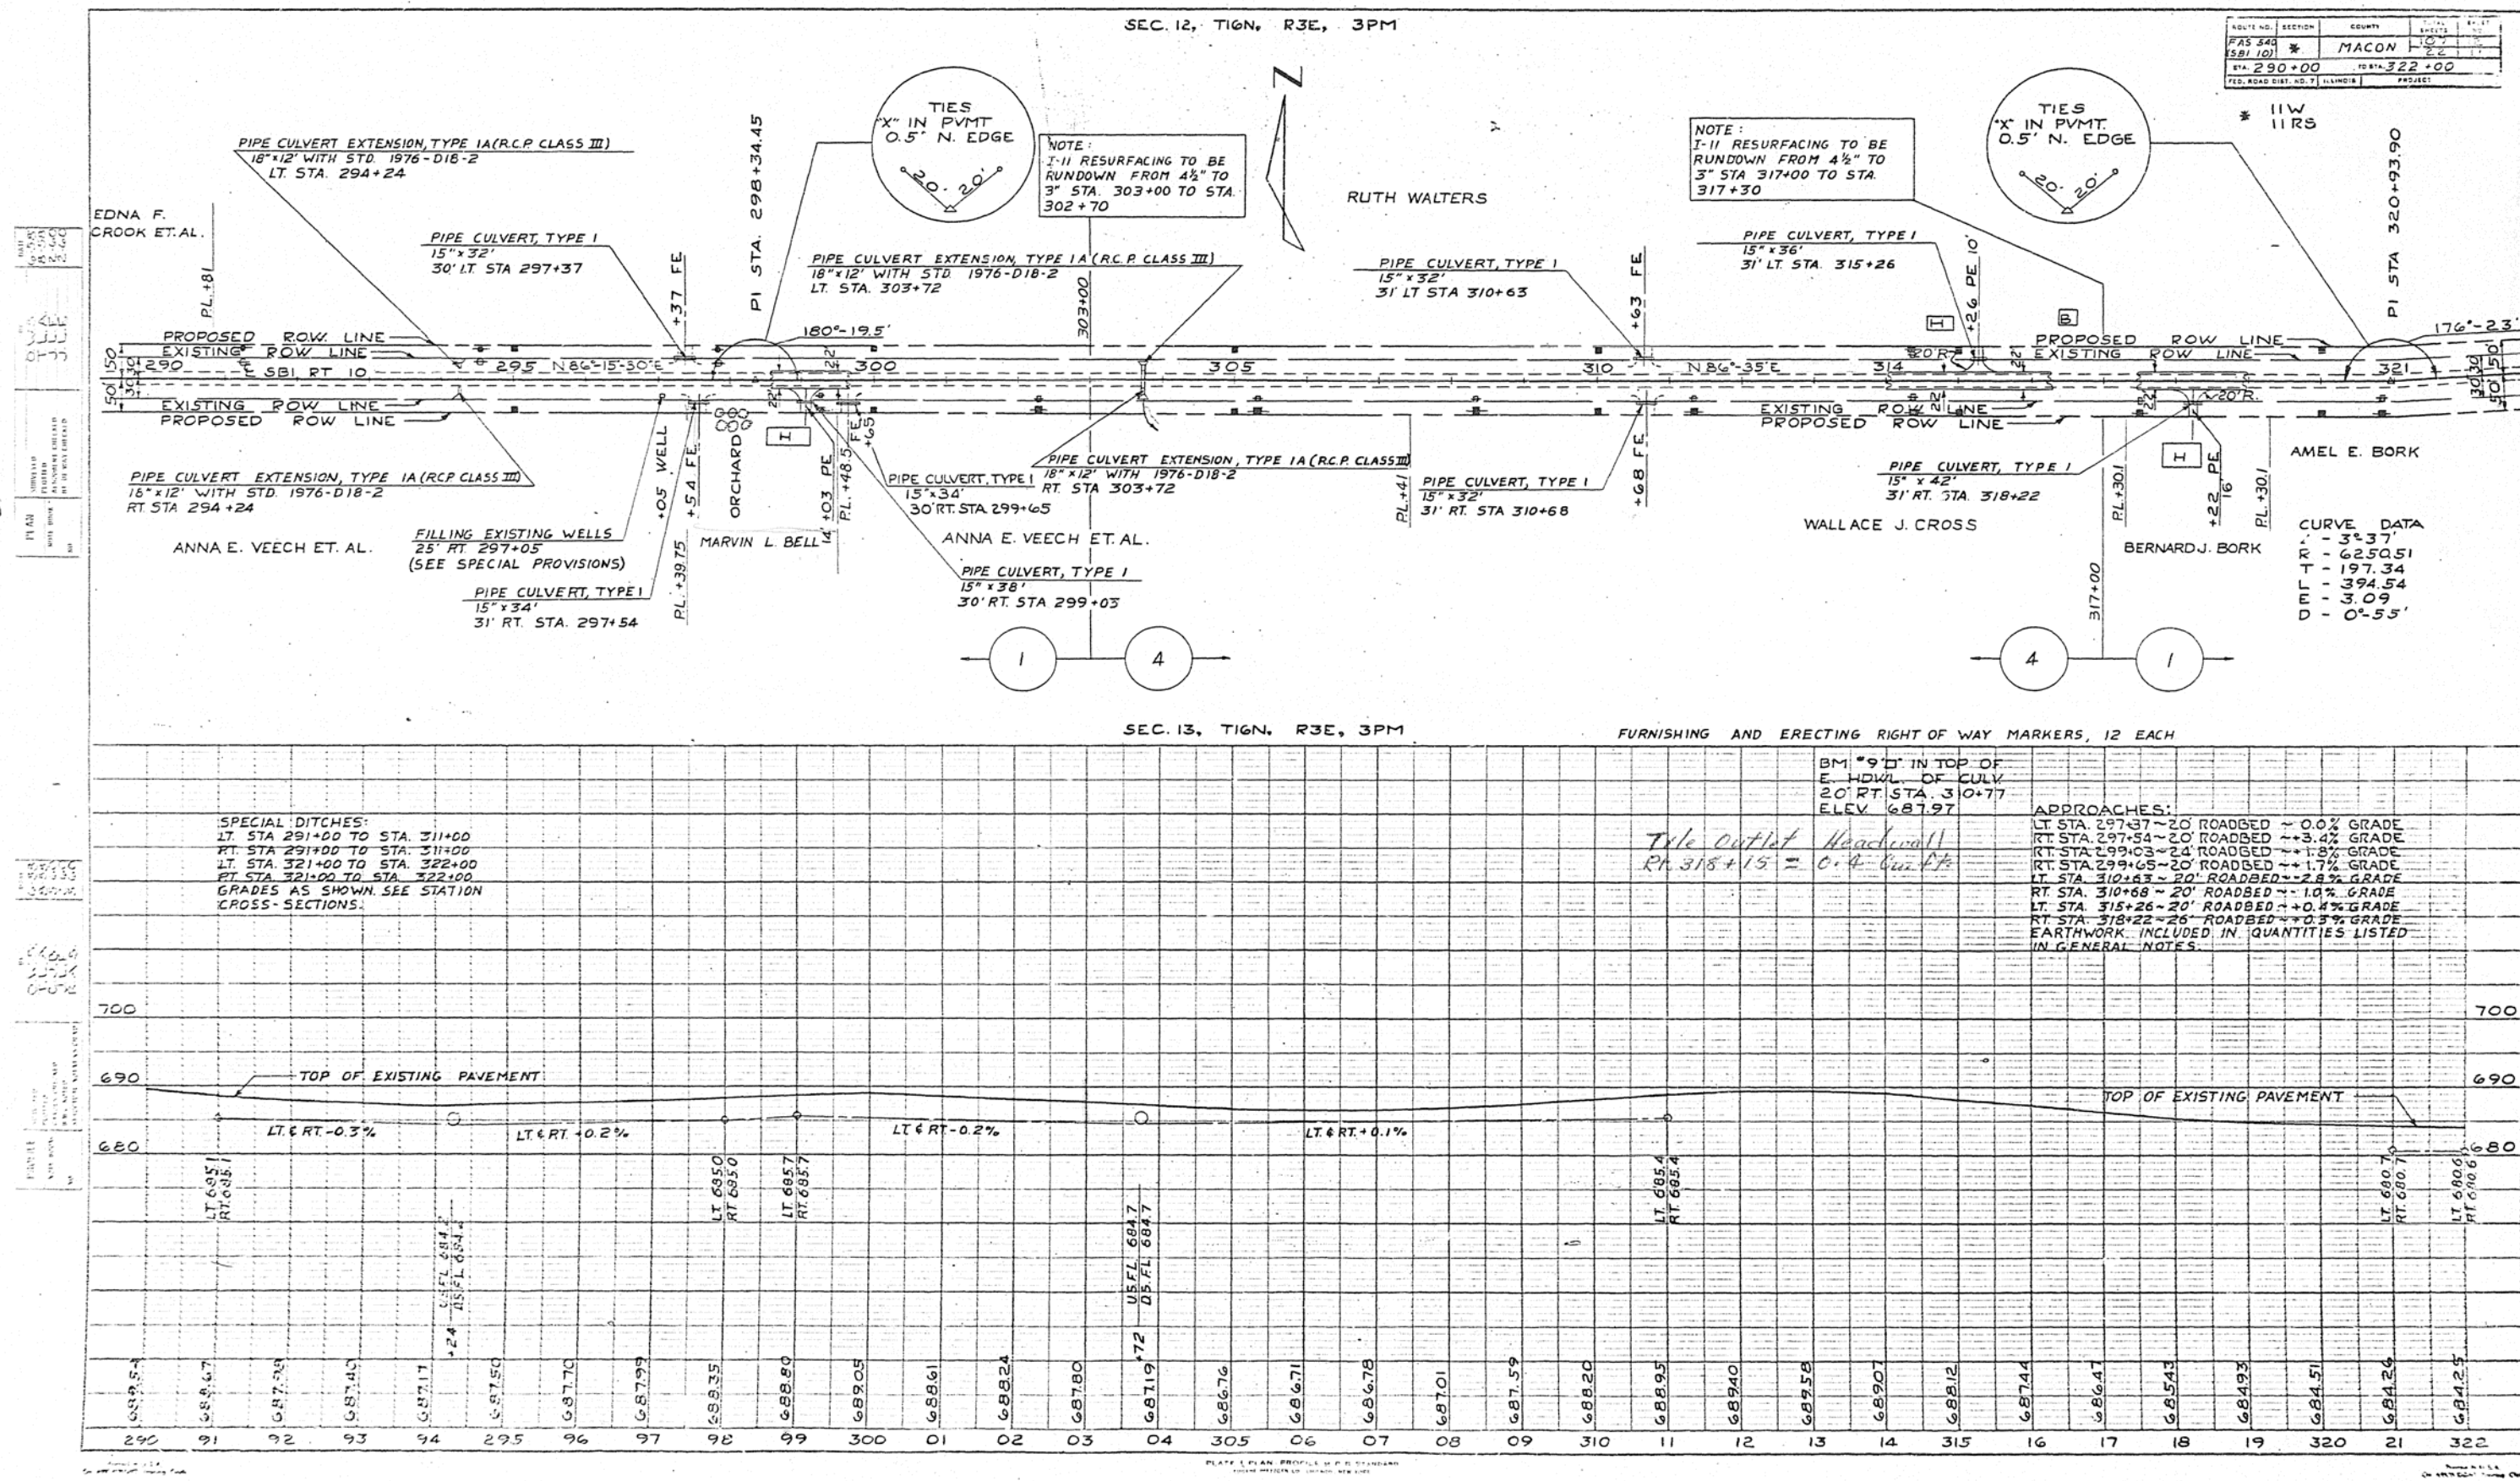

SEC. 12, T. 16N., R. 3E, 3PM.

RUTH WALTERS

FOR DETAIL OF INTERSECTION SEE SHEET NO. 20 (WIDENING SECTION) NO. 19 (RESURFACING SECTION)

AMEL E. BORK

SEC. 13, T. 16N., R. 3E., 3PM.

SEC. 7 T16N R4E 3PM

CHARLES E. REEVES

MICHAEL MARQUARDT

BRIDGE APPROACH SLABS (METHOD II)
STA. 348+78.41 TO STA. 349+13.88
STA. 349+46.13 TO STA. 349+81.60
QUANTITIES FOR APPROACHES:
P.C. BASE COURSE 16 1/2" - 10 1/2" - 16 1/2" = 176 SQ. YDS.
REINFORCEMENT BARS = 10,610 LBS.
124 TRANSVERSE BARS #5 @ 22'-11"
116 LONGITUDINAL BARS #8 @ 17'-4"
64 LONGITUDINAL BARS #8 @ 13'-4"
NOTE: SAME AS STANDARD FOR BRIDGE
APPROACH SLABS, BASE COURSE, EXCEPT
LENGTH OF APPROACH SLABS ARE 16'-0"
INCLUDED IN SEC. 10W-1 (11, 12) W
2 CAPS - 3.2 CU. YDS. CLASS "X" CONC.
1140 LBS. REIN. BARS

SPECIAL BRIDGE DESIGN
R.C. DECK GIRDER ON SOLID CONCRETE ABUTMENTS
1 SPAN @ 30'-11 1/2" ALONG E., SKEWED 20°
41' ROADWAY
STA. 349+30
INCLUDED IN SEC. 11BR

ROUTE NO.	SECTION	COUNTY	TOTAL SHEETS	SHEET NO.
MASS 40	MASS 40	MASS 40	107	13
MASS 40	MASS 40	MASS 40	107	13
MASS 40	MASS 40	MASS 40	107	13

BERTHA M. MAYBERRY EST.

THELMA CLARKSON ET. AL.

THELMA CLARKSON ET. AL.

GEORGE WILLARD LEONARD

NOTE:
BRIDGE APPROACH SLABS TO BE
RESURFACED WITH 3" BITUMINOUS
RESURFACING (165 LBS. PER SQ. YD.
BITUMINOUS CONCRETE SURFACE COURSE
SUBCLASS I-11 AND 165 LBS. PER SQ. YD.
BITUMINOUS CONCRETE BINDER COURSE)

FURNISHING AND ERECTING RIGHT OF WAY MARKERS, 20 EACH


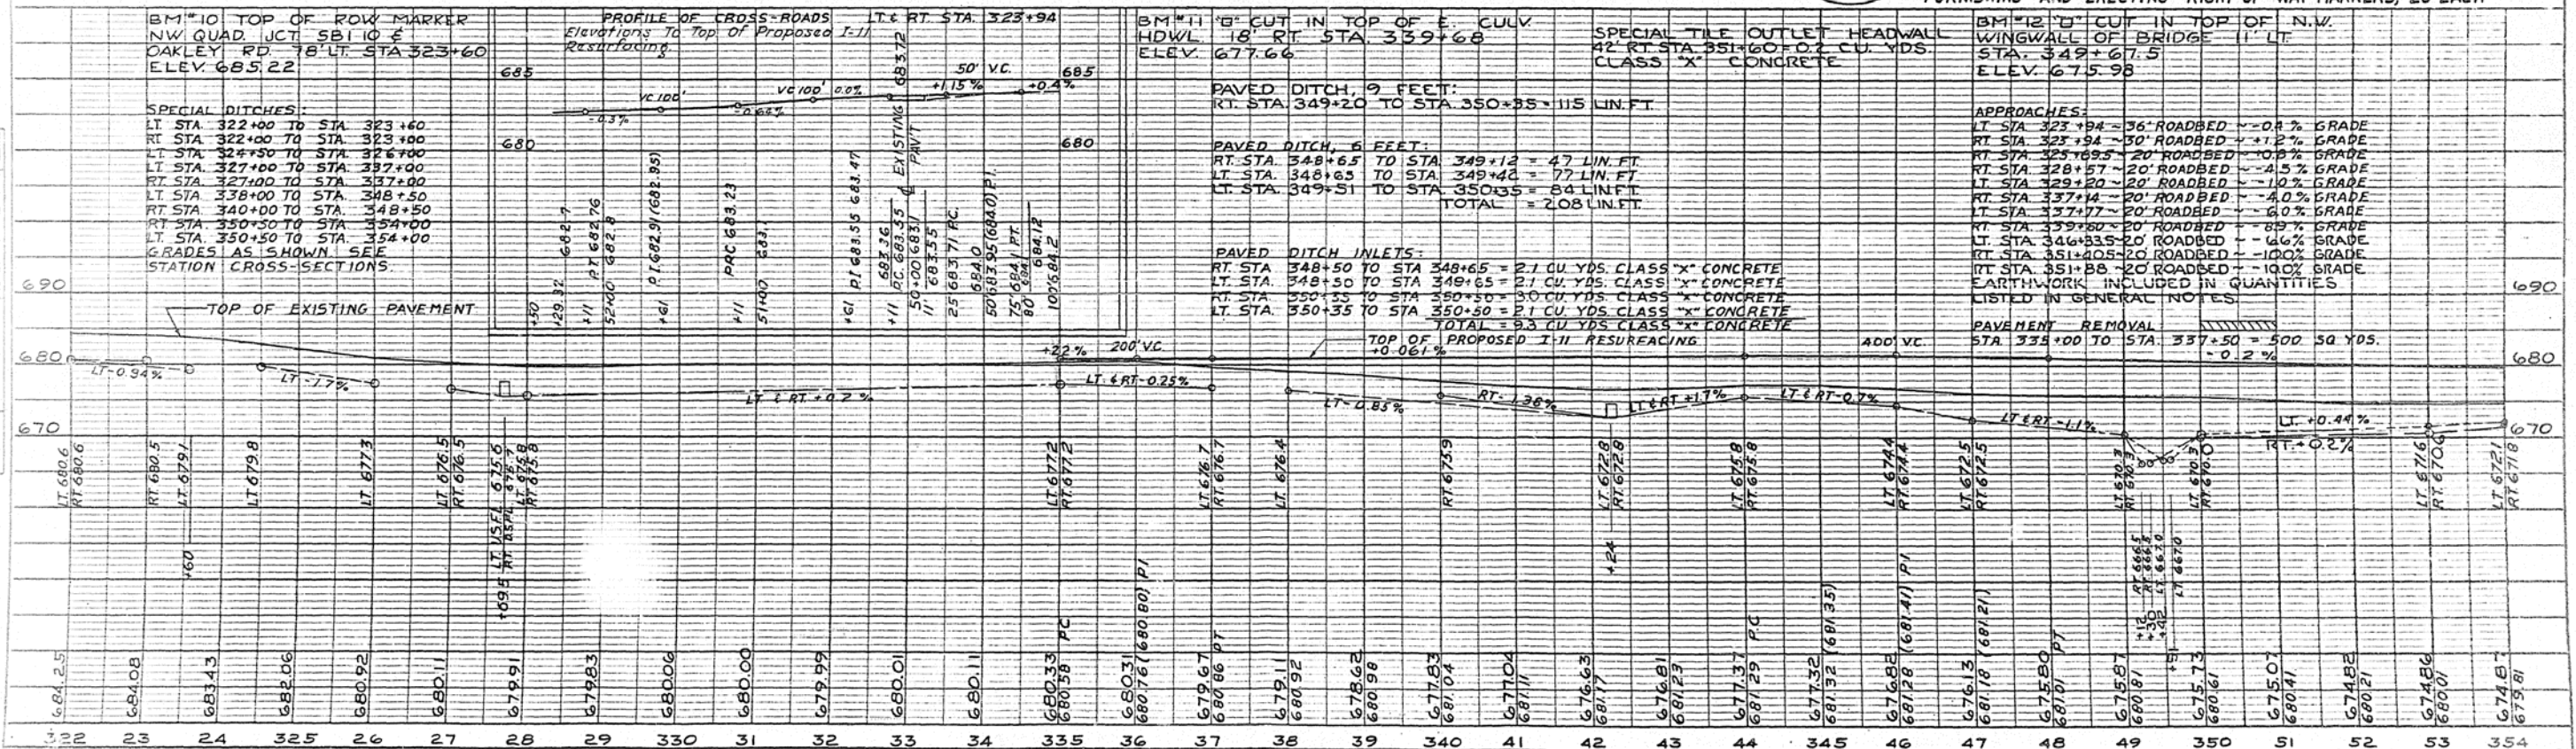




PLATE 1 PLAN: PROFILE B P R STANDARD

Revised 7/14/60 Channel Change

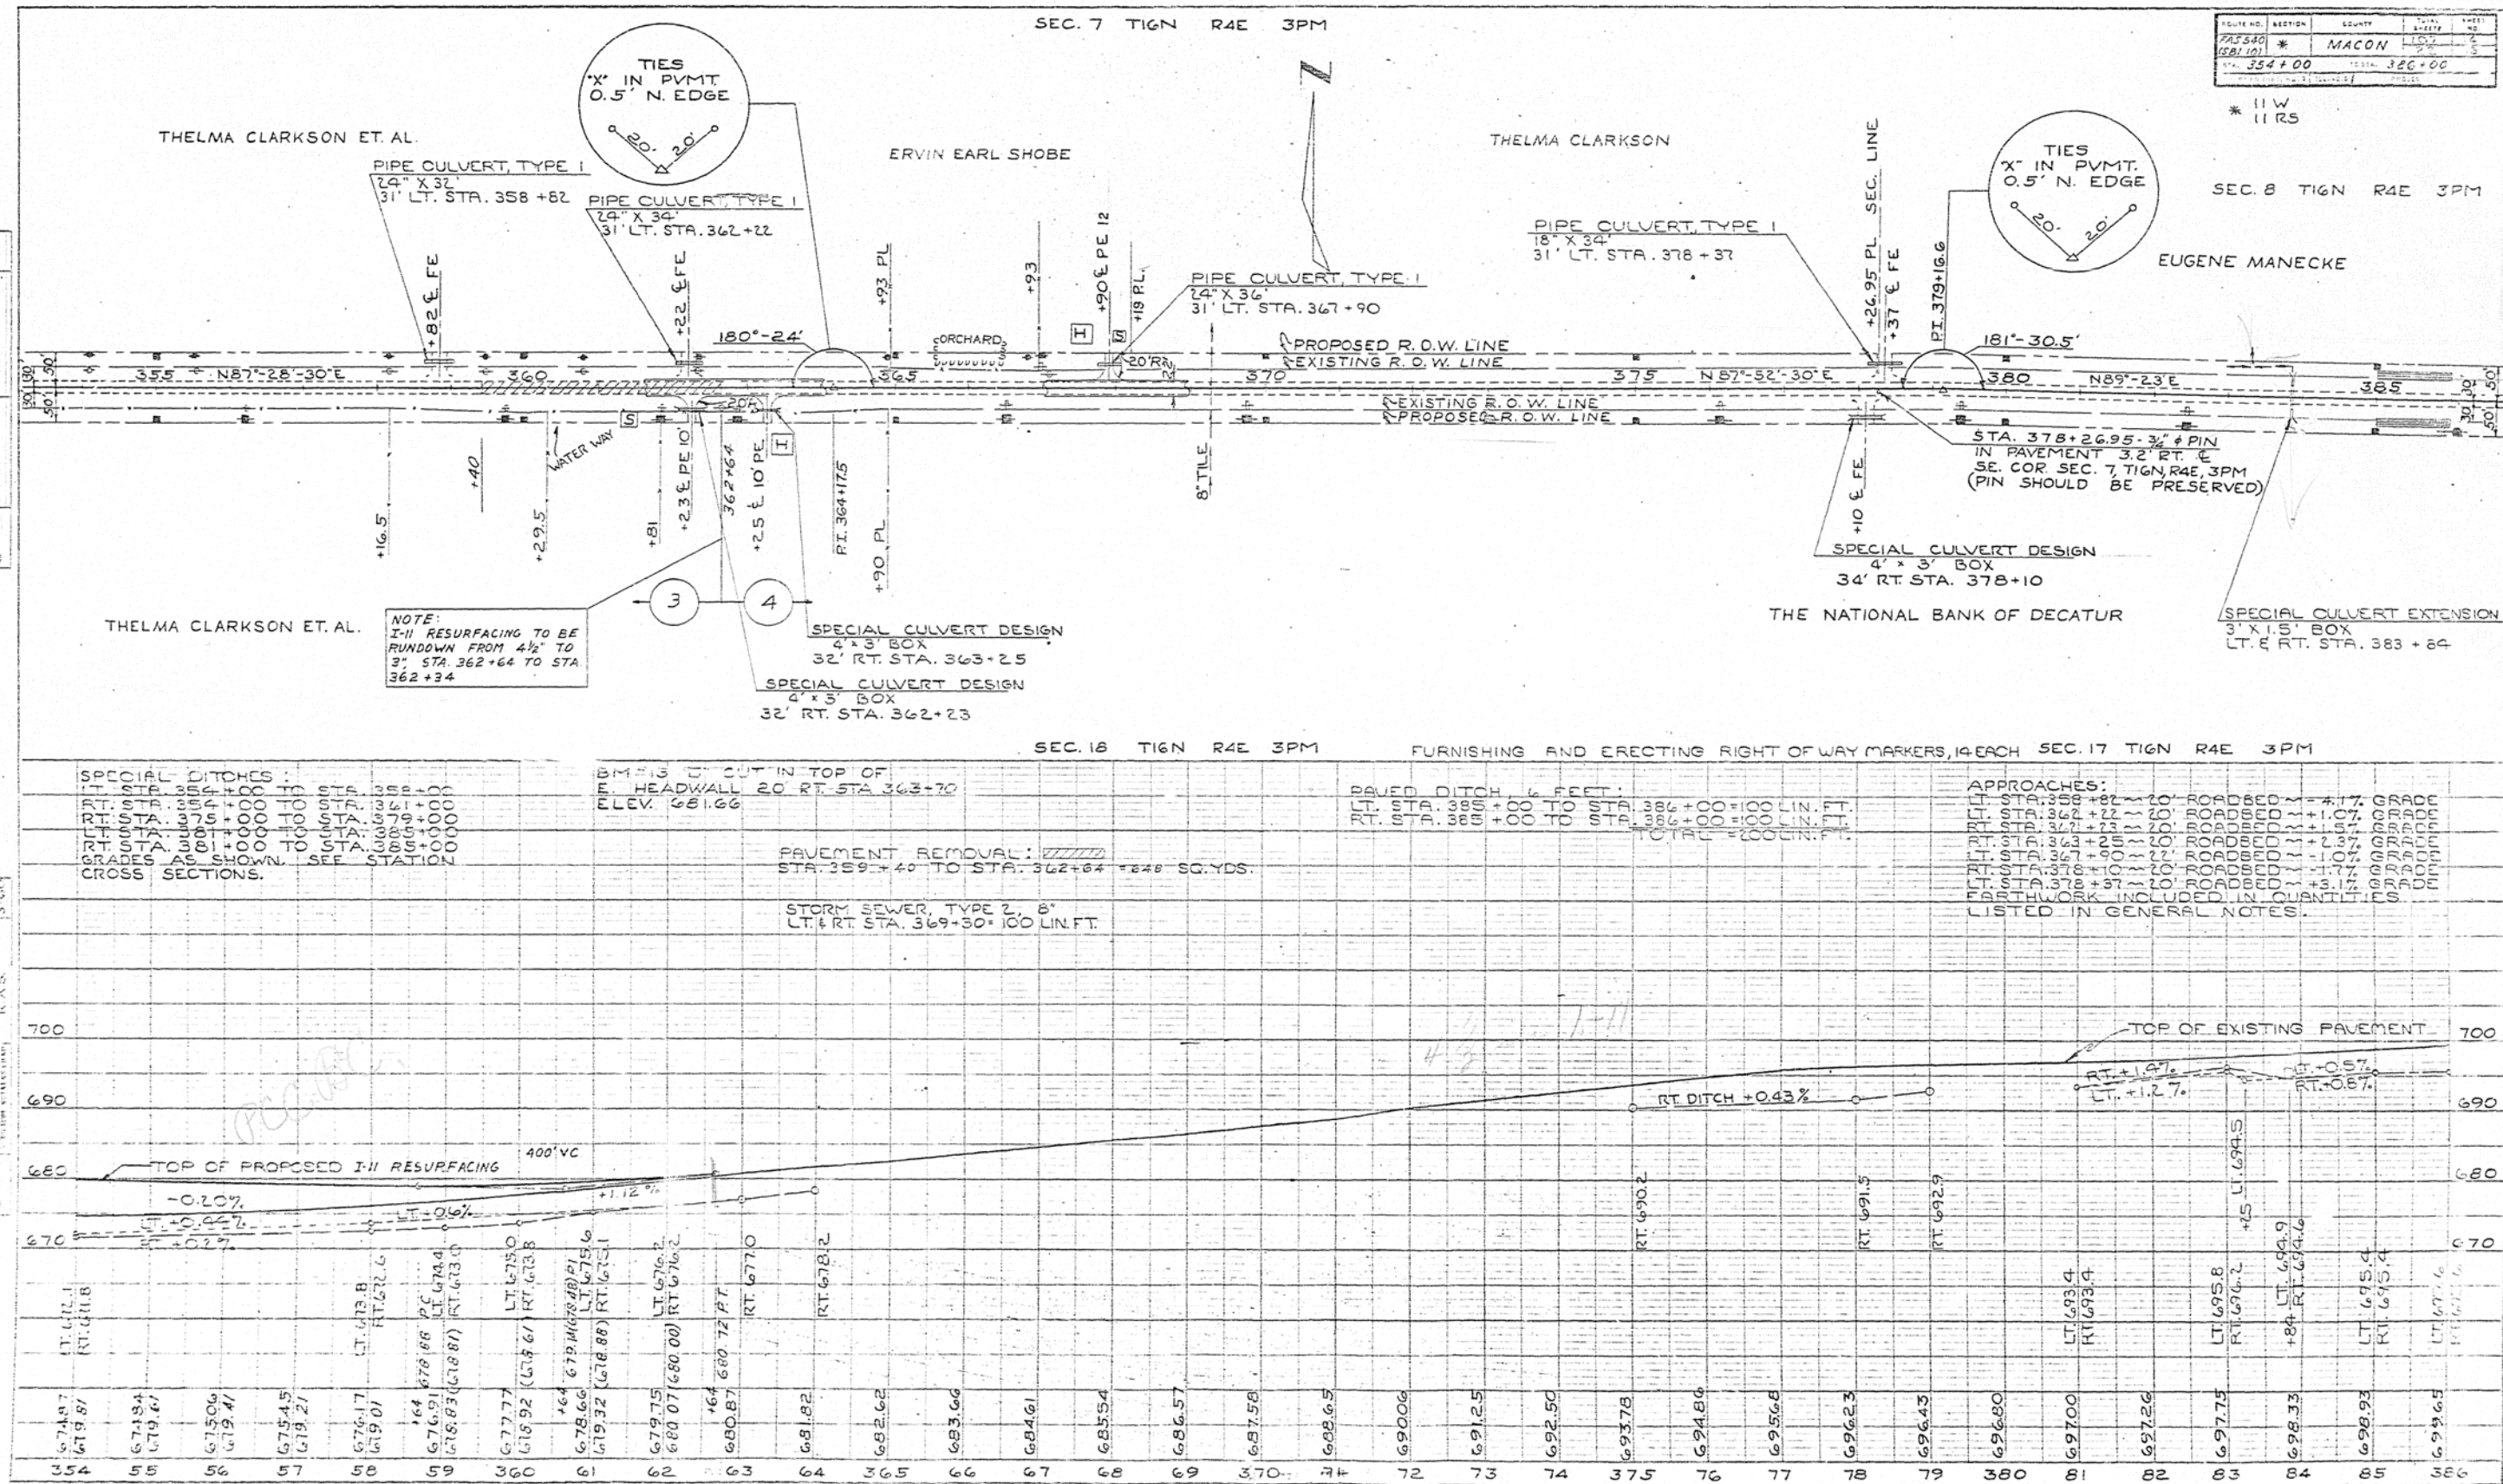



PLAN	NOTES	REVISIONS
NO.	NO.	NO.
1	1	1
2	2	2
3	3	3
4	4	4
5	5	5
6	6	6
7	7	7
8	8	8
9	9	9
10	10	10

PROFILE	NOTES	REVISIONS
NO.	NO.	NO.
1	1	1
2	2	2
3	3	3
4	4	4
5	5	5
6	6	6
7	7	7
8	8	8
9	9	9
10	10	10

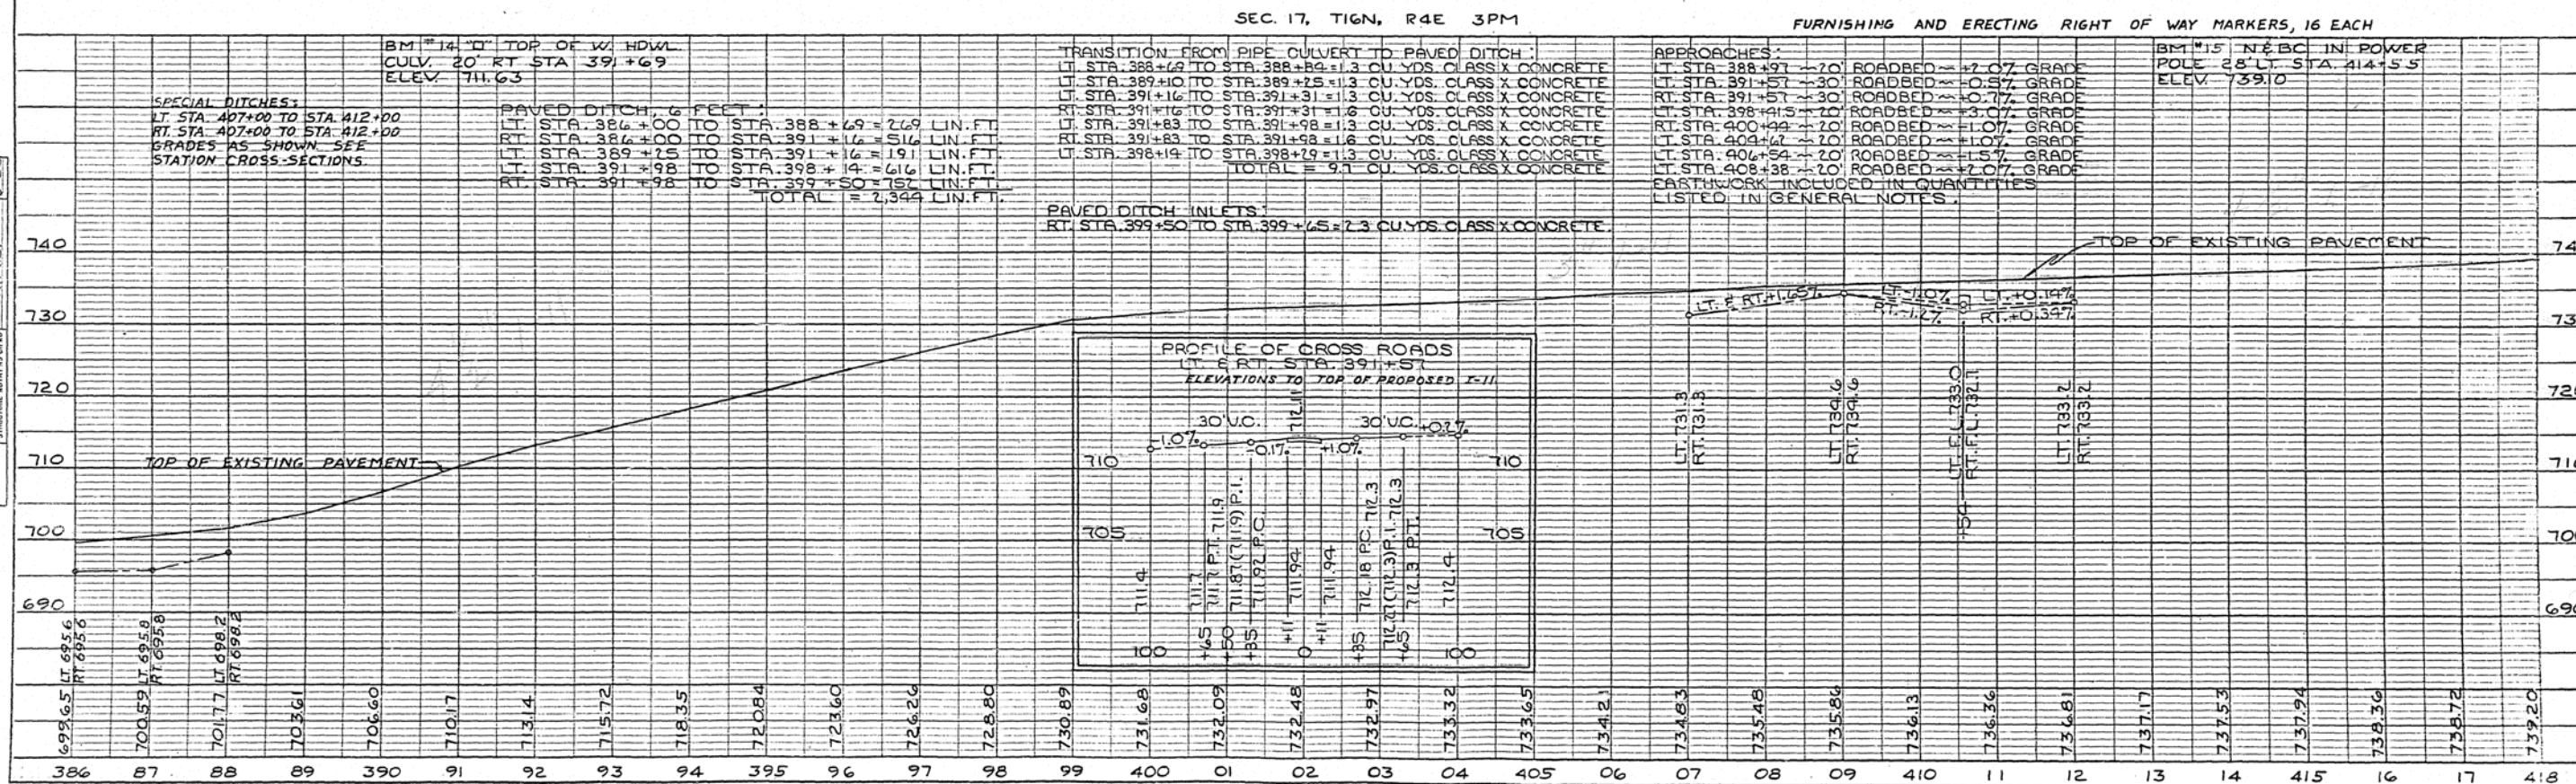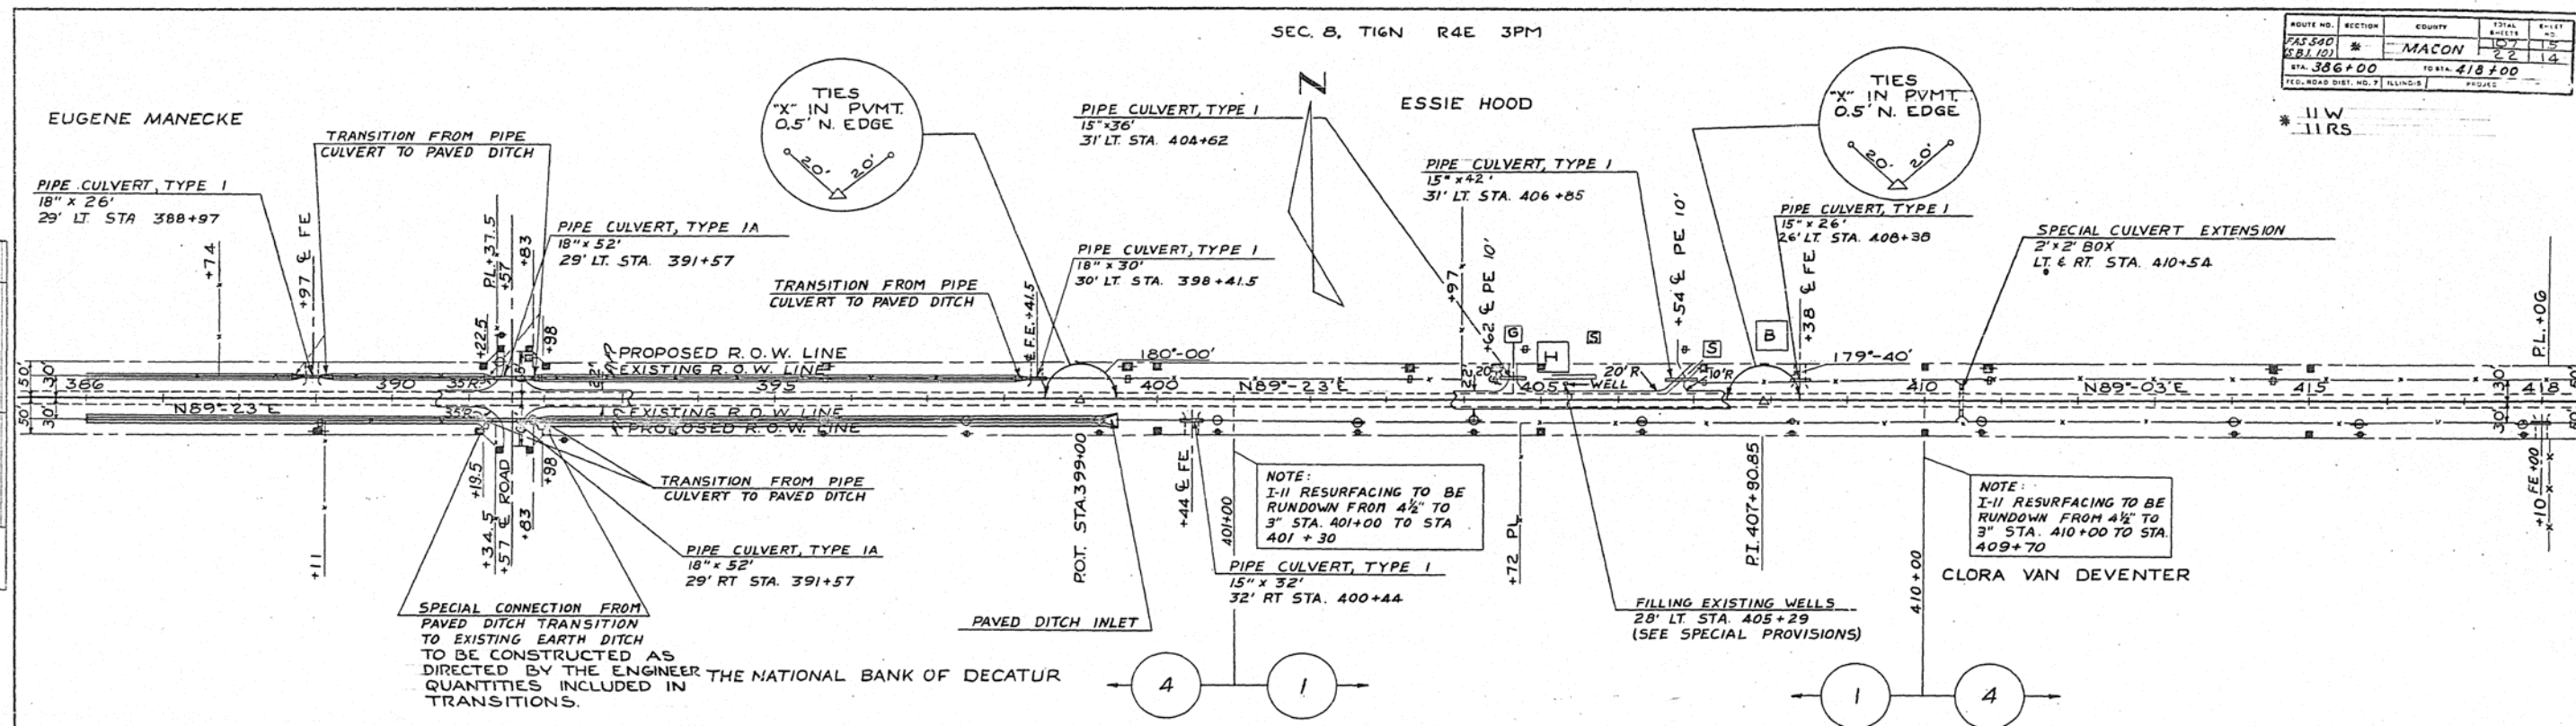


MINERVA BEERY

JESSE L. BERRY * 11W
11RS

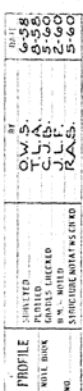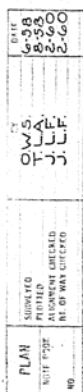

SEC. 16 T16N R4E 3PM


APPROACHES:			
RT STA	418+00	20	ROADBED ~ -1.0% GRADE
RT STA	421+47	5	ROADBED ~ -1.8% GRADE
RT STA	422+37	24	ROADBED ~ +1.3% GRADE
RT STA	424+46	70	ROADBED ~ -1.5% GRADE
LT STA	431+21	30	ROADBED ~ +2.2% GRADE
RT STA	431+74	30	ROADBED ~ +2.0% GRADE
RT STA	437+54	20	ROADBED ~ -1.4% GRADE
RT STA	437+88	20	ROADBED ~ -1.0% GRADE
LT STA	444+34	70	ROADBED ~ -2.5% GRADE
EARTHWORK INCLUDED IN QUANTITIES			
LISTED IN GENERAL NOTES			

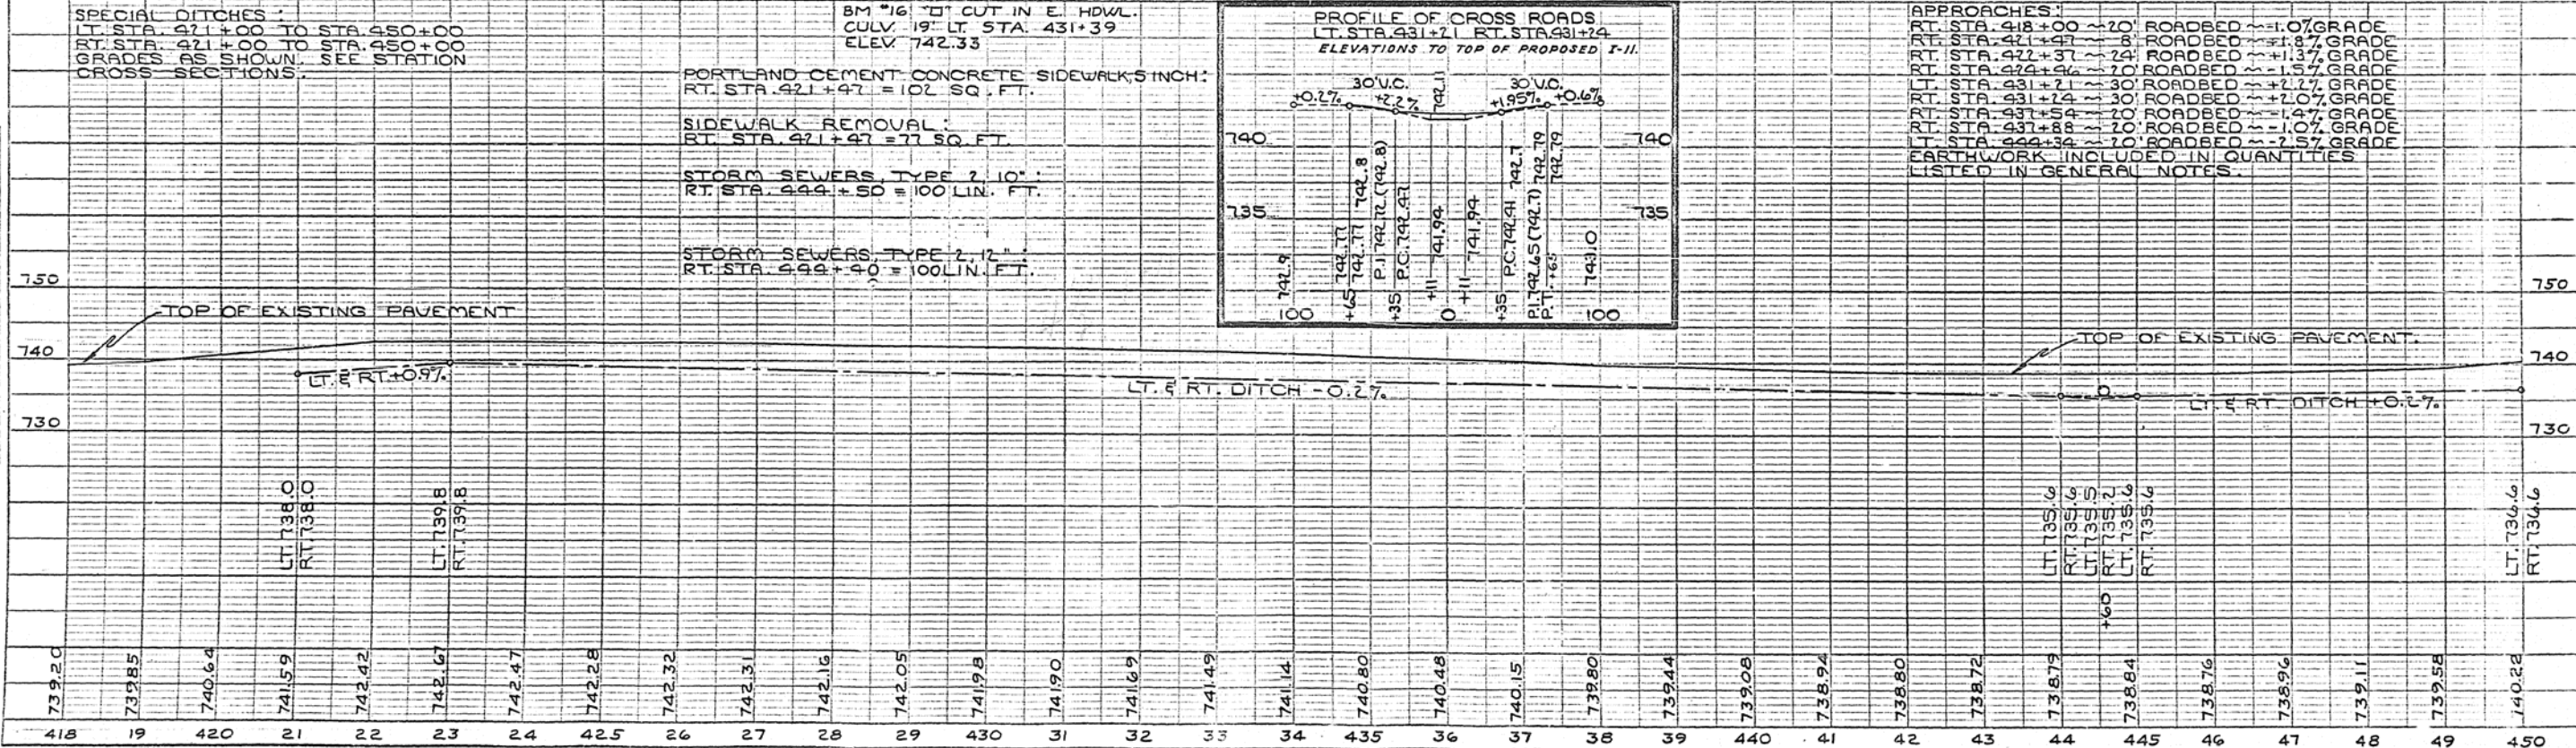

SEC. 9 T16N R4E 3PM


ROUTE NO.	SECTION	COUNTY	TOTAL SHEETS	SHEET NO.
FA5540 (SBL10)	*	MACON	107	17
STA. 450+00			22	16
TO STA. 482+00				




* 10W-1, 11W
10RS-1, 11RS

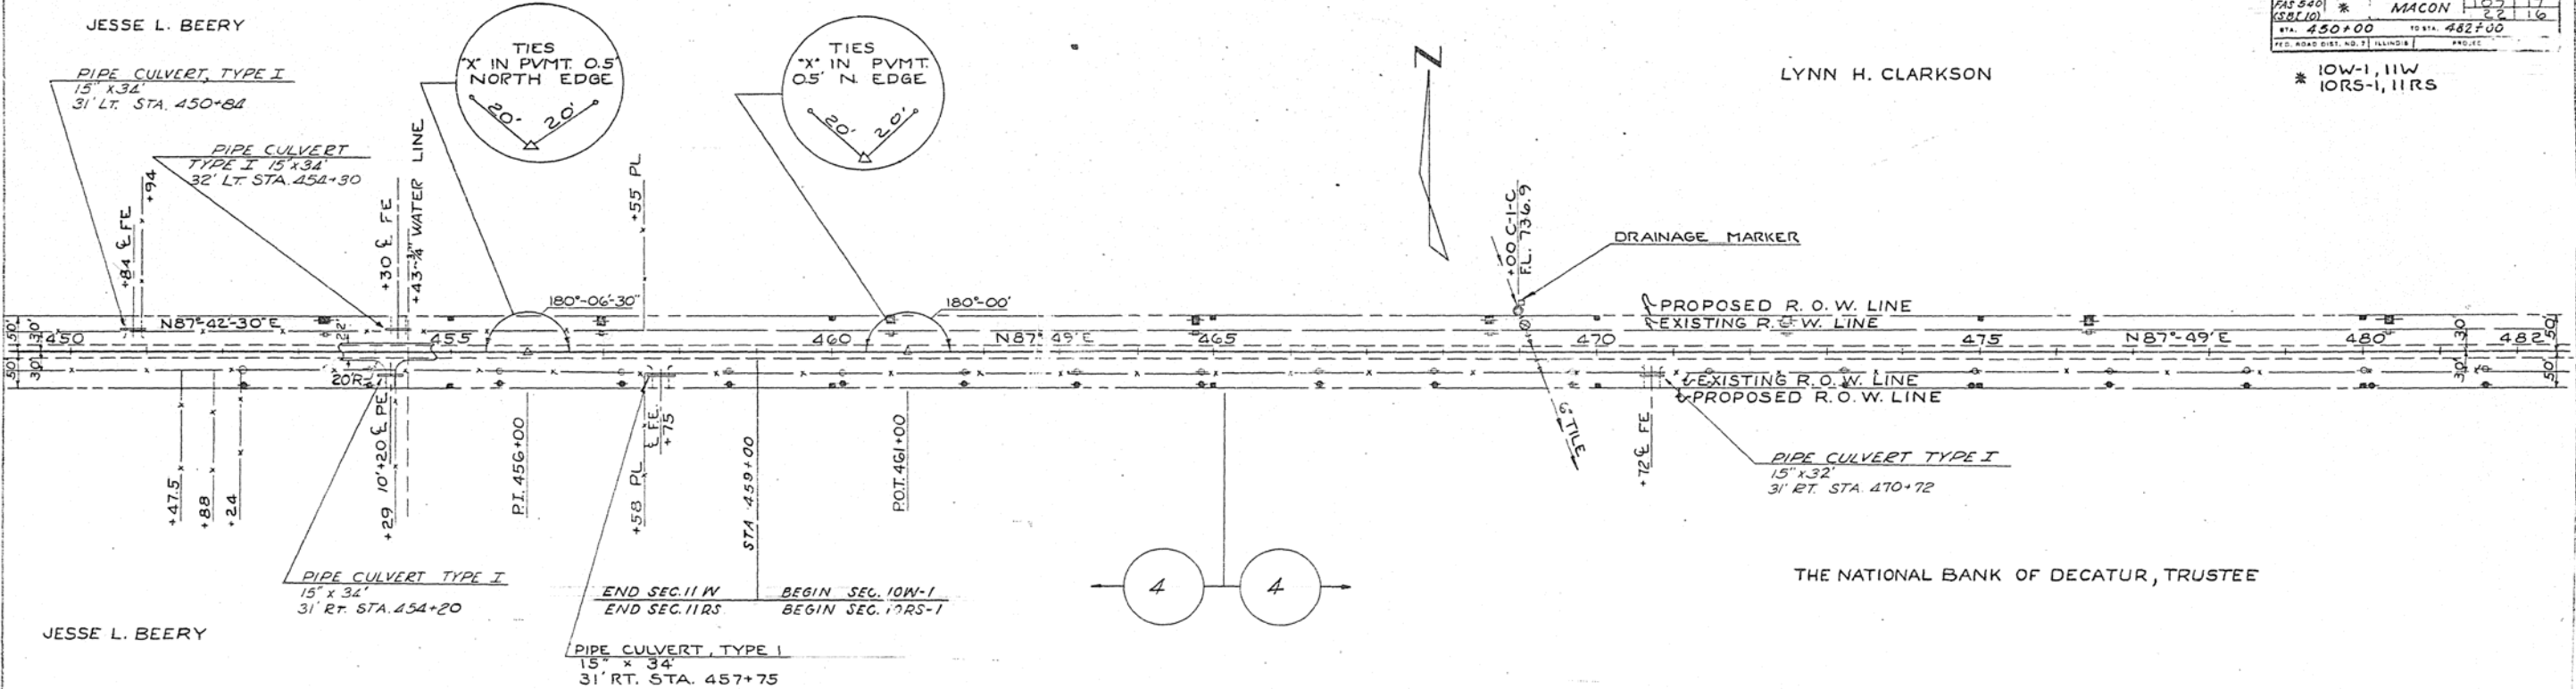

SEC. 16 T16N R4E 3PM

FURNISHING AND ERECTING RIGHT OF WAY MARKERS, 12 EACH

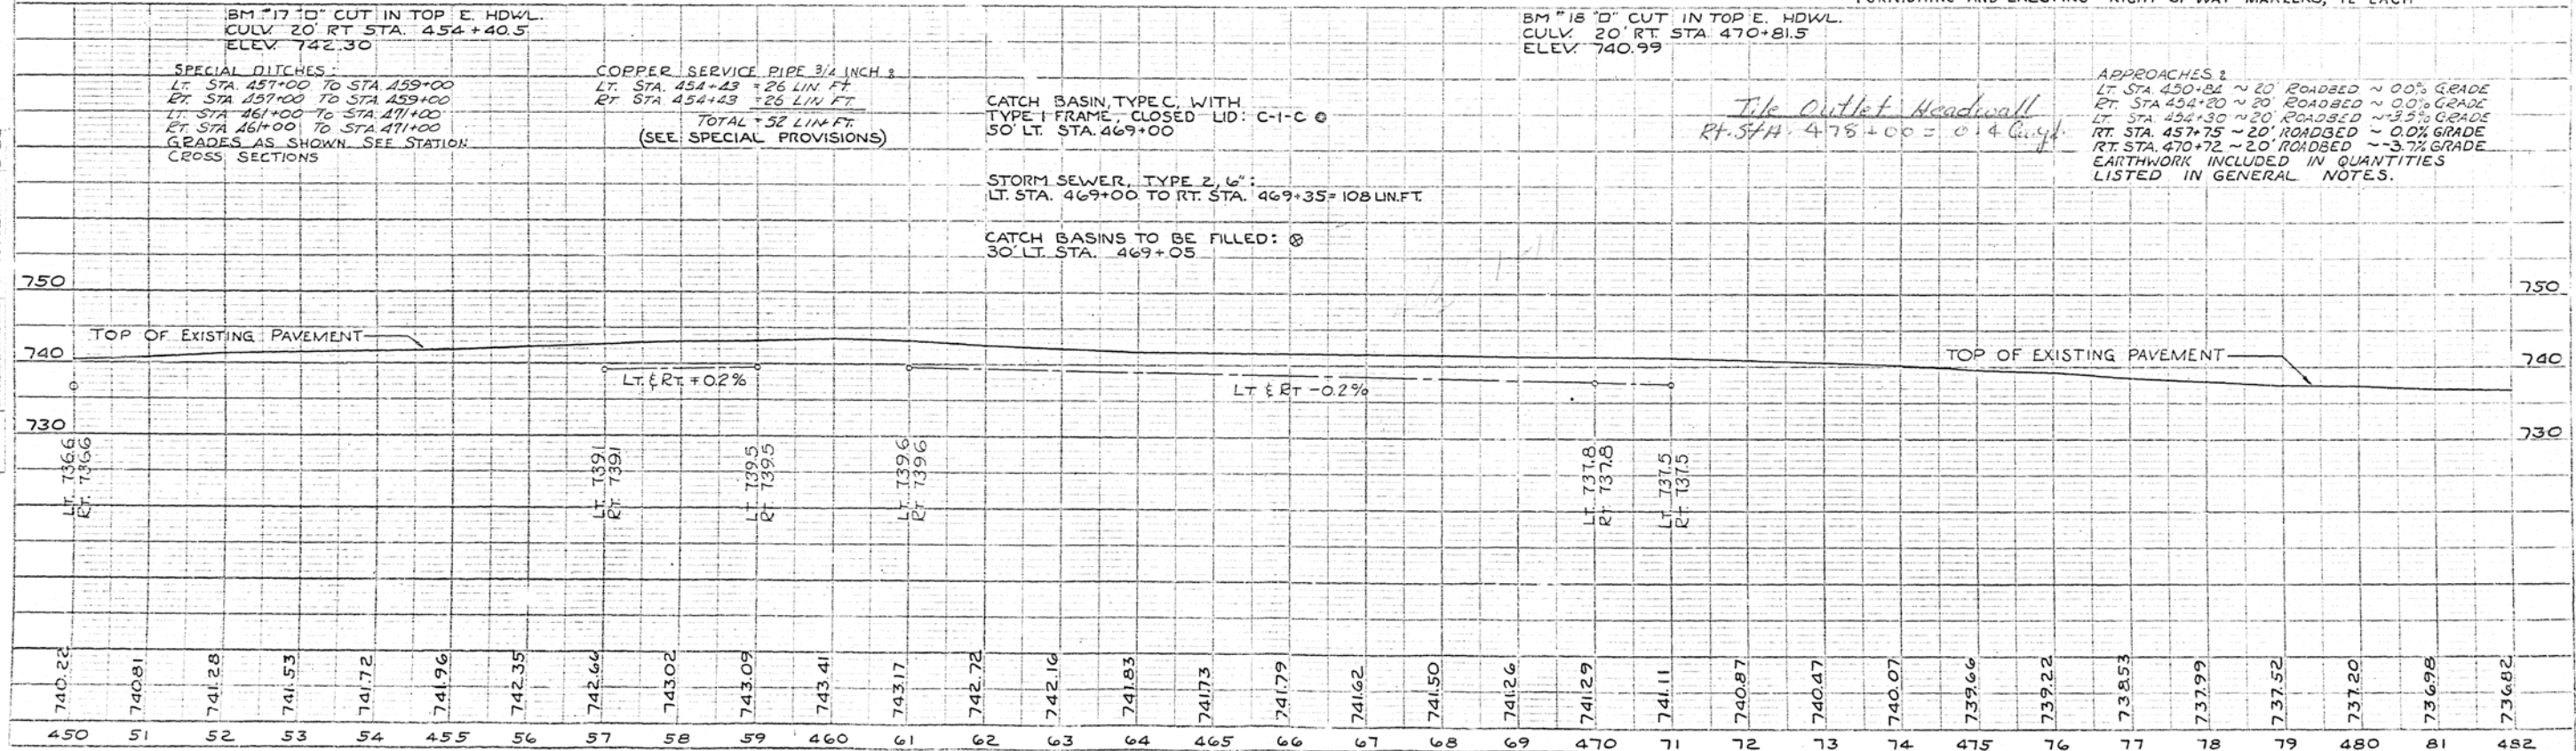

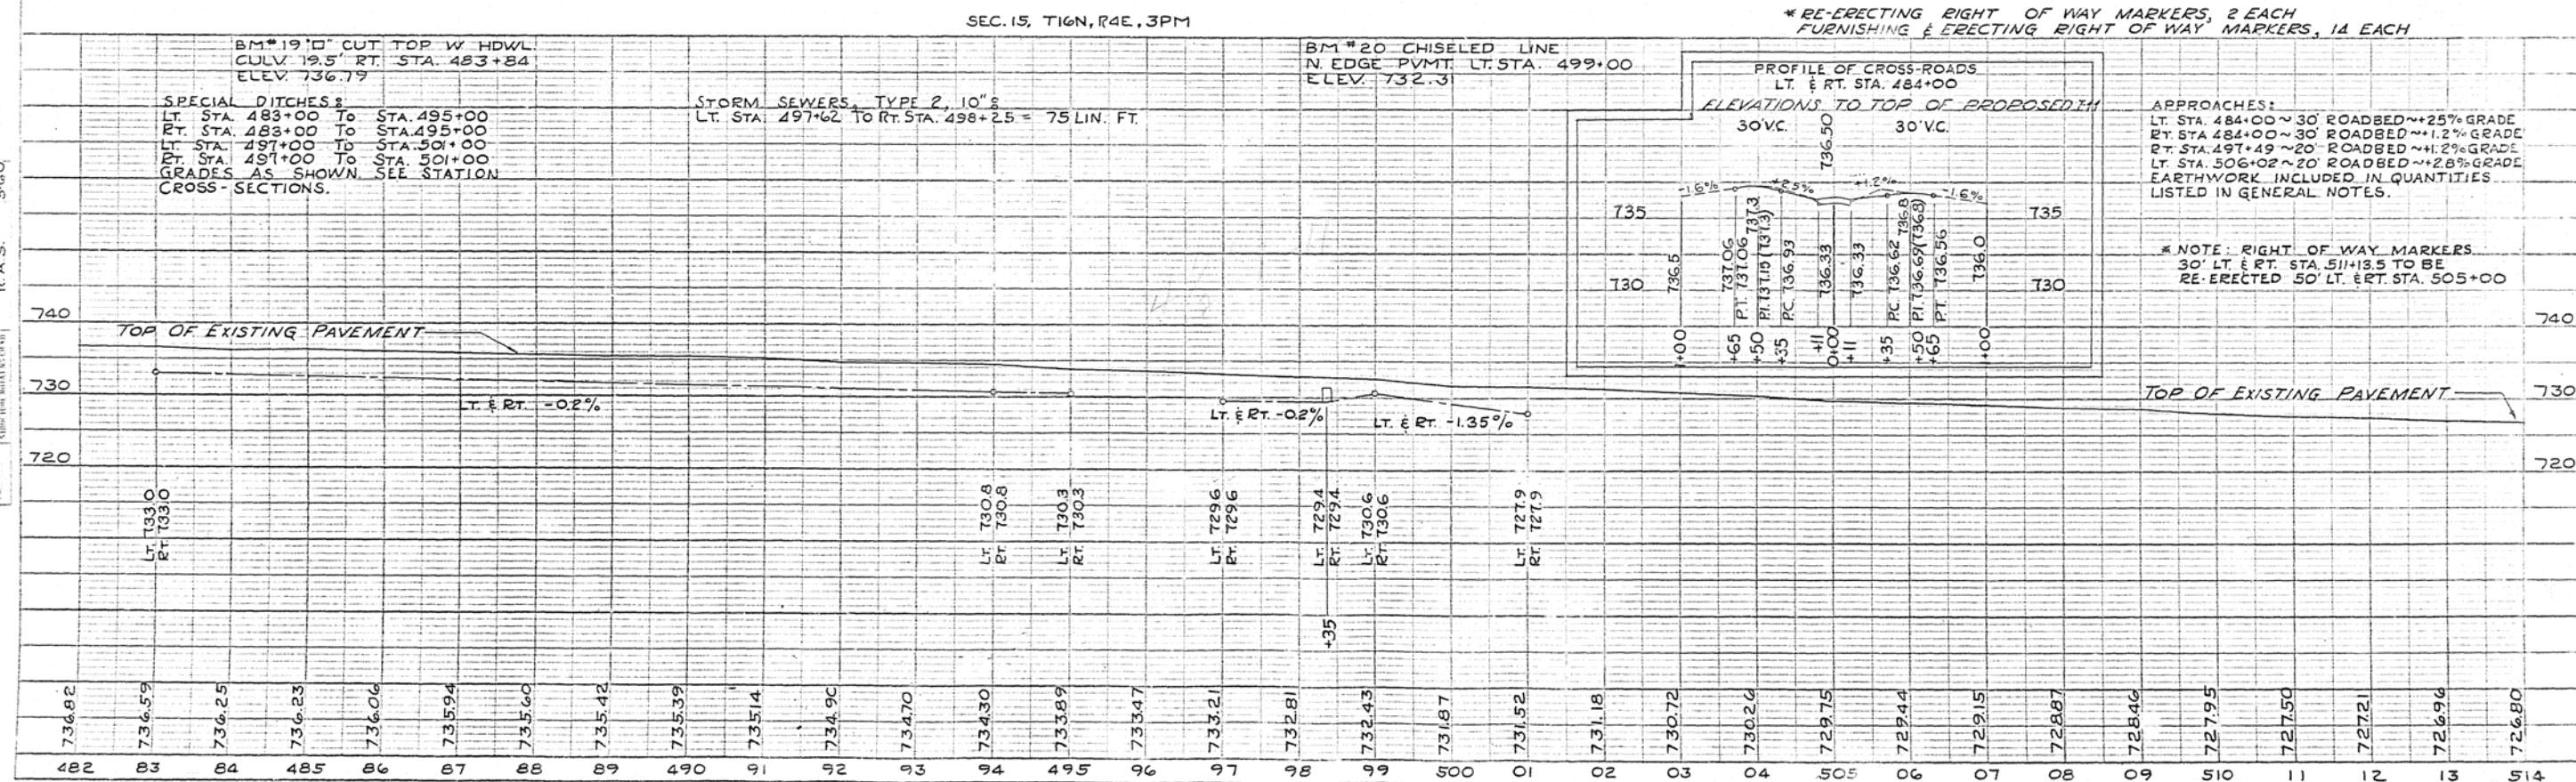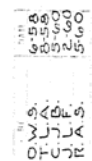
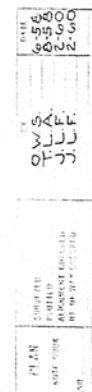


DETAIL OF PROPOSED INTERSECTION FOR S.A. 25 (OAKLEY ROAD) CONNECTION WITH FAS 540
SCALE 1"=20'

ROUTE NO.	SECTION	COUNTY	SHEET NO.	TOTAL SHEETS
FA 540	15.8.1.10	MACON	107	20
STA. 323 + 94			TO STA.	
PROJ. ROAD DIST. NO. 7 ILLINOIS			PROJECT	

11 W
11 RS

FOR PROFILE OF S.A. 25
INTERSECTION SEE SHEET
NO. 13 (WIDENING SECTION)
NO. 12 (RESURFACING SECTION)

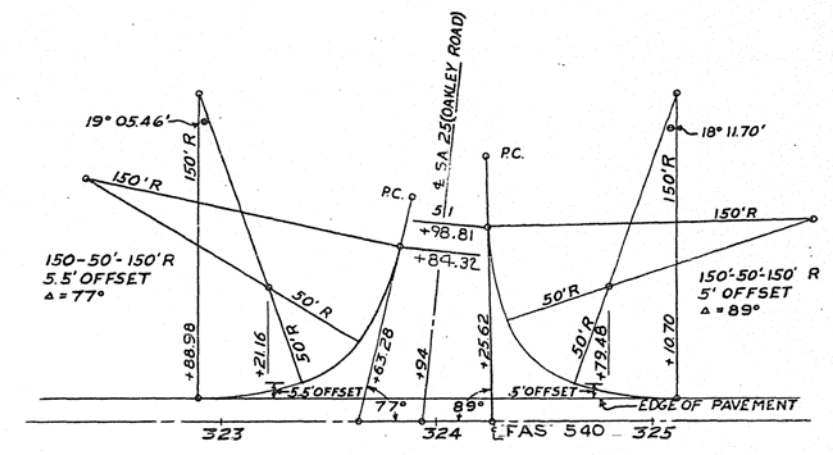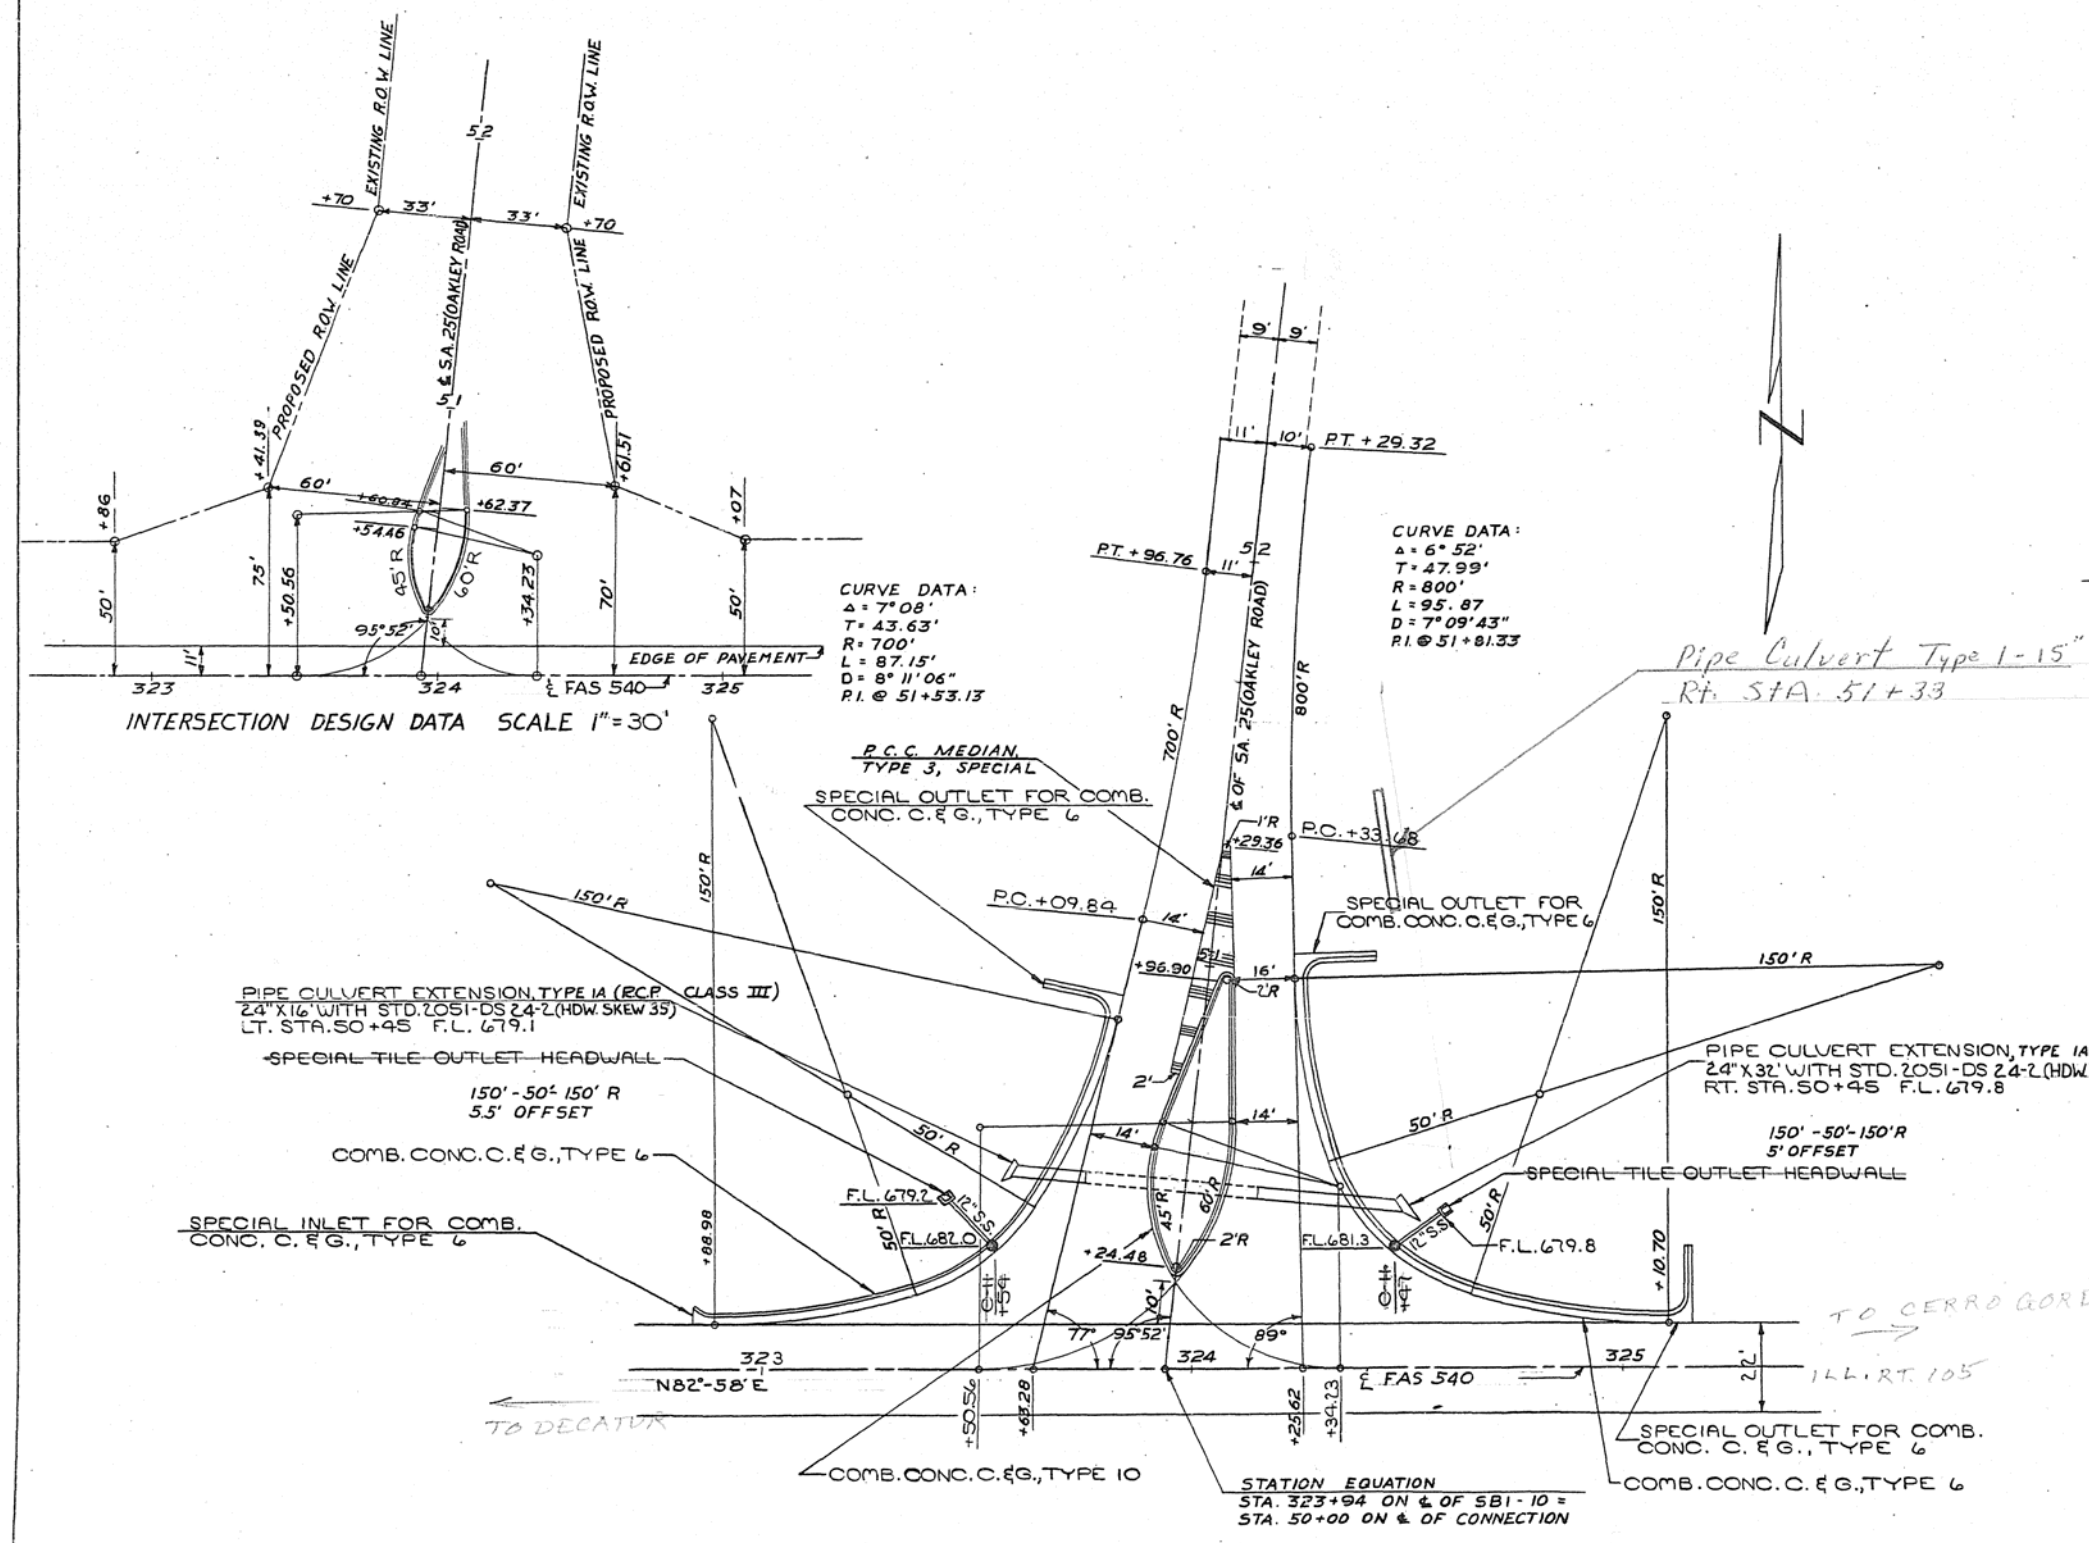


- PORTLAND CEMENT CONCRETE BASE COURSE, 8" :
LT. STA. 322+88.98 TO STA. 325+10.70 = 92.9 SQ. YDS.
- P.C. CONCRETE MEDIAN, TYPE 3, SPECIAL :
STA. 50+63 TO STA. 51+30.36 = 30 SQ. YDS.
- BITUMINOUS CONCRETE SURFACE COURSE, SUB-CLASS I-II :
LT. STA. 322+88.98 TO STA. 325+10.70 = 92.9 SQ. YDS.
- SPECIAL TILE OUTLET HEADWALLS :
LT. STA. 323+44 = 4 CU. YDS. CLASS X CONCRETE.
LT. STA. 324+56 = 4 CU. YDS. CLASS X CONCRETE.
TOTAL = 8 CU. YDS. CLASS X CONCRETE.
- STORM SEWERS, TYPE 1, 12" :
LT. STA. 323+54 = 14 LIN. FT.
LT. STA. 324+47 = 12 LIN. FT.
TOTAL = 26 LIN. FT.
- CATCH BASINS, TYPE C, TYPE II FRAME :
LT. STA. 323+54
LT. STA. 324+47
- COMBINATION CONCRETE CURB & GUTTER, TYPE 10 :
LT. STA. 50+22.48 TO LT. STA. 50+98.90 = 81 LIN. FT.
RT. STA. 50+22.48 TO RT. STA. 50+98.90 = 79 LIN. FT.
TOTAL = 160 LIN. FT.
- COMBINATION CONCRETE CURB & GUTTER, TYPE 6 :
LT. STA. 322+88.98 TO LT. STA. 50+84.32 = 134 LIN. FT.
RT. STA. 50+98.81 TO LT. STA. 325+10.70 = 141 LIN. FT.
TOTAL = 275 LIN. FT.
- SPECIAL INLET FOR COMBINATION CONCRETE C.E.G., TYPE 6 :
LT. STA. 322+88.98 = .5 CU. YDS. CLASS X CONCRETE.
- SPECIAL OUTLET FOR COMBINATION CONCRETE C.E.G., TYPE 6 :
LT. STA. 50+84.32 = 1.4 CU. YDS. CLASS X CONCRETE.
RT. STA. 50+98.81 = 1.4 CU. YDS. CLASS X CONCRETE.
LT. STA. 325+10.70 = 1.5 CU. YDS. CLASS X CONCRETE.
TOTAL = 4.3 CU. YDS. CLASS X CONCRETE.

TYPICAL DETAIL OF INTERSECTING SIDEROADS AND PRIVATE ENTRANCES

STA. 163+53 TO STA. 530+91.65

DETAIL OF PRIVATE ENTRANCES SHOWN ON LEFT.
DETAIL OF SIDEROADS SHOWN ON RIGHT.


MACON COUNTY
PLAT 12120
10W-1 (11,12)W
11RS (10,12)RS-1

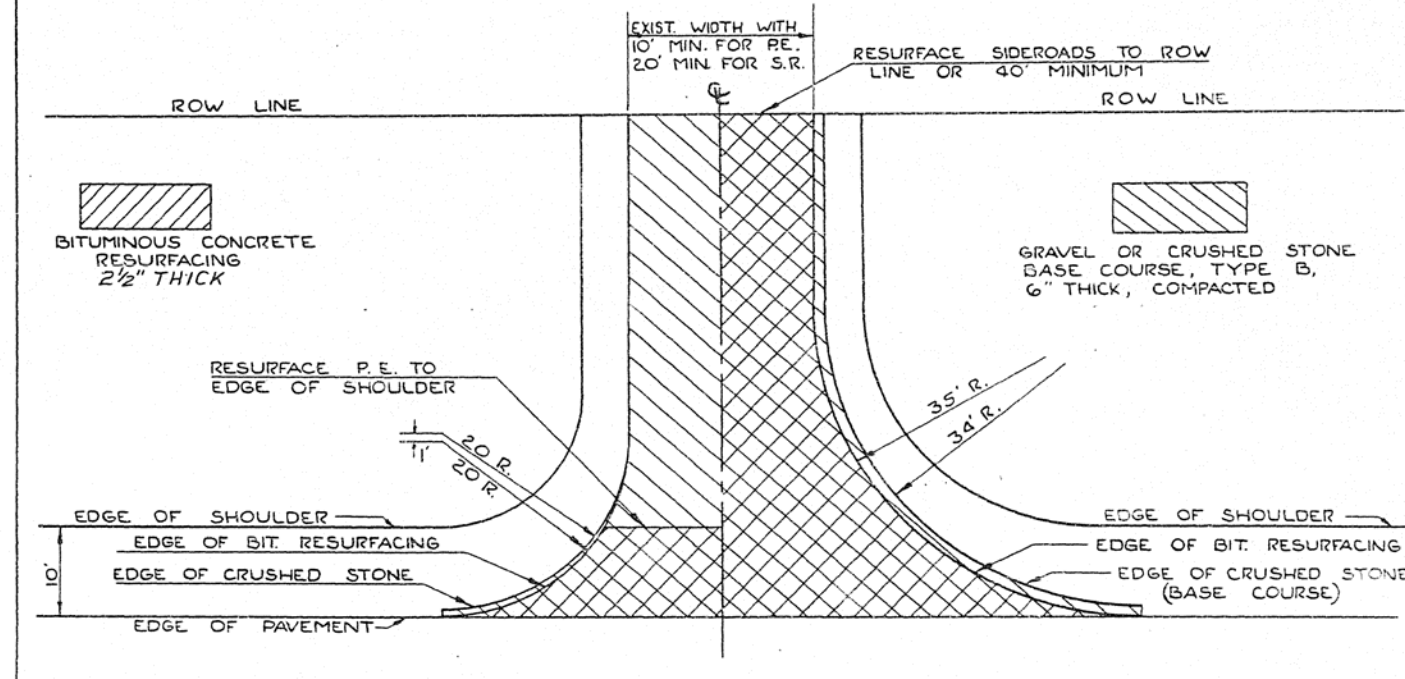

TYPICAL DETAIL OF INTERSECTING SIDEROADS AND PRIVATE ENTRANCES


STA. 120+95 TO STA. 163+53

MACON COUNTY
PLAT 12120
10W-1 (11,12)W
11RS (10,12)RS-1

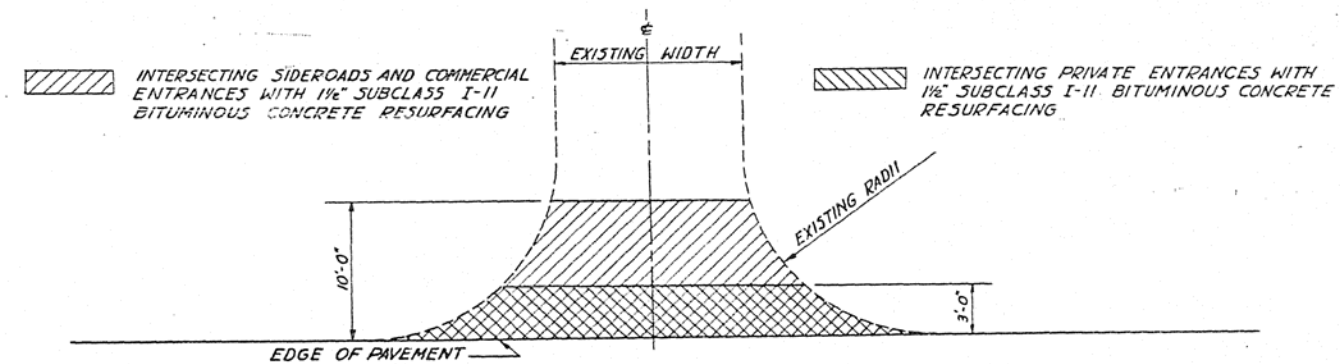


SPECIAL TILE OUTLET HEADWALL

Project: Section: COUNTY: TOTAL: 107 22
 F.A.S. * MACON * PLATT *
 S.D. *
 T.M.S.D. #11111111 PROJECT #
 * 10 W-1 (11,12) W
 * S-835()

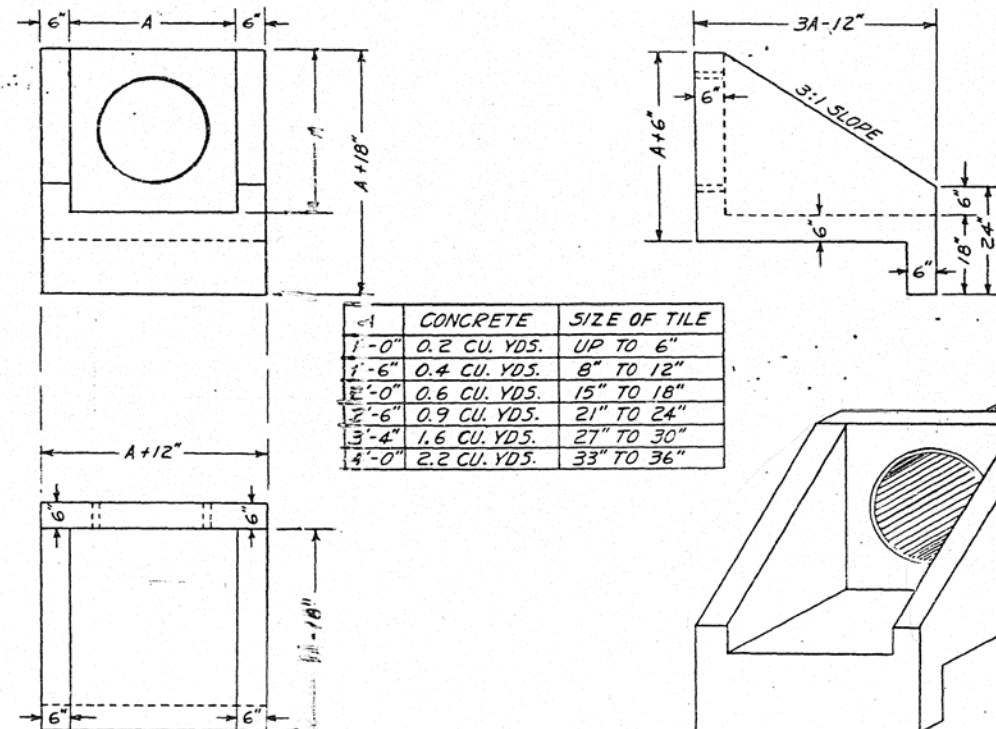

DETAIL OF SPECIAL OUTLET FOR COMBINATION CONCRETE CURB & GUTTER, TYPE 6


Project: Section: COUNTY: TOTAL: 107 22
 F.A.S. * MACON * PLATT *
 S.D. *
 T.M.S.D. #11111111 PROJECT #
 * 10 W-1 (11,12) W

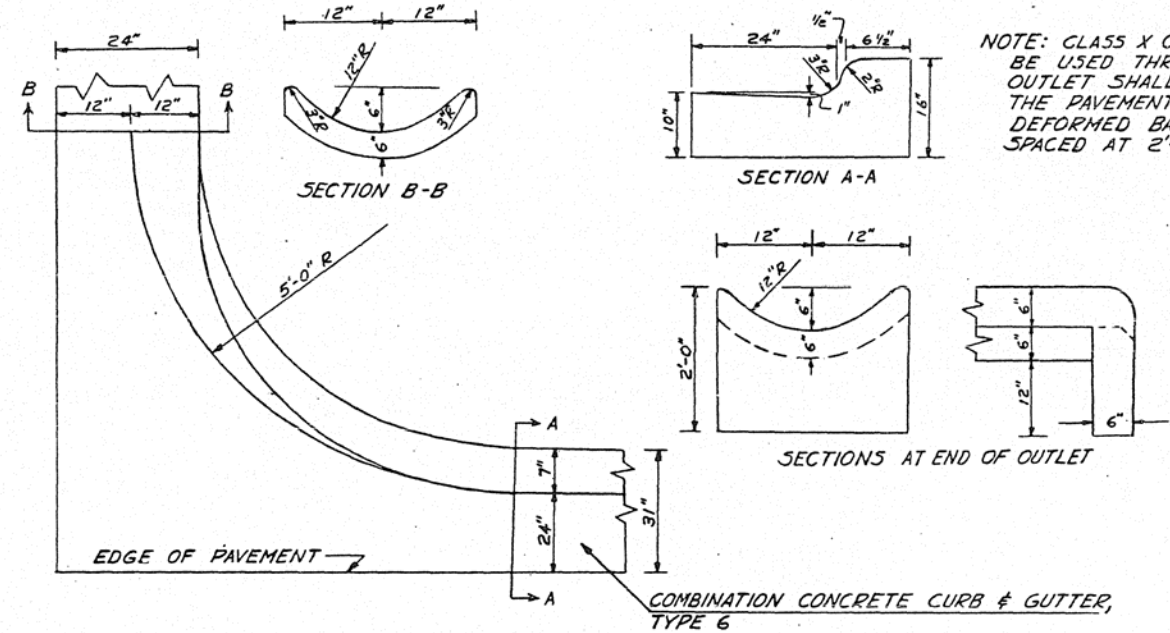

QUANTITY FOR SPECIAL OUTLET FOR COMBINATION CONCRETE CURB & GUTTER, TYPE 6:
 SECTION A-A TO SECTION B-B AND CURTAIN WALL = 0.90 CU. YDS. CLASS X CONCRETE.
 SECTION B-B = 0.042 CU. YDS. CLASS X CONCRETE PER LIN. FT.

DETAIL OF SPECIAL INLET FOR COMBINATION CONCRETE CURB & GUTTER, TYPE 6

Project: Section: COUNTY: TOTAL: 107 22
 F.A.S. * MACON * PLATT *
 S.D. *
 T.M.S.D. #11111111 PROJECT #
 * 10 W-1 (11,12) W

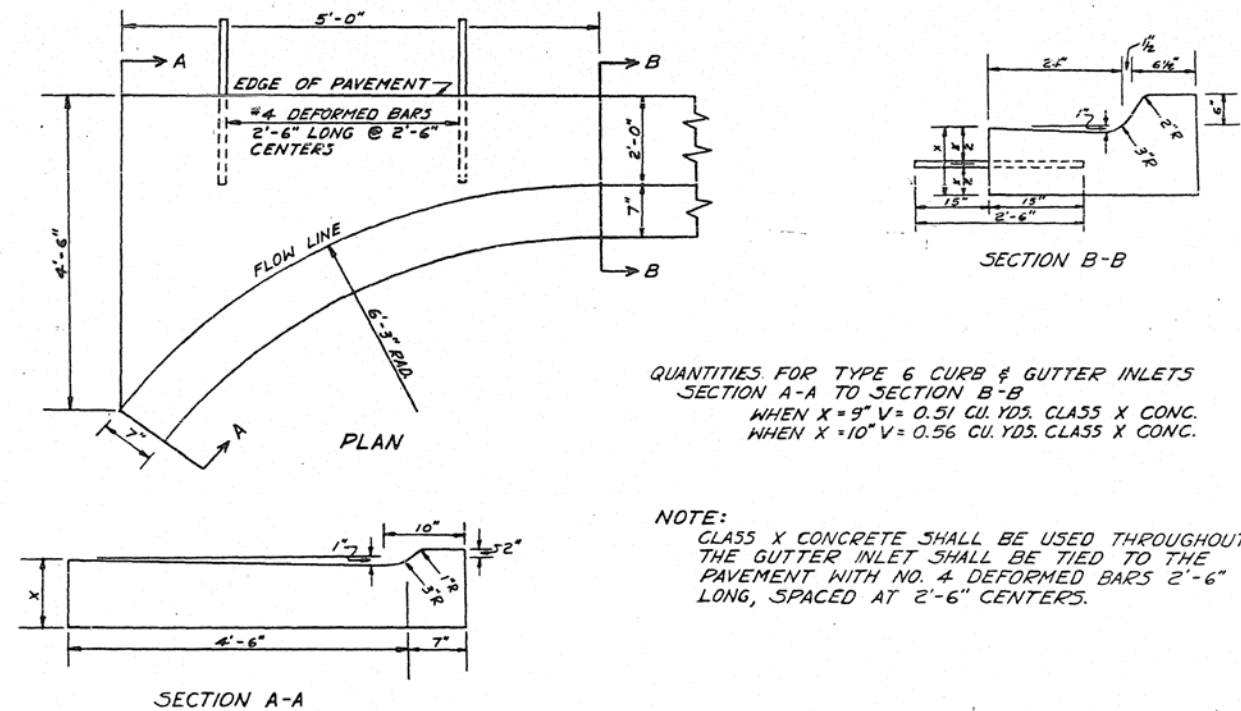


QUANTITIES FOR TYPE 6 CURB & GUTTER INLETS
 SECTION A-A TO SECTION B-B
 WHEN X = 9" V = 0.51 CU. YDS. CLASS X CONG.
 WHEN X = 10" V = 0.56 CU. YDS. CLASS X CONG.

SPECIAL DESIGN FOR PAVED DITCH INLETS

Sheet No.	Section	COUNTY	TOTAL SHEETS
543	* MAJOR	PLATT	107 23
Sheet No. 47	PROJECT		

* 10 W-1 (11, 12) W

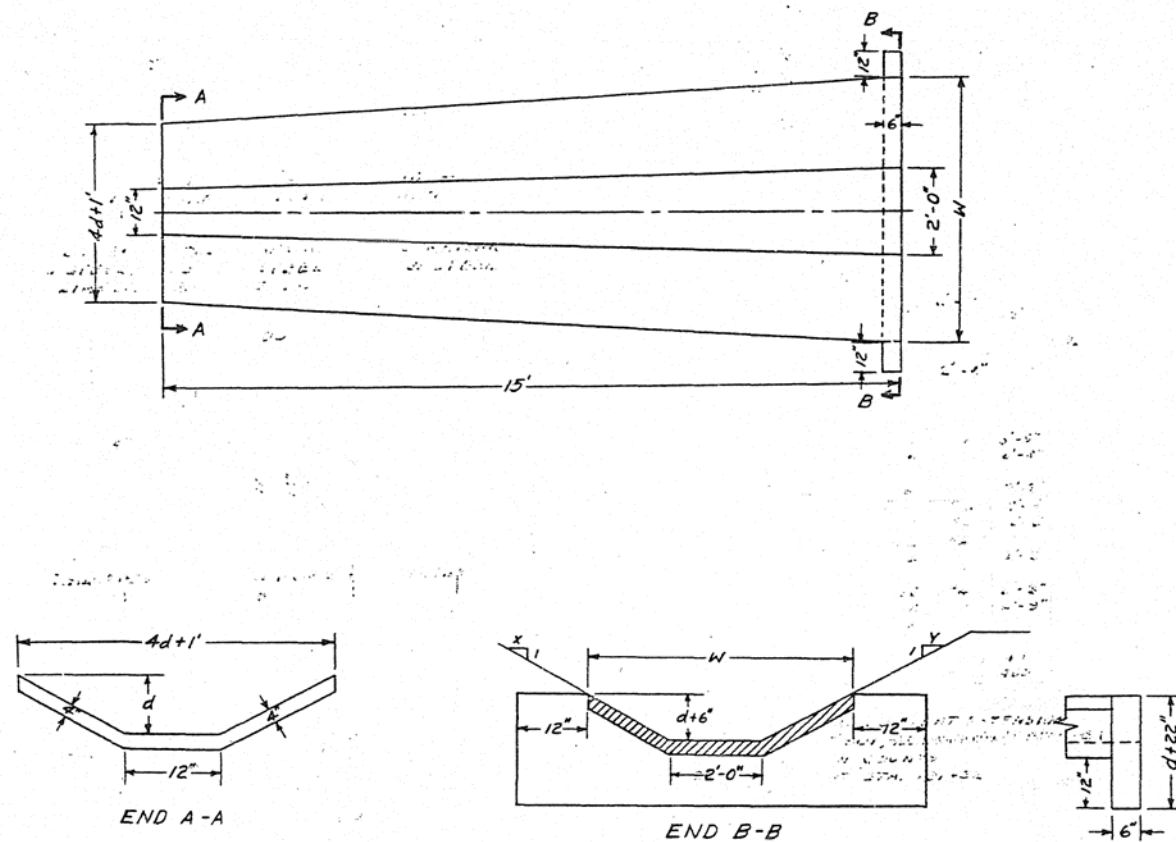


NOTE: PAVED DITCH INLETS SHALL BE CONSTRUCTED OF CLASS "X" CONCRETE THROUGHOUT AND SHALL BE PAID FOR AT THE CONTRACT UNIT PRICE PER CUBIC YARD FOR CLASS "X" CONCRETE.

SLOPES		5 FEET			6 FEET			7 FEET		
X:1	Y:1	d	W	CL. "X" CONC. CU. YDS.	d	W	CL. "X" CONC. CU. YDS.	d	W	CL. "X" CONC. CU. YDS.
2:1	2:1	12"	8'	1.7	15"	9'	1.9	18"	10'	2.2
3:1	2:1	12"	9'-6"	1.8	15"	10'-9"	2.1	18"	12'	2.4
3:1	3:1	12"	11'	2.0	15"	12'-6"	2.3	18"	14'	2.7
4:1	2:1	12"	11'	2.0	15"	12'-6"	2.3	18"	14'	2.7
4:1	3:1	12"	12'-6"	2.2	15"	14'-3"	2.6	18"	16'	2.9
4:1	4:1	12"	14'	2.4	15"	16'	2.8	18"	18'	3.2

SPECIAL DESIGN FOR PAVED DITCH

Sheet No.	Section	COUNTY	TOTAL SHEETS
543	* MAJOR	PLATT	107 23
Sheet No. 47	PROJECT		



* 10 W-1 (11, 12) W

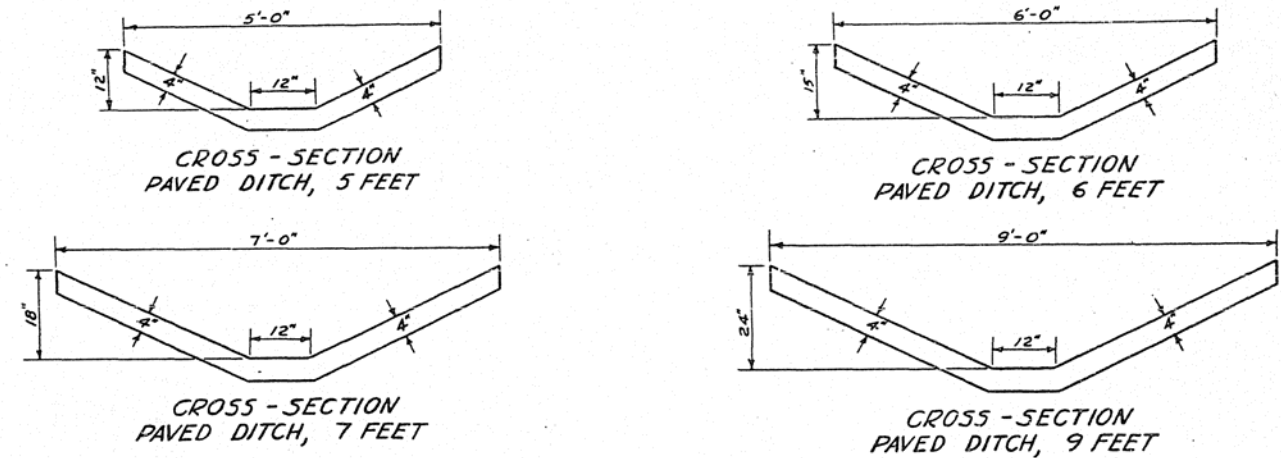


NOTE: PAVED DITCHES SHALL BE CONSTRUCTED OF CLASS "X" CONCRETE THROUGHOUT. TRANSITIONS SHALL BE PAID FOR AT THE CONTRACT UNIT PRICE PER CUBIC YARD FOR CLASS "X" CONCRETE.

VOLUME IN TRANSITIONS CU. YDS. OF CONCRETE REQUIRED												
PIPE SIZE	5 FEET			6 FEET			7 FEET			9 FEET		
	L	CONC.	C.M.P.	L	CONC.	C.M.P.	L	CONC.	C.M.P.	L	CONC.	C.M.P.
12"	15'	1.0	1.0									
15"	15'	1.1	1.1									
18"	15'	1.2	1.2	15'	1.3	1.3						
21"	25'	2.2	2.2	15'	1.5	1.5						
24"				25'	2.5	2.5	15'	1.7	1.7			
30"				35'	4.0	3.9	25'	3.0	3.0	15'	2.1	2.1
33"							35'	4.3	4.3	25'	3.5	3.5
36"							35'	4.6	4.6	25'	3.7	3.6
42"										35'	5.5	5.5

SPECIAL DESIGN FOR TRANSITION FROM PIPE CULVERT TO PAVED DITCH

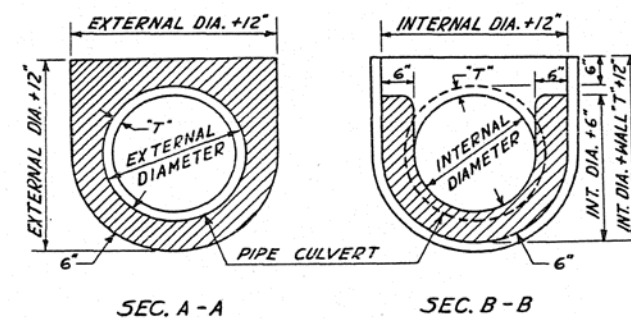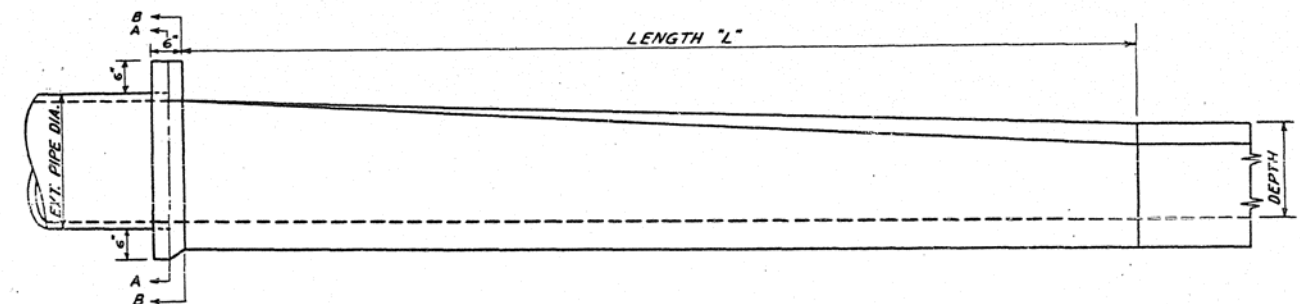



DETAIL OF ANCHOR WALL FOR PAVED DITCH

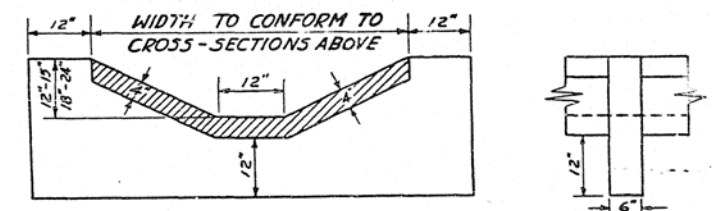

ANCHOR WALLS SHALL BE PROVIDED AT 100 FOOT CENTERS, AND SHALL BE MONOLITHIC WITH THE PAVED DITCH. PAVED DITCHES SHALL BE PAID FOR AT THE CONTRACT UNIT PRICE PER LINEAL FOOT FOR PAVED DITCH OF THE WIDTH SPECIFIED, WHICH PRICE OR PRICES SHALL INCLUDE THE ANCHOR WALLS.

STATE OF ILLINOIS
DEPARTMENT OF PUBLIC WORKS & BUILDINGS
DIVISION OF HIGHWAYS


PROJECT NO. 540
SECTION *
COUNTY MACON
PIATT
SHEET NO. 106
24
SHEETS
ILLINOIS FED. AID PROJECT 5-835(7)
* 10W-1(11,12)W

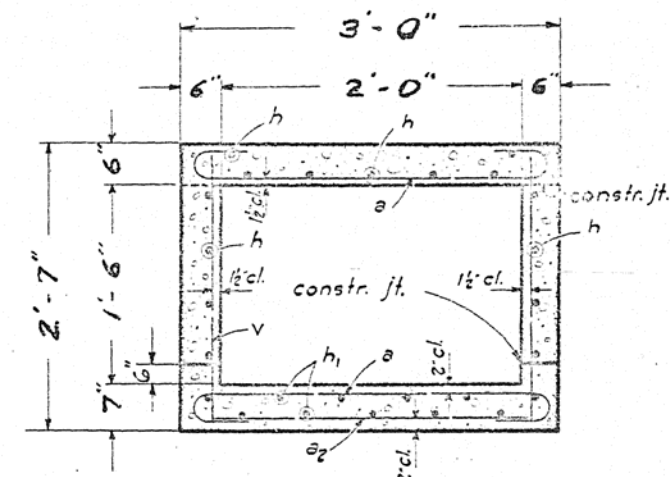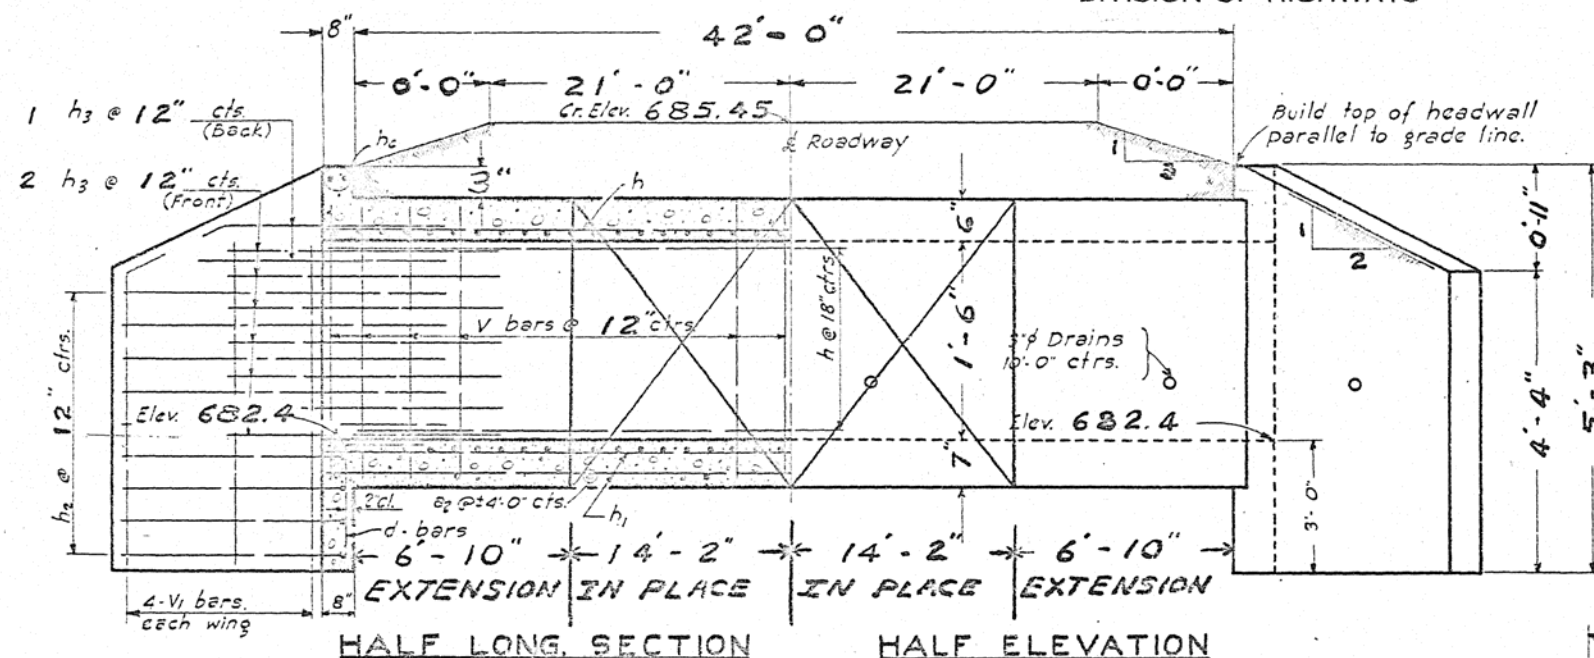




SECTION THRU BARREL

HALF LONG SECTION HALF ELEVATION

NOTE: REMOVE OLD HEADWALLS AND STRAIGHTEN
OLD STEEL. TIE OLD STEEL TO NEW STEEL
AS DIRECTED BY THE ENGINEER.

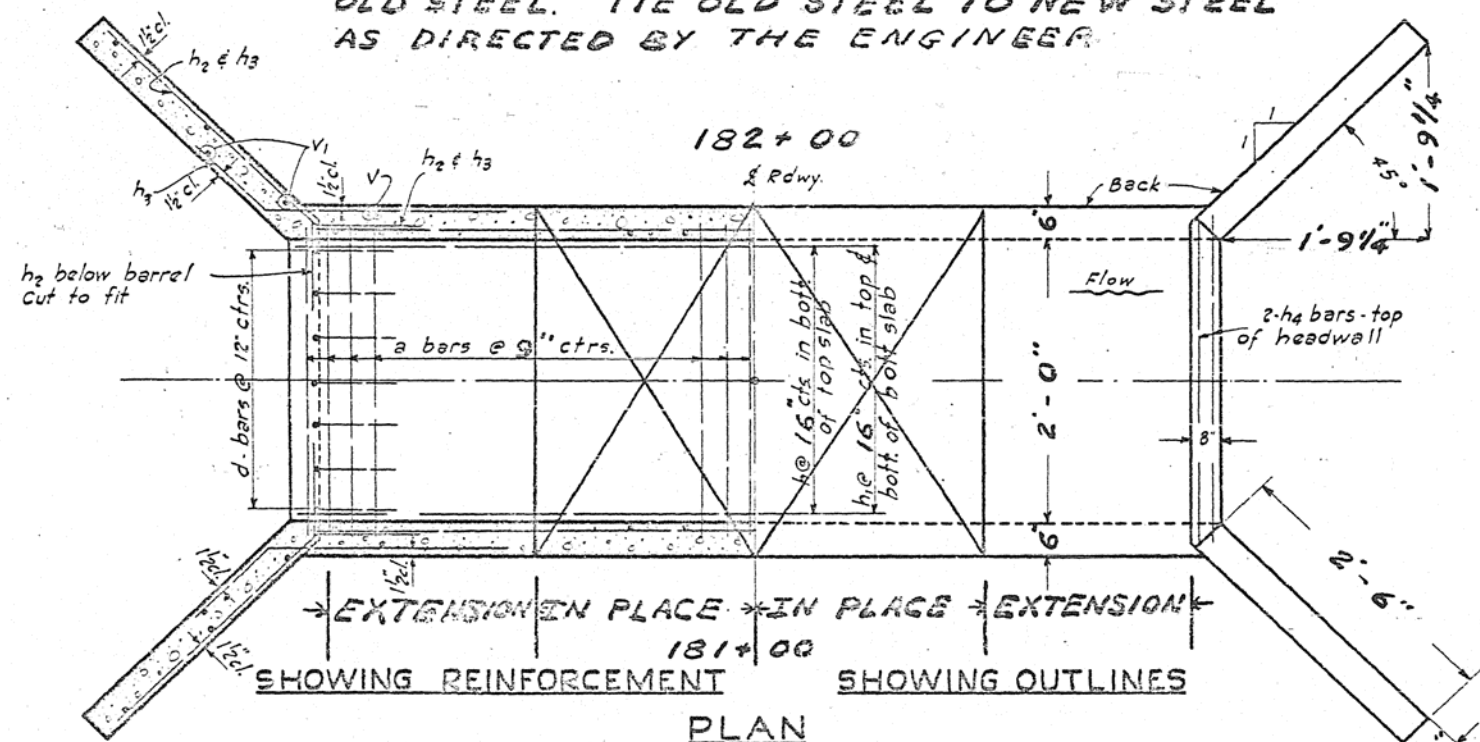

SHOWING REINFORCEMENT SHOWING OUTLINES
PLAN

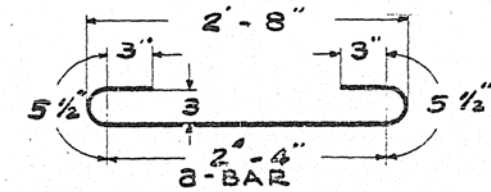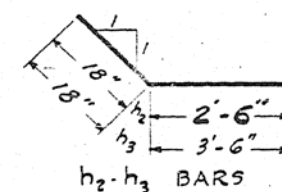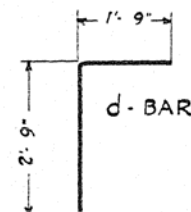

BILL OF MATERIAL

BAR	NO.	SIZE	LENGTH
a	40	#4	3'-9"
a2	4	#4	1'-3"
h	16	#4	7'-3"
h1	10	#4	7'-3"
h2	20	#4	4'-0"
h3	12	#4	5'-0"
h4	4	#6	2'-3"
v	36	#4	2'-3"
v1	16	#4	4'-9"
d	6	#4	4'-6"
Class 'X' Concrete Cu.Yds.			4.1
Reinforcement bars Lbs.			460

NOTE: All bars shall be round ASTM A305-49.
The size number is the number of
1/8 inches in the nominal diameter.

SPECIAL CULVERT EXTENSION
2' X 1.5' BOX, SEE 10W-1(11,12)W, IIR5(10,12)RS-1
MACON COUNTY
LT & RT STA 181+32

GENERAL NOTES
Class X concrete shall be used throughout.
At least six feet of Barrel shall be poured
monolithically with wing walls.
Exposed edges shall be beveled 3".
For backfilling & embankments see S+D. Spec's.
Tilt hook of "a" bars, if necessary, to obtain 1/2"
minimum clearance at top of hook.

fs = 20,000 psi
fc = 1200 psi
n = 10
H-20 LOADING

STANDARD	COMPUTED	EXAMINED	7-1
	CHECKED		
	DRAWN		
	CHECKED		
SPECIAL	ASSEMBLED		
	CHECKED		



Reinf. Revised - 11-50 - J.S.M.

STANDARD 2020

STATE OF ILLINOIS
DEPARTMENT OF PUBLIC WORKS & BUILDINGS
DIVISION OF HIGHWAYS





ROUTE	SECTION	COUNTY	TOTAL SHEETS	SHEET NO.	SHEETS
F.A.S. 540	#	MACON & PIATT	106	25	
FED. ROAD DIST. NO. 7	ALABAMA	FED. AID PROJECT 5-835(7)			

*10W-1 (11,12)W

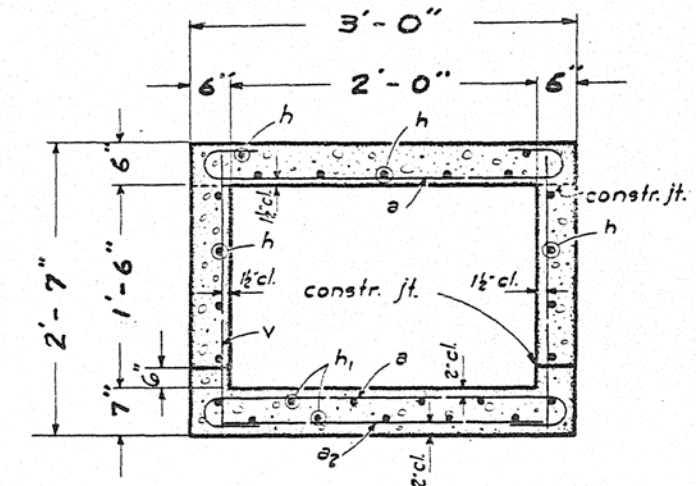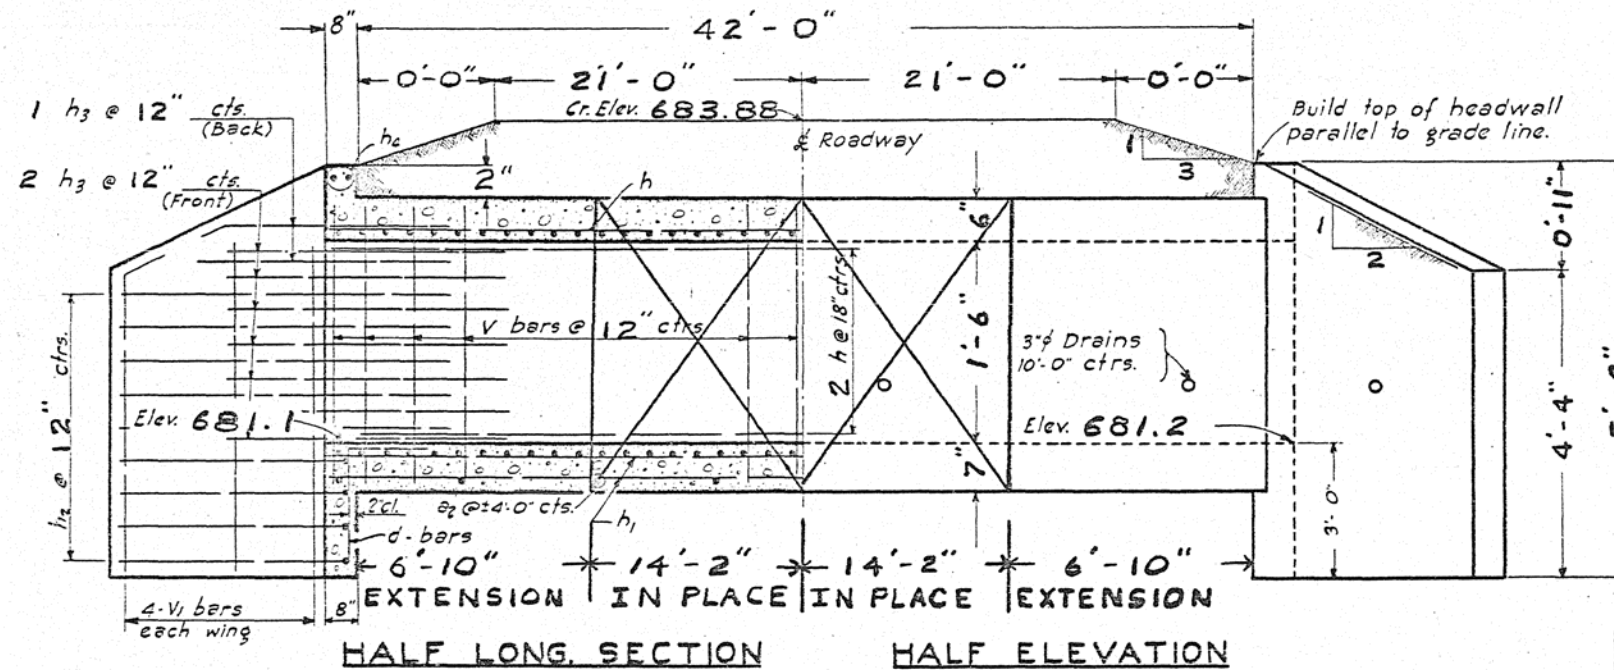

SECTION THRU BARREL

NOTE: REMOVE OLD HEADWALLS AND STRAIGHTEN OLD STEEL. TIE OLD STEEL TO NEW STEEL AS DIRECTED BY THE ENGINEER

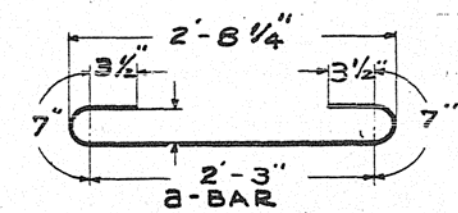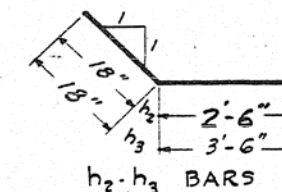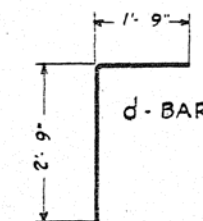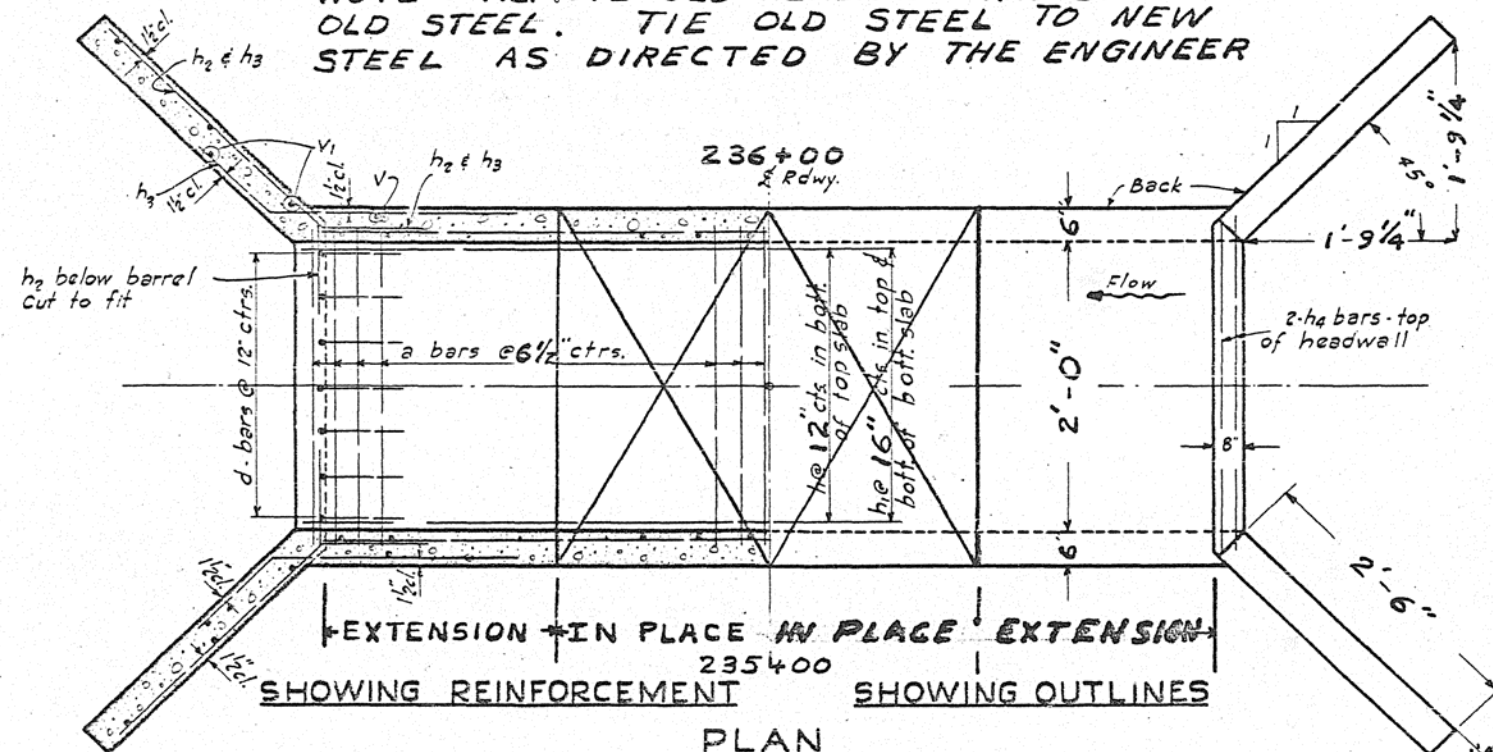

BILL OF MATERIAL

BAR	NO.	SIZE	LENGTH
a	56	#5	4'-0"
a2	4	#4	2'-3"
h	16	#4	7'-3"
h1	10	#4	7'-3"
h2	20	#4	4'-0"
h3	12	#4	5'-0"
h4	4	#6	2'-3"
V	36	#4	2'-3"
V1	16	#4	4'-9"
d	6	#4	4'-6"

Class 'X' Concrete cu. yds. 4.0
Reinforcement bars Lbs. 600

NOTE: All bars shall be round ASTM A305-49. The size number is the number of 1/8 inches in the nominal diameter.

SPECIAL CULVERT EXTENSION
2' X 1.5' BOX, SEC. 10W-1 (11,12)W & 11RS (10,12) RS-1
MACON COUNTY
LT. & RT. STA. 235+95

fs = 20,000 #/sq.
fc = 1200 #/sq.
n = 10
H=20 LOADING

GENERAL NOTES

Class 'X' concrete shall be used throughout. At least six feet of Barrel shall be poured monolithically with wing walls. Exposed edges shall be beveled 3". For backfilling & embankments see std. Spec's. Tilt hook of 'a' bars, if necessary, to obtain 1/2" minimum clearance at top of hook.

COMPUTED	7-1	1960
CHECKED	K.M. Leonard	ENGINEER
DRAWN	-C.L. HAZLETT-	PASSED
CHECKED		ENGINEER OF DESIGN
ASSEMBLED	R.G.S.	APPROVED
CHECKED	J.L.F.	CHIEF HIGHWAY ENGINEER



Reinf. Revised - 11-50 - J.S.M.

STANDARD 2020

STATE OF ILLINOIS
DEPARTMENT OF PUBLIC WORKS & BUILDINGS
DIVISION OF HIGHWAYS





ROUTE	SECTION	COUNTY	TOTAL SHEETS	SHEET NO.
F.A.S. 540	*	MACON & PIATT	106	26
FED. ROAD DIST. NO. 7	ILLINOIS	FED. AID PROJECT 5-835()		

*10W-1 (11,12)W

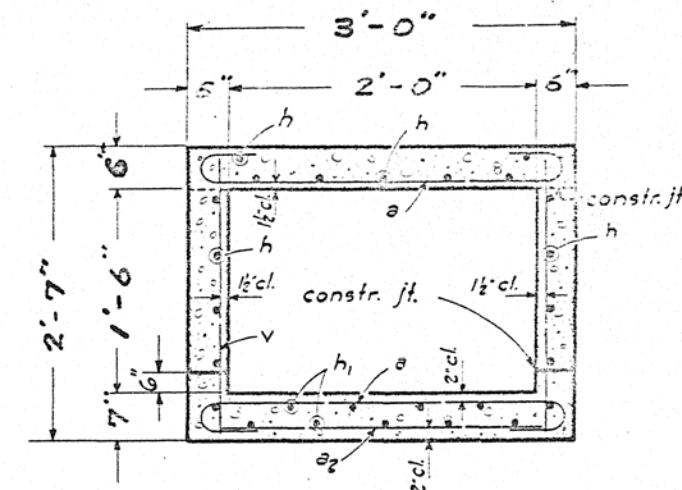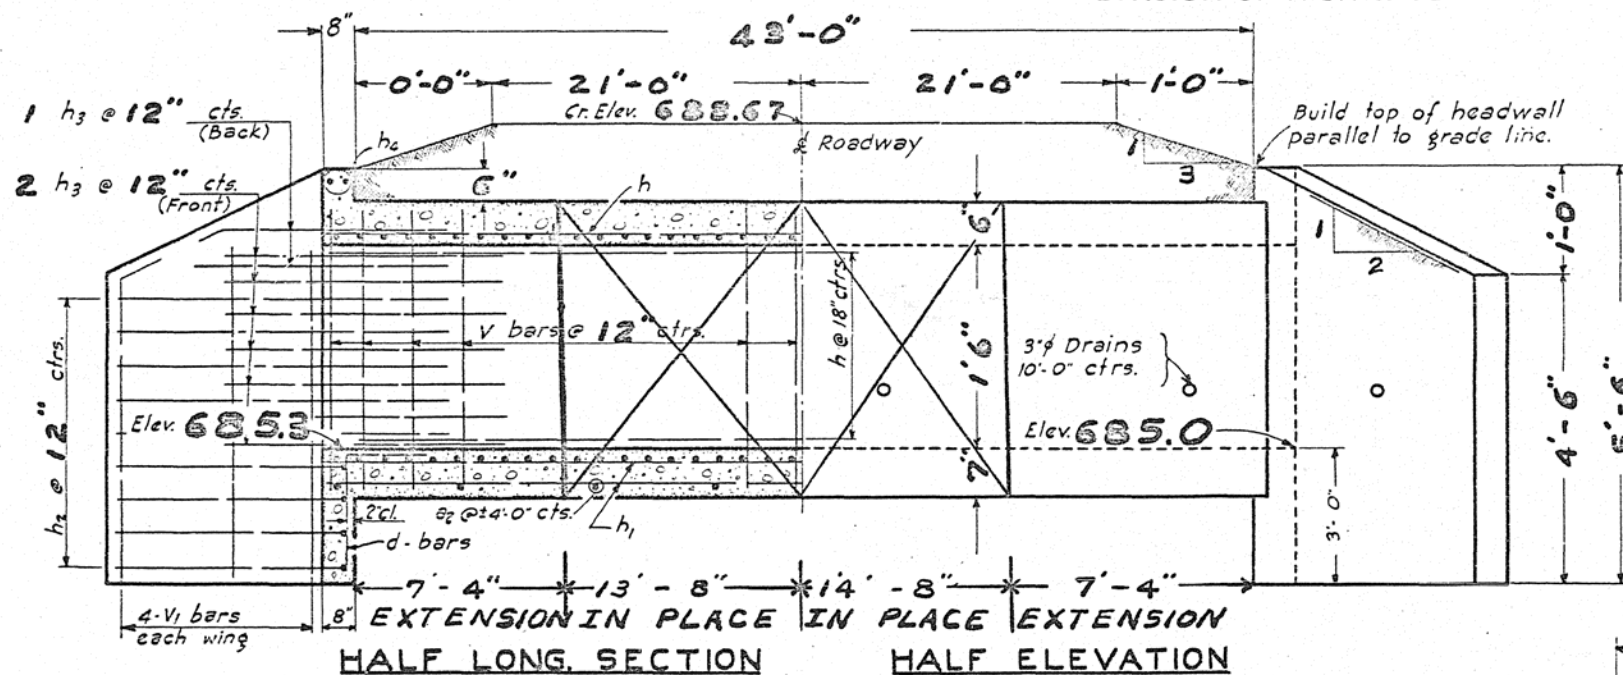

SECTION THRU BARREL

NOTE: REMOVE OLD HEADWALLS AND STRAIGHTEN OLD STEEL. TIE OLD STEEL TO NEW STEEL AS DIRECTED BY THE ENGINEER

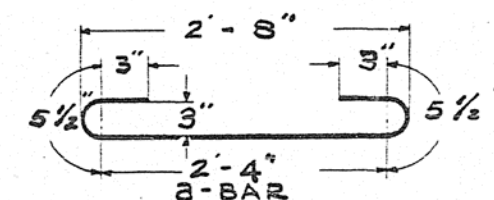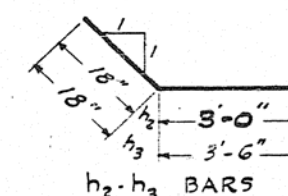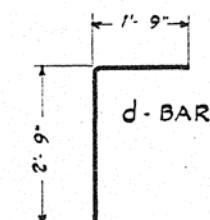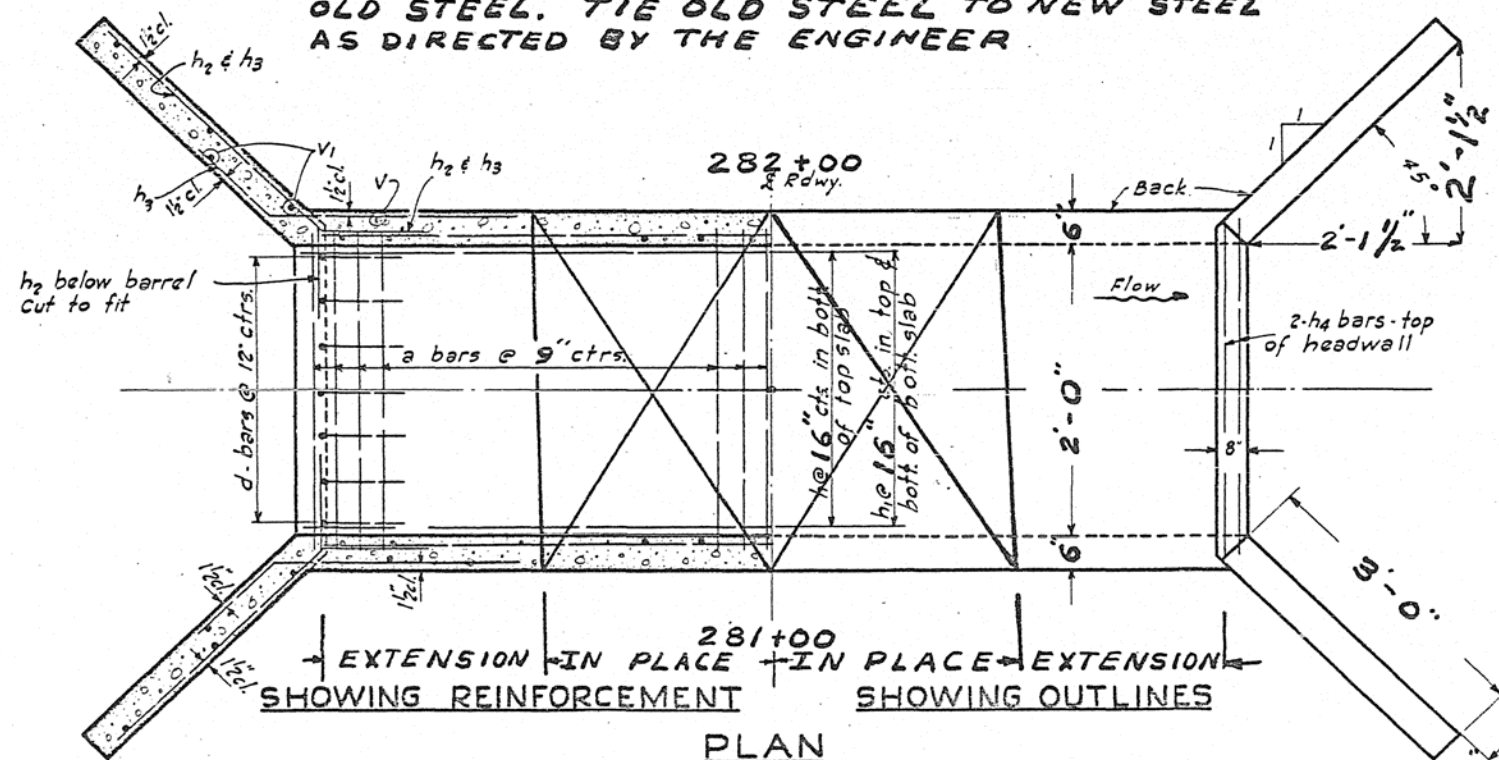

BILL OF MATERIAL

BAR	NO.	SIZE	LENGTH
a	40	#4	3'-9"
a2	4	#4	2'-3"
h	16	#4	7'-9"
h1	10	#4	7'-9"
h2	20	#4	4'-6"
h3	12	#4	5'-0"
h4	4	#6	2'-3"
v	36	#4	2'-3"
v1	16	#4	5'-0"
d	6	#4	4'-6"

Class 'X' Concrete Cu.Yds. 4.6
Reinforcement bars Lbs. 480

NOTE: All bars shall be round ASTM A305-49. The size number is the number of 1/8 inches in the nominal diameter.

SPECIAL CULVERT EXTENSION
2'X1.5' BOX, SEC. 10W-1 (11,12)W & 11RS (10,12) RS-1
MACON COUNTY
LT. & RT. STA. 281+53


STANDARD	COMPUTED
	CHECKED
	DRAWN - C.L. HAZLETT
	CHECKED
SPECIAL	ASSEMBLED R.G.S.
	CHECKED J.L.F.

EXAMINED 7-1-60
CHECKED
APPROVED


GENERAL NOTES

Class X concrete shall be used throughout. At least six feet of Barrel shall be poured monolithically with wing walls. Exposed edges shall be beveled 5/8". For backfilling & embankments see S.D. Spec's. Tilt hook of 'a' bars, if necessary, to obtain 1/2" minimum clearance at top of hook.

fs = 20,000 #/sq. in.
fc = 1200 #/sq. in.
n = 10
H-20 LOADING

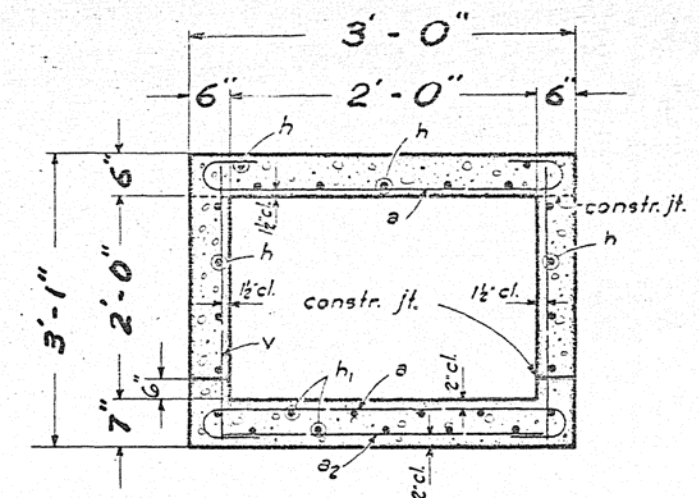

HALF LONG. SECTION HALF ELEVATION

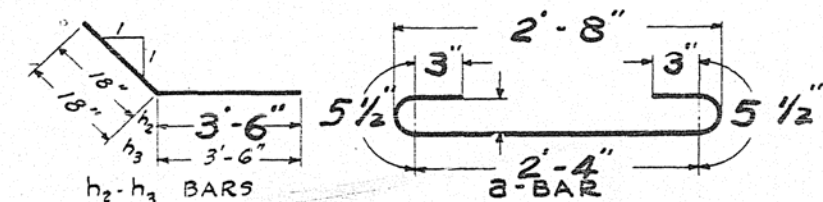

BAR	NO.	SIZE	LENGTH
a	54	#4	3'-9"
a ₂	6	#4	2'-3"
h _L	8	#4	9'-9"
h _R	8	#4	9'-6"
h _{1L}	5	#4	9'-9"
h ₂	20	#4	5'-0"
h ₃	16	#4	5'-0"
h ₄	4	#6	2'-3"
h _{1A}	5	#4	9'-6"
v	44	#4	2'-9"
v ₁	16	#4	5'-6"
d	6	#4	4'-6"

NOTE:—All bars shall be round ASTM A305-49.
The size number is the number of
 $\frac{1}{8}$ inches in the nominal diameter.

$f_s = 20,000 \text{ #/in}^2$
 $f_c = 1200 \text{ #/in}^2$
 $n = 10$
H-20 LOADING

STANDARD	COMPUTED
	CHECKED
	DRAWN - C.L. HAZLETT-
	CHECKED
SPECIAL	ASSEMBLED R.G.S.
	CHECKED 11 E



EXAMINED 7-1 1960
V. M. Jones
BRIDGE ENGINEER
PASSED
ENGINEER OF DESIGN
APPROVED

GENERAL NOTES
Class X concrete shall be used throughout.
At least six feet of Barrel shall be poured
monolithically with wing walls.
Exposed edges shall be beveled 3".
For backfilling & embankments see Std. Spec's.
Tilt hook of "a" bars, if necessary, to obtain 1 1/2"
minimum clearance at top of hook.

STATE OF ILLINOIS
DEPARTMENT OF PUBLIC WORKS & BUILDINGS
DIVISION OF HIGHWAYS


PROJECT	SHEET NO.	DATE	BY	CHECKED
F.A.S. 540	106	28	MACON	
10W-1(11,12)W				

SHEET NO.
106
28


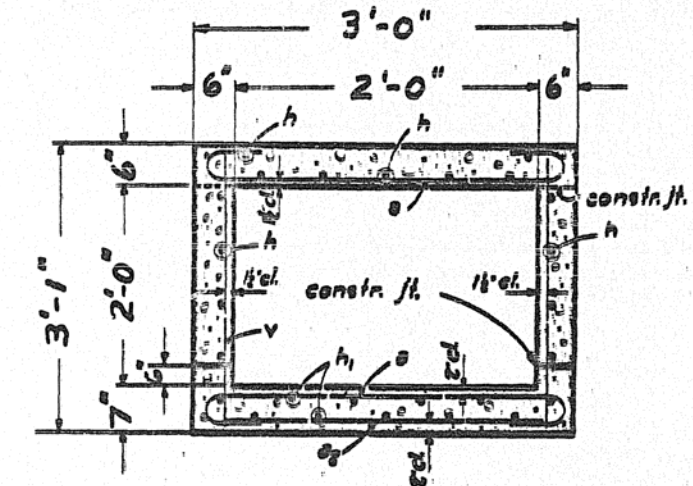
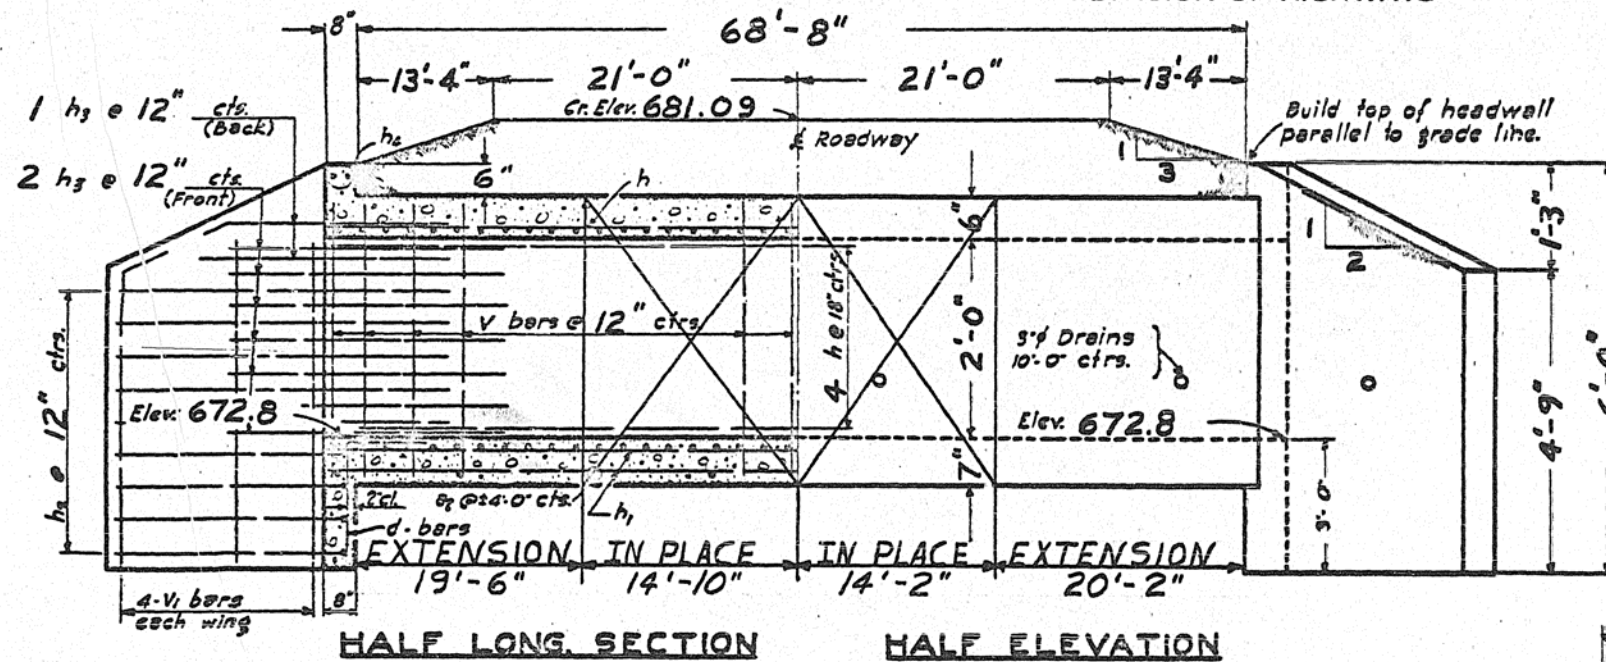


SECTION THRU BARREL

NOTE: REMOVE OLD HEADWALLS AND STRAIGHTEN OLD STEEL. TIE OLD STEEL TO NEW STEEL AS DIRECTED BY THE ENGINEER

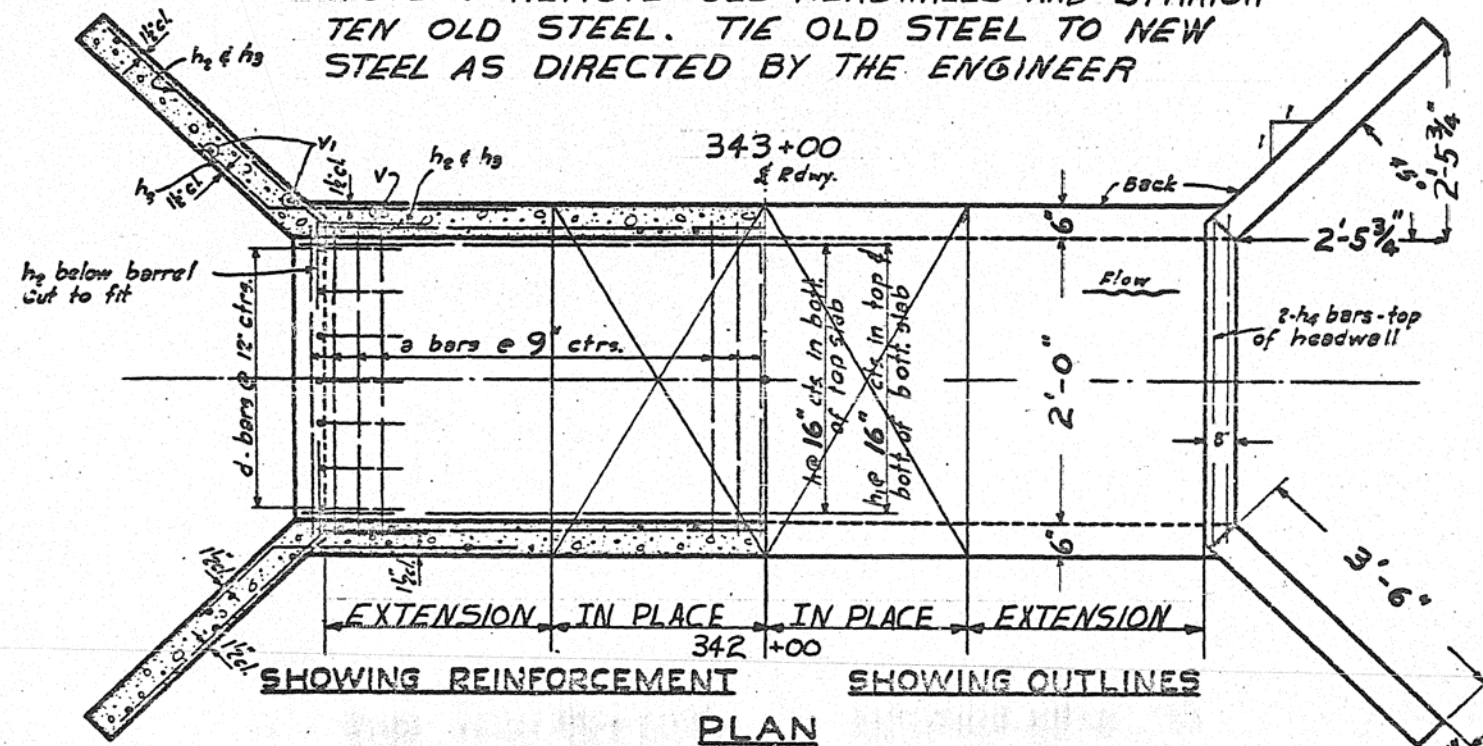

SHOWING REINFORCEMENT
SHOWING OUTLINES
PLAN

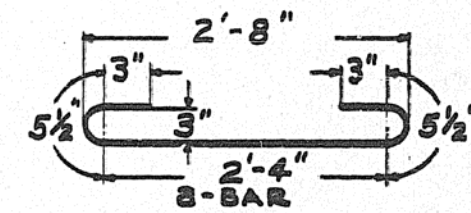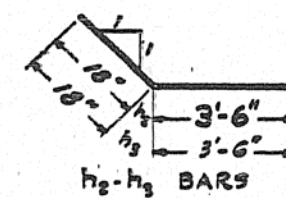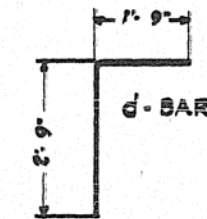

BILL OF MATERIAL

BAR	NO.	SIZE	LENGTH
a	110	#4	3'-9"
a2	10	#4	2'-3"
h1	8	#4	20'-0"
h2	8	#4	20'-6"
h3	5	#4	20'-0"
h4	20	#4	5'-0"
h5	12	#4	3'-0"
h6	4	#4	2'-3"
h7	5	#4	20'-6"
v	86	#4	2'-9"
v1	16	#4	5'-6"
d	6	#4	4'-6"

Class "X" Concrete Cuyds. 10.0
Reinforcement bars Lbs. 1,000


NOTE: All bars shall be round ASTM A305-69. The size number is the number of 1/8 inches in the nominal diameter.

fs = 20,000 psi
fc = 1200 psi
n = 10
SPECIAL CULVERT EXTENSION 2'x2' BOX
F.A.S. 540, SEC. 10W-1(11,12)W & 11RS(10,12) RS-1
MACON COUNTY
H20 LOADING LT. & RT. STA. 342+24


COMPUTED	
CHECKED	
DRAWN	-C.L. HAZLETT-
CHECKED	
ASSEMBLED	R.G.S.
CHECKED	G.K.C.

EXAMINED	7-1-60
PASSED	V.M. Korman
APPROVED	

GENERAL NOTES
Class X concrete shall be used throughout. At least six feet of Barrel shall be poured monolithically with wing walls. Exposed edges shall be beveled 1/2". For backfilling & embankments see std. Spec's. Tilt hook of #4 bars, if necessary, to obtain 1/2" minimum clearance at top of hook.

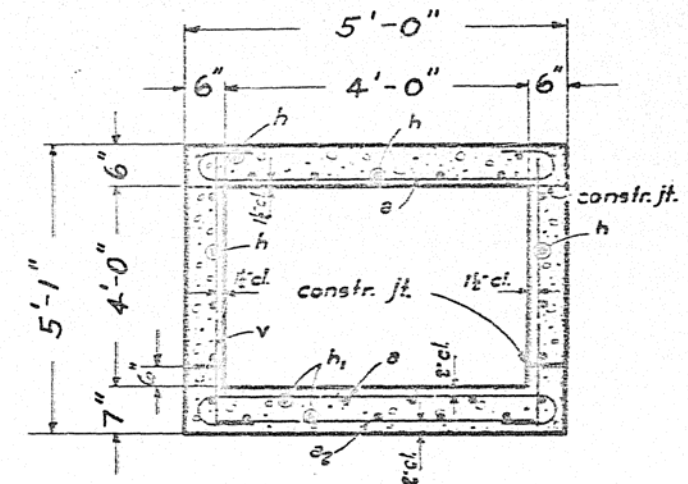

SECTION THRU BARREL

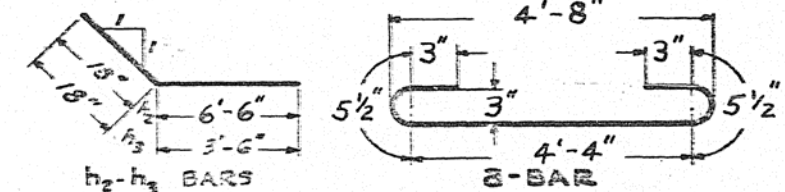

BILL OF MATERIAL

BAR	NO.	SIZE	LENGTH
a	110	#4	5'-9"
a ₂	8	#4	4'-3"
h	22	#4	16'-6"
h ₂	14	#4	16'-6"
h ₂	32	#4	8'-0"
h ₃	28	#4	5'-0"
h ₄	4	#6	4'-3"
v	68	#4	4'-9"
v ₁	16	#4	6'-9"
d	10	#4	4'-6"

class "X" concrete cu.yds	16.3
Reinforcement bars Lbs.	1,440

Note: - All bars shall be round ASTM A305-49.
The size number is the number of
1/8 inches in the nominal diameter.

$f_s = 29,000 \text{ psi}$
 $f_c = 1000 \text{ psi}$
 $n = 10$
 SPECIAL CULVERT DESIGN 4'-4' BOX
 SEC. 10W-1(11,12)W 4' HRS (10,12) RS-1
 MACON COUNTY
 H15 Loading 39' RT. STA. 351 + 40.5

STANDARD 2020

STANDARD	COMPUTED
	CHECKED
	DRAWN - C. L. HAZLETT -
	CHECKED
SPECIAL	ASSEMBLED R. G. S.
	CHECKED C. J. B.

Reinf. Revised - 11-50 - J.E.M.


EXAMINED 7-1 165
1.12.20
PASSED
APPROVED

GENERAL NOTES


Class X concrete shall be used throughout.
At least six feet of Barrel shall be poured
monolithically with wing walls.
Exposed edges shall be beveled 2".
For backfilling & embankments see Std. Spec's.
Tilt hook of "a" bars, if necessary, to obtain 1/2"
minimum clearance at top of hook.

BOND ISSUE ROUTE NO	SECTION	COUNTY	TOTAL SHEETS	SHEET NO
F.A.S. 540	*	MACON PIATT	106	30
FED. ROAD DIST. NO. 7		ILLINOIS FED. AID PROJECT 5-835C		

* 10W-1 (11, 12) W

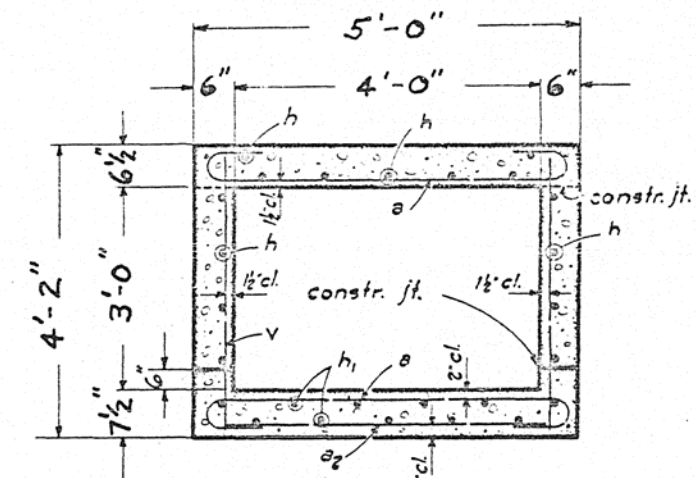

SECTION THRU BARREL

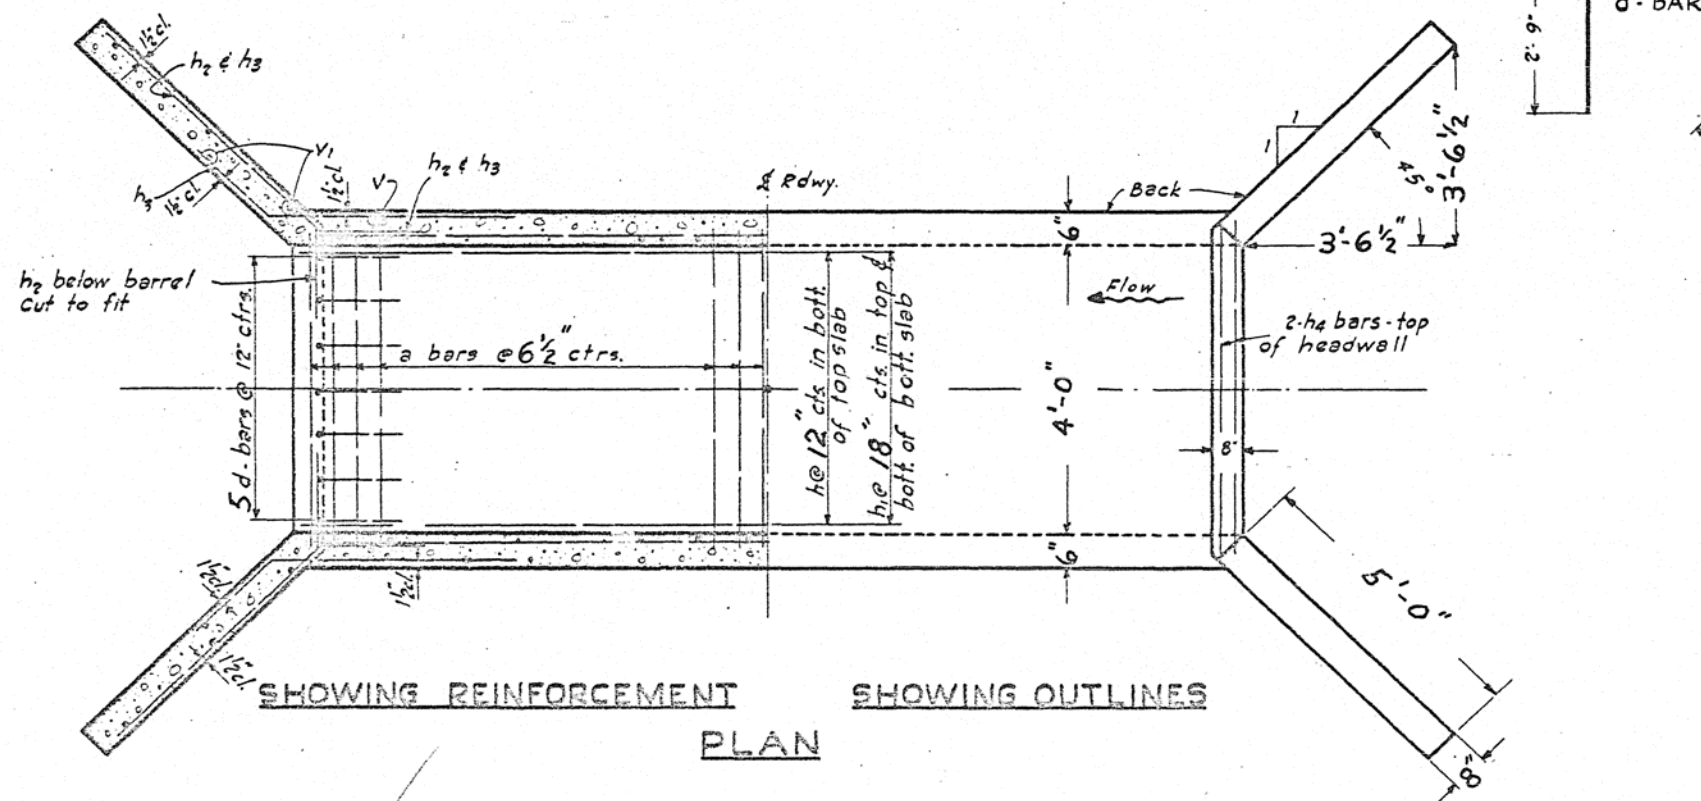

SHOWING REINFORCEMENT
PLAN

SHOWING OUTLINES

STANDARD	COMPUTED
	CHECKED
	DRAWN - C.L. HAZLETT-
	CHECKED
SPECIAL	ASSEMBLED R. G. S.
	CHECKED C. J. B.

Reinf. Revised - 11-50 - J.S.M.

EXAMINED 7-1 12 60
V. H. [Signature]
PASSED
ENGINEER
APPROVED
ENGINEER OF DESIGN

GENERAL NOTES

Class X concrete shall be used throughout. At least six feet of Barrel shall be poured monolithically with wing walls. Exposed edges shall be beveled $\frac{1}{2}$ ". For backfilling & embankments see St'd. Spec's. Tilt hook of "a" bars, if necessary, to obtain 1' minimum clearance at top of hook.

$$\begin{aligned} f_s &= 20,000 \text{ * / s} \\ f_c &= 1200 \text{ * / s} \\ n &= 10 \end{aligned}$$



H/5 LOADING

SPECIAL CULVERT DESIGN 4'x3' BOX
SEC. 10W-1(11,12)W & 11RS (10,12)RS-1
MACON COUNTY
32' RT. STA. 362+23


BAR	NO.	SIZE	LENGTH
a	84	#5	6'-0"
a ₂	6	#4	4'-3"
h	10	#4	22'-6"
h ₁	7	#4	22'-6"
h ₂	24	#4	6'-6"
h ₃	16	#4	5'-0"
h ₄	4	#6	4'-3"
v	50	#4	3'-9"
v ₁	16	#4	6'-3"
d	10	#4	4'-6"
Class 'X' Concrete cu.yds. 11.2			
Reinforcement bars Lbs. 1,200			

NOTE 1—All bars shall be round ASTM A305-49.
The size number is the number of
 $\frac{1}{8}$ inches in the nominal diameter.

STANDARD 2020

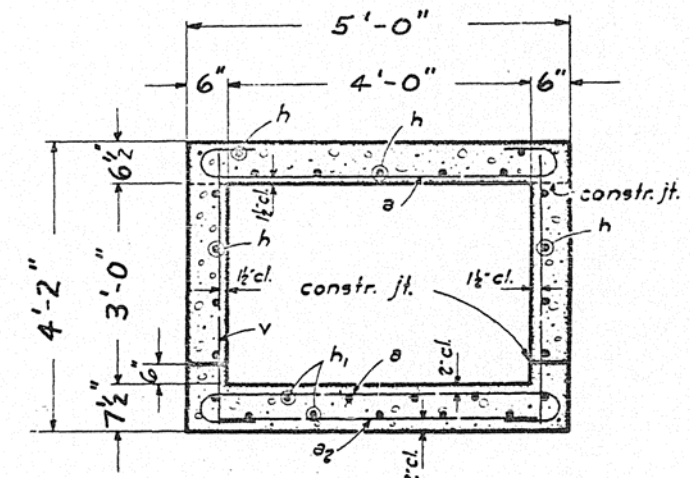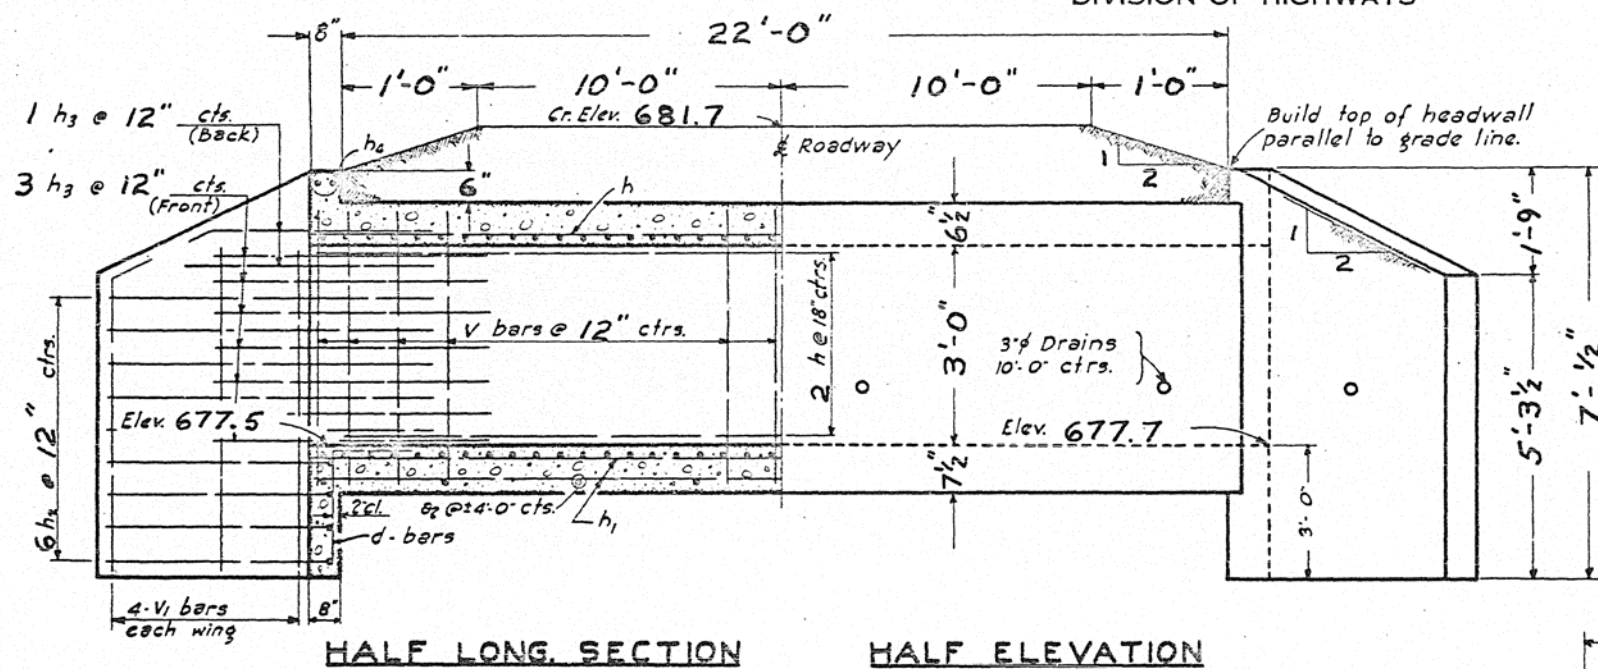

SECTION THRU BARREL

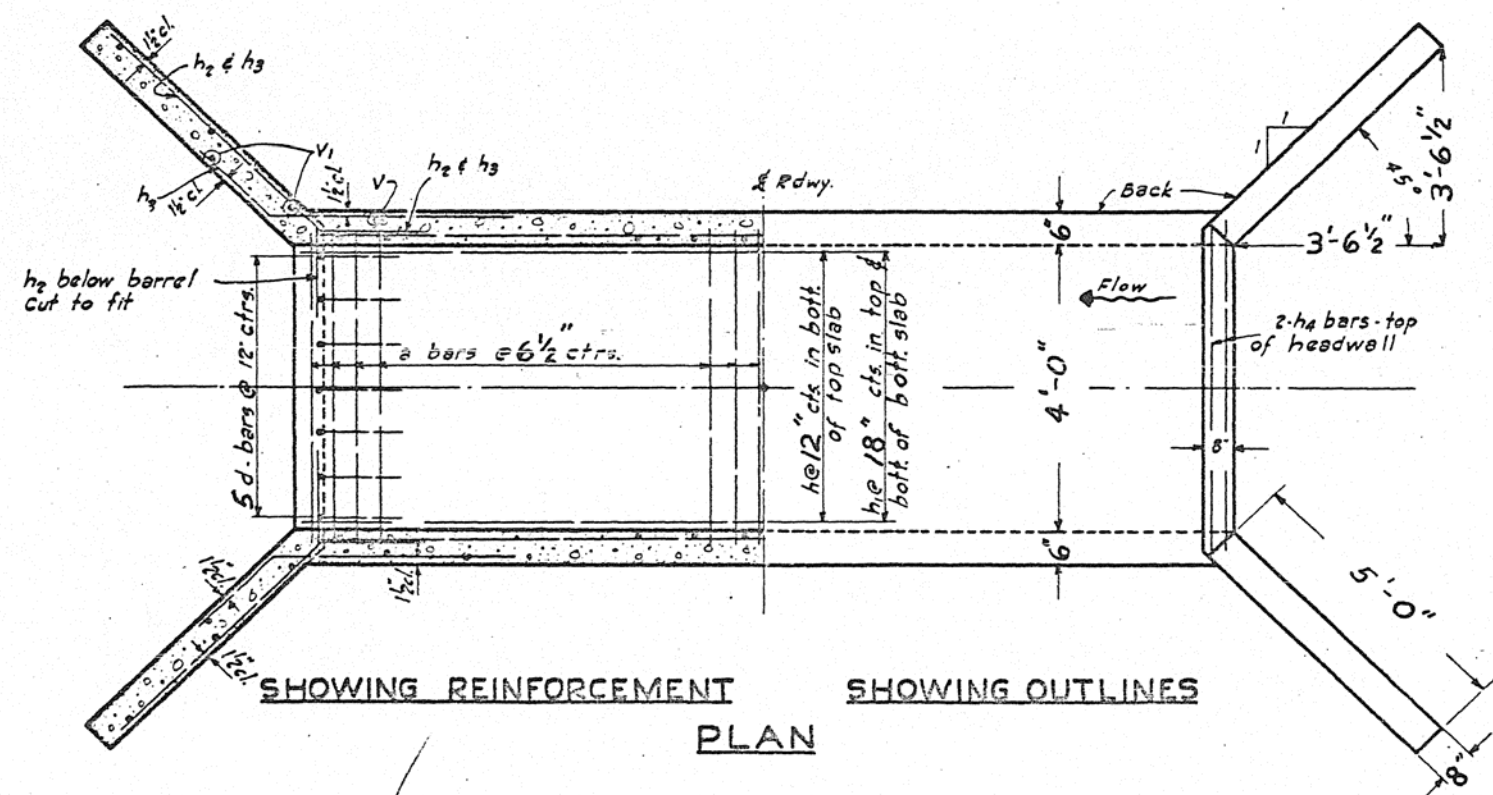

BILL OF MATERIAL

BAR	NO.	SIZE	LENGTH
a	84	#5	6'-0"
a ₂	6	#4	4'-3"
h	10	#4	22'-6"
h ₁	7	#4	22'-6"
h ₂	24	#4	6'-6"
h ₃	16	#4	5'-0"
h ₄	4	#6	4'-3"
v	50	#4	3'-9"
v ₁	16	#4	6'-3"
d	10	#4	4'-6"

class "X" Concrete cu.yds.	11.2
Reinforcement bars Lbs.	1,200

NOTE:—All bars shall be round ASTM A305-49.
The size number is the number of
 $\frac{1}{8}$ inches in the nominal diameter.

SPECIAL CULVERT DESIGN 4'x3' BOX
SEC. 10W-1(11,12)W & 11RS(10,12)RS-1
MACON COUNTY
32' RT. STA. 363+25

$f_s = 20,000 \text{ #/yr}$
 $f_c = 1200 \text{ #/yr}$
 $n = 10$
H 15 LOADING

STANDARD 2020

STANDARD	COMPUTED
	CHECKED
	DRAWN - C.L. HAZLETT
	CHECKED
SPECIAL	ASSEMBLED R.G.S.
	CHECKED C.J.B.

ReInf. Revised - 11-50 - J.S.M.

EXAMINED 7-1 1960
V. M. Konic
DESIGN ENGINEER
PASSED
ENGINEER OF DESIGN
APPROVED



GENERAL NOTES

Class X concrete shall be used throughout. At least six feet of Barrel shall be poured monolithically with wing walls. Exposed edges shall be beveled 3". For backfilling & embankments see St'd. Spec's. Tilt hook of "a" bars, if necessary, to obtain 16" minimum clearance at top of hook.




STATE OF ILLINOIS
DEPARTMENT OF PUBLIC WORKS & BUILDINGS
DIVISION OF HIGHWAYS

ROAD DISTRICT	SECTION	COUNTY	TOTAL SHEETS	SHEET NO.	SHEET NO.
F.A.S. 540	*	MACON & PIATT	106	32	
FED. ROAD DIST. NO. 7		ILLINOIS	FED. AID PROJECT 5-835()		

*10W-1(11,12)W

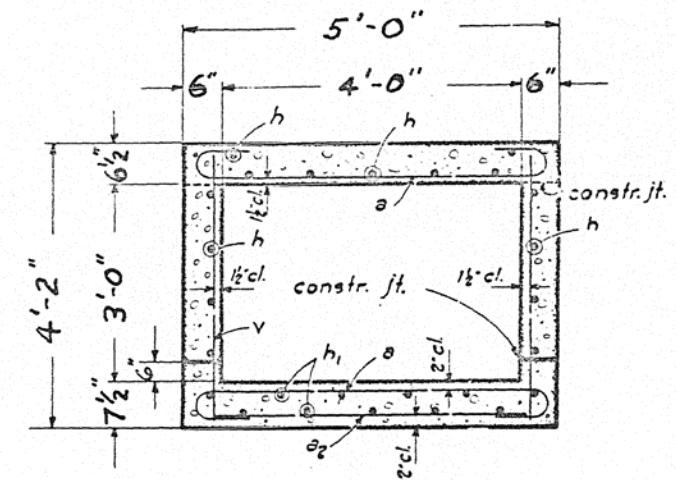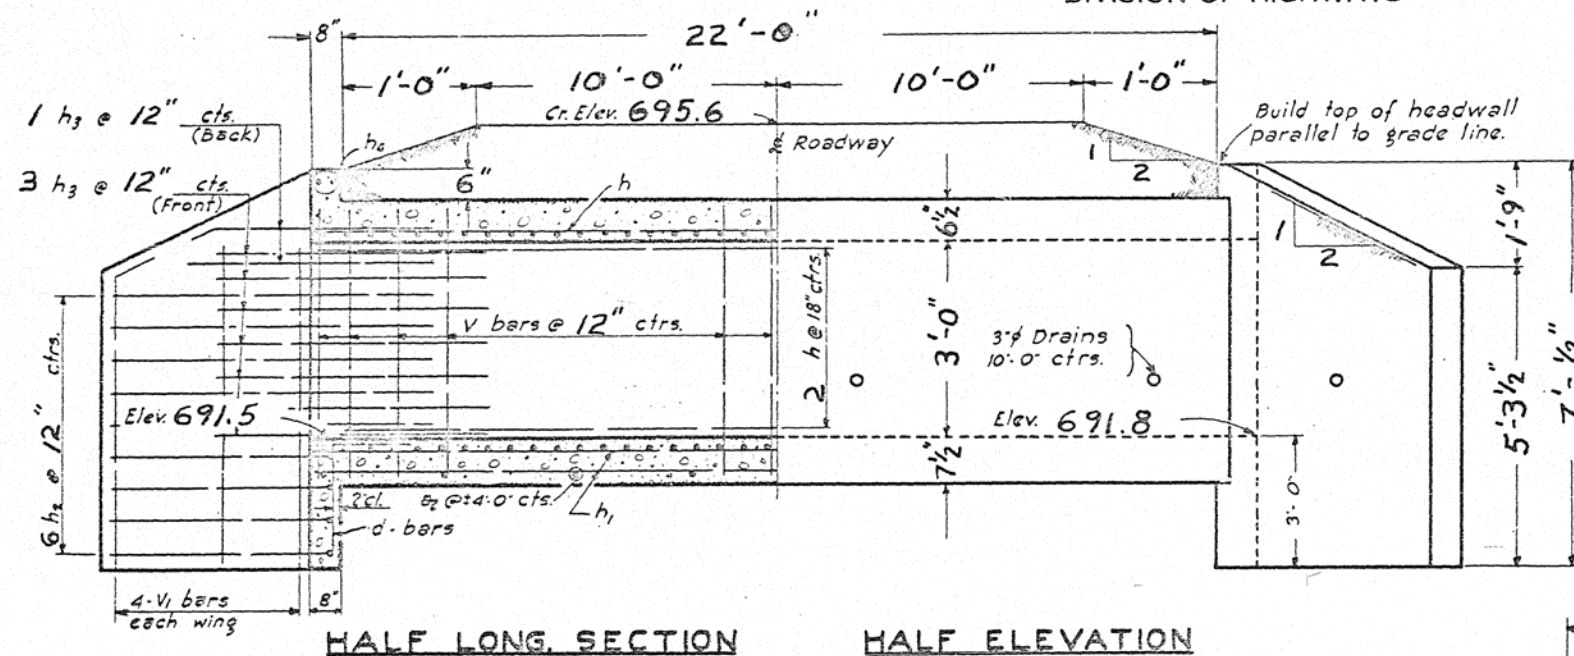

SECTION THRU BARREL

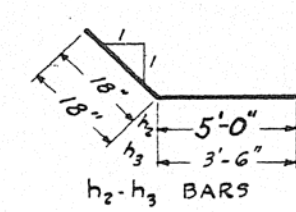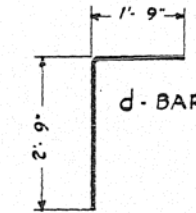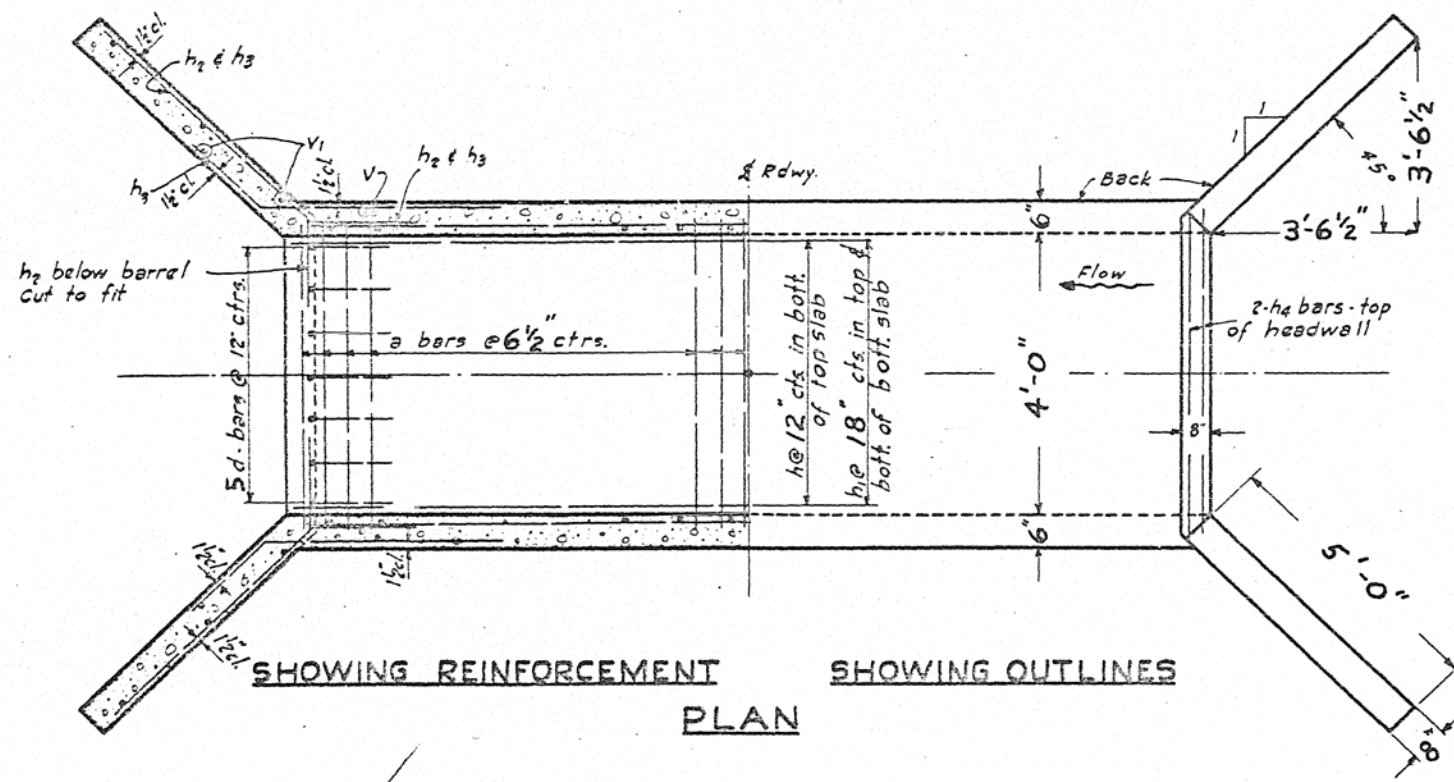

BILL OF MATERIAL

BAR	NO.	SIZE	LENGTH
a	84	#5	6'-0"
a2	6	#4	4'-3"
h	10	#4	22'-6"
h1	7	#4	22'-6"
h2	24	#4	6'-6"
h3	16	#4	5'-0"
h4	4	#6	4'-3"
v	50	#4	3'-9"
v1	16	#4	6'-3"
d	10	#4	4'-6"

Class 'X' Concrete cu. yds. 11.2
Reinforcement bars Lbs. 1,200


NOTE: All bars shall be round ASTM A305-49.
The size number is the number of
1/8 inches in the nominal diameter.

GENERAL NOTES
Class X concrete shall be used throughout.
At least six feet of Barrel shall be poured
monolithically with wing walls.
Exposed edges shall be beveled 3/4".
For backfilling & embankments see std. Spec's.
Tilt hook of 'a' bars, if necessary, to obtain 1/4"
minimum clearance at top of hook.



fs = 20,000 psi
fc = 1200 psi
n = 10
SPECIAL CULVERT DESIGN 4'x3' BOX
SEC. 10W-1(11,12)W & 11 RS (10,12) RS-1
MACON COUNTY
34' RT. STA. 378+10

STANDARD	COMPUTED	EXAMINED	7-1	1960
	CHECKED			
	DRAWN			
	CHECKED			
SPECIAL	ASSEMBLED			
	CHECKED			

Reinf. Revised - 11-50 - J.S.M.

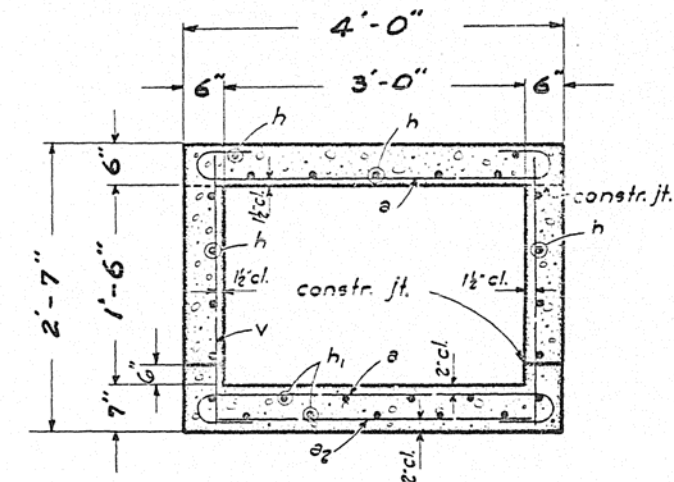

SECTION THRU BARREL

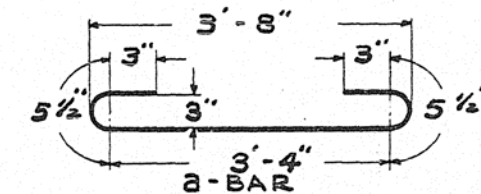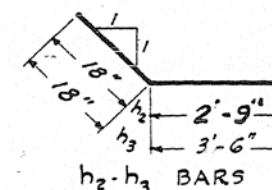

BILL OF MATERIAL

BAR	NO.	SIZE	LENGTH
a	70	#4	4'-9"
a ₂	6	#4	3'-3"
h _L	9	#4	8'-0"
h _R	9	#4	8'-6"
h _{1L}	7	#4	8'-0"
h ₂	20	#4	4'-3"
h ₃	12	#4	5'-0"
h ₄	4	#6	3'-3"
h _{1R}	7	#4	8'-6"
v	40	#4	2'-3"
v ₁	16	#2	5'-0"
d	8	#4	4'-6"

Class "X" Concrete cu.Yds.	5.4
Reinforcement bars Lbs.	670

NOTE:—All bars shall be round ASTM A305-49.
The size number is the number of
 $\frac{1}{8}$ inches in the nominal diameter.

SPECIAL CULVERT EXTENSION
3'x1.5' BOX, SECTION 14 (11,12) AND RS (10,12) RS-1
MACON COUNTY
LT & RT STA 503+04

$$\begin{aligned} f_s &= 20,000 \text{ \$/sq} \\ f_c &= 1200 \text{ \$/sq} \\ n &= 10 \end{aligned}$$

H-20 LOADING

STANDARD	COMPUTED
	CHECKED
	DRAWN - C.L. HAZLETT
	CHECKED
SPECIAL	ASSEMBLED R.G.S.
	CHECKED .11 F

Reinf. Revised - 11-50-J.S.M.

EXAMINED 7.1 19 62
K. M. Romine
BRIDGE ENGINEER
PASSED
ENGINEER OF DESIGN
APPROVED


GENERAL NOTES

Class X concrete shall be used throughout. At least six feet of Barrel shall be poured monolithically with wing walls. Exposed edges shall be beveled $\frac{3}{4}$ ". For backfilling & embankments see St'd. Spec's. Tilt hook of "a" bars, if necessary, to obtain $1\frac{1}{2}$ " minimum clearance at top of hook.



STATE OF ILLINOIS
DEPARTMENT OF PUBLIC WORKS & BUILDINGS
DIVISION OF HIGHWAYS

SECTION	COUNTY	TOTAL SHEETS	SHEET NO.
F.A.S. # 540	MACON # PIATT	106	34
FED. ROAD DIST. NO. 7	ILLINOIS	FED. AID PROJECT 5-835(1)	




SHEET NO.
SHEETS

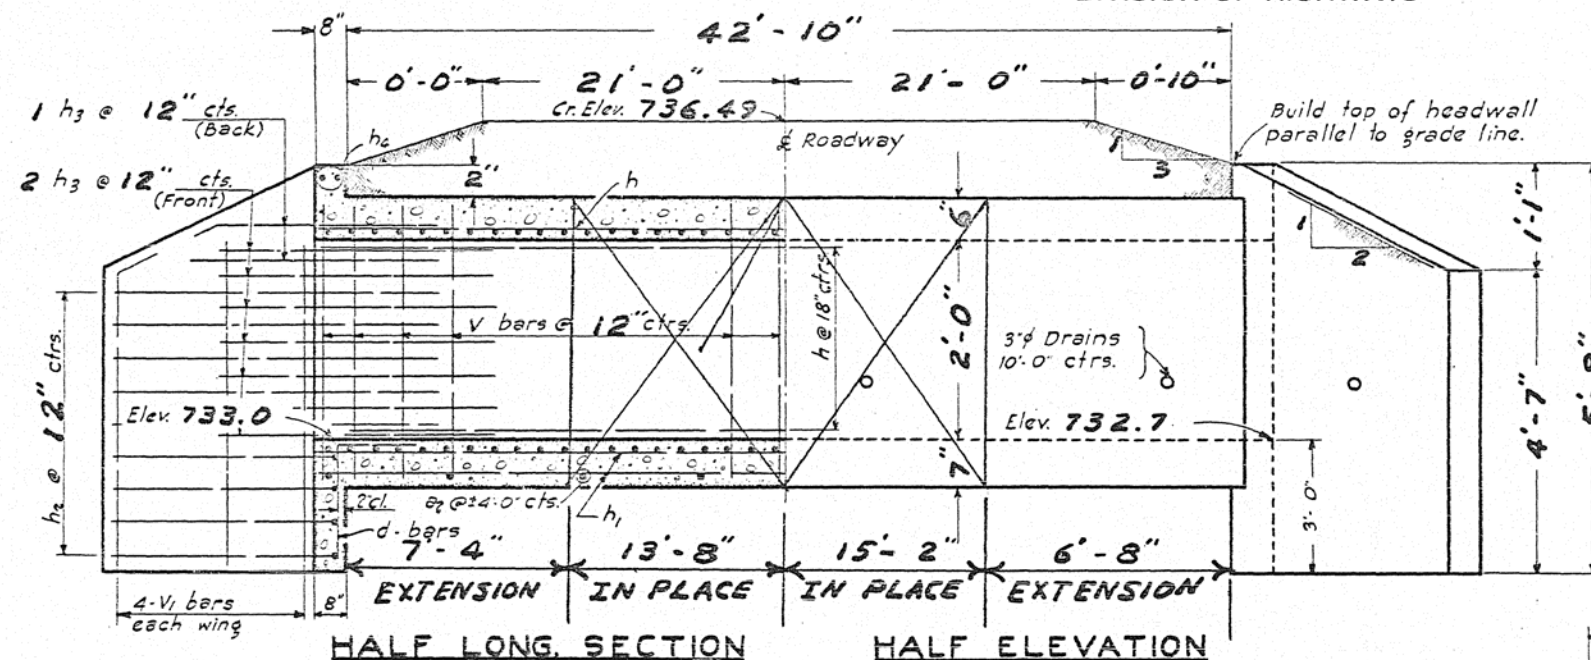

NOTE: REMOVE OLD HEADWALLS AND STRAIGHTEN OLD STEEL. TIE OLD STEEL TO NEW STEEL AS DIRECTED BY THE ENGINEER

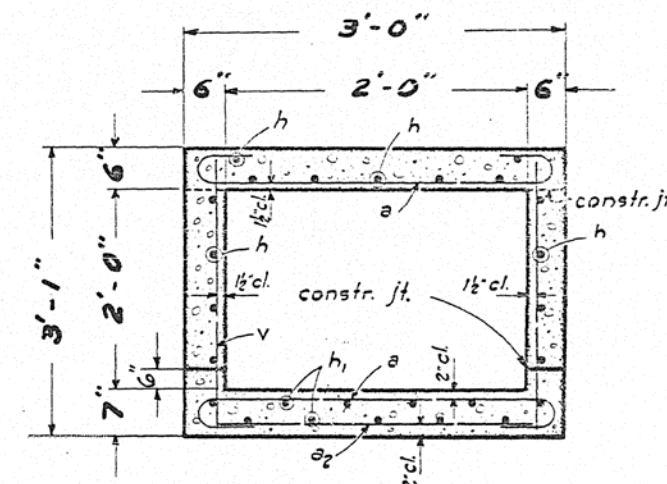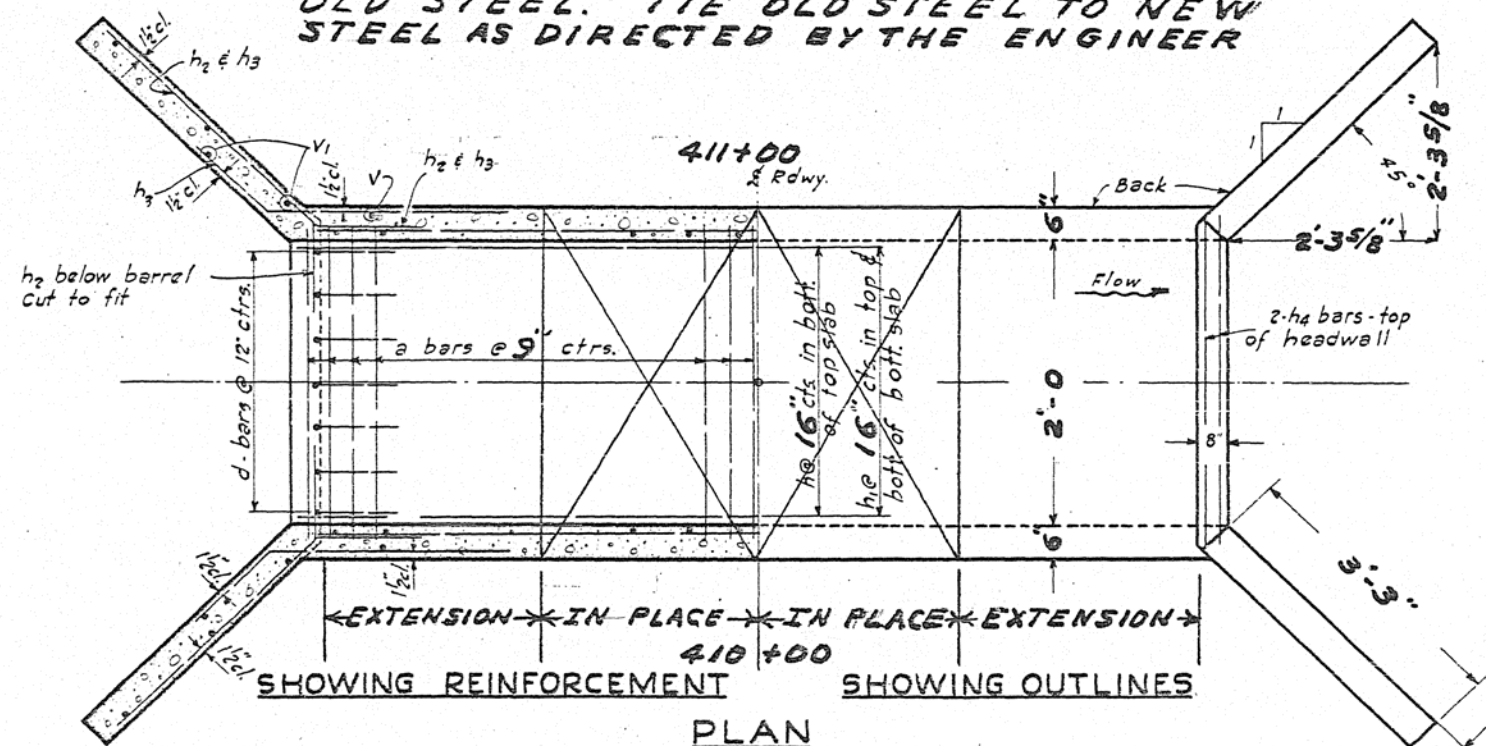

SECTION THRU BARREL

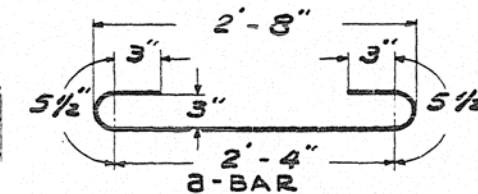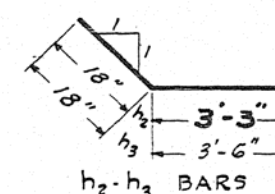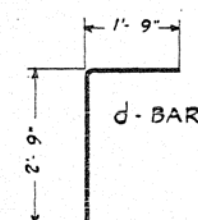

BILL OF MATERIAL

BAR	NO.	SIZE	LENGTH
a	42	#4	3'-9"
a2	6	#4	2'-3"
h2	8	#4	7'-9"
h3	8	#4	7'-0"
h4	5	#4	7'-9"
h5	20	#4	4'-9"
h6	12	#4	5'-0"
h7	4	#6	2'-3"
h8	5	#4	7'-0"
v	36	#4	2'-9"
v1	16	#4	5'-3"
d	6	#4	4'-6"

Class 'X' Concrete cu. yds. 4.9
Reinforcement bars Lbs. 500

NOTE: All bars shall be round ASTM A305-49. The size number is the number of 1/8 inches in the nominal diameter.

SPECIAL CULVERT EXTENSION
2' X 2' BOX, SEC. 10W-1(10,12)W9 HRS(10,12)RS-1
MACON COUNTY
LT. & RT. STA. 410+50

fs = 20,000 #/sq.
fc = 1200 #/sq.
n = 10
H-20 LOADING

STANDARD	COMPUTED
	CHECKED
	DRAWN - C.L. HAZLETT
	CHECKED
SPECIAL	ASSEMBLED R.G.S.
	CHECKED J.L.F.

EXAMINED	7-11-10
PASSED	
APPROVED	

GENERAL NOTES

Class X concrete shall be used throughout. At least six feet of Barrel shall be poured monolithically with wing walls. Exposed edges shall be beveled 3". For backfilling & embankments see std. Spec's. Tilt hook of "a" bars, if necessary, to obtain 1/2" minimum clearance at top of hook.



Reinf. Revised - 11-30-J.S.M.

STANDARD 2020

STATE OF ILLINOIS
DEPARTMENT OF PUBLIC WORKS & BUILDINGS
DIVISION OF HIGHWAYS




ROAD DIST. NO.	SECTION	COUNTY	TOTAL SHEETS	SHEET NO.	SHEET NO.
F.A.S. 540	MACON PIATT	106	35		
ILLINOIS	FFD. AND PROJECT	5-835			

*10W-1(11,12)W

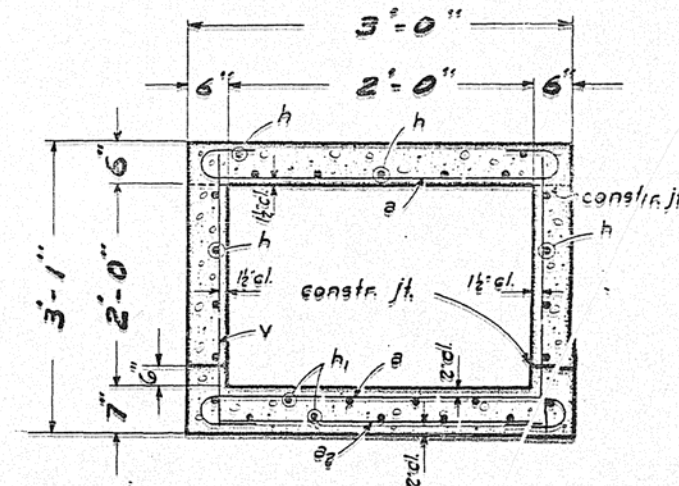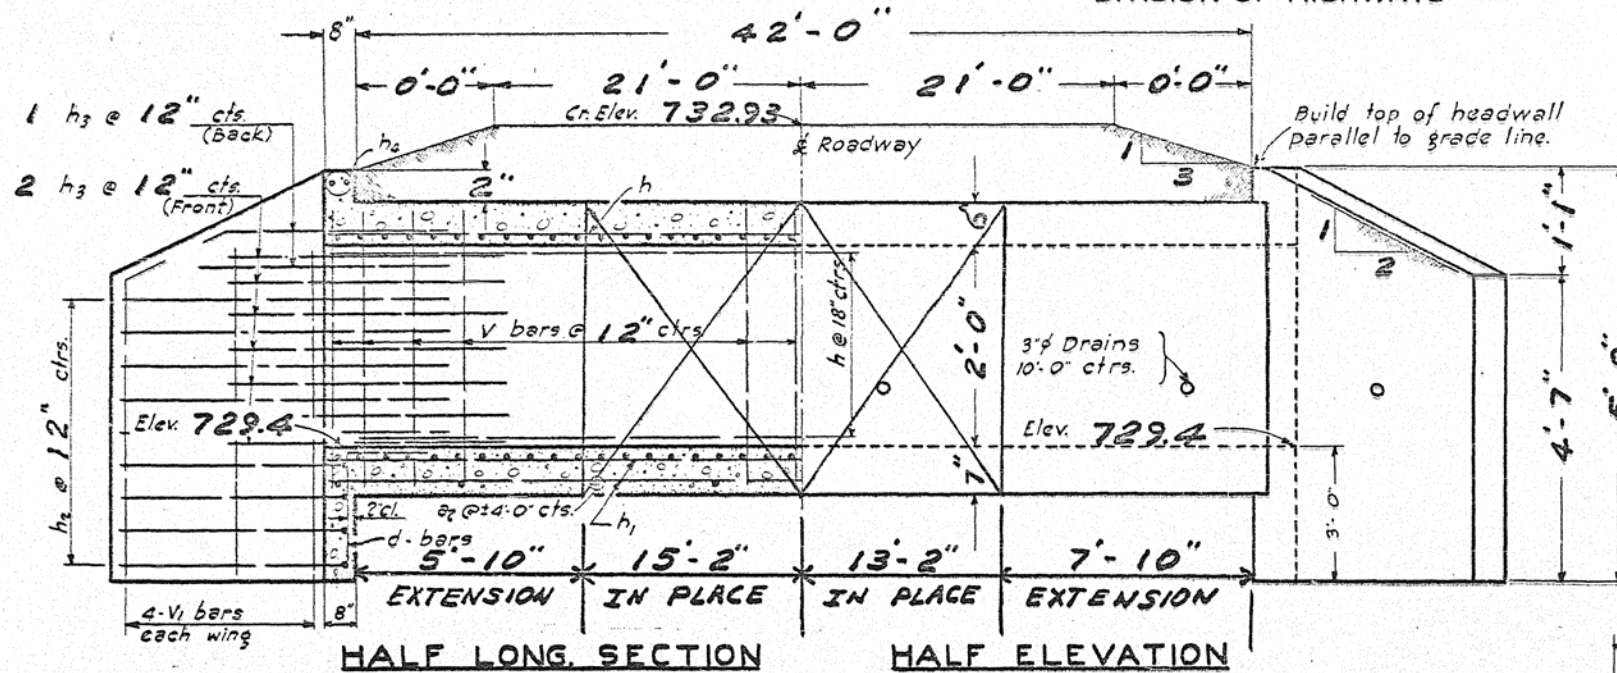

SECTION THRU BARREL

NOTE: REMOVE OLD HEADWALLS AND STRAIGHTEN OLD STEEL TIE OLD STEEL TO NEW STEEL AS DIRECTED BY THE ENGINEER

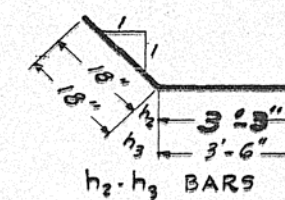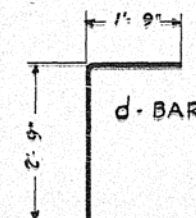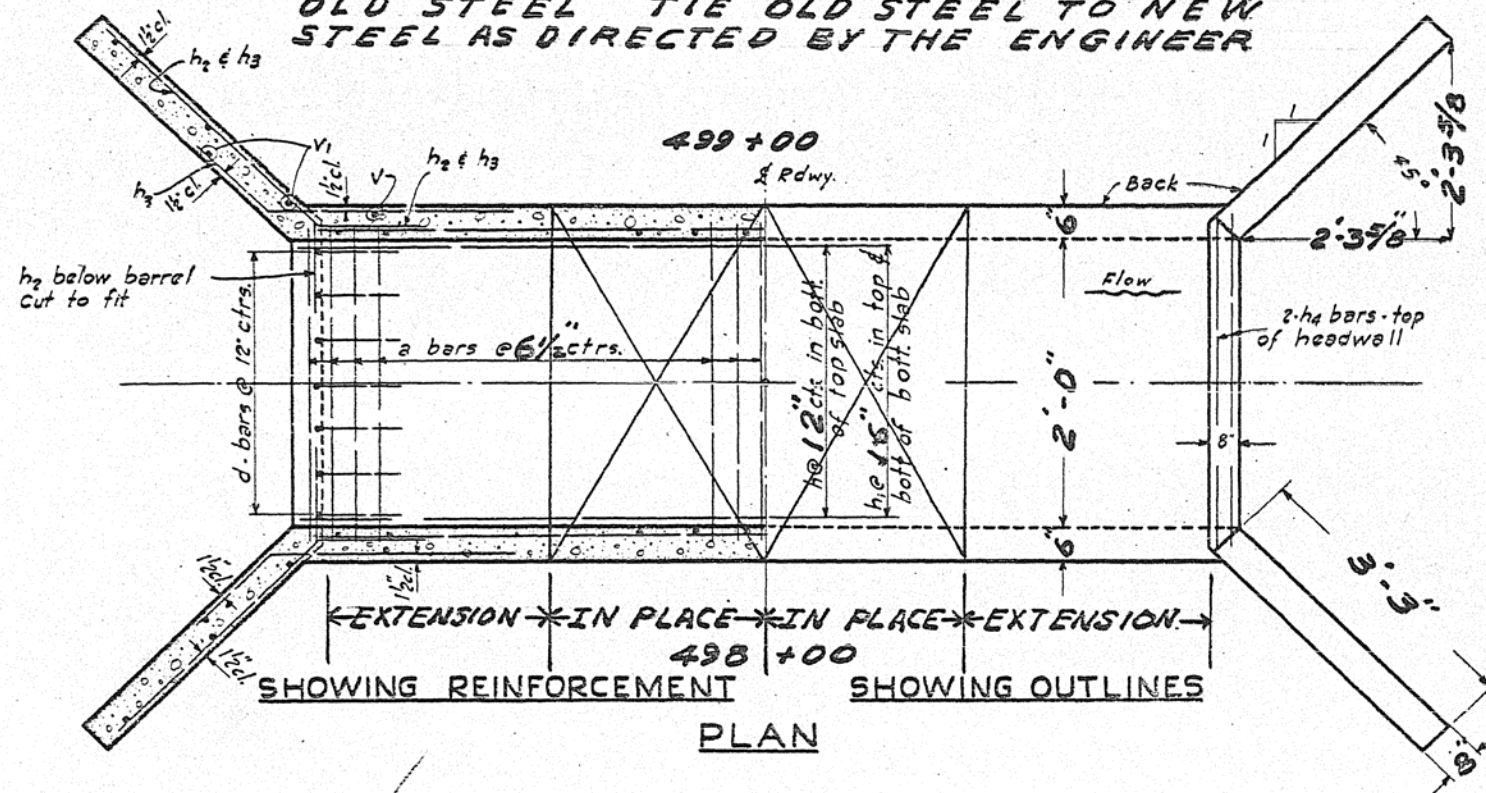

BILL OF MATERIAL

BAR	NO.	SIZE	LENGTH
a	56	#5	4'-0"
a2	5	#4	2'-3"
h1	8	#4	6'-3"
h2	8	#4	8'-3"
h3	5	#4	6'-3"
h4	20	#4	4'-9"
h5	12	#4	5'-0"
h6	4	#6	2'-3"
h7	5	#4	8'-3"
V	36	#4	2'-9"
V1	16	#4	5'-3"
d	6	#4	4'-6"

Class 'X' Concrete cu.yds. 4.8
Reinforcement bars Lbs. 620

NOTE: All bars shall be round ASTM A305-49. The size number is the number of 1/8 inches in the nominal diameter.

SPECIAL CULVERT EXTENSION
2'X2' BOX SEC. 10W-1(11,12)W/11RS(10,12)RS-1
PIATT COUNTY
LT. ART. STA. 498+55

STANDARD	COMPUTED	
	CHECKED	
	DRAWN	-C.L. HAZLETT-
	CHECKED	
SPECIAL	ASSEMBLED	R.G.S.
	CHECKED	J.L.F.

EXAMINED	7-1	1960
	V.M. [Signature]	DESIGN ENGINEER
PASSED		
APPROVED		ENGINEER OF DESIGN
		CHIEF HIGHWAY ENGINEER

GENERAL NOTES



Class X concrete shall be used throughout. At least six feet of Barrel shall be poured monolithically with wing walls. Exposed edges shall be beveled 3/4". For backfilling & embankments see S.D. Spec's. Tilt hook of "a" bars, if necessary, to obtain 1/8" minimum clearance at top of hook.

STATE OF ILLINOIS
DEPARTMENT OF PUBLIC WORKS & BUILDINGS
DIVISION OF HIGHWAYS

REVISION	SECTION	COUNTY	TOTAL SHEETS	SHEET NO.
540	* MACOM & PIATT	106	36	




SHEET NO.
SHEETS

* 10W-1(11,12)W

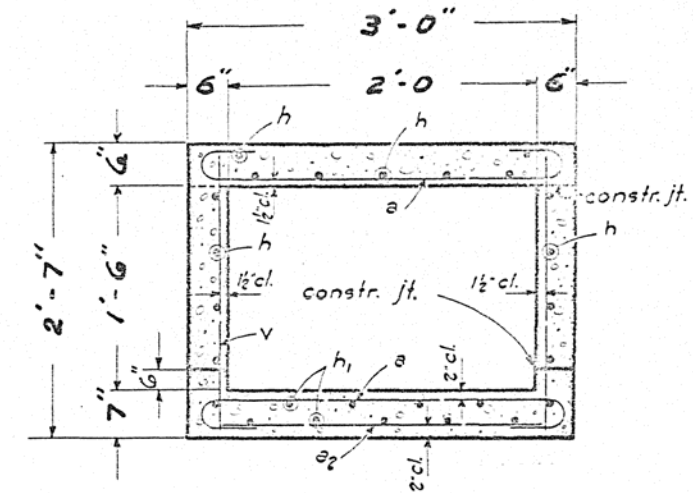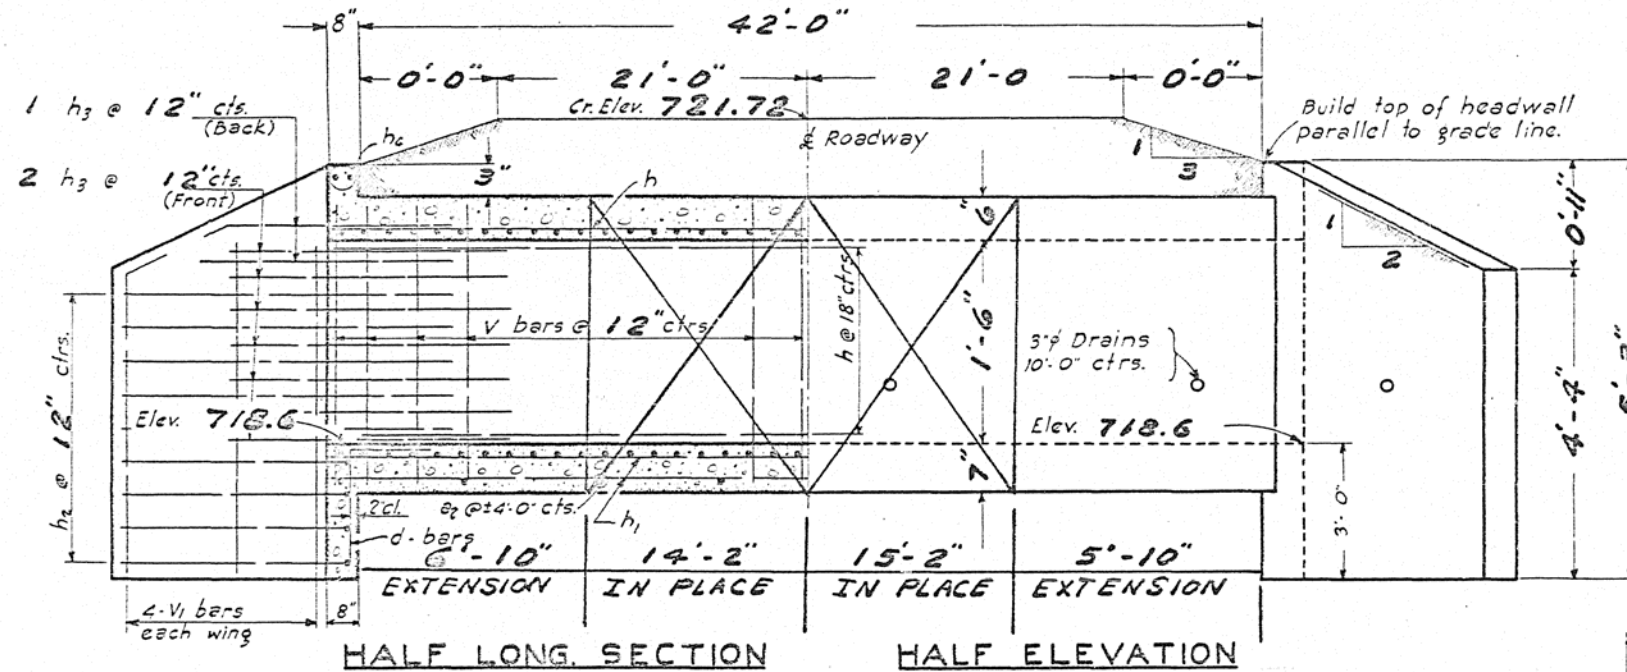

SECTION THRU BARREL

NOTE: REMOVE OLD HEADWALLS AND STRAIGHTEN OLD STEEL TIE OLD STEEL TO NEW STEEL AS DIRECTED BY THE ENGINEER

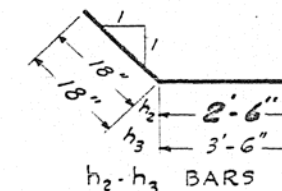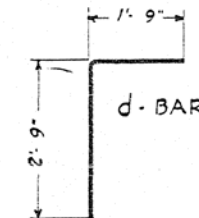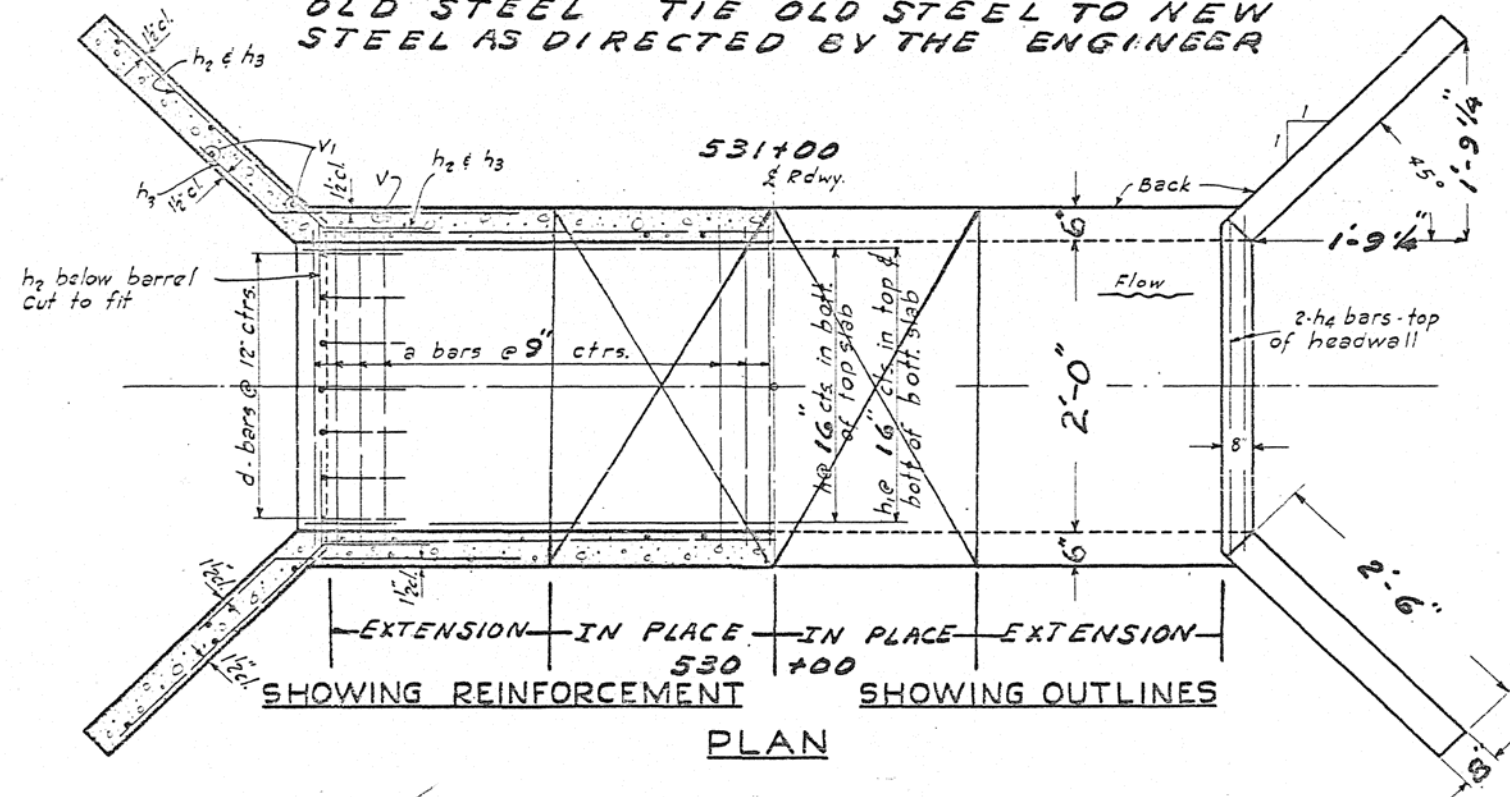

BILL OF MATERIAL

BAR	NO.	SIZE	LENGTH
a	38	#4	3'-9"
a2	4	#4	2'-3"
h1L	8	#4	7'-3"
h1R	8	#4	6'-3"
h2	20	#4	7'-3"
h3	12	#4	4'-0"
h4	4	#6	5'-0"
h1R	5	#4	2'-3"
V	34	#4	6'-3"
V1	16	#4	2'-3"
d	6	#4	4'-9"

Class 'X' Concrete cu. Yds. 3.9
Reinforcement bars Lbs. 450

NOTE: All bars shall be round ASTM A305-49. The size number is the number of 1/8 inches in the nominal diameter.

fs = 20,000 psi
fc = 1200 psi
n = 10
SPECIAL CULVERT EXTENSION
2' x 1.5' BOX, SEC. 10W-1(11,12)W & 11R5(10,12)R5-1
PIATT COUNTY
LT. & RT. STA. 530+11

STANDARD	COMPUTED
	CHECKED
	DRAWN - C.L. HAZLETT
	CHECKED
SPECIAL	ASSEMBLED R.G.S.
	CHECKED J.L.F.


EXAMINED	7-1
PASSED	
APPROVED	

GENERAL NOTES
Class X concrete shall be used throughout. At least six feet of Barrel shall be poured monolithically with wing walls. Exposed edges shall be beveled 3". For backfilling & embankments see std. Spec's. Tilt hook of "a" bars, if necessary, to obtain 1/2" minimum clearance at top of hook.

FIRM SURVEY	SUBMITTAL NOTES	DATE BY	STARBUCK
			7/1/68
			7/1/68
			7/1/68
NO. 2	NO. 2	NO. 2	NO. 2


ORIGINAL SURVEY	SUBMITTAL NOTES	DATE BY	
NO.	NO.	NO.	NO.

DATE NO.	SECTION	COUNTY	TOTAL SHEETS	SHEET NO.
1/63+00	1/12/68	MACON-PHATT	107	37
1/63+00	1/63+00			

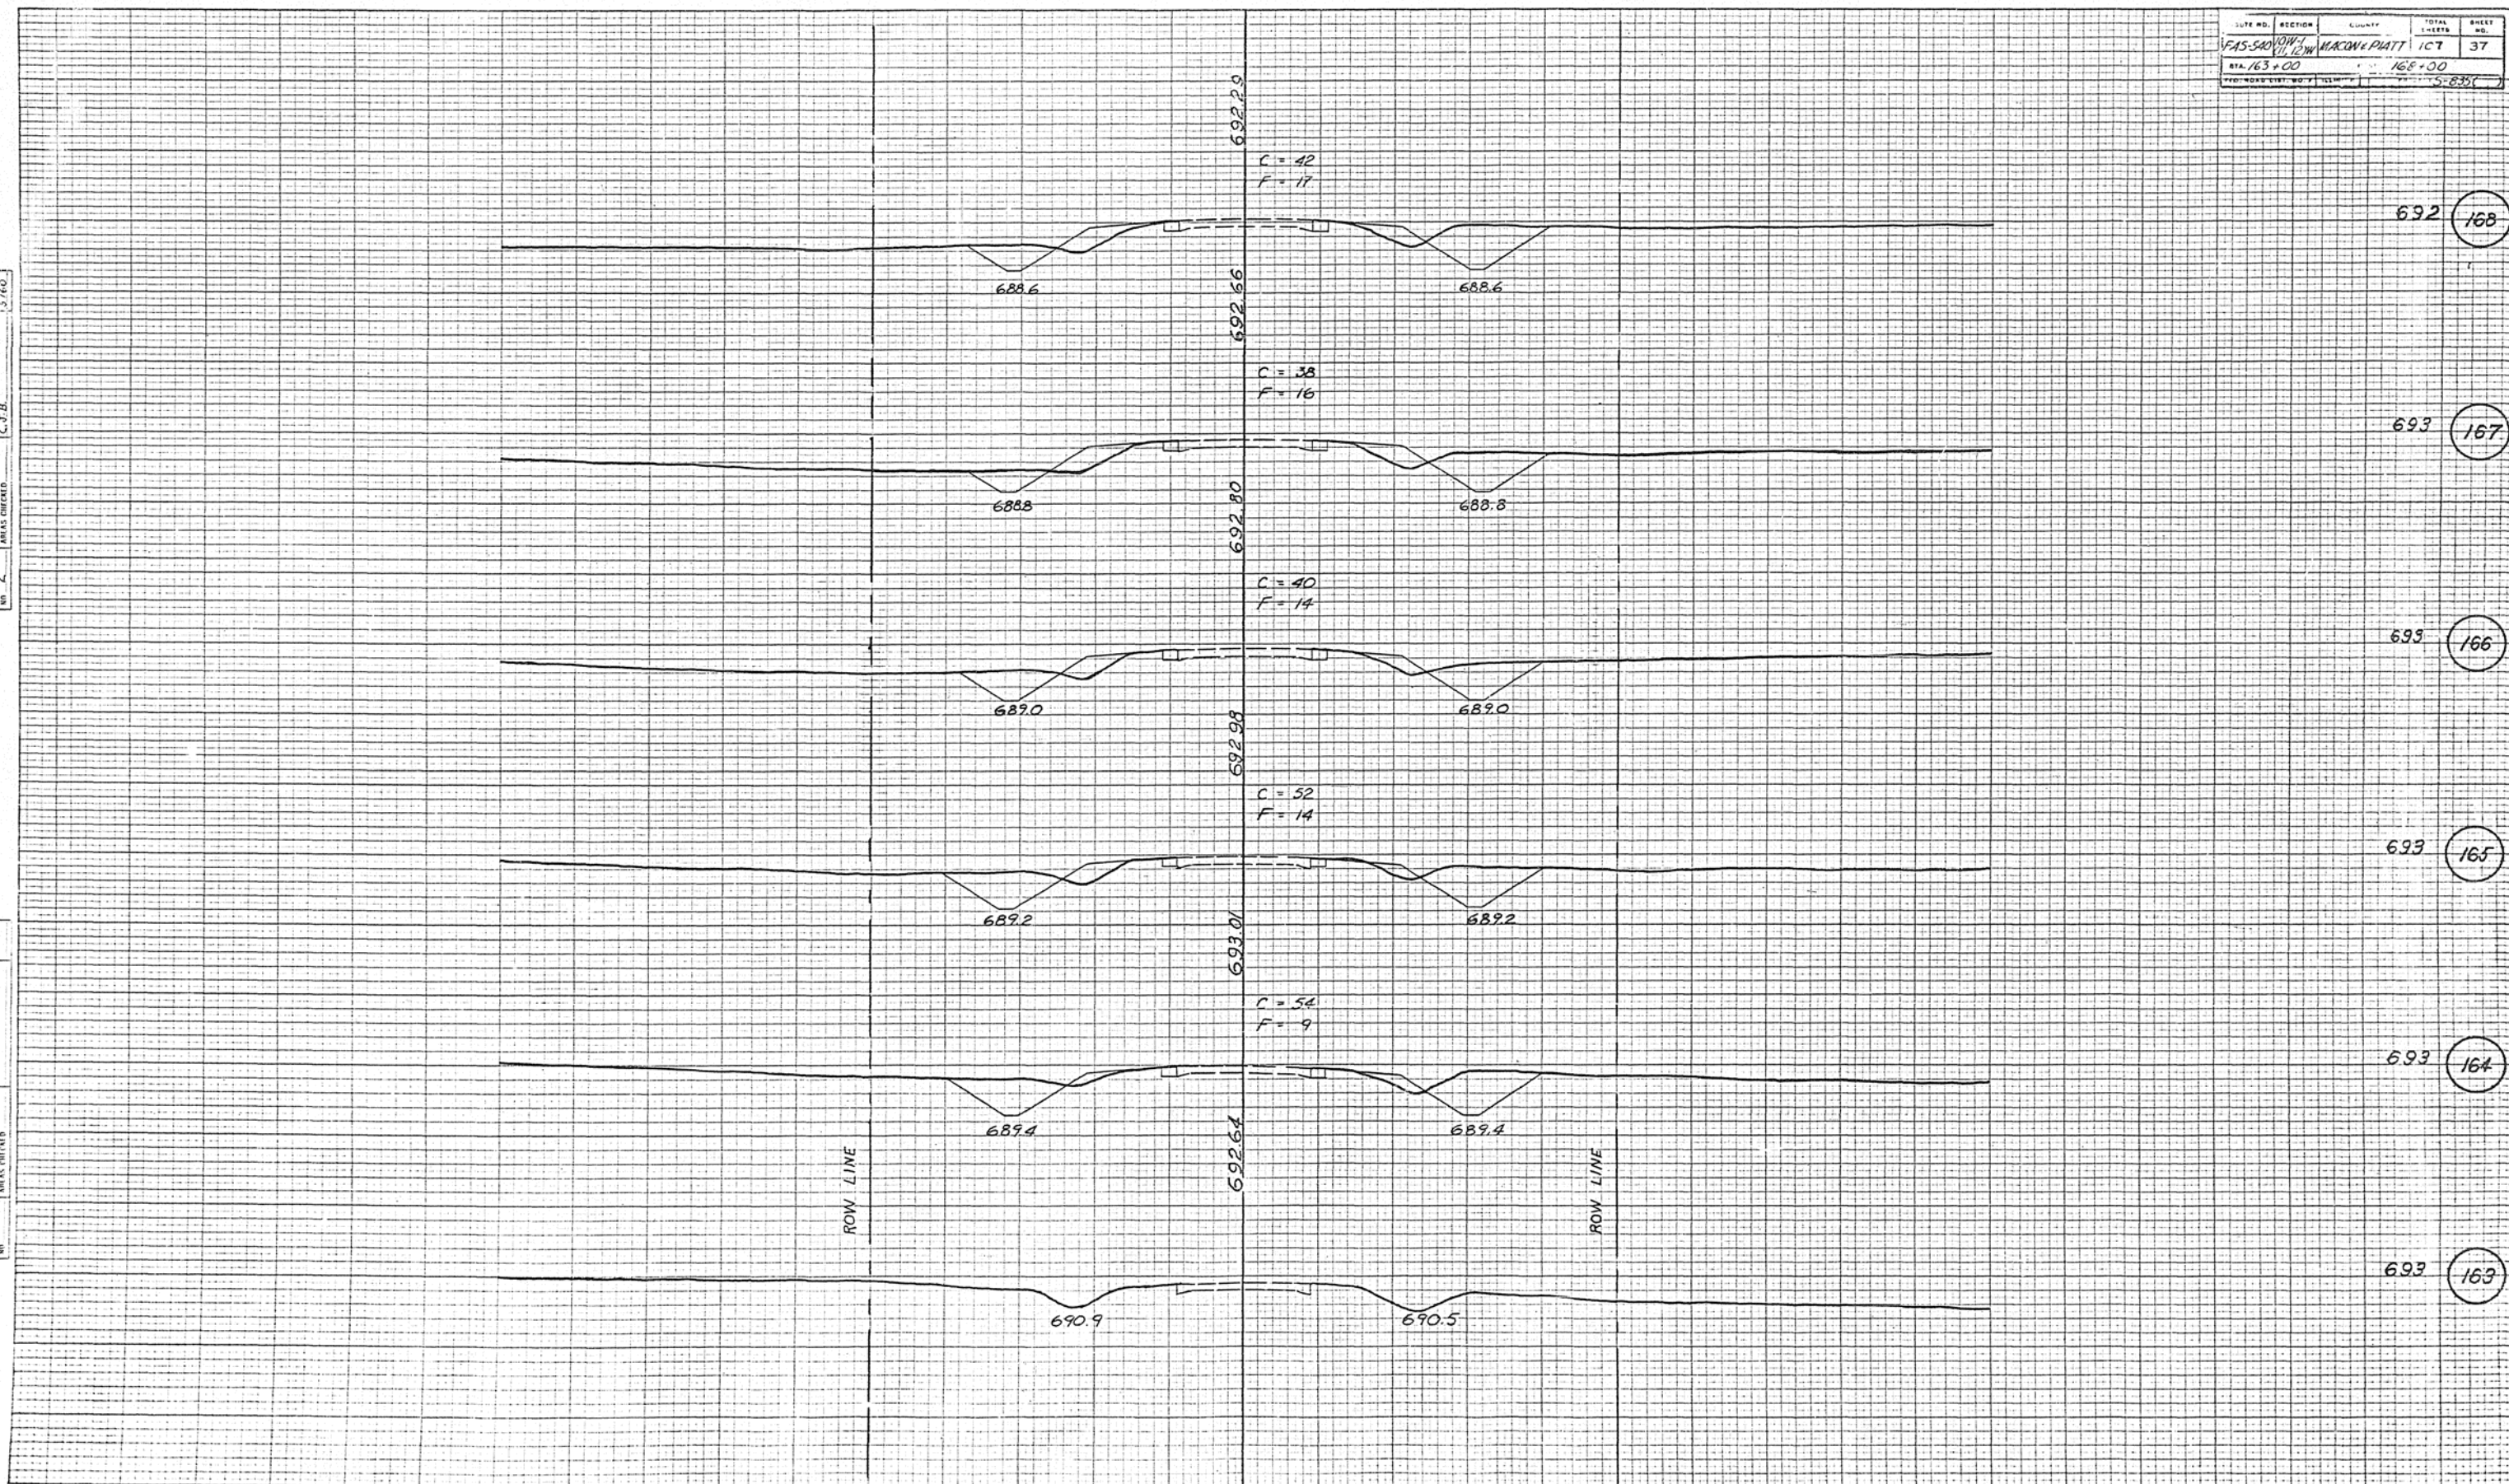

DATE 5/20/69
BY J. B. BUCK
SURVEY NO. 2
FINAL SURVEY
NOTE BOOK
NO. 2

DATE
BY
ORIGINAL SURVEY
NOTE BOOK
NO.

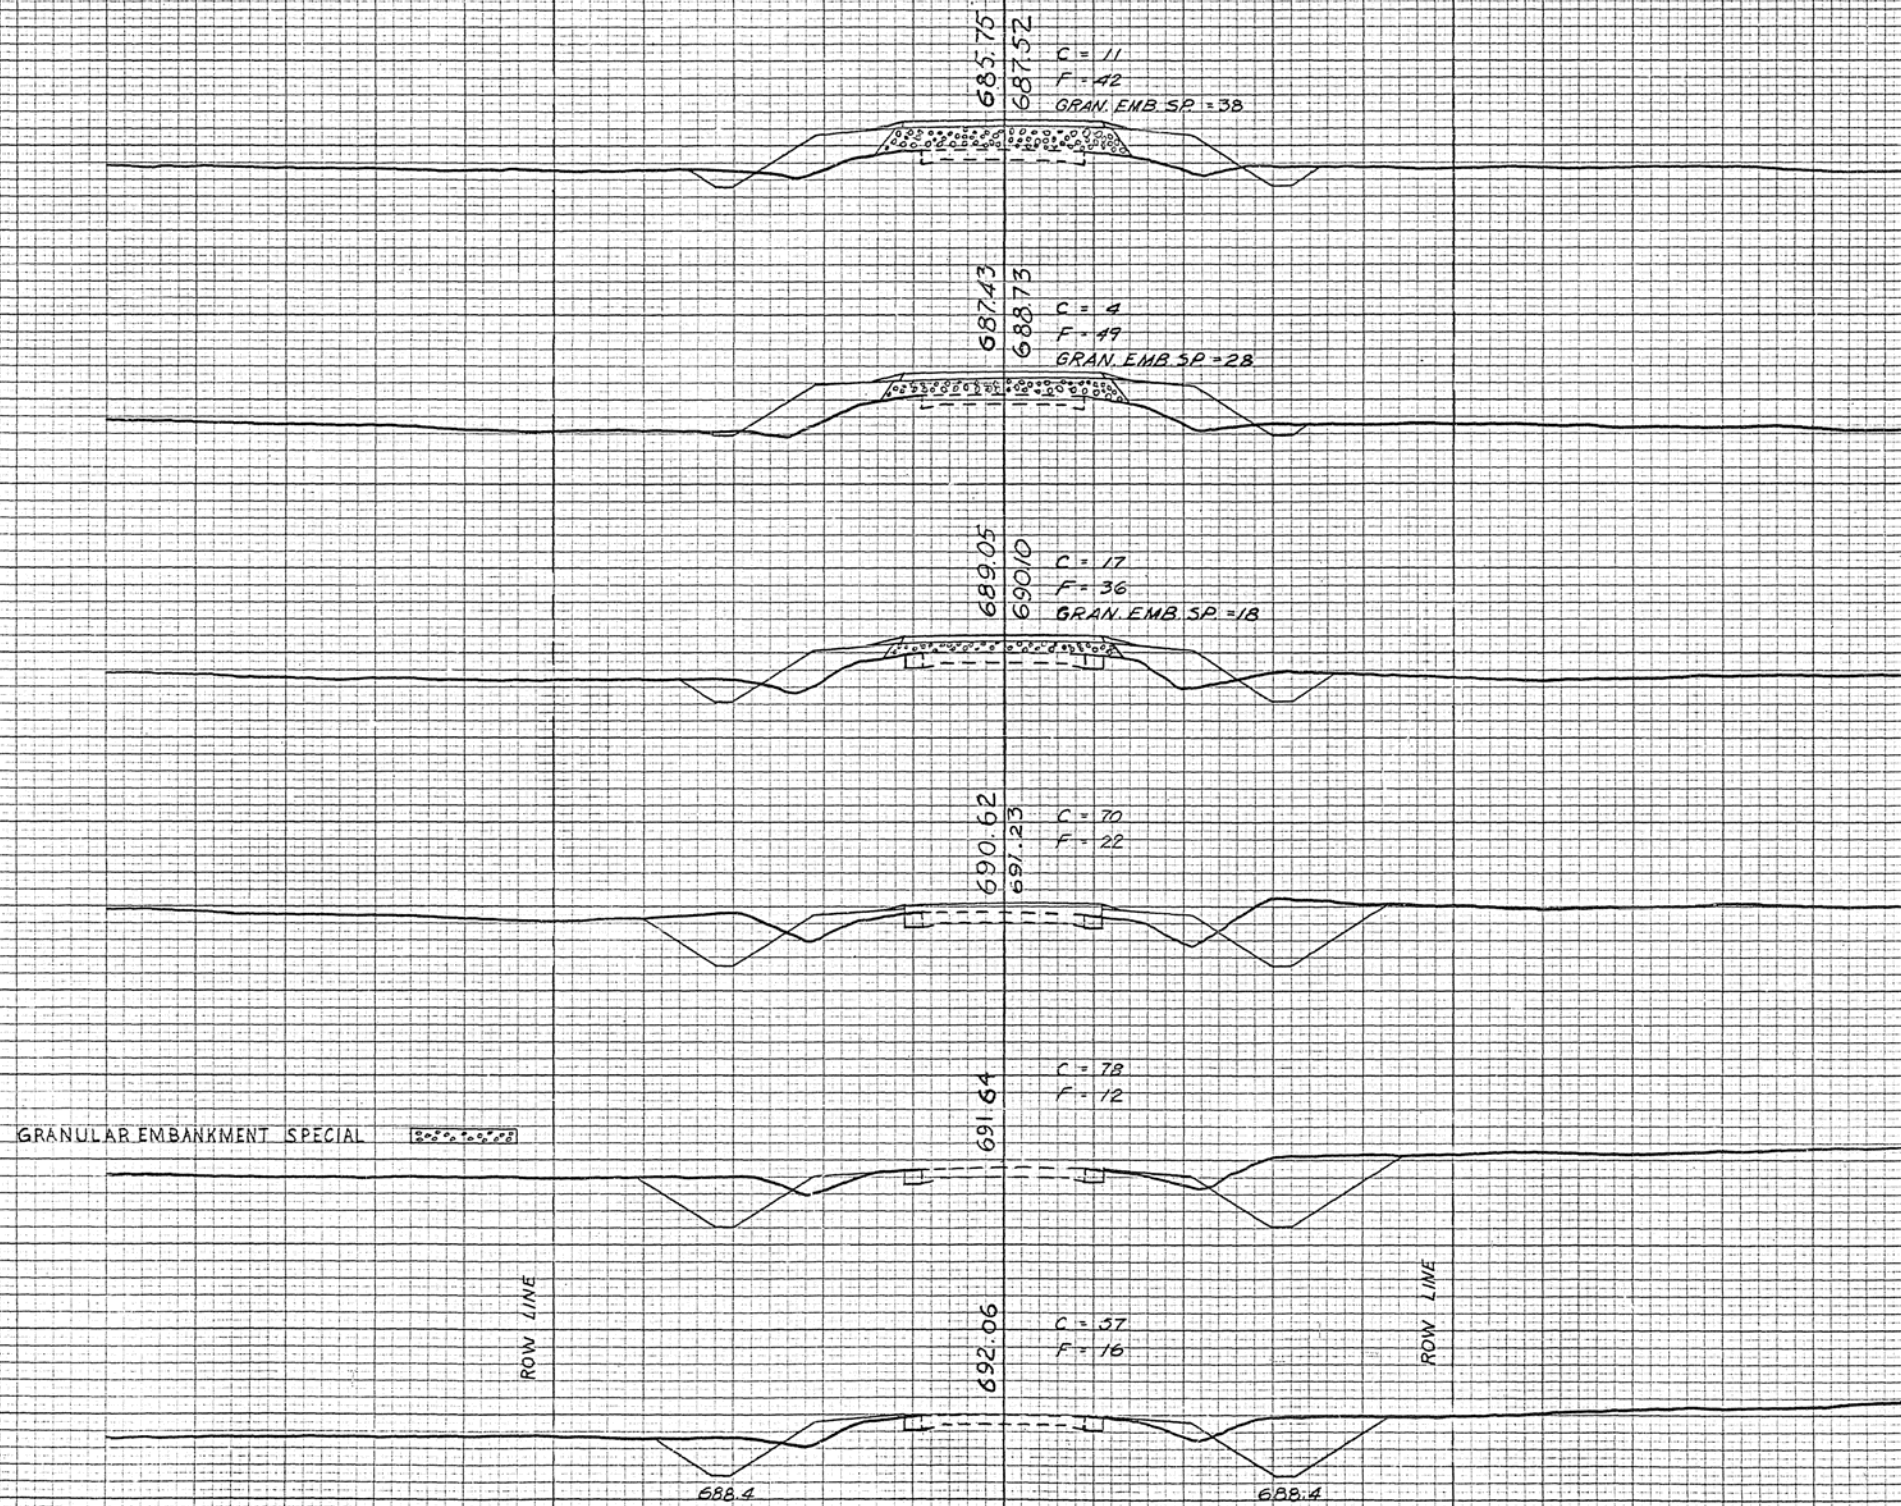

686 (174)

687 (173)


689 (172)

691 (171)

692 (170)

692 (169)

FILE NO.	SECTION	COUNTY	TOTAL SHEETS	SHEET NO.
FAS-543	10W-1 (11,12)W	WAGON PLATT	107	40
STA. 181+00		TO STA. 166+00		
TYPED AND DRAWN BY: J. J. JELINEK		CHECKED BY: J. J. JELINEK		

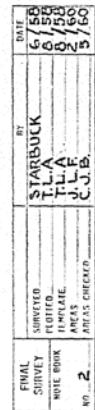

685 (186)

684 (185)

684 (184)

584 (183)

585 (102)

635 (181)


ORIGINAL SURVEY NOTE BOOK	SUSPECTED PLOTTED TEMPLATE AREAS	BY	DATE
NO			

NO.	SECTION	COUNTY	TOTAL SHEETS	SHEET NO.
FAS-540	LOW-1 (U. 12) W	MACON & PIATT	107-	42
STA. 193+00		TO STA. 198+00		
FED. ROAD DIST. NO. 1		ILLINOIS	PROJECT NO. 6356	



DATE	BY	FINAL SURVEY	NOTED	AREAS CHECKED
10-1-00	STARBUCK	10-1-00	10-1-00	10-1-00
10-1-00	10-1-00	10-1-00	10-1-00	10-1-00
10-1-00	10-1-00	10-1-00	10-1-00	10-1-00
10-1-00	10-1-00	10-1-00	10-1-00	10-1-00

DATE	BY	ORIGINAL SURVEY	NOTED	AREAS CHECKED

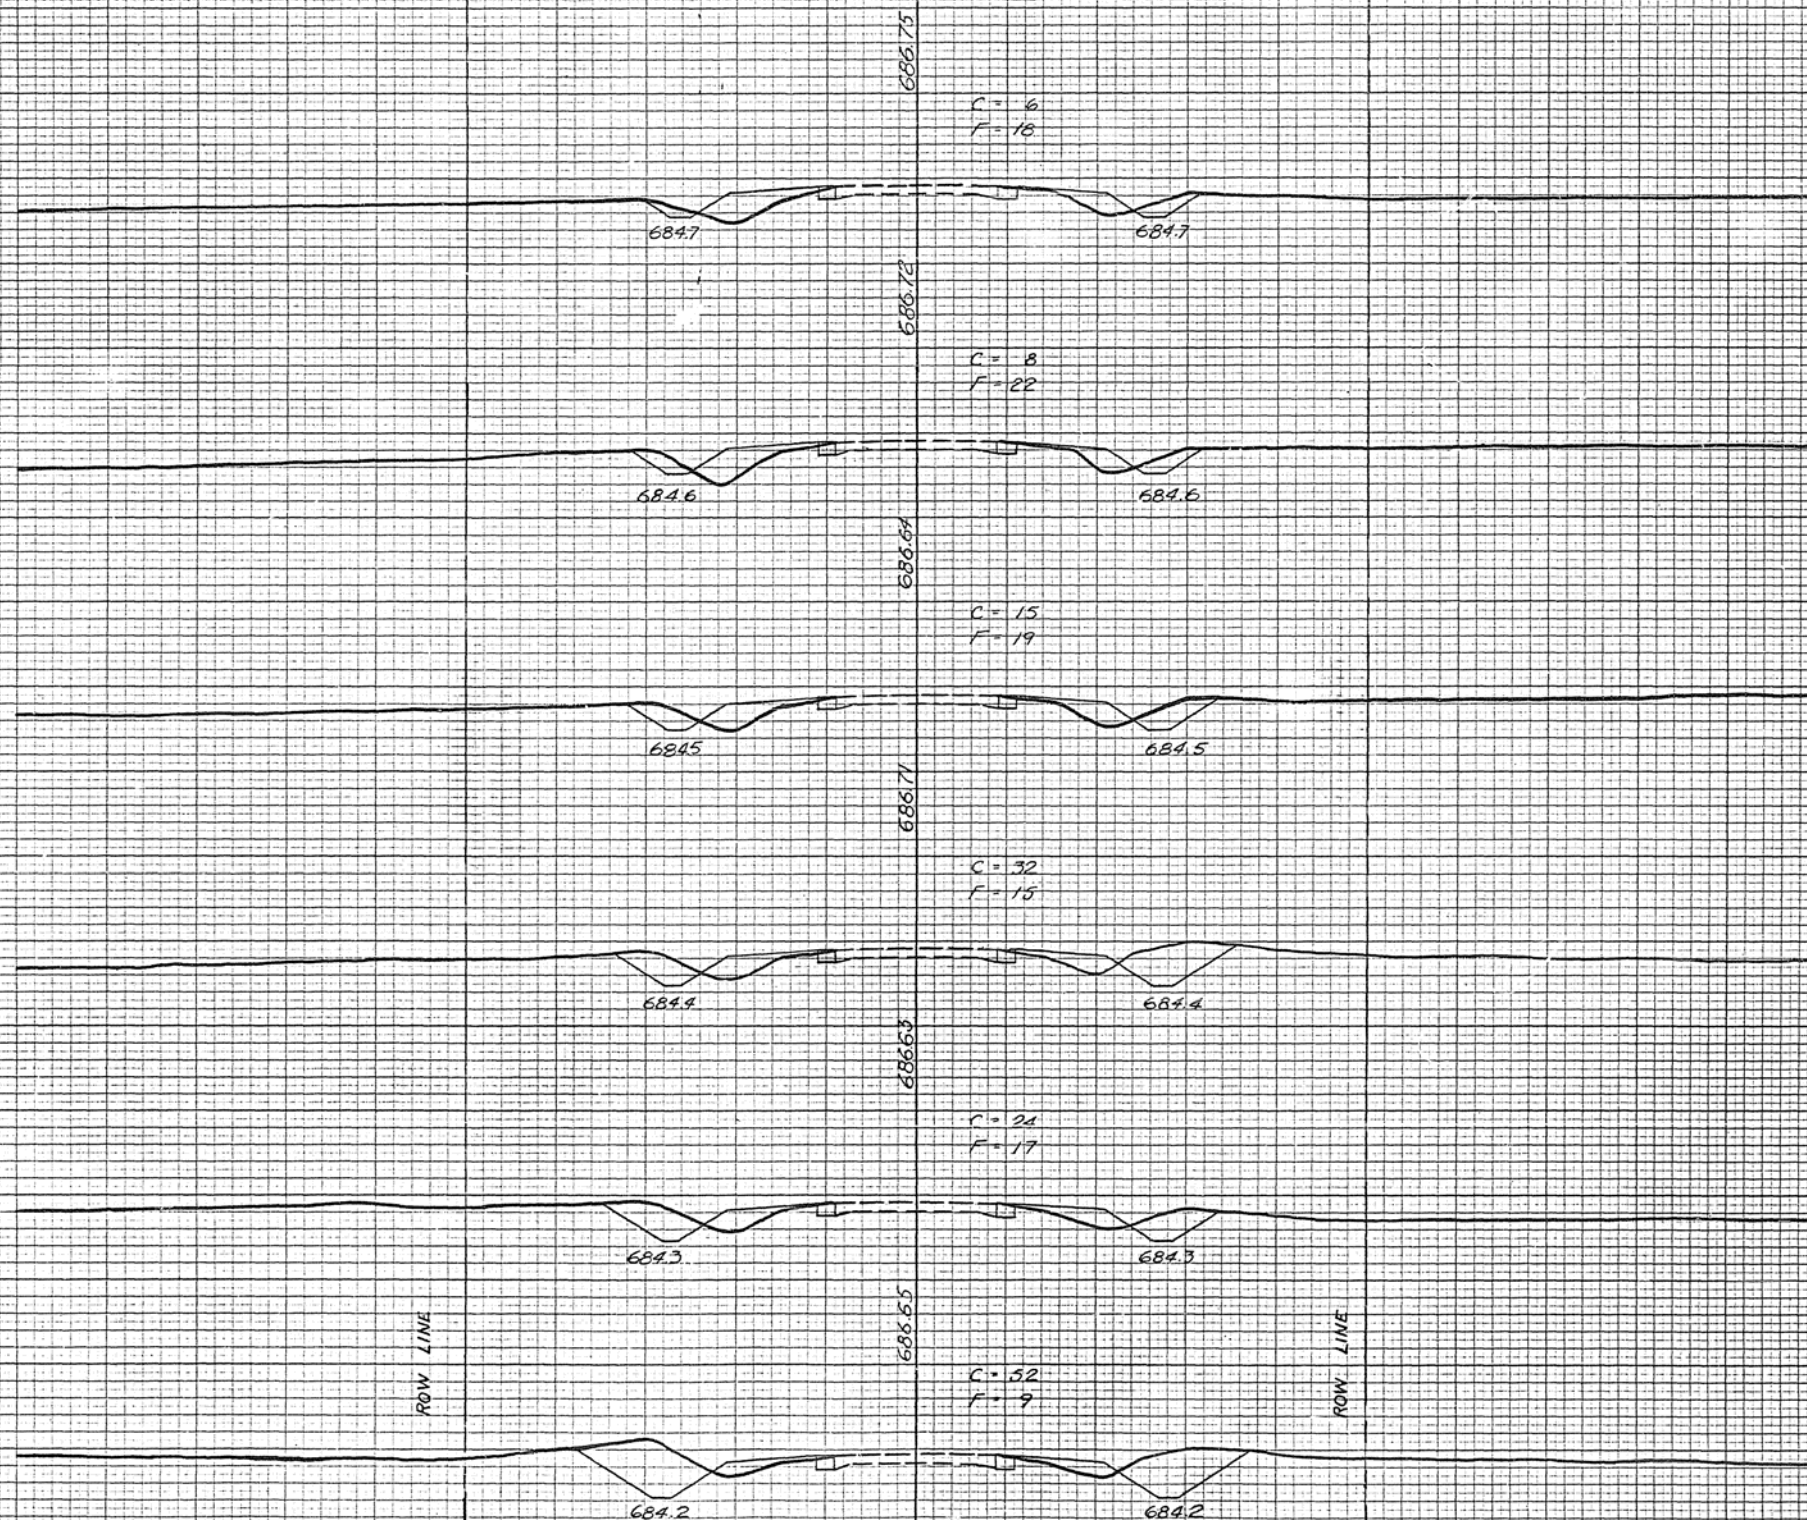

687 (204)

687 (203)

687 (202)

687 (201)


687 (200)

687 (199)

FINAL SURVEY NOTE BOOK NO. 2	SURVEYED PLOT TEMPERATURE AREAS CHECKED	DATE	6-30
		BY	STARBUCK
		BY	J. A. B.
		BY	J. A. B.
		BY	J. A. B.

ORIGINAL SURVEY NOTE BOOK NO.	SURVEYED PLOT TEMPERATURE AREAS CHECKED	DATE	
		BY	
		BY	
		BY	
		BY	

ROUTE NO.	SECTION	COUNTY	TOTAL SHEETS	SHEET NO.
145-540	100-1	MACON & PIATT	107	44
Sta. 205+00		Sta. 210+00		

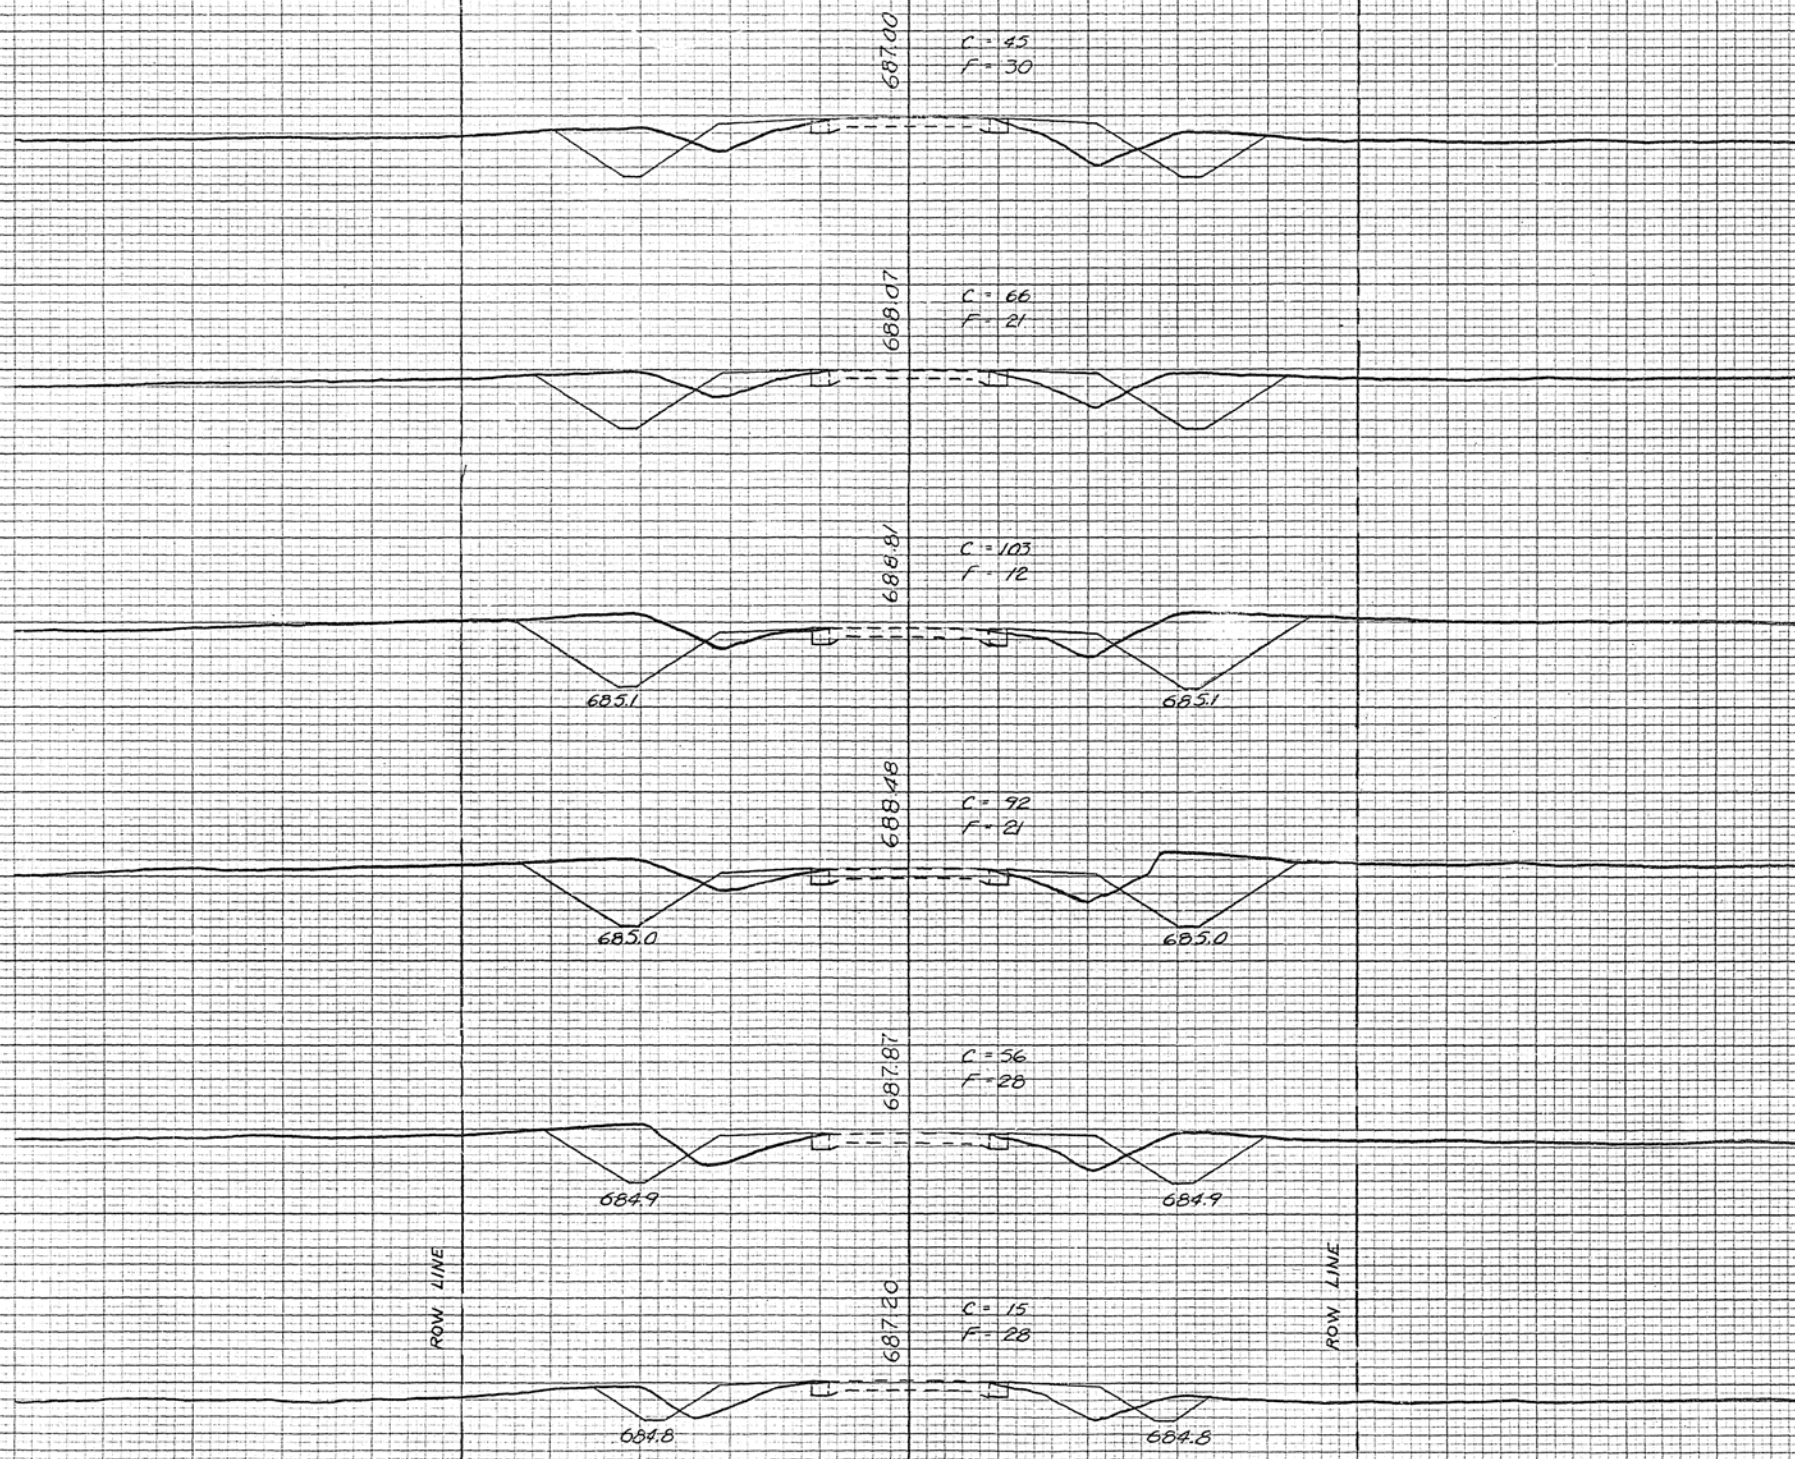

687 210

688 209

689 208


688 207

688 206

687 205

FINAL SURVEY	DATE
NO. 2	6-55
NOTE BOOK	6-56
	6-57
	6-58
	6-59
	6-100

ORIGINAL	SURVEYED	BY	DATE
SURVEY	PLOTTED		
NOTE BOOK	TEMPLATE		
	AREAS		
	AREAS CHECKED		

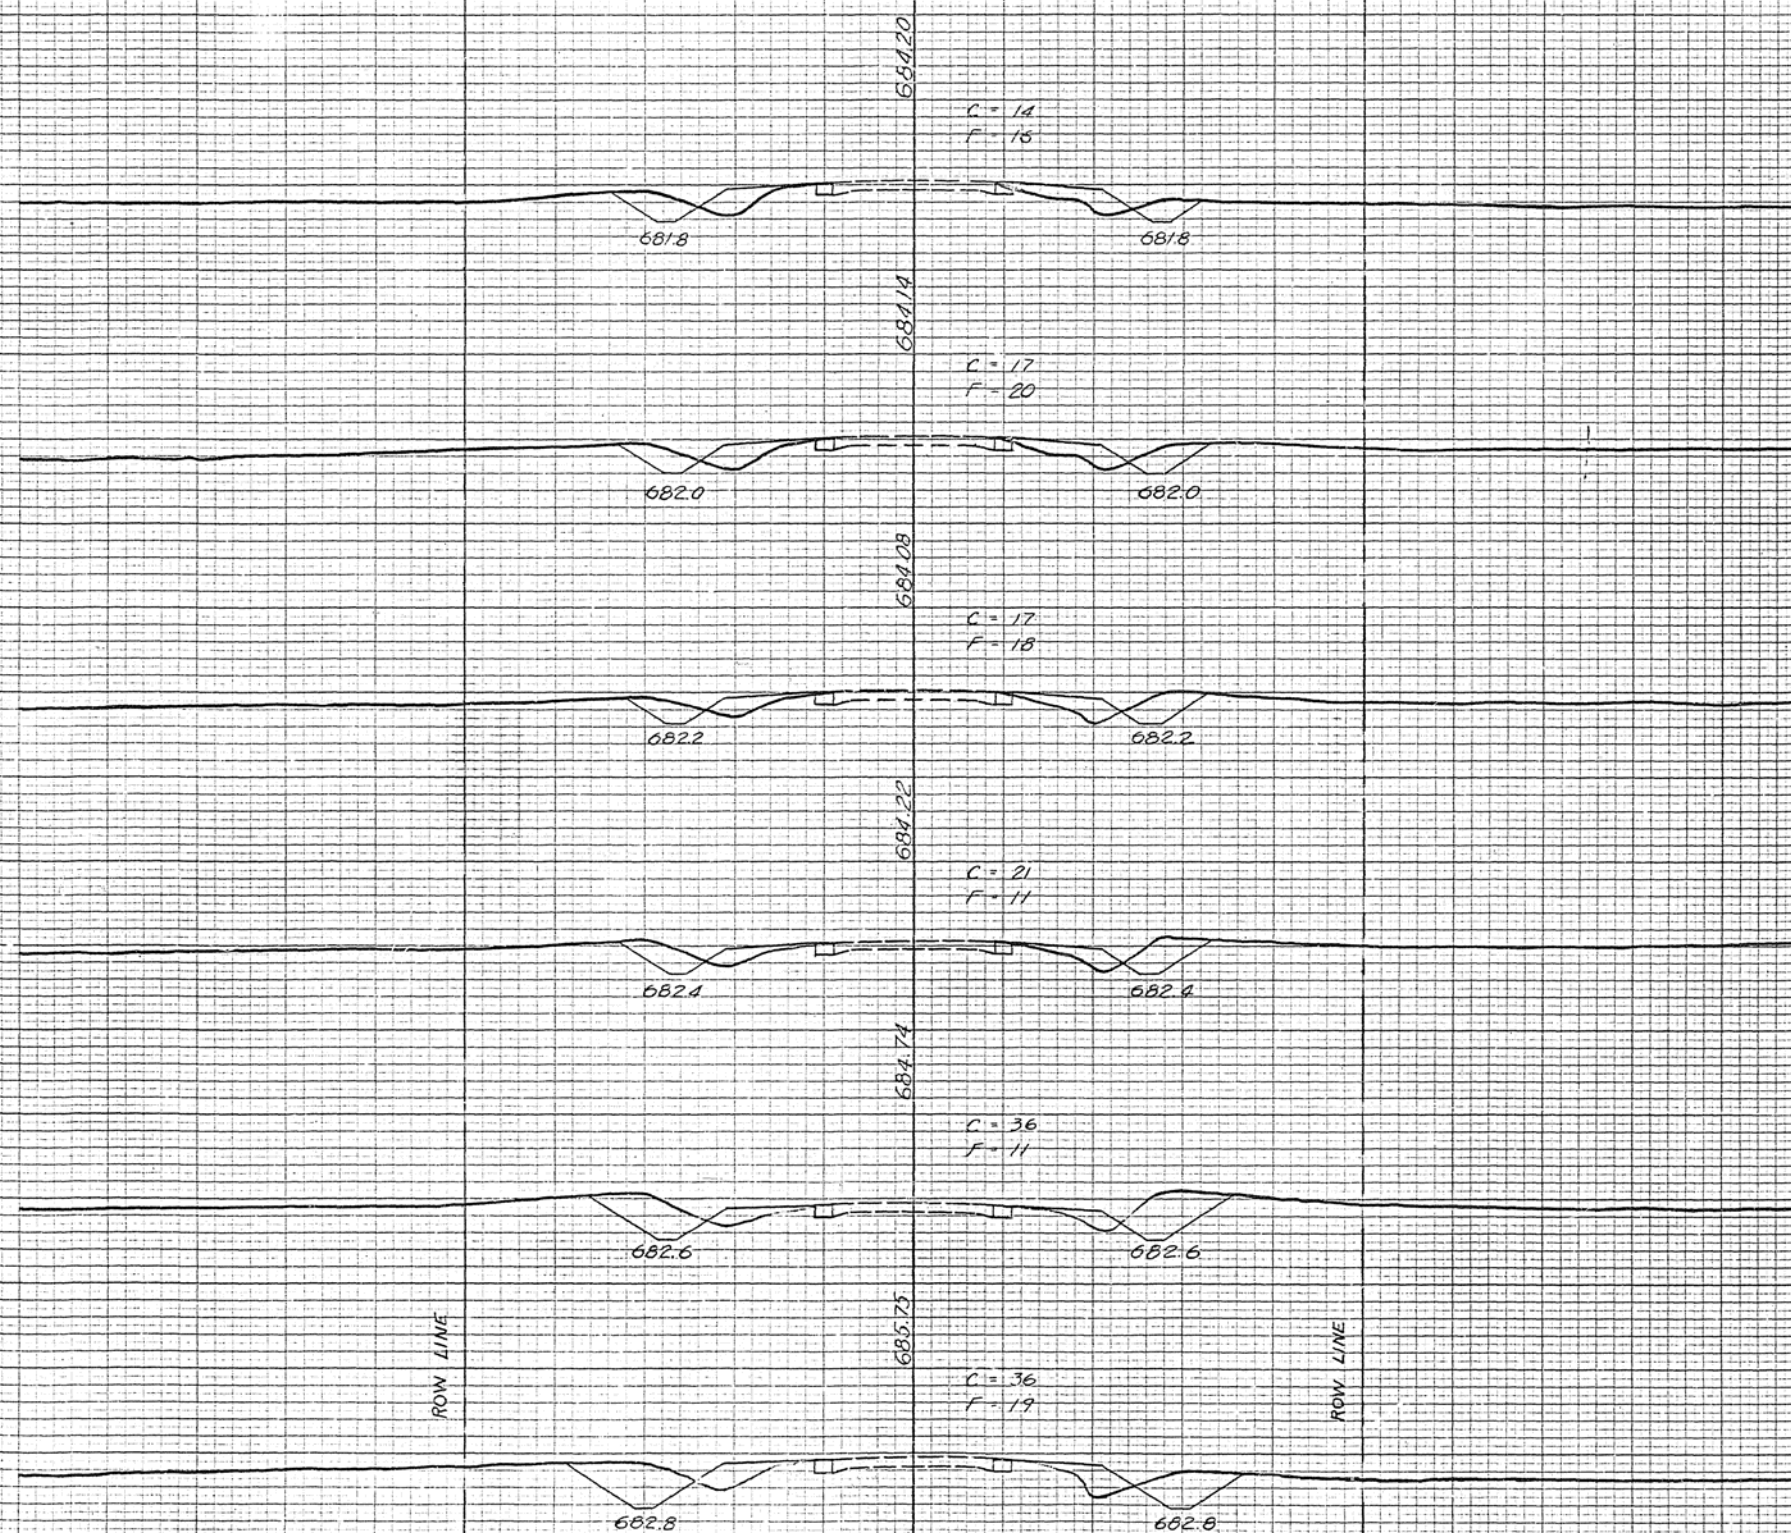

Printed in U.S.A.
Cox ARFWEIGHT Trading Cook

PLATE 2 CROSS SECTION B P R STANDARD
ENGINE DESIGN CO. CHICAGO, NEW YORK

Printed in U.S.A.

SECTION	COUNTY	TOTAL	SHEET
107	MACON & PIATT	107	46
STA. 210+87	FOOTING 221+00		
107	107	107	107

DATE	BY	REVISION	NO.
10-1-60	STARBUCK	1	2
10-1-60		2	
10-1-60		3	
10-1-60		4	
10-1-60		5	
10-1-60		6	
10-1-60		7	
10-1-60		8	
10-1-60		9	
10-1-60		10	

DATE	BY	REVISION	NO.
10-1-60	STARBUCK	1	2
10-1-60		2	
10-1-60		3	
10-1-60		4	
10-1-60		5	
10-1-60		6	
10-1-60		7	
10-1-60		8	
10-1-60		9	
10-1-60		10	

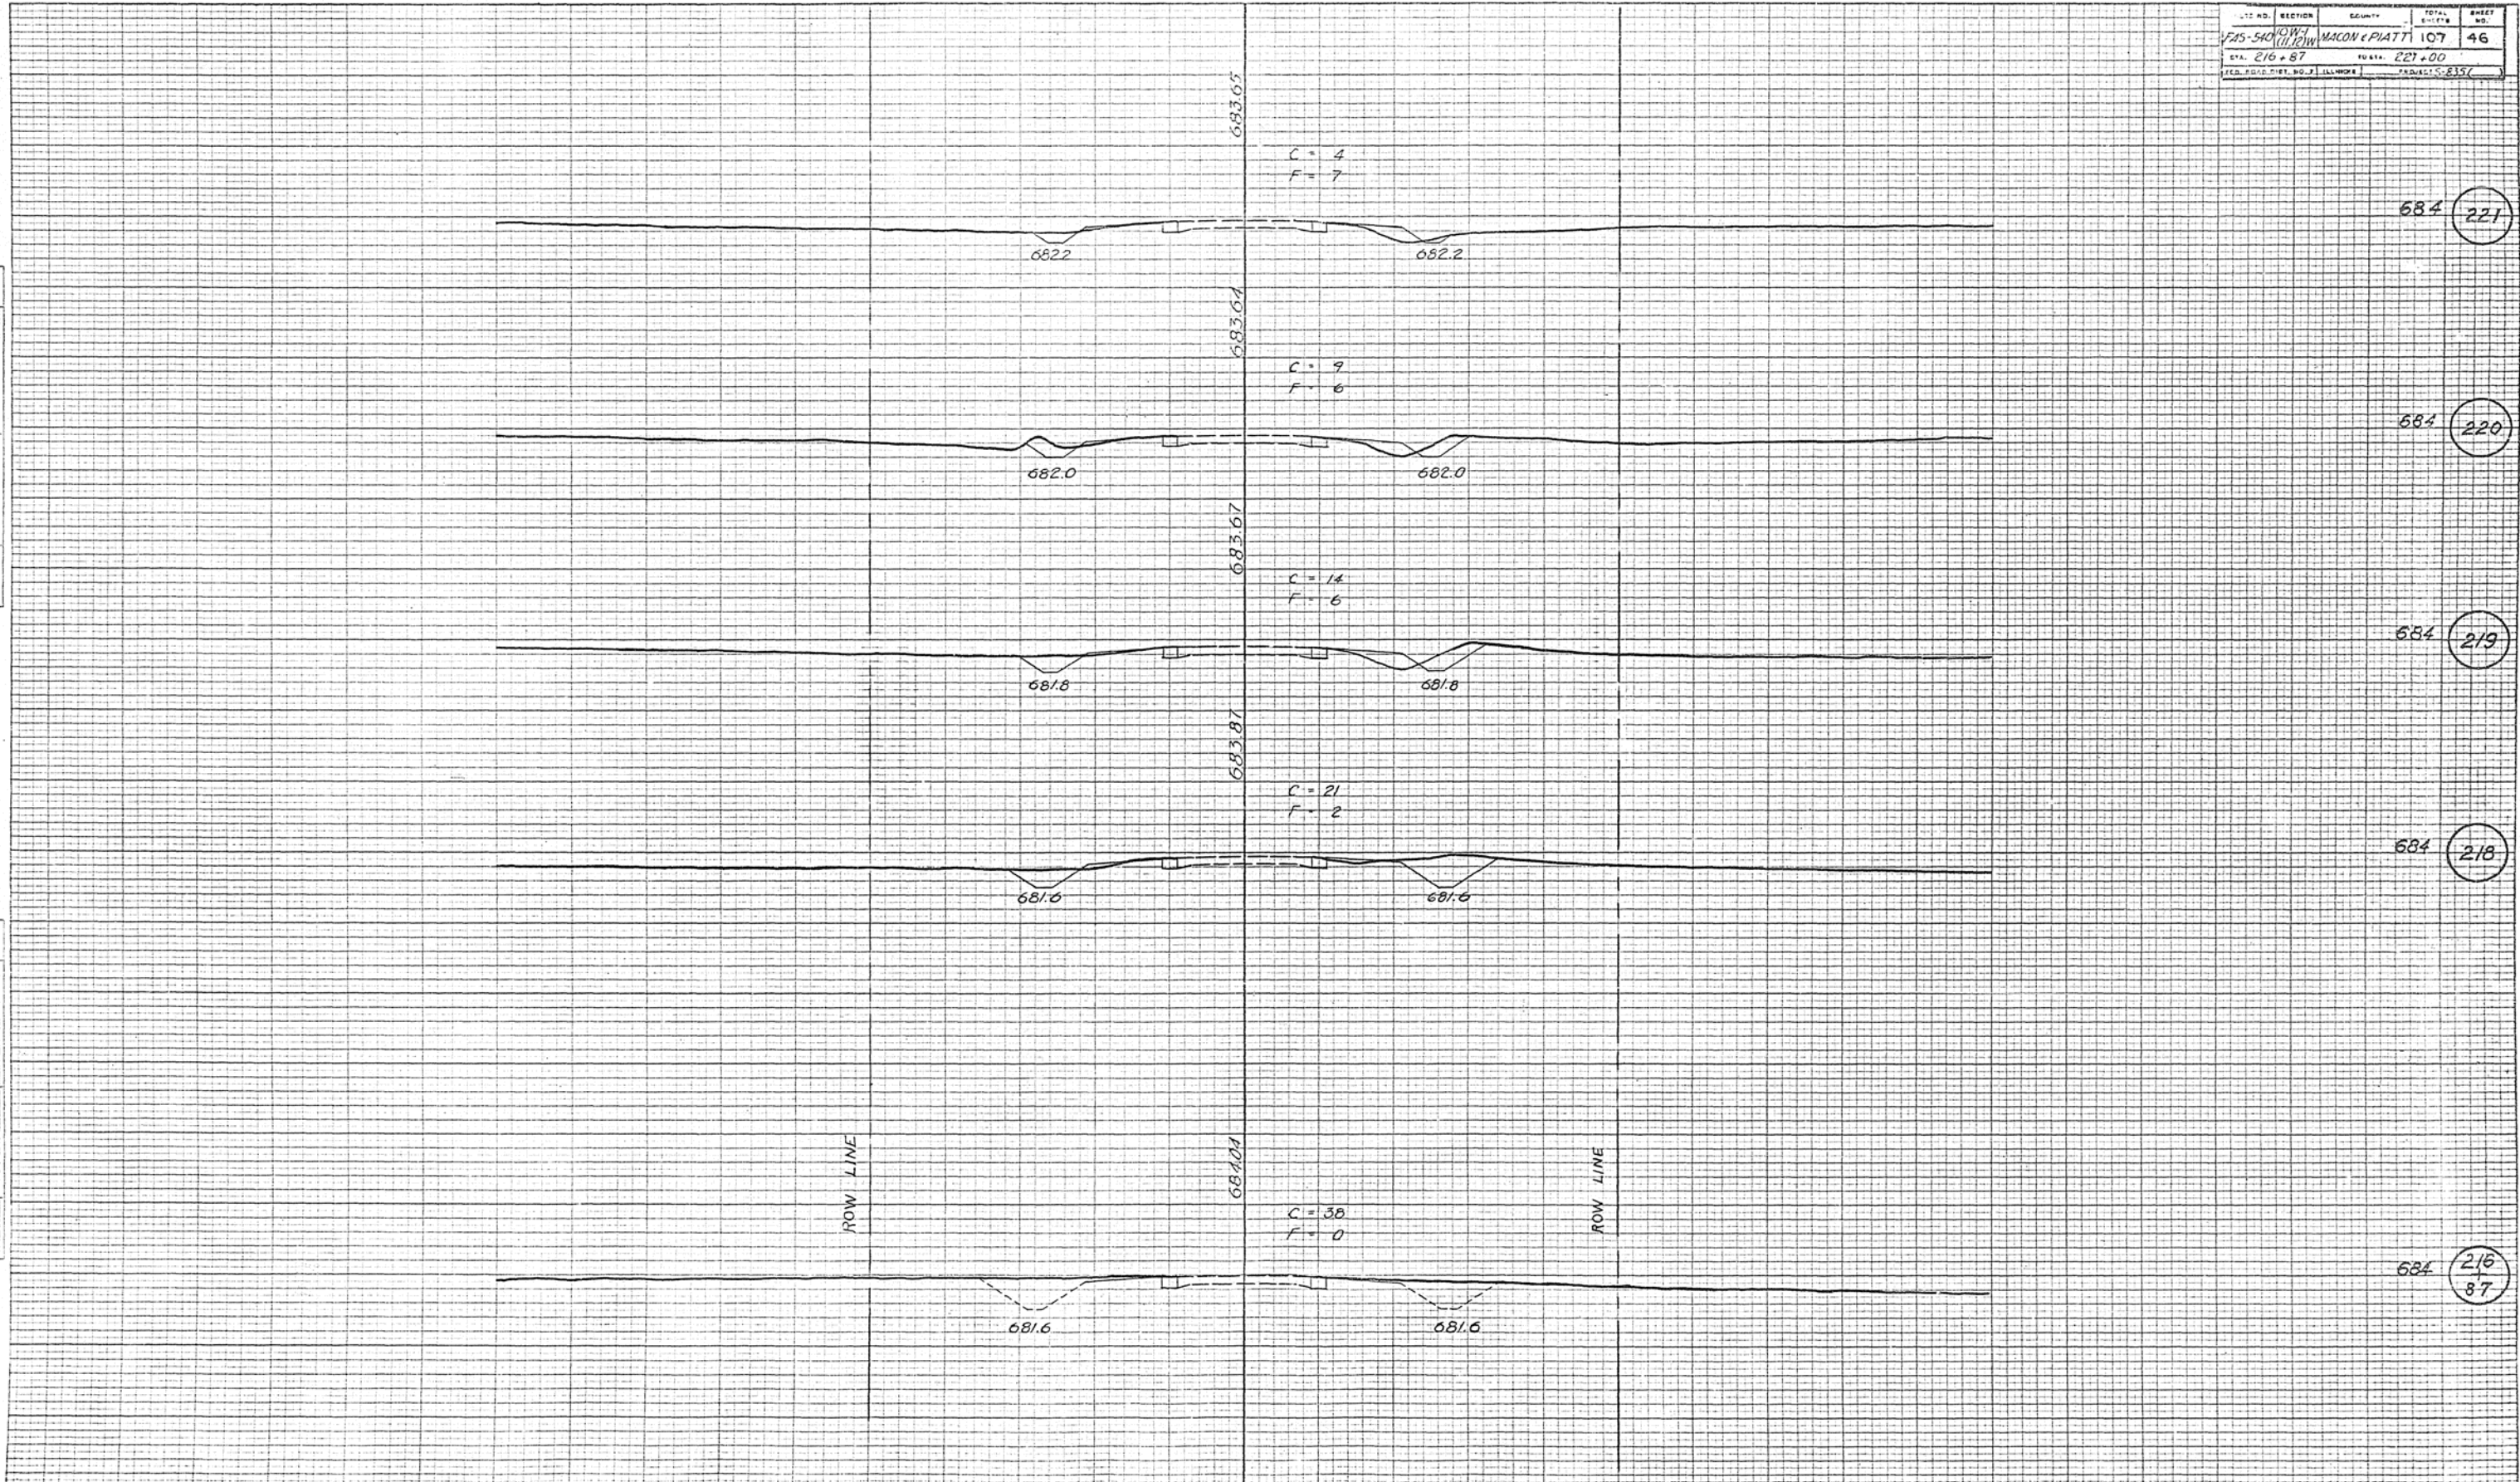


PLATE 3 CROSS SECTION & P. & STANDARD
EUGENE DIEZGEN CO. CHICAGO - NEW YORK

Printed in U.S.A.
See APPENDIX for Tracing Chart

Printed in U.S.A.
See APPENDIX for Tracing Chart


ROUTE NO.	SECTION	COUNTY	TOTAL SHEET NO.	SHEET NO.
FAS-540	ROW-1 (11/12)W	MARION / PLATT	107	47
STA. 222+00		TO STA. 227+00		
FED. ROAD DIST. NO. 1		PROJECT 5-555		

DATE	BY	SUBMITTED	FINAL SURVEY	NO.
6-55	STARBUCK	PLOTTED	NOTE BOOK	2
6-55	T. L. A.	TEMPERATURE		
6-55	T. L. A.	AREAS		
2-60	J. J. B.	AREAS CHECKED		
3-60				

DATE: 6-58
 BY: STARBUCK
 SURVEYED: T.A.
 PLOTTED: J.C.
 REVISION: J.J.B.
 NO. 2

DATE: _____
 BY: _____
 SURVEYED: _____
 PLOTTED: _____
 REVISION: _____
 NO. _____

ROUTE NO. 107
 SECTION 107
 STA. 228+00
 TOTAL 233+00
 SHEET 48

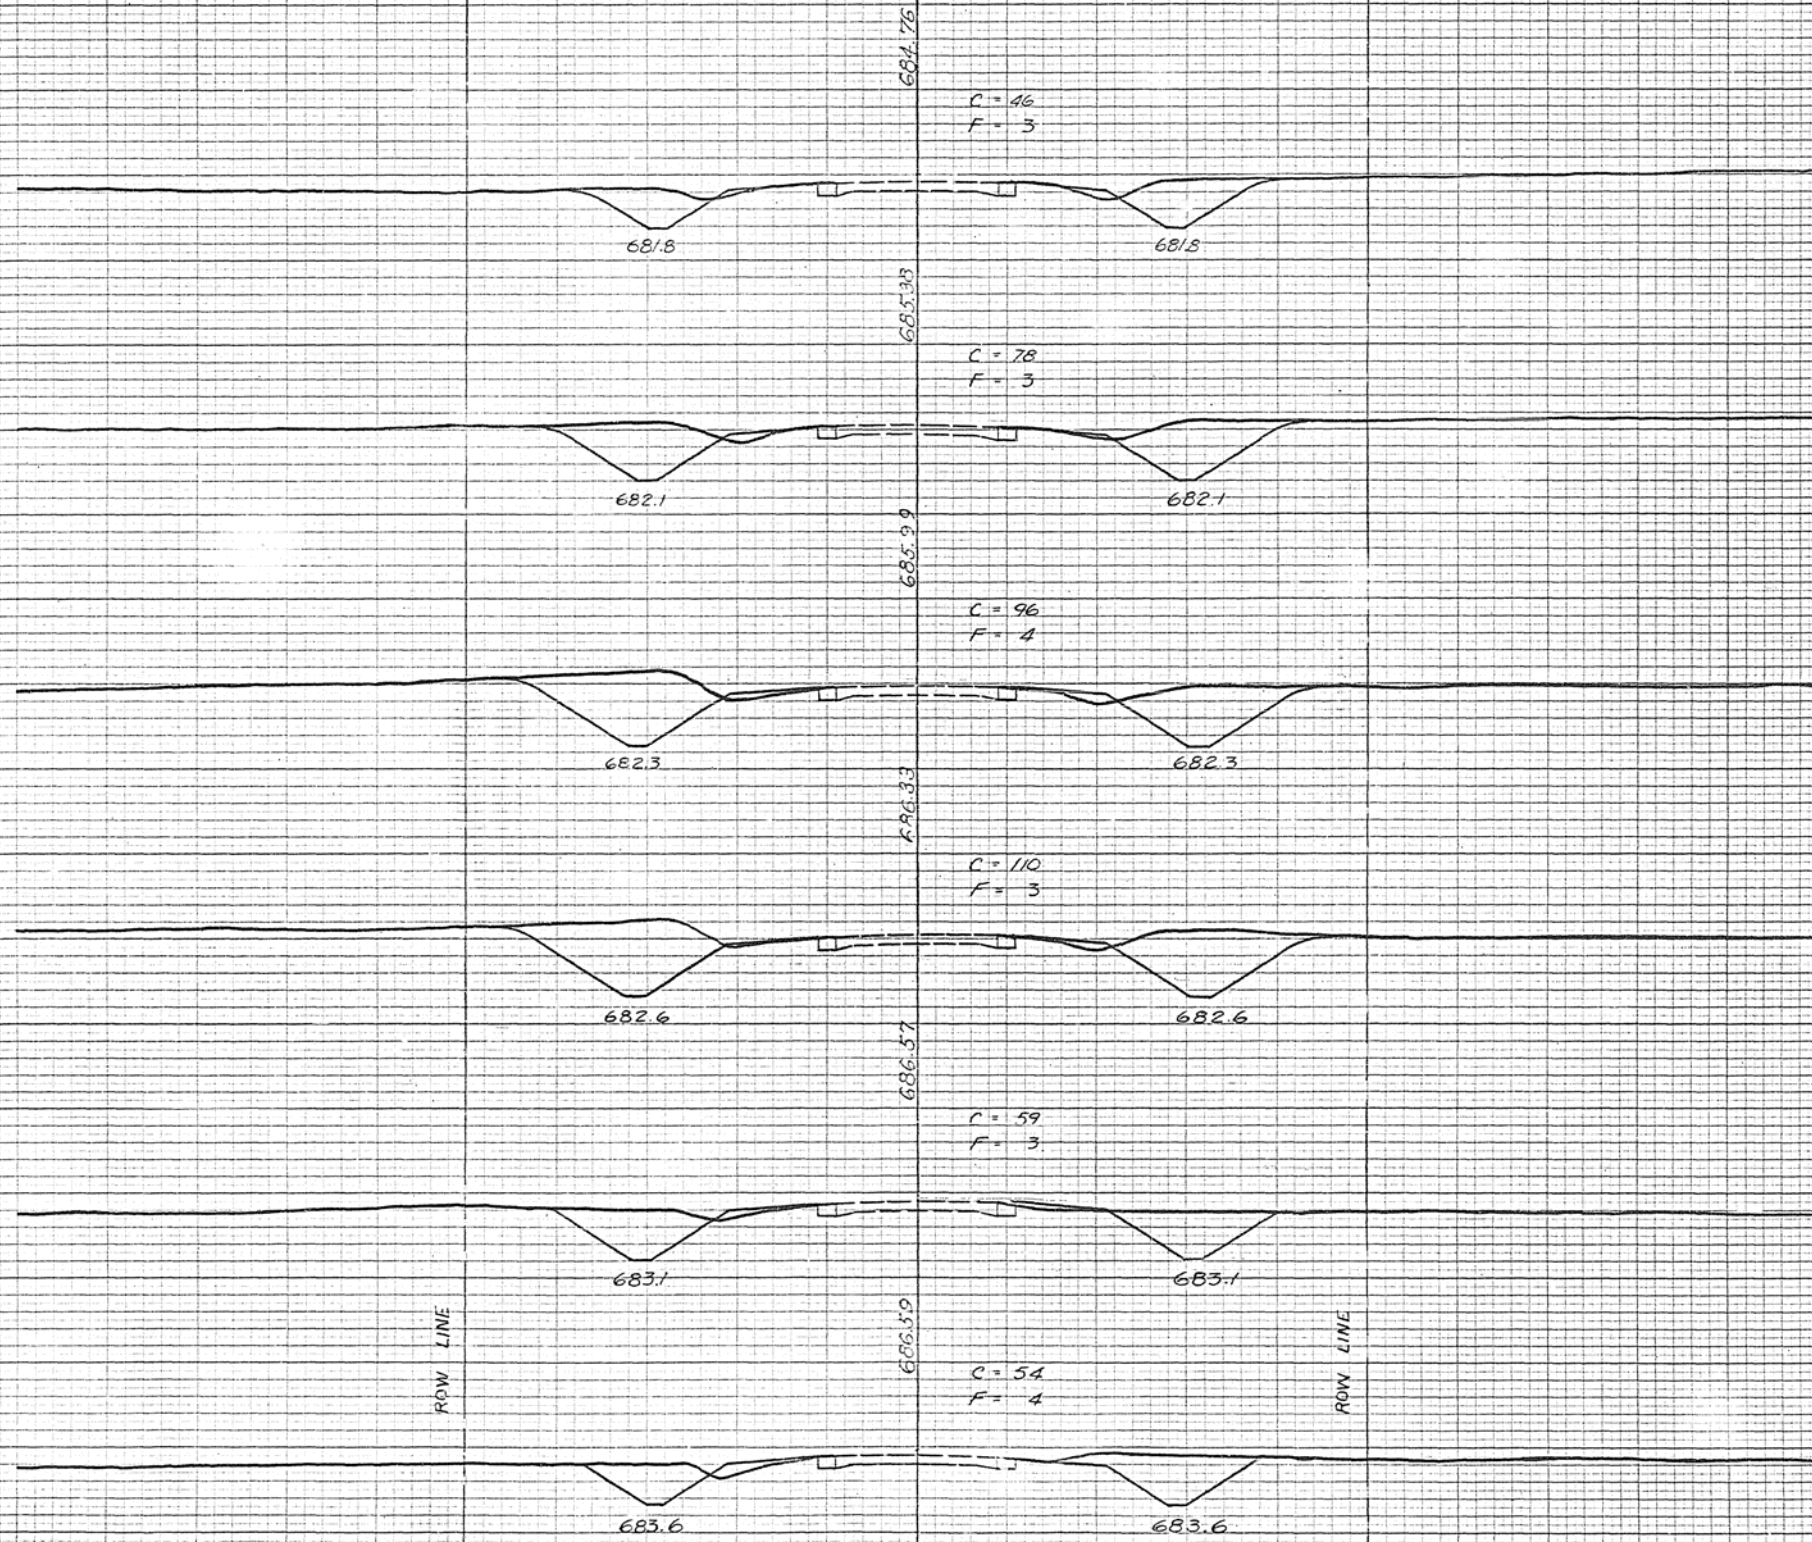

685 (233)

685 (232)

686 (231)


686 (230)

687 (229)

687 (228)

DATE: 6-58
BY: STARBUCK
CHECKED: J.L.L.
NO. 2

DATE:
BY:
CHECKED:
NO.
NO.
NO.

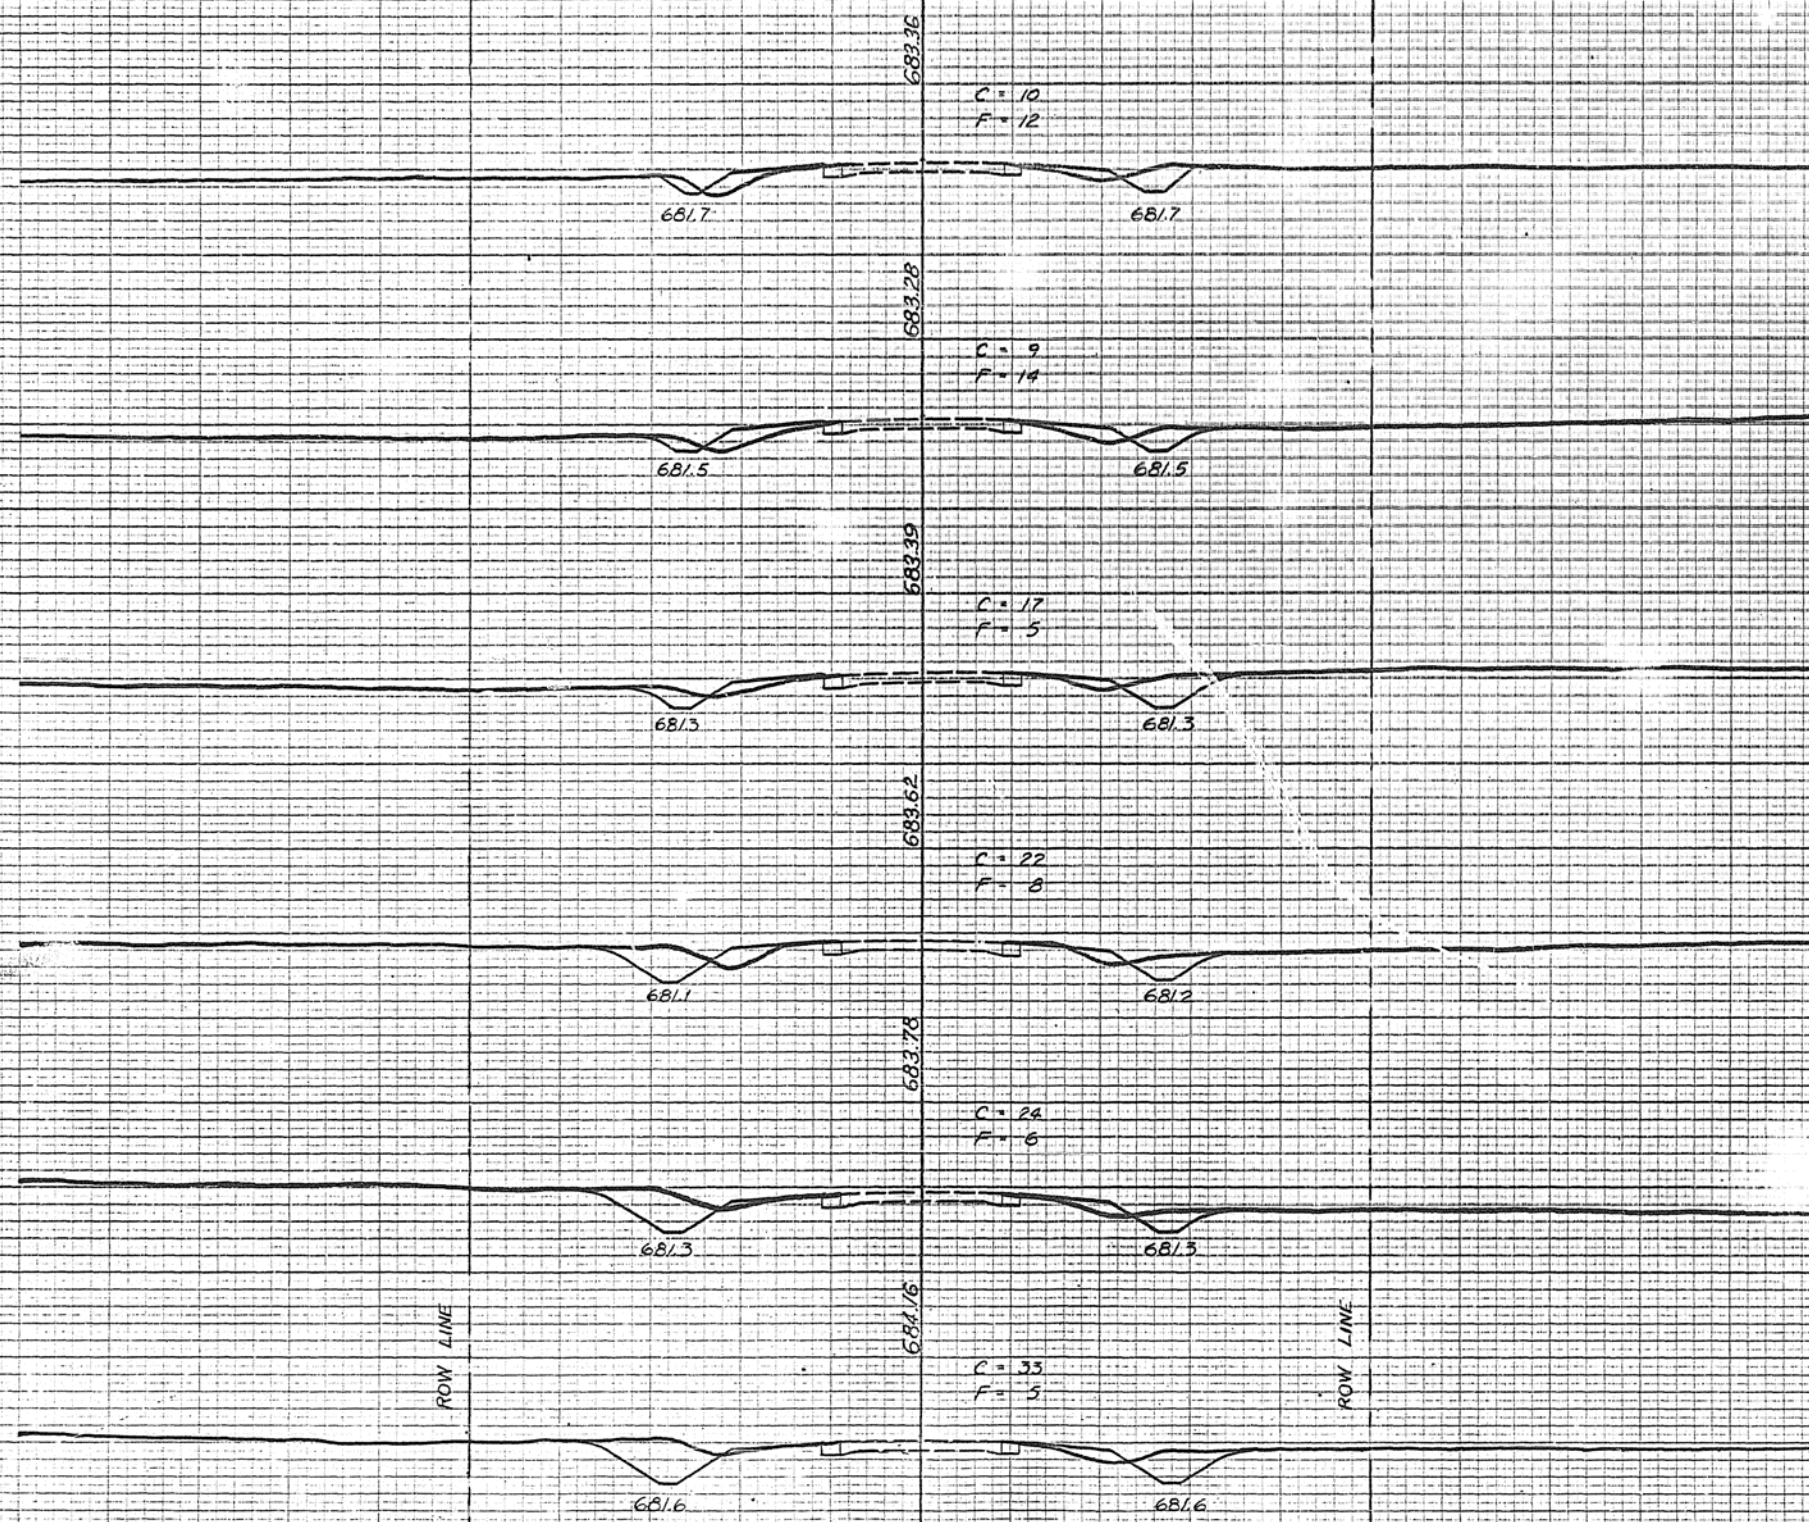


DATE 6-56
BY STARBUCK
CHECKED
DATE 6-56
BY
DATE 6-56
BY

FINAL
SURVEY
NOTE BOOK
NO. 2

DATE
BY

ORIGINAL
SURVEY
NOTE BOOK
NO.

CHECKED
DATE
BY

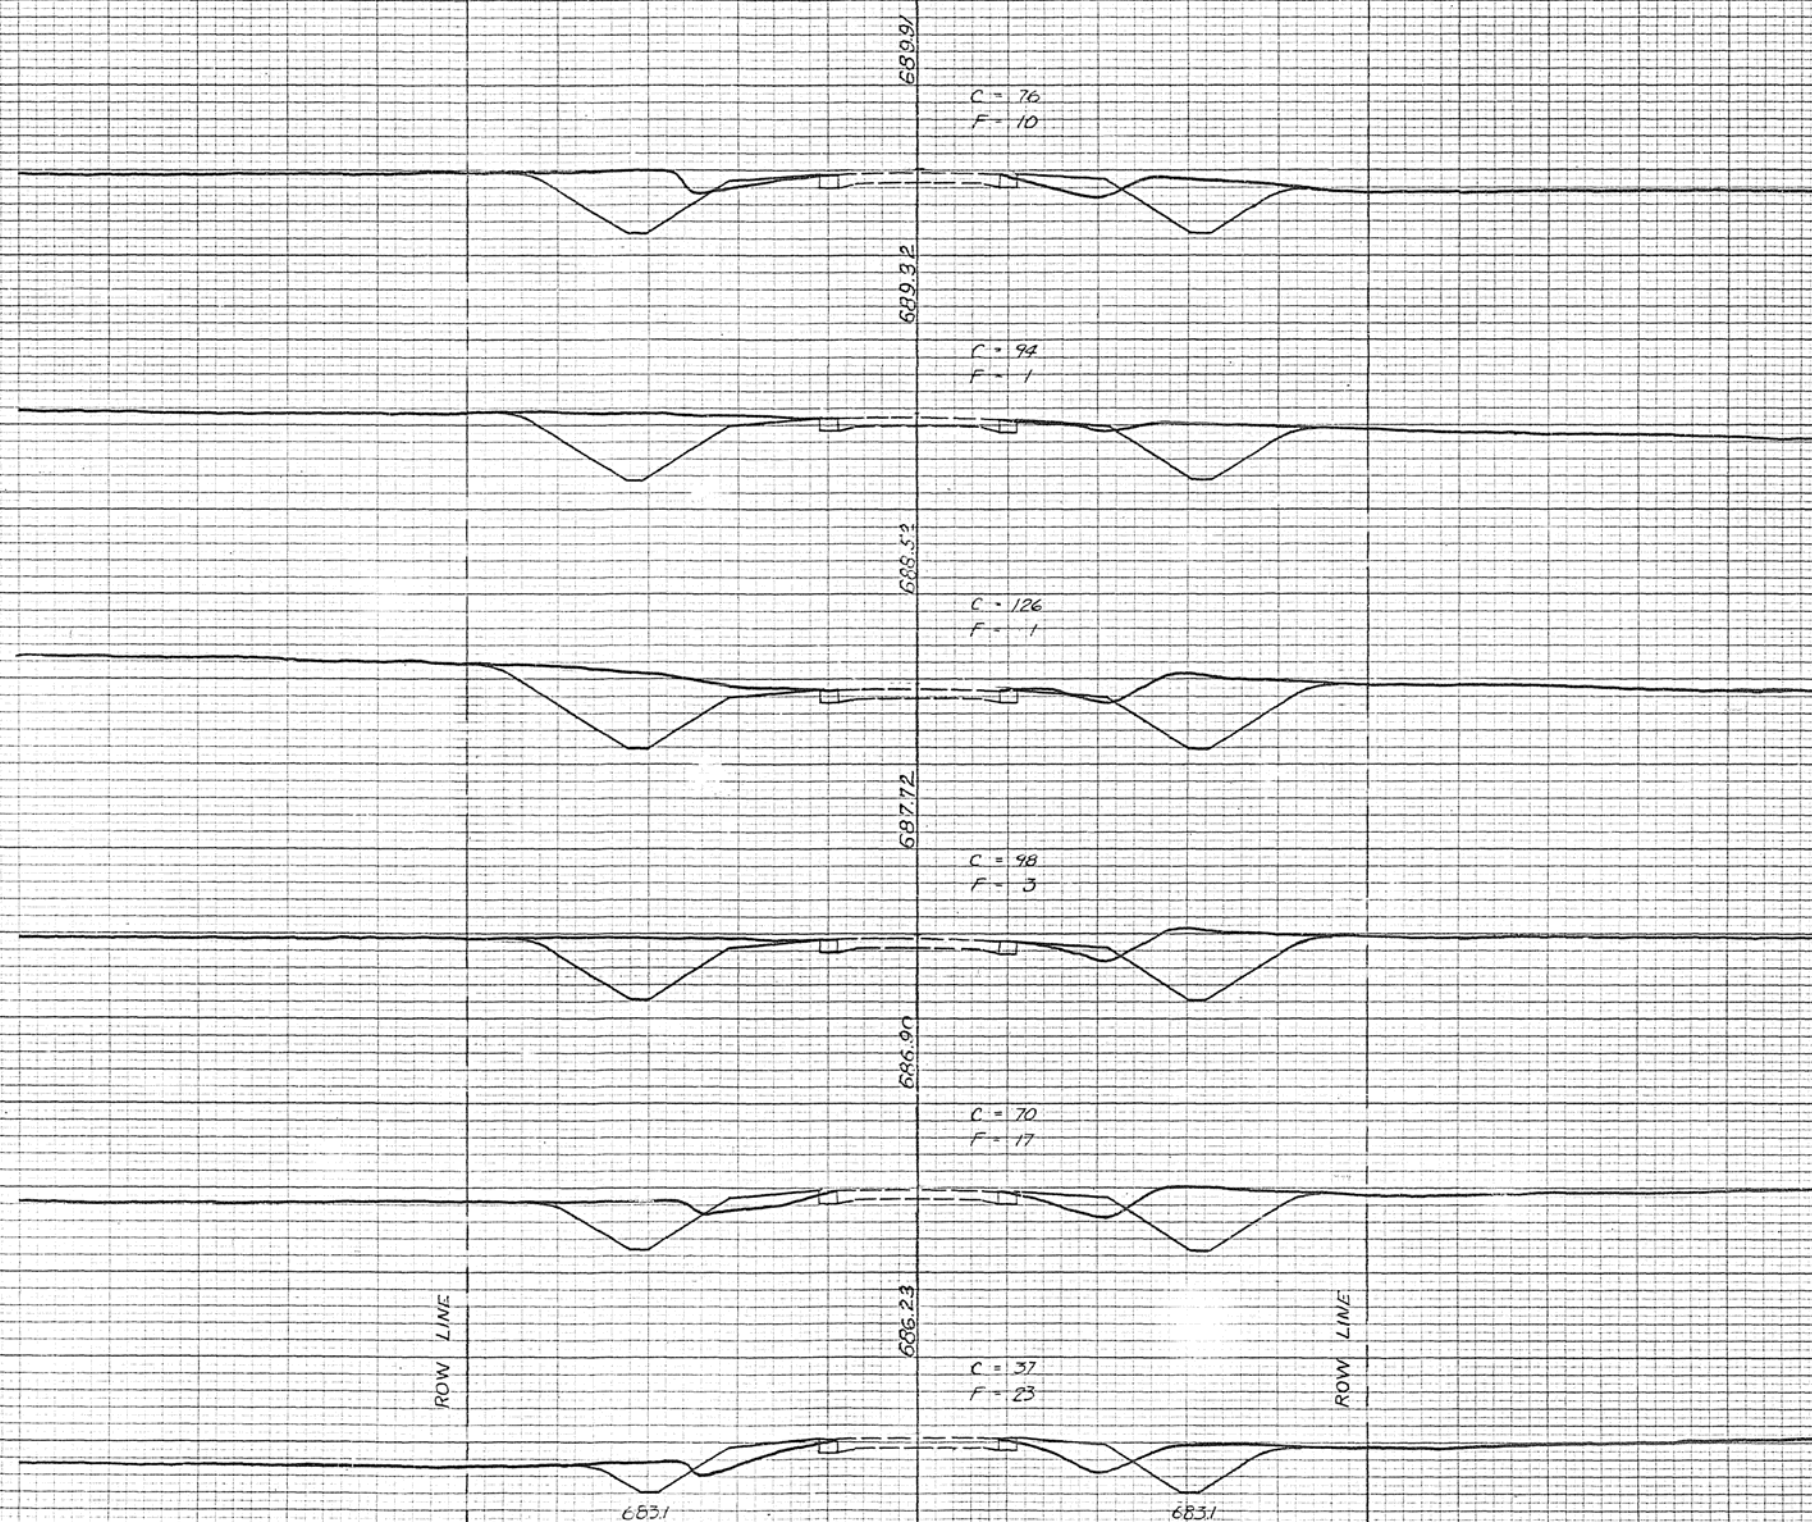

690 (251)

689 (250)

688 (249)

688 (248)


687 (247)

686 (246)

FINAL SURVEY	DATE	BY
NO. 2	8-55	STARBUCK
NO. 2	8-55	STARBUCK
ORIGINAL SURVEY	DATE	BY
NO. 2		
NO. 2		
SECTION	COUNTY	TOTAL SHEETS	SHEET NO.
145-540 ROW-1 MILLER	MACON / PIATT	107	52
252+00	257+00		

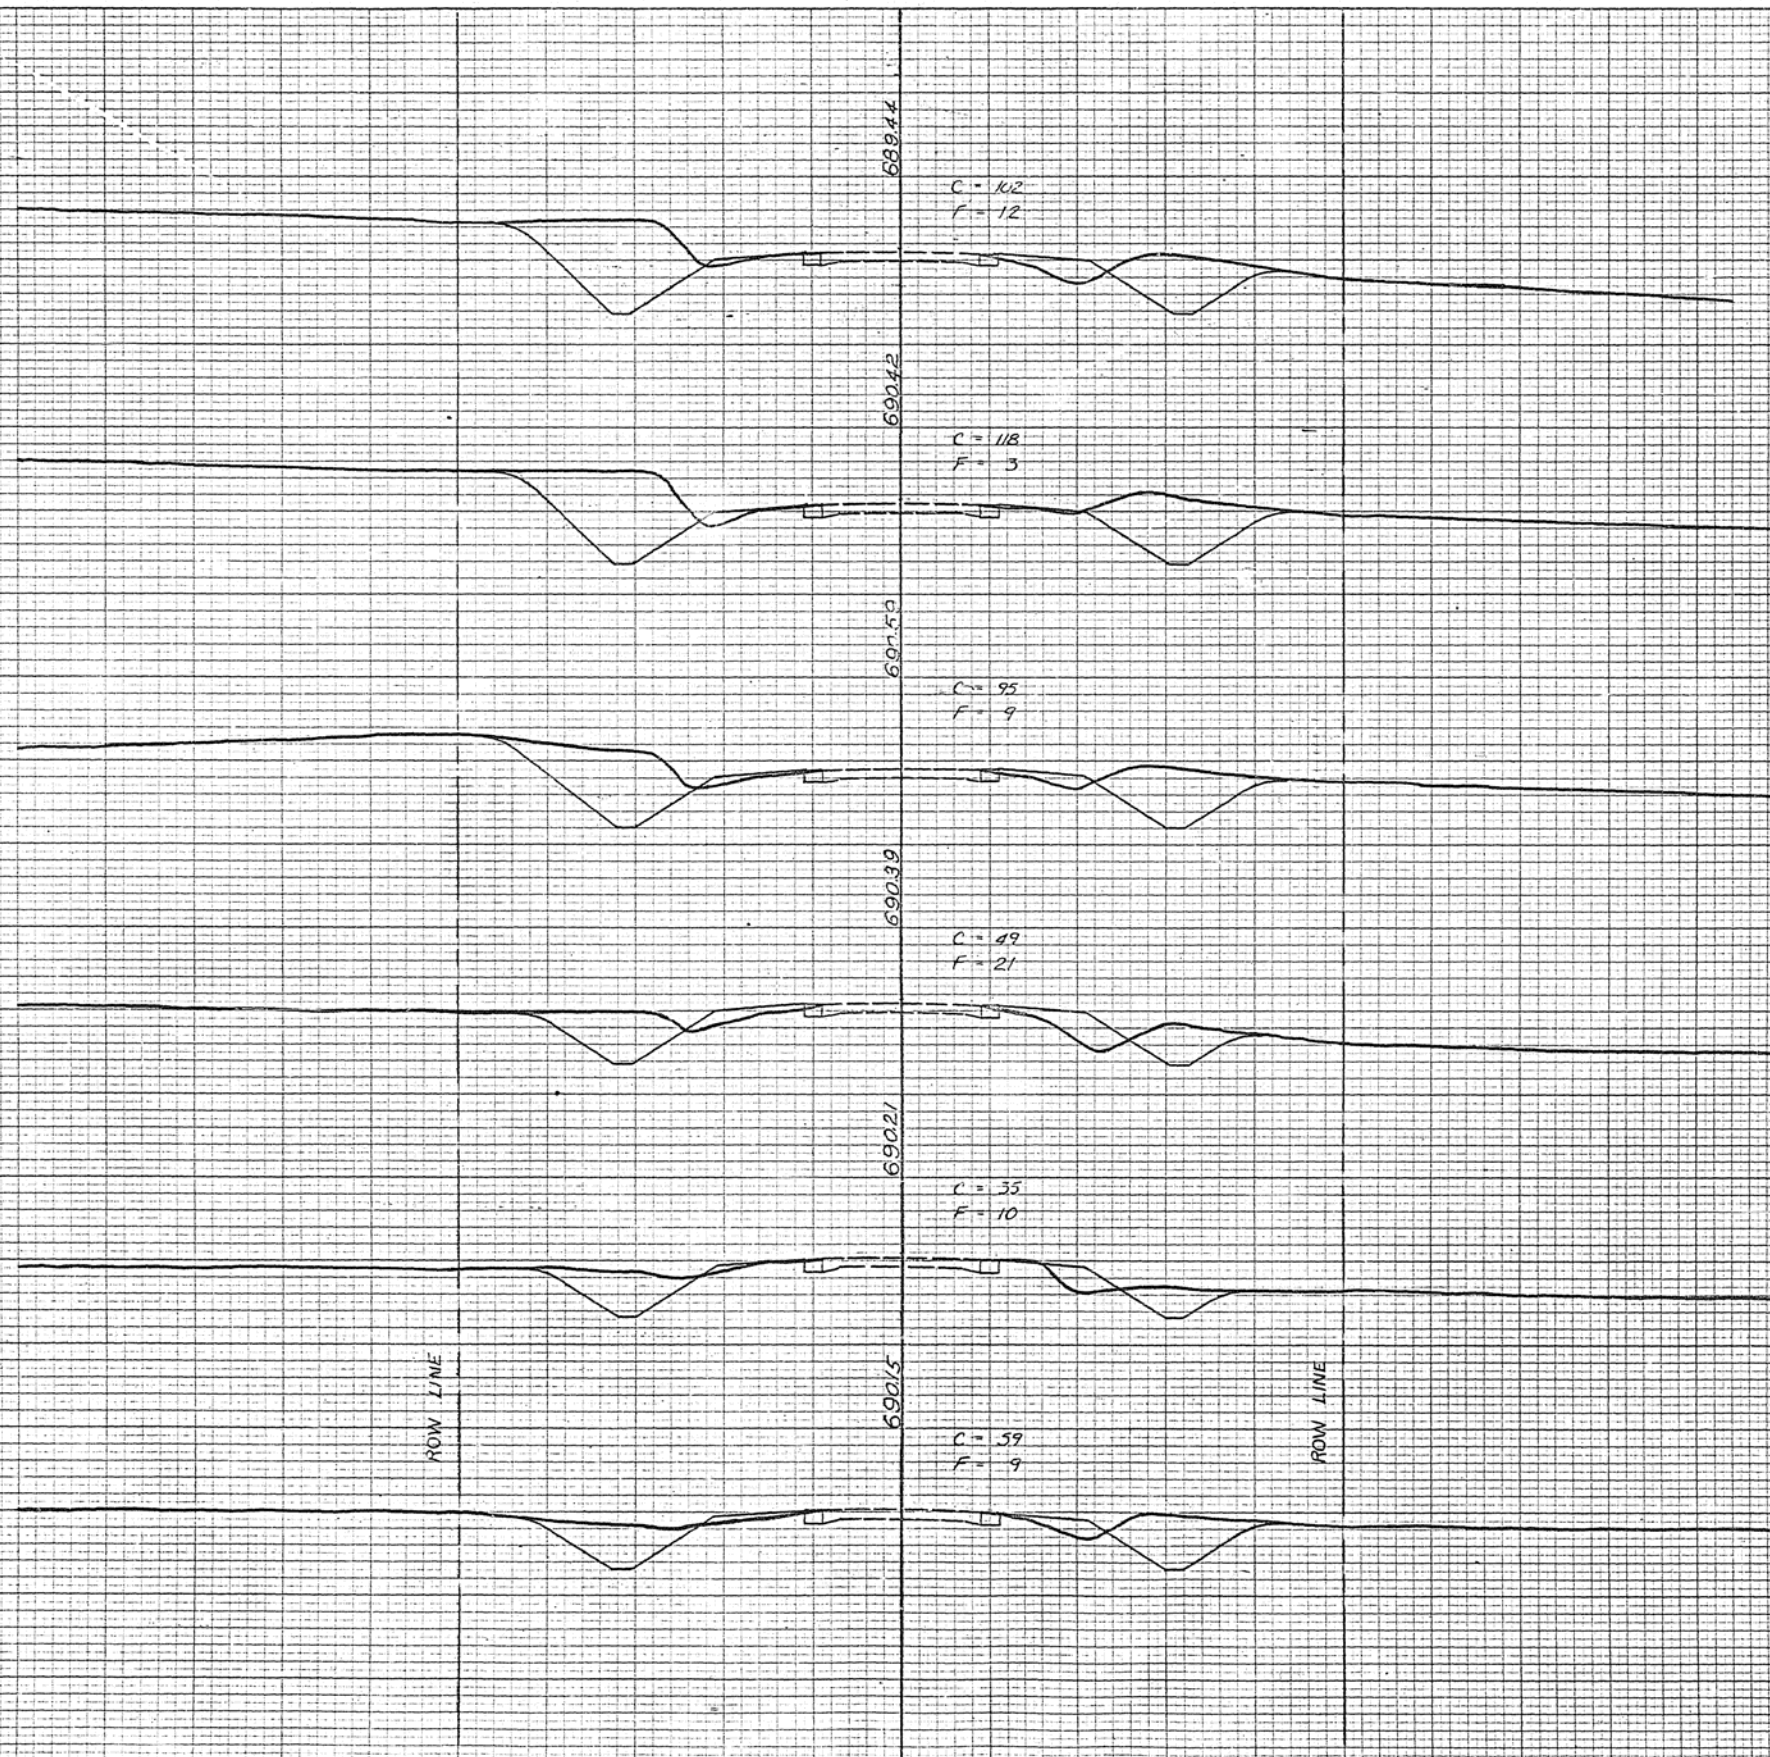

689 (257)

690 (256)

691 (255)

690 (254)

690 (253)

690 (252)

FINAL SURVEY NOTE BOOK NO. 2	SURVEYED BY STARBUCK T.A. J.J.B.	DATE 8-1-50 8-5-50 8-5-50

ORIGINAL SURVEY NOTE BOOK NO.	SURVEYED BY STARBUCK T.A. J.J.B.	DATE

ROUTE NO.	SECTION	COUNTY	TOTAL SHEETS	SHEET NO.
FA-54	10W-1 (11/12)W	MACON & PIATT	107	54
Sta. 264+00			TOTAL 269+00	
100' WORK DIST. 50' TILLINGHAM			PROJECT 5-3-50	

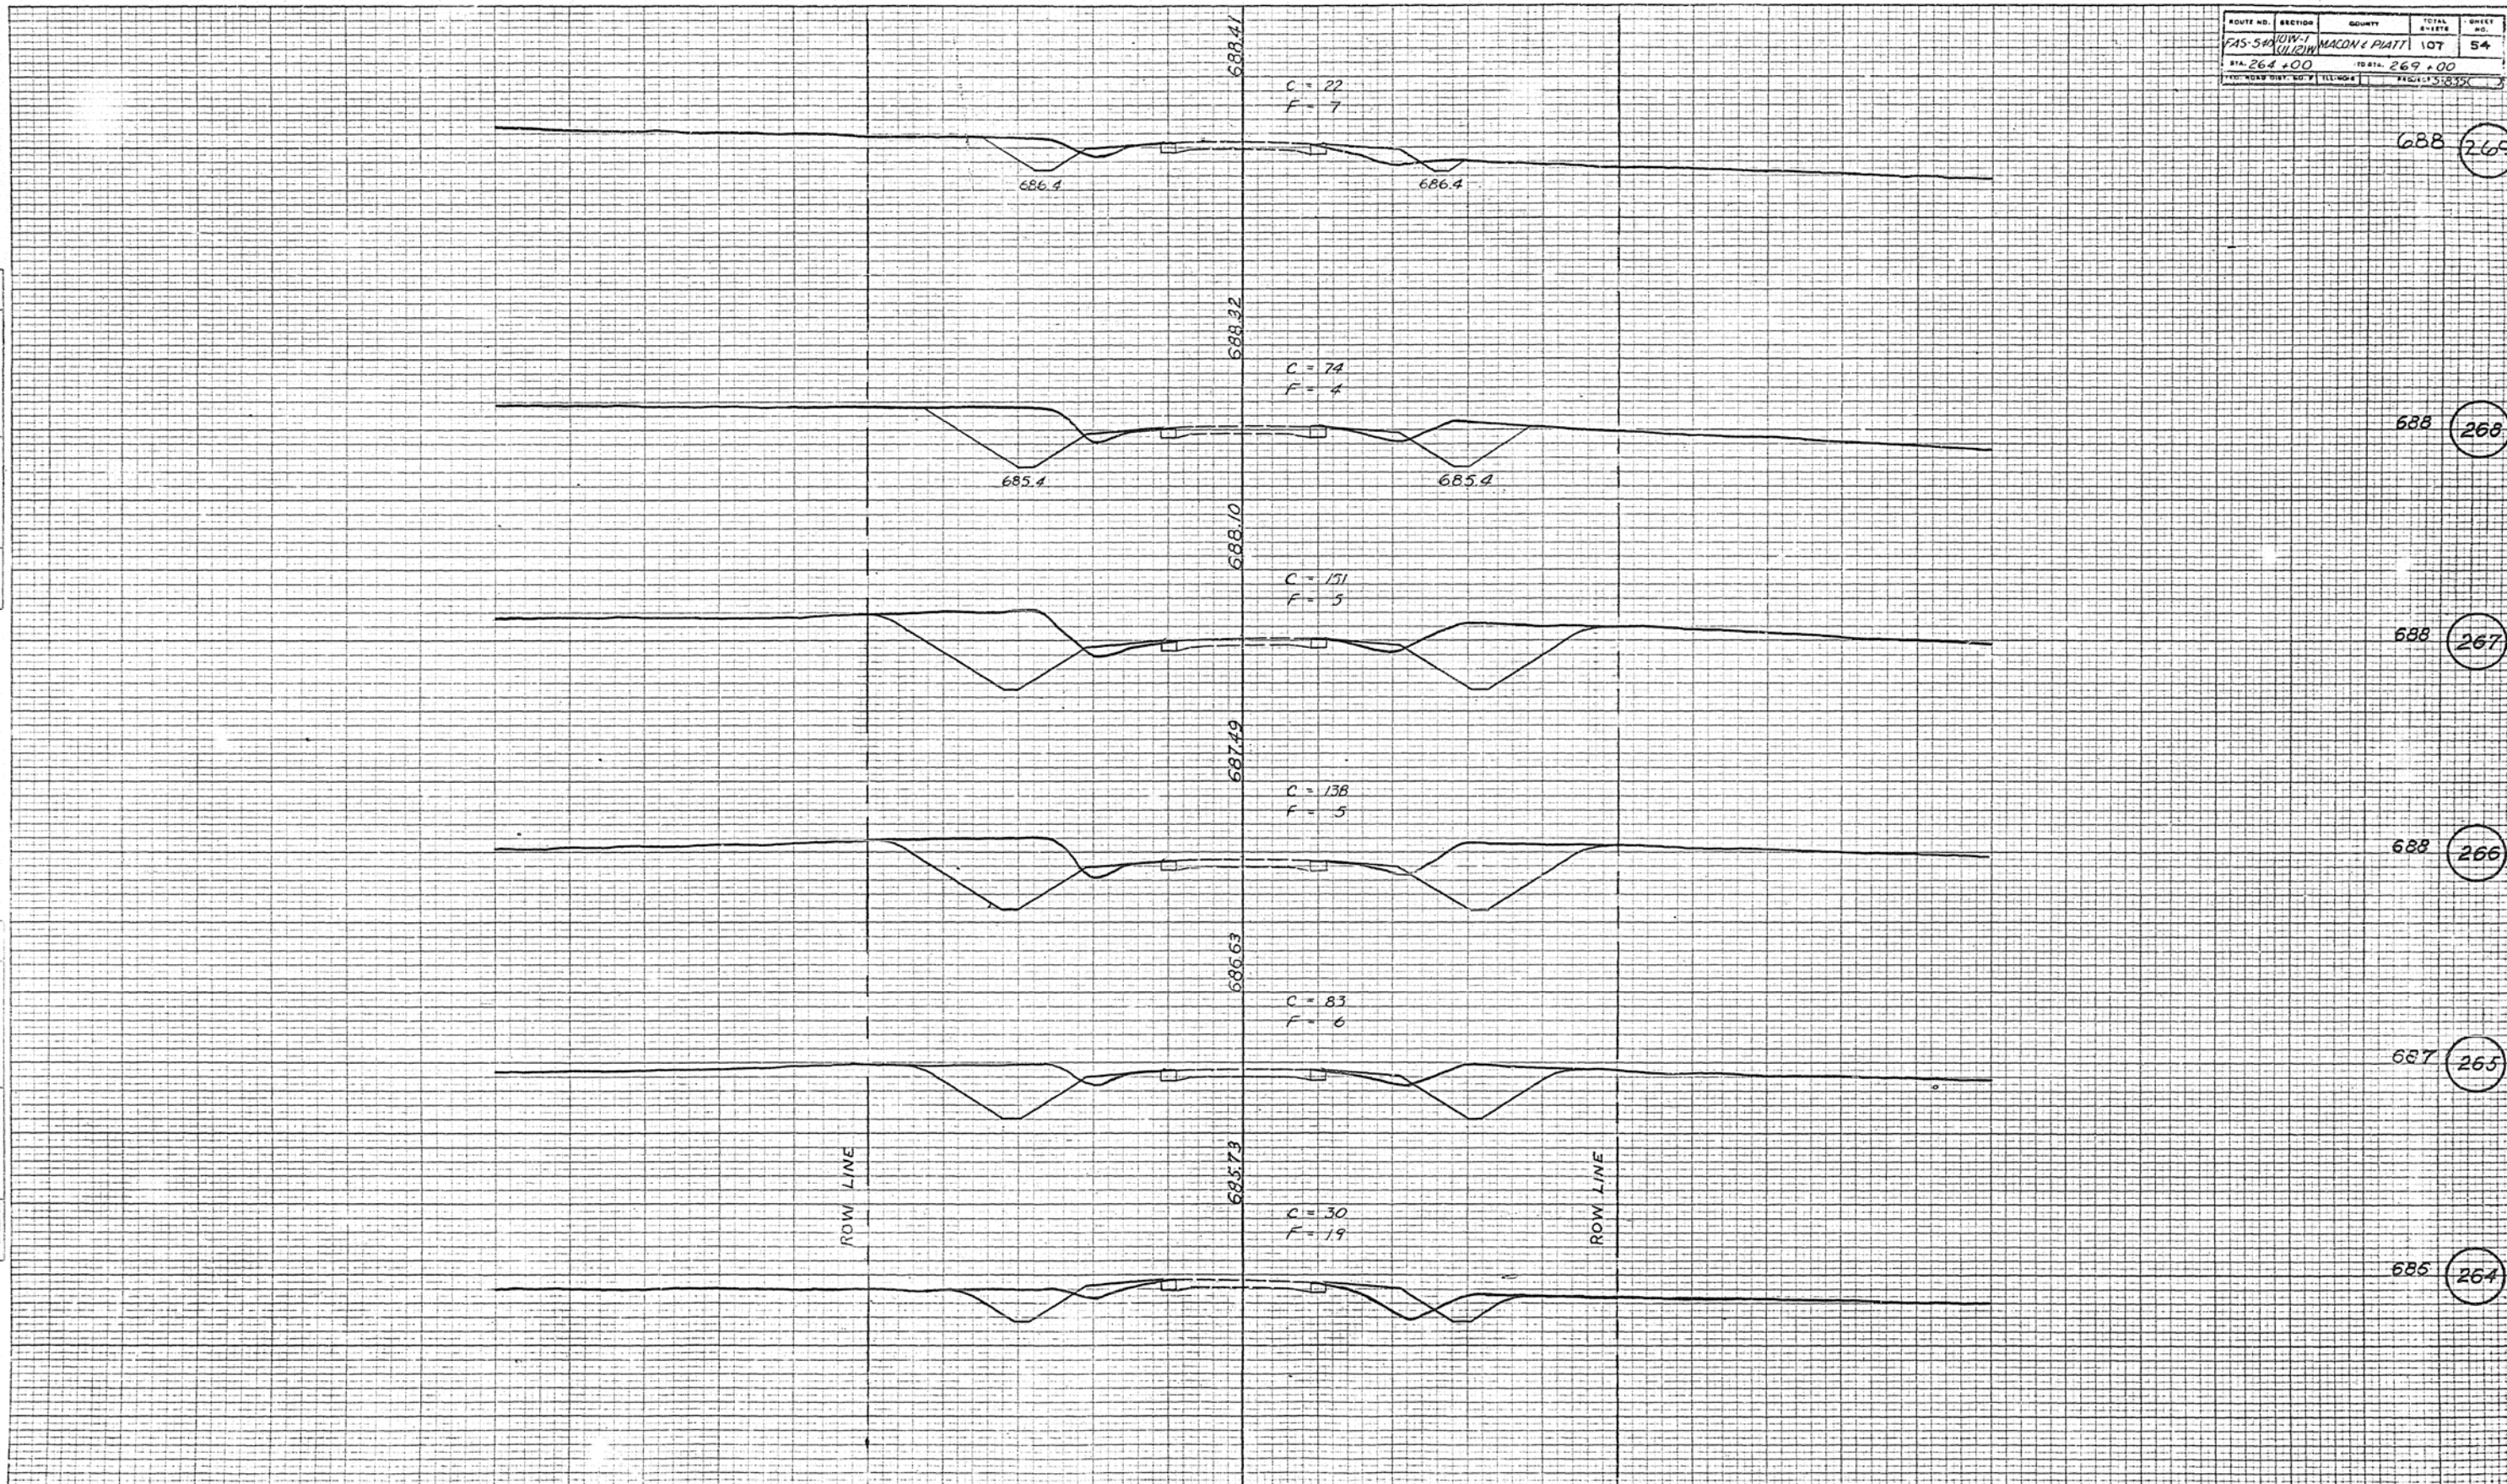



PLATE 3 CROSS SECTION 6 P.R. STANDARD
EISEN DITZEN CO. CHICAGO, NEW YORK

Printed in U.S.A.
By AMERICAN TYPING CO.

Printed in U.S.A.
On AMERICAN TYPING CO.

ORIGINAL SURVEY	BY	DATE
NOTE BOOK		
NO	SUBMITTED	
	PLOTTED	
	TRIPLATE	
	AREAS	
	AREAS CHECKED	


ROUTE NO.	SECTION	COUNTY	TOTAL SHEETS	SHEET NO.
FAS-540	10W-1 (11,12)W	MAHONGUE PLATT	107	57
STA. 282 + 00		TO STA. 287 + 00		
PROJECT NO. 5-8357		SHEET NO. 57		

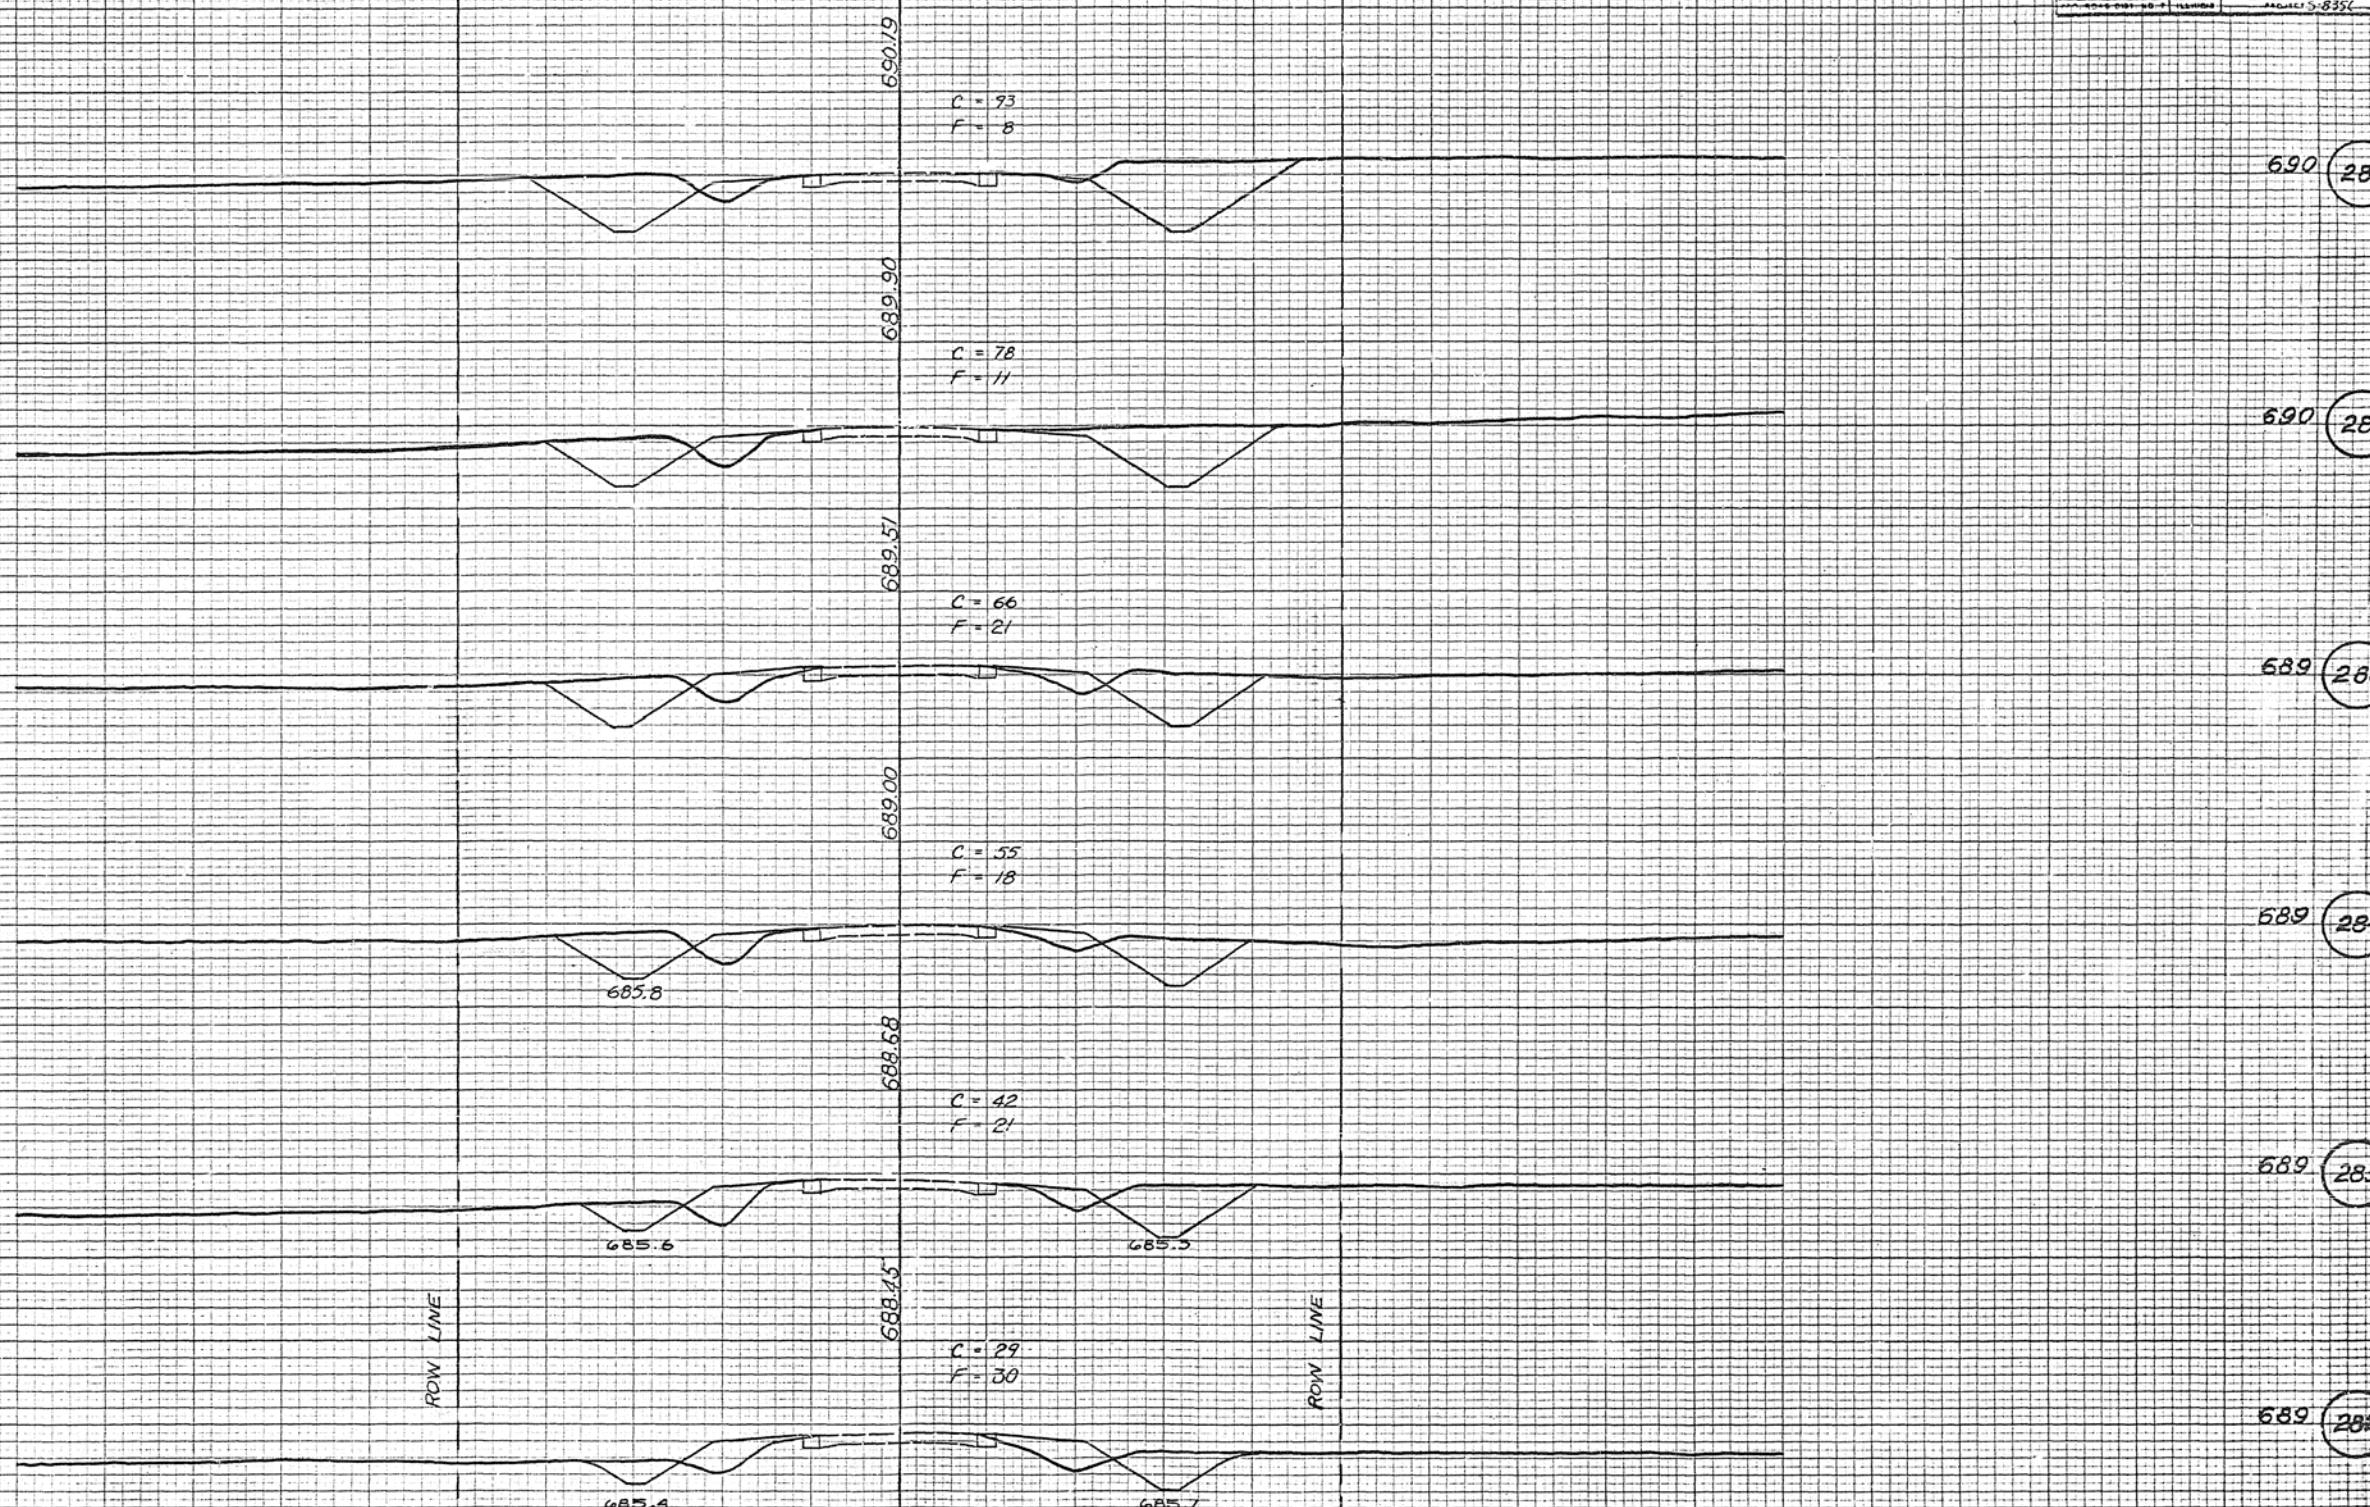

ORIGINAL SURVEY NOTE BOOK NO.	SURVEYED FLOTTED TEMPERATURE ANALYSIS CHECKED	BY STARBUCK T. J. A. T. J. B.	DATE
			6-58 6-58 6-58 6-58

ORIGINAL SURVEY NOTE BOOK NO.	SURVEYED FLOTTED TEMPERATURE ANALYSIS CHECKED	BY	DATE

ROUTE NO.	SECTION	COUNTY	TOTAL SHEET	SHEET NO.
FA-5-40	10W-1	MACON/PIATT	101	58
288+00		TO STA. 293+00		

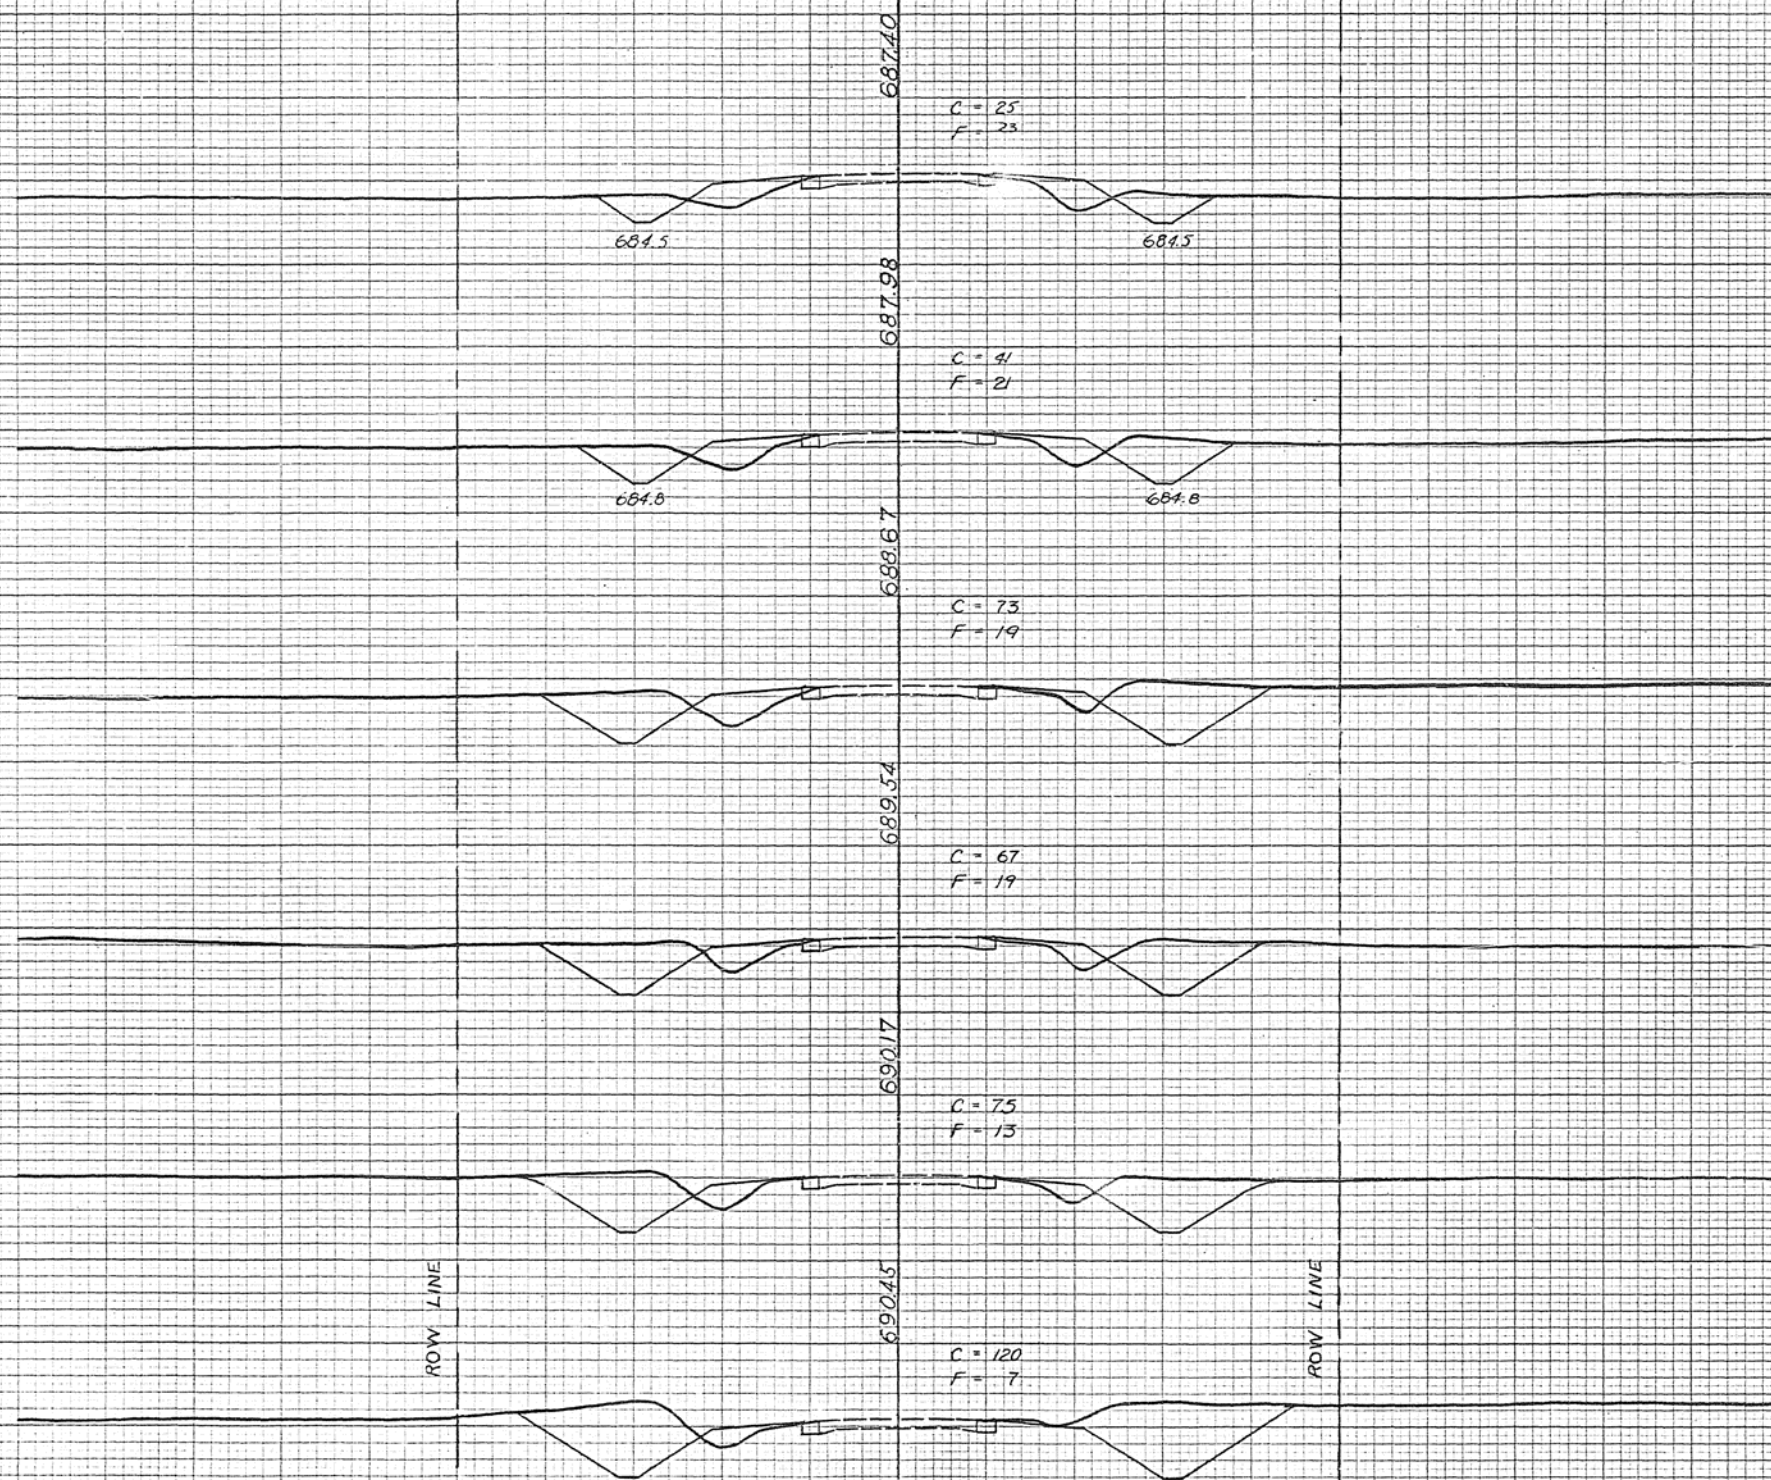

687 (293)

688 (292)

689 (291)


690 (290)

690 (289)

690 (288)


ORIGINAL SURVEY	DATE
NOTE BOOK	BY
NO.	SKETCHED _____ PLOTTED _____ TEMPLATE _____ AREAS _____ AREAS CHECKED _____

ROUTE NO.	SECTION	COUNTY	TOTAL SHEETS	SHEET NO.
625-540	10W-1 11.12W	MACON & PIATT	107	59
STA. 294 + 00		PD STA. 299 + 00		
ADD. ROAD DIST. NO. 3		PROJECT 5-838		

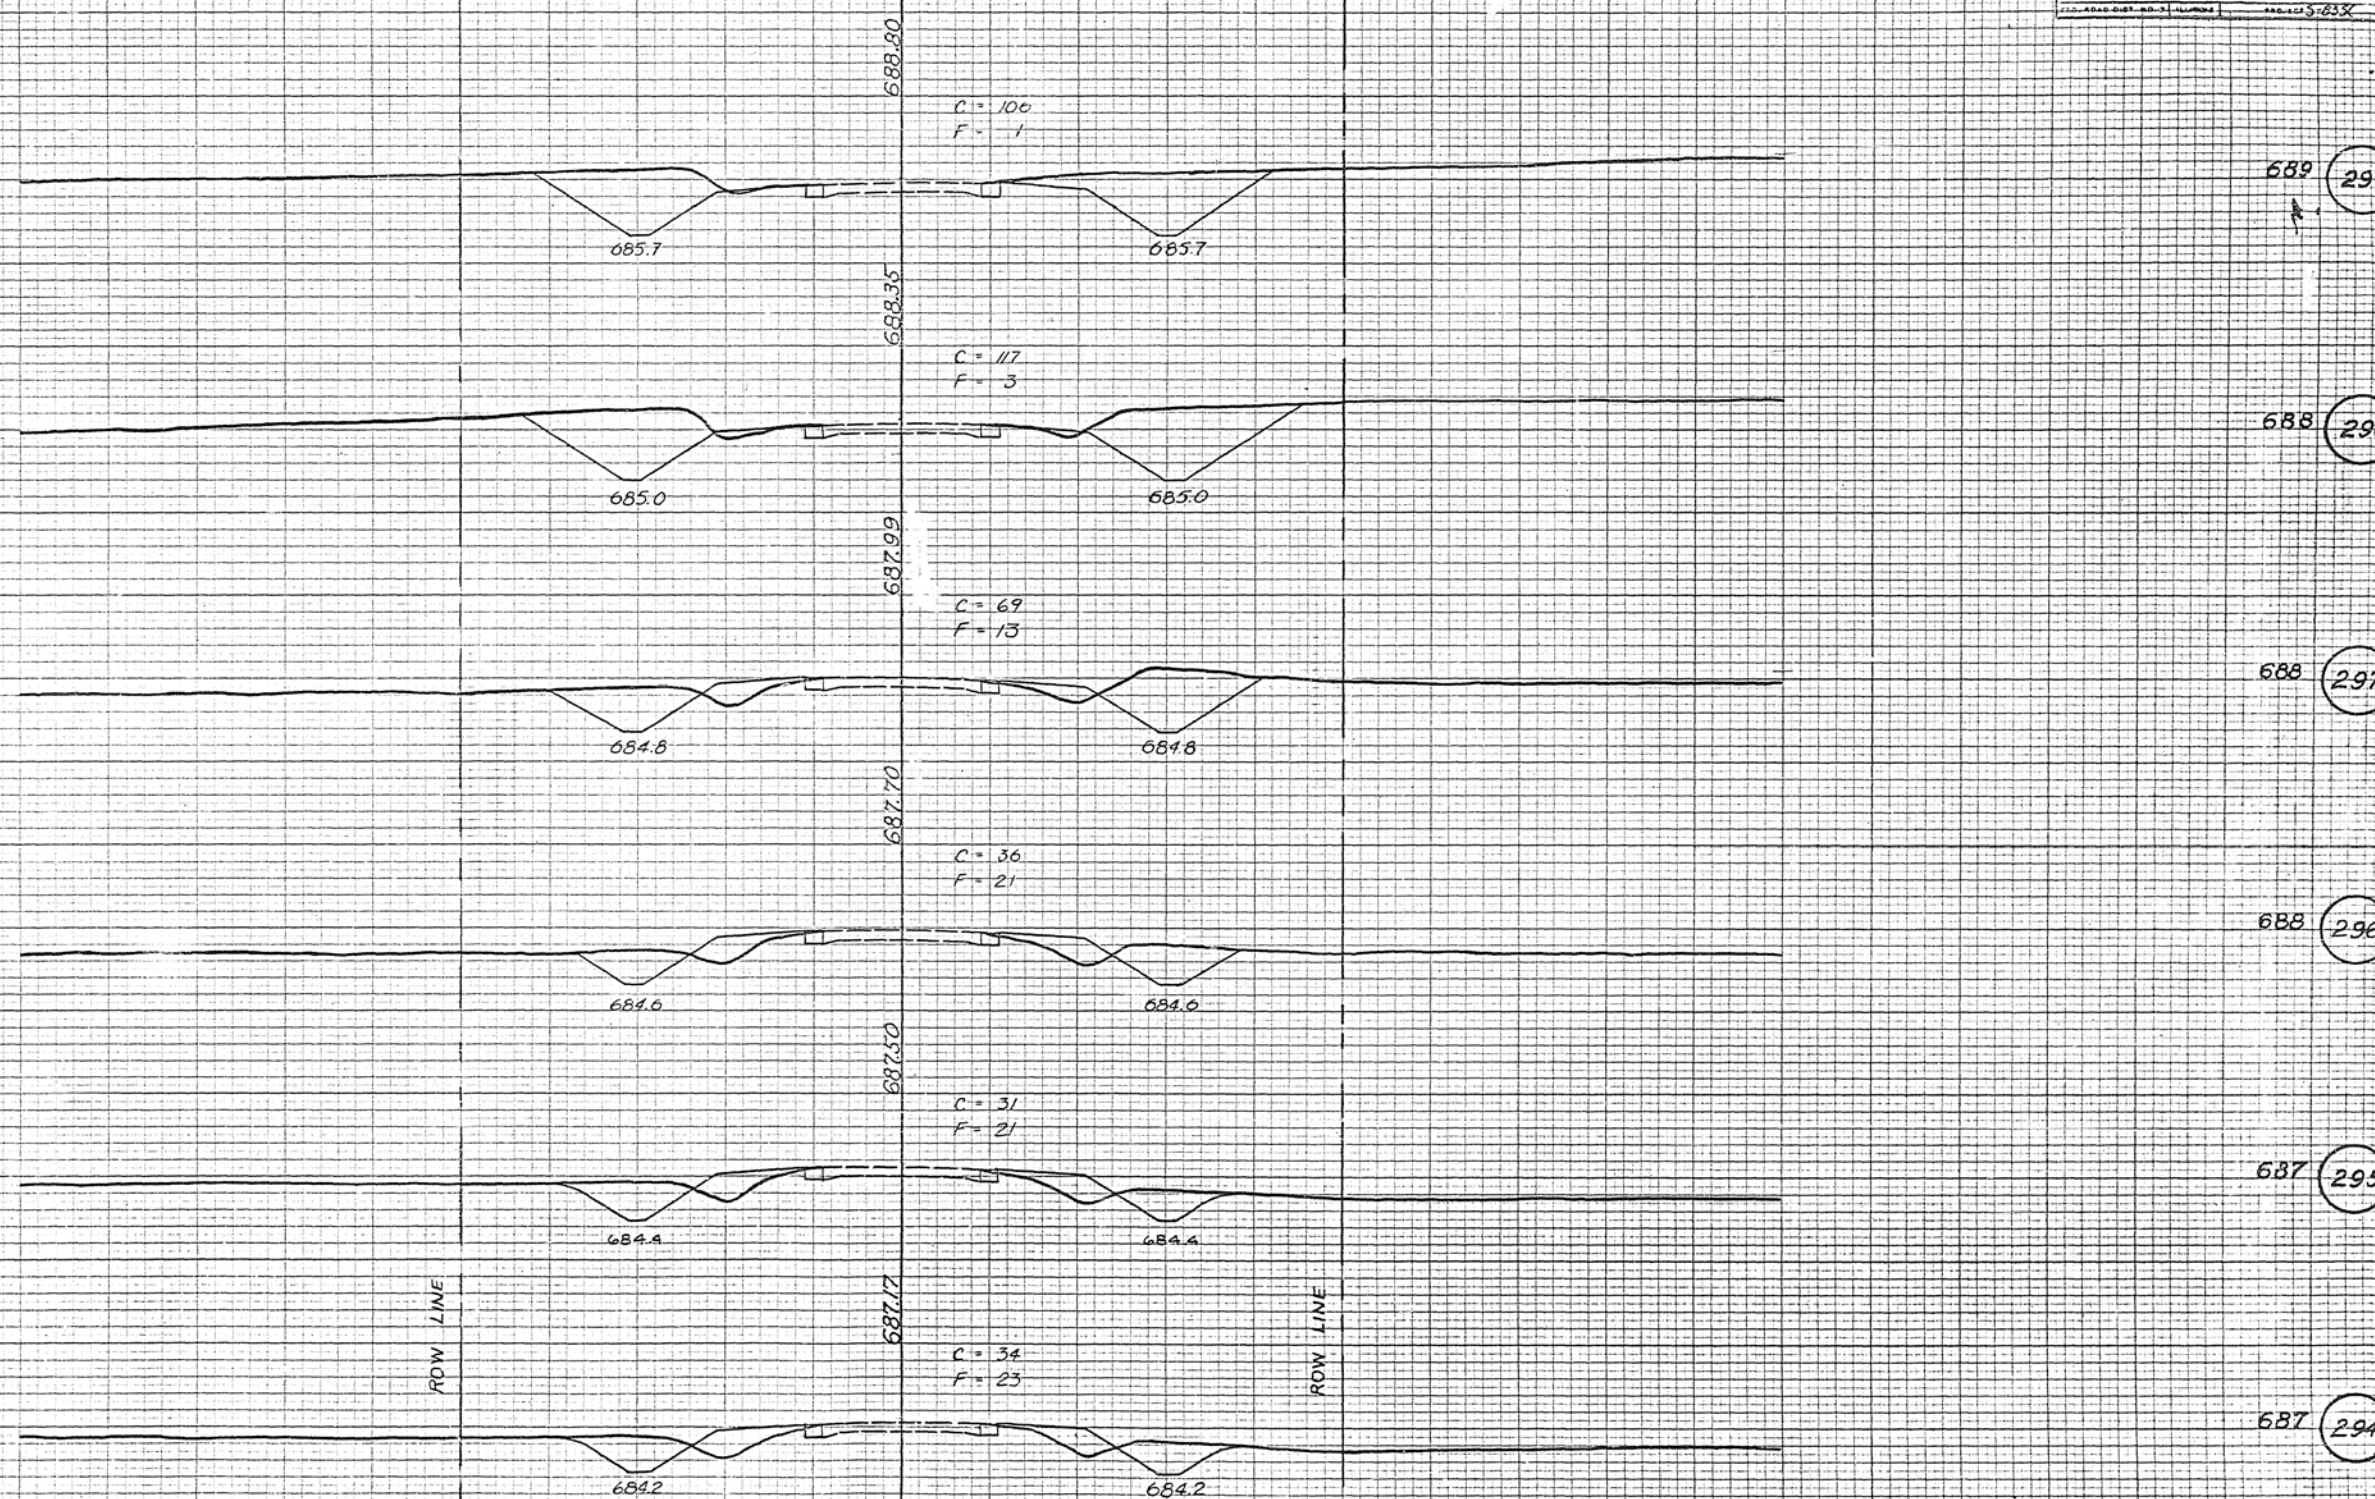

FINAL SURVEY	SUBMITTED	BY	DATE
NOTE BOOK	FLOTTED	STARBUCK	6-58
	TEMPLATE	T.L.A.	9-58
	AREAS	J.L.F.	2-60
	AREAS CHECKED	J.C.B.	5-60


DATE	BY
SURVEYED	
PLOTTED	
TEMPLATE	
INDEXED	
FILED	

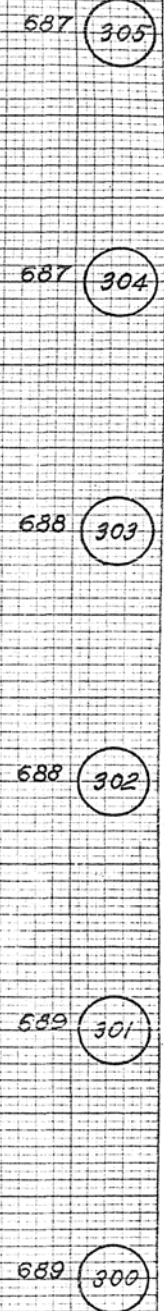

ROUTE NO.	SECTION	COUNTY	TOTAL SHEETS	SHEET NO.
PA-540	10 MI. S. CLINTON	MACON & PIATT	107	62
STA. 312+00		STA. 317+00		
SHEET NO. 62		SHEET NO. 62		

DATE	BY	REVISION	DATE	BY
6-28-60	STARBUCK			
6-28-60	T.A.			
6-28-60	J.L.			
6-28-60	C.B.			


DATE	BY	REVISION	DATE	BY

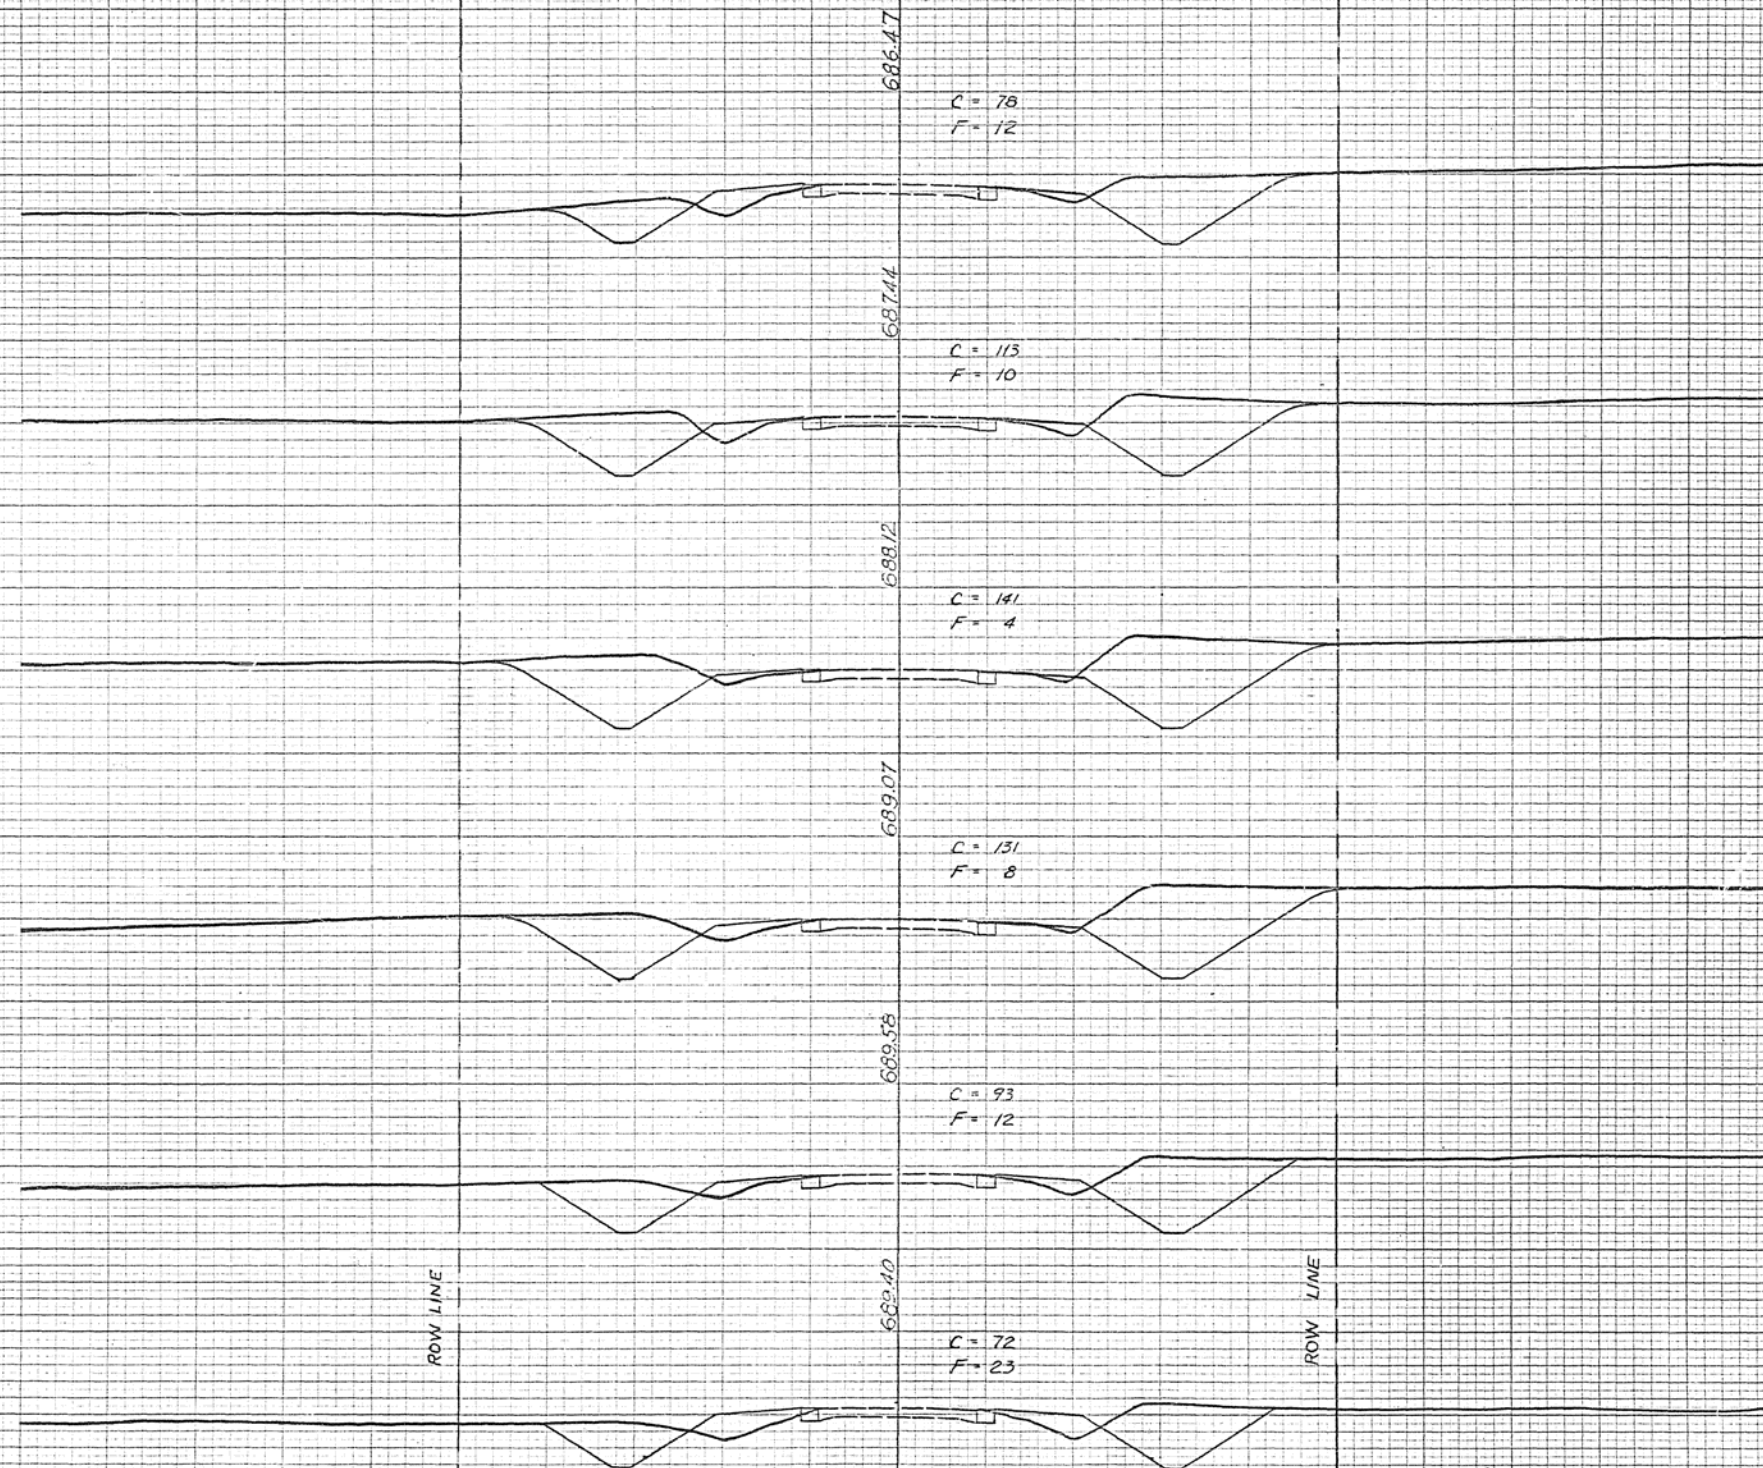

FINAL SURVEY NOTE BOOK NO. 2	SUBMITTED DATE BY J. A. BUCK J. A. B. J. J. B. J. J. B.	SERVED DATE BY J. A. B. J. A. B. J. J. B. J. J. B.	REPLATE DATE BY J. A. B. J. A. B. J. J. B. J. J. B.	AREAS CHECKED DATE BY J. A. B. J. A. B. J. J. B. J. J. B.

ORIGINAL SURVEY NOTE BOOK NO.	SUBMITTED DATE BY	SERVED DATE BY	REPLATE DATE BY	AREAS CHECKED DATE BY

ROUTE NO.	SECTION	COUNTY	TOTAL SHEET NO.	SHEET NO.
FA-540	1011-1	MACON/PUTT	107	63
STA. 318+00		POST 323+00		
SHEET NO. 1		SHEET NO. 2		

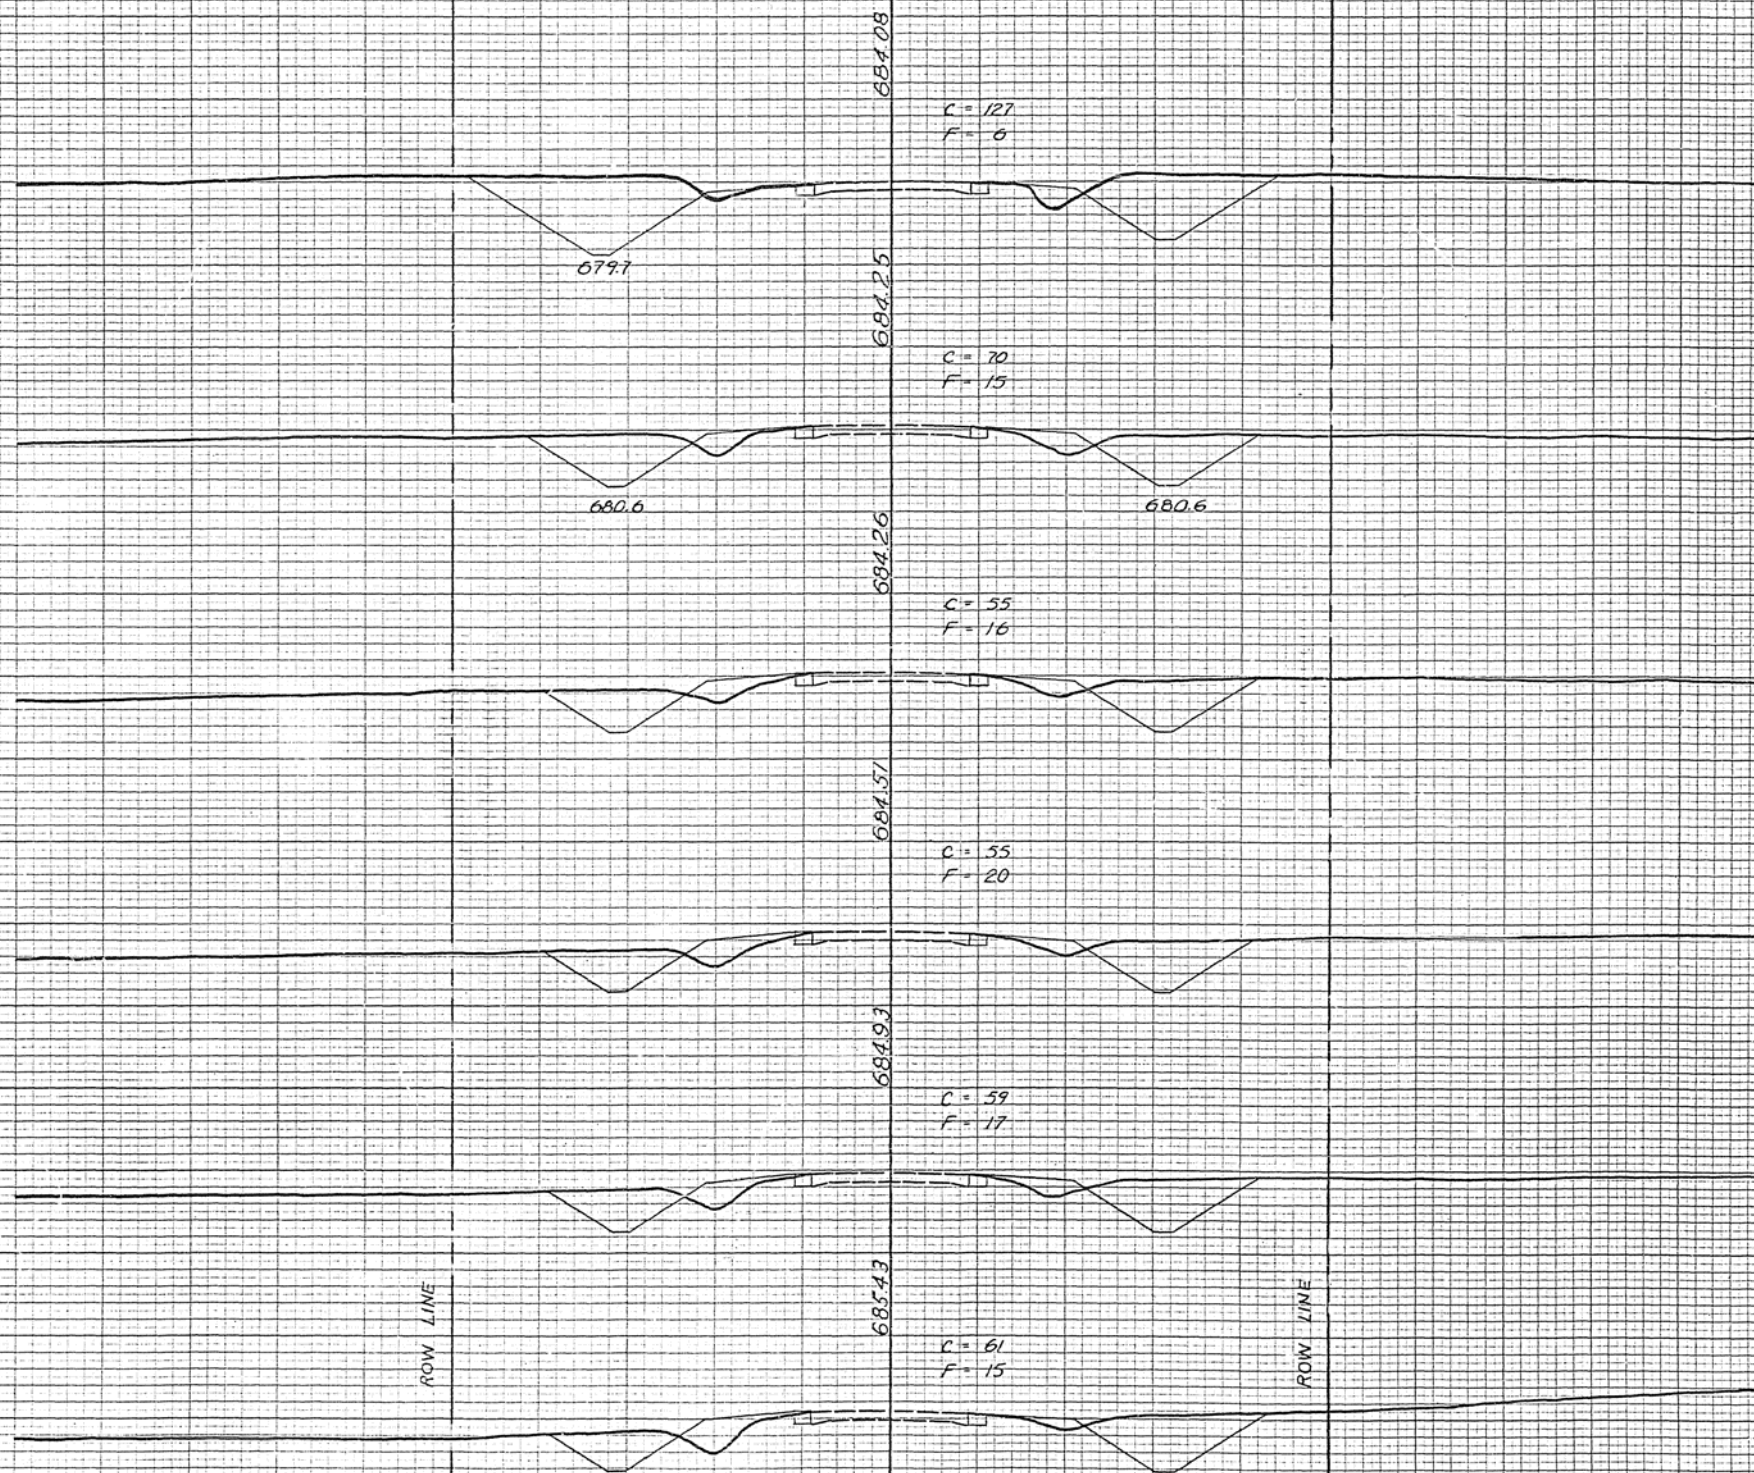

684 (323)

684 (322)

684 (321)

685 (320)

685 (319)

685 (318)


DATE	BY	DATE
6-58	STARBUCK	6-58
8-58	T. A.	8-58
9-58	J. E.	9-58
10-58		10-58
11-58		11-58
12-58		12-58
1-59		1-59
2-59		2-59
3-59		3-59
4-59		4-59
5-59		5-59
6-59		6-59
7-59		7-59
8-59		8-59
9-59		9-59
10-59		10-59
11-59		11-59
12-59		12-59
1-60		1-60
2-60		2-60
3-60		3-60
4-60		4-60
5-60		5-60
6-60		6-60
7-60		7-60
8-60		8-60
9-60		9-60
10-60		10-60
11-60		11-60
12-60		12-60
1-61		1-61
2-61		2-61
3-61		3-61
4-61		4-61
5-61		5-61
6-61		6-61
7-61		7-61
8-61		8-61
9-61		9-61
10-61		10-61
11-61		11-61
12-61		12-61
1-62		1-62
2-62		2-62
3-62		3-62
4-62		4-62
5-62		5-62
6-62		6-62
7-62		7-62
8-62		8-62
9-62		9-62
10-62		10-62
11-62		11-62
12-62		12-62
1-63		1-63
2-63		2-63
3-63		3-63
4-63		4-63
5-63		5-63
6-63		6-63
7-63		7-63
8-63		8-63
9-63		9-63
10-63		10-63
11-63		11-63
12-63		12-63
1-64		1-64
2-64		2-64
3-64		3-64
4-64		4-64
5-64		5-64
6-64		6-64
7-64		7-64
8-64		8-64
9-64		9-64
10-64		10-64
11-64		11-64
12-64		12-64
1-65		1-65
2-65		2-65
3-65		3-65
4-65		4-65
5-65		5-65
6-65		6-65
7-65		7-65
8-65		8-65
9-65		9-65
10-65		10-65
11-65		11-65
12-65		12-65
1-66		1-66
2-66		2-66
3-66		3-66
4-66		4-66
5-66		5-66
6-66		6-66
7-66		7-66
8-66		8-66
9-66		9-66
10-66		10-66
11-66		11-66
12-66		12-66
1-67		1-67
2-67		2-67
3-67		3-67
4-67		4-67
5-67		5-67
6-67		6-67
7-67		7-67
8-67		8-67
9-67		9-67
10-67		10-67
11-67		11-67
12-67		12-67
1-68		1-68
2-68		2-68
3-68		3-68
4-68		4-68
5-68		5-68
6-68		6-68
7-68		7-68
8-68		8-68
9-68		9-68
10-68		10-68
11-68		11-68
12-68		12-68
1-69		1-69
2-69		2-69
3-69		3-69
4-69		4-69
5-69		5-69
6-69		6-69
7-69		7-69
8-69		8-69
9-69		9-69
10-69		10-69
11-69		11-69
12-69		12-69
1-70		1-70
2-70		2-70
3-70		3-70
4-70		4-70
5-70		5-70
6-70		6-70
7-70		7-70
8-70		8-70
9-70		9-70
10-70		10-70
11-70		11-70
12-70		12-70
1-71		1-71
2-71		2-71
3-71		3-71
4-71		4-71
5-71		5-71
6-71		6-71
7-71		7-71
8-71		8-71
9-71		9-71
10-71		10-71
11-71		11-71
12-71		12-71
1-72		1-72
2-72		2-72
3-72		3-72
4-72		4-72
5-72		5-72
6-72		6-72
7-72		7-72
8-72		8-72
9-72		9-72
10-72		10-72
11-72		11-72
12-72		12-72
1-73		1-73
2-73		2-73
3-73		3-73
4-73		4-73
5-73		5-73
6-73		6-73
7-73		7-73
8-73		8-73
9-73		9-73
10-73		10-73
11-73		11-73
12-73		12-73
1-74		1-74
2-74		2-74
3-74		3-74
4-74		4-74
5-74		5-74
6-74		6-74
7-74		7-74
8-74		8-74
9-74		9-74
10-74		10-74
11-74		11-74
12-74		12-74
1-75		1-75
2-75		2-75
3-75		3-75
4-75		4-75
5-75		5-75
6-75		6-75
7-75		7-75
8-75		8-75
9-75		9-75
10-75		10-75
11-75		11-75
12-75		12-75
1-76		1-76
2-76		2-76
3-76		3-76
4-76		4-76
5-76		5-76
6-76		6-76
7-76		7-76
8-76		8-76
9-76		9-76
10-76		10-76
11-76		11-76
12-76		12-76
1-77		1-77
2-77		2-77
3-77		3-77
4-77		4-77
5-77		5-77
6-77		6-77
7-77		7-77
8-77		8-77
9-77		9-77
10-77		10-77
11-77		11-77
12-77		12-77
1-78		1-78
2-78		2-78
3-78		3-78
4-78		4-78
5-78		5-78
6-78		6-78
7-78		7-78
8-78		8-78
9-78		9-78
10-78		10-78
11-78		11-78
12-78		12-78
1-79		1-79
2-79		2-79
3-79		3-79
4-79		4-79
5-79		5-79
6-79		6-79
7-79		7-79
8-79		8-79
9-79		9-79
10-79		10-79
11-79		11-79
12-79		12-79
1-80		1-80
2-80		2-80
3-80		3-80
4-80		4-80
5-80		5-80
6-80		6-80
7-80		7-80
8-80		8-80
9-80		9-80
10-80		10-80
11-80		11-80
12-80		12-80
1-81		1-81
2-81		2-81
3-81		3-81
4-81		4-81
5-81		5-81
6-81		6-81
7-81		7-81
8-81		8-81
9-81		9-81
10-81		10-81
11-81		11-81
12-81		12-81
1-82		1-82
2-82		2-82
3-82		3-82
4-82		4-82
5-82		5-82
6-82		6-82
7-82		7-82
8-82		8-82
9-82		9-82
10-82		10-82
11-82		11-82
12-82		12-82
1-83		1-83
2-83		2-83
3-83		3-83
4-83		4-83
5-83		5-83
6-83		6-83
7-83		7-83
8-83		8-83
9-83		9-83
10-83		10-83
11-83		11-83
12-83		12-83
1-84		1-84
2-84		2-84
3-84		3-84
4-84		4-84
5-84		5-84
6-84		6-84
7-84		7-84
8-84		8-84
9-84		9-84
10-84		10-84
11-84		11-84
12-84		12-84
1-85		1-85
2-85		2-85
3-85		3-85
4-85		4-85
5-85		5-85
6-85		6-85
7-85		7-85
8-85		8-85
9-85		9-85
10-85		10-85
11-85		11-85
12-85		12-85
1-86		1-86
2-86		2-86
3-86		3-86
4-86		4-86
5-86		5-86
6-86		6-86
7-86		7-86
8-86		8-86
9-86		9-86
10-86		10-86
11-86		11-86
12-86		12-86
1-87		1-87
2-87		2-87
3-87		3-87
4-87		4-87
5-87		5-87
6-87		6-87
7-87		7-87
8-87		8-87
9-87		9-87
10-87		10-87
11-87		11-87
12-87		12-87
1-88		1-88
2-88		2-88
3-88		3-88
4-88		4-88
5-88		5-88
6-88		6-88
7-88		7-88
8-88		8-88
9-88		9-88
10-88		10-88
11-88		11-88
12-88		12-88
1-89		1-89
2-89		2-89
3-89		3-89
4-89		4-89
5-89		5-89
6-89		6-89
7-89		7-89
8-89		8-89
9-89		9-89
10-89		10-89
11-89		11-89
12-89		12-89
1-90		1-90

ORIGINAL SURVEY	BY	DATE
SUNSHED		
PLOTTED		
TEMPLATE		
ARLAS		
ARLAS CHECKED		

PIECE NO.	SECTION	COUNTY	TOTAL EN/FTL	BLK NO.
FAS-540	10 W-1 (11, 12) W	MACONE PLATT	10%	63
STA. 330 + 00		TO STA. 335 + 00		
ROAD DIST. NO. 7		ILLINOIS	ROUTE 6	

NOTE:


THE PROPOSED ELEVATION AS SHOWN
IS TO THE TOP OF THE PROPOSED
1-11 RESURFACING

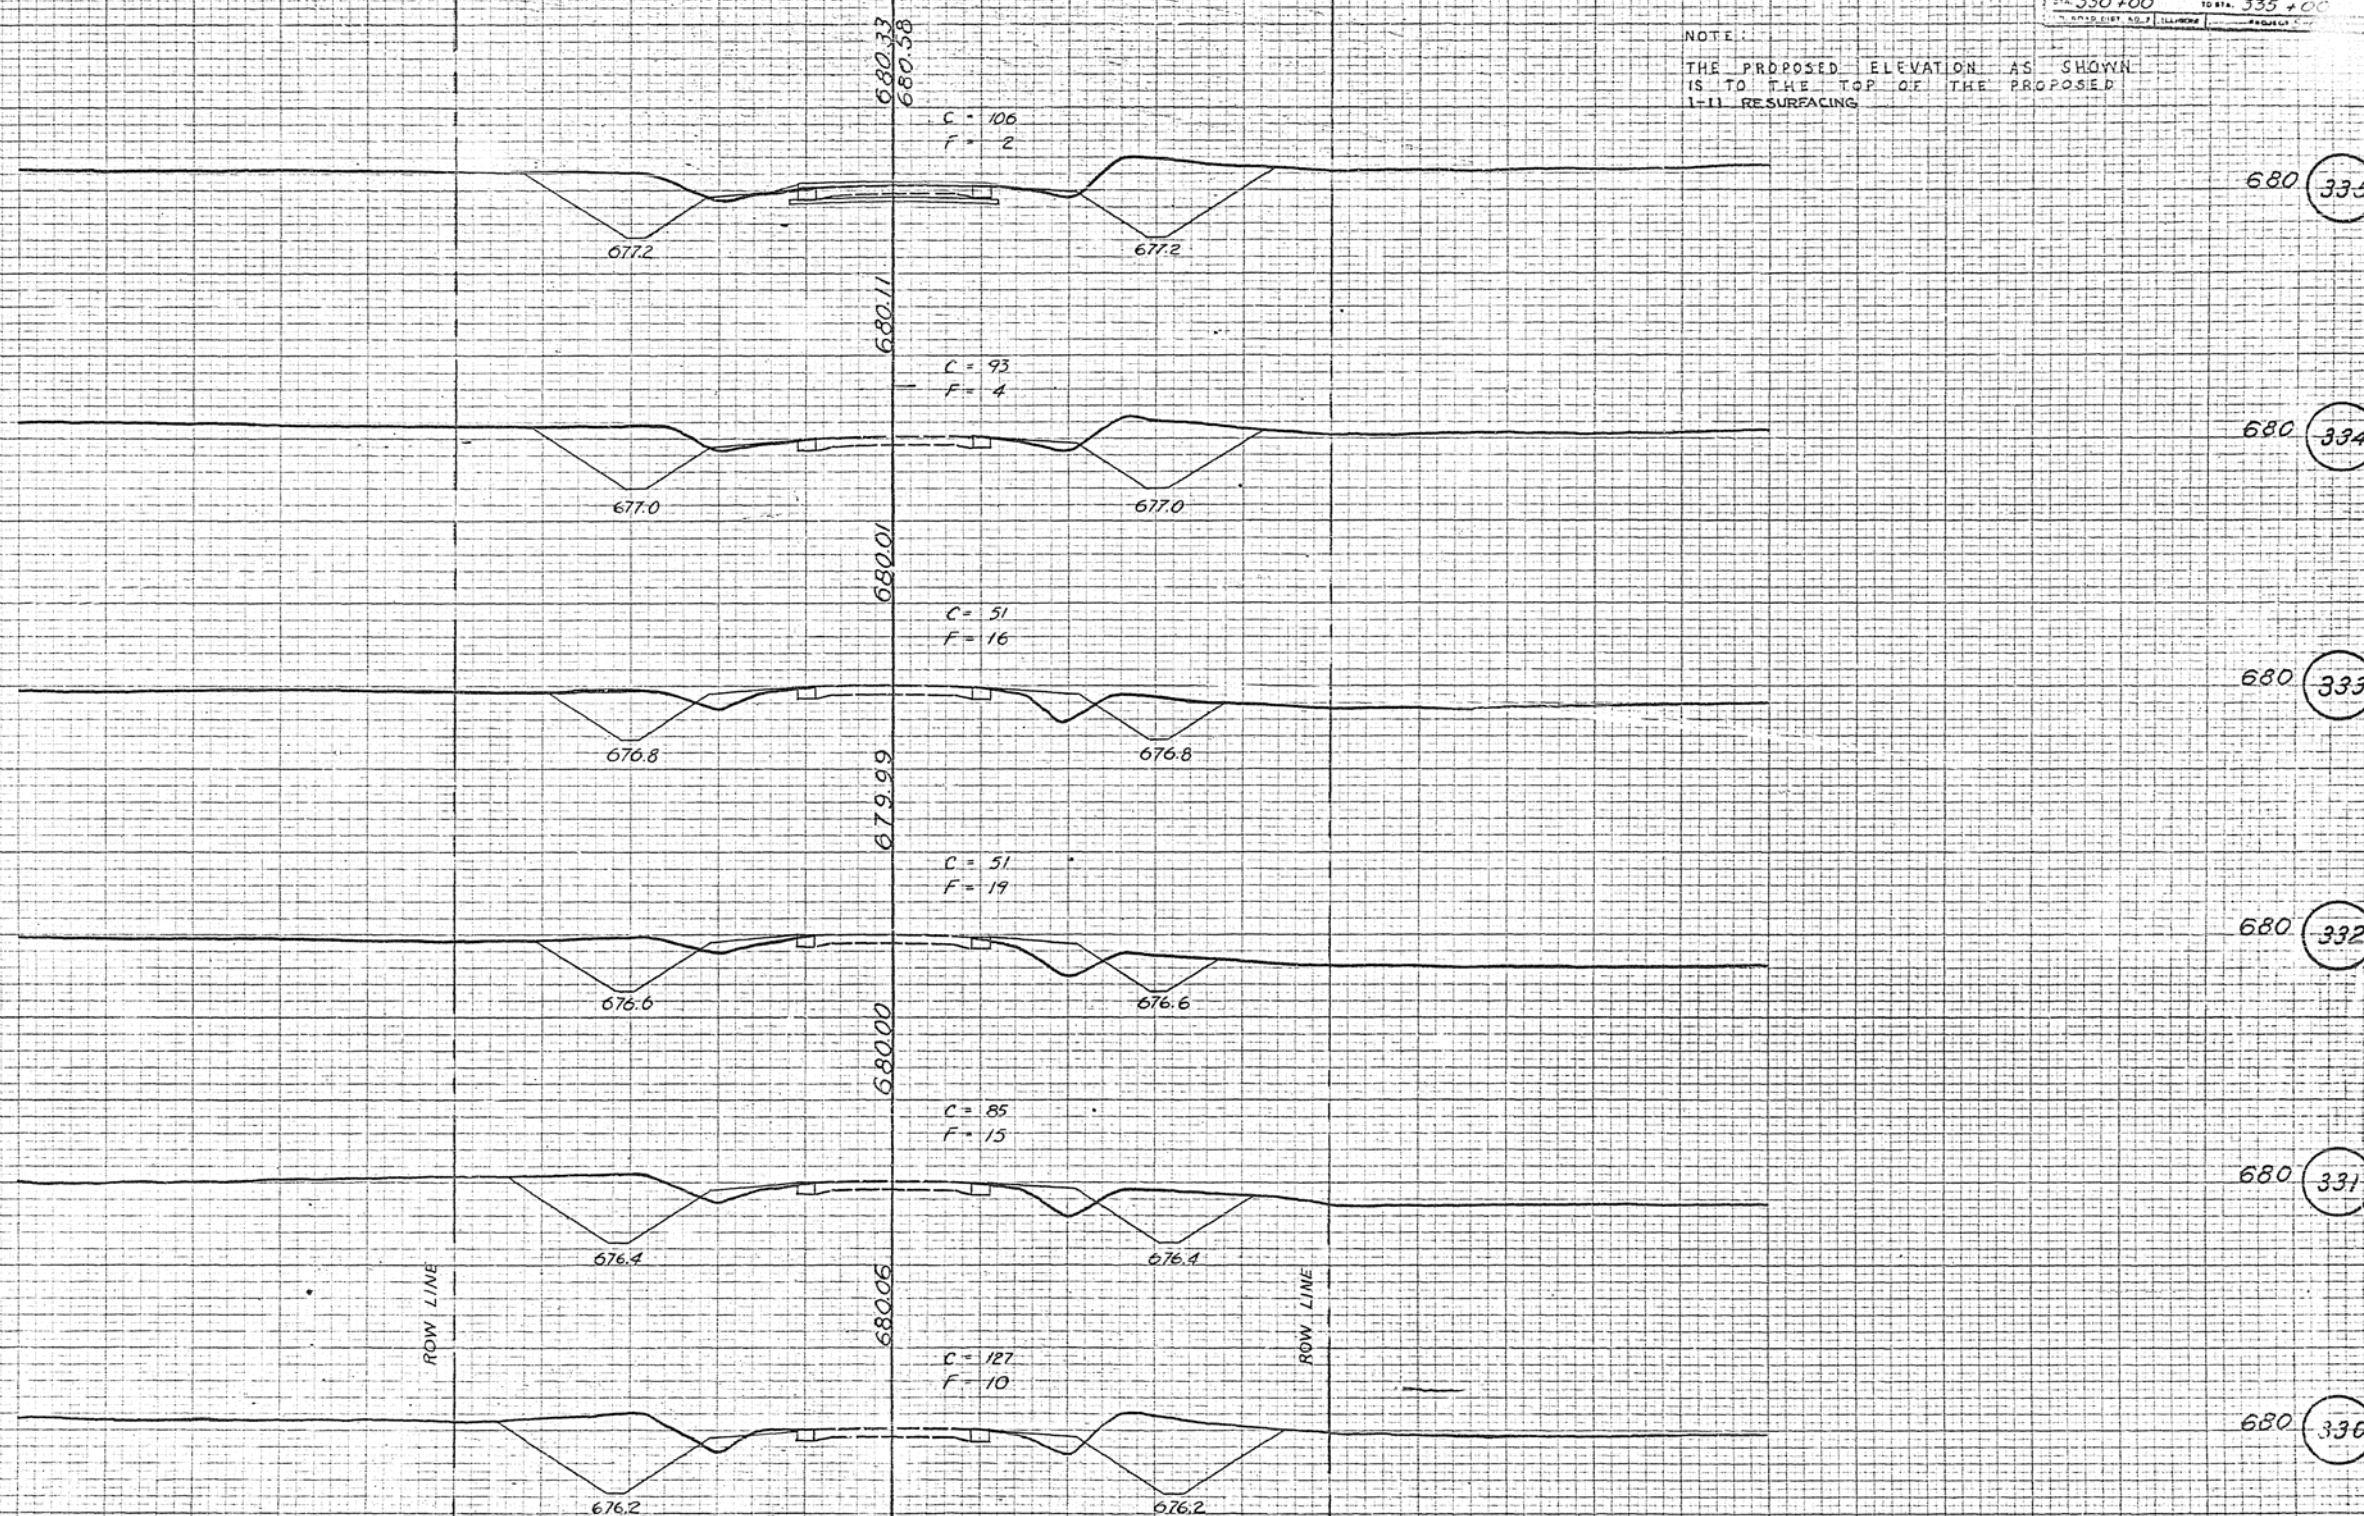

ROUTE NO.	SECTION	COUNTY	TOWNSHIP	RANGE	SHEET NO.
F.A.S. 540	10W-1 (11,12)W	MACON	PIATT	107	GT
STA. 342+00				POST M. 347+00	
1" = 40' ROAD DIST. NO. 7 ILLINOIS PROJECT 5-835()					

DATE	BY	REVIEWED	DATE
6-50	STARBUCK		
9-50	J.L.A.		
2-60	J.L.F.		
5-60	C.J.B.		

DATE	BY	REVIEWED	DATE

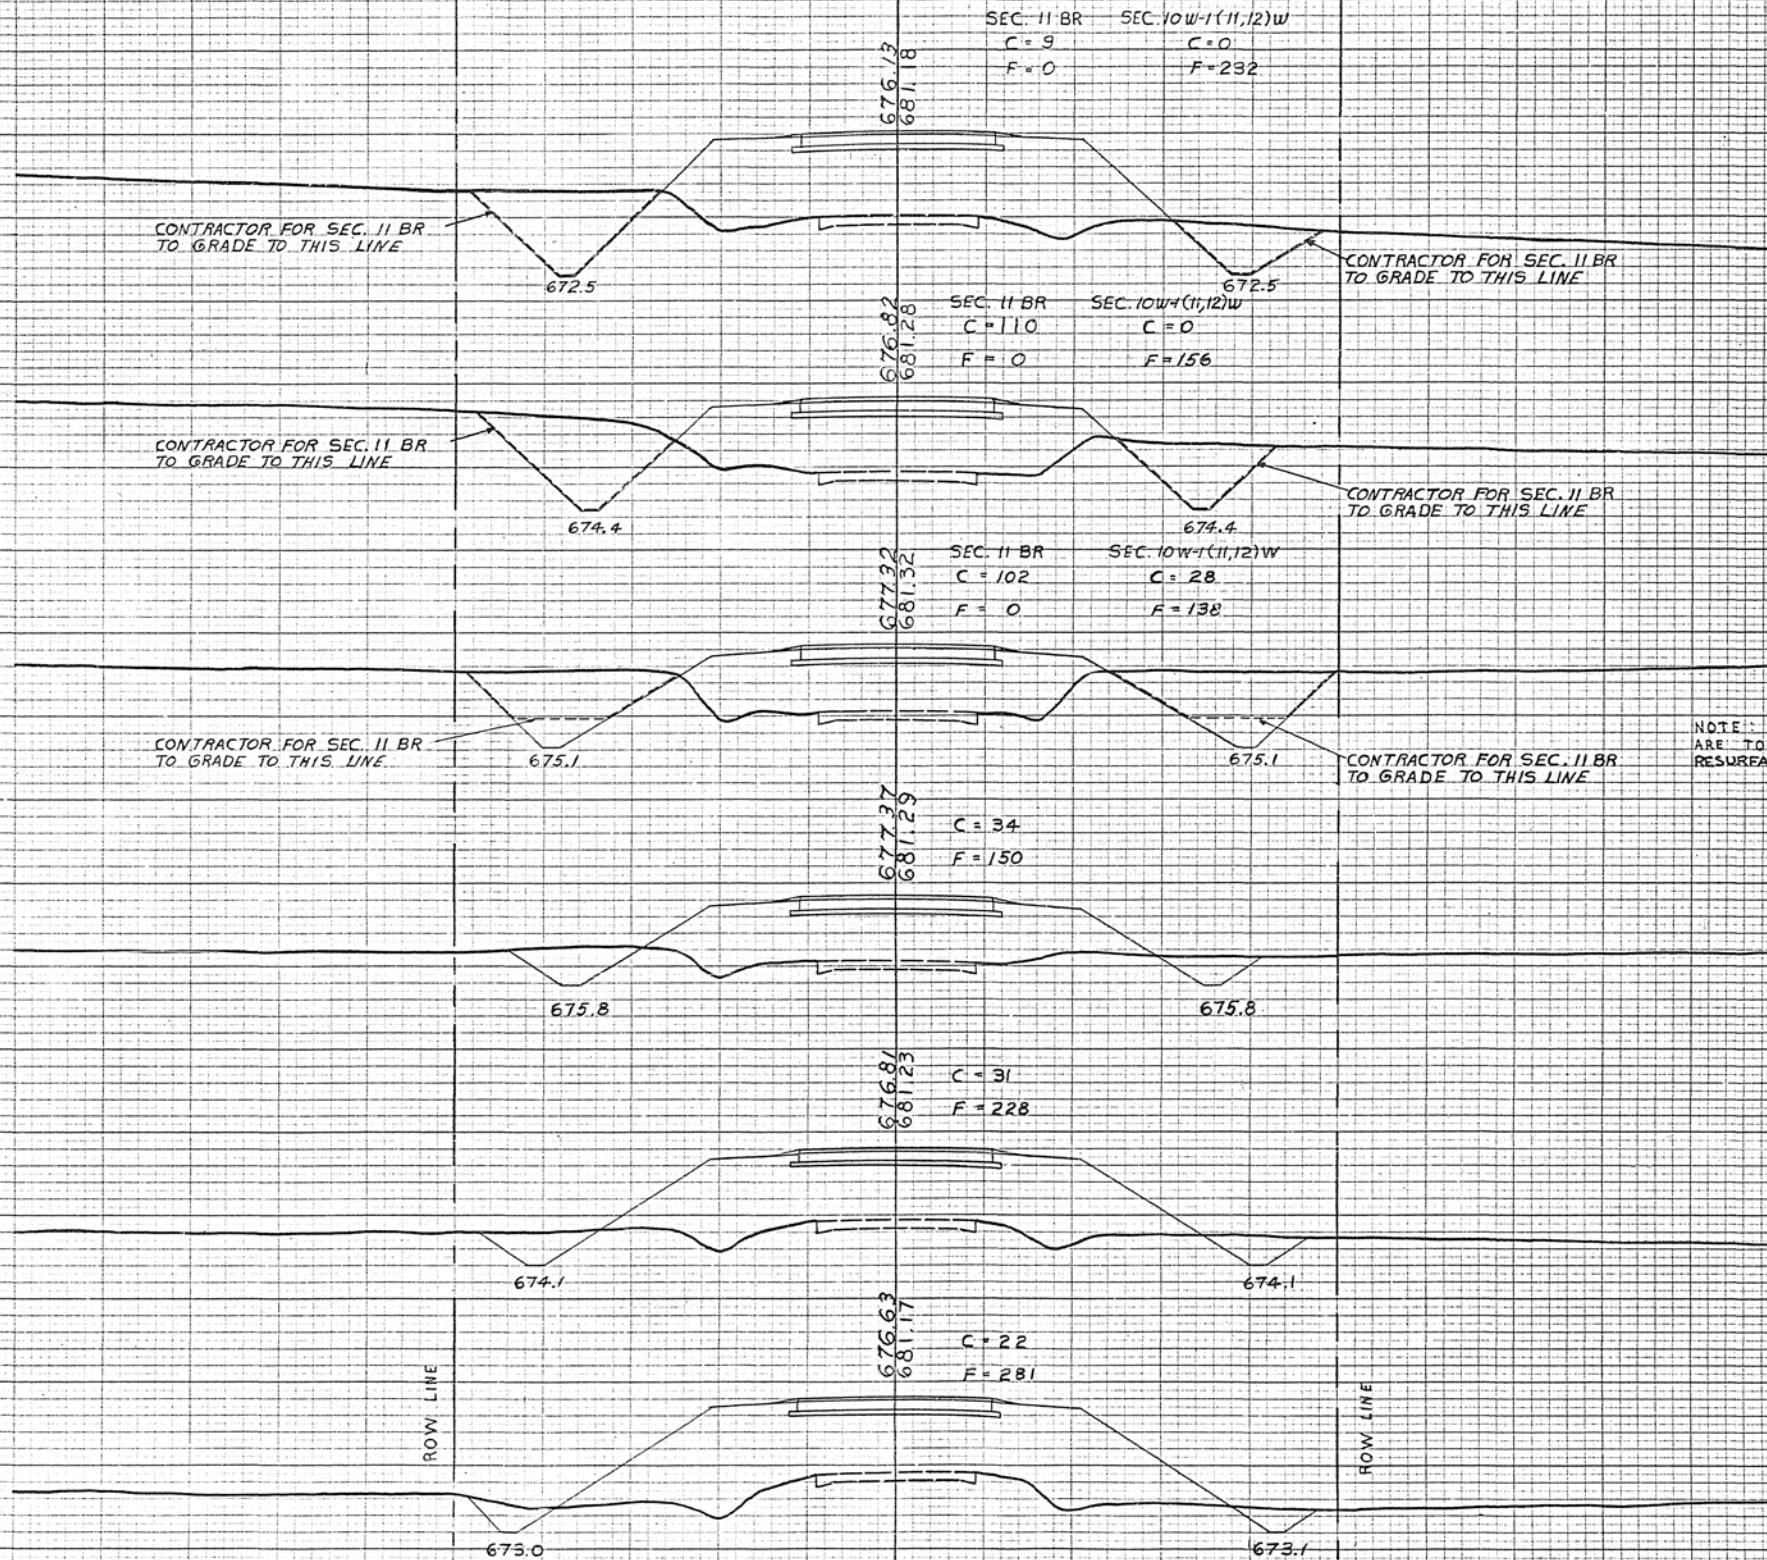


NOTE: PROPOSED ELEVATIONS AS SHOWN ARE TO THE TOP OF THE PROPOSED I-11 RESURFACING



DATE	6-55
BY	STARBUCK
SURVEYED	U.A.
NOTED	J.L.F.
AREA	C.J.B.
NO.	2

DATE	
BY	
SURVEYED	
NOTED	
AREA	
NO.	

ROUTE NO.	SECTION	RIGHT	TO R.	DATE
F.A.S. 10W-1	MACON	PIATT	107	68
STA. 348+00	ED STA.	350+00		
PER. ROAD DIST. NO. 1	ILLINOIS	PER. DIST. NO. 2	350	

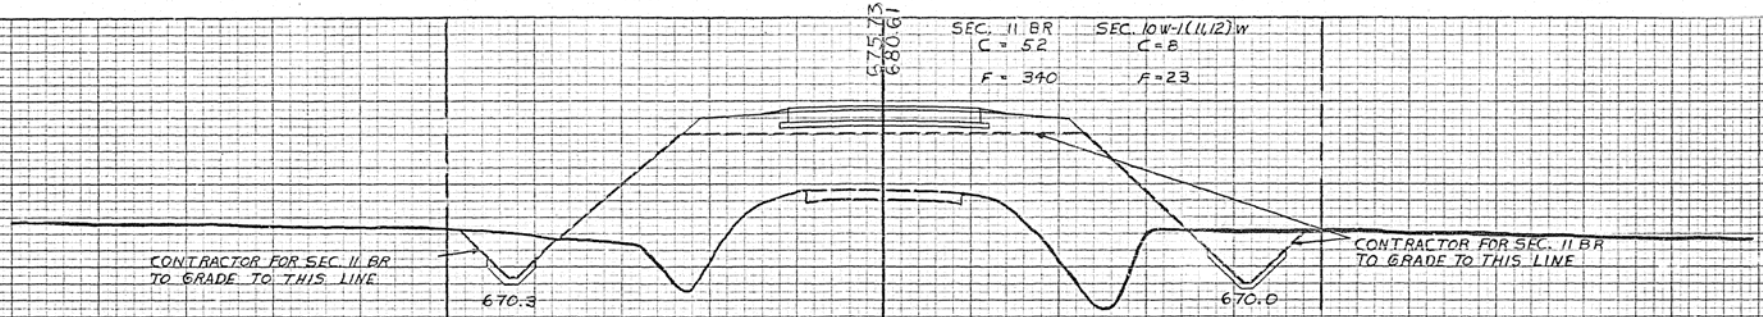


NOTE: PROPOSED ELEVATIONS AS SHOWN ARE TO THE TOP OF THE PROPOSED I-11 RESURFACING.

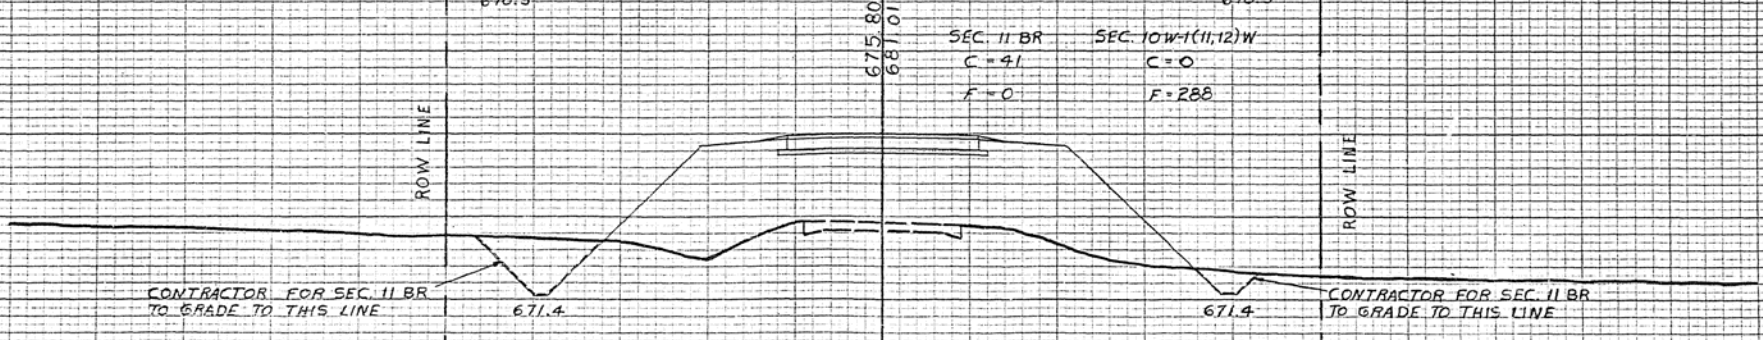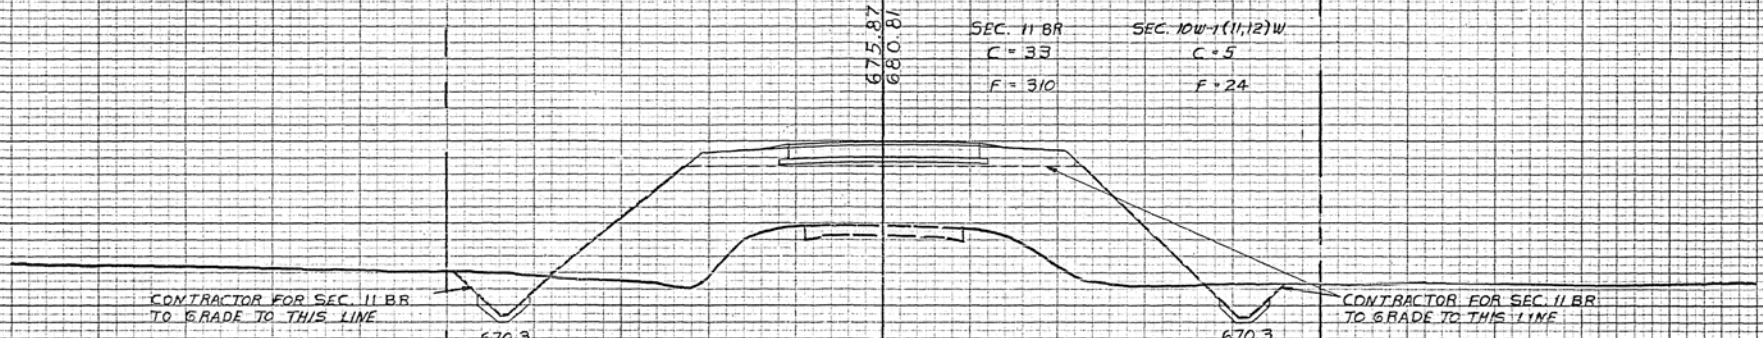

DATE	BY	PROJECT	SECTION	PIVOT	STATION
6-58	STARBUCK	MAISON	107	69	
8-58	L.A.	PIATT			
2-60	J.E.				
5-60	J.B.				

DATE	BY	PROJECT	SECTION	PIVOT	STATION
6-58	STARBUCK	MAISON	107	69	
8-58	L.A.	PIATT			
2-60	J.E.				
5-60	J.B.				

DATE	BY	PROJECT	SECTION	PIVOT	STATION
6-58	STARBUCK	MAISON	107	69	
8-58	L.A.	PIATT			
2-60	J.E.				
5-60	J.B.				

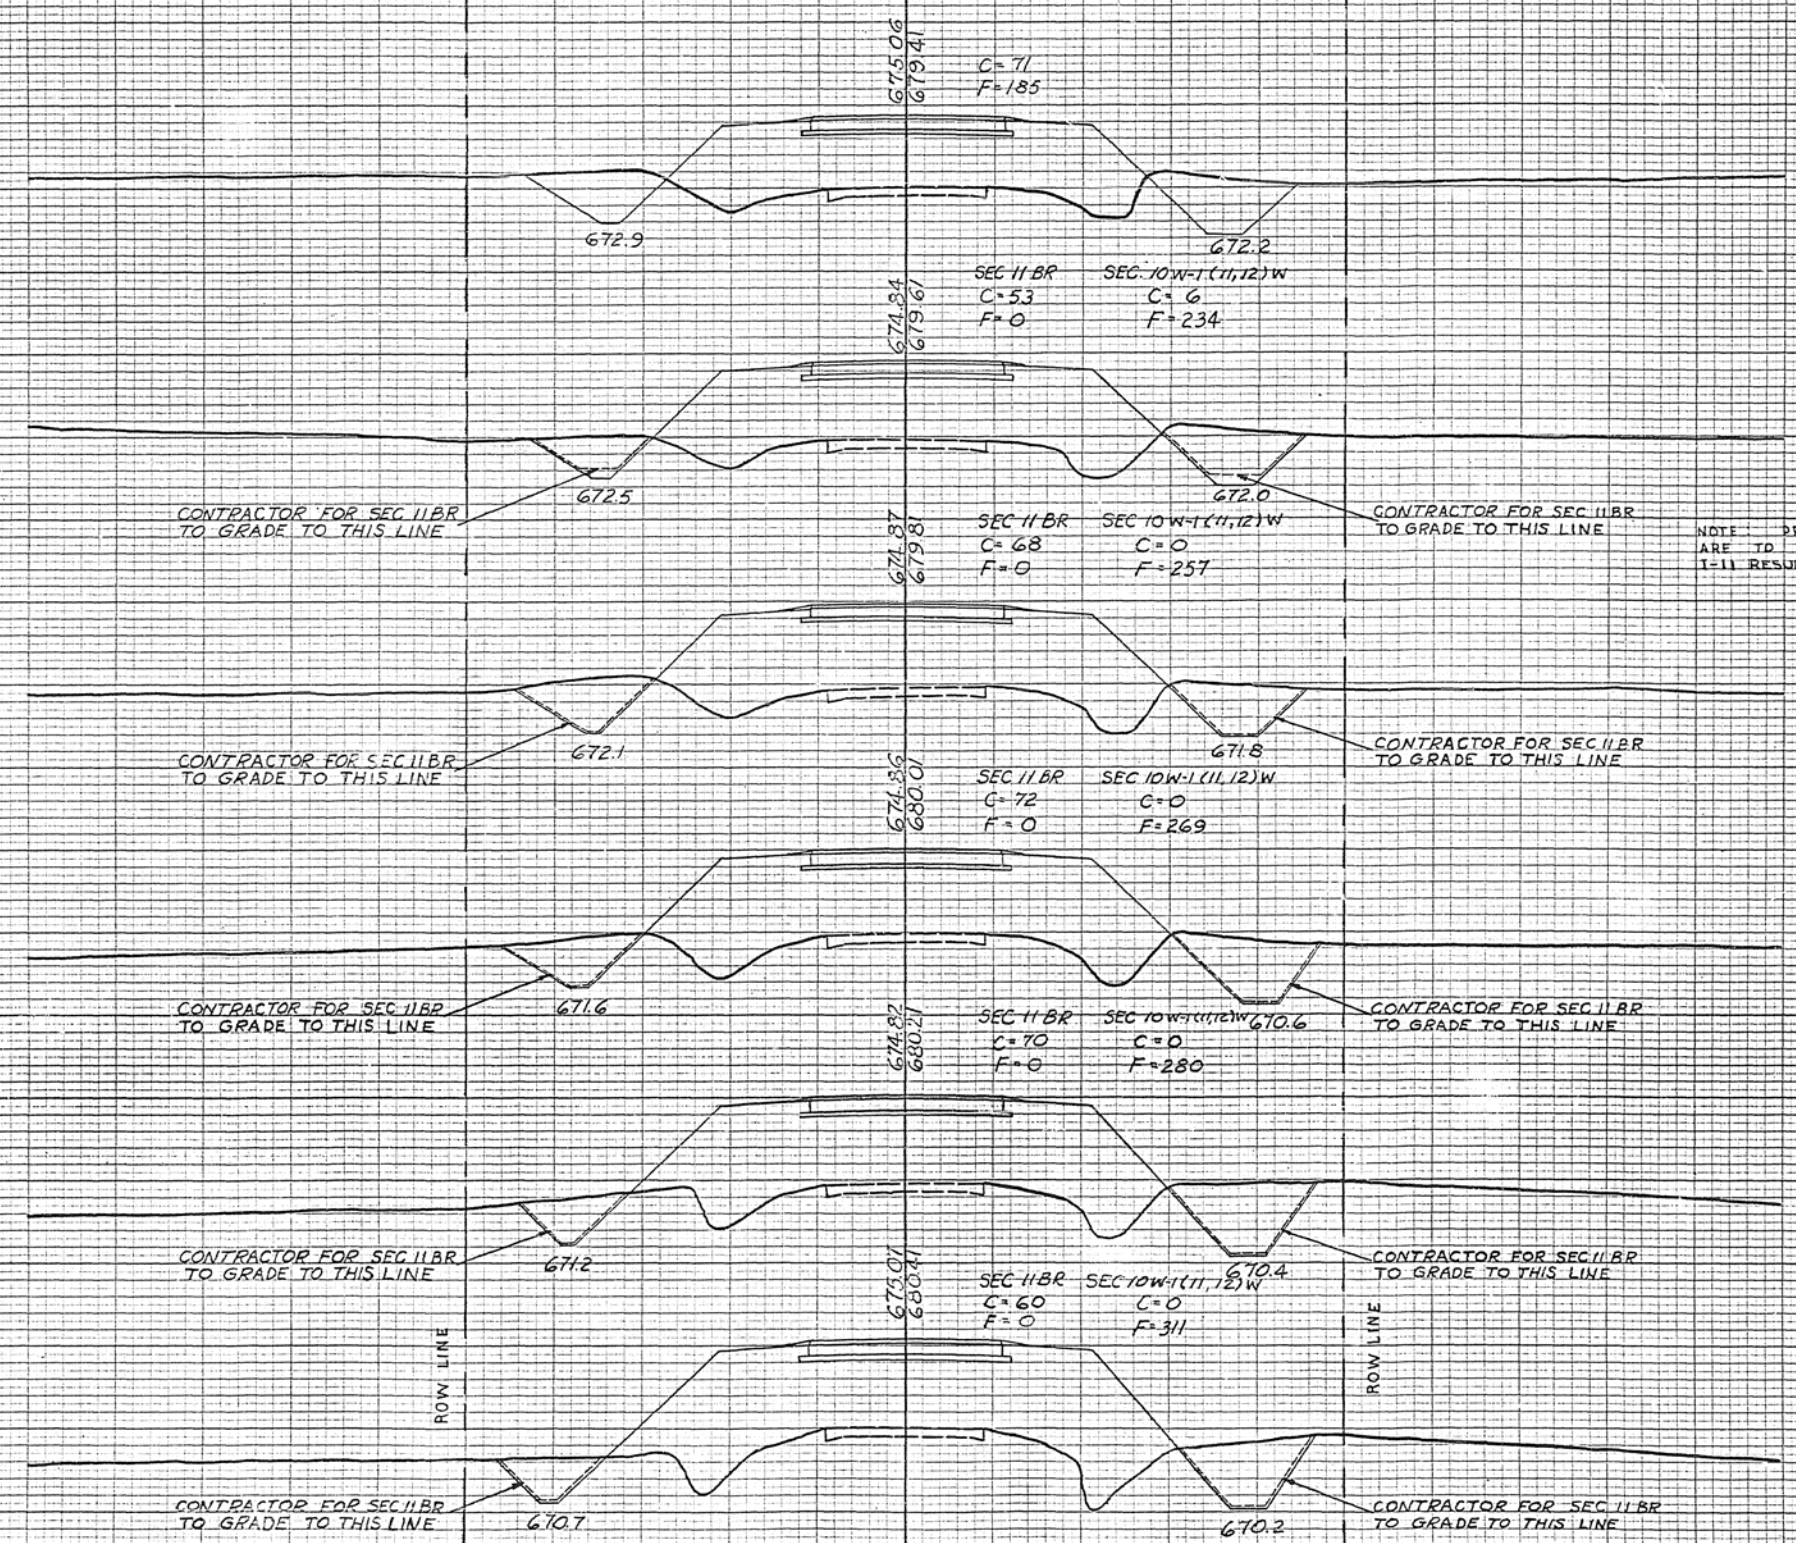


NOTE: PROPOSED ELEVATIONS AS SHOWN ARE TO THE TOP OF THE PROPOSED T-11 RESURFACING

ROUTE NO.	SECTION	COUNTY	TOTAL	DATE
F.A.S. 104-1	MACOM 2	ILLINOIS	107	TO
540	KILIZH	PIATT		
STA. 357+00	PC STA. 362+00			
100' ROAD DIST. NO. 1	ILLINOIS	PROJECT 5-55		

DATE	BY	REVISION
6-88	STARBUCK	
8-88	T.A.	
2-89	J.L.F.	
5-89	C.J.B.	

DATE	BY	REVISION

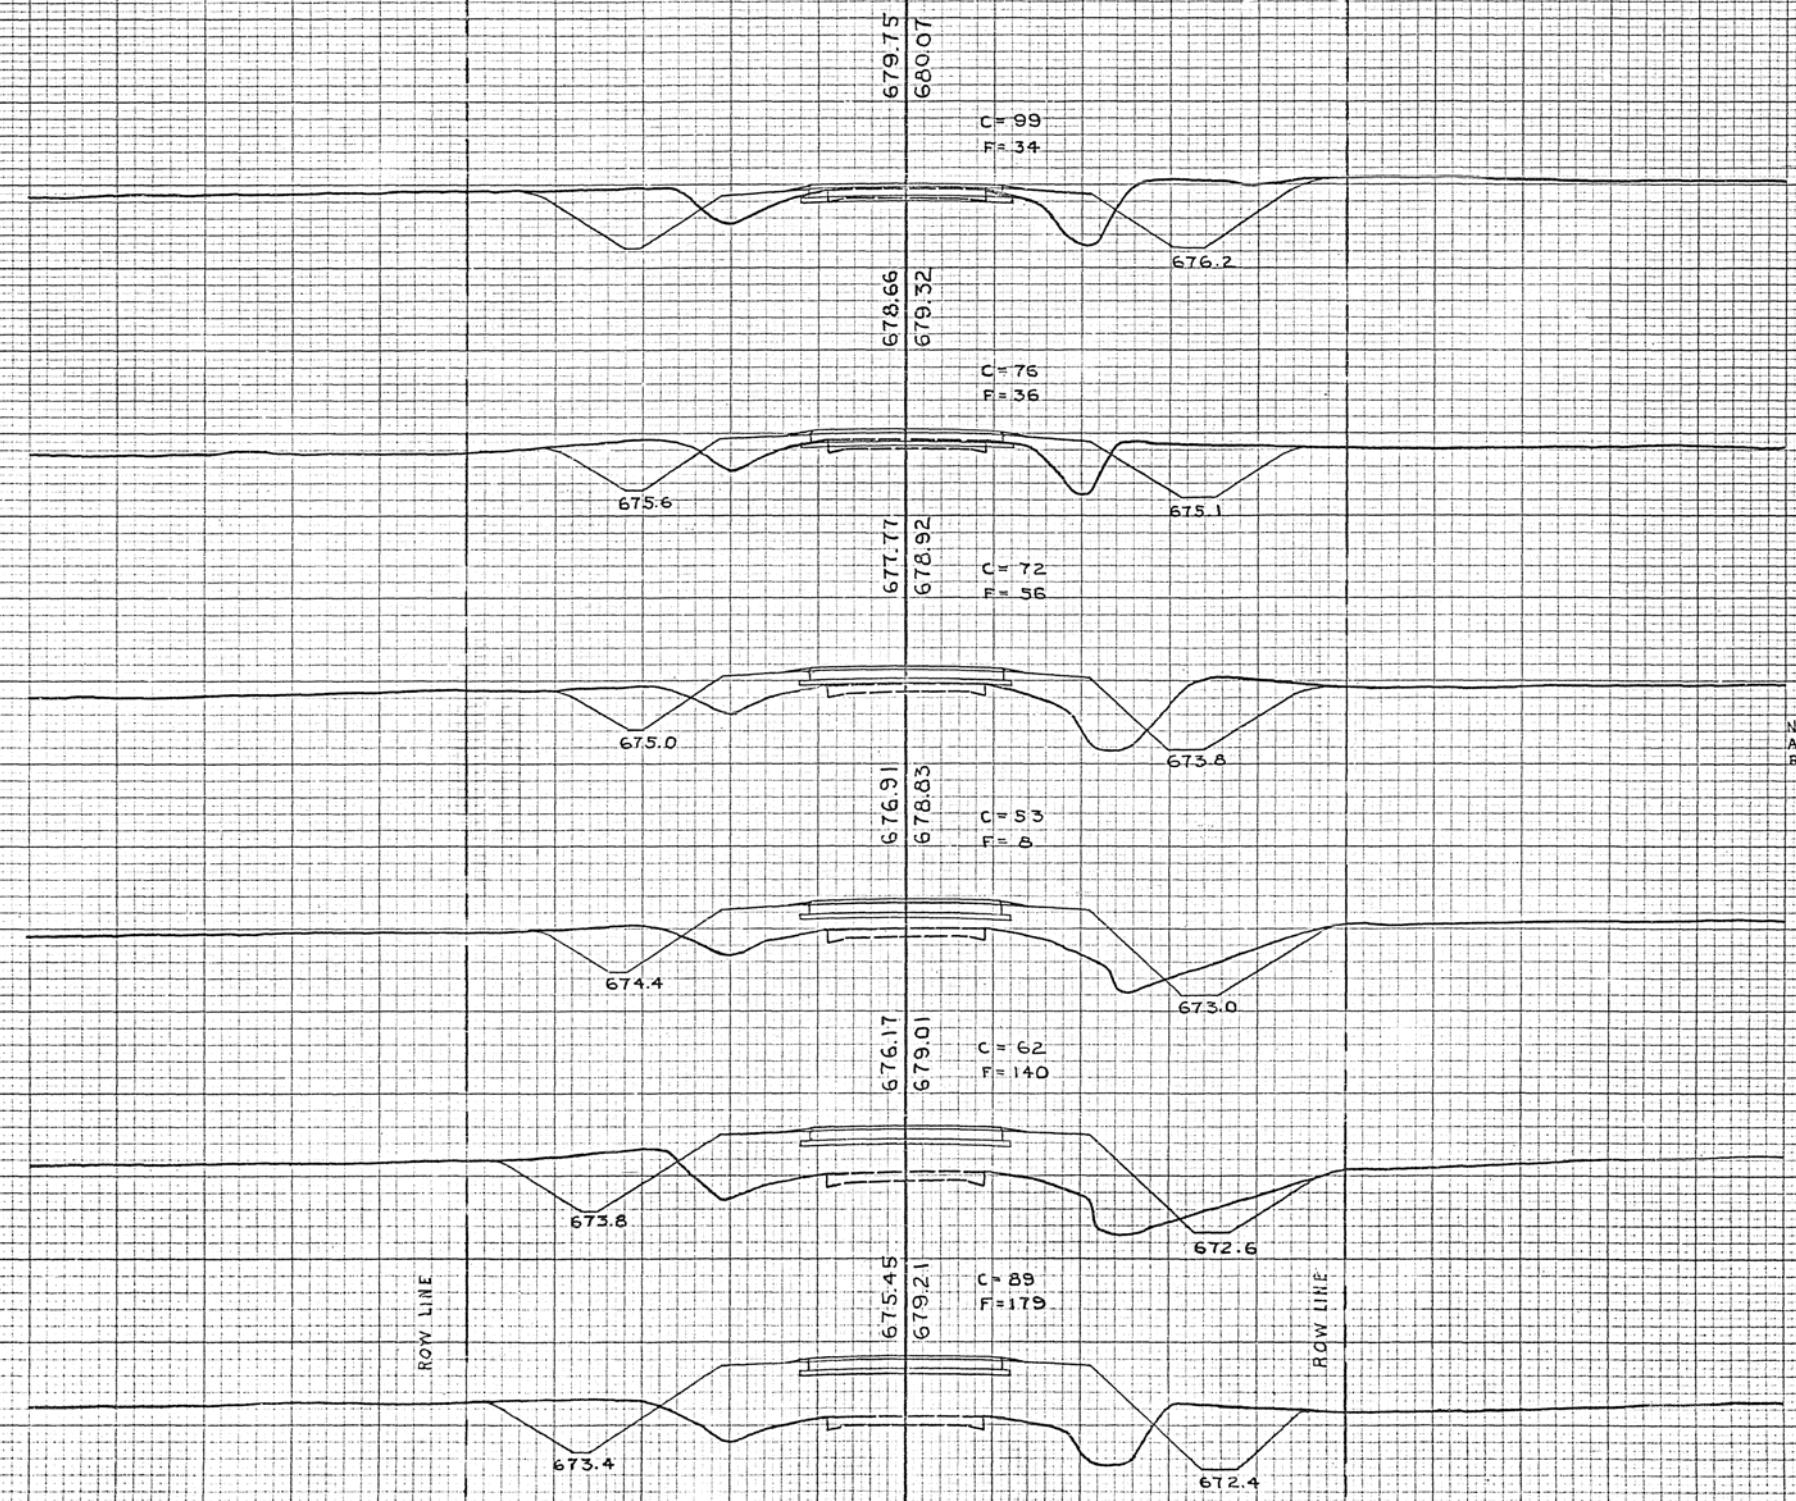


NOTE: PROPOSED ELEVATIONS AS SHOWN ARE TO THE TOP OF THE PROPOSED 1-11 RESURFACING.

DATE	BY	REVIEWED	DATE
6-65	STARBUCK	6-65	
6-65	T. L. A.	6-65	
2/50	J. J. B.	2/50	
5-60	C. J. B.	5-60	

DATE	BY	REVIEWED	DATE

ROUTE NO.	SECTION	BOUNDS	TOTAL	SHEET
685	100-1	PIATT	107	71
686	100-2	PIATT	107	71
687	100-3	PIATT	107	71
688	100-4	PIATT	107	71
689	100-5	PIATT	107	71

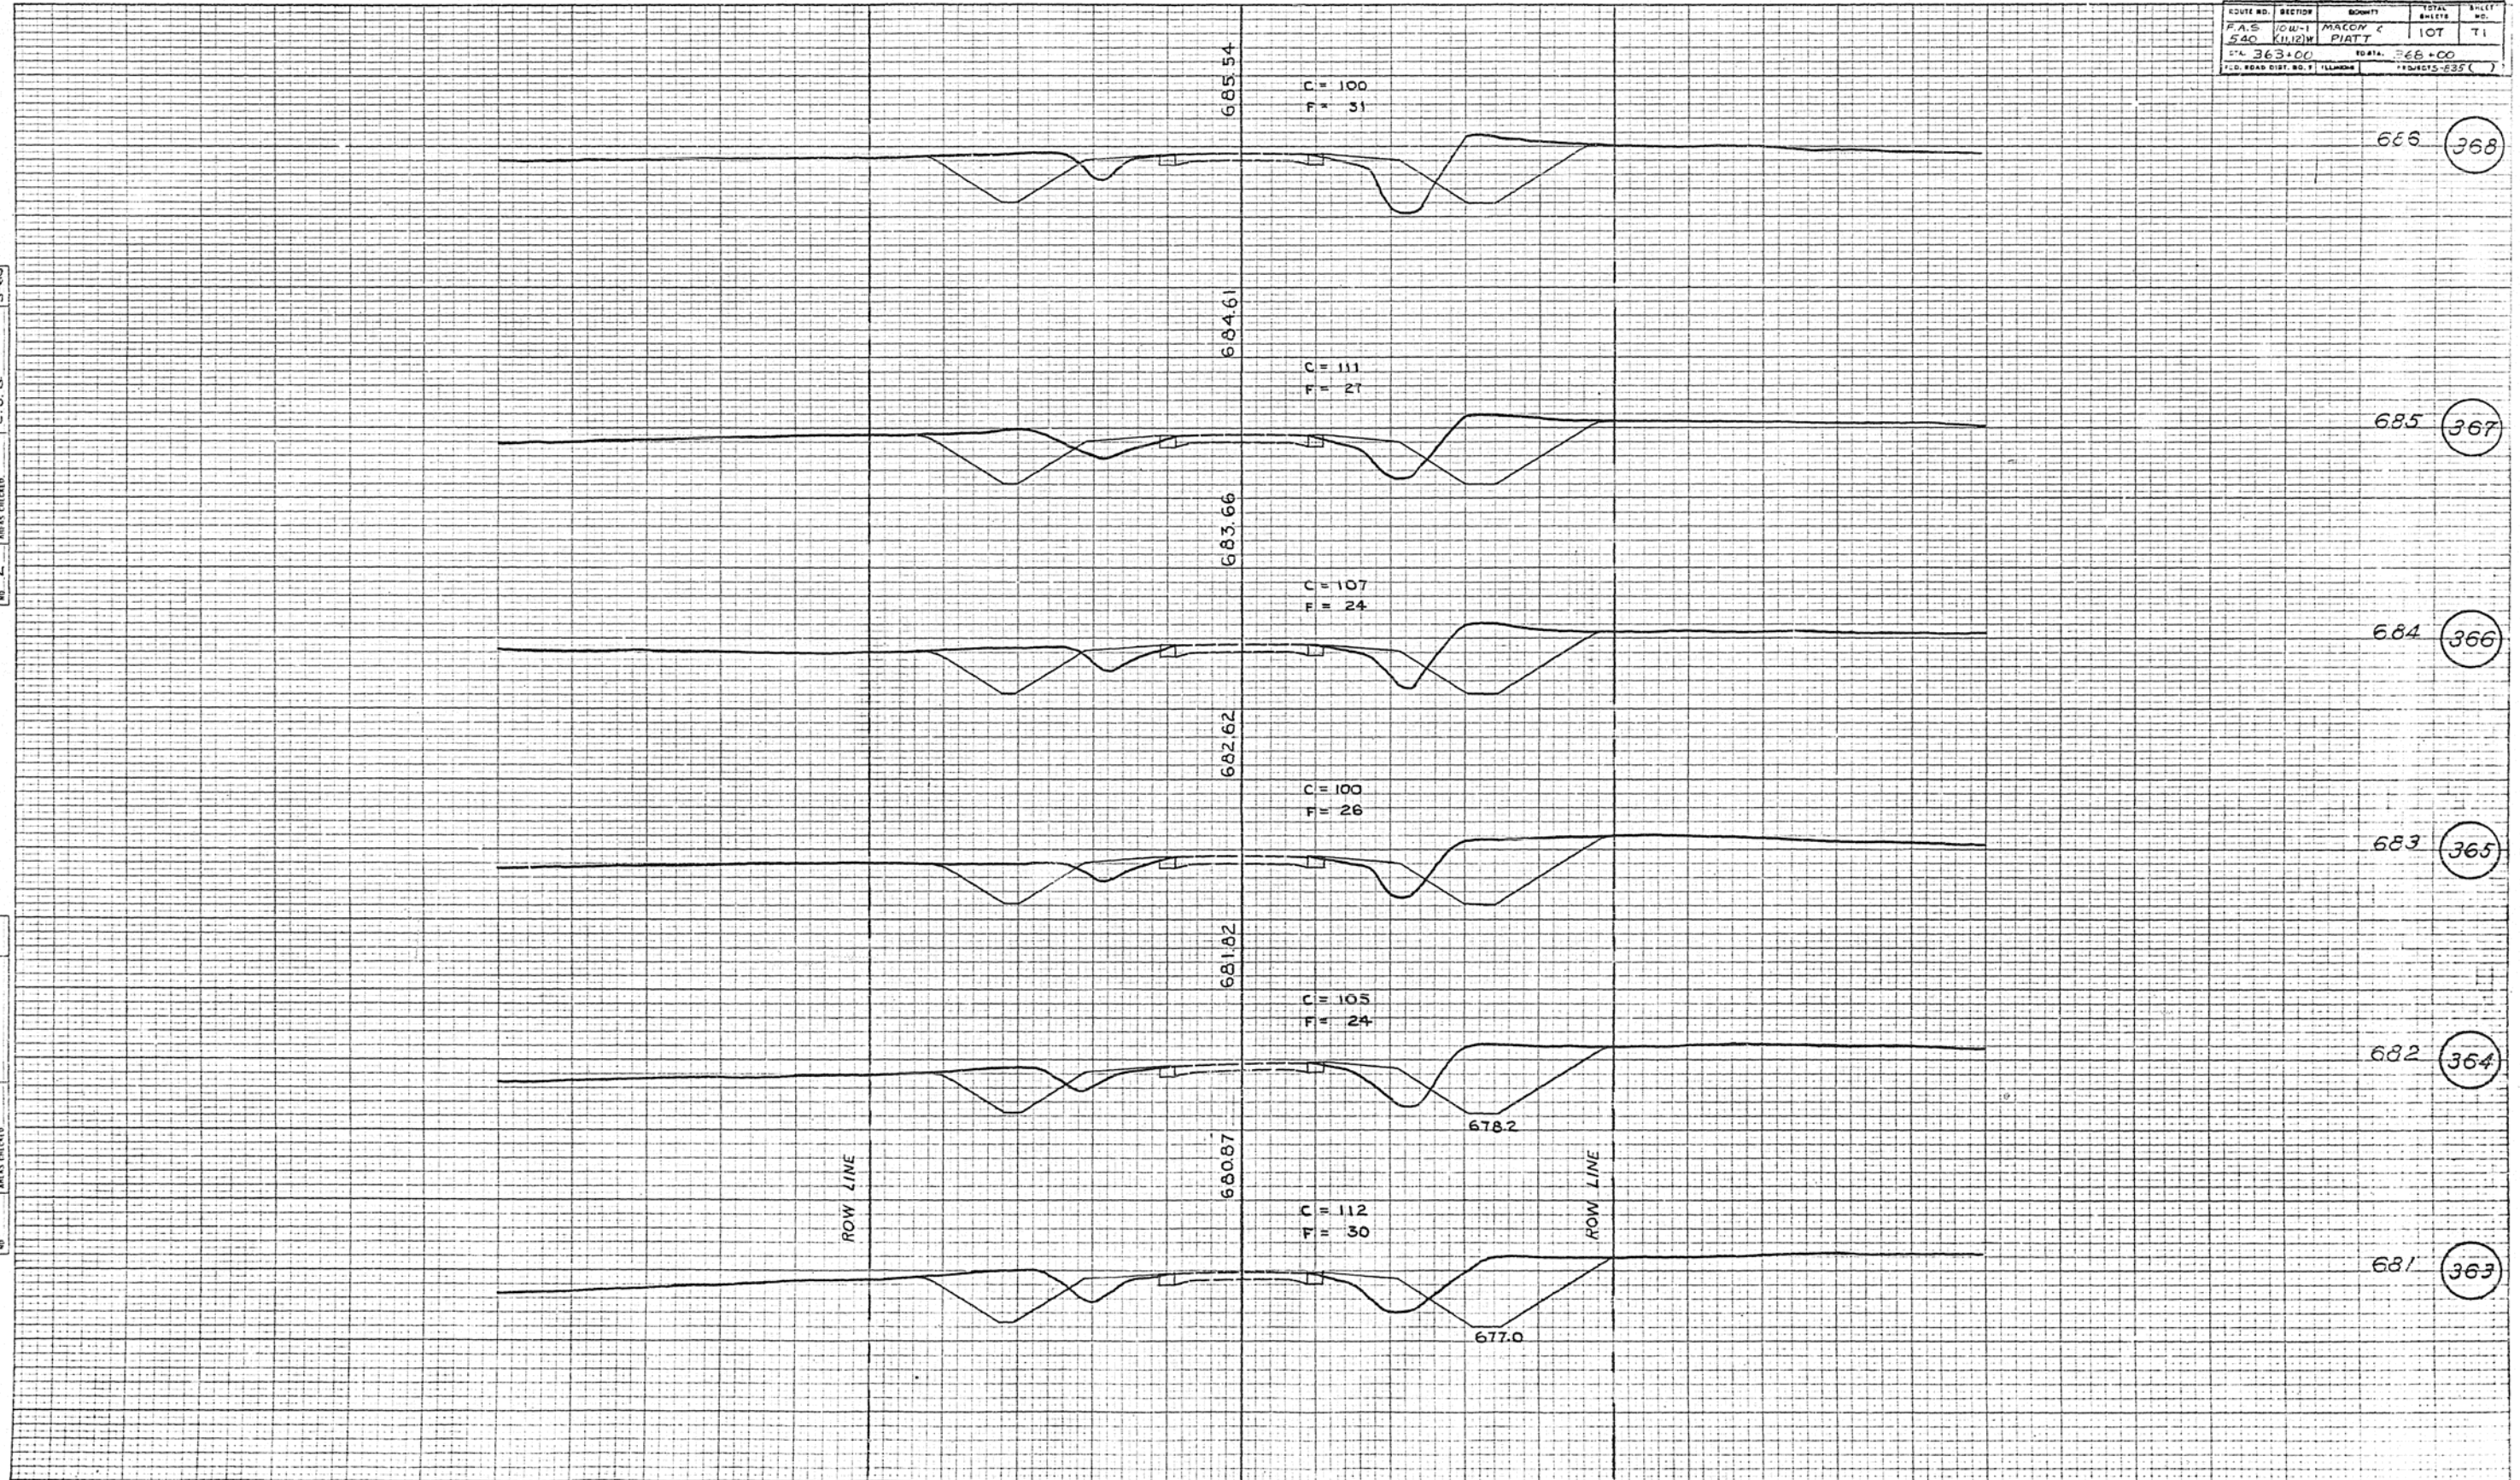

685 (368)

684 (367)

683 (366)

682 (365)


681 (364)

680 (363)

DATE	6-56
	6-56
BY	STARBUCK
	T.L.A.
CHECKED	J.L.P.
	C.J.B.
NO	2

DATE	
BY	
CHECKED	
NO	

ROUTE NO.	SECTION	STATION	TOTAL	SHEET
540	10W-1	MACON C	107	72
540	K1112	PIATT		
540	369+00	TOTAL	374-00	
540	369+00	PROJECT	5-635	

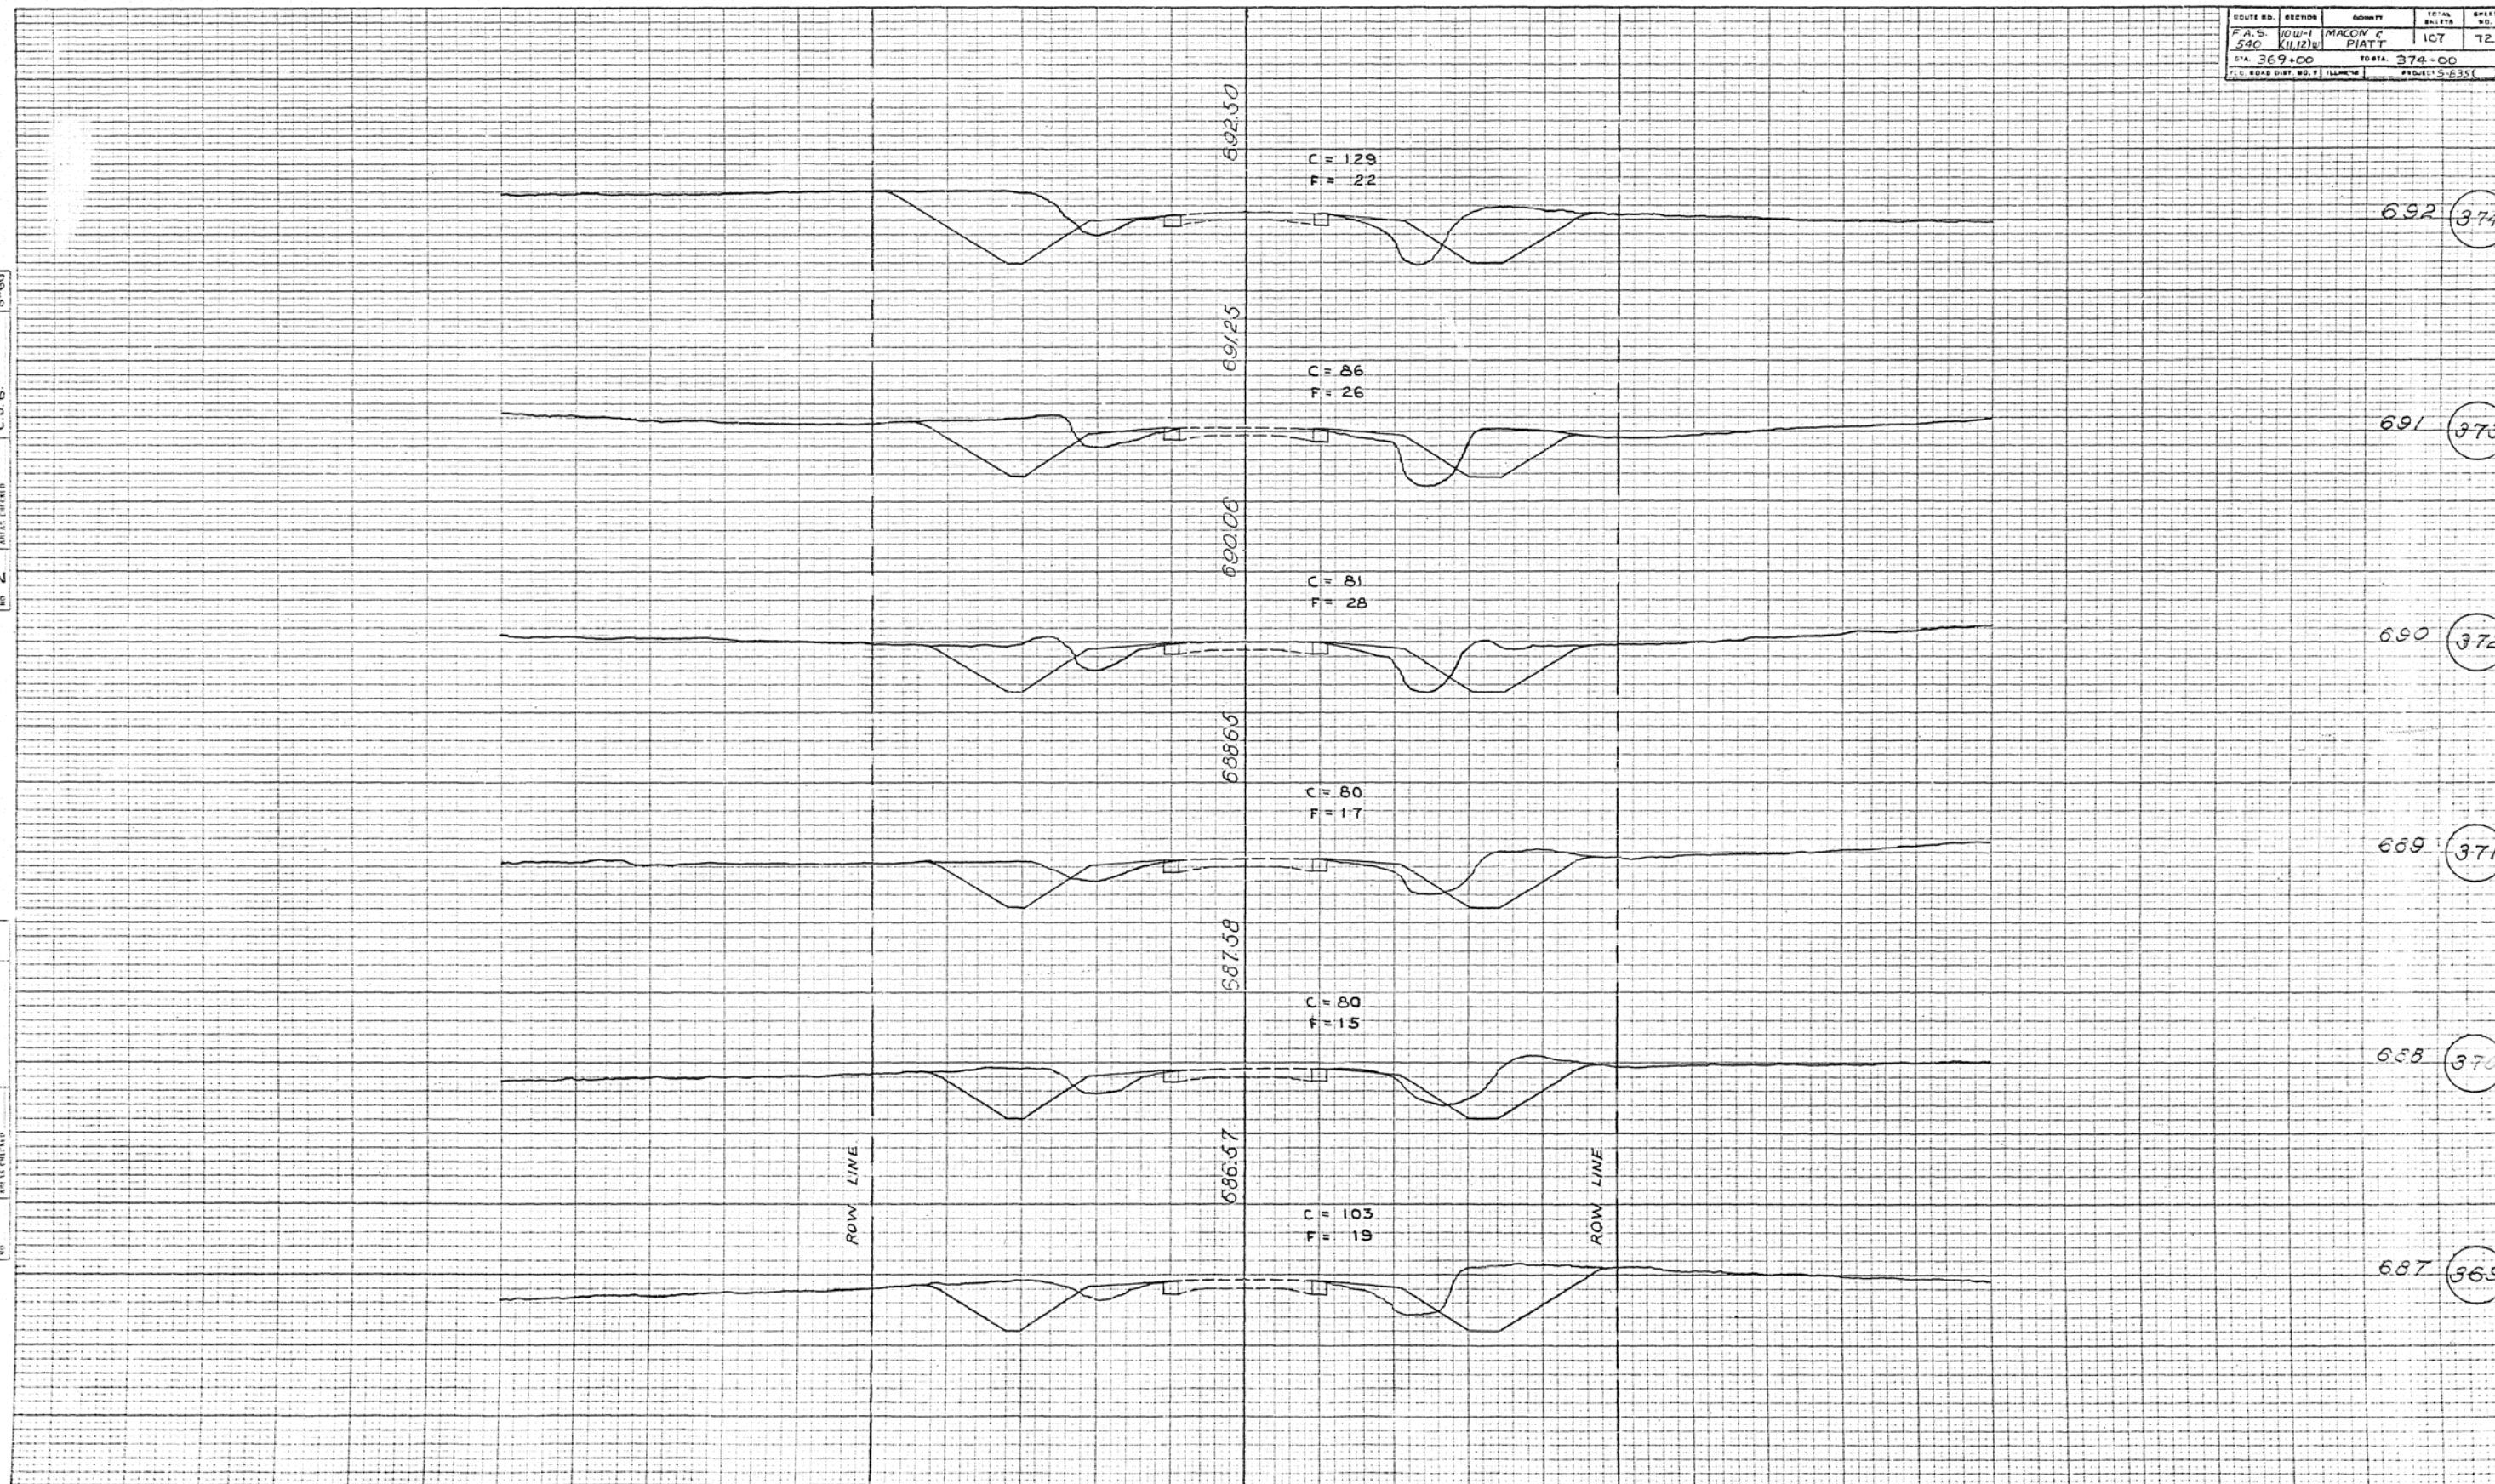

DATE	6-58
BY	STARBUCK
FINAL SURVEY	NOTED
NO. 2	AREAS CHECKED

DATE	
BY	
ORIGINAL SURVEY	NOTED
NO.	

ROUTE NO.	SECTION	COUNTY	TOTAL SHEETS	SHEET NO.
F.A.S.	10W-1	MACON	107	75
540	KILBURN	PIATT		
STA 375+00		TO STA 380+00		
ROAD DIST. NO. 11111111		PROJECT NO. 111111		

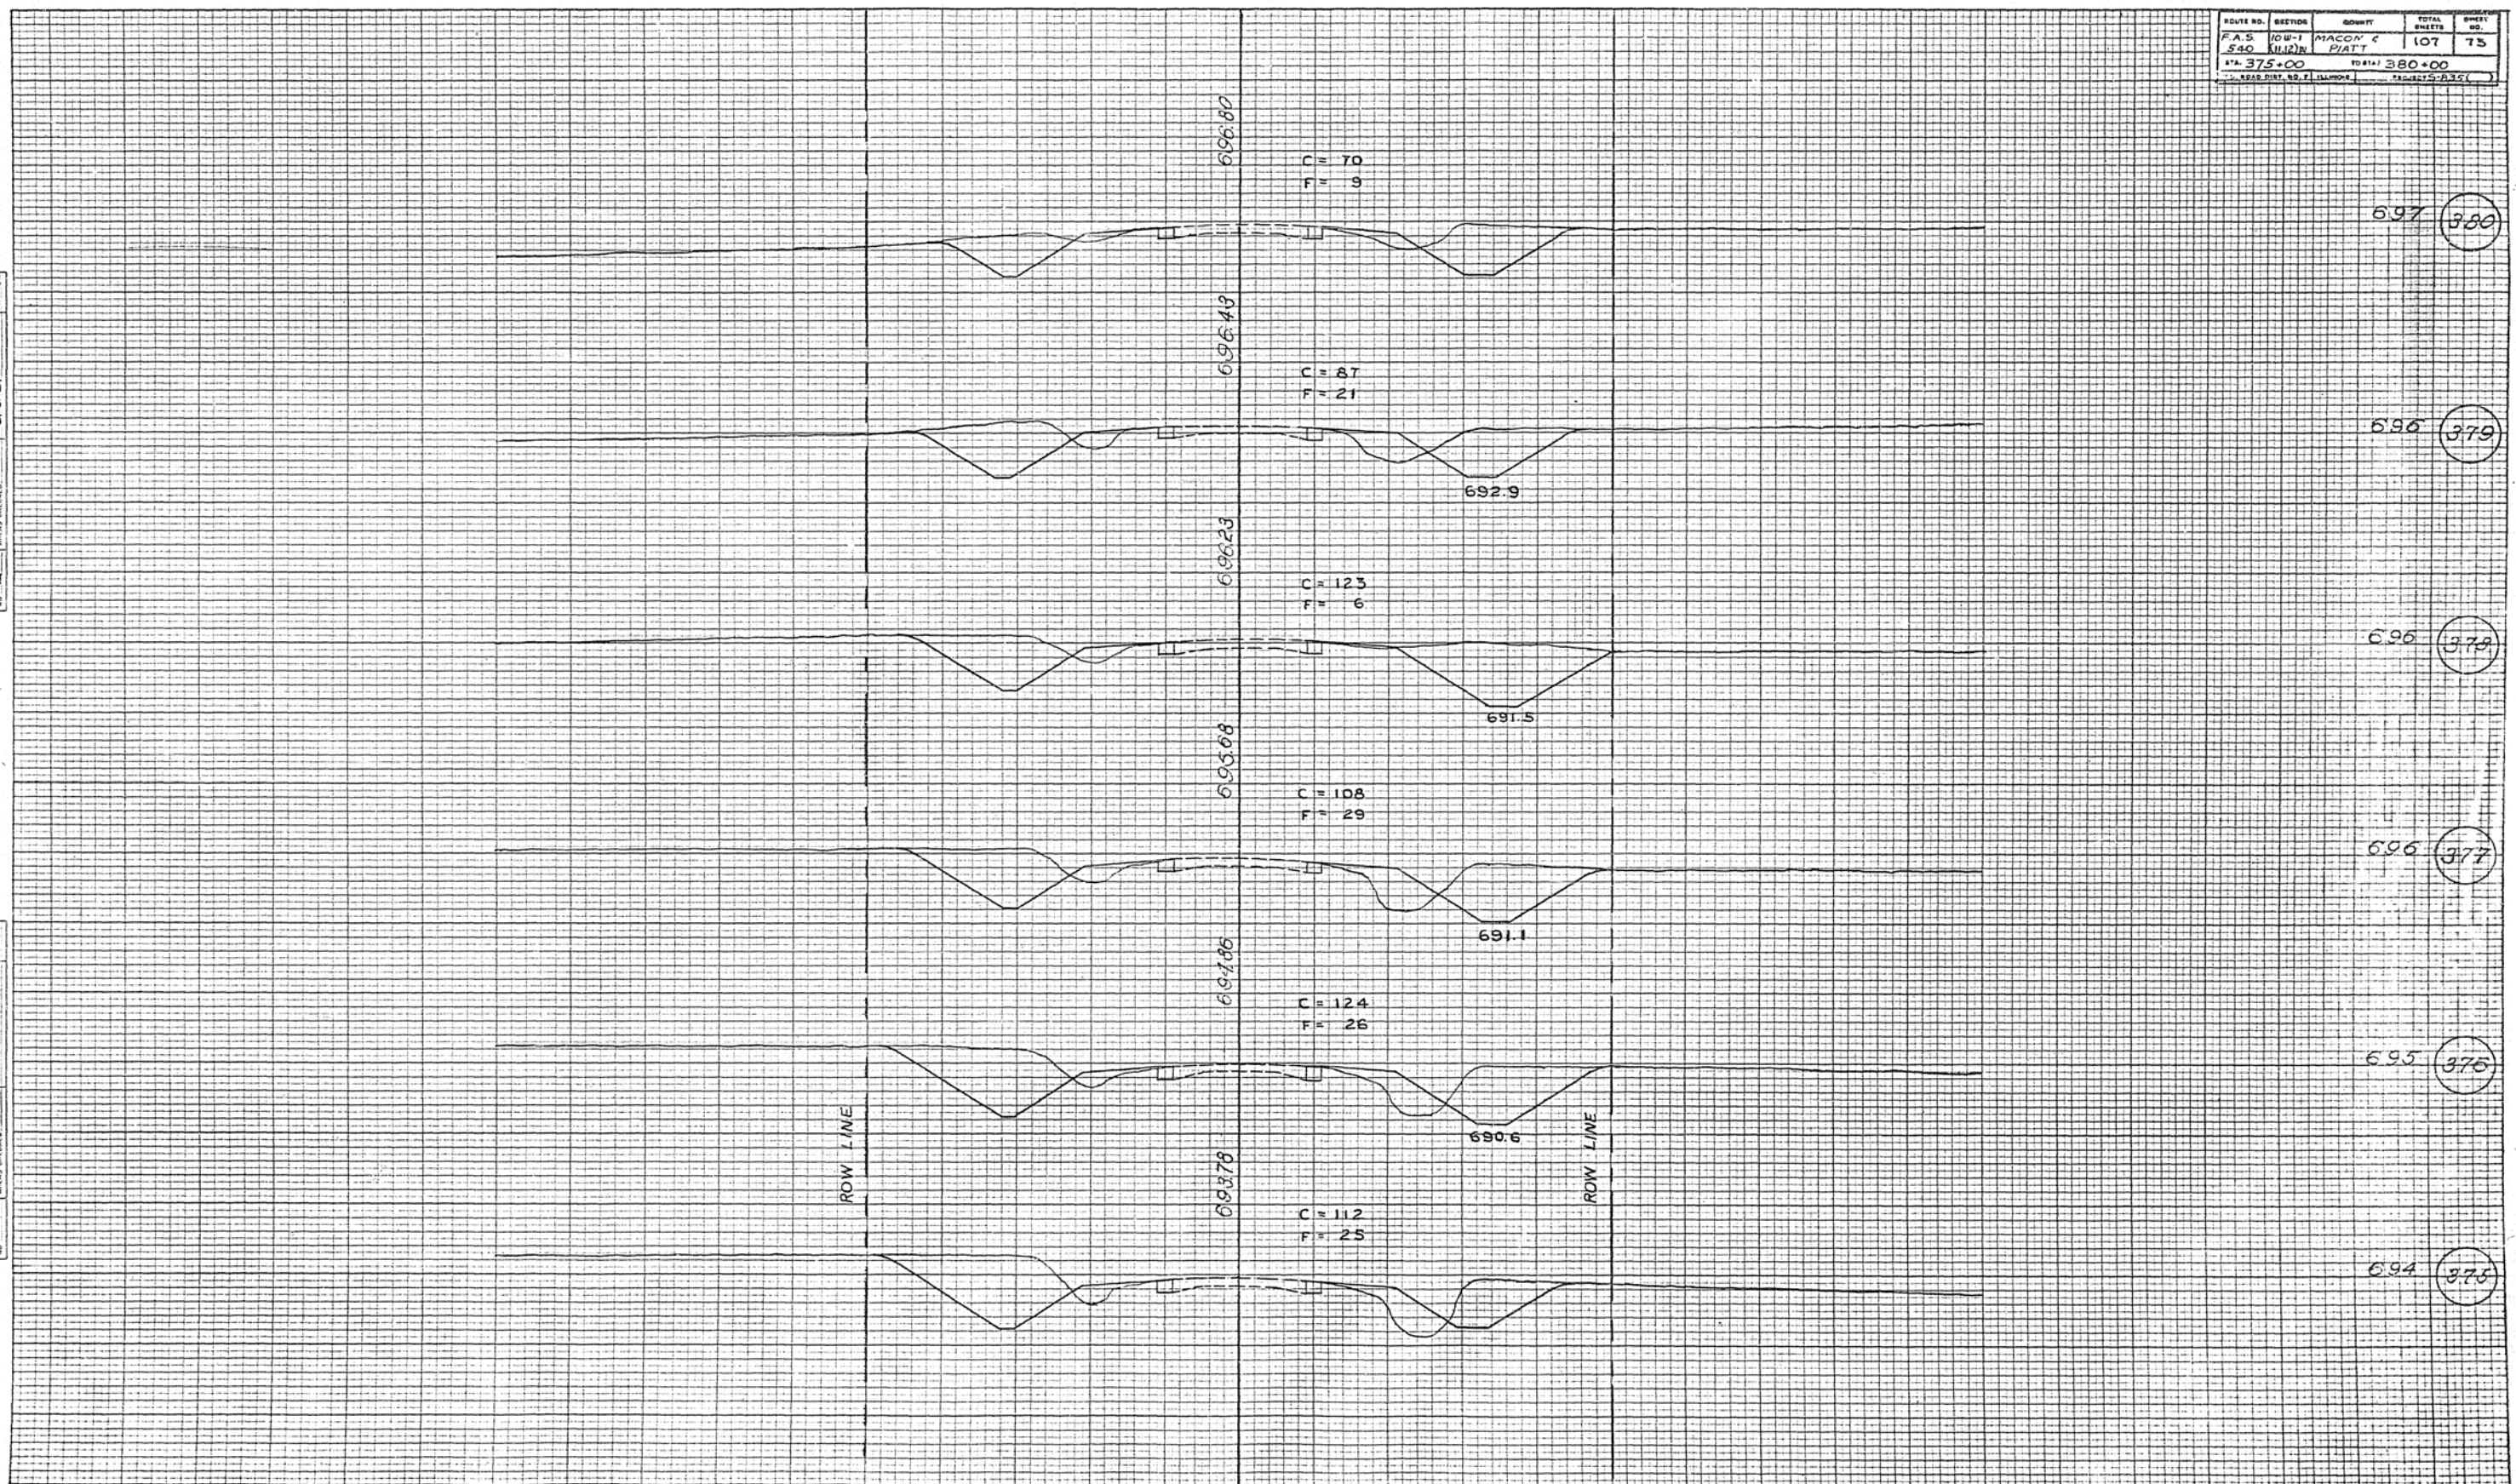


PLATE 3 CROSS SECTION B P R STANDARD
EUGENE D. FRIEDMAN CO. CHICAGO, ILL. NEW YORK

ROUTE NO.	SECTION	SCHWY	TOTAL SHEETS	SHEET NO.
540	10W-1	MACON PIATT	107	74
STA 381+00	TO STA 386+00			
ROAD DIST. NO. 2	ILLINOIS			

DATE	BY	BY	BY	BY
6-58	STARBUCK	STARBUCK	STARBUCK	STARBUCK
0-58	J.L.A.	J.L.A.	J.L.A.	J.L.A.
2-59	J.L.F.	J.L.F.	J.L.F.	J.L.F.
5-60	C.J.D.	C.J.D.	C.J.D.	C.J.D.

DATE	BY	BY	BY	BY


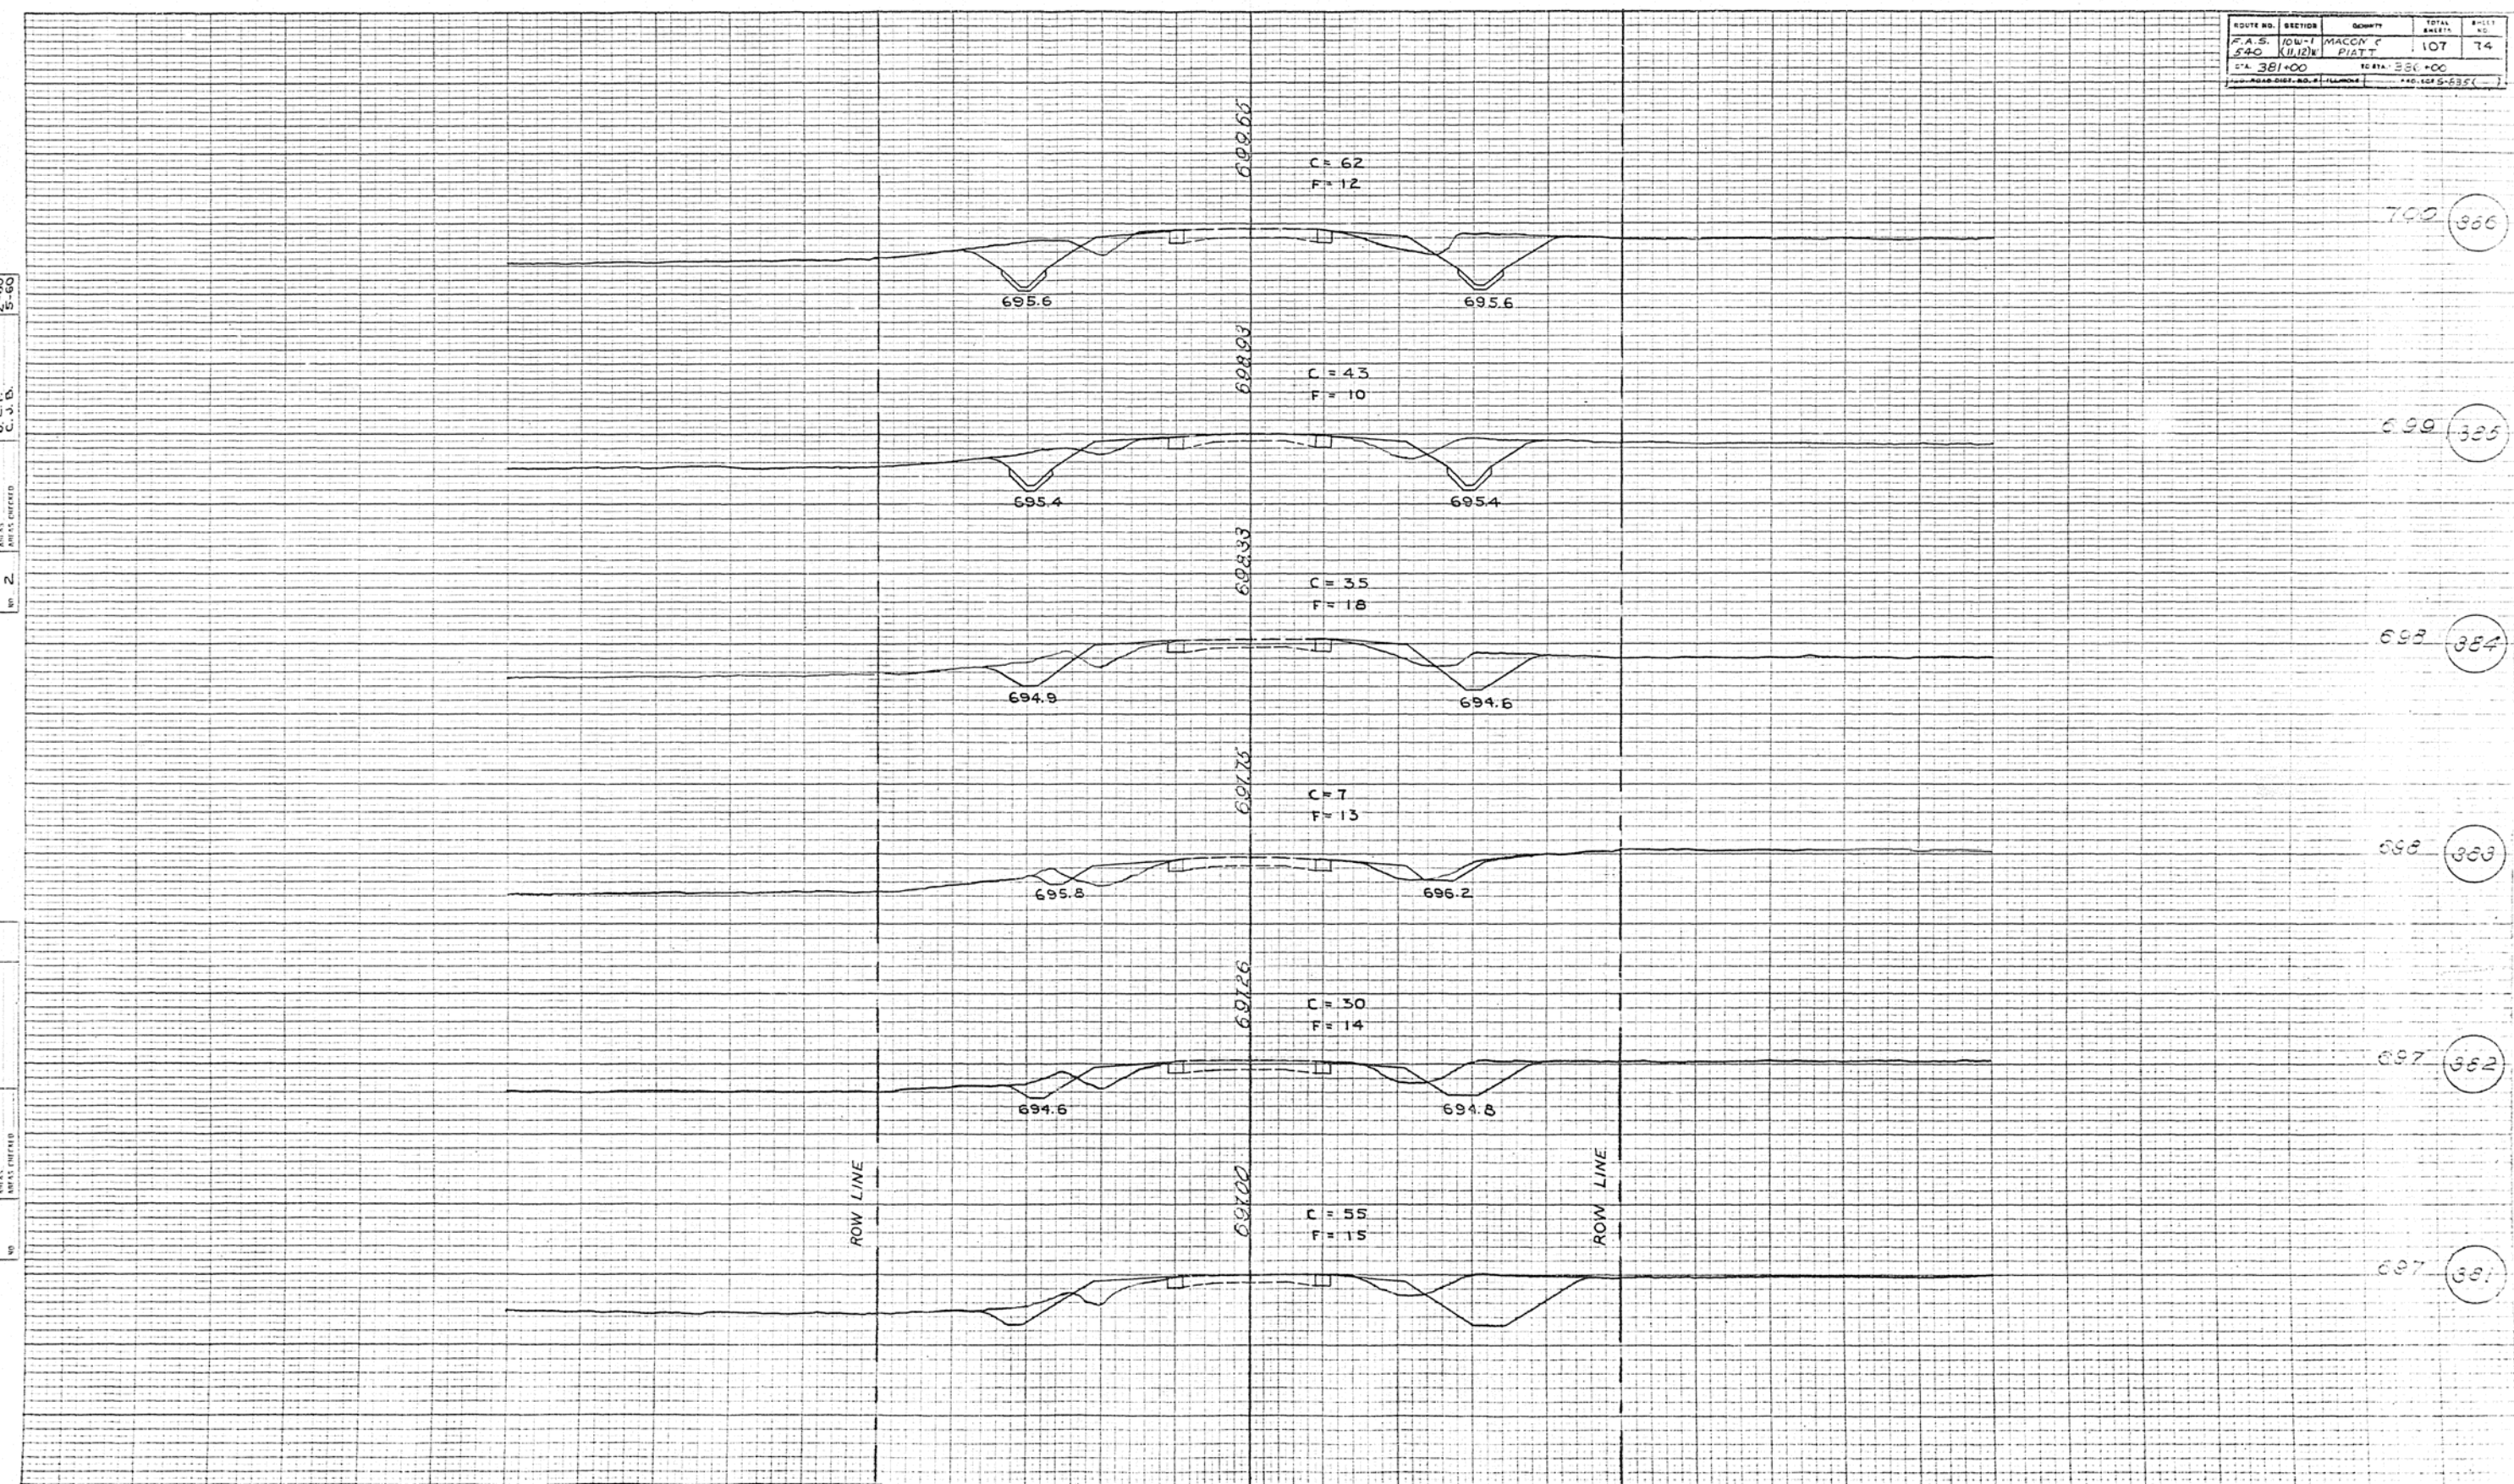


PLATE 3 CROSS SECTION B.P.R. STANDARD
 100% DESIGN CO. CHICAGO, ILL. 1944

DATE	5-56
BY	STARBUCK
PROJECT	T.L.A.
REVISION	U.S.G.
NO.	2

DATE	
BY	
PROJECT	
REVISION	
NO.	

ROUTE NO.	STATE	COUNTY	TOWNSHIP	RANGE	SECTION
FAS-540	WYOMING	WAGON (PLATT)	107	75	
ELEV. 3871.00		WPL 392.00			
ROAD DIST. 0.1		11.12		3.55	

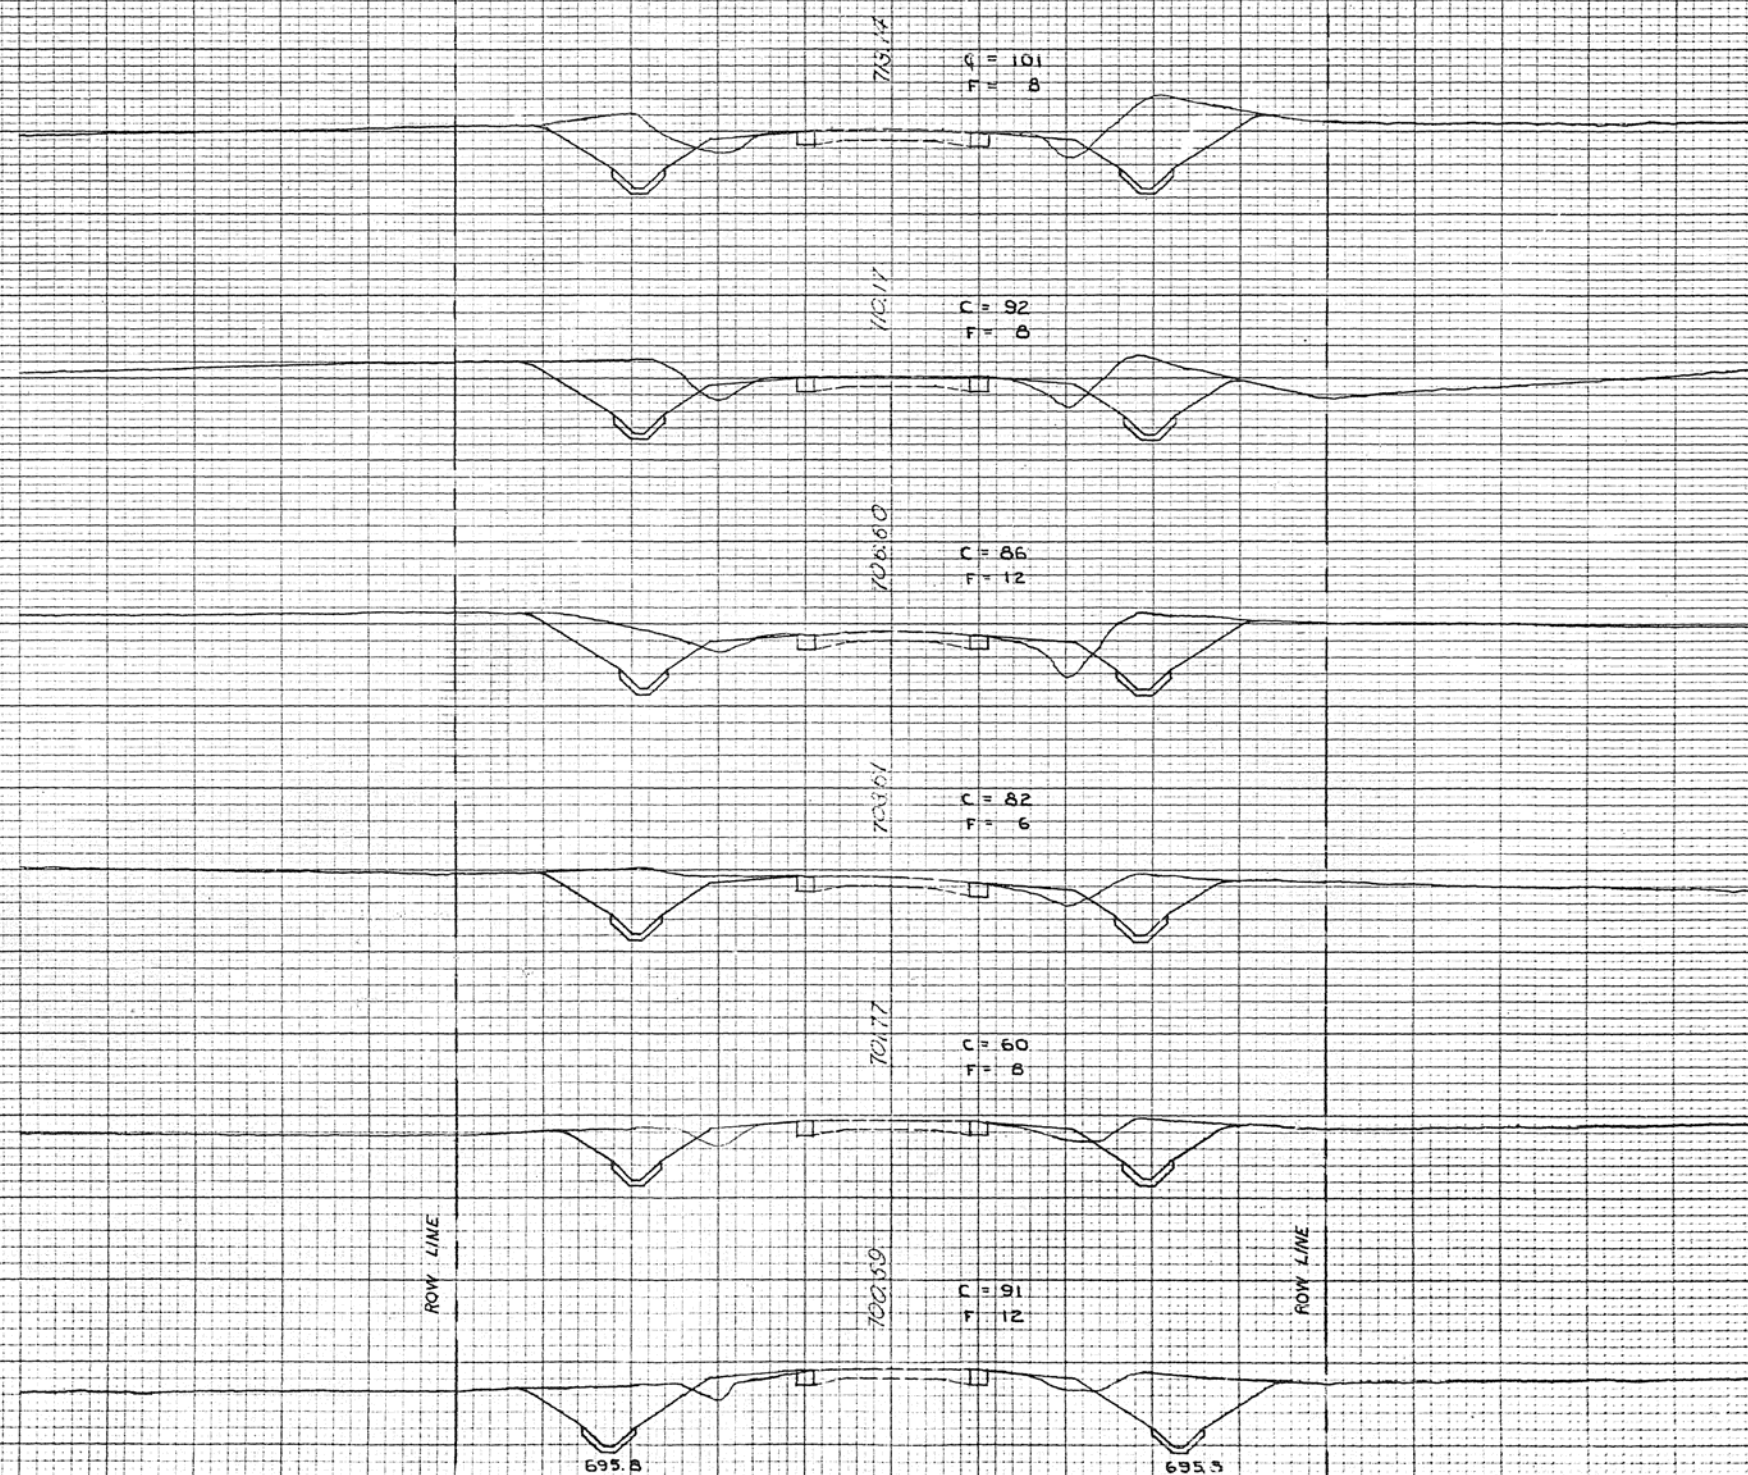

715 (392)

110 (391)

108 (390)

704 (388)


702 (388)

701 (387)

DATE	5-58
BY	STARBUCK
SURVEYED	L.A.
PLOTTED	J.P.
TEMPERATURE	2/50
WIND	5-60
NO.	2

DATE	
BY	
SURVEYED	
PLOTTED	
TEMPERATURE	
WIND	
NO.	

ROUTE NO.	SECTION	COUNTY	TOWNSHIP	RANGE
EAS-540	10W-1	MACON (PLATT)	107	76
STATION	393+00	STATION	398+00	
FED. ROAD DIST. NO.	ILLINOIS	PROJECT	5-658	

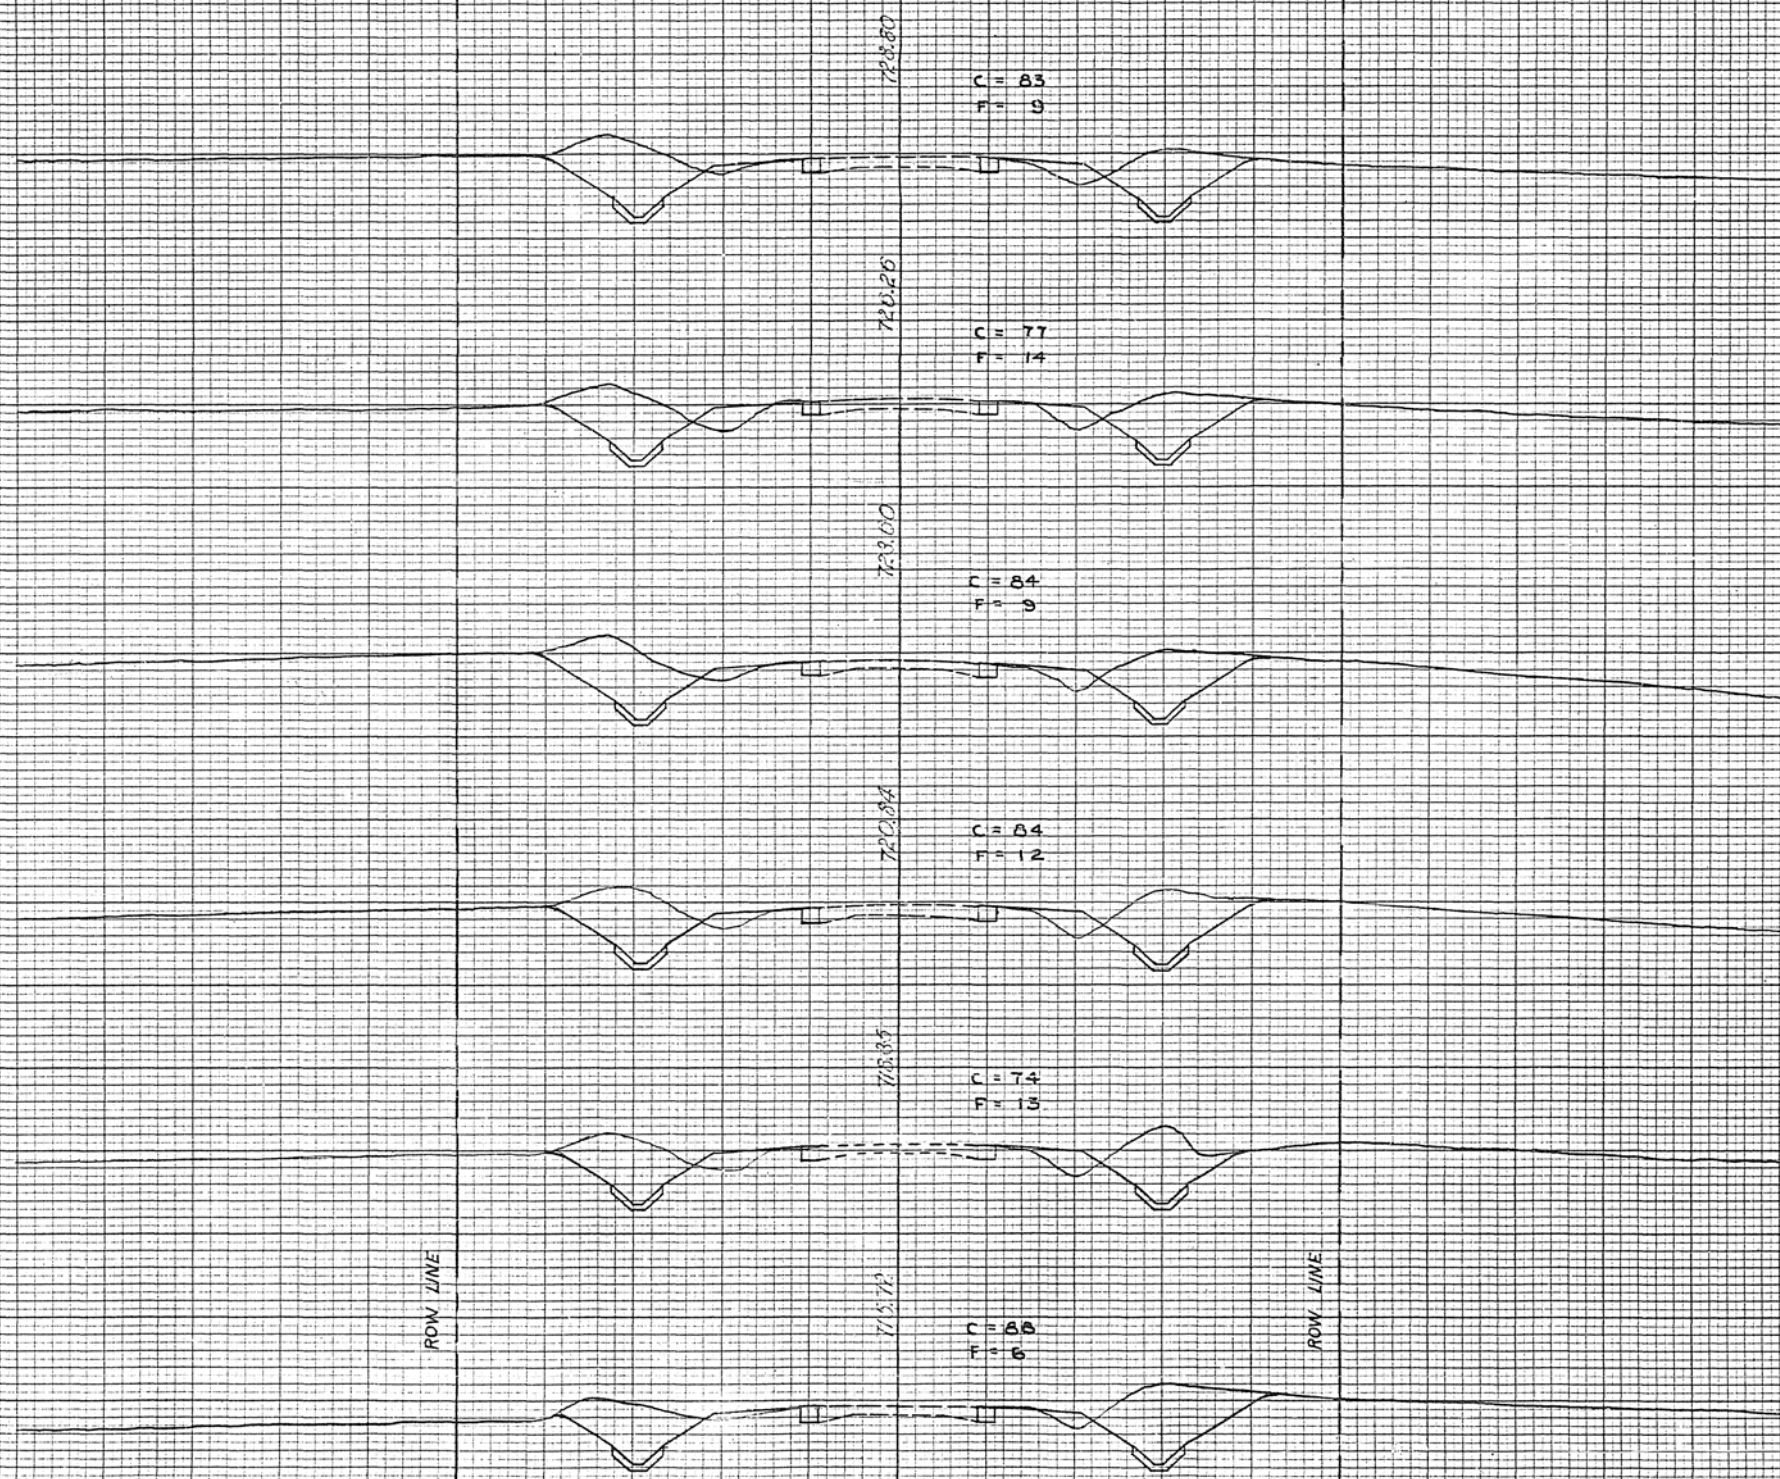

398

397

396


395

394

393

ORIGINAL SURVEY NOTE BOOK	BY	DATE
SUBMITTED		
PLOTTED		
TEMPLATE		
AREAS		
AREAS CHECKED		


ROUTE NO.	SECTION	COUNTY	TOTAL SHEETS	SHEET NO.
FAS-540	10W-1 (11,12)W	MACON & PIATT	107	78
STA. 405+00		TO STA. 410+00		
FOR ROAD DIST. NO. 1		ILLINOIS PROJECT S-835C		

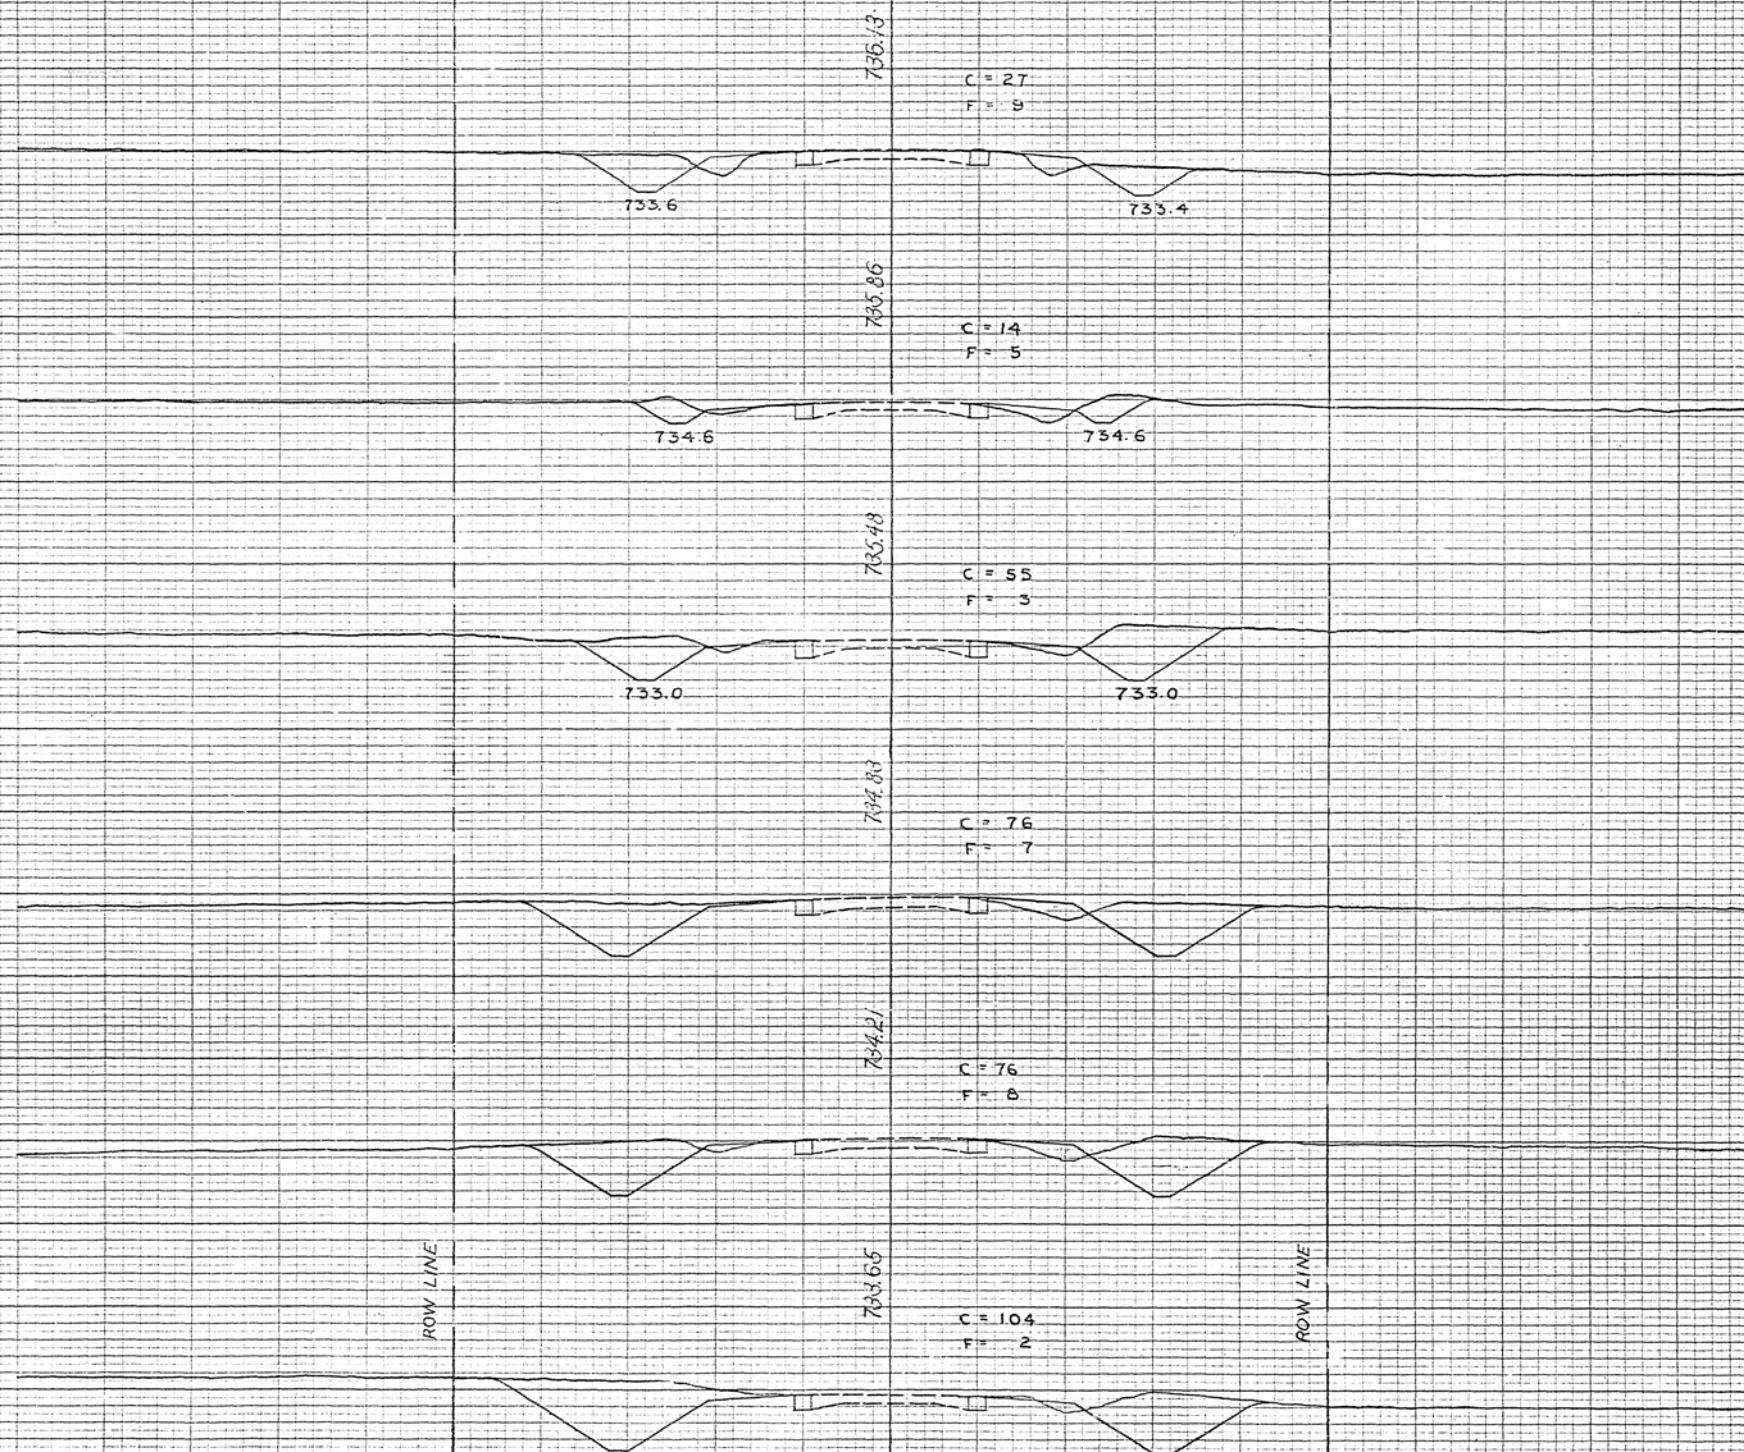

DATE	5-25
BY	STARBUCK
FINAL SURVEY	NO. 2
REVISIONS	1-1-A
REVISIONS	1-1-B
REVISIONS	1-1-C
REVISIONS	1-1-D
REVISIONS	1-1-E
REVISIONS	1-1-F
REVISIONS	1-1-G
REVISIONS	1-1-H
REVISIONS	1-1-I
REVISIONS	1-1-J
REVISIONS	1-1-K
REVISIONS	1-1-L
REVISIONS	1-1-M
REVISIONS	1-1-N
REVISIONS	1-1-O
REVISIONS	1-1-P
REVISIONS	1-1-Q
REVISIONS	1-1-R
REVISIONS	1-1-S
REVISIONS	1-1-T
REVISIONS	1-1-U
REVISIONS	1-1-V
REVISIONS	1-1-W
REVISIONS	1-1-X
REVISIONS	1-1-Y
REVISIONS	1-1-Z

DATE	
BY	
ORIGINAL SURVEY	NO. 2
REVISIONS	1-1-A
REVISIONS	1-1-B
REVISIONS	1-1-C
REVISIONS	1-1-D
REVISIONS	1-1-E
REVISIONS	1-1-F
REVISIONS	1-1-G
REVISIONS	1-1-H
REVISIONS	1-1-I
REVISIONS	1-1-J
REVISIONS	1-1-K
REVISIONS	1-1-L
REVISIONS	1-1-M
REVISIONS	1-1-N
REVISIONS	1-1-O
REVISIONS	1-1-P
REVISIONS	1-1-Q
REVISIONS	1-1-R
REVISIONS	1-1-S
REVISIONS	1-1-T
REVISIONS	1-1-U
REVISIONS	1-1-V
REVISIONS	1-1-W
REVISIONS	1-1-X
REVISIONS	1-1-Y
REVISIONS	1-1-Z

ROUTE NO.	SECTION	SHEET	TOTAL SHEETS	SHEET NO.
107	MACON & KILGORE	107	107	80
STA. 417+00	STATION	422+00		
107+00	107+00	107+00		

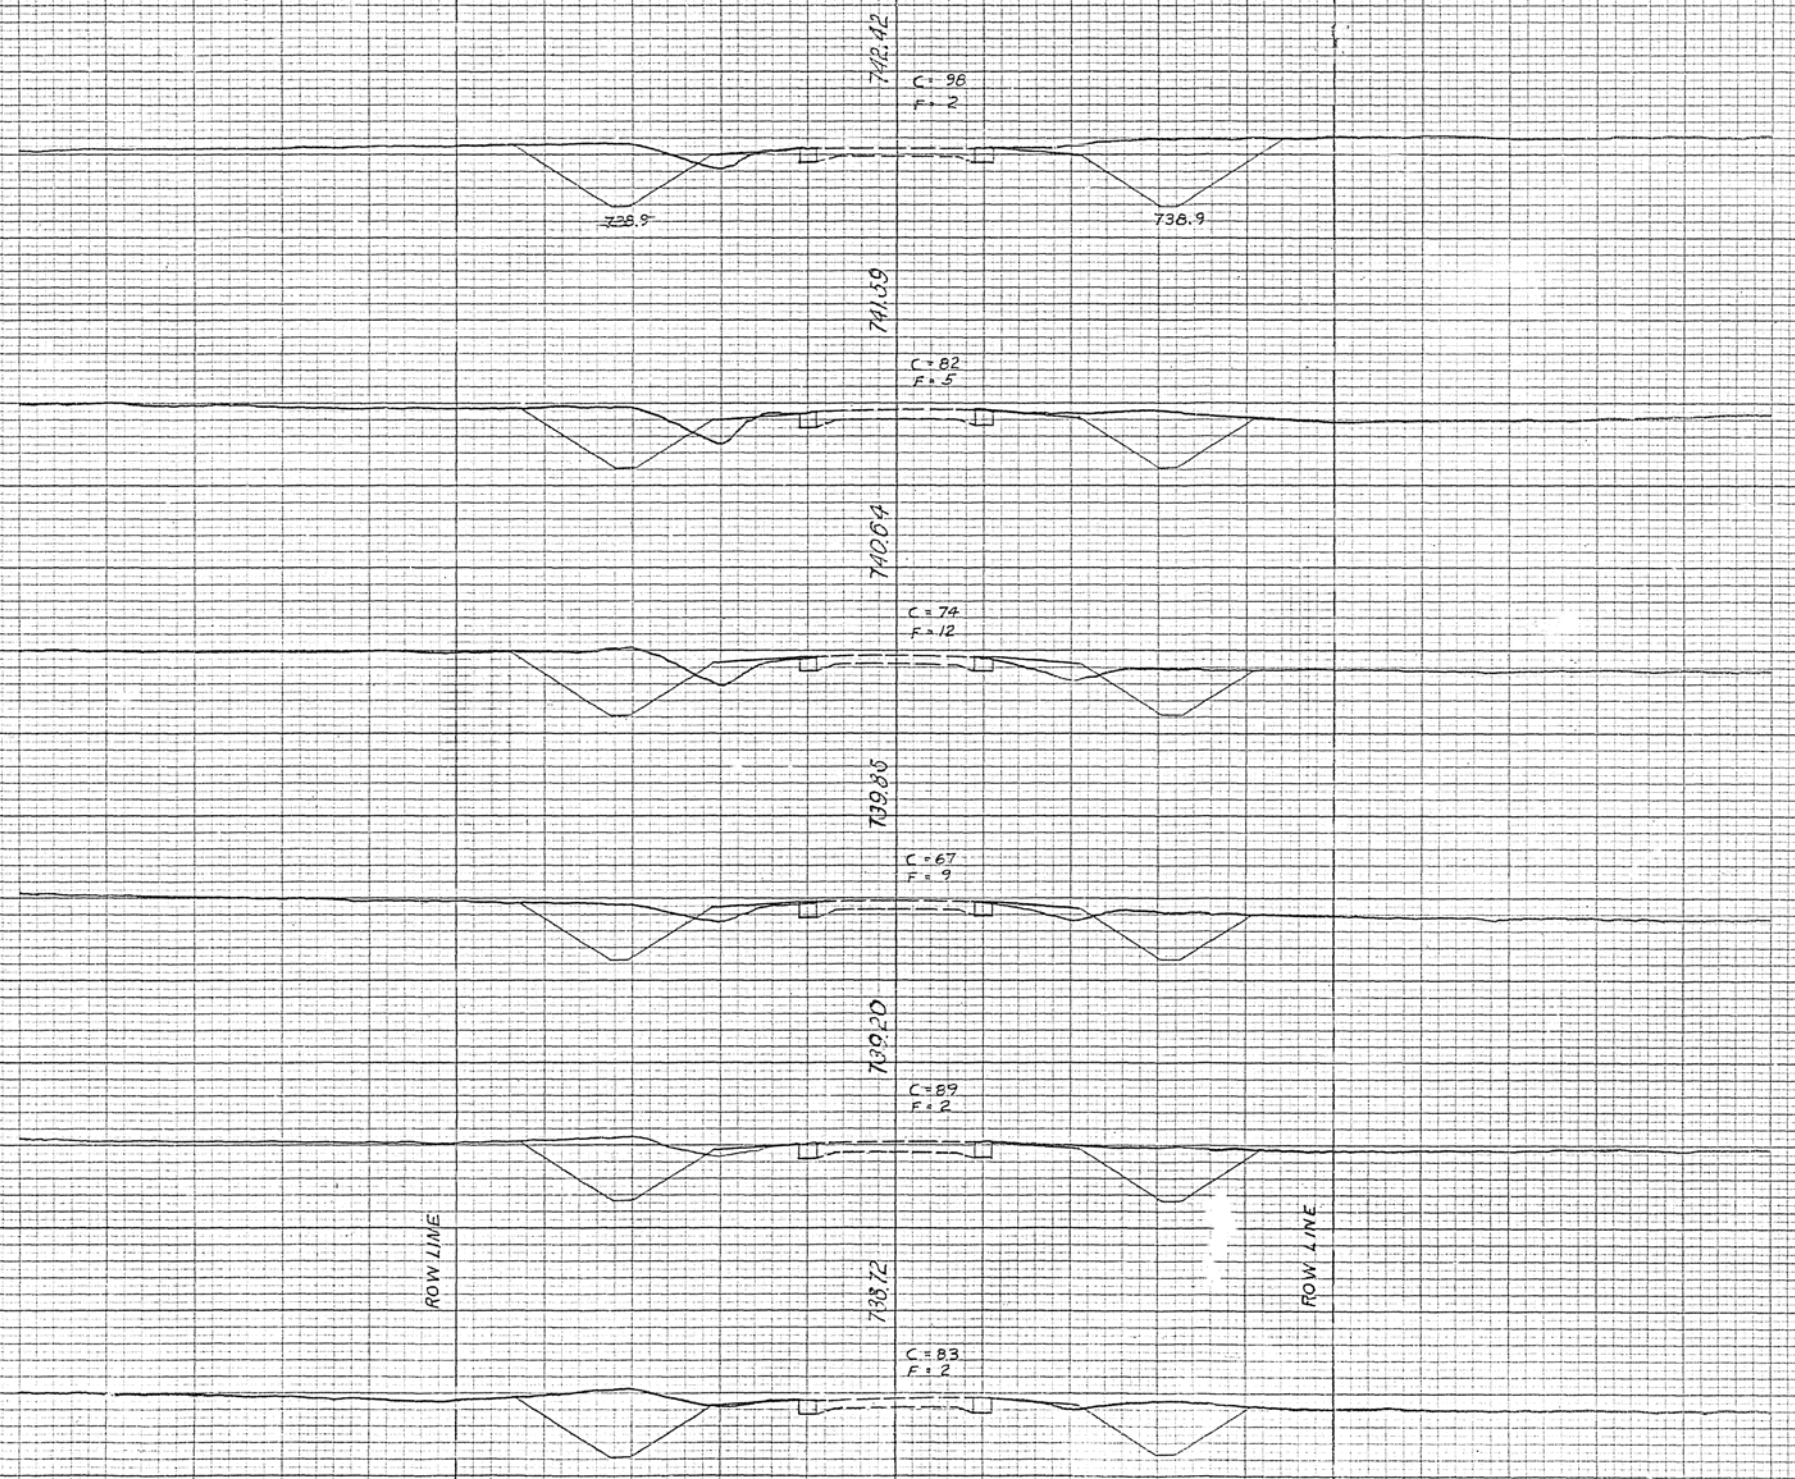


422
421
420
419
418
417

DATE	6-58
BY	STARBUCK
PROJECT	LA
FLIGHT	LA
NOTE BOOK	LA
NO.	3


DATE	
BY	
PROJECT	
FLIGHT	
NOTE BOOK	
NO.	

ROUTE NO.	SECTION	SHEET	TOTAL SHEETS	DATE
AS	MACON	PIATT	107	52
429+00	434+00			

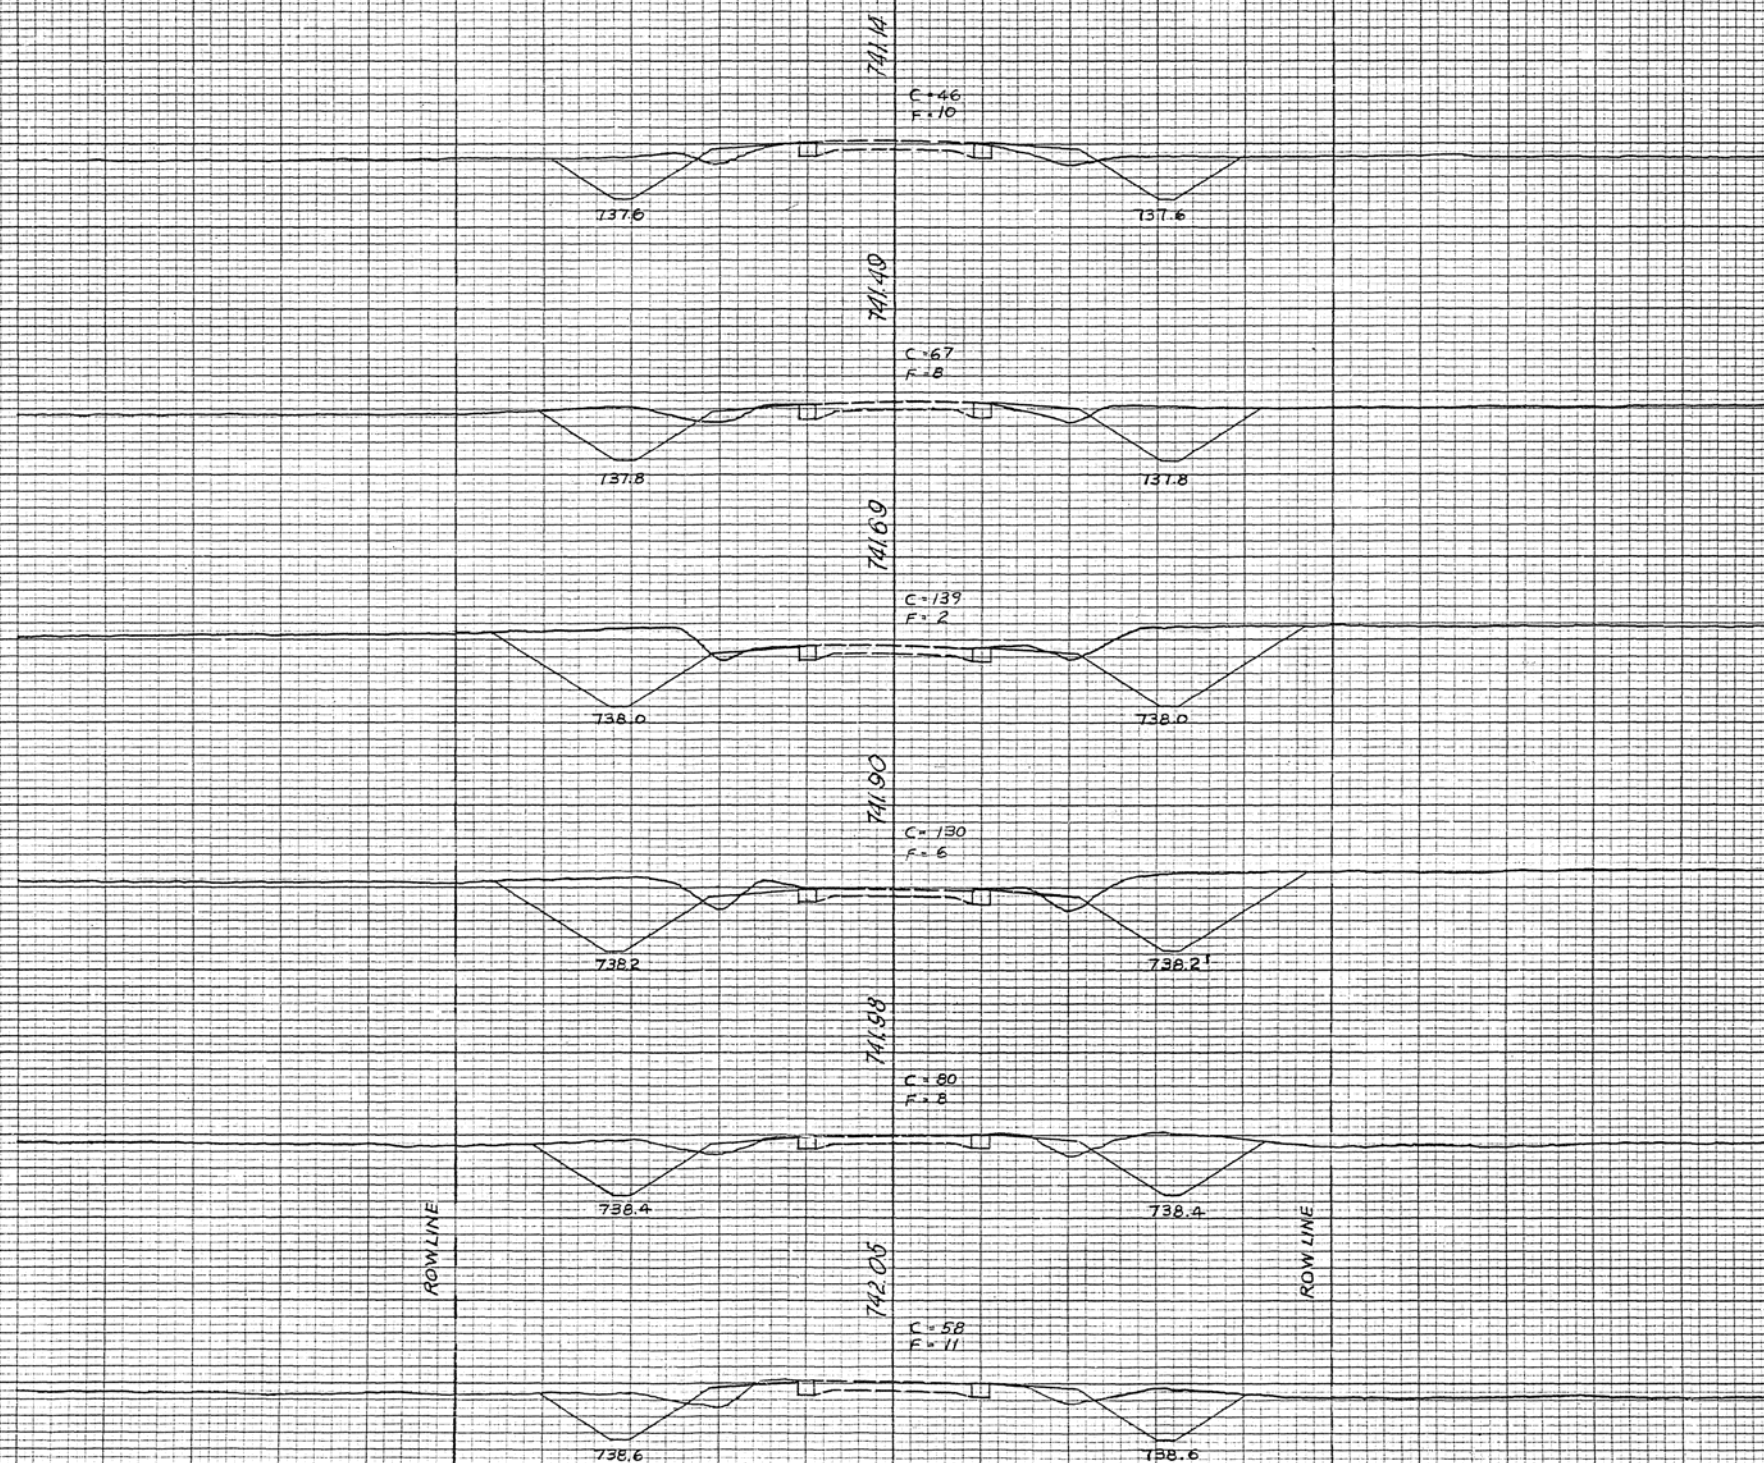

ORIGINAL SURVEY NOTE BOOK	SURVEYED, PLOTTED TEMPLATE AREAS.	BY	DATE
NO			

ROUTE NO.	SECTION	COUNTY	TOWNSHIP	RANGE
FAS-540	10W-1 (11,12)W	MACON & PIATT	107	8
S.A. 435 + 00		TO STA. 440 + 00		
ROAD DIST. NO. 7		PROJECT 5-855C		

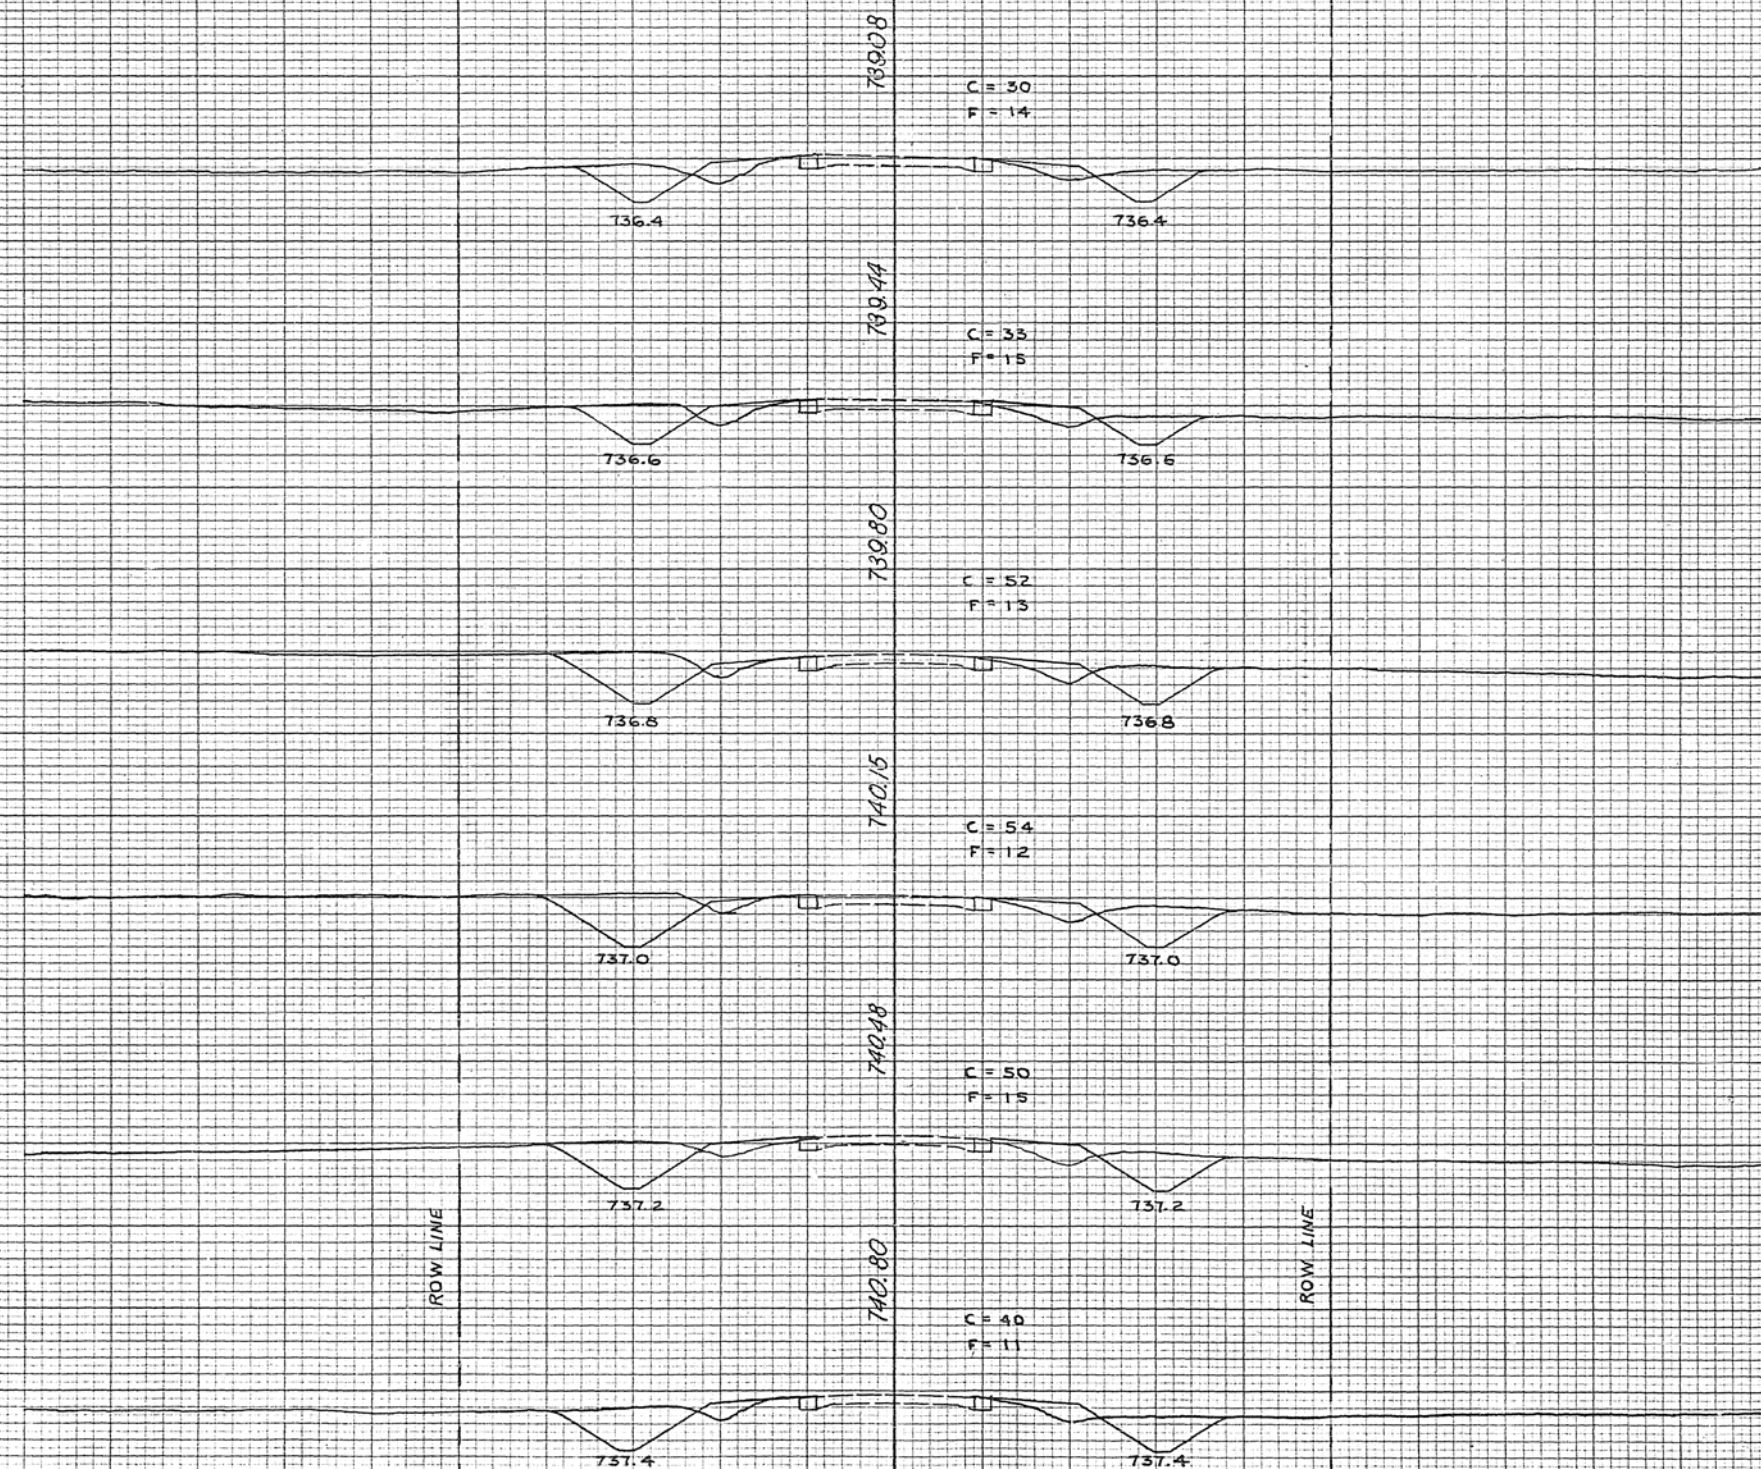

739 (44)

739 (439)

140 (438)







140 (437)

740 (430)

741 (43)

FINAL SURVEY	SURVEYED	BY	DATE
NOTE BOOK	PLOTTED	STARBUCK	5-59
	TEMPERATURE	T.L.A.	5-59
	AREAS	T.L.A.	1-58
	AREAS CHECKED	C.Y.B.	5-59
NO			


ORIGINAL SURVEY	97	DATE
SURVEYED		
PLOTTED		
TEMPLATE		
NOTE BOOK		
AREAS		
AREAS CHECKED		

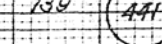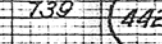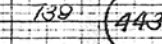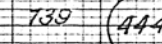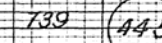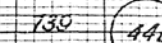

DATE	BY	REVIEWED	DATE
8-58	STARBUCK	8-58	
1/58		1/58	
2-60		2-60	
NO. 3			

DATE	BY	REVIEWED	DATE


ROUTE NO.	SECTION	QUANTITY	DATE	BY
FA-540	LOW-1	MAON (PIATT)	107	85
S.A. 447+00		FOOT 452+00		

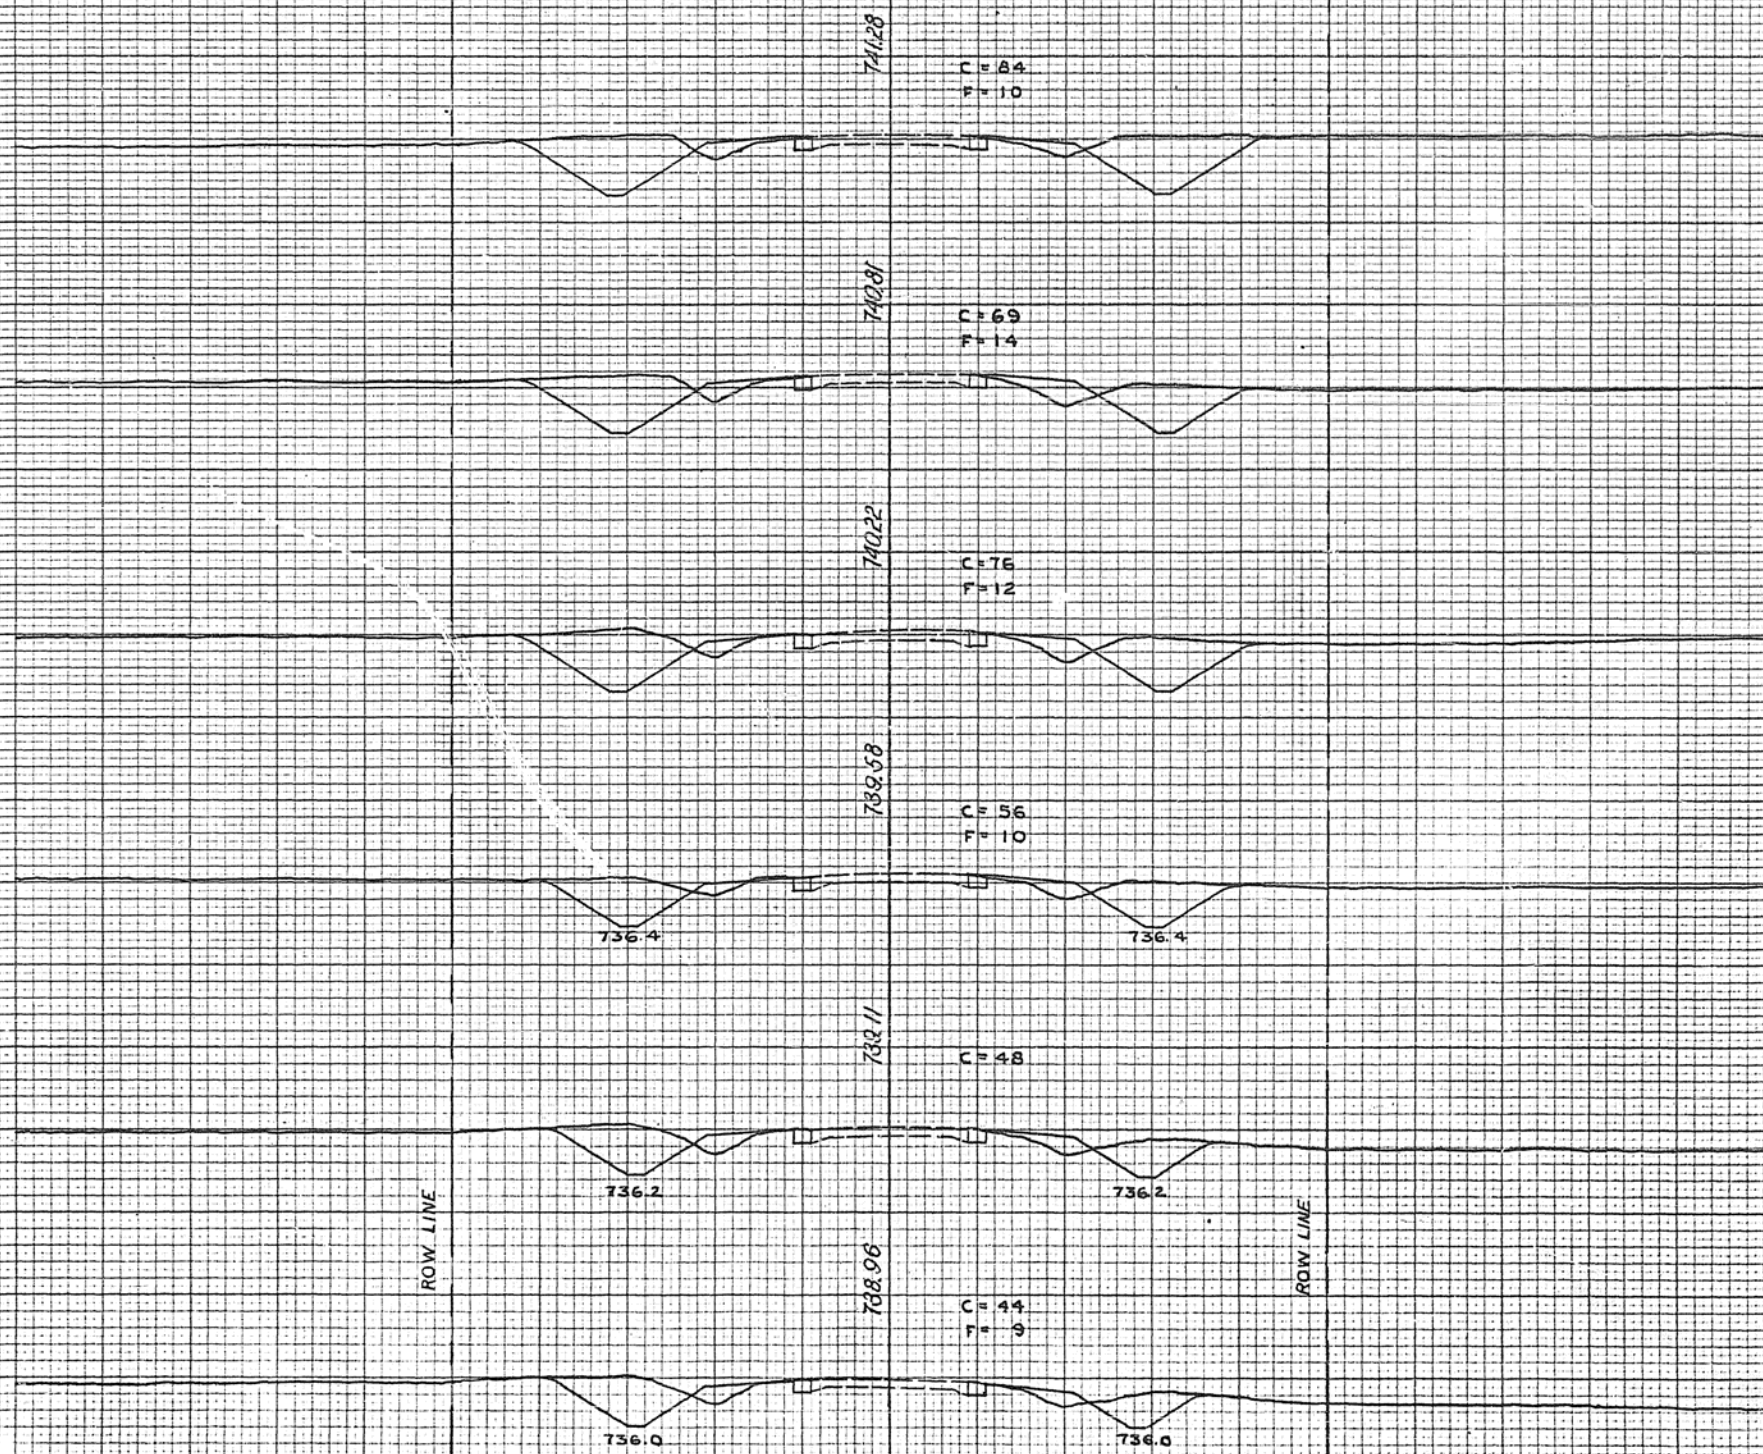

FINAL SURVEY NOTE BOOK NO. 5	SUBMITTED DATE 6-58	BY STARBUCK	CHECKED DATE 6-58

ORIGINAL SURVEY NOTE BOOK NO. 5	SUBMITTED DATE 6-58	BY STARBUCK	CHECKED DATE 6-58

ROUTE NO.	SECTION	COUNTY	TOTAL MILES	SHEET
FAS-540	10W-1	MACON (PLATT)	107.2	86
STA. 453+00	TOTAL 458+00			
NO. ADJ. DIST. NO. 1 (LUMBER)		PROJECT 5-8501		

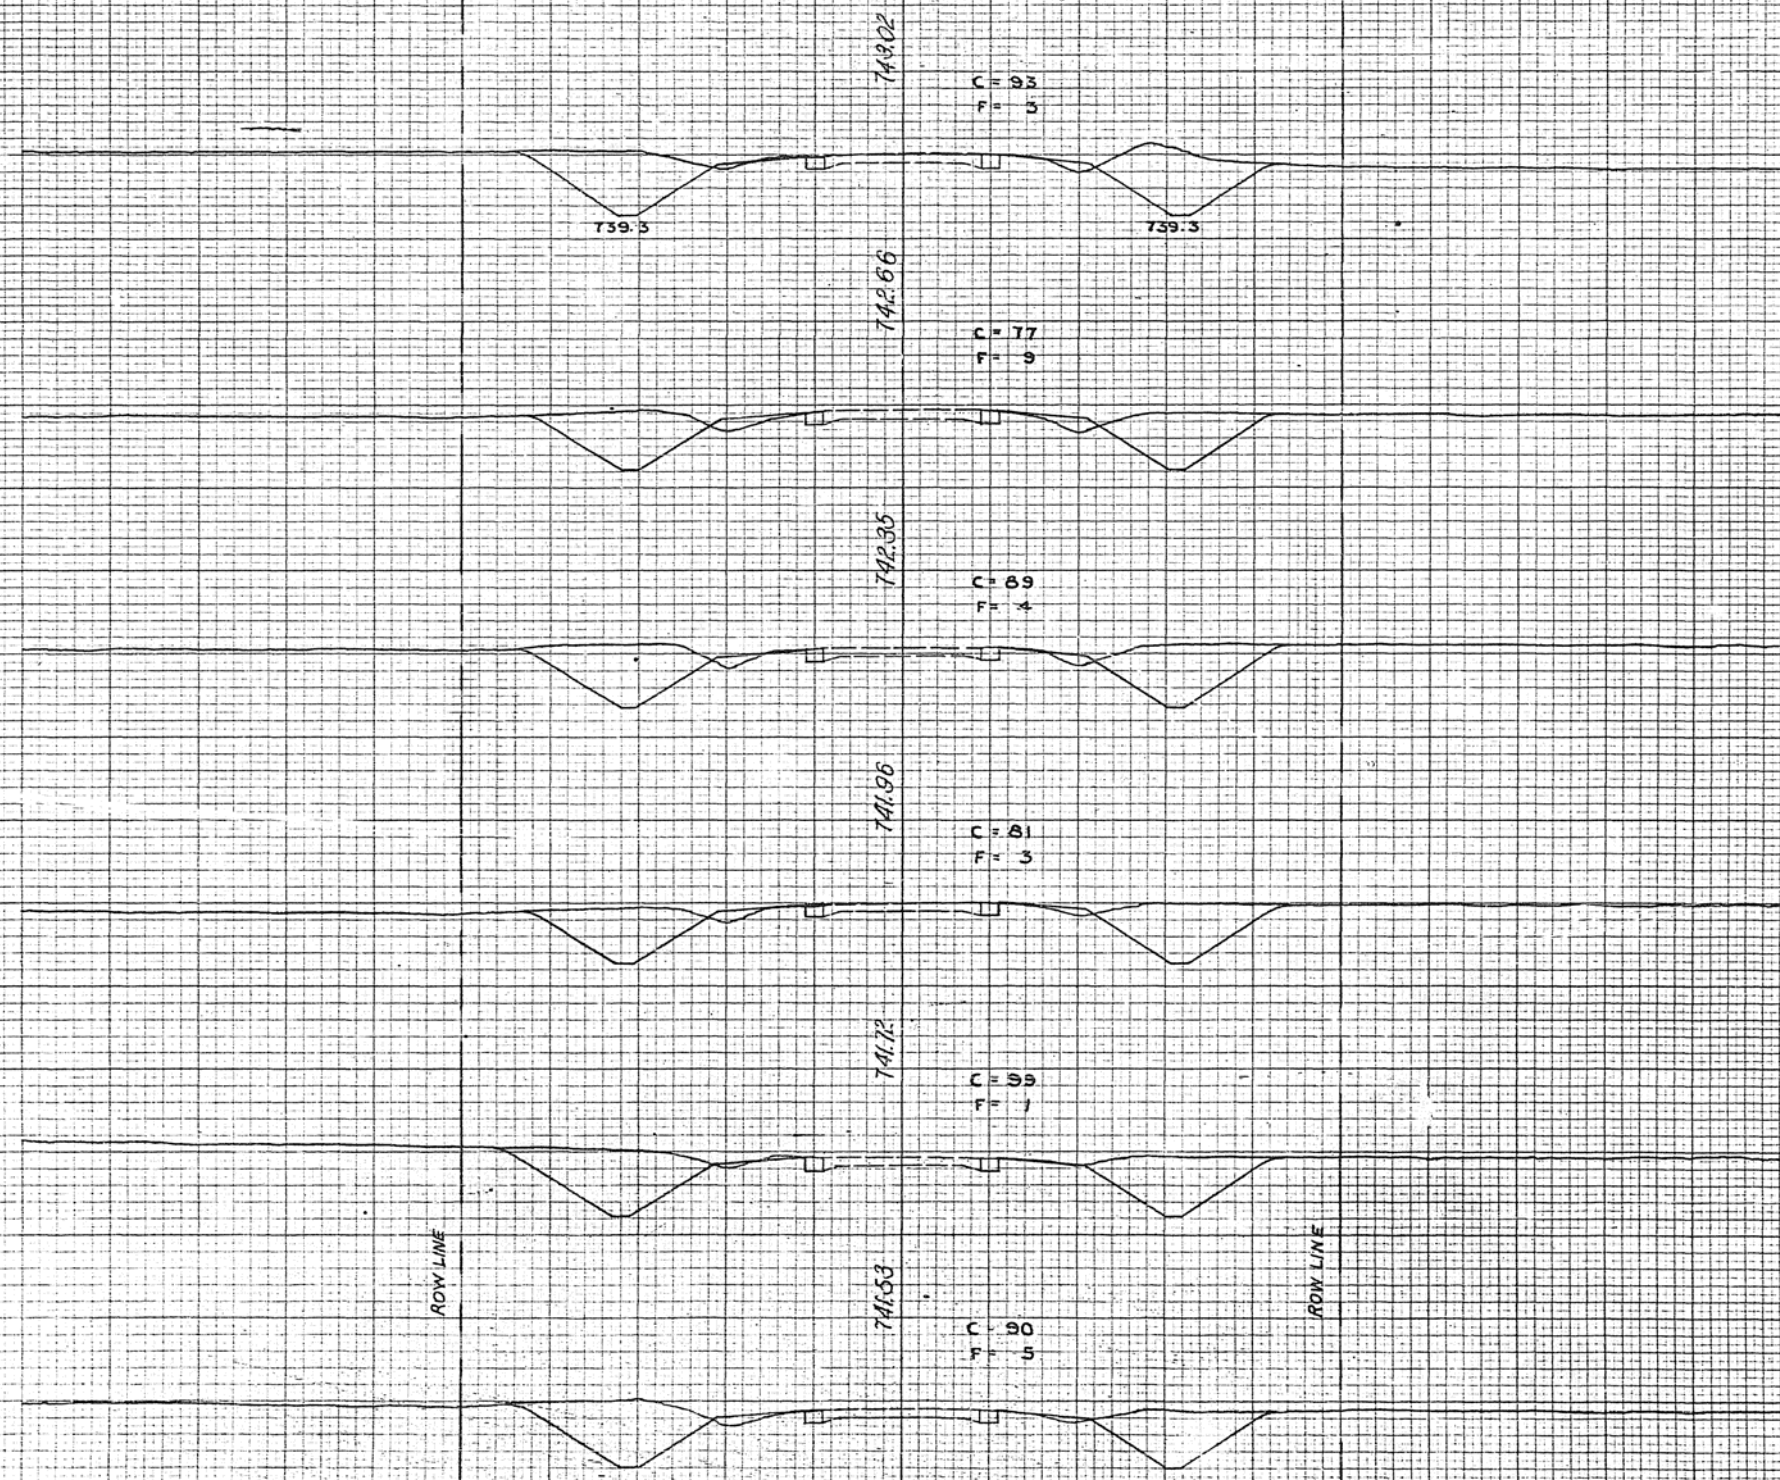

143 (458)

143 (457)

142 (456)

142 (455)


142 (454)

142 (453)

FINAL	DATE	BY	CHKD
SURVEY	11/58	W. J. J.	W. J. J.
ROUTE	3		
NO.	3		

ORIGINAL	DATE	BY	CHKD
SURVEY	11/58	W. J. J.	W. J. J.
ROUTE	3		
NO.	3		

SECTION	DATE	BY	CHKD
107	11/58	W. J. J.	W. J. J.
NO.	3		
NO.	3		

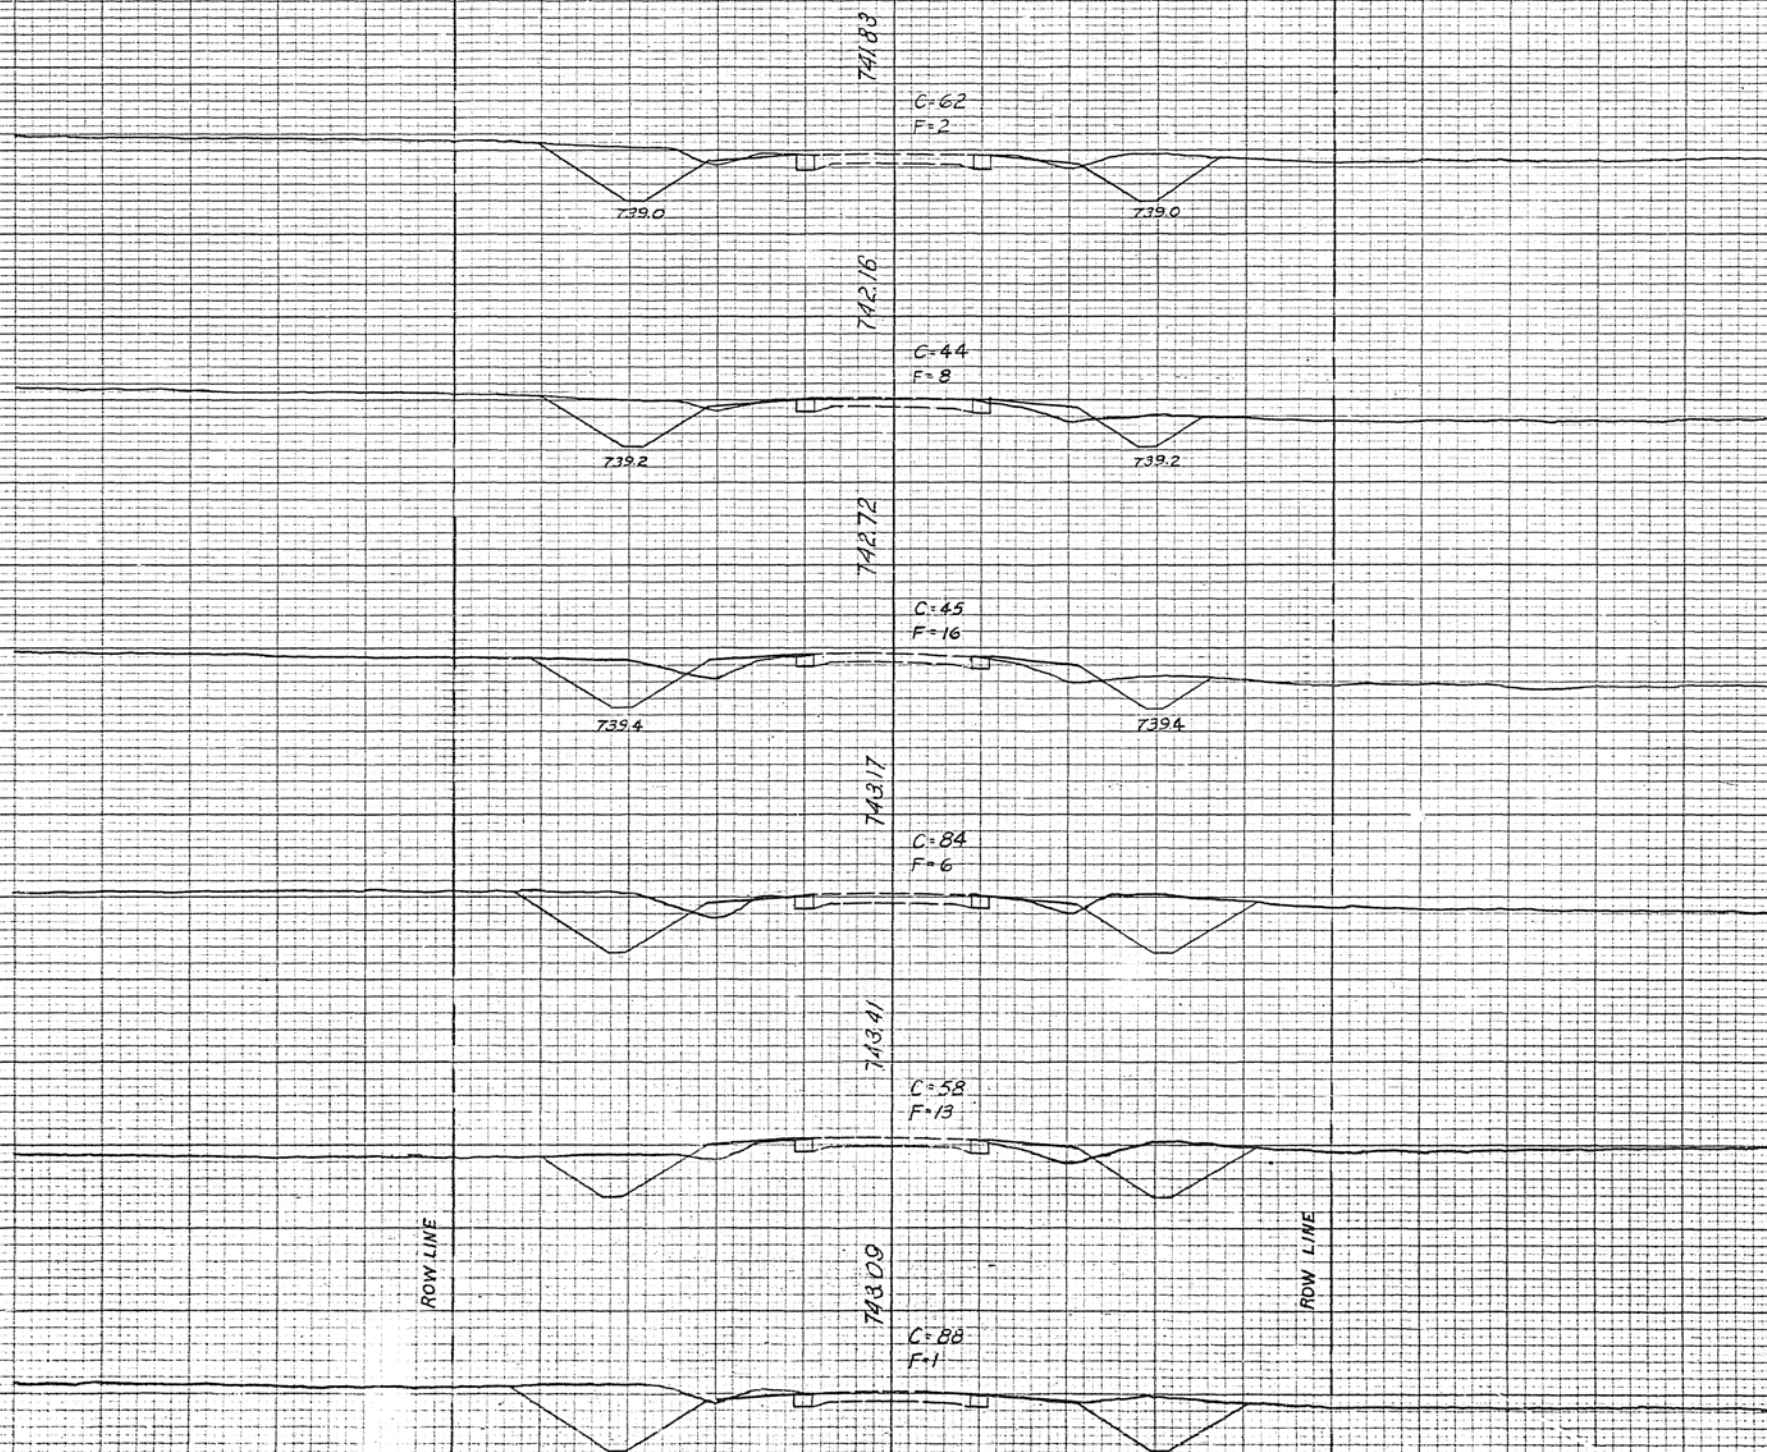

142 464

142 463

143 462

143 461


143 460

143 459

DATE	6-28-58
BY	STARBUCK
SURVEY	STARBUCK
PLOTTED	L.A.
AREA	L.A.
AREA CHECKED	L.A.
FINAL SURVEY	NO. 3

DATE	11/60
BY	STARBUCK
SURVEY	STARBUCK
PLOTTED	L.A.
AREA	L.A.
AREA CHECKED	L.A.
ORIGINAL SURVEY	NO. 3

ROUTE NO.	SECTION	EDMONT	TOTAL	SHEET
145-540	10W-1	MACONE PLATT	107	88
STA. 465 + 00		TO STA. 470 + 00		
1/2 IN. ROAD DIST. NO. 1		1/2 IN. ROAD DIST. NO. 1		

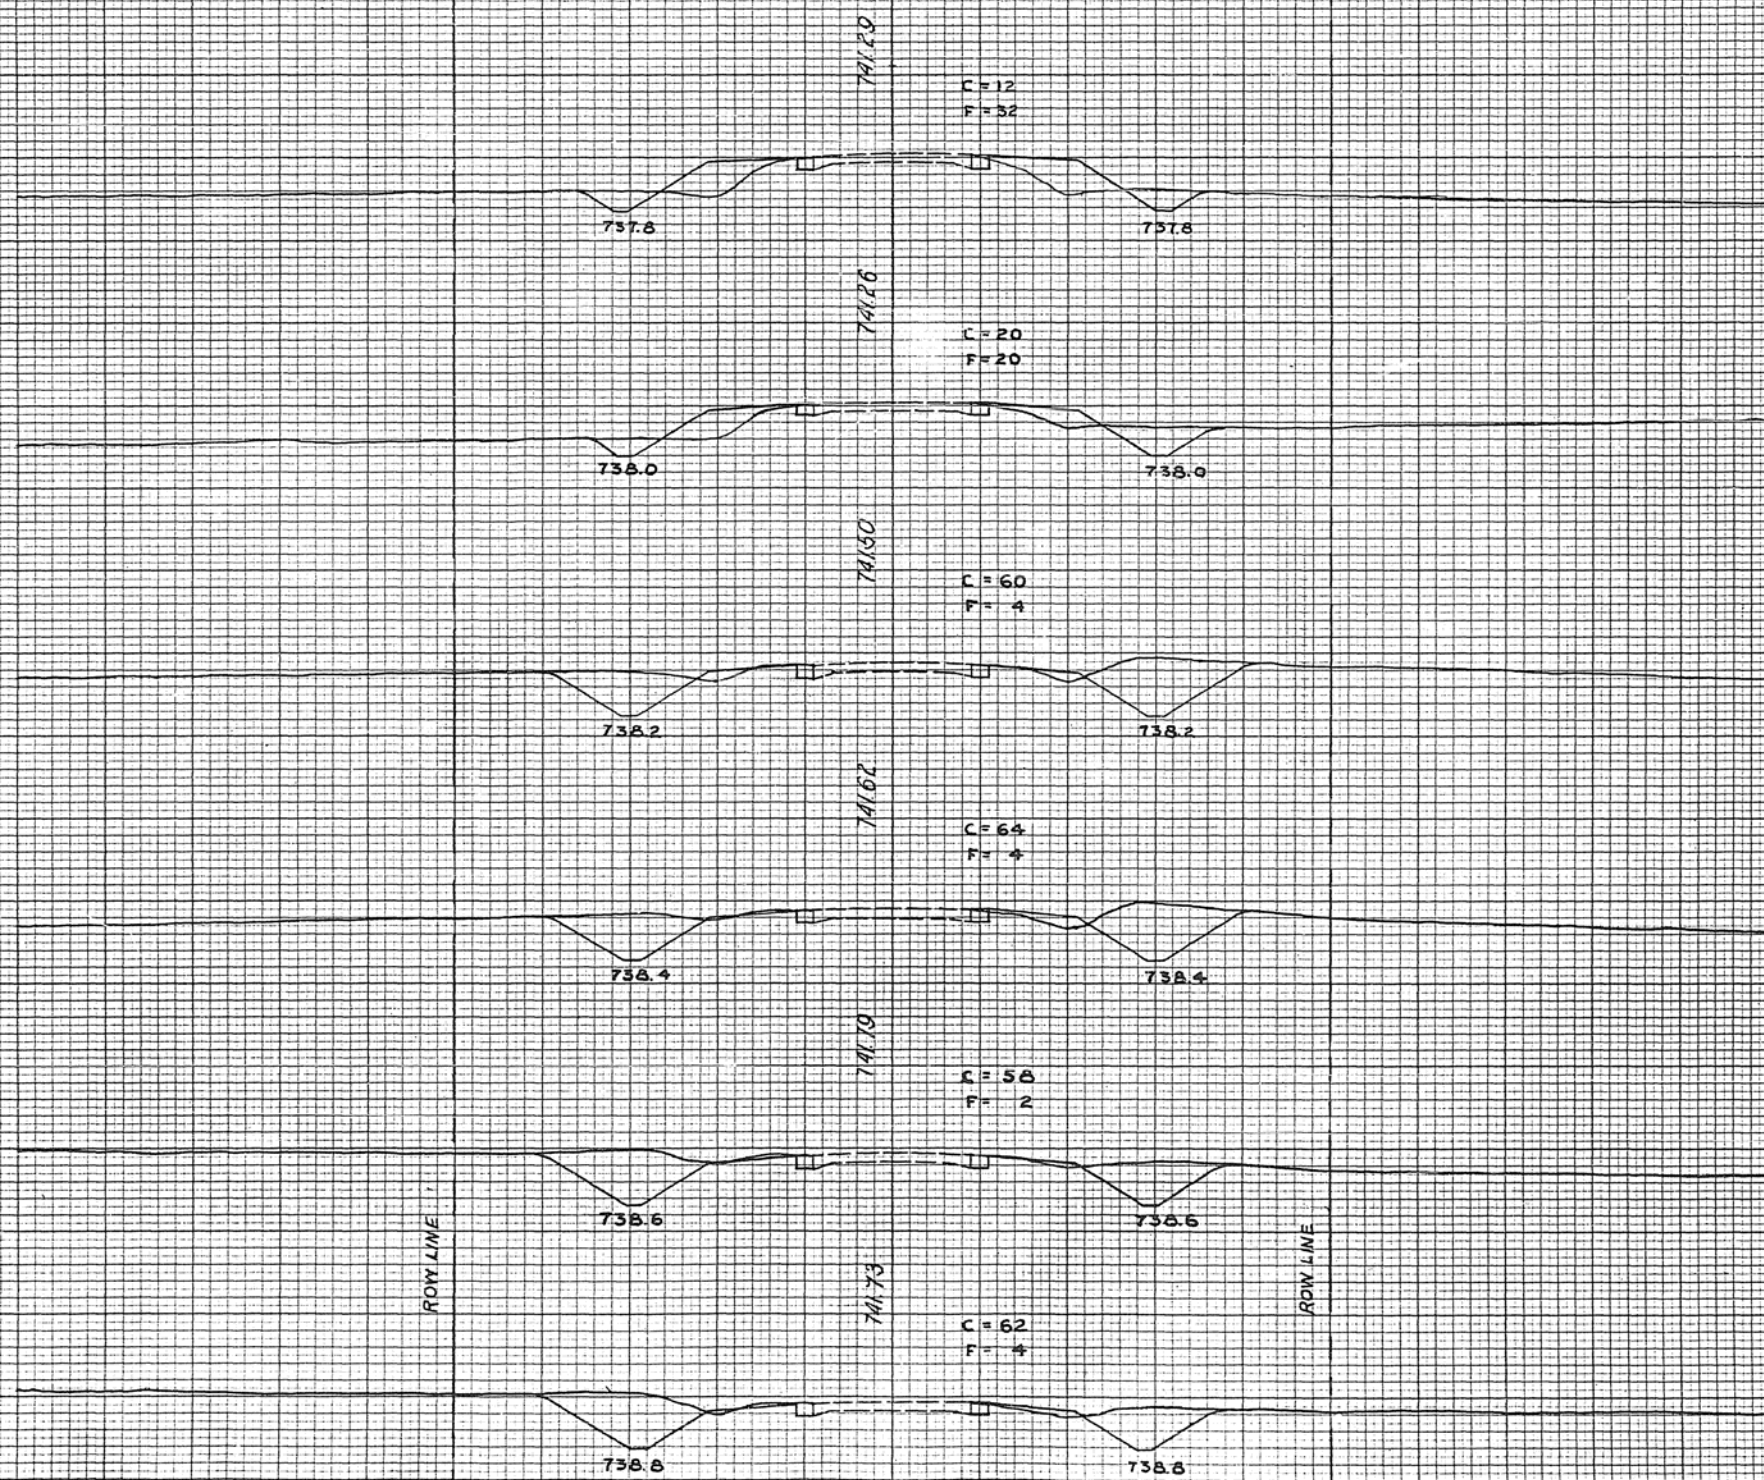

141 470

141 469

142 468

142 467


142 466

142 465

DATE	6-55
BY	STARBUCK
ORIGINAL SURVEY	FILED
NOTE BOOK	FILED
NO.	3

DATE	11/00
BY	STARBUCK
ORIGINAL SURVEY	FILED
NOTE BOOK	FILED
NO.	

ROUTE NO.	SECTION	COUNTY	TOTAL	SHEET
FA-540	101	MACON & PIATT	101	91
STA. 483+00			TO STA. 485+00	

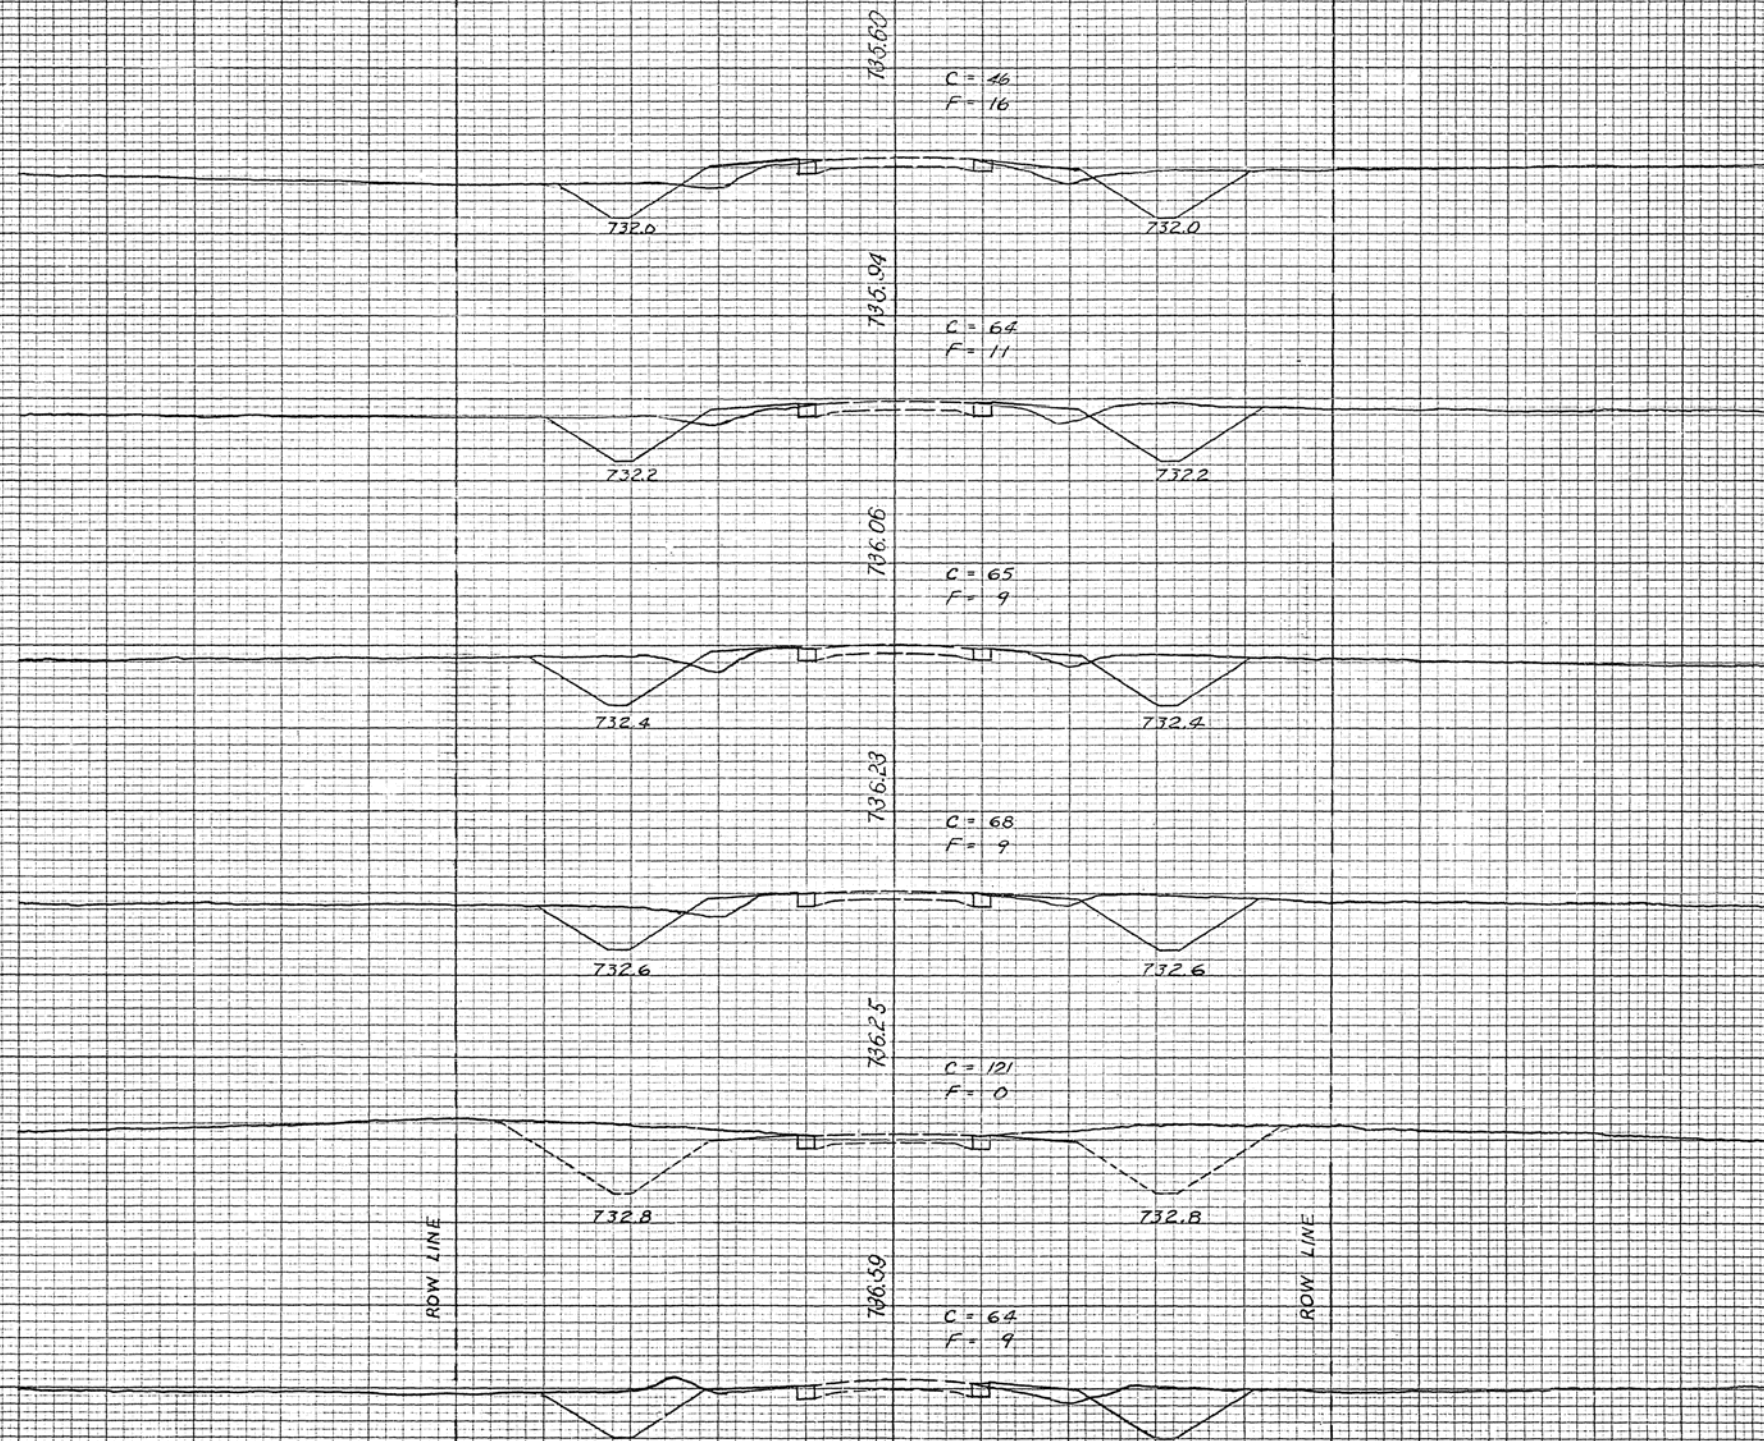

136 (488)

136 (487)

136 (486)

136 (485)

136 (484)

136 (483)


ROUTE NO.	SECTION	COUNTY	TOTAL SHEET	SHEET NO.
145-540	107	MACON PIATT	107	93
STA 495+00 - TO STA. 500+00		PROJECT 5-8351		

DATE	BY
6-58	STARBUCK
8-58	T.W.A.
9-58	T.W.A.
5-60	C.J.E.

FINAL SURVEY NOTE BOOK NO. 3	SURVEYED PLOTTED TEMPLATE AREAS CHECKED
---------------------------------------	--

DATE	BY
11/58	STARBUCK
	F.R. J.O.S.

ORIGINAL SURVEY NOTE BOOK NO. 3	SURVEYED PLOTTED TEMPLATE AREAS CHECKED
--	--

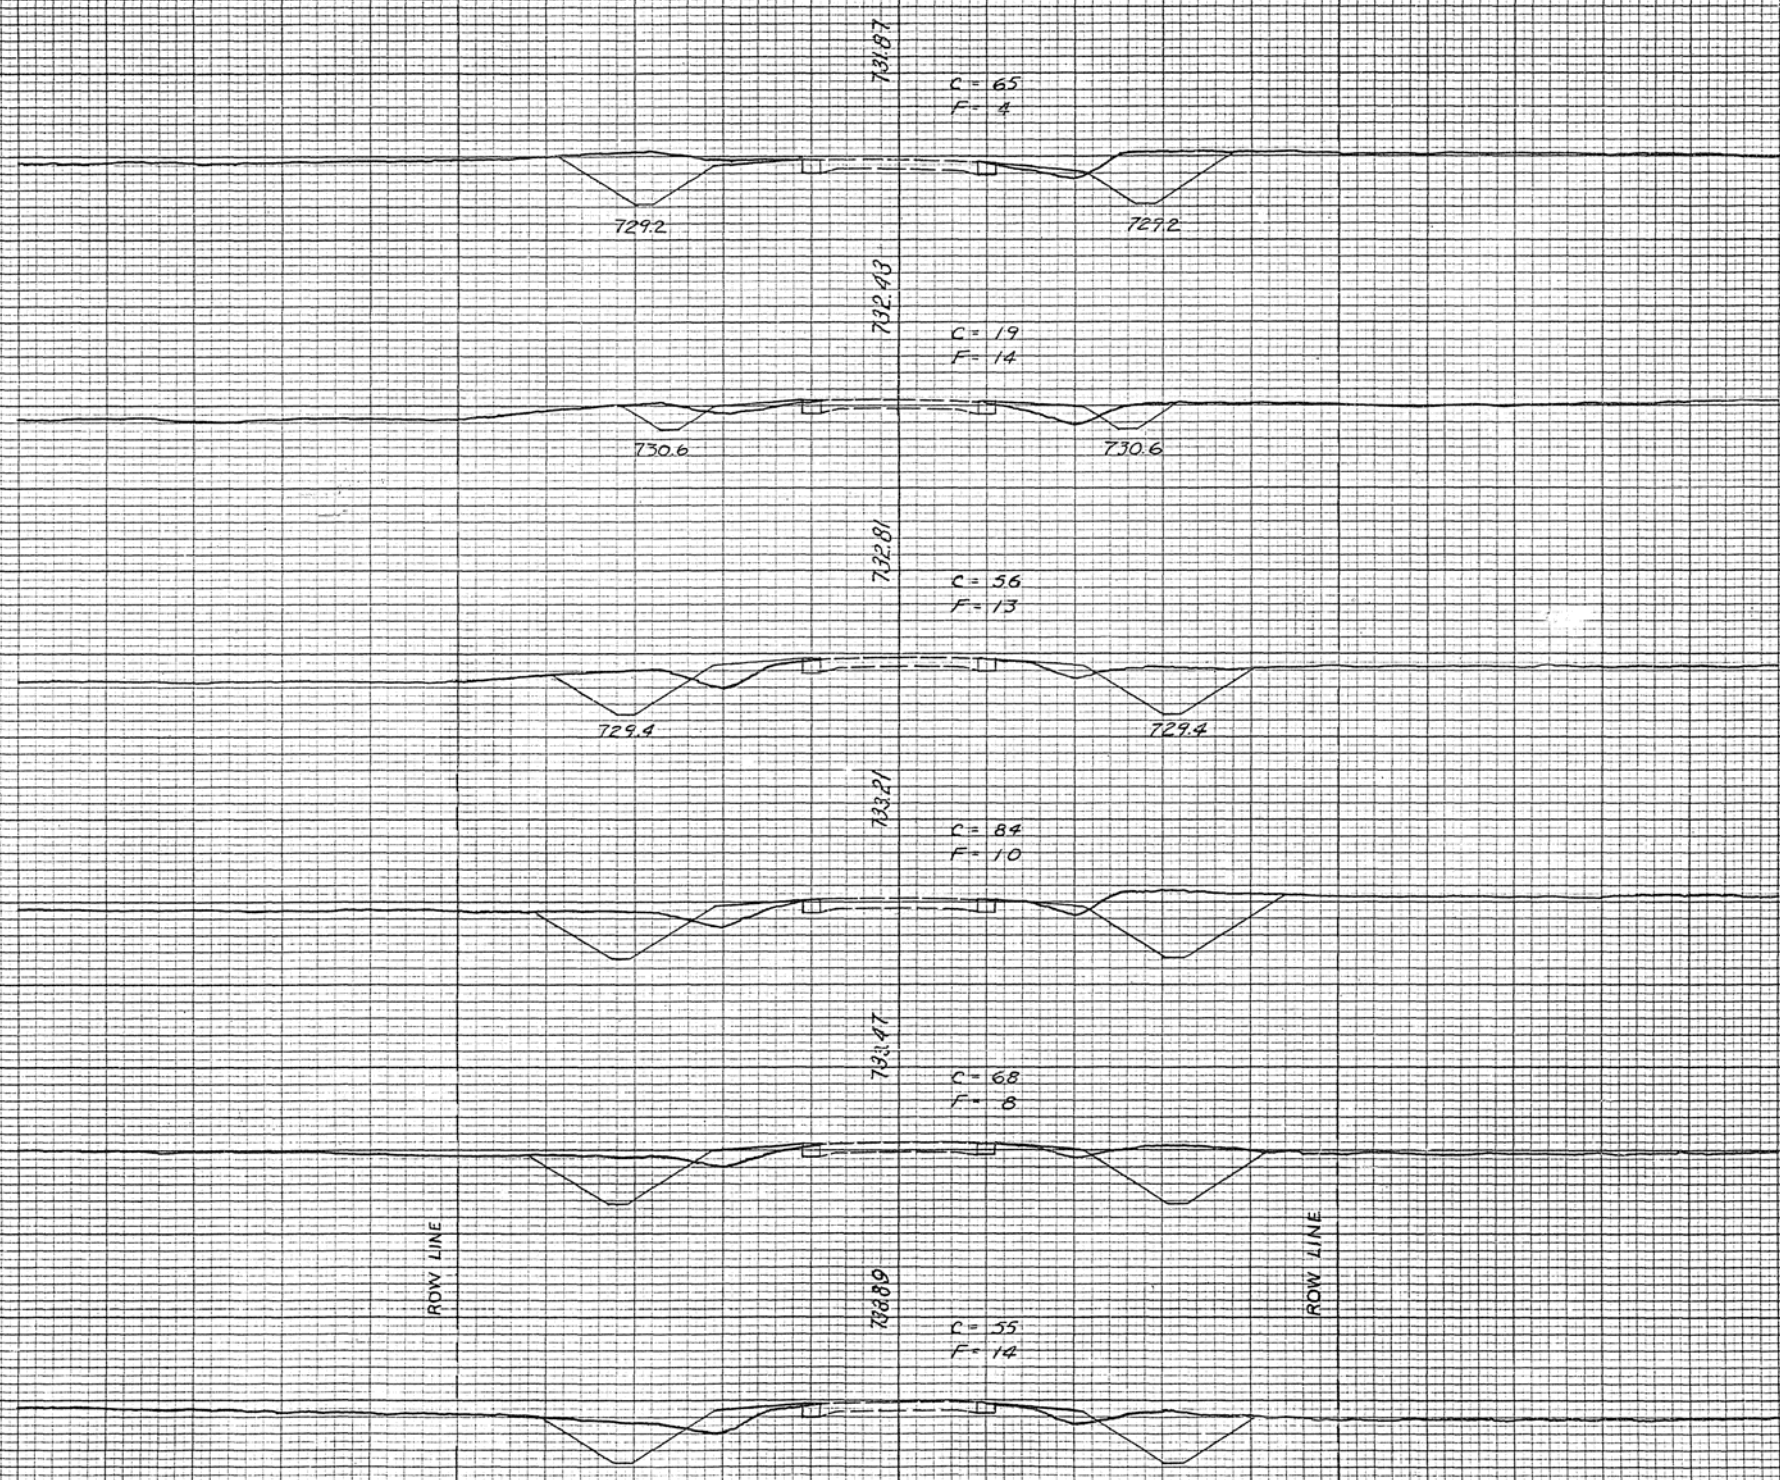

732 (500)

732 (499)

733 (498)

733 (497)


733 (496)

734 (495)

ROUTE NO.	SECTION	COUNTY	TOTAL SHEETS	SHEET NO.
145-540	10th	MACON PIATT	107	95
STA 507+00			ELEV 512+00	
TYPED BY: JLL			PROJECT: 5-83	

DATE	BY	REVISION	NO.
6-88	STARBUCK		1
8-88	JLL		2
2-90	JLL		3
6-90	JLL		4

DATE	BY	REVISION	NO.
6-88	STARBUCK		1
8-88	JLL		2
2-90	JLL		3
6-90	JLL		4

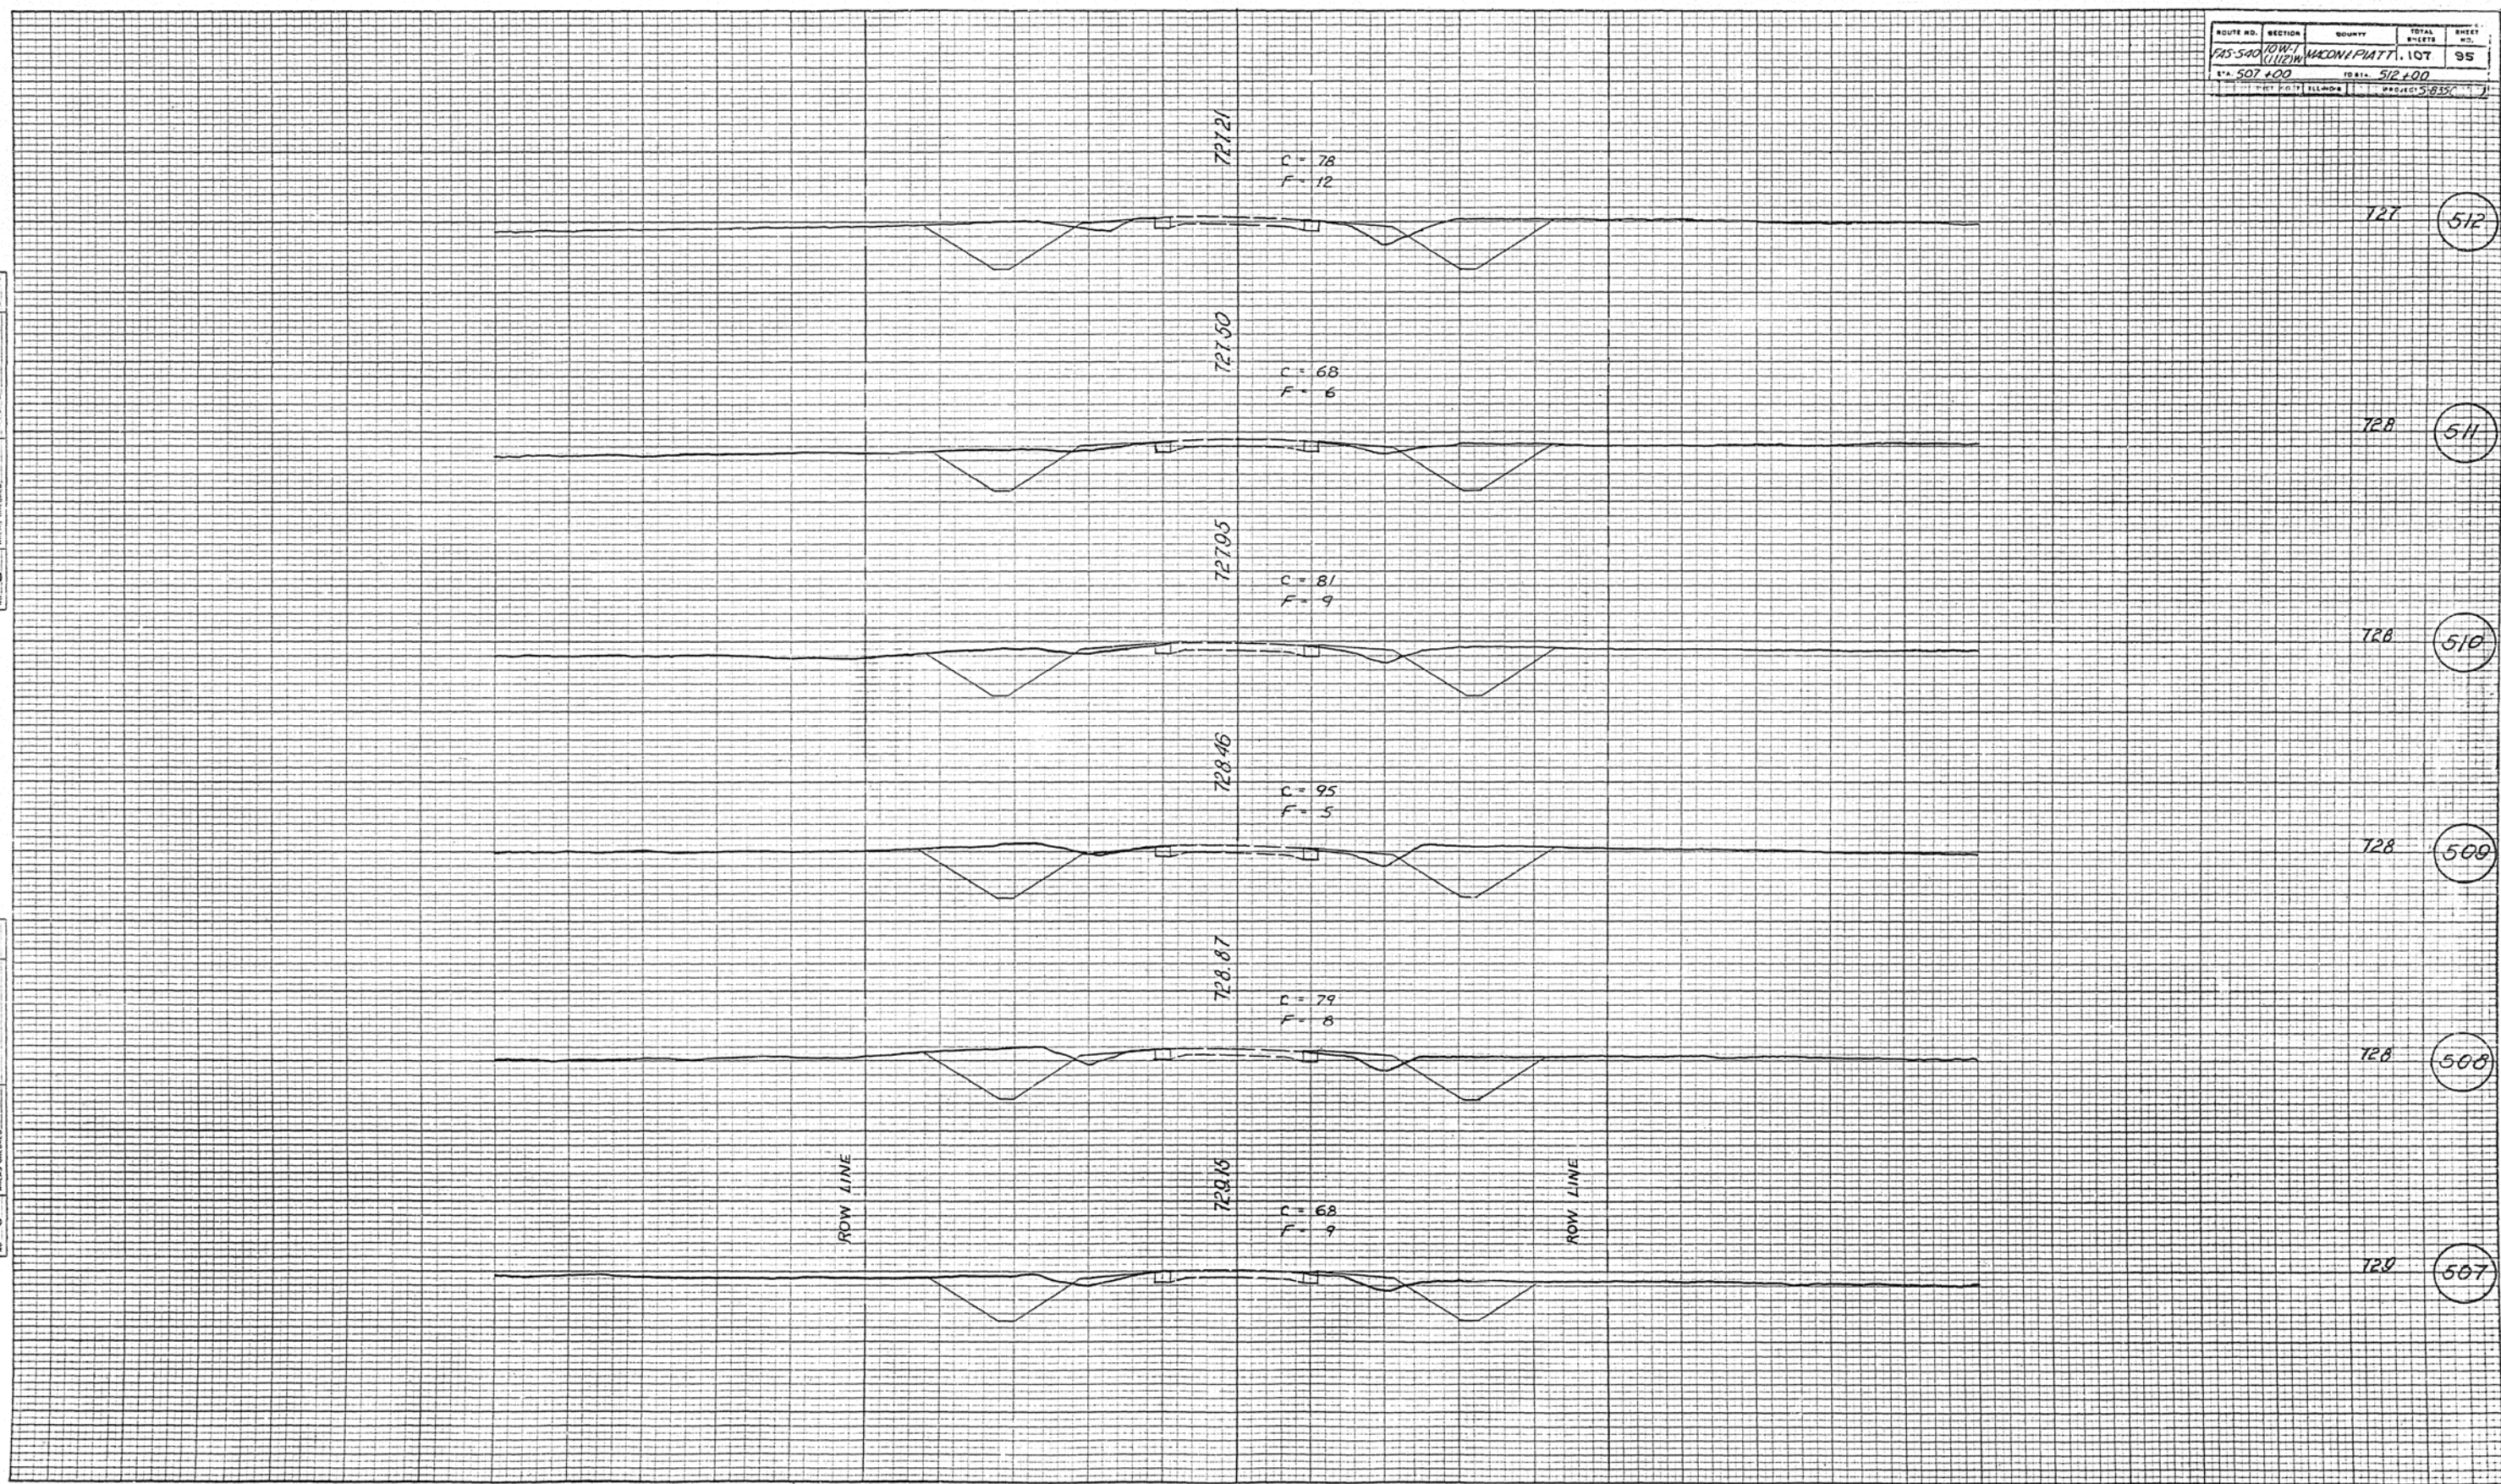

121 (512)

728 (511)

728 (510)

728 (509)


728 (508)

728 (507)

DATE	6-28-60
BY	STARBUCK
FINAL SURVEY	SURVEYED
NOTE BOOK	PLOTTED
NO	3
	AREAS CHECKED

DATE	
BY	
ORIGINAL SURVEY	SURVEYED
NOTE BOOK	PLOTTED
NO	
	AREAS CHECKED

ROUTE NO.	SECTION	COUNTY	TOTAL	SHEET
145-540	10W-1	MACON, PIATT	107	96
STA. 513+00		108+00		518+00
PROJECT 5-535				

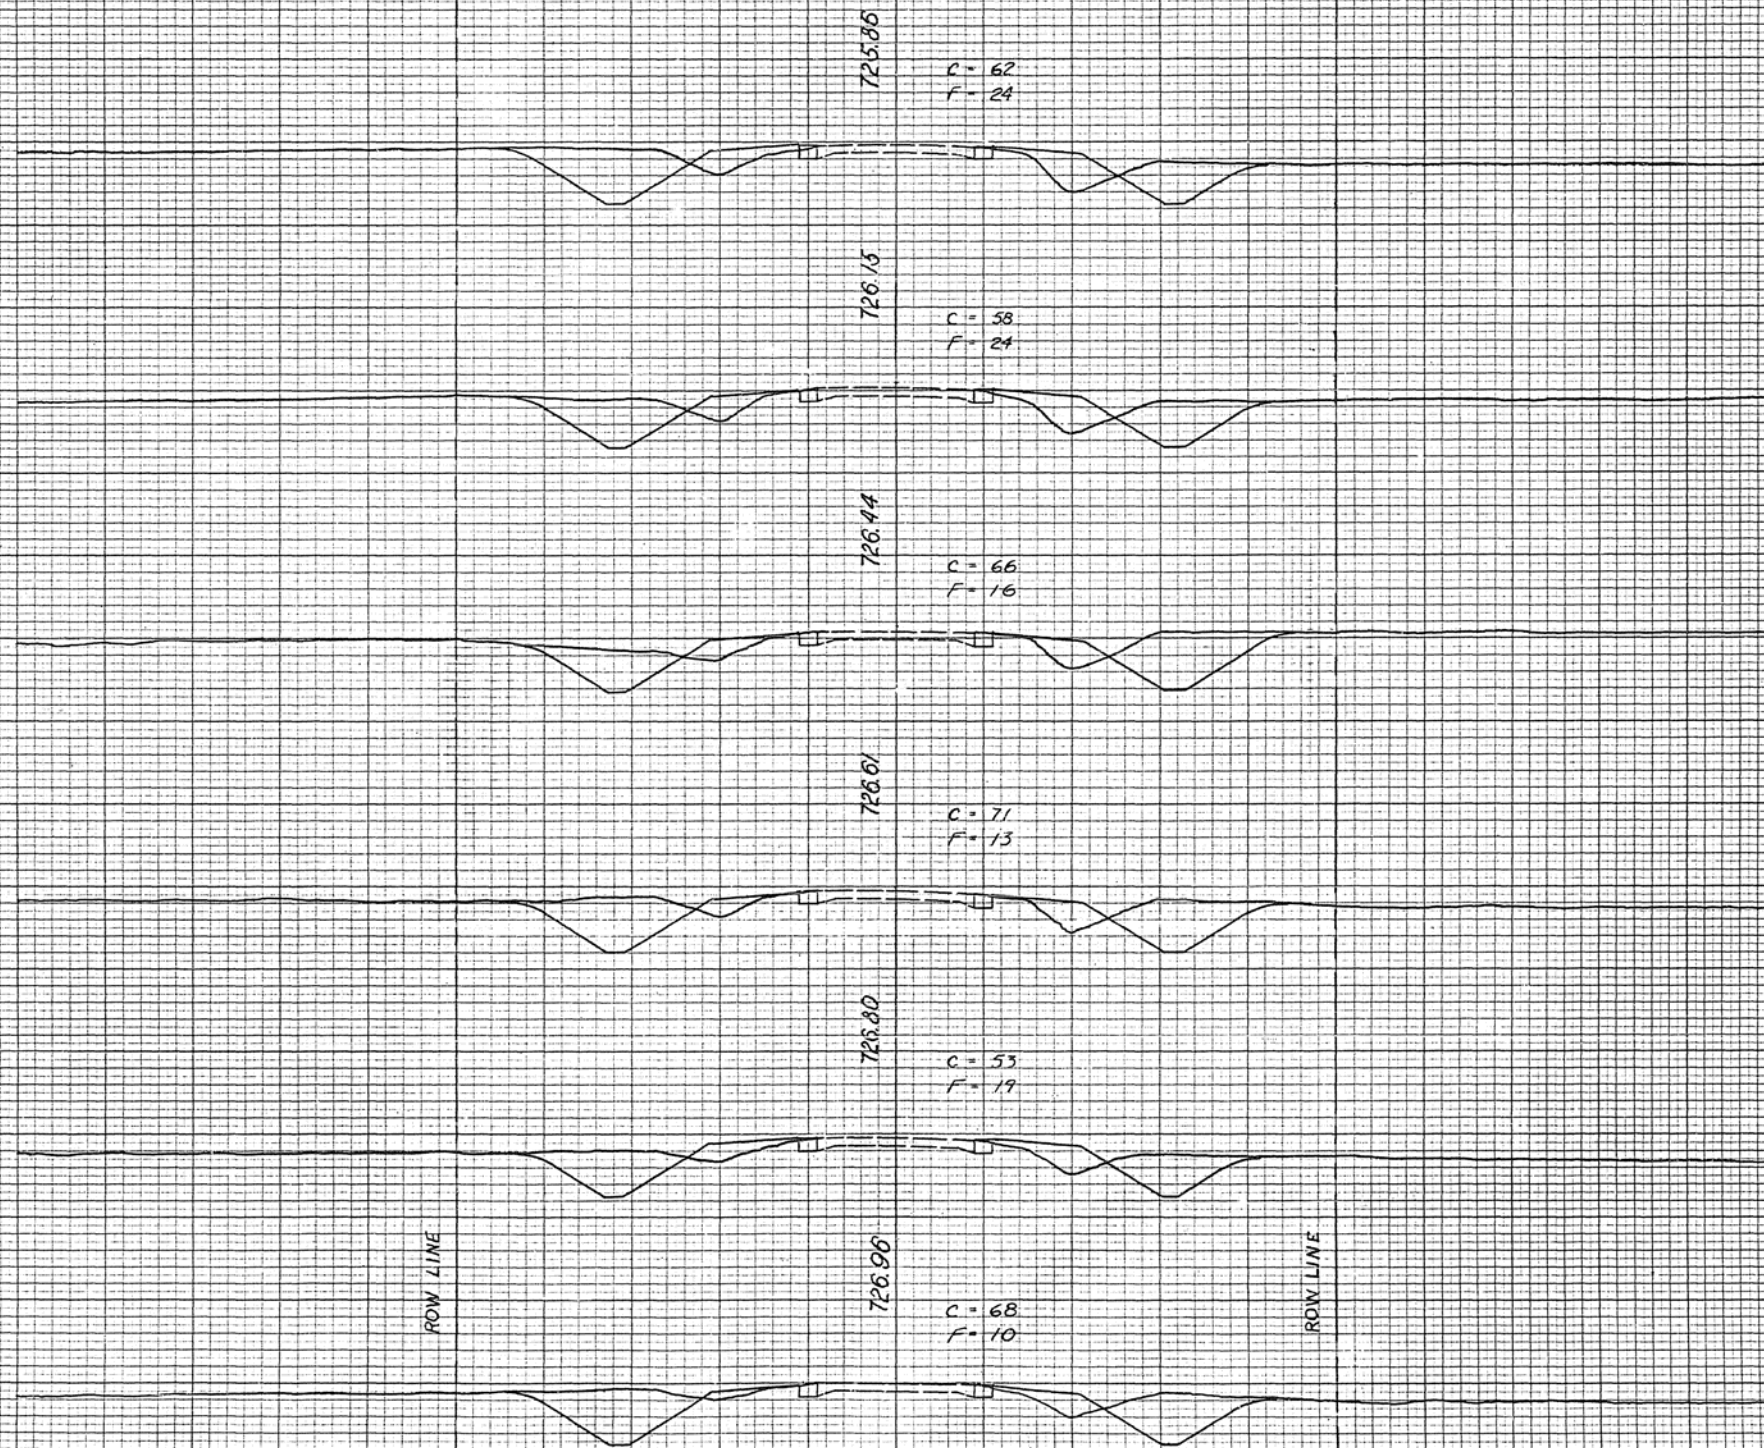

126 (518)

126 (517)




126 (516)

127 (515)

127 (514)


127 (513)

ROUTE NO.	SECTION	COUNTY	TOTAL MILES	EST. MILES
FAS-540	ROW-1 (CL. 12)W	MACON & PIATT	107	97
STA. 519 + 00		TOTAL 524 + 00		
ROW-100-000-107	CL. 12	TOTAL 5.635		

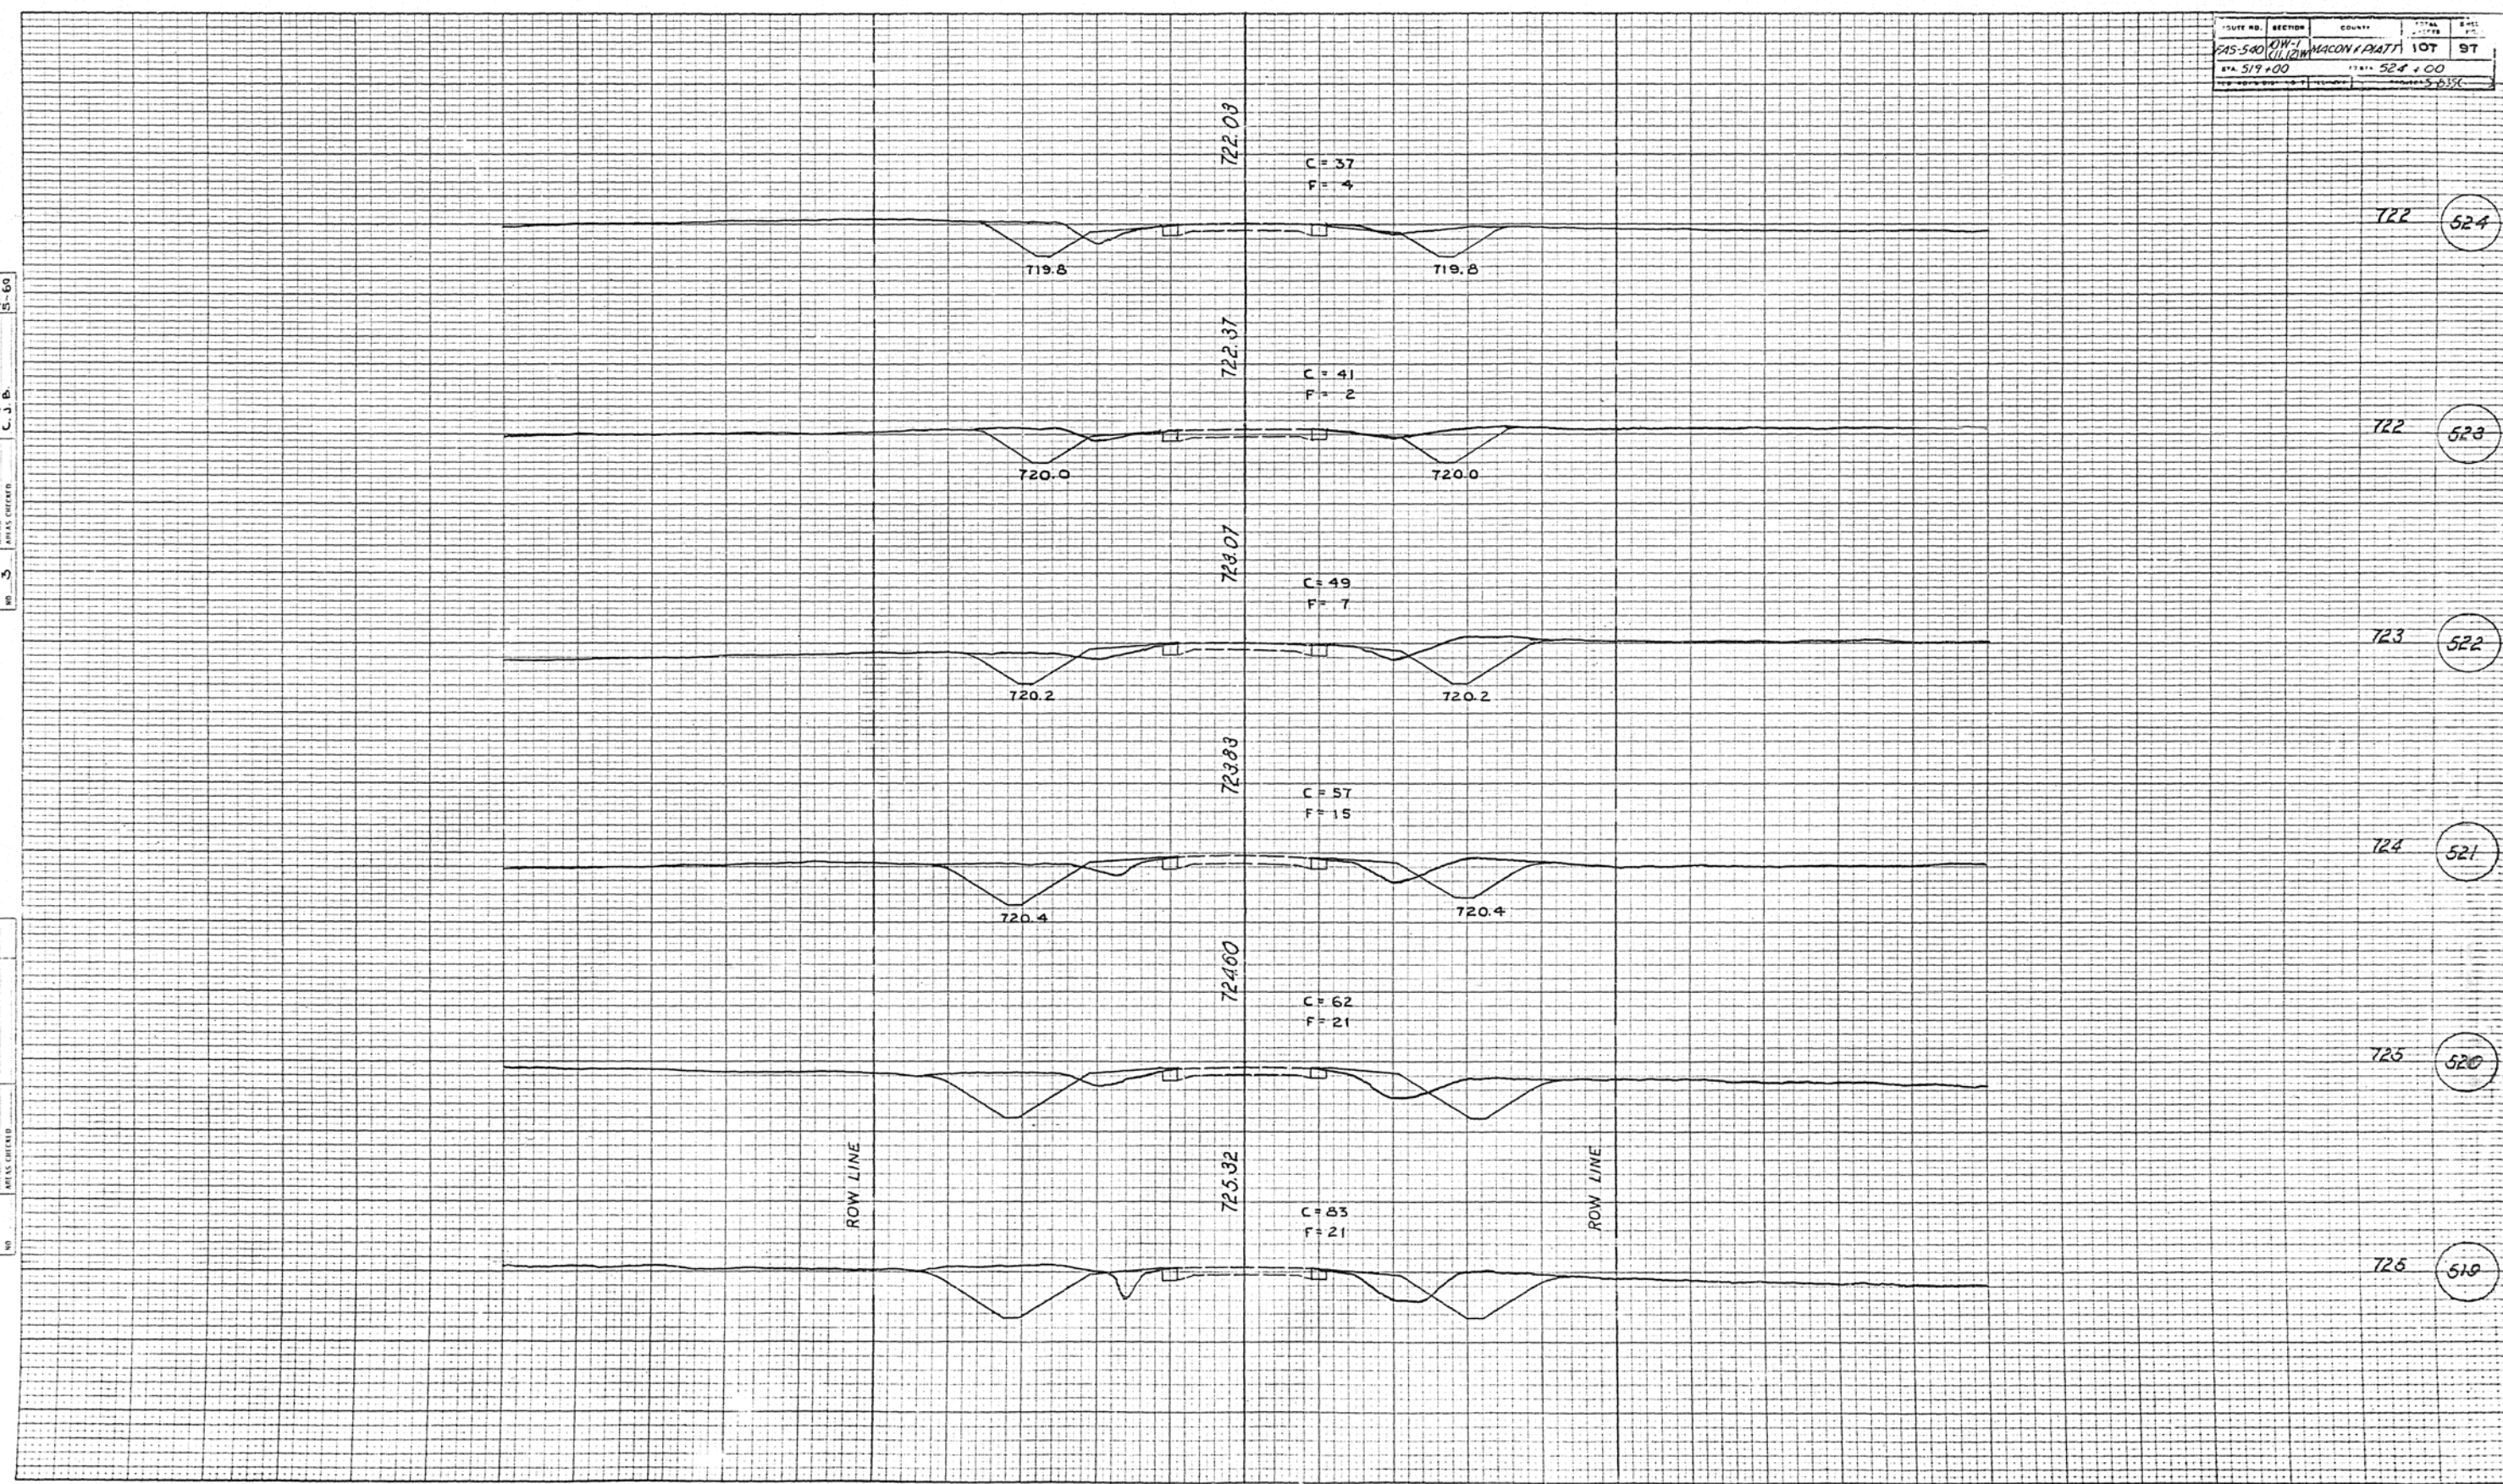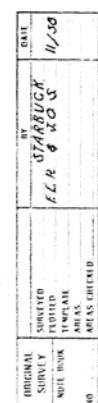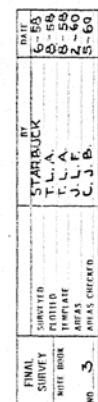

ORIGINAL SURVEY	NOTE BOOK	NO.	SURVEYED PLOTTED TEMPLATE AREAS	BY STARBUCK P.E.R. & W.A.C.	DATE
					11/158

ROUTE NO.	DIRECTION	COUNTY	TO AA	TO BB
FAS-540	KW-1 (11/12)N	MACON & PIATT	10T	9B
Sta. 525+00		TO Sta. 530+00		
FD 2242 RST 99.3	11/12/12	MACON & PIATT		

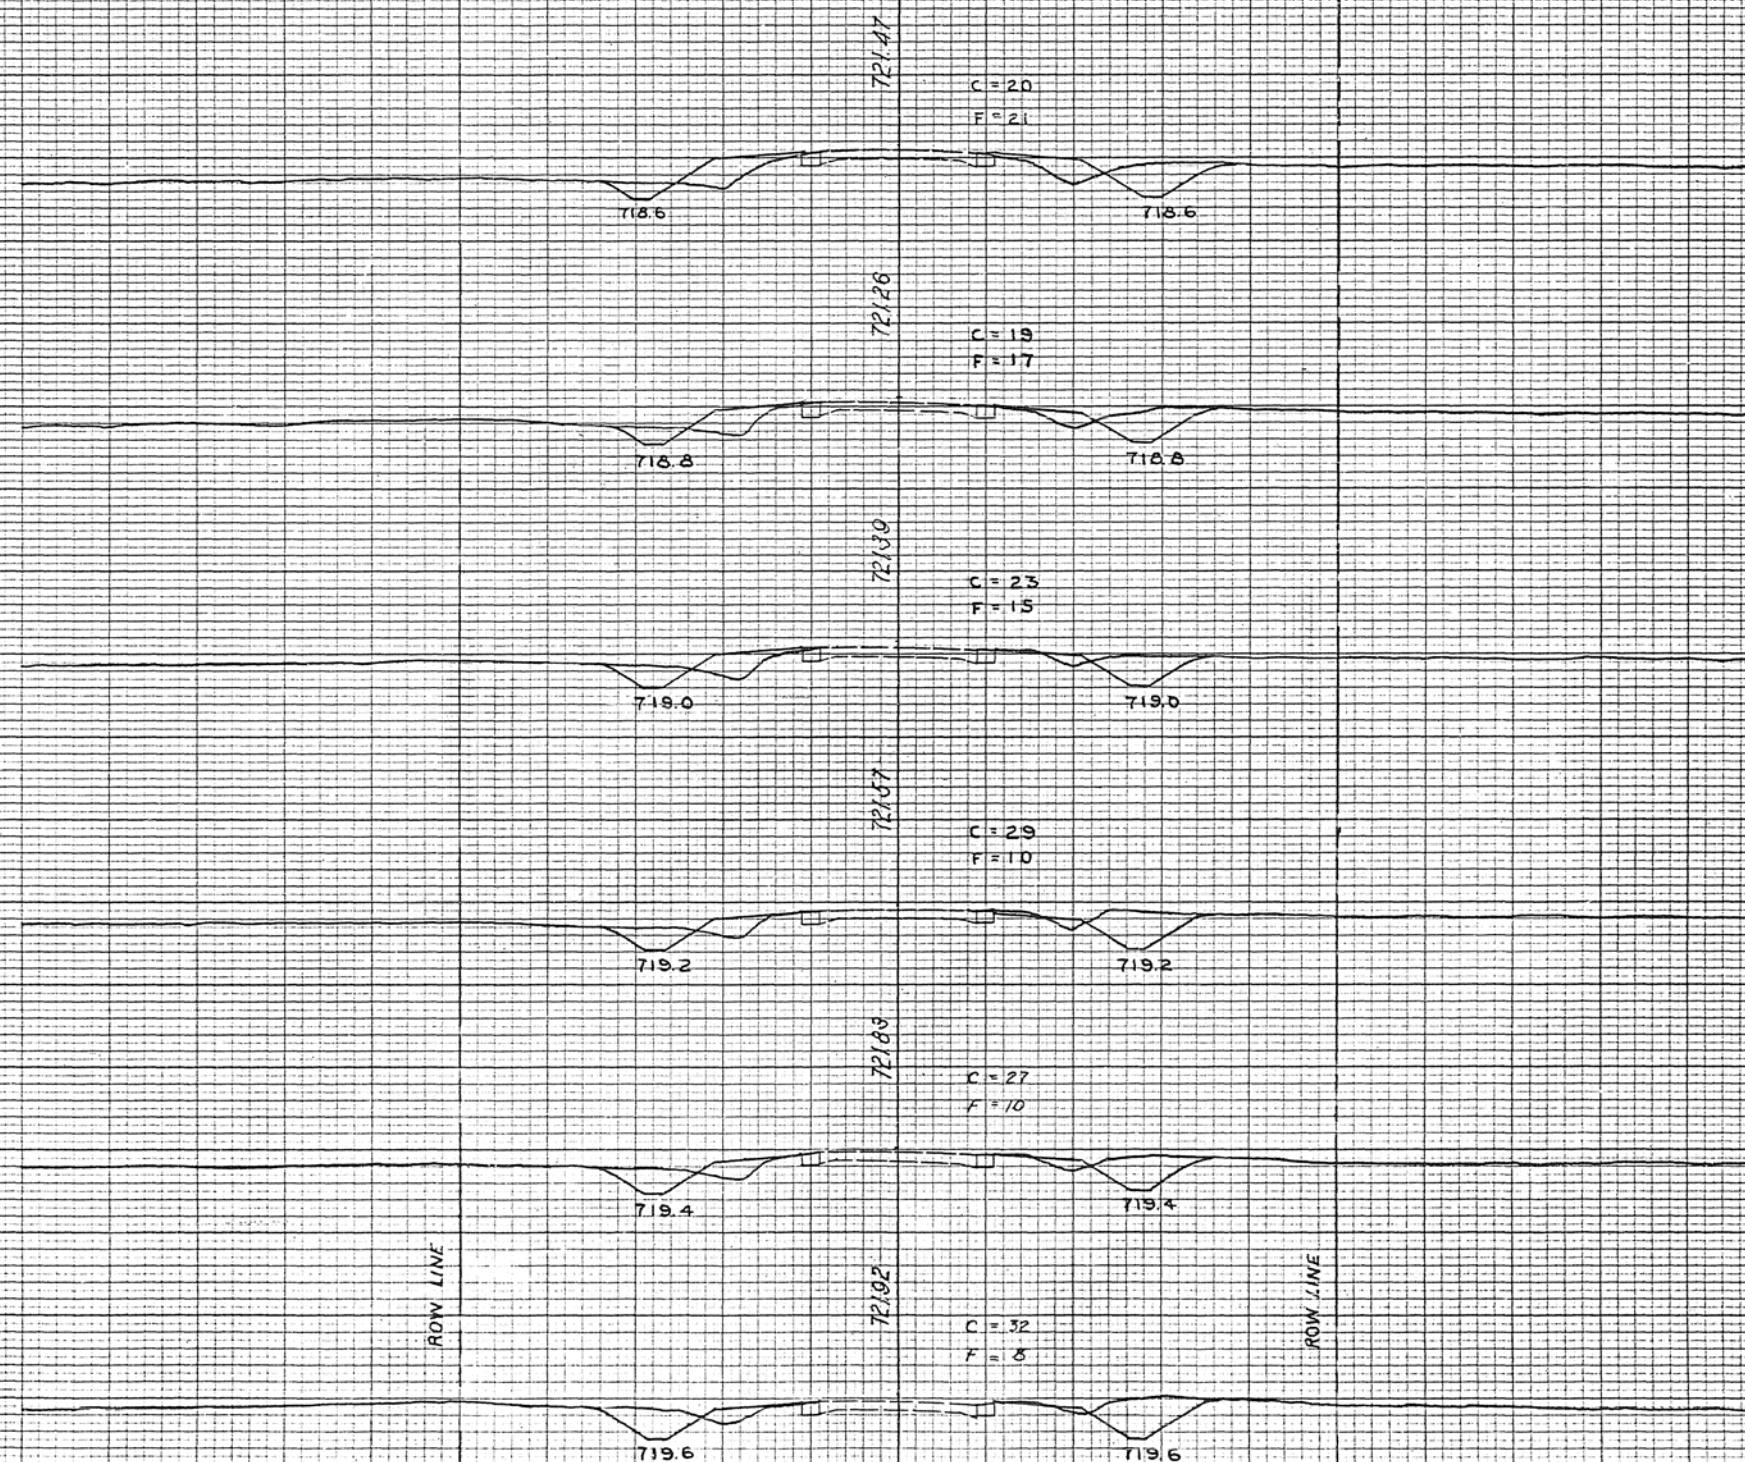

721 (530)

721 (529)

721 (528)

722 (527)

722 525

722 (528)

ROUTE NO.	SECTION	SHEET	TOTAL SHEETS
FA-540	10W-1 (112)W	MACON PLATT	107 99
STA 530+91.65		TOTAL SHEETS 107 99	

DATE	5-30-59
BY	STARBUCK
REVISION	1-1-59
DATE	1-1-59
BY	STARBUCK
REVISION	1-1-59
DATE	1-1-59
BY	STARBUCK

DATE	5-30-59
BY	STARBUCK
REVISION	1-1-59
DATE	1-1-59
BY	STARBUCK
REVISION	1-1-59
DATE	1-1-59
BY	STARBUCK


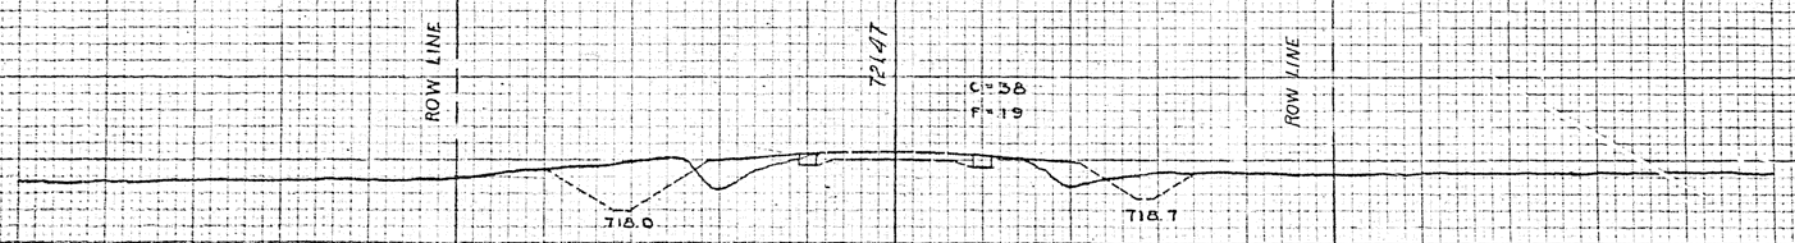



PLATE 3 CHOOSE SECTION B P. N. STANDARD
 DRAWN BY: J. C. JONES, JR. 1959

721 730
 5.65


DETAILS OF STANDARD FRAMES AND GRATES TYPES 1 TO 8

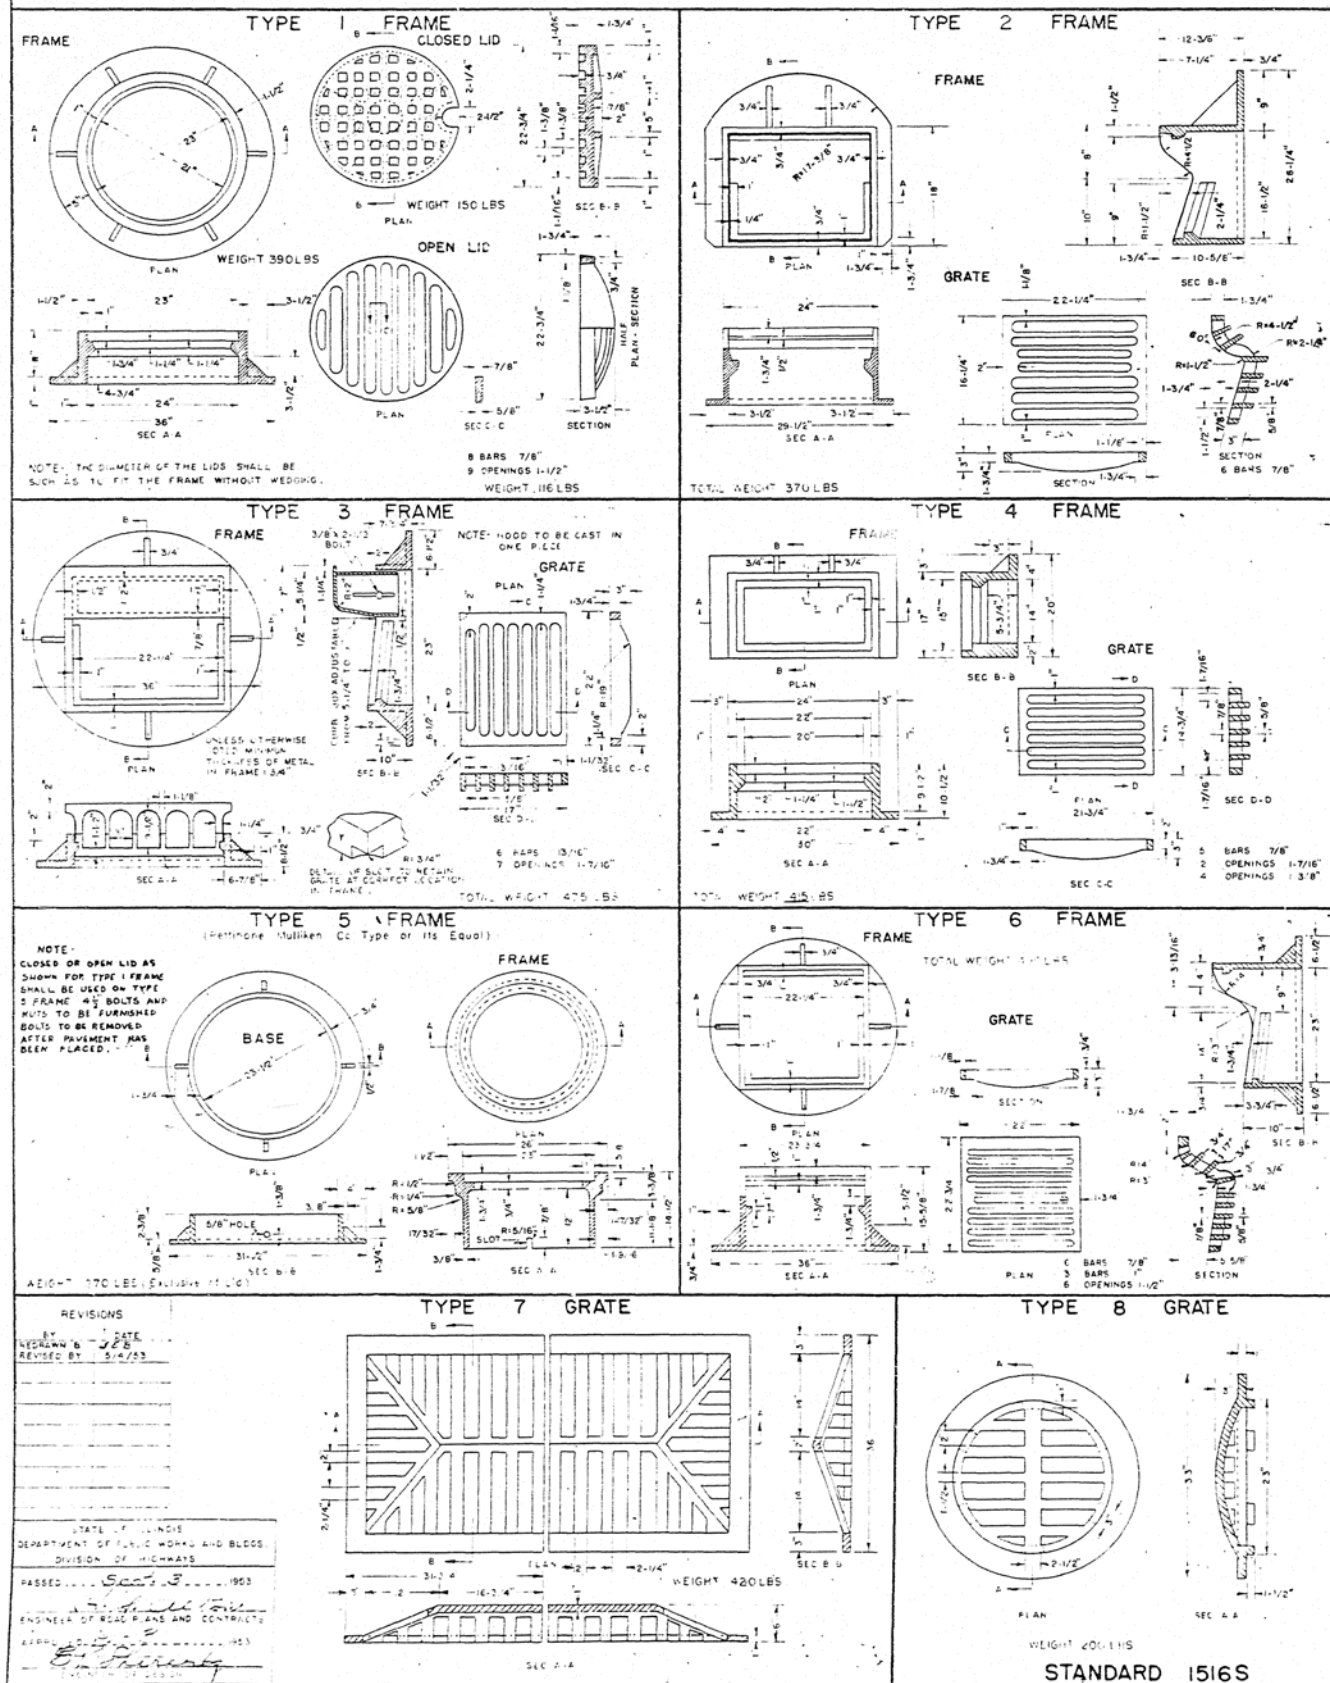

DETAILS OF STANDARD FRAMES AND GRATES TYPES 9 TO 15





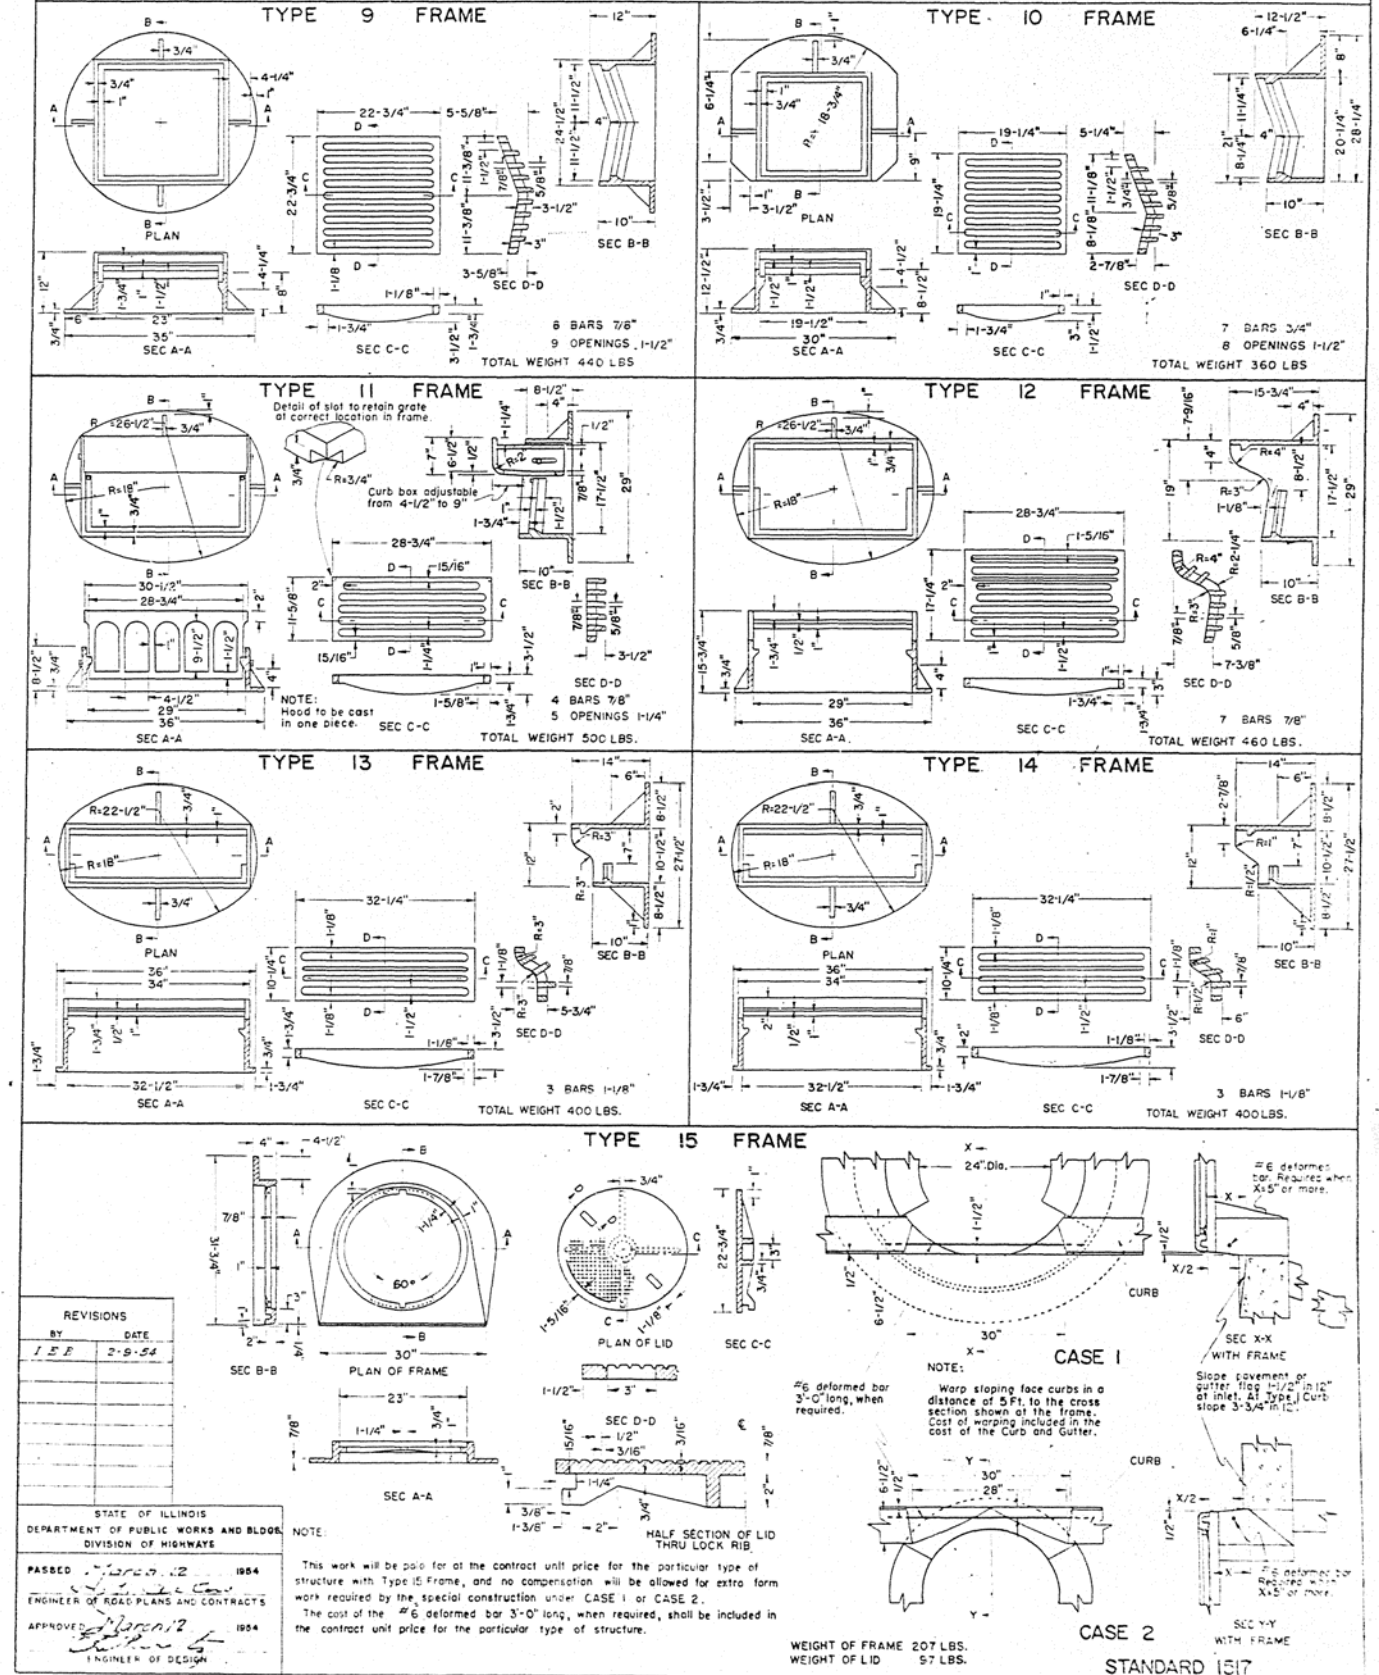


STANDARD DESIGN FOR RIGHT OF WAY MARKERS

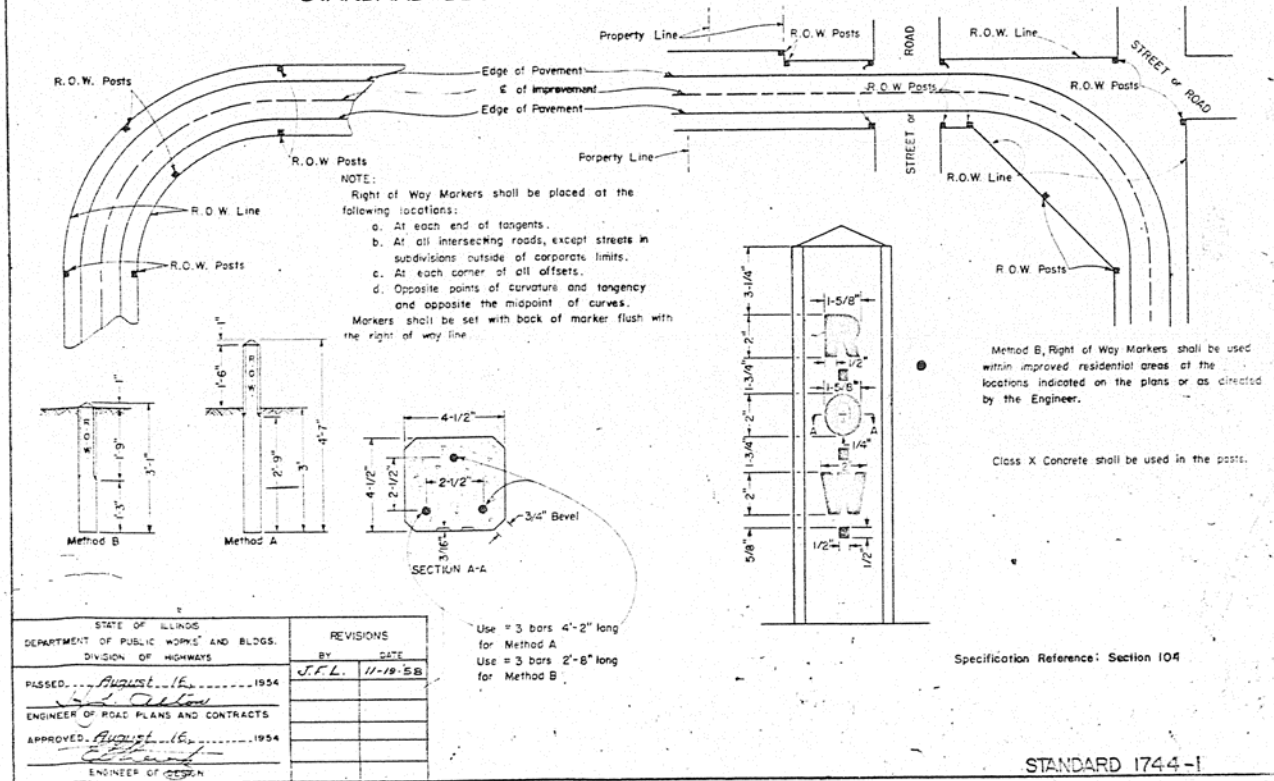

STATE OF ILLINOIS DEPARTMENT OF PUBLIC WORKS & BUILDINGS DIVISION OF HIGHWAYS

SHEET 1 OF 1

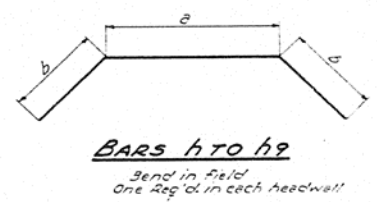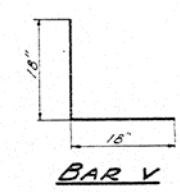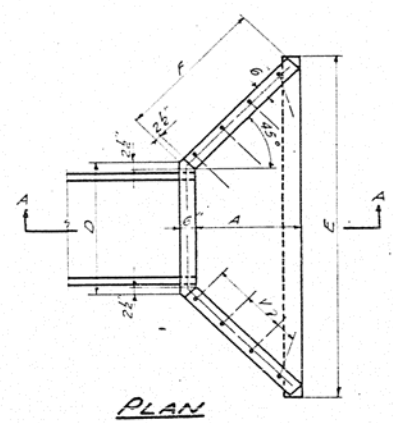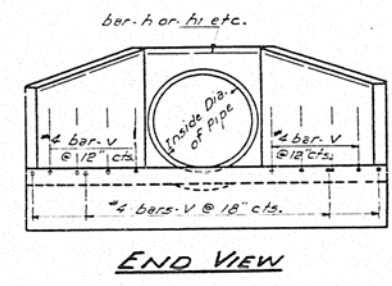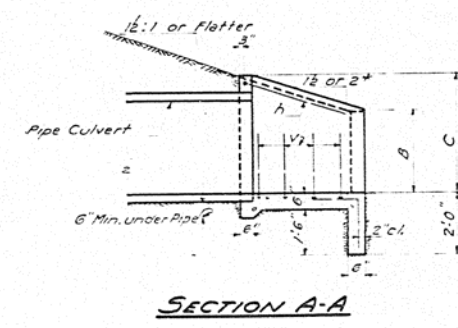

Mark	H	B
H	1'10"	2'58"
H1	1'10"	3'28"
H2	2'1"	3'58"
H3	2'1"	4'28"
H4	2'9"	4'58"
H5	2'9"	5'28"
H6	3'3"	5'58"
H7	3'3"	6'28"
H8	3'11"	6'58"
H9	3'11"	7'28"

TABLE OF DIMENSIONS


Design No.	Inside dia. of Pipe	Slope of Fill	Dimensions						C/S One Shows Cu. Yds.	Reinforcement Bars			
			A	B	C	D	E	F		h Bars	h Bars	V Bars	h Bars
D15-16	15"	1:1	1'7"	10"	1'11"	2'0"	5'58"	2'58"	0.9	H	6'9"	18	40
D15-2	15"	2:1	2'2"	10"	1'11"	2'0"	6'08"	3'34"	1.0	H1	6'13"	22	60
D16-16	16"	1:1	1'7"	11"	2'0"	2'3"	5'68"	2'58"	1.0	H2	7'10"	18	40
D16-2	16"	2:1	2'2"	11"	2'0"	2'3"	6'108"	3'34"	1.3	H3	8'6"	22	60
D24-16	24"	1:1	2'11"	14"	2'9"	2'11"	7'48"	3'2"	1.5	H4	9'2"	22	60
D24-2	24"	2:1	2'10"	14"	2'9"	2'11"	8'108"	4'28"	2.0	H5	11'0"	26	70
D30-16	30"	1:1	2'6"	1'7"	3'3"	3'5"	8'68"	3'9"	2.0	H6	11'0"	28	70
D30-2	30"	2:1	3'4"	1'7"	3'3"	3'5"	10'48"	4'11"	2.6	H7	13'0"	34	80
D36-16	36"	1:1	3'0"	1'10"	3'10"	4'1"	10'48"	4'58"	2.6	H8	13'3"	30	80
D36-2	36"	2:1	4'0"	1'10"	3'10"	4'1"	12'48"	5'108"	3.5	H9	15'6"	40	100

* If embankment slope above headwall is flatter than 2:1, provide wings for 2:1 slope.

COT 5 10 59
EXAMINED
PASSED
APPROVED

REINFORCED CONCRETE HEADWALLS
FOR
15"-18"-24"-30"-36" DIAMETER
PIPE CULVERTS
AT RIGHT ANGLES WITH ROADWAY
STANDARD 1976

STANDARD DESIGN FOR CATCH BASIN TYPE C

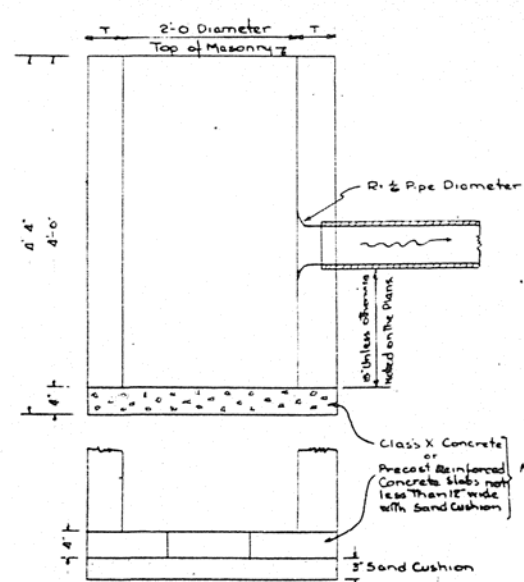

ALTERNATE MATERIALS FOR WALLS	T
Precast Reinforced Concrete Risers	3"
Concrete Masonry Units	5"
Monolithic Concrete	6"
Building Brick, Grade SW, from Clay or Shale	6"
Concrete Building Brick, Grade A	6"

Type C Catch Basin to be provided with:

- Type 1 Frame & Open Lid
- or Type 2 Frame
- or Type 3 Frame
- or Type 5 Frame & Open Lid
- or Type 6 Frame
- or Type 8 Grate
- or Type 9 Frame or Type 13 Frame
- or Type 10 Frame or Type 14 Frame
- or Type 11 Frame or Type 15 Frame
- or Type 12 Frame

Brick, Concrete Masonry Units and Precast R.C. Risers are to be laid in full mortar beds with flush joints.

The Contract Unit Price for "Catch Basins, Type C" shall include frame and lid or grate, as specified.

Passed July 23, 1952
REVISOR
Approved July 23, 1952

STANDARD NO. 1539R


STATE OF ILLINOIS
DEPARTMENT OF PUBLIC WORKS & BUILDINGS
DIVISION OF HIGHWAYS

ROUTE NO.	SECTION	COUNTY	TOTAL SHEETS	SHEET NO.
1	1	1	1	1


WINGS FOR 1 1/2:1 SLOPE

Skew Angle	Design No.	Ins. Dia. of Pipe	Dimensions for Concrete														Conc. 2-H.W. CULVERTS	Reinf. Bars - 2-H.W.				Bars 2-H.W. LBS.
			A	B	C	D	E	F	G	H	J	K	M	N	α	h - Bars						
																0		1	2	4		
5°	DS 15-1/2	15"	2-4	0-10	2-5	1-7	6-11 1/2	3-5 1/2	3-2	1-7	3-5 1/2	3-6	0-2 1/2	0-2 1/2	85°	1.4	3-6	1-9	3-9	9-0	28	70
	DS 18-1/2	18"	2-4	1-1	2-8	1-10	7-2 1/2	3-5 1/2	3-2	1-10	3-7 1/2	3-7 1/2	"	"	"	1.6	3-6	2-0	3-9	9-3	28	70
	DS 24-1/2	24"	2-10	1-4	3-3	2-6	8-10 1/2	4-2 1/2	3-10	2-6	4-5 1/2	4-5 1/2	"	"	"	2.2	4-3	2-6	4-7	11-6	32	80
	DS 30-1/2	30"	3-3	1-7	3-9	3-0	10-3	4-9 1/2	4-5	3-0	5-1 1/2	5-1 1/2	"	"	"	2.7	4-10	3-3	5-2	13-3	36	90
	DS 36-1/2	36"	3-9	1-10	4-4	3-6 1/2	11-11	5-6 1/2	5-1	3-8	5-1 1/2	5-1 1/2	0-2 1/2	0-2 1/2	85°	3.3	5-7	3-11	6-0	15-6	42	100
	DS 15-1/2	15"	2-4	0-10	2-5	1-7 1/2	7-0 1/2	3-7 1/2	3-0 1/2	1-7	3-6	3-6 1/2	0-2 1/2	0-2 1/2	80°	1.5	3-4	1-10	3-10	9-0	28	70
	DS 18-1/2	18"	2-4	1-1	2-8	1-10 1/2	7-3 1/2	3-7 1/2	3-0 1/2	1-10	3-7 1/2	3-8 1/2	"	"	"	1.6	3-4	2-1	3-10	9-3	28	70
	DS 24-1/2	24"	2-10	1-4	3-3	2-6 1/2	9-0	4-5	3-8 1/2	2-6	4-5 1/2	4-6 1/2	"	"	"	2.2	4-1	2-9	4-8	11-6	34	80
	DS 30-1/2	30"	3-3	1-7	3-9	3-0 1/2	10-4 1/2	5-0 1/2	4-3	3-0	5-1 1/2	5-2 1/2	"	"	"	2.8	4-9	3-3	5-6	13-6	36	90
	DS 36-1/2	36"	3-9	1-10	4-4	3-6 1/2	12-0 1/2	5-10	4-10 1/2	3-8	6-0	6-0 1/2	0-2 1/2	0-2 1/2	80°	3.5	5-6	3-11	6-4	15-9	42	110
10°	DS 15-1/2	15"	2-4	0-10	2-5	1-7 1/2	7-2	3-10	2-11 1/2	1-7	3-6 1/2	3-7 1/2	0-3	0-2	75°	1.5	3-4	1-10	4-1	9-3	28	70
	DS 18-1/2	18"	2-4	1-1	2-8	1-10 1/2	7-5 1/2	3-10	2-11 1/2	1-10	3-8	3-9 1/2	"	"	"	1.7	3-4	2-1	4-1	9-6	28	70
	DS 24-1/2	24"	2-10	1-4	3-3	2-7	9-2	4-7 1/2	3-6 1/2	2-6	4-6 1/2	4-7 1/2	"	"	"	2.3	4-0	2-10	4-11	11-9	34	80
	DS 30-1/2	30"	3-3	1-7	3-9	3-1 1/2	10-6 1/2	5-4	4-1 1/2	3-0	5-2 1/2	5-3 1/2	"	"	"	2.9	4-8	3-4	5-9	13-9	40	100
	DS 36-1/2	36"	3-9	1-10	4-4	3-9 1/2	12-3 1/2	6-2	4-8 1/2	3-8	6-1	6-2 1/2	0-3	0-2	75°	3.8	5-3	4-0	6-6	15-9	46	110
	DS 15-1/2	15"	2-4	0-10	2-5	1-8 1/2	7-4	4-0 1/2	3-10 1/2	1-7	3-7 1/2	3-8 1/2	0-3	0-2	70°	1.6	3-3	1-11	4-4	9-6	28	70
	DS 18-1/2	18"	2-4	1-1	2-8	1-11 1/2	7-7 1/2	4-0 1/2	3-10 1/2	1-10	3-9	3-10 1/2	"	"	"	1.7	3-3	2-2	4-4	9-9	28	70
	DS 24-1/2	24"	2-10	1-4	3-3	2-8	9-4 1/2	4-1 1/2	3-5 1/2	2-6	4-7 1/2	4-9	"	"	"	2.4	3-11	2-11	5-2	12-0	38	90
	DS 30-1/2	30"	3-3	1-7	3-9	3-2 1/2	10-9 1/2	5-8	3-11 1/2	3-0	5-4 1/2	5-5 1/2	"	"	"	3.1	4-5	3-5	5-11	13-9	42	100
	DS 36-1/2	36"	3-9	1-10	4-4	3-10 1/2	12-7	6-6 1/2	4-7	3-8	6-2 1/2	6-4 1/2	0-3	0-2	70°	4.0	5-3	4-1	6-11	16-3	50	120
15°	DS 15-1/2	15"	2-4	0-10	2-5	1-9	7-7	4-4	3-9 1/2	1-7	3-8 1/2	3-10 1/2	0-3 1/2	0-1 1/2	65°	1.6	3-3	1-11	4-7	9-9	28	70
	DS 18-1/2	18"	2-4	1-1	2-8	2-0 1/2	7-10 1/2	4-4	3-9 1/2	1-10	3-10 1/2	4-0	"	"	"	1.8	3-2	2-3	4-7	10-0	32	80
	DS 24-1/2	24"	2-10	1-4	3-3	2-9	9-8 1/2	5-3 1/2	3-4 1/2	2-6	4-9 1/2	4-11 1/2	"	"	"	2.5	3-10	2-11	5-6	12-3	38	90
	DS 30-1/2	30"	3-3	1-7	3-9	3-3 1/2	11-2	6-0 1/2	3-10 1/2	3-0	5-6	5-8	"	"	"	3.3	4-5	3-6	6-4	14-3	44	110
	DS 36-1/2	36"	3-9	1-10	4-4	4-0 1/2	13-0 1/2	6-11 1/2	4-5 1/2	3-8	6-5 1/2	6-7	0-3 1/2	0-1 1/2	65°	4.3	5-0	4-3	7-3	16-6	50	120
	DS 15-1/2	15"	2-4	0-10	2-5	1-10	7-10 1/2	4-8	3-8 1/2	1-7	3-10 1/2	4-0 1/2	0-3 1/2	0-1 1/2	60°	1.7	3-1	2-0	4-11	10-0	36	90
	DS 18-1/2	18"	2-4	1-1	2-8	2-1 1/2	8-2 1/2	4-8	3-8 1/2	1-10	4-0	4-2 1/2	"	"	"	1.9	3-2	2-4	5-0	10-6	36	90
	DS 24-1/2	24"	2-10	1-4	3-3	2-10 1/2	10-1 1/2	5-8	3-9 1/2	2-6	4-11 1/2	5-11	"	"	"	2.7	3-9	3-1	5-11	12-9	40	100
	DS 30-1/2	30"	3-3	1-7	3-9	3-5 1/2	11-7 1/2	6-6	3-9	3-0	5-8 1/2	5-11	"	"	"	3.5	4-4	3-8	6-9	14-9	46	110
	DS 36-1/2	36"	3-9	1-10	4-4	4-2 1/2	13-7	7-6	4-4	3-8	6-8 1/2	6-10 1/2	0-3 1/2	0-1 1/2	60°	4.6	5-0	4-5	7-10	17-3	54	130
20°	DS 15-1/2	15"	2-4	0-10	2-5	1-11 1/2	8-3 1/2	5-0 1/2	3-7 1/2	1-7	4-0 1/2	4-3	0-3 1/2	0-1 1/2	55°	1.8	3-1	2-2	5-3	10-6	36	90
	DS 18-1/2	18"	2-4	1-1	2-8	2-3	8-7 1/2	5-0 1/2	3-7 1/2	1-10	4-2 1/2	4-5	"	"	"	2.0	3-1	2-5	5-3	10-9	36	90
	DS 24-1/2	24"	2-10	1-4	3-3	3-0 1/2	10-7 1/2	6-1 1/2	3-2 1/2	2-6	5-2 1/2	5-5 1/2	"	"	"	2.9	3-8	3-3	6-4	13-3	40	100
	DS 30-1/2	30"	3-3	1-7	3-9	3-8	12-3 1/2	7-0 1/2	3-8	3-0	6-0 1/2	6-3	"	"	"	3.7	4-2	3-11	7-2	15-3	50	120
	DS 36-1/2	36"	3-9	1-10	4-4	4-3 1/2	14-3 1/2	8-1 1/2	4-2 1/2	3-8	7-0 1/2	7-3 1/2	0-3 1/2	0-1 1/2	55°	4.9	4-11	4-8	8-5	18-0	56	140
	DS 15-1/2	15"	2-4	0-10	2-5	2-0 1/2	8-10	5-6 1/2	3-7	1-7	4-3 1/2	4-6 1/2	0-3 1/2	0-1 1/2	50°	1.9	3-1	2-3	5-3	11-0	38	90
	DS 18-1/2	18"	2-4	1-1	2-8	2-4 1/2	9-1 1/2	5-6 1/2	3-7	1-10	4-5 1/2	4-8 1/2	"	"	"	2.2	3-0	2-7	5-8	11-3	38	90
	DS 24-1/2	24"	2-10	1-4	3-3	3-3 1/2	11-4	6-8 1/2	3-7 1/2	2-6	5-6 1/2	5-9 1/2	"	"	"	3.1	3-8	3-6	6-10	14-0	48	110
	DS 30-1/2	30"	3-3	1-7	3-9	3-11	13-0 1/2	7-8 1/2	3-7	3-0	6-5	6-7 1/2	"	"	"	4.0	4-2	4-2	7-11	16-3	54	130
	DS 36-1/2	36"	3-9	1-10	4-4	4-9 1/2	15-3	8-10 1/2	4-1 1/2	3-8	7-6	7-9	0-3 1/2	0-1 1/2	50°	5.3	4-10	5-0	9-2	19-0	62	150
25°	DS 15-1/2	15"	2-4	0-10	2-5	2-3	9-6	6-1 1/2	3-6 1/2	1-7	4-7 1/2	4-10 1/2	0-4	0-1 1/2	45°	2.1	3-0	2-5	6-1	11-6	40	100
	DS 18-1/2	18"	2-4	1-1	2-8	2-7	9-10 1/2	6-1 1/2	3-6 1/2	1-10	4-9 1/2	5-0 1/2	"	"	"	2.4	3-0	2-10	6-2	12-0	44	100
	DS 24-1/2	24"	2-10	1-4	3-3	3-6 1/2	12-2 1/2	7-4 1/2	3-10 1/2	2-6	5-11 1/2	6-3	"	"	"	3.4	3-8	3-9	7-7	15-0	50	120
	DS 30-1/2	30"	3-3	1-7	3-9	4-3	14-1	8-6	3-6 1/2	3-0	6-11	7-2	"	"	"	4.4	4-2	4-5	8-8	17-3	62	150
	DS 36-1/2	36"	3-9	1-10	4-4	5-2 1/2	16-5 1/2	9-9 1/2	4-0 1/2	3-8	8-1	8-4 1/2	0-4	0-1 1/2	45°	5.7	4-10	5-5	10-0	20-3	66	160
	DS 15-1/2	15"	2-4	0-10	2-5	2-5 1/2	10-4 1/2	8-10	4-0 1/2	1-7	5-0 1/2	5-4	0-4 1/2	0-1	40°	2.3	2-11	2-8	6-11	12-6	46	110
	DS 18-1/2	18"	2-4	1-1	2-8	2-10 1/2	10-9	8-10	4-0 1/2	1-10	5-2 1/2	5-6 1/2	"	"	"	2.6	3-0	3-1	6-11	13-0	46	110
	DS 24-1/2	24"	2-10	1-4	3-3	3-10 1/2	13-4 1/2	8-3 1/2	3-0 1/2	2-6	6-6 1/2	6-10	"	"	"	3.7	3-7	4-1	8-4	16-0	56	130
	DS 30-1/2	30"	3-3	1-7	3-9	4-8	15-5	9-6	3-5 1/2	3-0	7-6 1/2	7-10 1/2	"	"	"	4.8	4-1	4-10	9-7	18-6	66	160
	DS 36-1/2	36"	3-9	1-10	4-4	5-8 1/2	18-0 1/2	10-11 1/2	4-0	3-8	8-10 1/2	9-2	0-4 1/2	0-1	40°	6.3	4-9	5-11	11-1	21-9	74	180
30°	DS 15-1/2	15"	2-4	0-10	2-5	2-9	11-6 1/2	9-9	2-5 1/2	1-7	5-7 1/2	5-11	0-4 1/2	0-1	35°	2.6	2-11	3-0	7-10	13-9	50	120
	DS 18-1/2	18"	2-4	1-1	2-8	3-2 1/2	11-11 1/2	9-9	2-5 1/2	1-10	5-9 1/2	6-1 1/2	"	"	"	2.9	3-0	3-5	7-10	14-3	50	120
	DS 24-1/2	24"	2-10	1-4	3-3	4-4 1/2	14-10 1/2	9-5	2-11 1/2	2-6	7-3 1/2	7-7 1/2	"	"	"	4.2	3-6	4-7	9-5	17-6	62	150
	DS 30-1/2	30"	3-3	1-7	3-9	5-2 1/2	17-2 1/2	10-9 1/2	3-5	3-0	8-5 1/2	8-9	"	"	"	5.4	4-1	5-6	10-11	20-6	74	180
	DS 36-1/2	36"	3-9	1-10	4-4	6-4 1/2	20-12 1/2	12-5 1/2	3-11 1/2	3-8	9-10 1/2	10-2 1/2	0-4 1/2	0-1	35°	7.1	4-9	6-7	12-8	24-0	86	200
	DS 15-1/2	15"	2-4	0-10	2-5	3-2	13-14	9-0 1/2	2-6	1-7	6-4 1/2	6-8 1/2	0-4 1/2	0-0 1/2	30°	2.9	2-10	3-5	9-0	15-3	54	130
	DS 18-1/2	18"	2-4	1-1	2-8	3-8	13-7 1/2	9-0 1/2	2-5	1-10	6-7 1/2	6-11 1/2	"	"	"	3.2	3-10	3-11	9-0	15-9	58	140

TYPE A

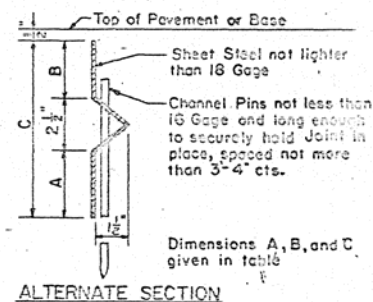

TYPE C

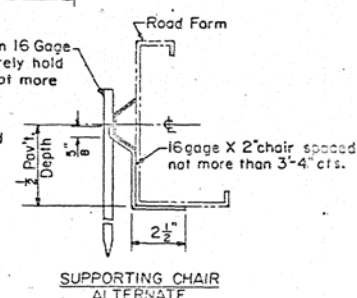

STANDARD 1766-2

TYPE I

Depressed Curb
slope 1" in 5"

DEPRESSED CURB

TYPE 3

[illegible]

TYPE 4

[illegible]

TYPE 5

Technical drawing of a depressed curb cross-section. The top part shows a plan view with dimensions: 15", 12", 3", and 4". A slope of 1" per foot is indicated. A #4 tie bar, 2'-6" long at 2'-6" centers, is shown. Dowel bars at contraction joints are also indicated. The bottom part shows a side view of the curb with a vertical dimension "Var." and a slope of 1" in 5".

TYPE 6

When necessary the curb shall be warped in a distance of 10 ft. to line up with the cross section of curb on bridges.

15' 24' 1/2' 6 1/2' 1/2' 6' 10' 6' 2'-7"

Slope 1/2% per ft except at Inlets

#4 tie bars 2'-6" long @ 2'-6" c/s.

Dowel bars at Contraction Joints

CURB AND

TYPE

15" 7 5/8" 2" 1/4" 6" 12" #4 tie bars 2'-6" long at 2'-6" ctrs. Dowel bars at Contraction Joints. COMBINATION CONCRETE CURB AND GUTTER

4" 3" 6" 2" 1/4" 6" 13" #4 tie bars 2'-6" long at 2'-6" ctrs. Dowel bars at Contraction Joints. COMBINATION CONCRETE CURB AND GUTTER

TYPICAL SECTION SHOWING CONSTRUCTION OF COMBINATION CONCRETE CURB AND GUTTER ADJACENT TO P.C.CONCRETE BASE COURSE AND BITUMINOUS SURFACING

Bituminous Surfacing

R.C. Concrete Base Course

15"

4"

COMBINATION CONCRETE CURB AND GUTTER TYPES 1, 3, 5, 7, & 10

#4 tie bars 2'-6" long of 2'-6" c/s.

9" with 8" R.C. Concrete Base Course

10" with 9" R.C. Concrete Base Course

Dimension "X" is equal to the adjacent pavement edge thickness.

DEPRESSED CURBS—The top of curbs shall be depressed where the Curb and Gutter is constructed across street intersections and for private drives opposite each lot, tract or parcel of land fronting on the improvement upon request of the owner or owners thereof or where directed by the Engineer.

CONTRACTION JOINTS—Contraction Joints of a type similar to that used in the adjacent pavement shall be installed in the Curb and Curb and Gutter in prolongation with the joints in the pavement. The details of the transverse joints in the Curb and Curb and Gutter shall be approved by the Engineer. If Contraction Joints are not provided in the pavement, Contraction Joints are not required in the Curb or Curb and Gutter. The cost of Contraction Joints including dowel bars shall be included in the contract unit price per lineal foot for the particular type of Curb and Curb and Gutter specified.

The cost of furnishing and installing tie bars shall be included in the contract unit price per lineal foot for the particular type of Curb and Curb and Gutter specified.

Where Curb and Curb and Gutter are not adjacent to P.C. Concrete Pavement or P.C. Concrete Base Course, tie bars, Contraction Joints and dowel bars shall be omitted.








STATE OF ILLINOIS
DEPARTMENT OF PUBLIC WORKS AND BUILDINGS
DIVISION OF HIGHWAYS

PASSED January 10, 1955
J. C. O'NEILL
ENGINEER OF ROAD PLANS AND CONTRACTS





Specification Reference: Section 81

STANDARD 1790 F

DETAILS OF BRIDGE APPROACHES P.C.C. BASE COURSE (16'-10'-16')

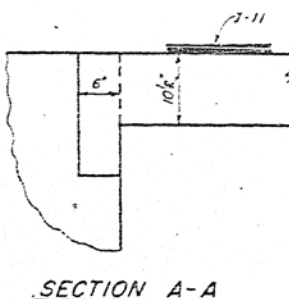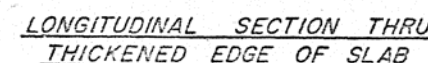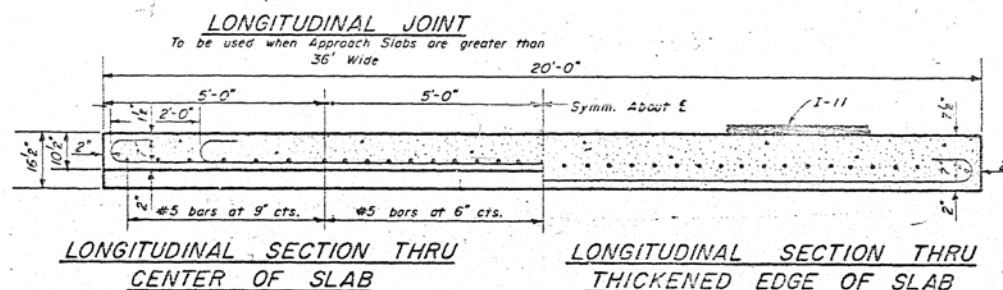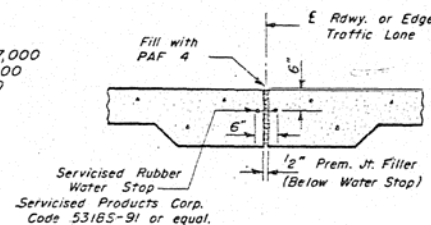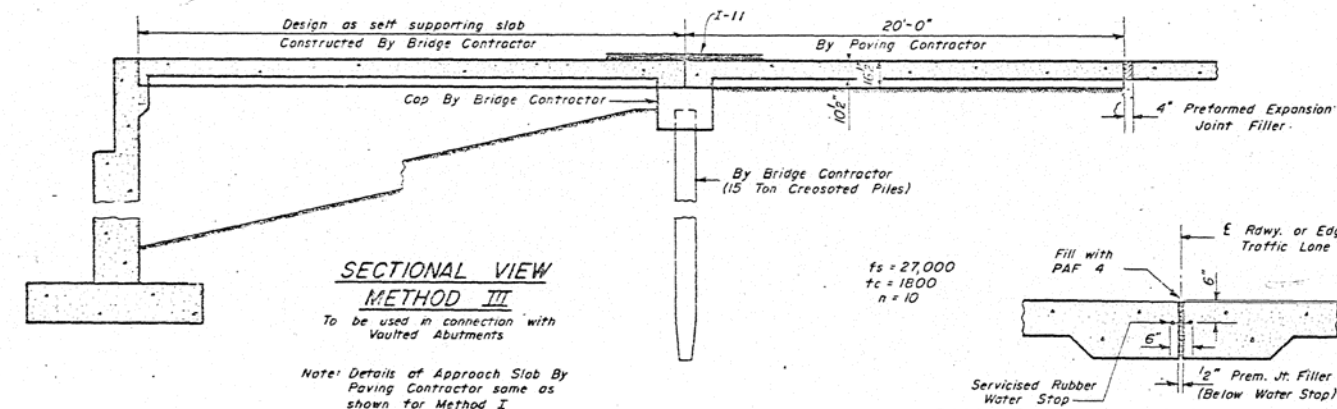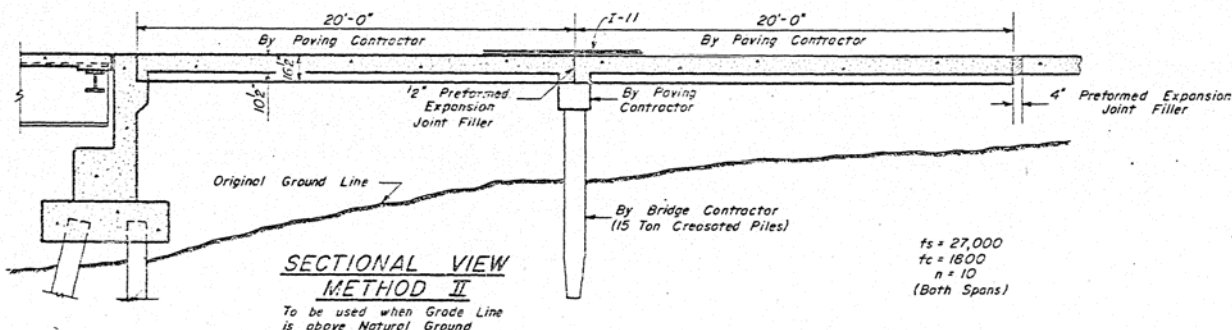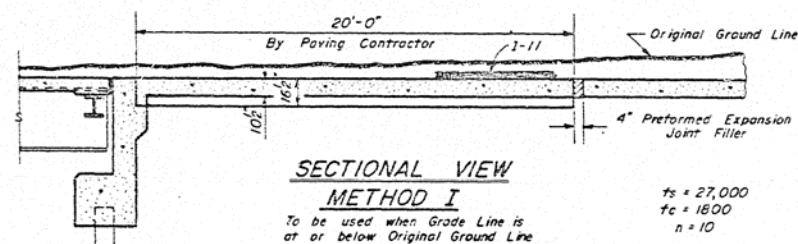

Variable for crown or superelevation. Similar construction at Abutment ends.

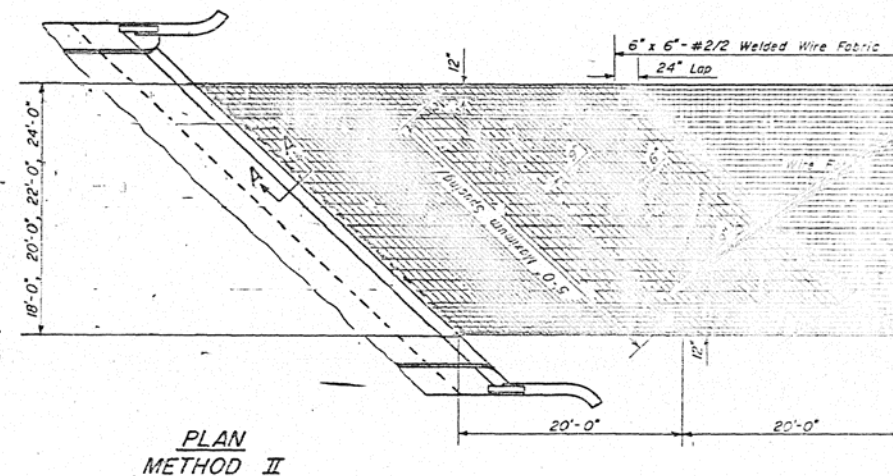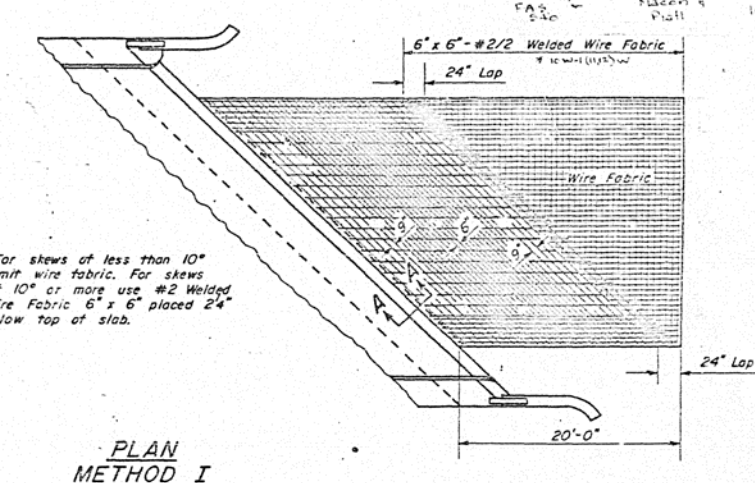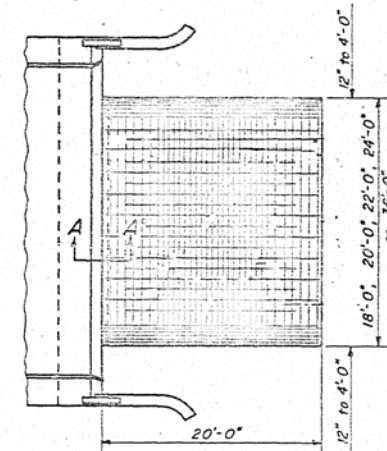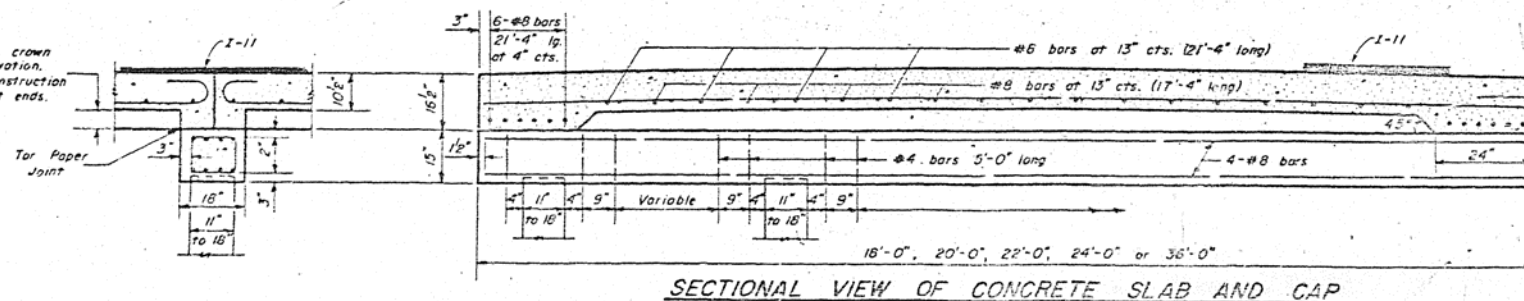

GENERAL NOTES



The slab or slabs shall be paid for at the contract unit price for P.C. CONC. BASE COURSE (16'-10'-16').
The concrete cap shall be paid for at the contract unit price for CLASS X CONCRETE.
All Reinforcement Bars shall be paid for at the contract unit price for REINFORCEMENT BARS.
The Welded Wire Fabric, Mud Jack Cylinders and Preformed Expansion Joint Filler shall be included in the contract unit price for P.C. CONC. BASE COURSE (16'-10'-16').
Preformed Expansion Joint Filler shall conform to Section 128 of the Standard Specifications.
No Mud Jack Cylinders are required.

Note: When road plans show curb and gutter adjacent to approach slabs place #4 Tie bar 2'-6" long at 2'-6" cts. Cost of tie bars included in contract unit price for Curb & Gutter.
The transition for gutter shall be made in 100 feet and will be paid for as CONCRETE GUTTER, of the type specified.

The transition for curb and gutter shall be made in 20 feet and will be paid for as COMBINATION CURB and GUTTER, of the type specified.

REVISIONS	BY	DATE
1	WAS	2-2-59
2	WAS	2-2-59
3	WAS	2-2-59
4	WAS	2-2-59
5	WAS	2-2-59
6	WAS	2-2-59
7	WAS	2-2-59
8	WAS	2-2-59
9	WAS	2-2-59
10	WAS	2-2-59

STANDARD DESIGN FOR FLAGMAN TRAFFIC CONTROL SIGN

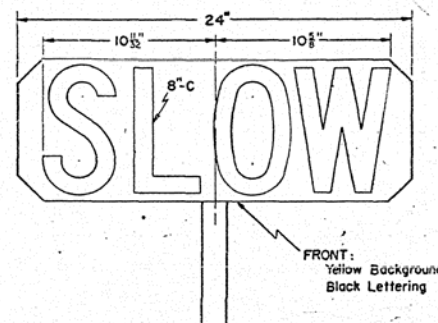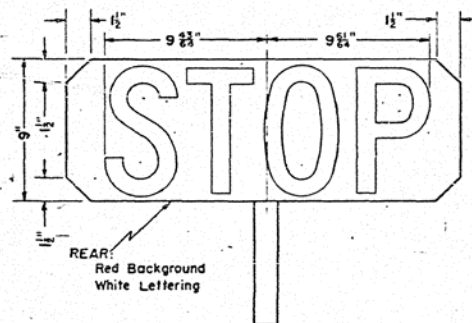

—NOTE—
The paddle type sign used by the flagmen to direct traffic shall be constructed with "STOP" on one side and "SLOW" on the reverse side.
Signs may be constructed with a short handle or a long staff which rests on the ground.

The material for the sign shall be 1/4" Exterior-Grade A-A Plywood or Exterior D.F.P.A.-2 sides sound.




These signs shall be furnished by the Contractor and shall be used by the flagmen in lieu of red flags or other signaling devices.

The cost of furnishing and maintaining the signs will be considered incidental to the contract and no additional compensation will be allowed.

STATE OF ILLINOIS DEPARTMENT OF PUBLIC WORKS AND BUILDINGS DIVISION OF HIGHWAYS	REVISIONS BY DATE
PASSED <u>April 10</u> 1954	
APPROVED <u>April 12</u> 1954	
ENGINEER OF ROAD PLANS AND CONTRACTS	
ENGINEER OF DESIGN	

STANDARD 2114

STANDARD DESIGN FOR DRAINAGE MARKERS

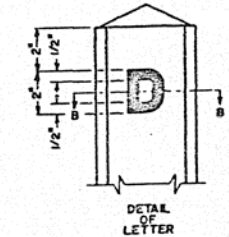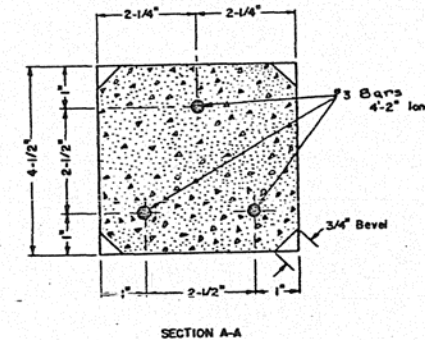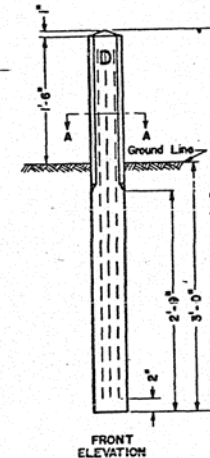

NOTE: Drainage Markers shall be constructed of Class X Concrete. All materials shall conform to Division III of the Standard Specifications.

Markers shall be placed on the right of way line at the locations shown on the plans or where directed by the Engineer. They shall be erected in accordance with Sec. 105.3 of the Standard Specifications.

This work will be paid for at the contract unit prices each for ERECTING DRAINAGE MARKERS or FURNISHING AND ERECTING DRAINAGE MARKERS, which price shall include the cost of furnishing and placing the reinforcement bars.


STATE OF ILLINOIS DEPARTMENT OF PUBLIC WORKS AND BUILDINGS DIVISION OF HIGHWAYS	REVISIONS BY DATE
PASSED <u>September 15</u> 1954	
APPROVED <u>September 15</u> 1954	
ENGINEER OF ROAD PLANS AND CONTRACTS	
ENGINEER OF DESIGN	

STANDARD 1999-1

STANDARD DESIGN FOR SIGN FOR HIGHWAY IMPROVEMENT

GENERAL NOTES

Signs shall be made of wood (1" lumber rigidly cleated, plywood (5/8" thick), or of metal, (18 gage or equivalent).
The Contractor shall furnish all material and labor for constructing and erecting the signs. The signs shall be placed prior to the starting of actual construction operations. Before any sign is erected it shall be approved by the Engineer as to appearance and quality of construction. The signs shall remain in place and shall be maintained in a satisfactory condition until the project is accepted by the Department. The Contractor shall then remove the signs and the material will become his.
The border shall be black and the letters printed black on a white background. The letters, width of stroke, width of letters and shape shall be Series C of the "Standard Alphabets for Highway Signs, Public Roads Administration, Federal Works Agency, 1945."
The number of signs and their location will be shown on the plans. The cost of the signs, the erection and later removal of the signs shall be incidental to the cost of the construction.

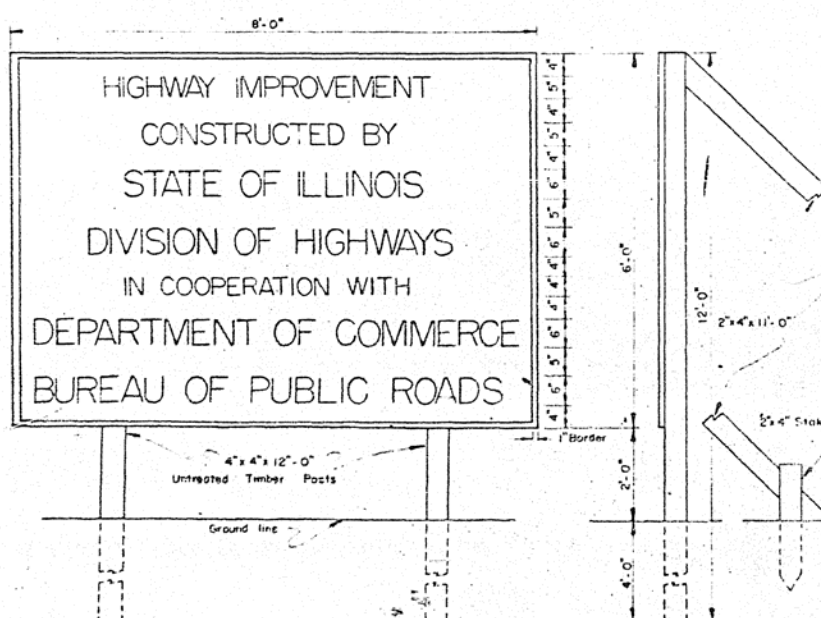


STATE OF ILLINOIS DEPARTMENT OF PUBLIC WORKS AND BUILDINGS DIVISION OF HIGHWAYS	REVISIONS BY DATE
PASSED <u>August 8</u> 1953	
APPROVED <u>August 8</u> 1953	
ENGINEER OF ROAD PLANS AND CONTRACTS	
ENGINEER OF DESIGN	

STANDARD 2136

STANDARD DESIGN FOR ROAD UNDER CONSTRUCTION SIGN

GENERAL NOTES

The border and letters shall be printed black on a white background.
The letters shall have a stroke 3/4" wide and a width in proportion to the dimensions shown.
The Contractor shall furnish all materials and labor for constructing and erecting this sign at each end of the construction section, or as directed by the Engineer. The signs shall be placed prior to the actual starting of construction operations.
Furnishing and erecting these signs will be considered incidental to the contract and no additional compensation will be allowed.

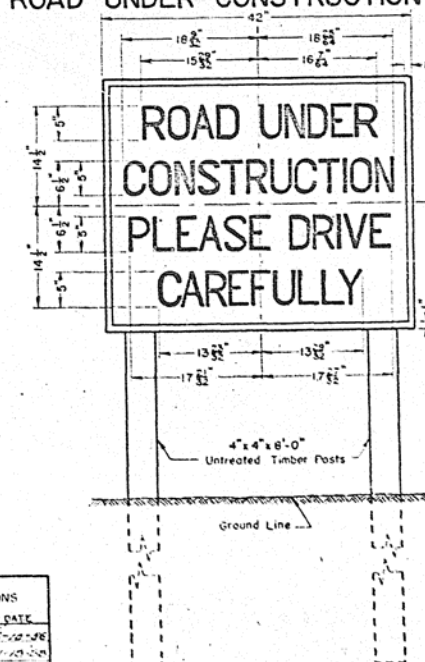

Sign may be made of wood, rigidly cleated or of metal.

STATE OF ILLINOIS DEPARTMENT OF PUBLIC WORKS AND BUILDINGS DIVISION OF HIGHWAYS	REVISIONS BY DATE
PASSED <u>Nov. 28</u> 1951	
APPROVED <u>Nov. 28</u> 1951	
ENGINEER OF ROAD PLANS AND CONTRACTS	
ENGINEER OF DESIGN	

STANDARD 1971-2

