


F.A.P. RTE.	SECTION	COUNTY	TOTAL SHEETS	SHEET NO.
64	130R-2	DU PAGE	10	208
STA. 12+4850		TO STA. 12+150		
FED. ROAD DIST. NO.		ILLINOIS FED. AID PROJECT		

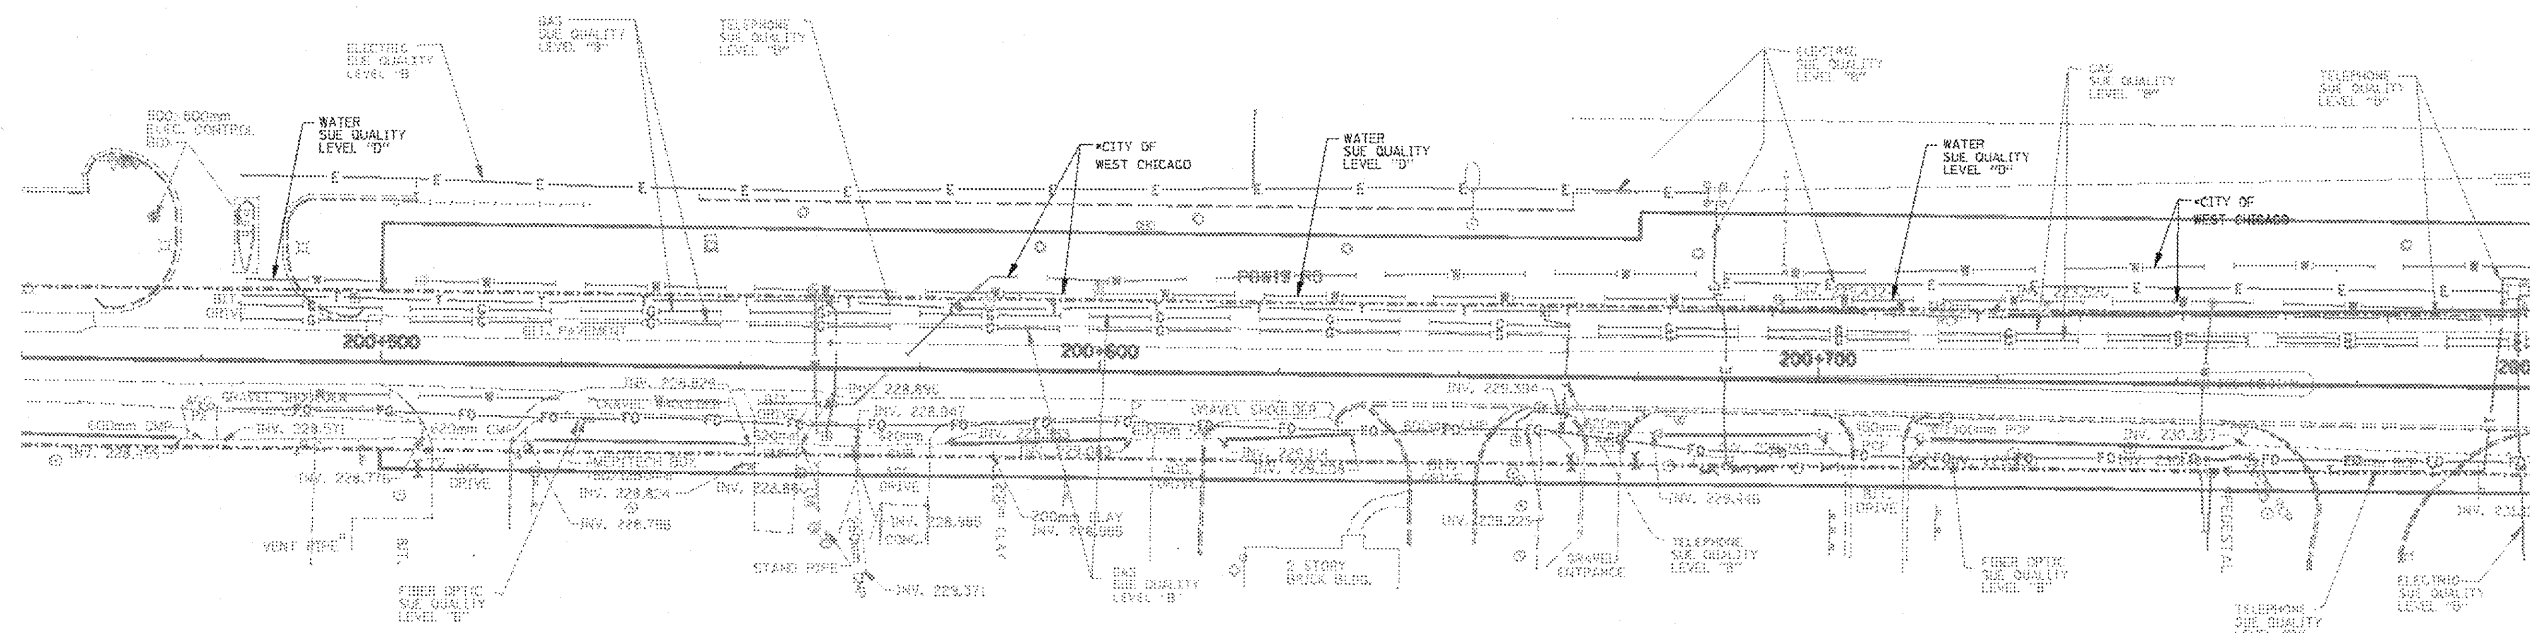

-----A-----A-----	OVERHEAD
-----T-----T-----	TELEPHONE
-----W-----W-----	WATER
-----G-----G-----	GAS
-----CTV-----CTV-----CTV	CABLE TELEVISION
-----FO-----FO-----FO	FIBER OPTIC
-----E-----E-----	ELECTRIC

CARONO TBE AND IDOT REQUESTED UTILITY AS-BUILTS FROM THE CITY OF WEST CHICAGO BUT HAVE NOT RECEIVED THEM AS OF 11/05/10.

TBE GROUP, INC.
 CIVIL ENGINEERING * TRANSPORTATION * ENVIRONMENTAL
 * PLANNING * UTILITY ENGINEERING/LOCATING
 SOUTHERN REGION: FL, GA, SC, NC
 NORTHERN REGION: IL, IN, MI, OH, MD, NJ, NY
 PA, VA, CANADA
 WESTERN REGION: AZ, NV, NM, TX, CA, OR, UT, WA



205 W. WACKER DRIVE
 SUITE 1020
 CHICAGO, IL 60606
 (312) 704-1970

WO : IL09500128 & IL09500135 & IL09510410
 SUE Quality Level "A" : Test Holes
 SUE Quality Level "B" : Designating

Utilities shown on these plans as depicted in the legend have been investigated by TBE Group, Inc. in accordance with SUE Industry Standards. All other information shown has been provided to TBE Group, Inc. by others. Additional utilities labeled with utility owner investigated by TBE 8/18/10 - 11/05/10 depicted by *.

REVISIONS		ILLINOIS DEPARTMENT OF TRANSPORTATION
NAME	DATE	
NEW UTILITIES IN COLOR	0/05/10	IL RTE 64 (NORTH AVE.) WEST OF IL RT 69 TO KAUTZ RD.
SCALE : 1"=50'		DRAWN BY - JAC
DATE - 08/18/10		CHECKED BY - RLC