


F.A. RTE.	SECTION	COUNTY	TOTAL SHEETS	SHEET NO.
90/94	2021-922PT.1-AC	COOK	460	458
STA.	TO STA.			
FED. ROAD DIST. NO.	ILLINOIS	FED. AID PROJECT		

62693

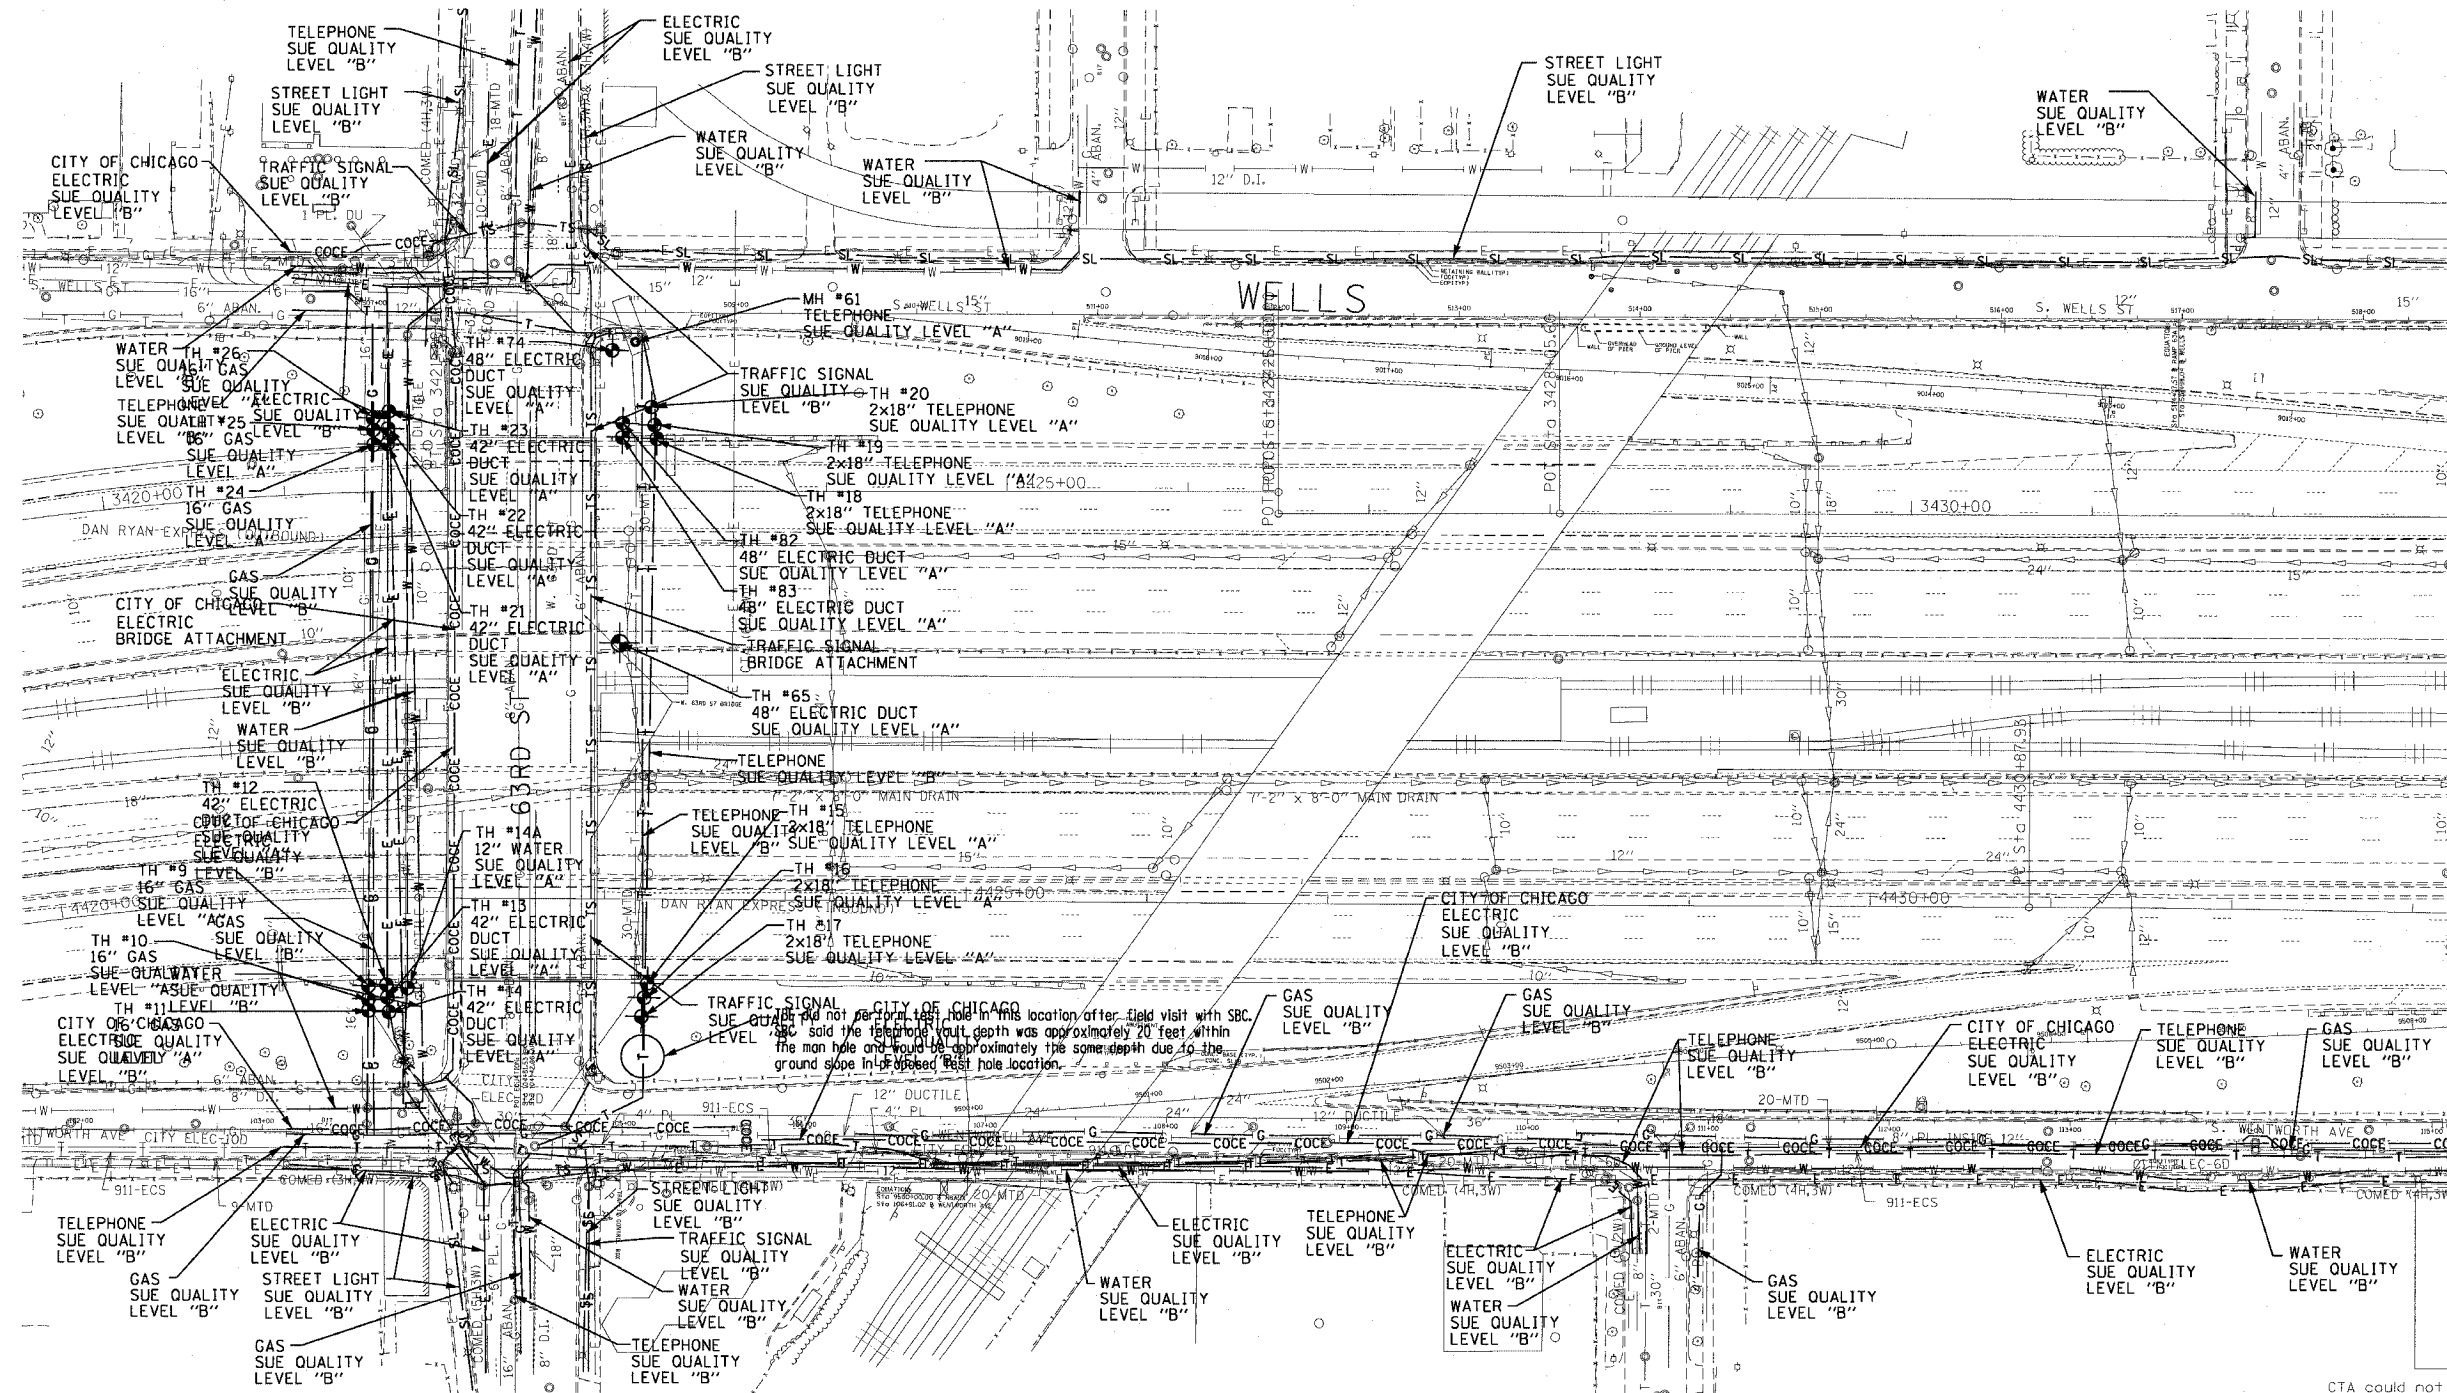

MATCH TO PAGE 22

MATCH TO PAGE 22




**TBE GROUP, INC.**  
 CIVIL ENGINEERING • TRANSPORTATION • ENVIRONMENTAL  
 PLANNING • UTILITY ENGINEERING/LOCATING  
 SOUTHERN REGION: FL, GA, SC, NC  
 NORTHERN REGION: IL, IN, MI, OH, MD, NJ, NY  
 PA, VA, CANADA  
 WESTERN REGION: AZ, NV, NM, TX, CA, OR, UT, WA

IL09500167, 168, 170, 171, 179, 180, 204, 205,  
 206, 211, 212, 219, 221, 225  
 TBE SUE PAGE NO: 21 of 30

Checked by: \_\_\_\_\_  
 SUE Quality Level "A" : Test Holes  
 SUE Quality Level "B" : Designating

— SL —	— SL —	STREET LIGHT
— TS —	— TS —	TRAFFIC SIGNAL
— T —	— T —	TELEPHONE
— W —	— W —	WATER
— G —	— G —	GAS
— FO —	— FO —	FIBER OPTIC CABLE
— COCE —	— COCE —	CITY OF CHICAGO ELECTRIC
— E —	— E —	ELECTRIC
		TEST HOLE

Utilities shown on these plans as depicted in the legend have been investigated by TBE Group, Inc in accordance with SUE Industry Standards. All other information shown has been provided to TBE Group, Inc by others.

  
 205 W. WACKER DRIVE  
 SUITE 1020  
 CHICAGO, IL 60606  
 (312) 704-1970

REVISIONS	
NAME	DATE

ILLINOIS DEPARTMENT OF TRANSPORTATION  
 SUE Investigation of Underground Utilities  
 1-94 NB & SB of Dan Ryan Expressway  
 From I-57 to 43rd Street  
 Contract No: 62586, 62589, 62590, 62594, 62693  
 SOL "A" DATE : 11/08/2004 DRAWN BY : KLC  
 SOL "B" DATE : 8/20/2003 SCALE 1" = 50'

CTA could not send as-built plans for review. TBE met with Leo Bazelewski, Testing Engineer for CTA regarding their facilities. Size given for Electric Duct is width only.