


WIRING DIAGRAM

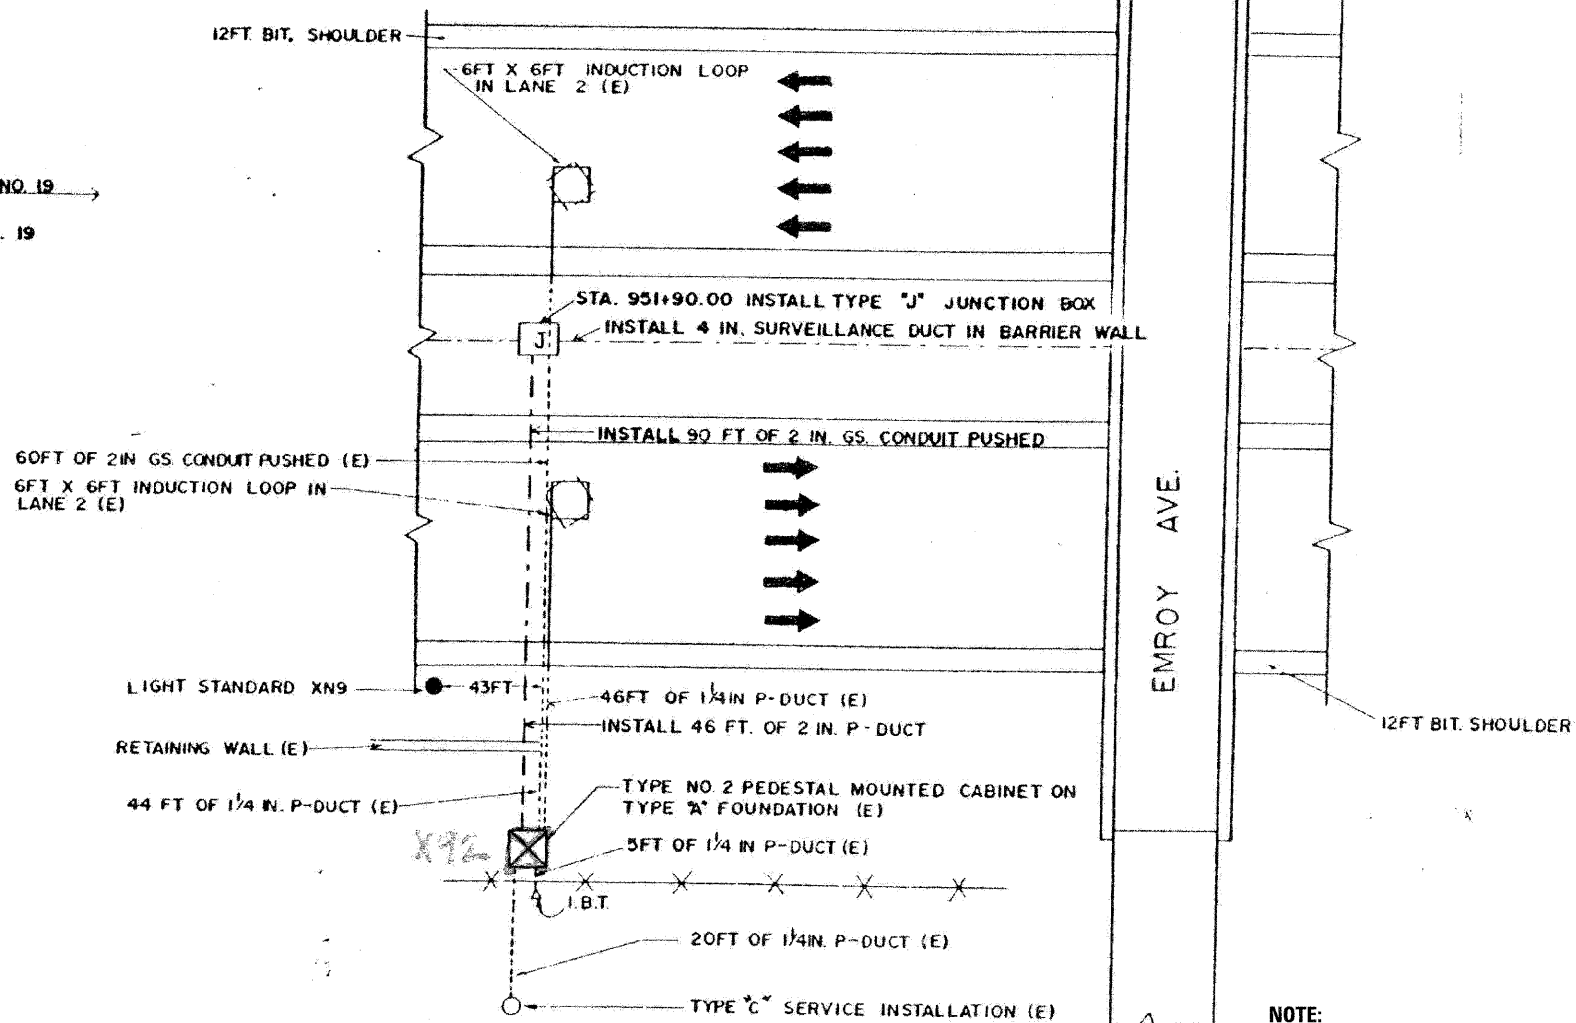

PLAN

NOTE:

IDOT RECORD PLANS PROVIDED FOR INFORMATIONAL PURPOSES ONLY. THE CONTRACTOR IS RESPONSIBLE FOR VERIFYING THE LOCATION AND EXTENT OF WORK ASSOCIATED WITH REPLACEMENT OF INDUCTION LOOPS, LEAD-IN CABLE AND RELATED WORK. LOOP AND LEAD-IN CABLE QUANTITIES BASED ON INTERCHANGE RAMP RESURFACING. EXISTING MAINLINE SURVEILLANCE LOOPS TO REMAIN UNLESS IMPACTED BY PATCHING OPERATIONS.

SUMMARY OF QUANTITIES (THIS SHEET)		
DESCRIPTION	UNIT	QUANTITY
ELECTRIC CABLE IN CONDUIT, LEAD-IN, NO. 18 4/C, TWISTED, SHIELDED	LF	0
INDUCTION LOOP	LF	0

FILE NAME =	DESIGNED - GHT	REVISED -
...:\Signals\ppr\in_abc_C4_ts_29.dgn	DRAWN - TMB	REVISED -
USER NAME = jmejevskz	CHECKED - MPM	REVISED -
PLOT DATE = 1/13/2009	DATE - 10/16/09	REVISED -

benesch

**STATE OF ILLINOIS
DEPARTMENT OF TRANSPORTATION**

**TRAFFIC SURVEILLANCE LOOP
EMROY AVE INSTALLATION**

SCALE: N.T.S. SHEET NO. 7 OF 10 SHEETS STA. TO STA.

F.A.I. RTE.	SECTION	COUNTY	TOTAL SHEETS	SHEET NO.
290	2009-0998R	COOK/DUPAGE	309	276
FED. ROAD DIST. NO. [ILLINOIS] FED. AID PROJECT			CONTRACT NO. 60157	