


FIG. NO.	SECTION	COUNT	DATE	BY
F.A.I. 290	S-26268-30	BOOK	41	M-2
FIG. NO. BY	ALL WORK	PROJECT	S-26268-30	

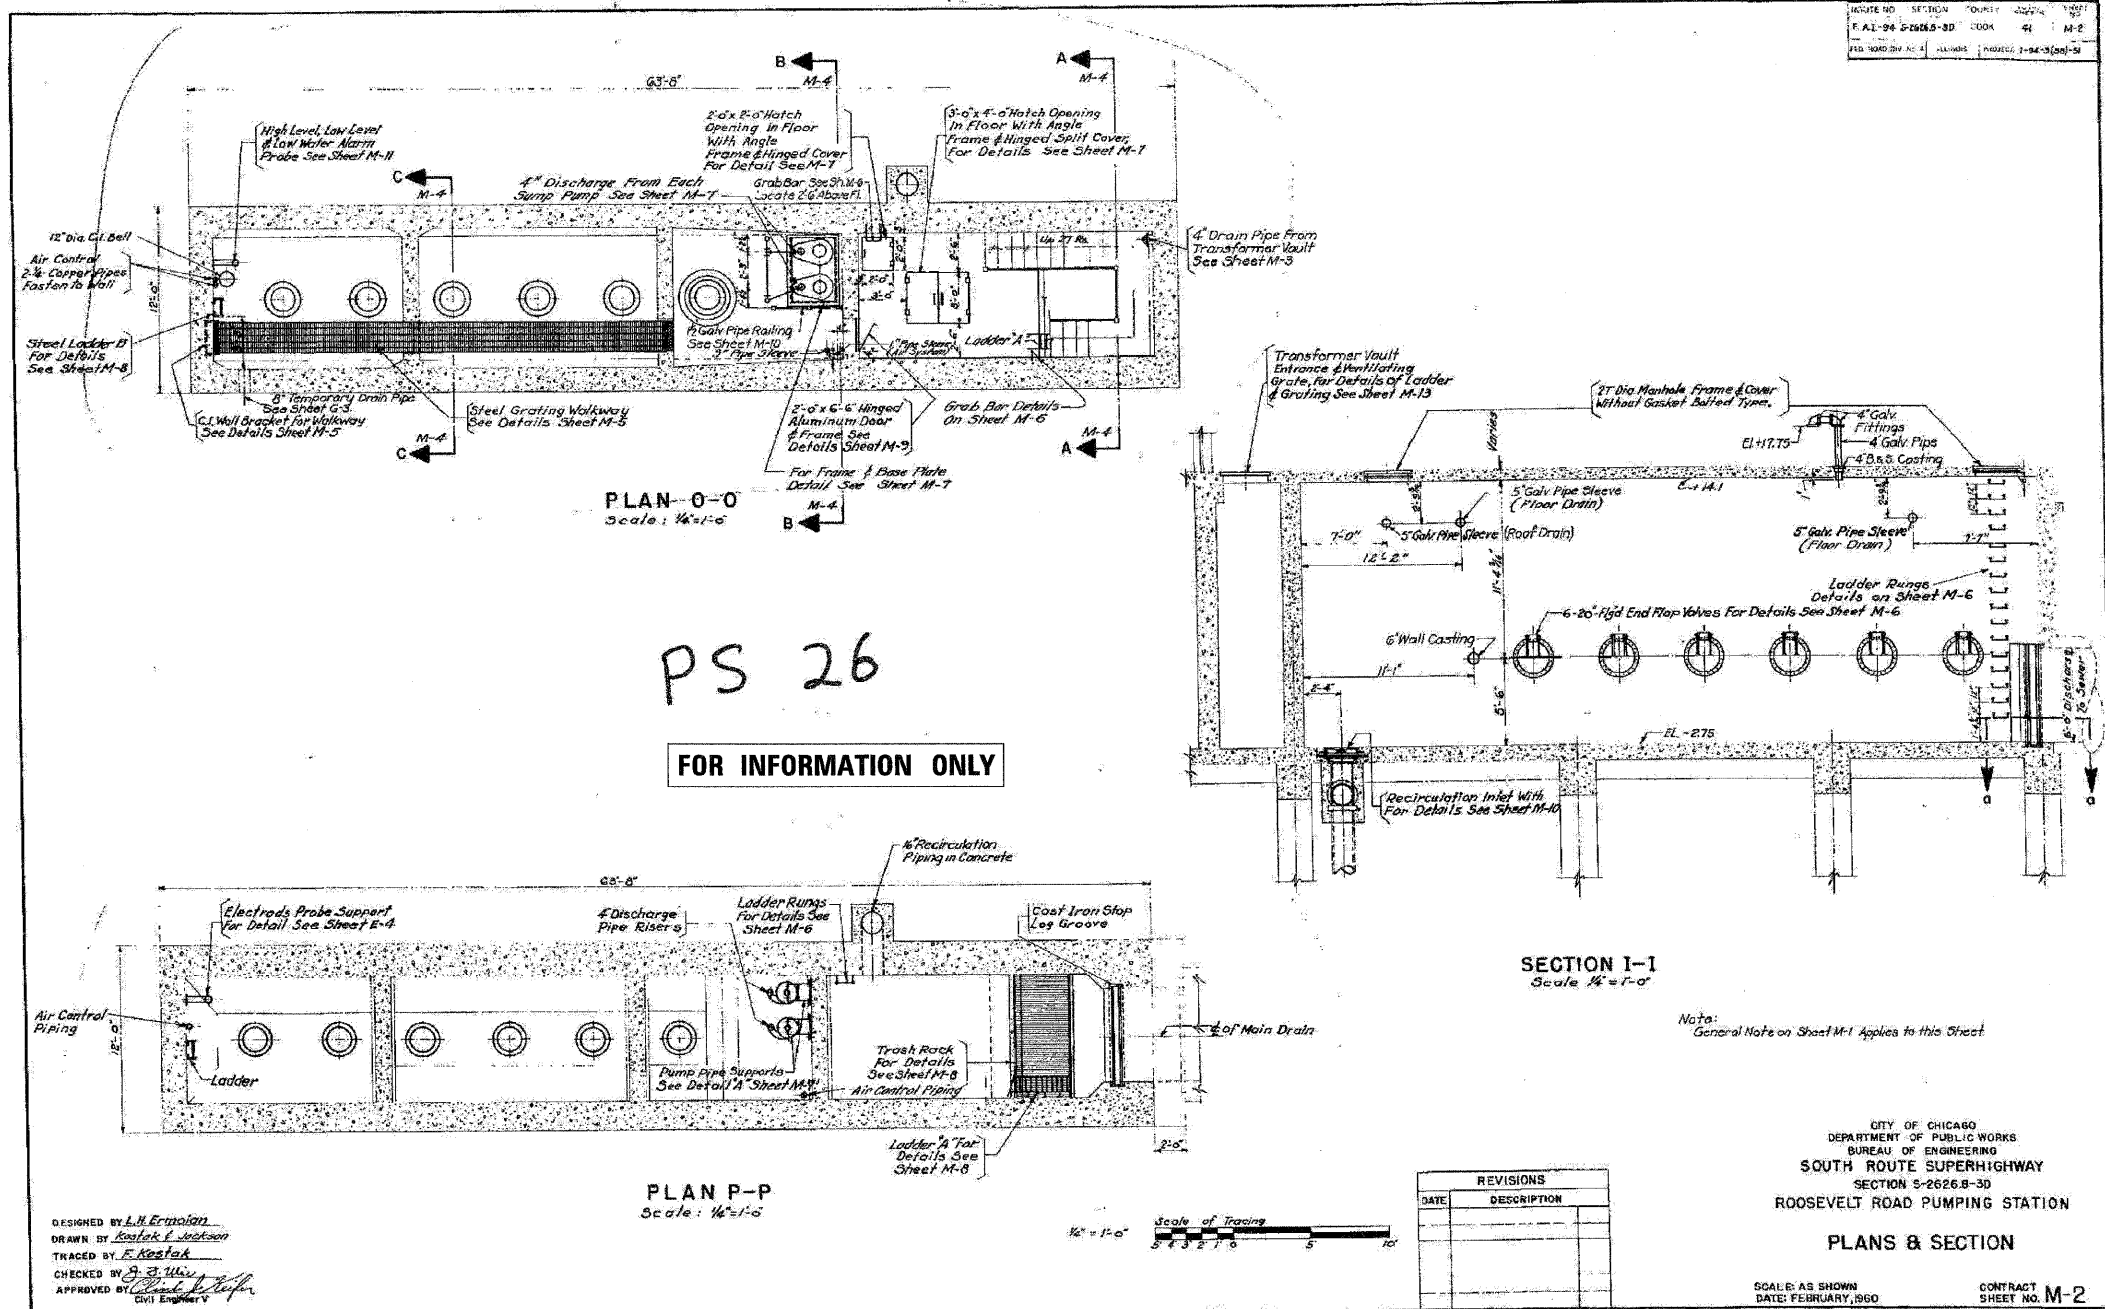

FILE NAME =	DESIGNED - SGL	REVISED -	<b>LIN ENGINEERING LTD.</b> Consulting Engineers <small>Chicago, Illinois    Westmont, Illinois</small>	<b>STATE OF ILLINOIS</b> <b>DEPARTMENT OF TRANSPORTATION</b>	<b>PUMP STATION NO. 26</b>	F.A.I. RTE.	SECTION	COUNTY	TOTAL SHEETS	SHEET NO.		
#FILE#	DRAWN - SGL	REVISED -			RECORD DRAWINGS	290	(2525, ETC., 2727)	RS-8	COOK	201	158	
USER NAME = #USER#	CHECKED - FML	REVISED -			SCALE:	SHEET NO. 4 OF 4 SHEETS	STA.	TO STA.	CONTRACT NO. 60K11			
PLOT DATE = #DATE#	DATE - 1/25/10	REVISED -			ILLINOIS FED. AID PROJECT							