
AS-BUILT PLANS FOR INFORMATION ONLY

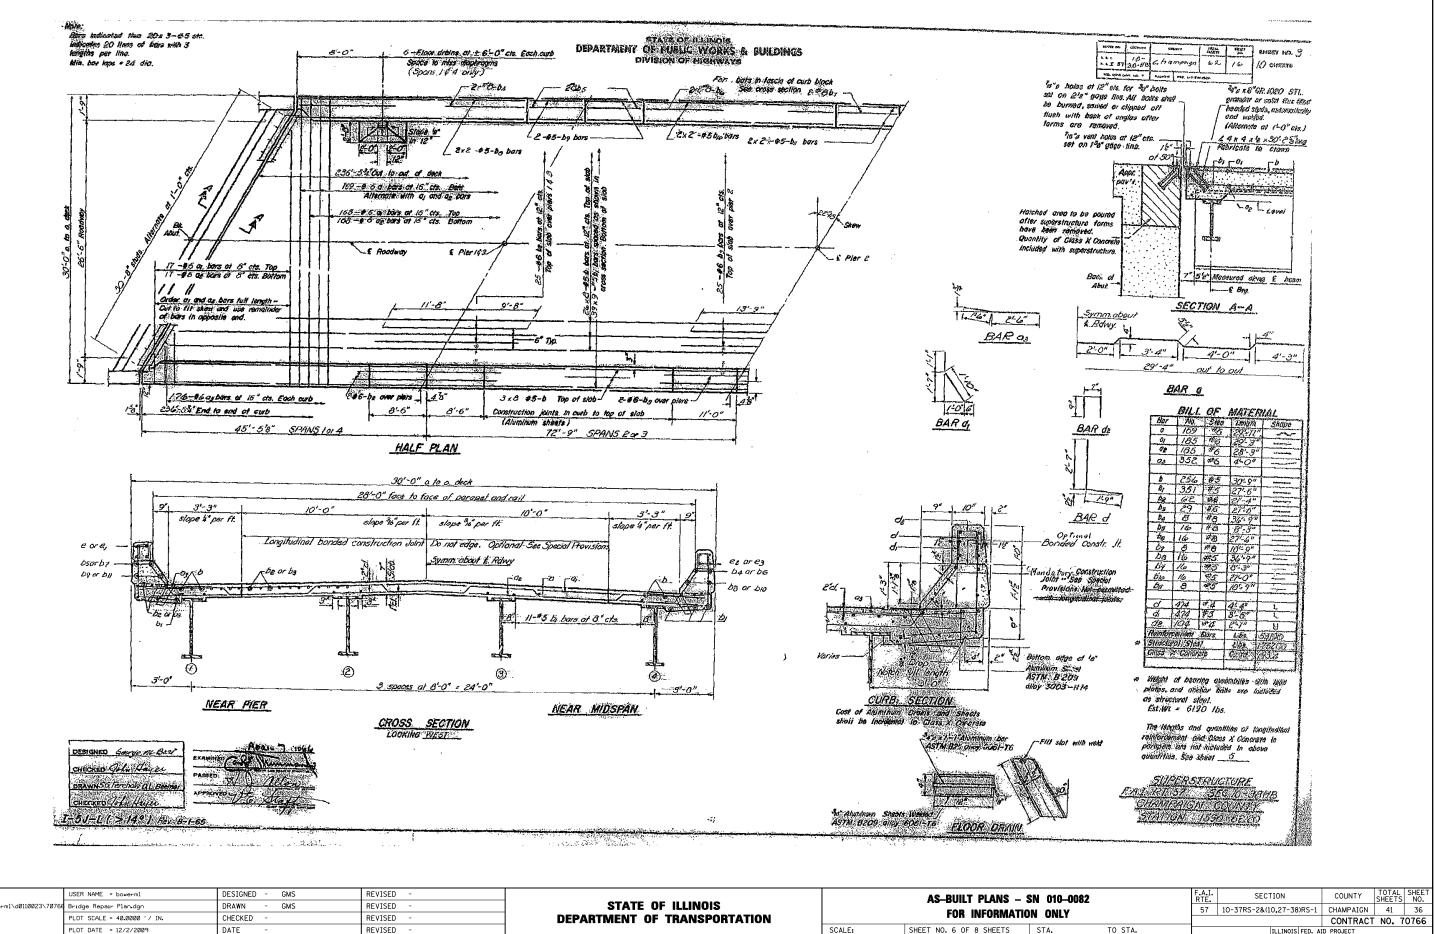

lLE NAME = U :\pw_work\pwidot\bowerm1\d0110023\70766 B	USER NAME = bowermi Bridge Repair Plan.dgn	DESIGNED - GMS DRAWN - GMS	REVISED - REVISED -	STATE OF ILLINOIS	AS-BUILT PLAN	
	PLOT SCALE = 40.0000 '/ IN.	CHECKED -	REVISED -	DEPARTMENT OF TRANSPORTATION		FOR INFOR
	PLOT DATE = 12/2/2009	DATE -	REVISED -		SCALE:	SHEET NO. 6 OF 8 SHEE