


STATE OF ILLINOIS DEPARTMENT OF TRANSPORTATION DIVISION OF HIGHWAYS PLANS FOR PROPOSED HIGHWAY BRIDGE PROGRAM


ROUTE NO.	SECTION	COUNTY	TOTAL SHEETS	SHEET NO.
T.R. 78	03-02125-00-BR	FAYETTE	12	1
FED. AID PROJECT NO.		ILLINOIS	PROJECT	
CONTRACT NO. 95540				

INDEX OF SHEETS

1	COVER SHEET
2	TYPICAL CROSS SECTION, GENERAL NOTES, AND SUMMARY OF QUANTITIES
3	PLAN AND PROFILE SHEET
4-10	BRIDGE PLANS
11-12	CROSS SECTIONS
	STANDARD 000001-05 STANDARD SYMBOLS, ABBREVIATIONS AND PATTERNS
	STANDARD 280001-04 TEMPORARY EROSION CONTROL SYSTEMS
	STANDARD 701901 TRAFFIC CONTROL DEVICES
	STANDARD B.L.R. 21-7 TYPICAL APPLICATION OF TRAFFIC CONTROL DEVICES FOR CONSTRUCTION ON RURAL LOCAL HIGHWAYS

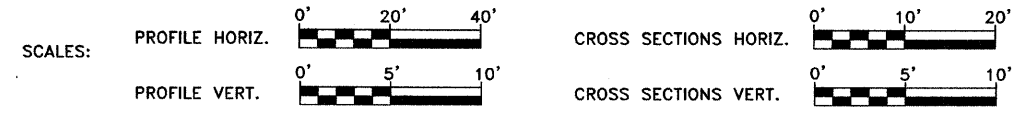

SECTION 03-02125-00-BR PROJECT NO. BROS-051(80) BEAR GROVE ROAD DISTRICT FAYETTE COUNTY JOB NO. C-97-045-08

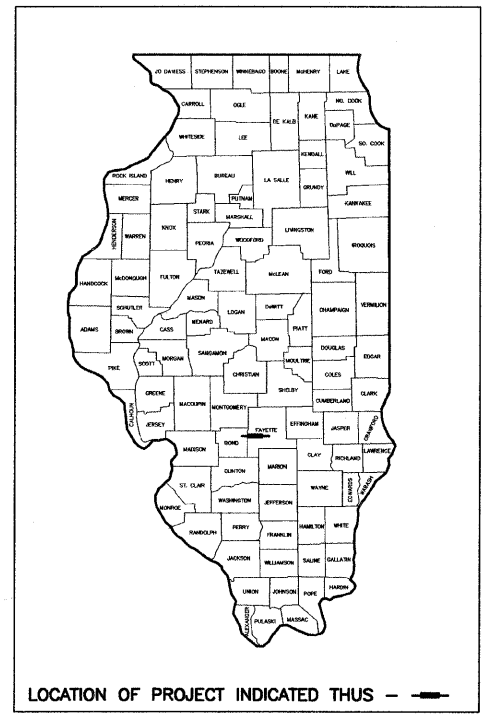


3rd P.M.

END SECTION 03-02125-00-BR
STA. 50+40.77

STA. 50+00 - CONSTRUCT SINGLE SPAN PRECAST
PRESTRESSED CONCRETE DECK BEAM BRIDGE
(71.54' BK. TO BK. ABUTMENTS) WITH
SPILL-THRU PILE BENT ABUTMENTS
10' SKEW, 24' ROADWAY
EXISTING STRUCTURE NO. 026-3058
PROPOSED STRUCTURE NO. 026-3440

BEGIN SECTION 03-02125-00-BR
STA. 49+59.23

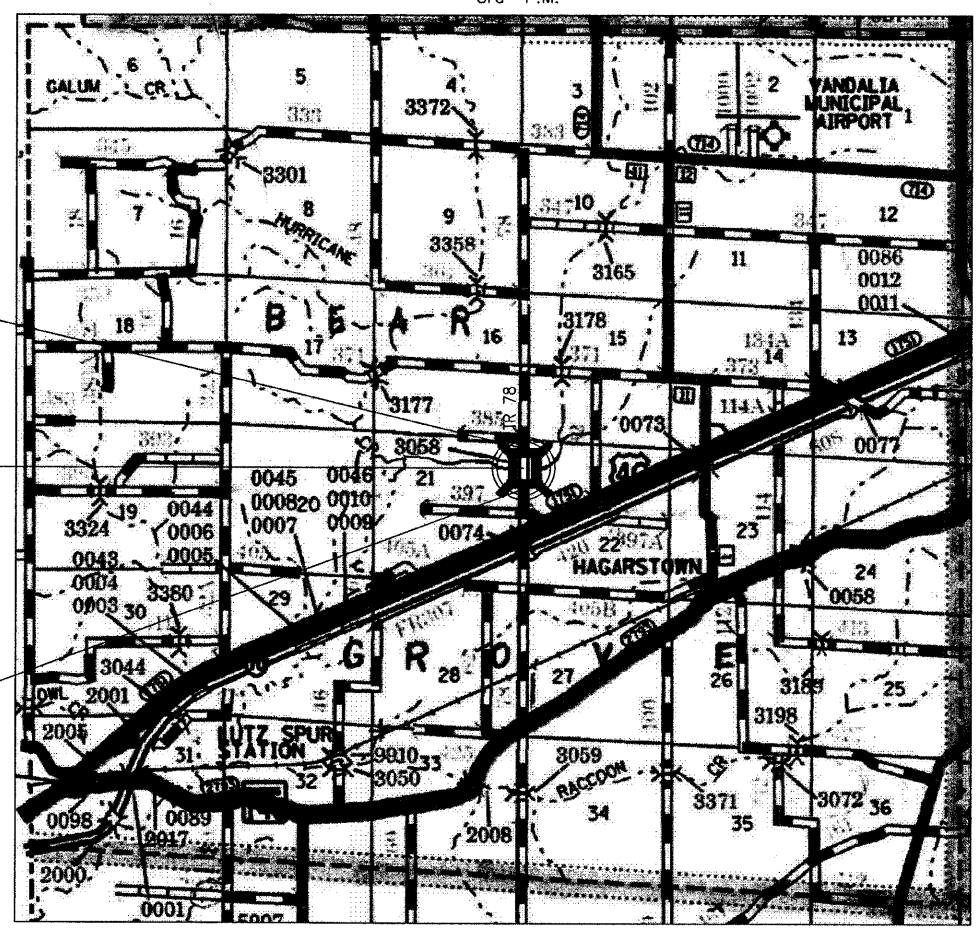

R.1W.

LOCATION MAP

APPROXIMATE SCALE - 1" = 0.62 MILE
NET LENGTH OF IMPROVEMENTS - 81.54 FEET = 0.015 MILE
GROSS LENGTH OF IMPROVEMENTS - 181.54 FEET = 0.034 MILE

APPROVED 12-12, 2007
Michael A. Kelly
COUNTY ENGINEER

PASSED 1-02, 2008
Marcus E. Keath
DISTRICT SEVEN ENGINEER OF
LOCAL ROADS & STREETS

Releasing For
Bid Based on
Limited Review 1-02, 2008
James M. Reed
DEPUTY DIRECTOR OF HIGHWAYS,
REGION FOUR ENGINEER

STATE OF ILLINOIS
DEPARTMENT OF TRANSPORTATION



MICHAEL R. QUANDT
SIGN: *Michael R. Quandt*
EXP. DATE: 11/30/09




48 HOURS PRIOR TO EXCAVATION
CALL J.U.L.I.E.: (811) or 1-800-892-0123

CLASS ROAD: MAJOR COLLECTOR
A.D.T. = 250
SPEED = 40 M.P.H.

STS CONSULTANTS
2524 South Broadway
Salem, Illinois 62881
PH (618) 548-1500
FAX (618) 548-5246
IL Design Firm Registration
No. 184-001518

DATE: DECEMBER 10, 2007
STS JOB NO. 200701115

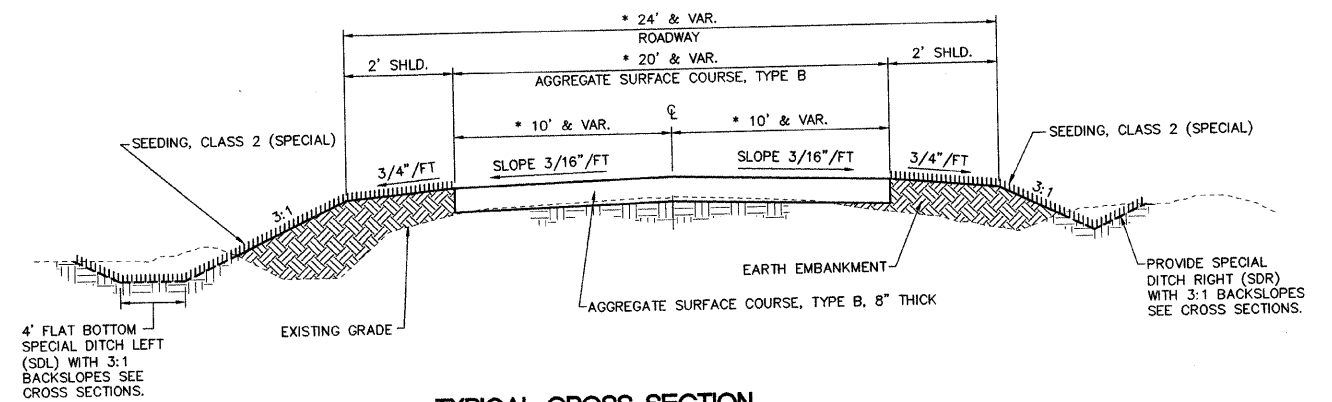

TYPICAL CROSS-SECTION

- * TRANSITION FROM 13.1' EXISTING TO 20' PROPOSED PAVEMENT STA. 49+09.23 TO STA. 49+59.23
- * 20' PROPOSED PAVEMENT STA. 49+59.23 TO BRIDGE AND FROM BRIDGE TO STA. 50+40.77
- * TRANSITION FROM 20' PROPOSED TO 11.9' EXISTING PAVEMENT STA. 50+40.77 TO STA. 50+90.77

GENERAL NOTES

1. THIS SECTION SHALL BE CONSTRUCTED ACCORDING TO THE PLANS, THE SPECIAL PROVISIONS AND THE "STANDARD SPECIFICATIONS FOR ROAD AND BRIDGE CONSTRUCTION" ADOPTED JANUARY 1, 2007.
2. THE SHRINKAGE FACTOR FOR EMBANKMENT IS 25%.
3. EXCEPT FOR TREE REMOVAL AS SHOWN ON THE PLANS, ALL CLEARING AND GRUBBING IS TO BE INCLUDED IN THE UNIT PRICE BID FOR EARTH EXCAVATION.
4. BITUMINOUS SURFACE TREATMENT (A-2) WILL BE COMPLETED BY THE OWNER.



SUMMARY OF QUANTITIES

X081-2A

CODE NO.	ITEM	QUANTITY	UNIT
20100110	TREE REMOVAL (6 TO 15 UNITS DIAMETER)	94	UNITS
20100210	TREE REMOVAL (OVER 15 UNITS DIAMETER)	44	UNITS
20200100	EARTH EXCAVATION	108	CU. YD.
20300100	CHANNEL EXCAVATION	356	CU. YD.
25001000	SEEDING, CLASS 2 (SPECIAL)	0.12	ACRE
28000300	TEMPORARY DITCH CHECKS	4	EACH
28100807	STONE DUMPED RIPRAP, CLASS A4	120	TON
40200800	AGGREGATE SURFACE COURSE, TYPE B	90	TON
50100100	REMOVAL OF EXISTING STRUCTURES	1	EACH
50300225	CONCRETE STRUCTURES	19.2	CU. YD.
50300280	CONCRETE ENCASEMENT	2.58	CU. YD.
50400605	PRECAST PRESTRESSED CONCRETE DECK BEAMS (33" DEPTH)	1680	SQ. FT.
50800105	REINFORCEMENT BARS	2340	POUND
50900205	STEEL RAILING, TYPE S1	140	FOOT
51201400	FURNISHING STEEL PILES HP 10x42	417	FOOT
51202305	DRIVING PILES	417	FOOT
51203400	TEST PILE STEEL HP 10x42	1	EACH
51500100	NAME PLATES	1	EACH
67100100	MOBILIZATION	1	L. SUM

POINT	LOCATION	N. COOR.	E. COOR.	ELEV.
HC#1 (IRON PIN)	© STA. 48+49.81	4711.08	3009.15	514.50
HC#2 (IRON PIN)	© STA. 51+49.81	5011.08	3009.03	500.67


POINT	LOCATION	ELEV.
BM#1 (R.R. SPIKE IN POWER POLE)	RT. 20.54, STA. 51+20.19	498.77
BM#2 (R.R. SPIKE IN TELEPHONE POLE)	LT. 19.79, STA. 49+47.89	511.82

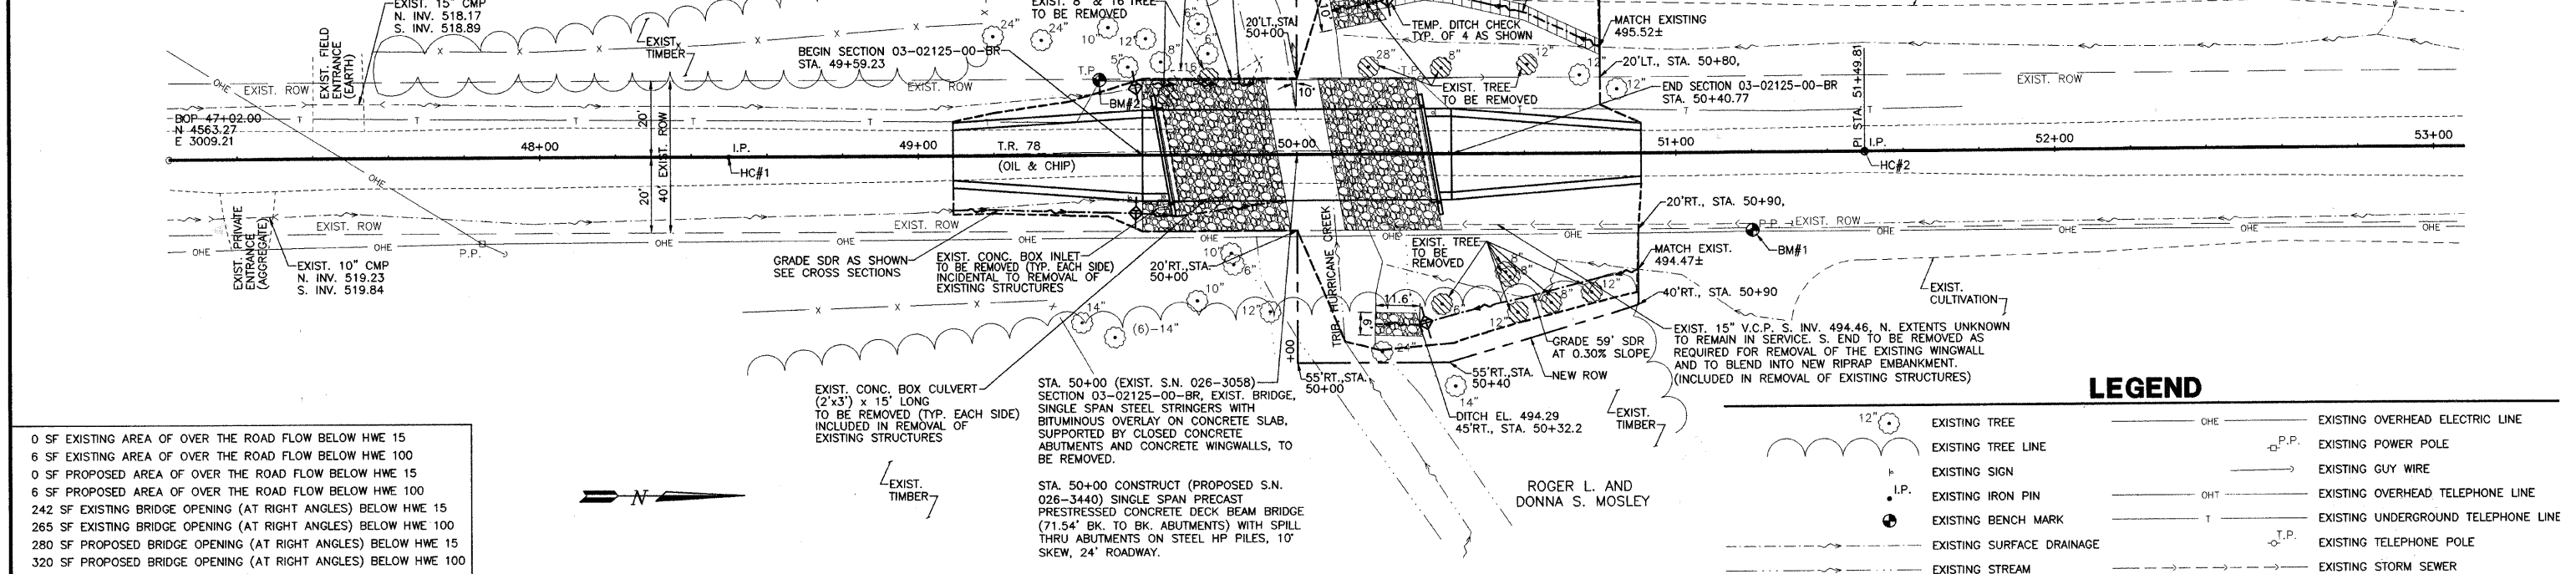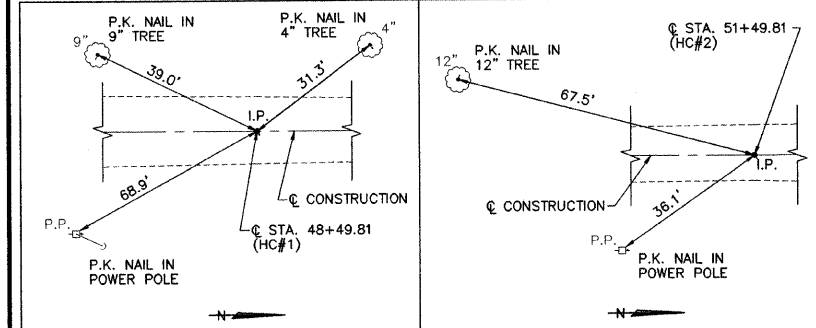


- 0 SF EXISTING AREA OF OVER THE ROAD FLOW BELOW HWE 15
- 6 SF EXISTING AREA OF OVER THE ROAD FLOW BELOW HWE 100
- 0 SF PROPOSED AREA OF OVER THE ROAD FLOW BELOW HWE 15
- 6 SF PROPOSED AREA OF OVER THE ROAD FLOW BELOW HWE 100
- 242 SF EXISTING BRIDGE OPENING (AT RIGHT ANGLES) BELOW HWE 15
- 265 SF EXISTING BRIDGE OPENING (AT RIGHT ANGLES) BELOW HWE 100
- 280 SF PROPOSED BRIDGE OPENING (AT RIGHT ANGLES) BELOW HWE 15
- 320 SF PROPOSED BRIDGE OPENING (AT RIGHT ANGLES) BELOW HWE 100

LEGEND

- 12" ○ EXISTING TREE
- EXISTING TREE LINE
- ⊙ EXISTING SIGN
- I.P. EXISTING IRON PIN
- EXISTING BENCH MARK
- EXISTING SURFACE DRAINAGE
- EXISTING STREAM
- EXISTING FENCE
- OHE EXISTING OVERHEAD ELECTRIC LINE
- P.P. EXISTING POWER POLE
- EXISTING GUY WIRE
- OHT EXISTING OVERHEAD TELEPHONE LINE
- T EXISTING UNDERGROUND TELEPHONE LINE
- T.P. EXISTING TELEPHONE POLE
- EXISTING STORM SEWER
- PROPOSED TEMPORARY DITCH CHECK
- PROPOSED CLASS A4 - RIPRAP PAD

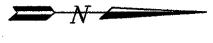

SCALES:
1" = 20' HOR
1" = 5' VER

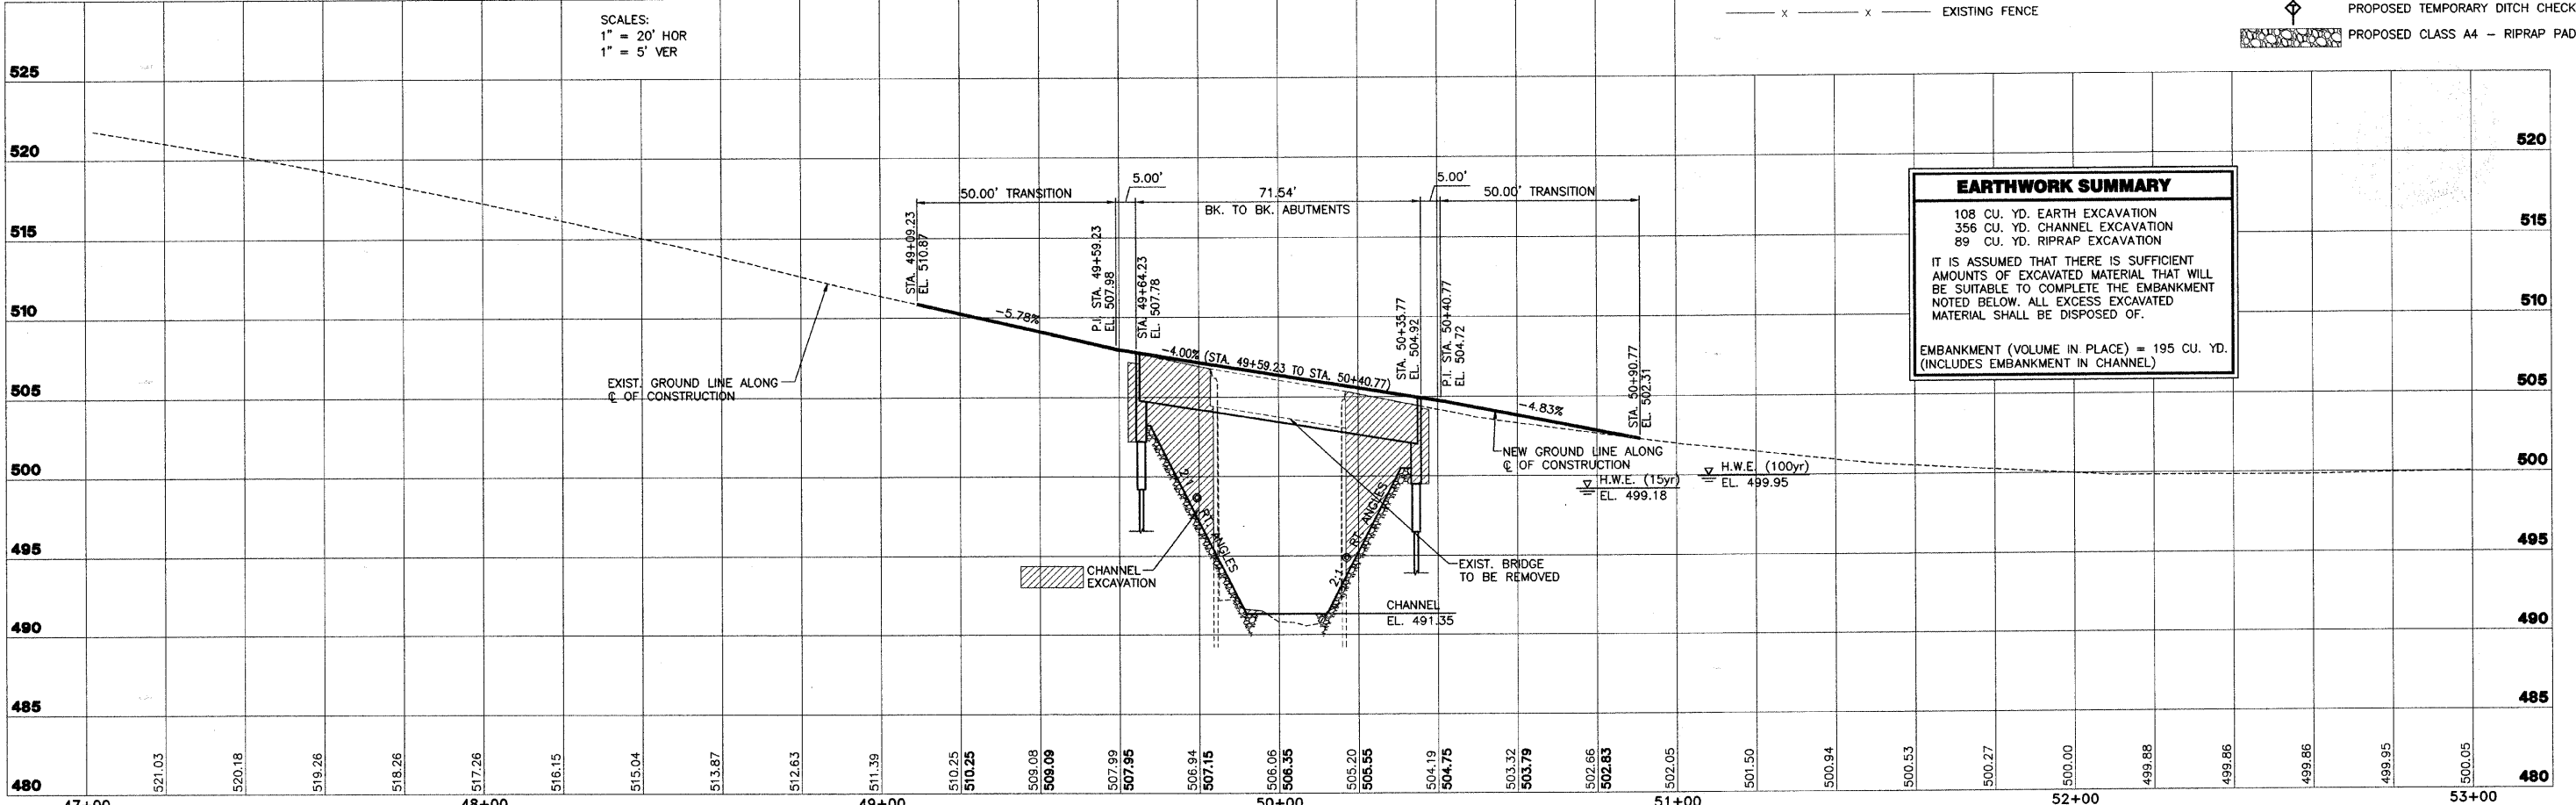

EARTHWORK SUMMARY	
108 CU. YD. EARTH EXCAVATION	
356 CU. YD. CHANNEL EXCAVATION	
89 CU. YD. RIPRAP EXCAVATION	
IT IS ASSUMED THAT THERE IS SUFFICIENT AMOUNTS OF EXCAVATED MATERIAL THAT WILL BE SUITABLE TO COMPLETE THE EMBANKMENT NOTED BELOW. ALL EXCESS EXCAVATED MATERIAL SHALL BE DISPOSED OF.	
EMBANKMENT (VOLUME IN PLACE) = 195 CU. YD. (INCLUDES EMBANKMENT IN CHANNEL)	

STS CONSULTANTS
2524 South Broadway, P.O. Box 850
Salem, Illinois 62881
Ph(618)548-3500
Fax(618)548-5246
IL Design Firm Reg. No. 184-001518

T.R. 78, SECTION 03-02125-00-BR
BEAR GROVE ROAD DISTRICT
FAYETTE COUNTY, ILLINOIS

PLAN AND PROFILE		SURVEY		CHECKED		DATE	
STA. 47+00 TO STA. 53+00		JAS	JAS	12/10/07		REVISED	
		MRQ	MRQ			JOB NO.	
		JMW	JMW			200701115	

B.M. - B.M. #1, R.R. Spike in Power Pole, 20.54' RT., STA. 51+20.19, EL. 498.77
 B.M. #2, R.R. Spike in Telephone Pole, 19.79' LT., STA. 49+47.89, EL. 511.82


STATE OF ILLINOIS
 DEPARTMENT OF TRANSPORTATION

ROUTE NO.	SECTION	COUNTY	TOTAL SHEETS	SHEET NO.
T.R. 78	03-02125-00-BR	FAYETTE	12	4
FED. AID PROJECT NO.		ILLINOIS	CONTRACT NO. 95540	

Existing Structure - Single span steel stringers with bituminous overlay on concrete slab on closed concrete abutments and concrete wingwalls.

Salvage - Material deemed salvageable by the Engineer shall be stored on the ROW for removal by the County.

Existing Known Utilities - Overhead electric, Telephone

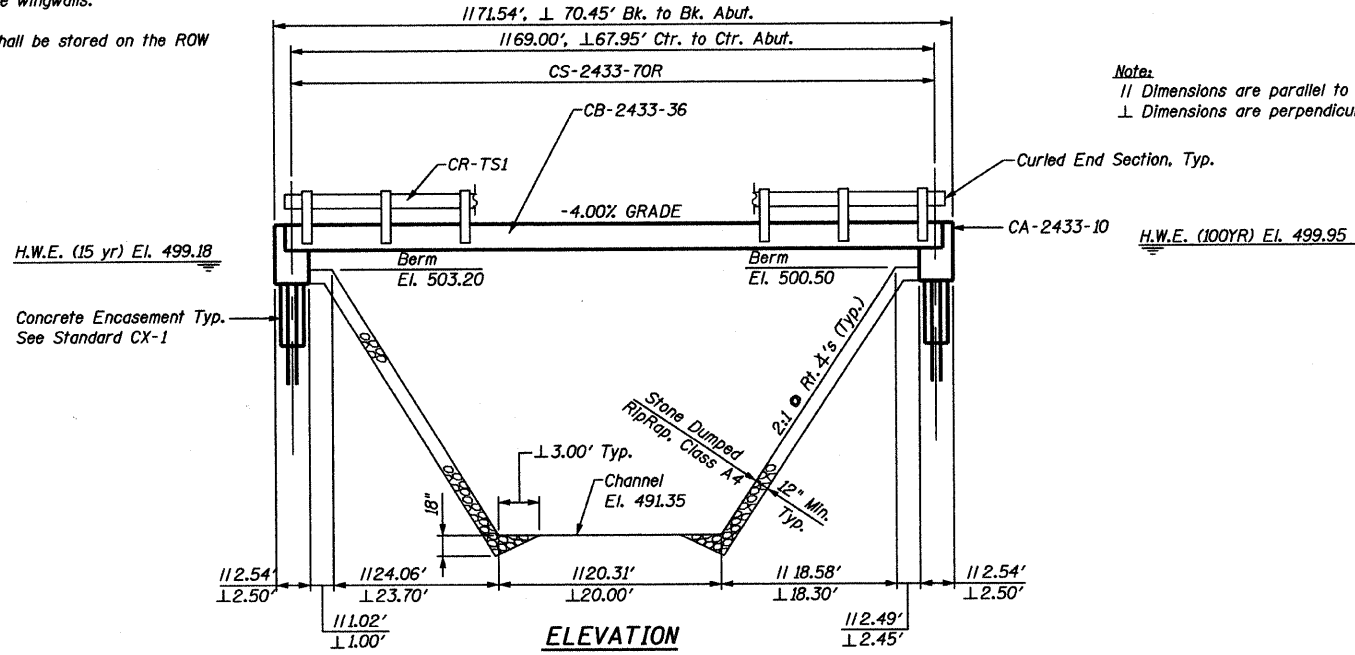


Note:
 // Dimensions are parallel to roadway
 ⊥ Dimensions are perpendicular to channel

GENERAL NOTES

- The contractor shall drive test piles to 110% of the nominal required bearing specified in production locations at the substructures specified or approved by the Engineer before ordering the remaining piles.
- See Special Provisions for boring logs.
- A corrosion inhibitor shall be used in the concrete for the precast, prestressed concrete deck beams (33" Depth).
- The Waterproofing Membrane System and Bituminous Concrete Surface Course Shown on the Standards Shall Not be Provided.
- Reinforcement bars shall conform to the requirements of ASTM A706 Grade 60 (IL Modified).

TOTAL BILL OF MATERIAL

Item	Unit	Super	Sub.		Total
			Piers	Abuts.	
Removal of Existing Structures	Each				1
Concrete Structures	Cu. Yd.			19.2	19.2
Precast Prestressed Concrete Deck Beams (33" Depth)	Sq. Ft.	1680			1680
Steel Railing, Type S-1	Foot	140			140
Reinforcement Bars	Pound			2340	2340
Furnishing Steel Piles HP 10x42	Foot			417	417
Driving Piles	Foot			417	417
Test Pile Steel HP 10x42	Each			1	1
Name Plates	Each			1	1
Concrete Encasement	Cu. Yd.			2.58	2.58

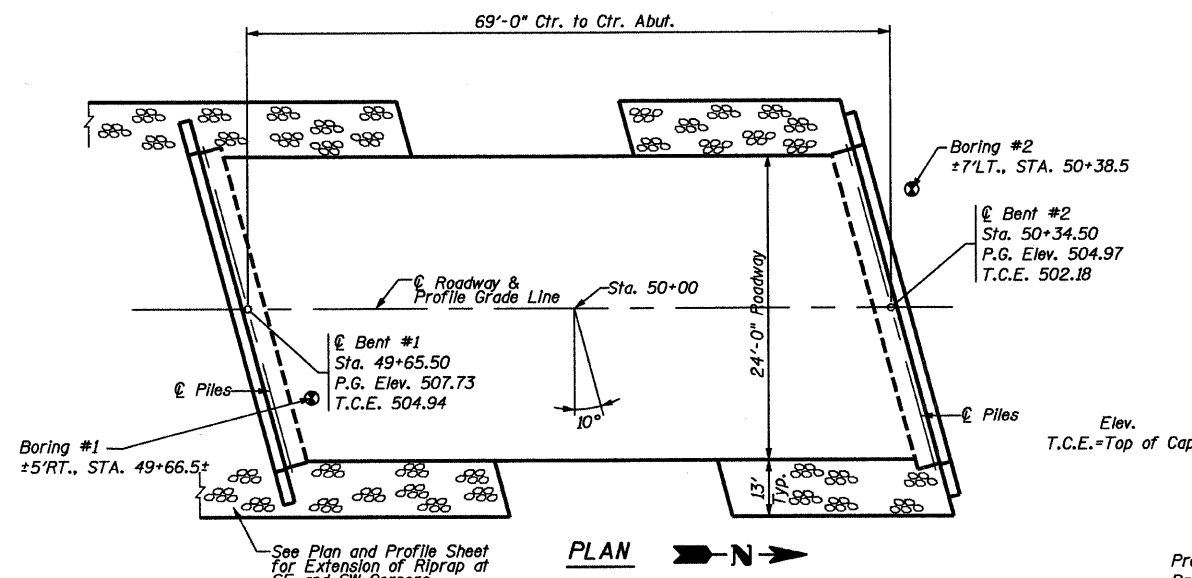

The standard detail sheets for this structure were assembled by me or persons under my direct supervision.

Date of License Expiration: 11/30/09

Date: 12/12/07

Signature: Michael R. Quarant



I certify these Standard Bridge Plans for foundation treatment only.

Date of License Expiration: 11/30/03

Date: 12/12/07

Signature: William D. Huebner



DESIGN SPECIFICATIONS

2002 AASHTO Standard Specifications - 17th ed.

LOADING HS 20-44

Allow 25# / Sq. Ft. for Future Wearing Surface.


PILE DATA (2-ABUTS.)

Pile Type and Size:	Steel Piles, HP10x42
Nominal Required Bearing:	240 kips
Allowable Resistance Available:	80 kips
Estimated Pile Length:	45 Ft Bent #1, 48 Ft Bent #2
Number of Production Piles:	9
Number of Test Piles:	1 (Located in Bent #2)

STATION 50+00
 TRIBUTARY TO HURRICANE CREEK
 SEC. 03-02125-00-BR BUILT 20...
 PROJECT NO. BR05-05(180)
 FAYETTE COUNTY
 LOADING HS20
 STR. NO. 026-3440

LETTERING FOR NAME PLATE

Locate Name Plate at Northwest Corner of Bridge (See Std. CN)

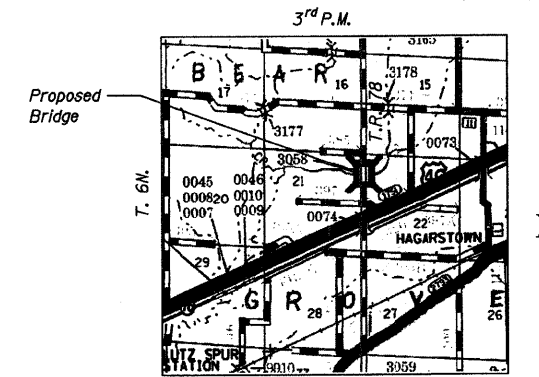

LOCATION SKETCH

WATERWAY INFORMATION

Flood		Q		Opening Sq. Ft.		Naf. H.W.E. Ft.		Head - Ft.		Headwater Elev. - Ft.	
Freq. Yr.	C.F.S.	Exist.	Prop.	Exist.	Prop.	Exist.	Prop.	Exist.	Prop.	Exist.	Prop.
Design	15	1621	242	280	499.18	N/A	0.56	N/A	499.74		
Base	100	2600	265	320	499.95	N/A	1.00	N/A	500.95		
Overtopping											
Max. Calc.	500										


INDEX OF SHEETS

- General Plan & Elevation
- Standard CS-2433-70R
- Standard CB-2433-36
- Standard CA-2433-10
- Standard CR-TS1
- Standard CN
- Standard CX-1


GENERAL PLAN & ELEVATION

T.R. 78
 OVER TRIB. TO HURRICANE CREEK


SECTION 03-02125-00-BR
 FAYETTE COUNTY
 STATION 50+00

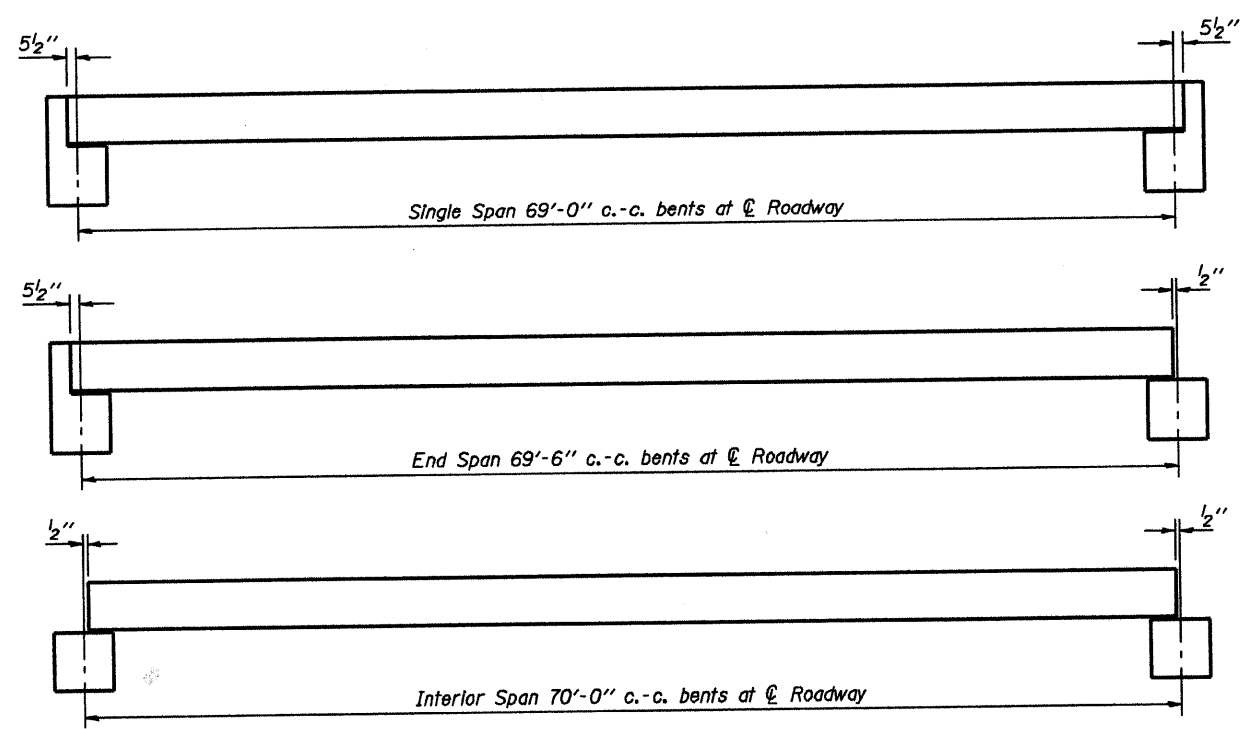


TYPICAL ELEVATIONS

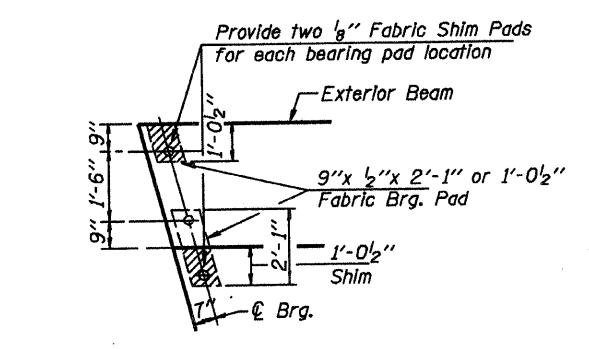


1/2" FABRIC BRG. PAD DETAILS

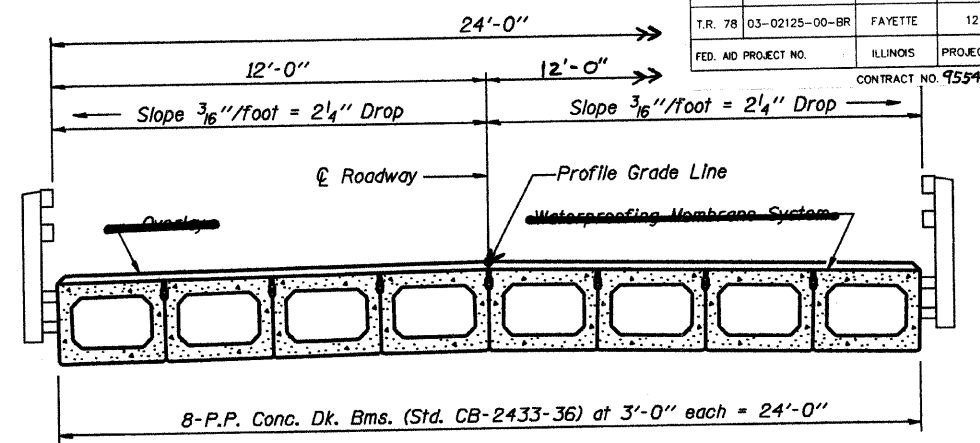

CROSS SECTION

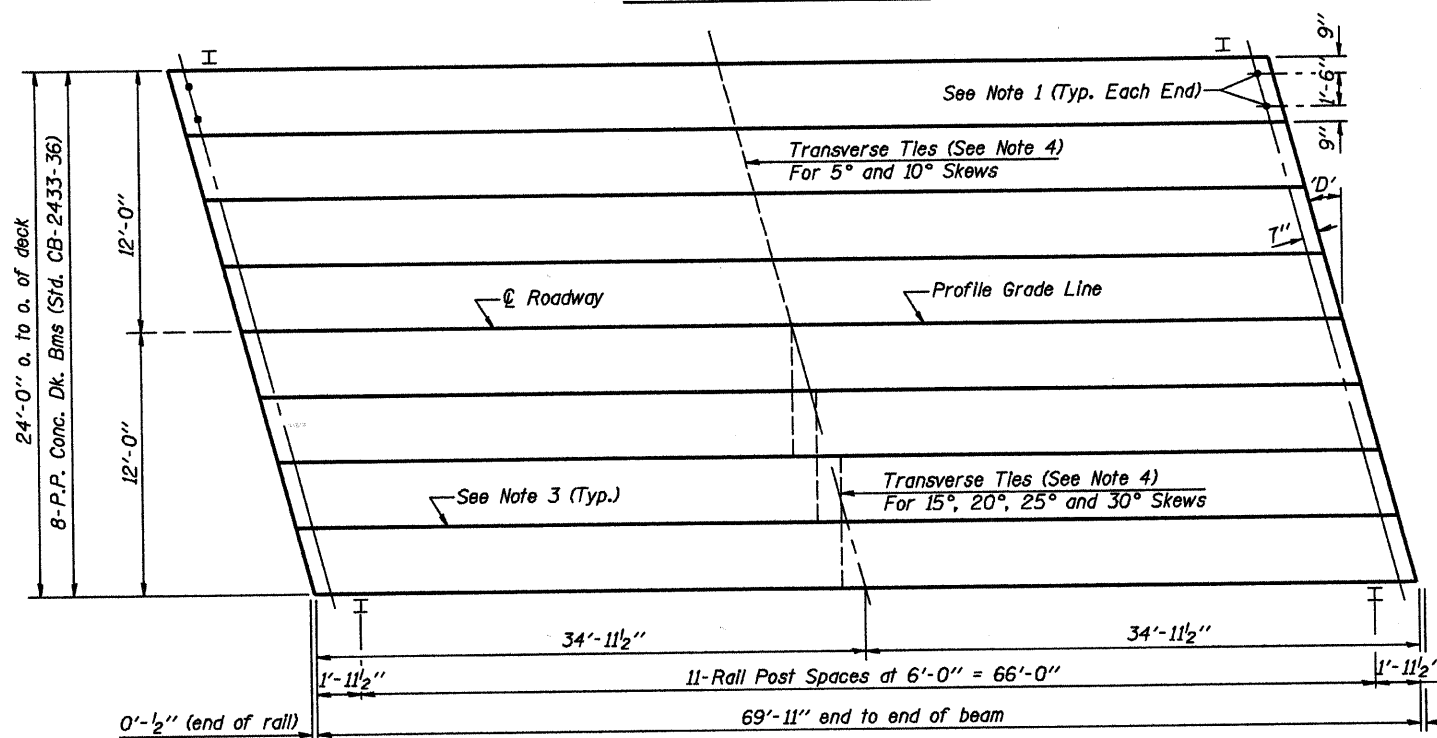

PLAN
(D' = Designated Skew Angle)

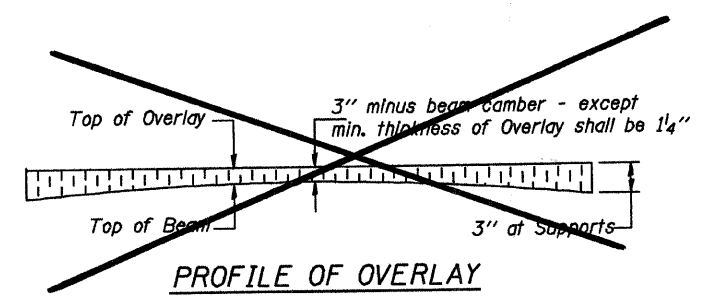


PROFILE OF OVERLAY

DIMENSIONS 'A' AND 'B'

'D'	5°	10°	15°	20°	25°	30°
A	1 1/2"	1 5/8"	1 3/4"	1 7/8"	2 1/4"	2 5/8"
B	7 1/2"	7 5/8"	7 3/4"	8"	8 1/4"	8 5/8"

- NOTES**
- After beams have been erected, holes shall be drilled into substructure and anchor dowels placed. Dowel holes shall be filled with non-shrink grout to top of beam and allowed to cure min. 24 hrs. prior to grouting the shear keys.
 - Nominal 1" joint at centerline pier shall be filled with non-shrink grout.
 - Longitudinal keys shall be grouted.
 - The 1" rods in the transverse tie assembly shall be tightened to a snug fit and the threads set. Pockets that receive transverse tie bar outside shall be filled with grout after transverse tie assembly is in place.

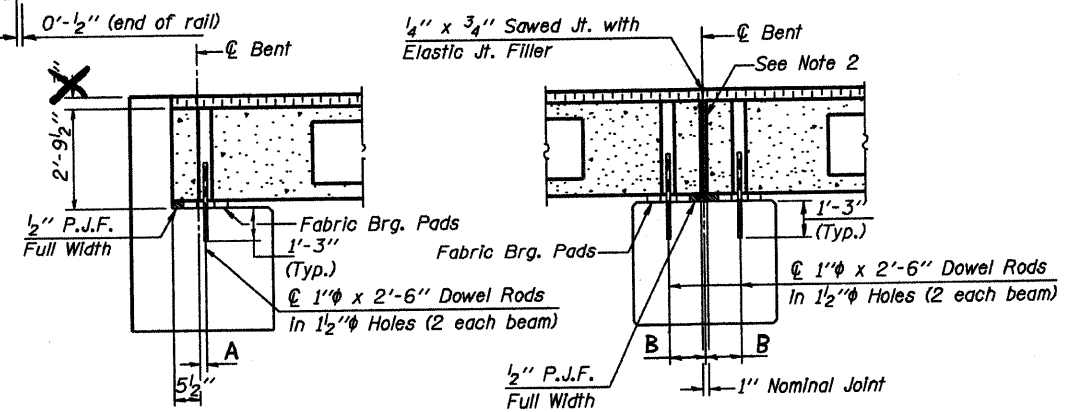

SECTION AT ABUTS.
(Along centerline beams)

SECTION AT PIERS
(Along centerline beams)

QUANTITIES FOR ONE SPAN

P.P. Conc. Dk. Bm. 33" Dp.	1680 Sq. Ft.
Steel Railing	140 Ft.
Waterproofing Membrane System	168.7 Sq. Yds.
Portland Cement Mortar	400.00
Fishing Gears	

Note: Quantity of overlay for one span = 21.3 Tons

P.P.C. DECK BEAM SUPERSTRUCTURE			
24' RDWY.	33" BMS.	70' SPAN	RIGHT
STANDARD CS-2433-70R			

Illinois Department of Transportation


PASSED APRIL 4, 2005

Theresa S. Romagosa
Engineer of Bridge Design


APPROVED APRIL 4, 2005

Ralph E. Anderson
Engineer of Bridges and Structures


ISSUED 4-4-2005

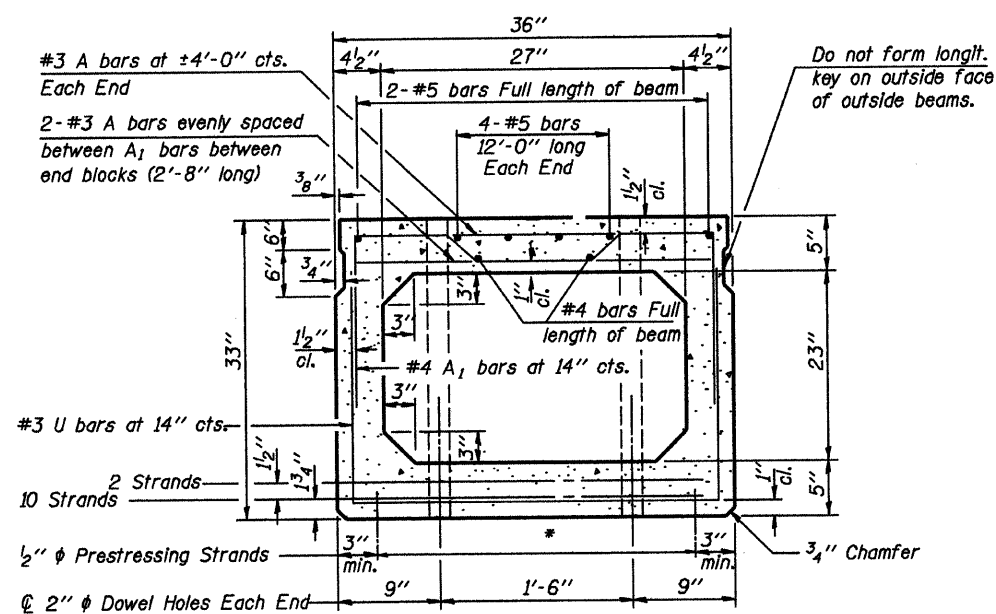


CROSS SECTION
(60' SPAN)

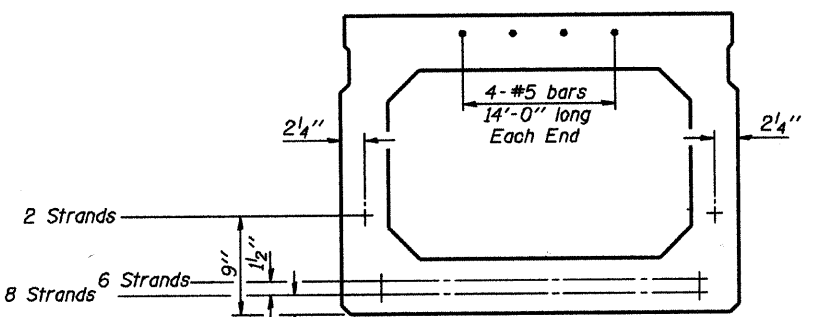

CROSS SECTION
(70' SPAN)

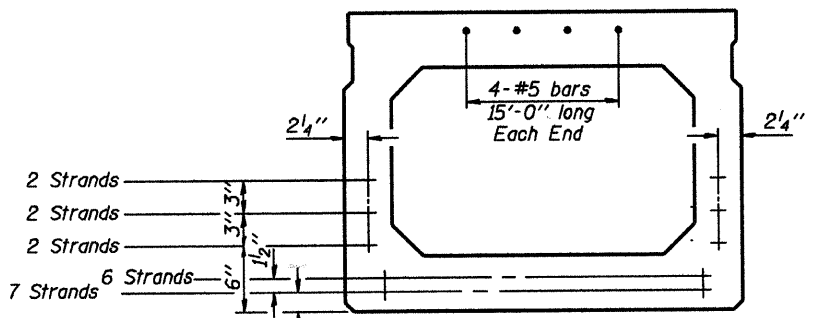


CROSS SECTION
(75' SPAN)

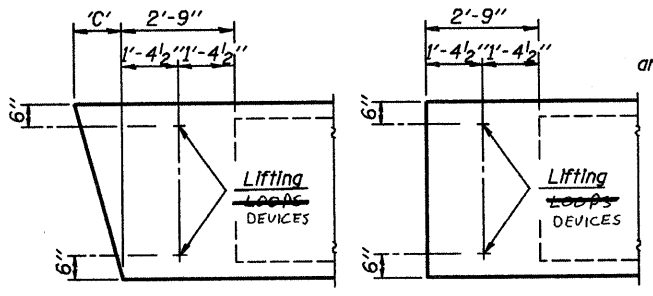

END BLOCK DETAILS

Each beam shall have four Lifting Loop DEVICES two at each end of beam cast in locations shown above. ~~Beams shall be cast with lifting loops.~~ ~~Beams shall be cast with lifting loops.~~

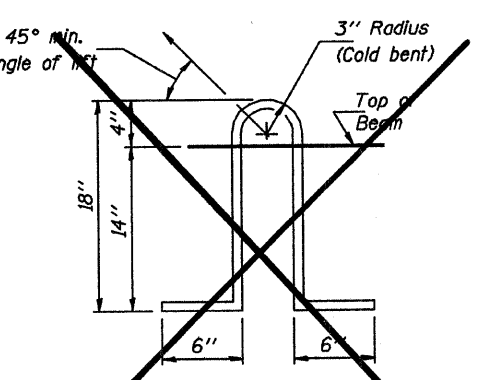

LIFTING LOOP DETAIL

Lifting loops shall be 3/2" φ - 270 ksi strands, as shown. Alternate approved lifting devices are also acceptable. See special provisions.


DIMENSION 'C'

Skew Angle 'D'	0°	5°	10°	15°	20°	25°	30°
Dimension 'C' (Inches)	0	3 3/8	6 3/8	9 5/8	13 1/8	16 3/4	20 3/4


*** TRANSVERSE STRAND PLACEMENT GUIDELINES**

1. Place strands symmetrically about centerline of beam.
2. The minimum distance from center to center of strands in all directions shall be 2".
3. The minimum clearance from strand to dowel hole shall be 1/2".
4. The minimum clearance from strand to void shall be 1 1/2".




Vertical placement of strands shall not be adjusted to satisfy the above guidelines.

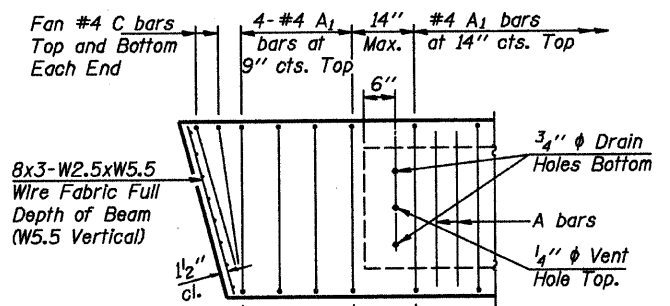

END REINFORCEMENT
(SKEWED)

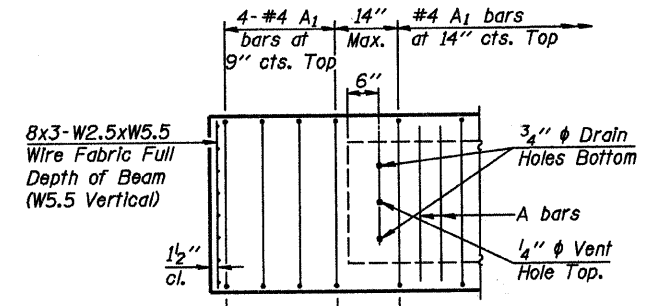

END REINFORCEMENT
(RIGHT ANGLE)

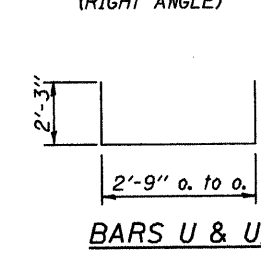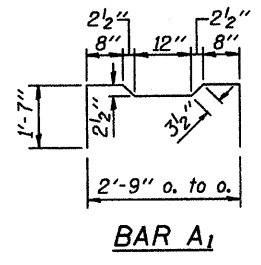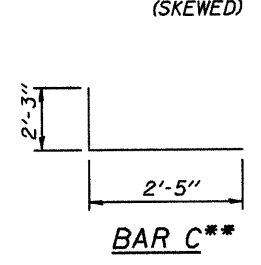


DESIGN STRESSES


- $f'_c = 5,000$ p.s.i.
- $f'_{ci} = 4,000$ p.s.i.
- $f'_s = 270,000$ p.s.i. (1/2" φ Strand)
- $f_{st} = 201,960$ p.s.i. (1/2" φ Strand)
- $f_y = 60,000$ p.s.i.

MIN. BAR LAP


- #4 bars = 1'-4"
- #5 bars = 1'-8"

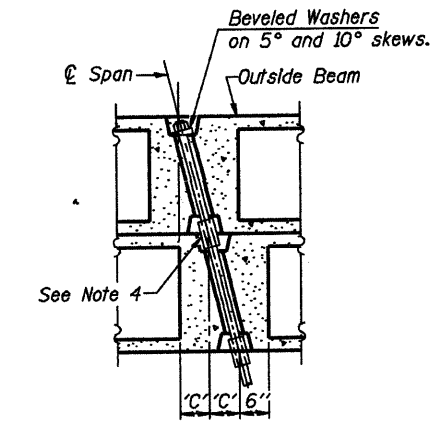

PARTIAL PLAN TRANSVERSE TIE ASSEMBLY
(D=0°, 5° and 10°)

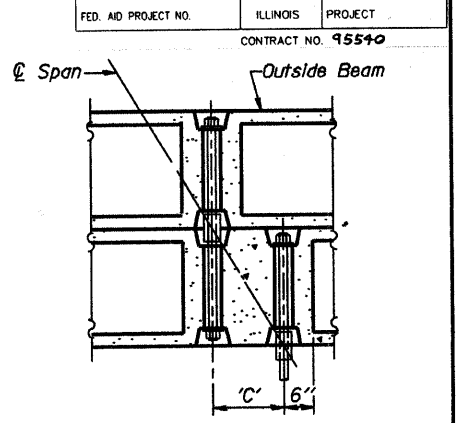

PARTIAL PLAN TRANSVERSE TIE ASSEMBLY
(D=15°, 20°, 25° and 30°)

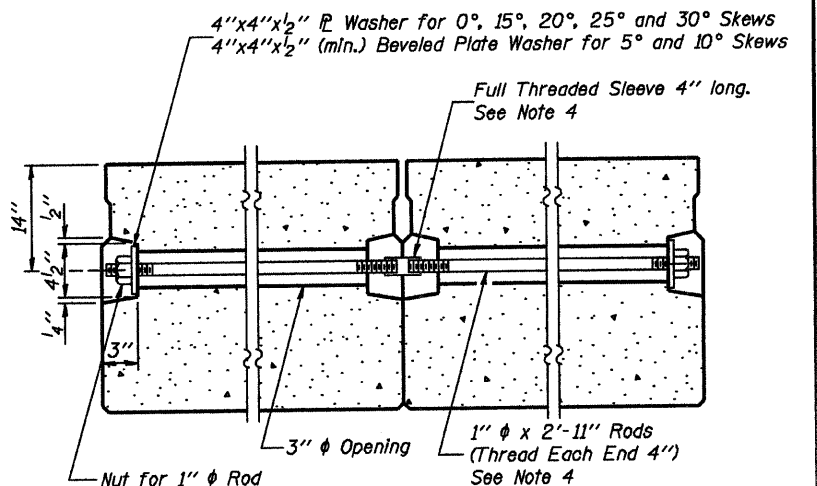

SECTION ALONG TRANSVERSE TIE ASSEMBLY

NOTES

1. Prestressing steel shall be uncoated high strength, low relaxation 7-wire strand, Grade 270.
2. The nominal diameter shall be 1/2" and the nominal cross-sectional area shall be 0.153 square inches.
3. Reinforcement bars shall conform to the requirements of AASHTO M-31 or M-322, Grade 60.
4. On 0°, 5° and 10° skewers, alternate approved transverse tie rods of increased segmental length are acceptable.
5. Rail Post anchor devices shall be cast into outside beam as elsewhere specified.
6. When a Waterproofing Membrane System is specified, the top surface of the beams shall be screeded with a straightedge and finished with a hand float. The finished surface shall be free of depressions or high spots with sharp corners and the top edge of keys shall be rounded or chamfered a minimum of 1/4".
7. Keyway surfaces shall be cleaned to remove form oil or other bond breaking material prior to shipment of the beams. Cleaning shall be done by sandblasting the keyway areas between the top of the beam and the bottom edge of the key.

Illinois Department of Transportation

PASSED APRIL 4, 2005

Thomas S. Namagala
Engineer of Bridge Design

APPROVED APRIL 4, 2005

Ralph E. Anderson
Engineer of Bridges and Structures

ISSUED 4-4-2005

NOTE:
The std. reinf. and dimensions shown on the 60' span cross section is typical for all spans, except as shown.

****NOTE:**
The following number of C bars shall be used:



Skew	No.
5° and 10°	1
15° and 20°	2
25° and 30°	3

P.P.C. DECK BEAM DETAILS

24' ROADWAY	33" x 36" BEAMS
STANDARD CB-2433-36	

ROUTE NO.	SECTION	COUNTY	TOTAL SHEETS	SHEET NO.
T.R. 78	03-02125-00-BR	FAYETTE	12	9
FED. AID PROJECT NO.	ILLINOIS PROJECT			

CONTRACT NO. 95540

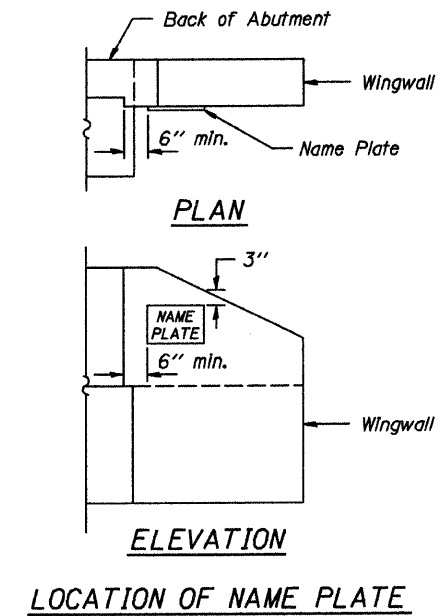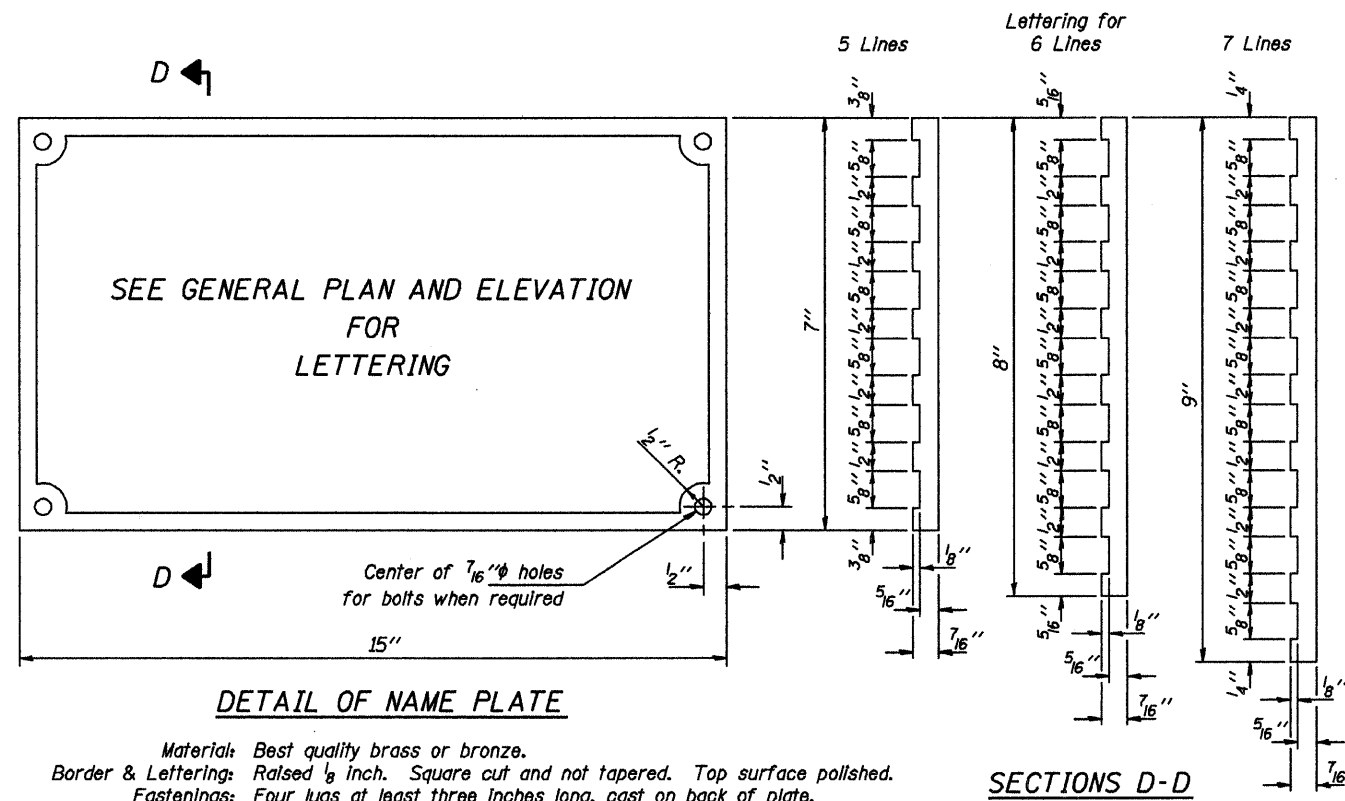

Illinois Department of Transportation

PASSED APRIL 4, 2005

Thomas S. Ramagosa
 Engineer of Bridge Design

APPROVED APRIL 4, 2005

Ralph E. Anderson
 Engineer of Bridges and Structures


ISSUED 7-1-9986

NAME PLATE
STANDARD CN


ROUTE NO.	SECTION	COUNTY	TOTAL SHEETS	SHEET NO.
T.R. 78	03-02125-00-BR	FAYETTE	12	10
FED. AID PROJECT NO.	ILLINOIS PROJECT	CONTRACT 95540		

Reinforcement cage shall be omitted when Concrete Encasement is provided.


The cost of Reinforcement is included with the Cost of Furnishing Piles.

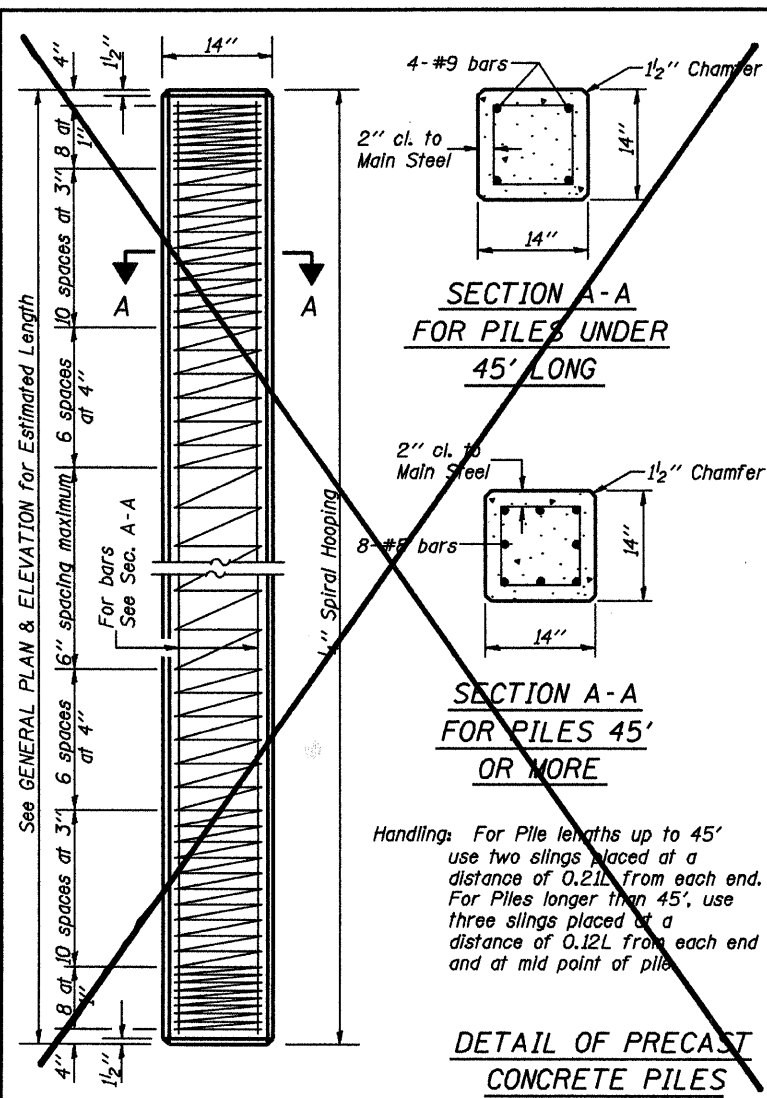


DETAIL OF PRECAST CONCRETE PILES

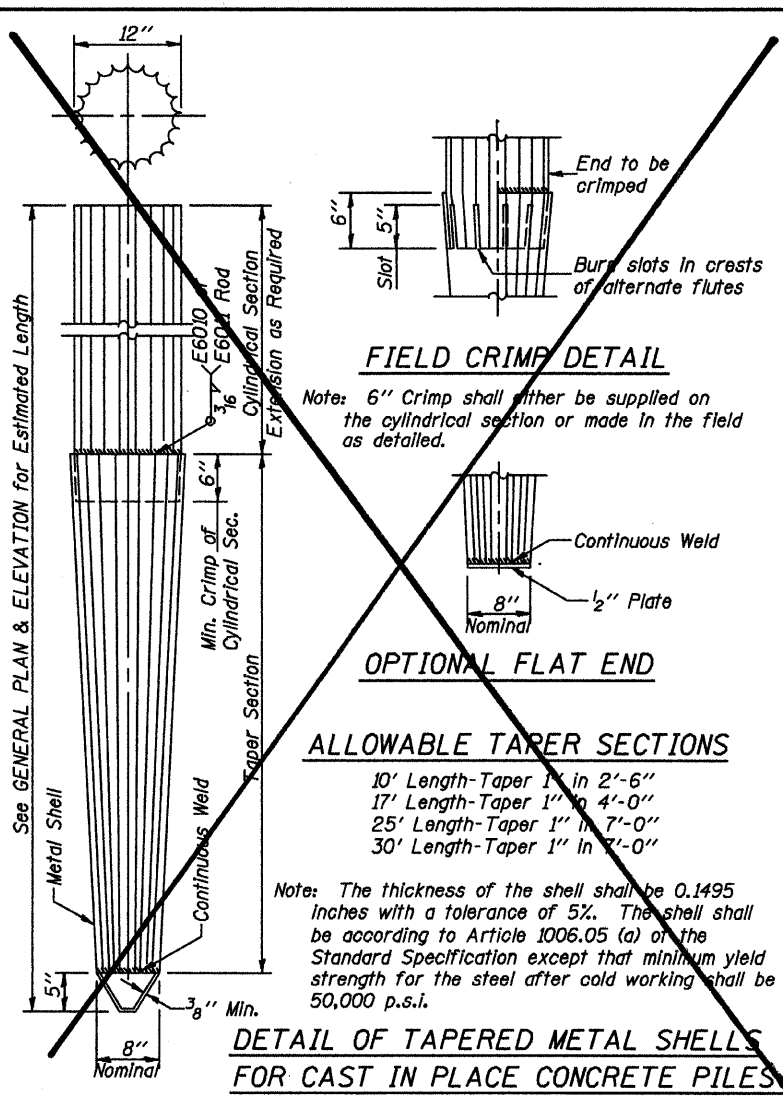

DETAIL OF TAPERED METAL SHELLS FOR CAST IN PLACE CONCRETE PILES

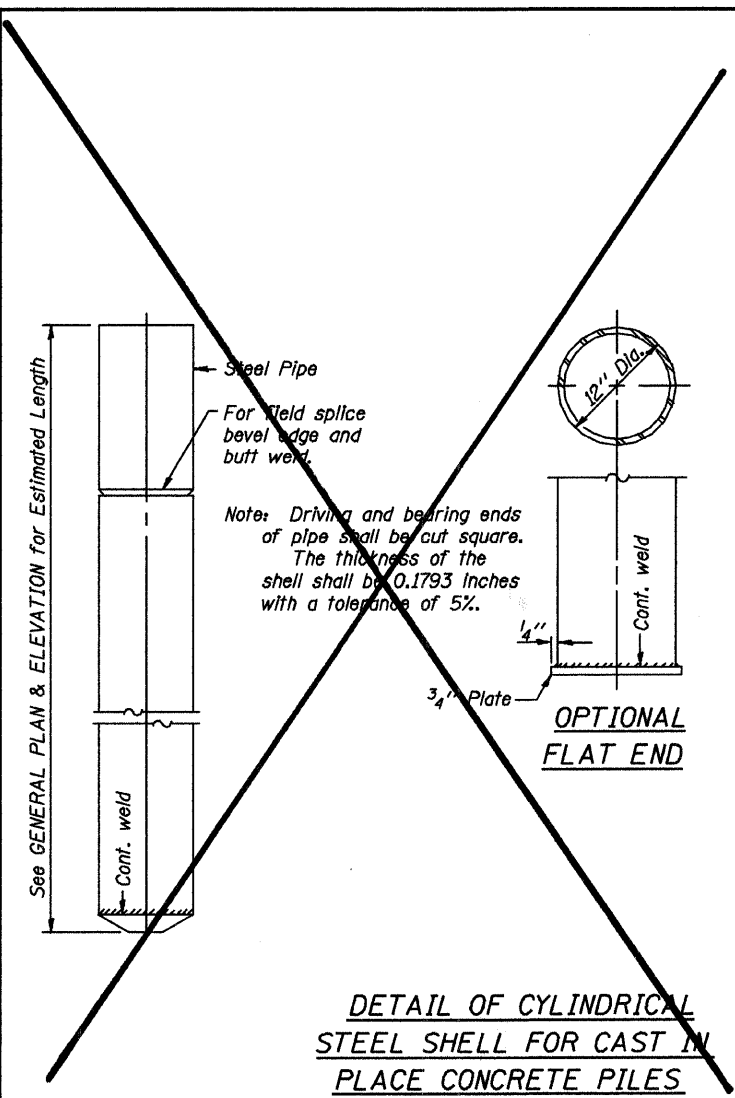

DETAIL OF CYLINDRICAL STEEL SHELL FOR CAST IN PLACE CONCRETE PILES

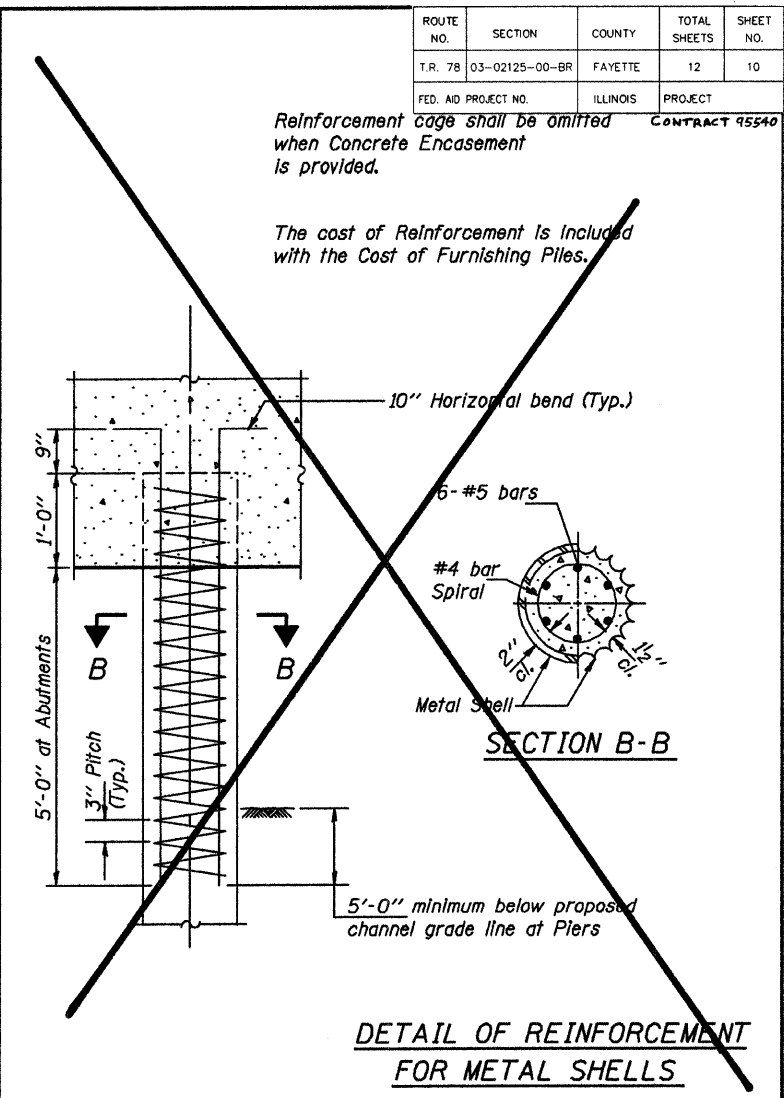


DETAIL OF REINFORCEMENT FOR METAL SHELLS

Illinois Department of Transportation


PASSED FEBRUARY 1, 2000
Thomas J. Demagala
 Engineer of Bridge Design

APPROVED FEBRUARY 1, 2000
Ralph E. Anderson
 Engineer of Bridges and Structures

1887-H (01/95)

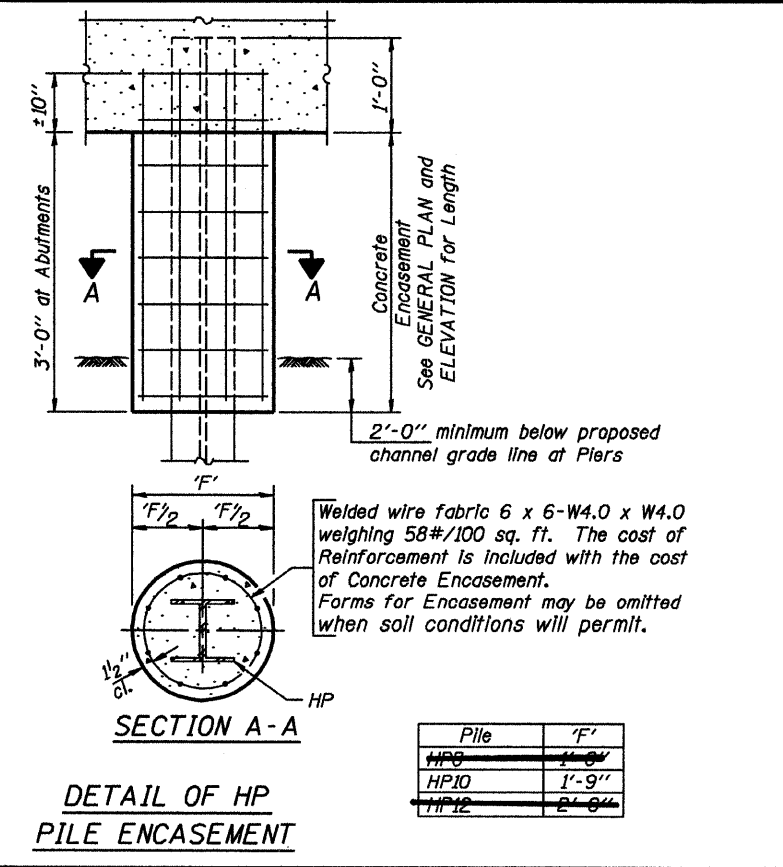

DETAIL OF HP PILE ENCASEMENT

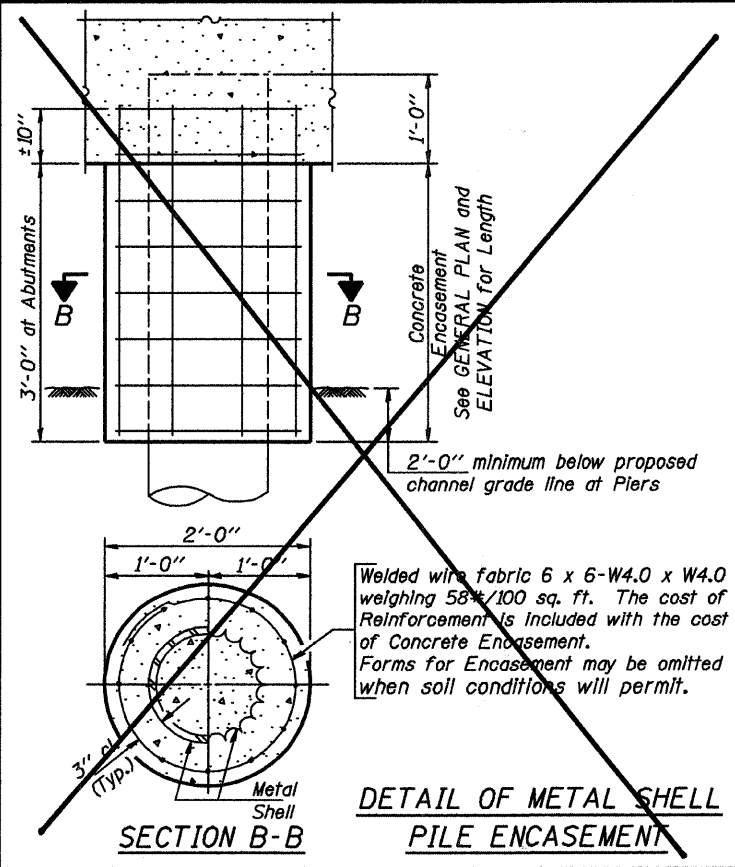

DETAIL OF METAL SHELL PILE ENCASEMENT

QUANTITIES/FT. OF ENCASEMENT (STEEL PILES)

Pile Size	Item	Quantity
HP8	Concrete Encasement	0.067 C.Y.
HP10	Concrete Encasement	0.086 C.Y.
HP12	Concrete Encasement	0.140 C.Y.


(METAL SHELL PILES)

Pile Size	Item	Quantity
12" Dia	Concrete Encasement	0.087 C.Y.

PILE DETAILS

STANDARD CX-1

ROUTE NO.	SECTION	COUNTY	TOTAL SHEETS	SHEET NO.
T.R. 78	03-02125-00-BR	FAYETTE	12	11
FED. AID PROJECT NO.		ILLINOIS	PROJECT	
CONTRACT NO. 95540				

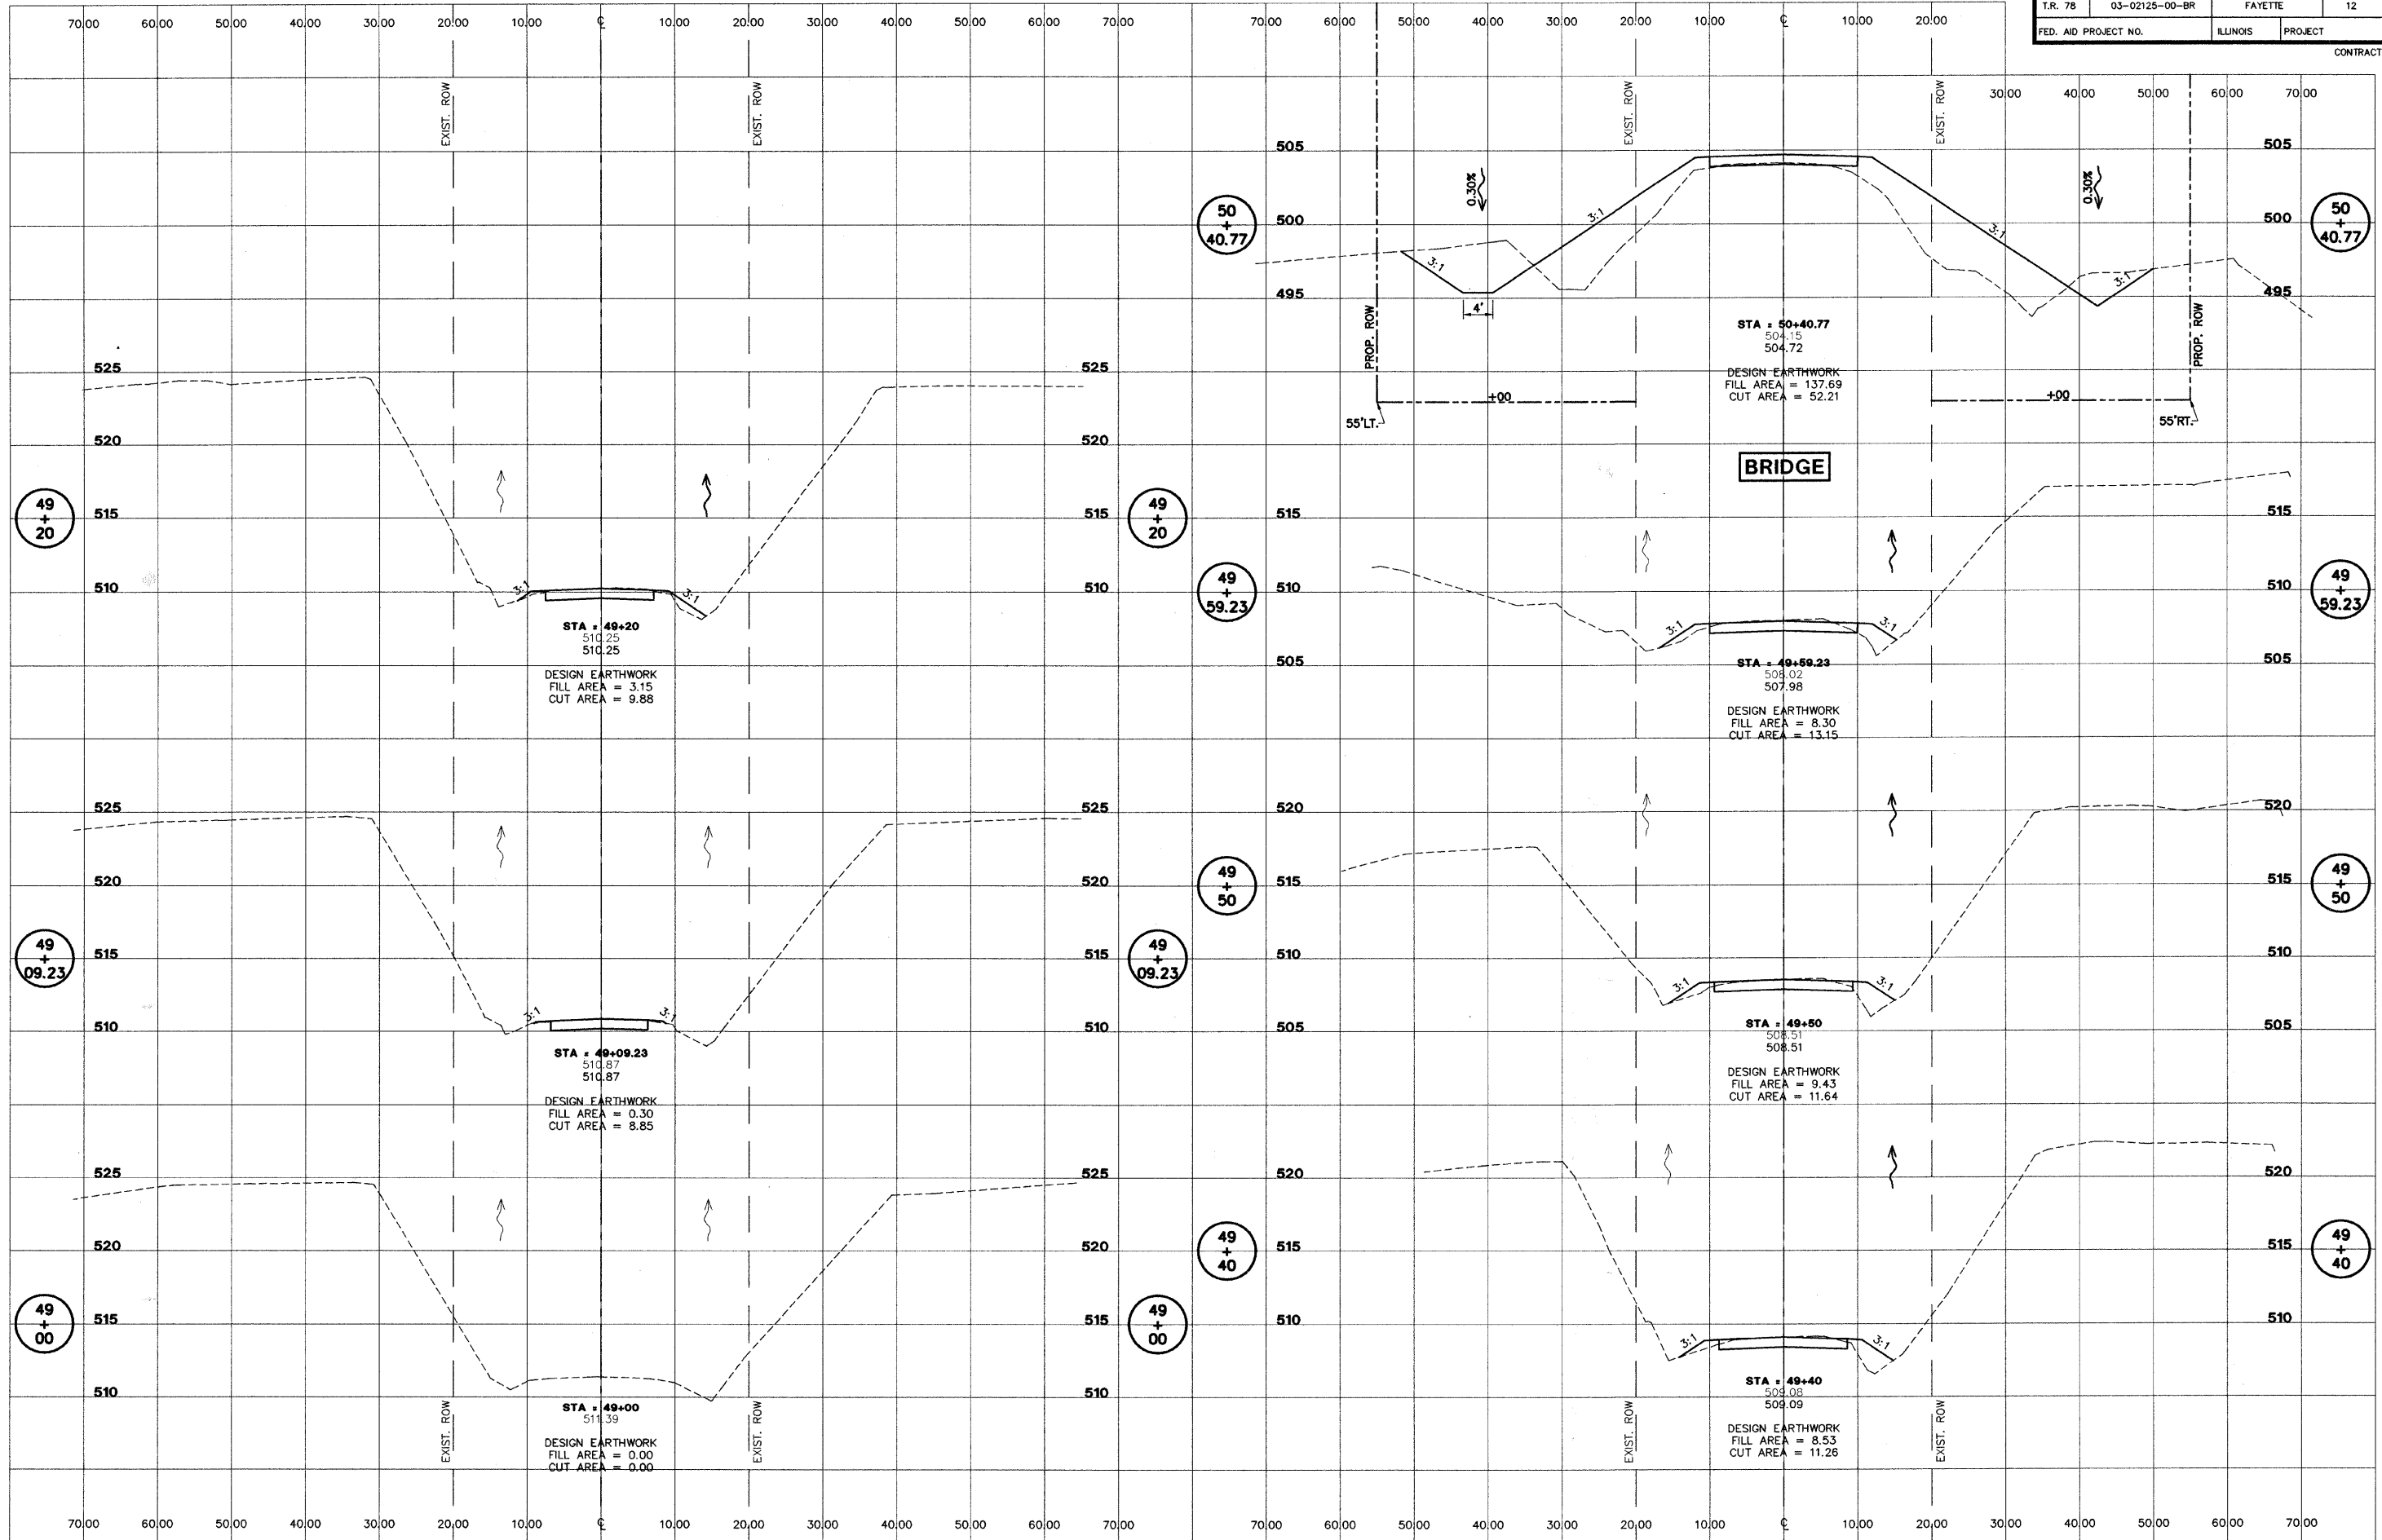


STS CONSULTANTS
 2524 South Broadway, P.O. Box 850
 Solem, Illinois 62881
 Ph (618) 548-3500
 Fax (618) 548-5246
 IL Design Firm Reg. No. 184-001518

T.R. 78, SECTION 03-02125-00-BR
BEAR GROVE ROAD DISTRICT
FAYETTE COUNTY, ILLINOIS

CROSS SECTIONS		DATE	
STA. 49+00 TO STA. 50+40.77		12/10/07	
SURVEY	JAS	CHECKED	DATE
DESIGN	MRQ	APPROVED	REVISION
DRAWN	JMW		JOB NO.
			200701115

L:\200701115\ep\rc001001.dwg, 12/11/2007 4:21:38 PM

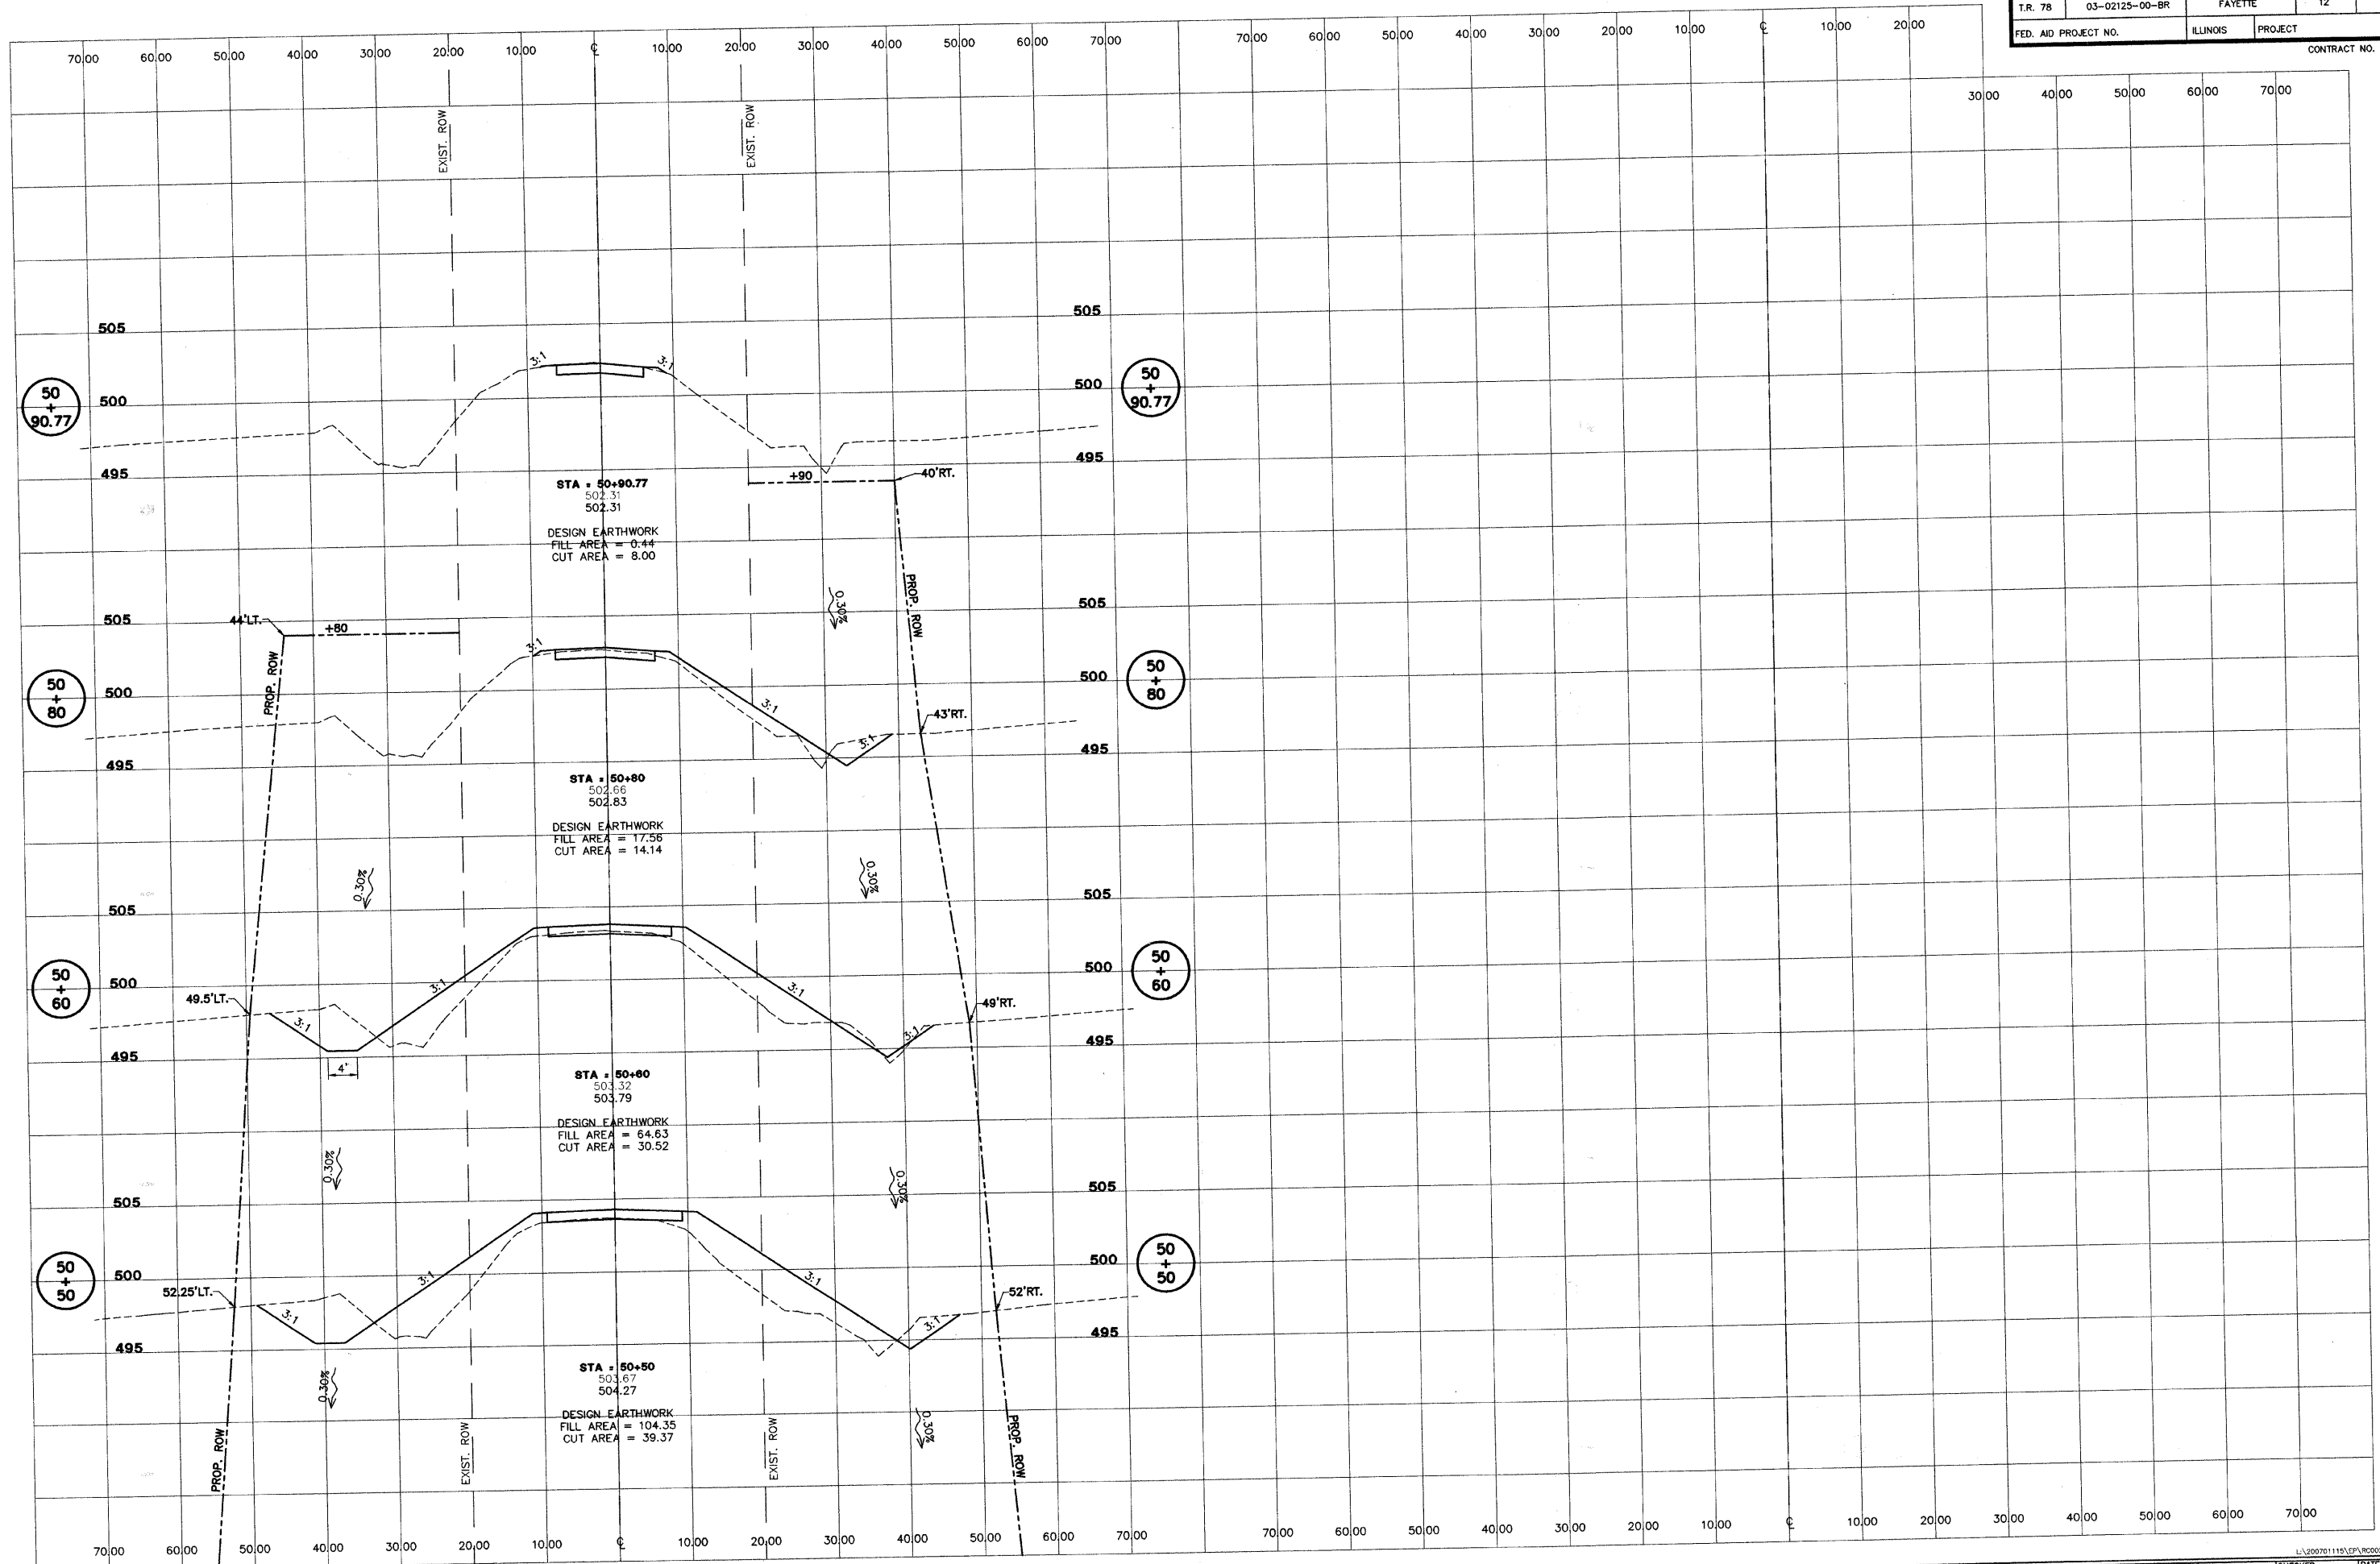

000701115\ep\c002001.dwg, 12/11/2007 4:22:36 PM



T.R. 78, SECTION 03-02125-00-BR
BEAR GROVE ROAD DISTRICT
FAYETTE COUNTY, ILLINOIS

CROSS SECTIONS
STA. 50+40.77 TO STA. 50+90.77

SURVEY	JAS	CHECKED	DATE
DESIGN	JMW	APPROVED	12/10/07
DRAWN	JMW		JOB NO.
			200701115

L:\200701115\EP\PC002001 12/11/07