
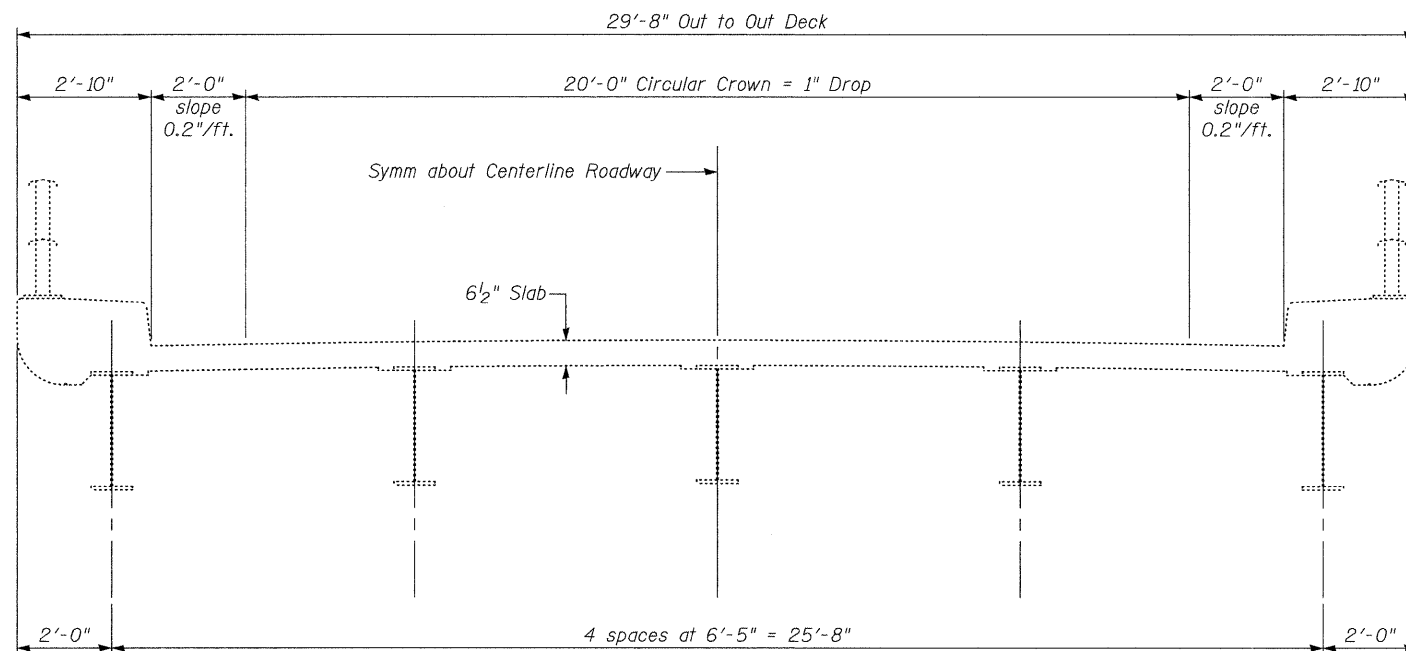



**DECK REPAIR PLAN**

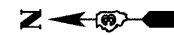

**TYPICAL SECTION**

**BILL OF MATERIALS**

ITEM	UNIT	QUANTITY
Deck Slab Repair (Full Depth, Type I)	Sq. Yd.	
Deck Slab Repair (Partial)	Sq. Yd.	

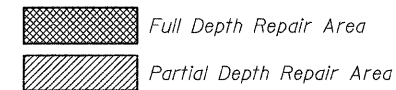

CHAMLIN & ASSOCIATES, INC. PERU, ILLINOIS

FILE NAME = 0500130-66A48-ABDECK-003.DGN

USER NAME =

DESIGNED - JKC

REVISED -

CHECKED - AJO

DRAWN - LAG

REVISED -

PLOT DATE =

CHECKED - JKC

REVISED -

**STATE OF ILLINOIS  
DEPARTMENT OF TRANSPORTATION**

**AS-BUILT DECK REPAIR PLAN  
STRUCTURE NO. 050-0130**

SHEET NO. 3 OF 3 SHEETS

F.A.I. RTE.

80

SECTION

(50-2,4)RS-5 & (50-3)RS-6

COUNTY

LASALLE

TOTAL SHEETS

109

SHEET NO.

73

CONTRACT NO. 66A48

ILLINOIS FED. AID PROJECT