

AS BUILT PLANS

OFFICE COPY RE: M. Diggins

STATE OF ILLINOIS
DEPARTMENT OF TRANSPORTATION
DIVISION OF HIGHWAYS

PLANS FOR PROPOSED
FEDERAL AID HIGHWAY

F.A. RTE.	SECTION	COUNTY	TOTAL SHEETS	SHEET NO.
116	113 VBR	CUMBERLAND	26	1


ILLINOIS PROJECT
A-95-021-18

FOR INDEX OF SHEETS, SEE SHEET NO.5
FOR SUMMARY OF QUANTITIES, SEE SHEET NO.6

SCALES
PLAN 1"=20'
PROFILE HORIZ. 1"=20'
PROFILE VERT. 1"=5'
CROSS SECTIONS 1"=10' (HORIZ.)
1"=5' (VERT.)

F.A. ROUTE 116
SECTION 113 VBR
PROJECT BR-F-116(17)
CUMBERLAND COUNTY

C-95-090-80
BRIDGE RECONSTRUCTION

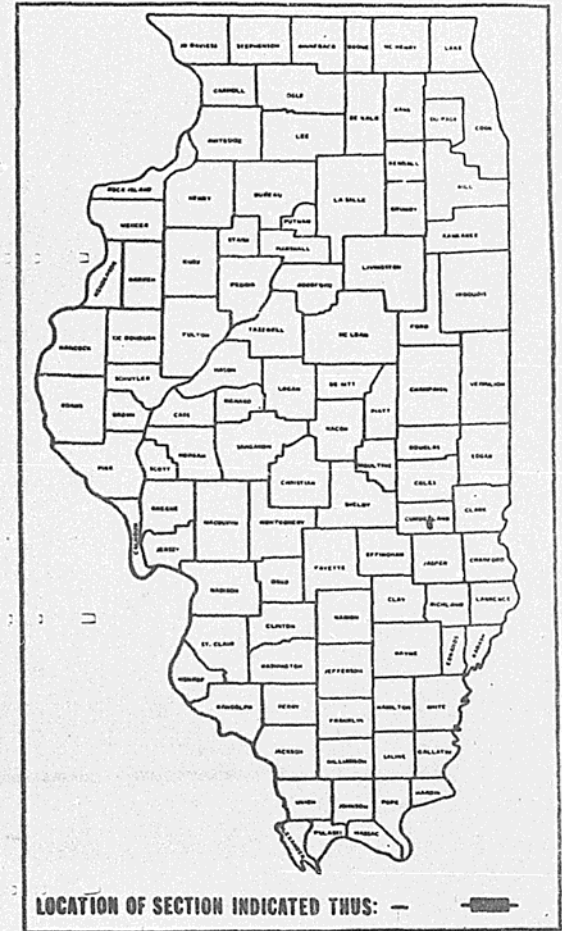

51 7/4

PROJECT BR-F-116(17) &
SECTION 113 VBR BEGINS
STATION 497+00

PROJECT BR-F-116(17) &
SECTION 113 VBR ENDS
STATION 500+25



STRUCTURE 113VBR: THE CONSTRUCTION OF A THREE SPAN STRUCTURE
CROSSING F.A. ROUTE 116 OVER THE CONDUIT TUBES AT STATION
498+60.60 CONSISTING OF A 74' REINFORCED CONCRETE BEAM
ON STEEL I BEAMS ON WIDENED AND RECONSTRUCTED CONCRETE
ABUTMENTS AND PILES. SPANS 1 @ 38'-0" & 2 @ 41'-9 1/2";
ROADWAY WIDTH 32'-0"; SKEW 15°-23'-30."

TOTAL LENGTH OF SECTION 113VBR = 325.00 FEET = 0.062 MILES
NET LENGTH OF SECTION 113VBR = 325.00 FEET = 0.062 MILES
TOTAL LENGTH OF PROJECT BR-F-116(17) = 325.00 FEET = 0.062 MILES
NET LENGTH OF PROJECT BR-F-116(17) = 325.00 FEET = 0.062 MILES



345-6404

CONTRACT NO. 34800

CALL J.U.L.I.E. BEFORE YOU DIG
TELEPHONE NO. 800-892-0123
(GREENUP TOWNSHIP)

STATE OF ILLINOIS
DEPARTMENT OF TRANSPORTATION
DIVISION OF HIGHWAYS

SUBMITTED: 6-6-80 11:30
A. E. Christ DISTRICT ENGINEER

REQUIRED: 10-14-80 10:50
R. W. Wilson ENGINEER OF PLANS AND CONTRACTS

PASSED: 10-14-80 10:50
Thomas R. Bright ENGINEER OF DESIGN


APPROVED: 10-14-80 10:50
John J. Morrison DIRECTOR, DIVISION OF HIGHWAYS

U.S. DEPARTMENT OF TRANSPORTATION
FEDERAL HIGHWAY ADMINISTRATION

APPROVED _____
DIVISION ADMINISTRATOR DATE

ROUTE NO.	SEC.	COUNTY	TOTAL SHEETS	SHEET NO.
F.R.116	13VBR	CUMBERLAND	26	2
FED. ROAD DIST. NO. 9 ILLINOIS			PROJECT	


EXISTING TYPICAL CROSS SECTION

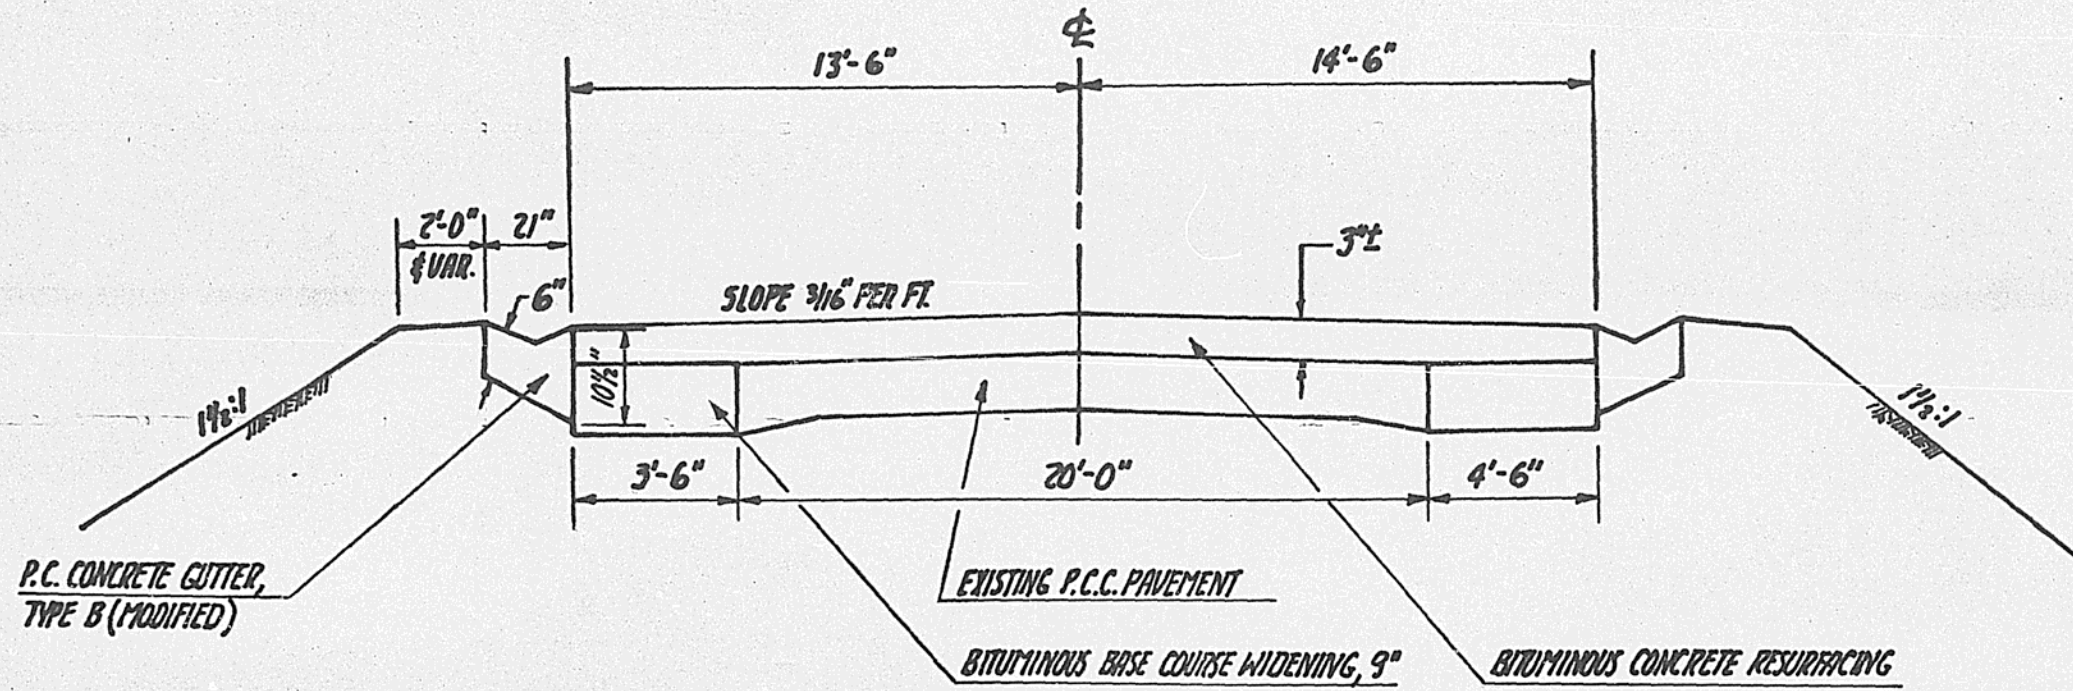

PROPOSED TYPICAL CROSS SECTION

STATION 497+00 TO STATION 497+72.88
 STATION 499+48.32 TO STATION 500+25

ROUTE NO.	SECTION	COUNTY	TOTAL SHEETS	SHEET NO.
S.B. I F.A. 116	113 132P	CUMBERLAND	26	3

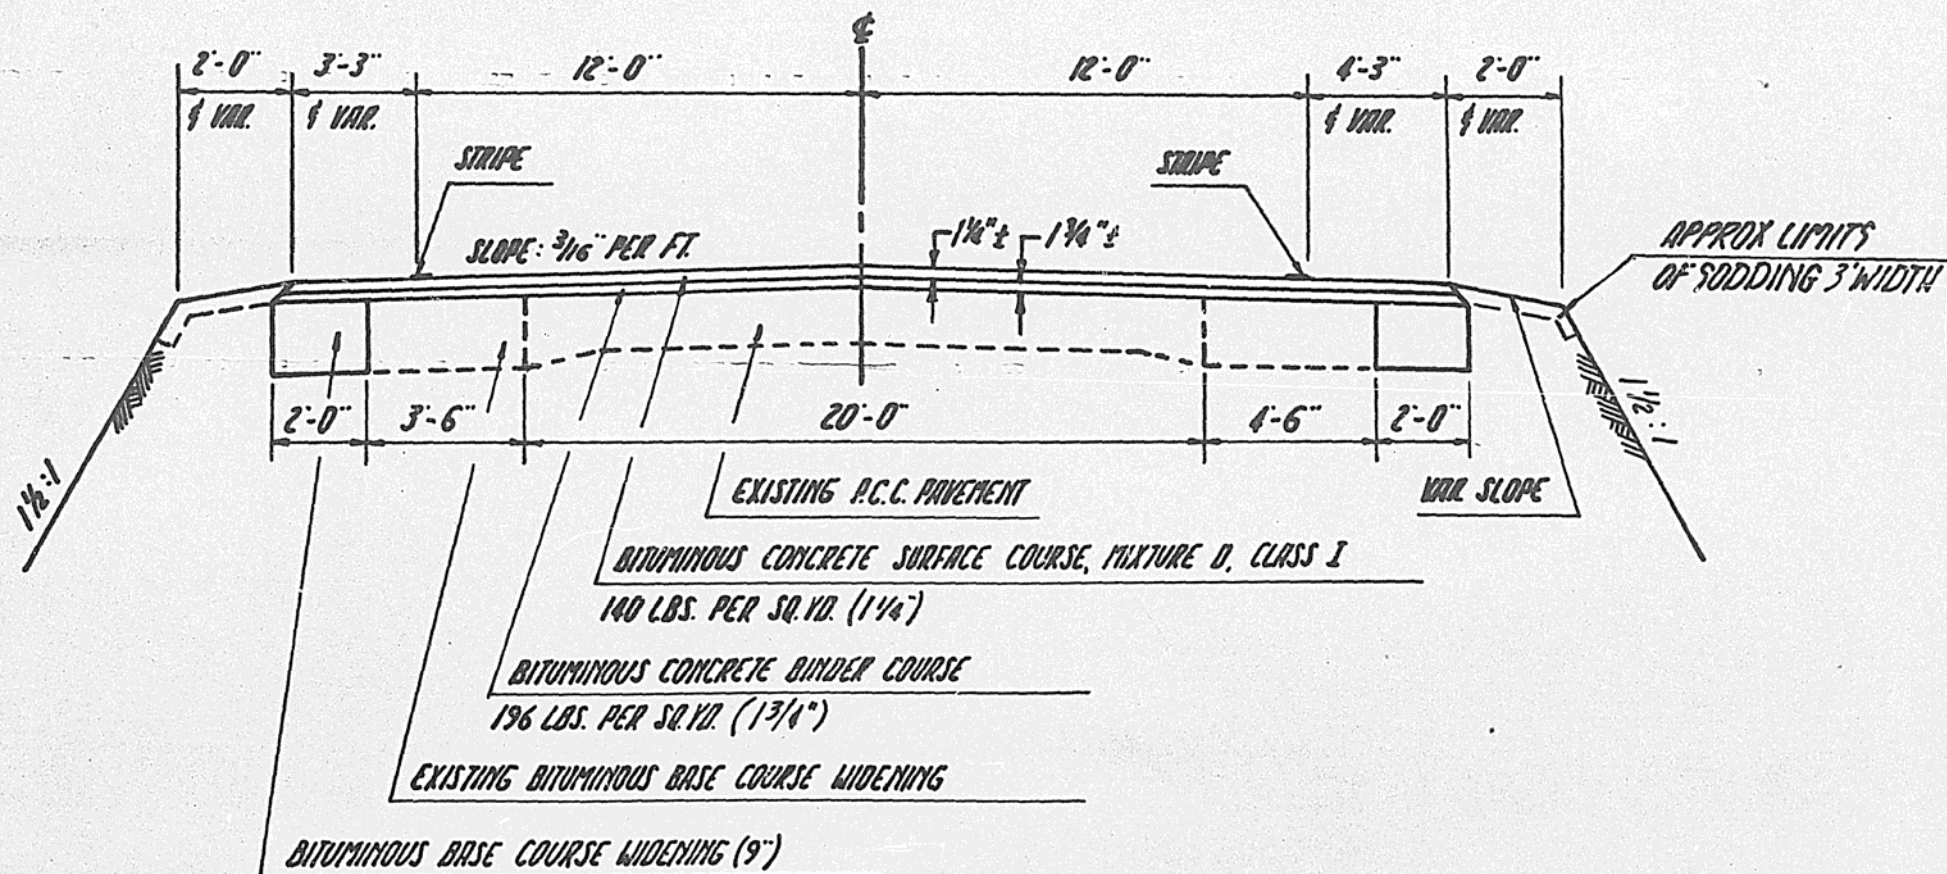


NOTE: EXISTING BITUMINOUS SURFACE & EXISTING GUTTER TO BE REMOVED

Proposed Typical Cross Section

STATION 497+72.88 TO STATION 497+96.46
STATION 499+24.74 TO STATION 499+48.32

ROUTE NO.	SECTION	COUNTY	TOTAL SHEETS	SHEET NO.
S.B.L. F.A. 116	113 VBR	CUMBERLAND	26	4

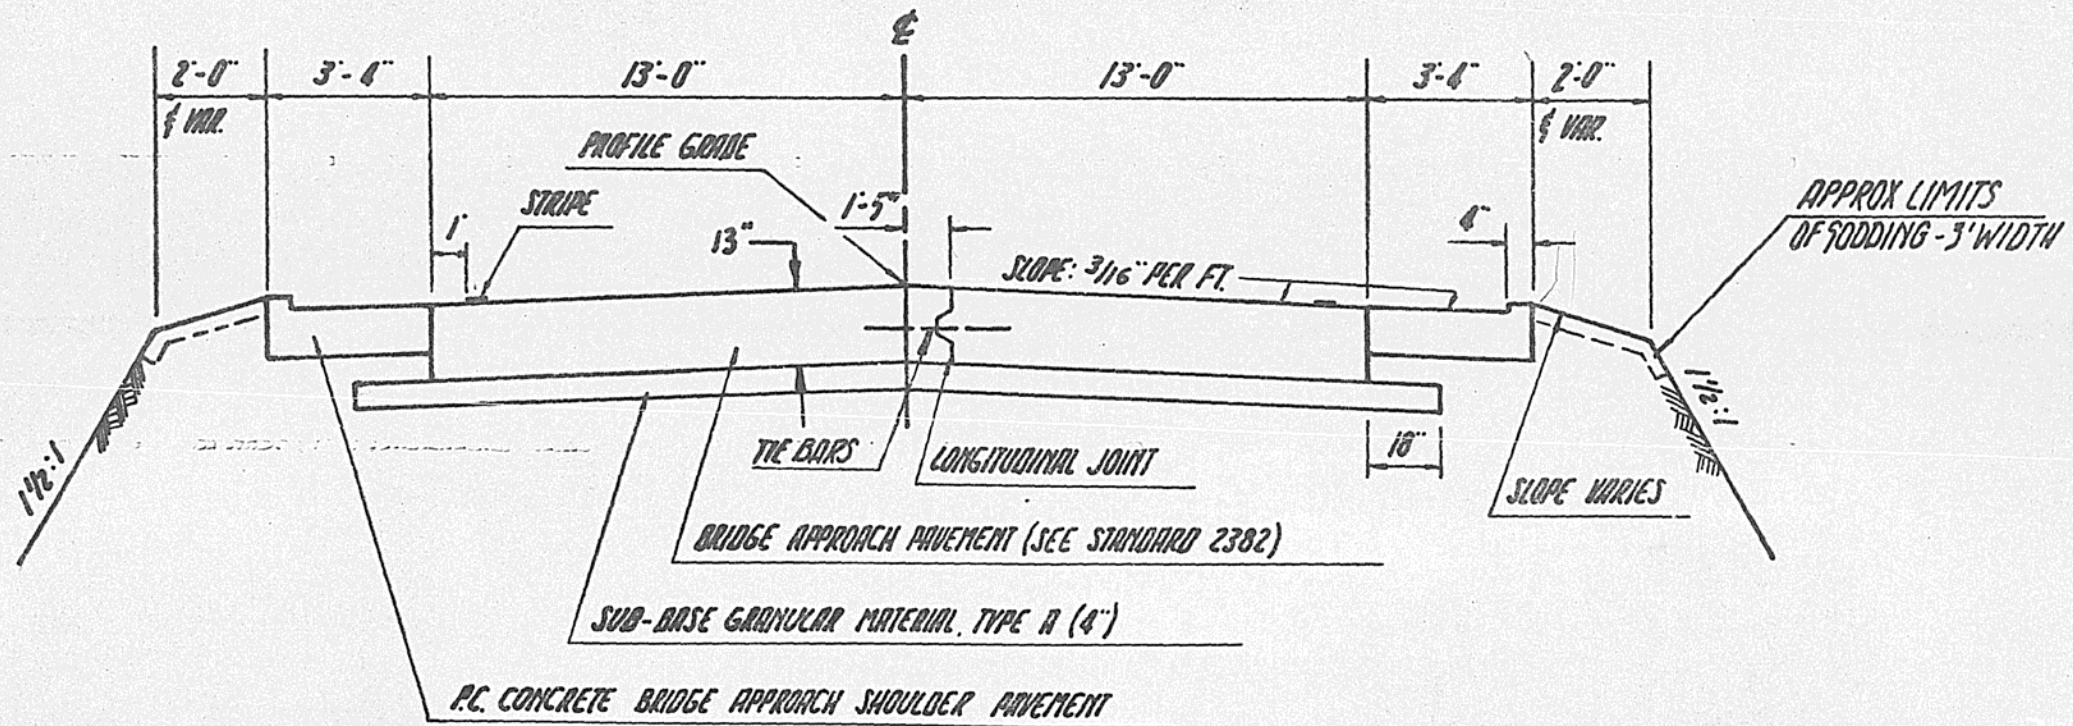

ROUTE NO.	SECTION	COUNTY	TOTAL SHEETS	SHEET NO.
# 116	11.3VER	CUMBERLAND	26	5

INDEX OF SHEETS

<u>SHEET NO.</u>	<u>CONTENTS</u>
1.	COVER SHEET
2.-4. (INCL)	TYPICAL CROSS SECTIONS
5.	INDEX OF SHEETS AND GENERAL NOTES
6.	SUMMARY OF QUANTITIES
7.	PLAN & PROFILE SHEET
8.	STAGE I DETAILS
9.	STAGE II DETAILS
10.	TYPICAL APPLICATION OF TRAFFIC CONTROL DEVICES
11.	TYPICAL APPLICATION OF TRAFFIC CONTROL DEVICES FOR ROAD CLOSURE
12.-24. (INCL)	BRIDGE PLANS
25.-26.	CROSS SECTIONS
	<u>STANDARDS</u>
1686-4	SYMBOLS AND ABBREVIATIONS
2113-2	NAME PLATE FOR BRIDGES
2135	PERMANENT SURVEY MARKERS
2228-4	METAL END SECTION
2230-13	STEEL PLATE BEAM GUARDRAIL
2239-6	WIDENING AND SHOULDERS FOR PAVEMENT RESURFACING
2258-5	TYPICAL APPLICATION OF TRAFFIC CONTROL DEVICES
2259-8	DESIGN OF TRAFFIC CONTROL DEVICES
2300-2	FLAGMAN TRAFFIC CONTROL SIGN
2301-3	TYPICAL APPLICATION OF TRAFFIC CONTROL DEVICES (CASE I)
2302-4	TYPICAL APPLICATION OF TRAFFIC CONTROL DEVICES (CASE II)
2303-5	TYPICAL APPLICATION OF TRAFFIC CONTROL DEVICES (CASE III)
2305-4	TYPICAL APPLICATION OF TRAFFIC CONTROL DEVICES (CASE V)
2306-4	TYPICAL APPLICATION OF TRAFFIC CONTROL DEVICES (CASE VI)
2307-4	TYPICAL APPLICATION OF TRAFFIC CONTROL DEVICES (CASE VII)
2323-5	PAVEMENT JOINTS
2324-5	BRIDGE APPROACH SHOULDER PAVEMENT
2341-1	TRAFFIC BARRIER TERMINAL TYPE 6
2382-1	BRIDGE APPROACH PAVEMENT
2383-1	TEMPORARY CONCRETE BARRIER
2388-1	TRAFFIC BARRIER TERMINAL TYPE 11

GENERAL NOTES

EARTHWORK QUANTITIES FOR THE ENTIRE SECTION:

EMBANKMENT:	104 CU. YDS.
EARTH EXCAVATION:	23 CU. YDS.
STRUCTURE EXCAVATION:	95 CU. YDS.
BORROW:	16 CU. YDS.

FERTILIZER NUTRIENT APPLICATION RATES FOR SODDING AND SEEDING:

NITROGEN AT 60 LBS. PER ACRE
PHOSPHORUS AT 200 LBS PER ACRE
POTASSIUM AT 60 LBS PER ACRE

STATE OF ILLINOIS
DEPARTMENT OF TRANSPORTATION
DISTRICT FIVE

REVIEWED BY:

J. G. Collins
DISTRICT ENGINEER OF DESIGN

DATE:

6-6-80

EXAMINED:

Charles D. DeRosa
DISTRICT ENGINEER OF CONST.

D. J. Anderson
DISTRICT ENGINEER OF MAINT.

J. B. Benson
DISTRICT ENGINEER OF PLANNING

D. R. Eusebio
DISTRICT ENGINEER OF TRAFFIC

SUMMARY OF QUANTITIES

ROUTE NO.	SECTION	COUNTY	TOTAL SHEETS	SHEET NO.
116	1137R	CUMBERLAND	26	6

CODE NO.	ITEM	UNIT	ACTUAL TOTAL QUANTITY PLACED	STRUCTURE 1137R	ROADWAY STA. 497+00.0 TO STA. 500+25.0	EROSION CONTROL	SAFETY CLASSIFICATION CODE	CONSTRUCTION TYPE CODE
207001	EMBANKMENT	CU.YD.	86		104			
306004	BITUMINOUS CONCRETE BASE COURSE WIDENING (9 IN)	SQ.YD.	66		66			
406001	BITUMINOUS MATERIALS (PRIME COAT)	GALLON	45		45			
406007	BITUMINOUS CONCRETE BINDER COURSE	TON	121		92			
406013	BITUMINOUS CONCRETE SURFACE COURSE, MIXTURE D; CLASS I	TON	38		37			
408012	BRIDGE APPROACH PAVEMENT (STANDARD 2382)	SQ.YD.	136		136.2			
408015	P.C. CONCRETE BRIDGE APPROACH SHOULDER PAVEMENT	SQ.YD.	34		31			
501048	REMOVAL OF EXISTING CONCRETE DECK	L.SUM	1	1				
501024	CONCRETE REMOVAL	CU.YD.	4	4				
501029	EXPANSION BOLTS, 3/4 INCH	EACH	199	204				
502001	STRUCTURE EXCAVATION	CU.YD.	95	95				
503003	PROTECTIVE COAT	SQ.YD.	727	560	167			
504003	CLASS X CONCRETE	CU.YD.	183.7	183.7				
507001	FURNISHING AND ERECTING STRUCTURAL STEEL	L.SUM	1	1				
507005	STUD SHEAR CONNECTORS	EACH	2,214	2,214				
509003	CLEANING AND PAINTING STEEL BRIDGE	L.SUM	1	1				
511759	END SECTIONS (12 IN.)	EACH	4		4			
512001	REINFORCEMENT BARS	POUND	26,523	19,580	6,943			
512002	REINFORCEMENT BARS (EPOXY COATED)	POUND	16,480	16,480				
513014	FURNISHING STEEL PILES .HP 10x42	LIN.FT.	183	154				
513027	DRIVING STEEL PILES	LIN.FT.	183	154				
514001	NAME PLATES	EACH	1	1				
601014	RIPRAP	SQ.YD.	387	350				
607005	TYPE DRAINS (12 IN.)	LIN.FT.	245		274			
612470	TYPE C INLET BOX, STANDARD 2324	EACH	4		4			
X61640	TEMPORARY CONCRETE BARRIER	LIN.FT.	0	430				
X61641	TEMPORARY CONCRETE BARRIER, TERMINAL SECTION	EACH	0	2				
X61642	RELOCATE TEMPORARY CONCRETE BARRIER	LIN.FT.	304	374				
617001	PAVEMENT REMOVAL	SQ.YD.	151		145			
617004	GUTTER REMOVAL	LIN.FT.	298		298			
617010	BITUMINOUS CONCRETE SURFACE REMOVAL	SQ.YD.	447		448			
620016	PAVEMENT REMOVAL AND BITUMINOUS REPLACEMENT, TYPE I (9 IN.)	SQ.YD.	4		20			
X62844	TRAFFIC BARRIER TERMINAL, TYPE 6	EACH	4		4			
X62875	TRAFFIC BARRIER TERMINAL, TYPE 11	EACH	2	2				
633003	STEEL PLATE BEAM GUARD RAIL REMOVAL	LIN.FT.	82		82			
633010	REMOVE AND RE-ERECT STEEL PLATE BEAM GUARD RAIL	LIN.FT.	156		152			
644001	SODDING	SQ.YD.	0		204			
644002	SUPPLEMENTAL WATERING	UNIT	0		2			
646004	ENGINEER'S FIELD OFFICE, TYPE A	CAL.NO	0	4				
647001	PAVEMENT MARKING TAPE	LIN.FT.	32		12			
648018	TRAFFIC CONTROL AND PROTECTION (SPECIAL)	L.SUM	1	1				
X64851	TRAFFIC CONTROL AND PROTECTION, STANDARD 2303	L.SUM	1	1				
210295	PERMANENT BENCH MARKS	EACH	1	1				
X09728	TEMPORARY BRIDGE RAIL	LIN.FT.	325	128	197			
X50313	PREPARED JOINT SEAL (2 1/2 IN.)	LIN.FT.	74	74				
X50315	ELASTOMERIC BEARING ASSEMBLY, TYPE I	EACH	8	8				
X04748	MOBILIZATION	L.SUM	1	1				
X21232	CONCRETE THRUST BLOCKS	EACH	4		4			
X95521	TRANS & ERECT TEMP CONC BARR.	LINE FT	430					
X95522	TRANS & ERECT TEMP CONC BAR TERM SEC.	EACH	2					
XX040	Value ENG. INCENTIVE	DOLLARS	2,339.50					
X95633	DEACT CA NO3 CL. X PARAPET	CU.YD	25.7					
FRC003	RE HAB STRUCT STEEL	DOLLARS	34,100.52					
X95654	BIT. ANTI STRIP AGENT	TONS	38					
X95655	RAIL ROAD FLAGMAN	DOLLARS						
FRC05A	SPLICE STEEL ALING	DOLLARS	614.90					
FRC05B	MOVE TRAFFIC SIGNALS	DOLLARS	206.13					
FRC05C	RAILROAD BALLAST AROUND PIERS	DOLLARS	2,691.47					
XX024	PRICE ADS. FOR FUEL	DOLLARS	4,485.55					

CODE NO.	Item	UNIT	ACTUAL QUANTITY PLACED
XX0230	PRICE ADJ. FOR BITUMINOUS	DOLLARS	374.86
642010	SEEDING II SPECIAL	ACRES	0.2
620017	PAVT REM & REPL TY 2 9	SOYB	2.0

ROUTE NO.	SEC.	COUNTY	TOTAL SHEETS	SHEET NO.
EA. 116	VIEN	CAYUGA	26	7
FED. ROAD DIST. NO. 9 ILLINOIS			PROJECT	

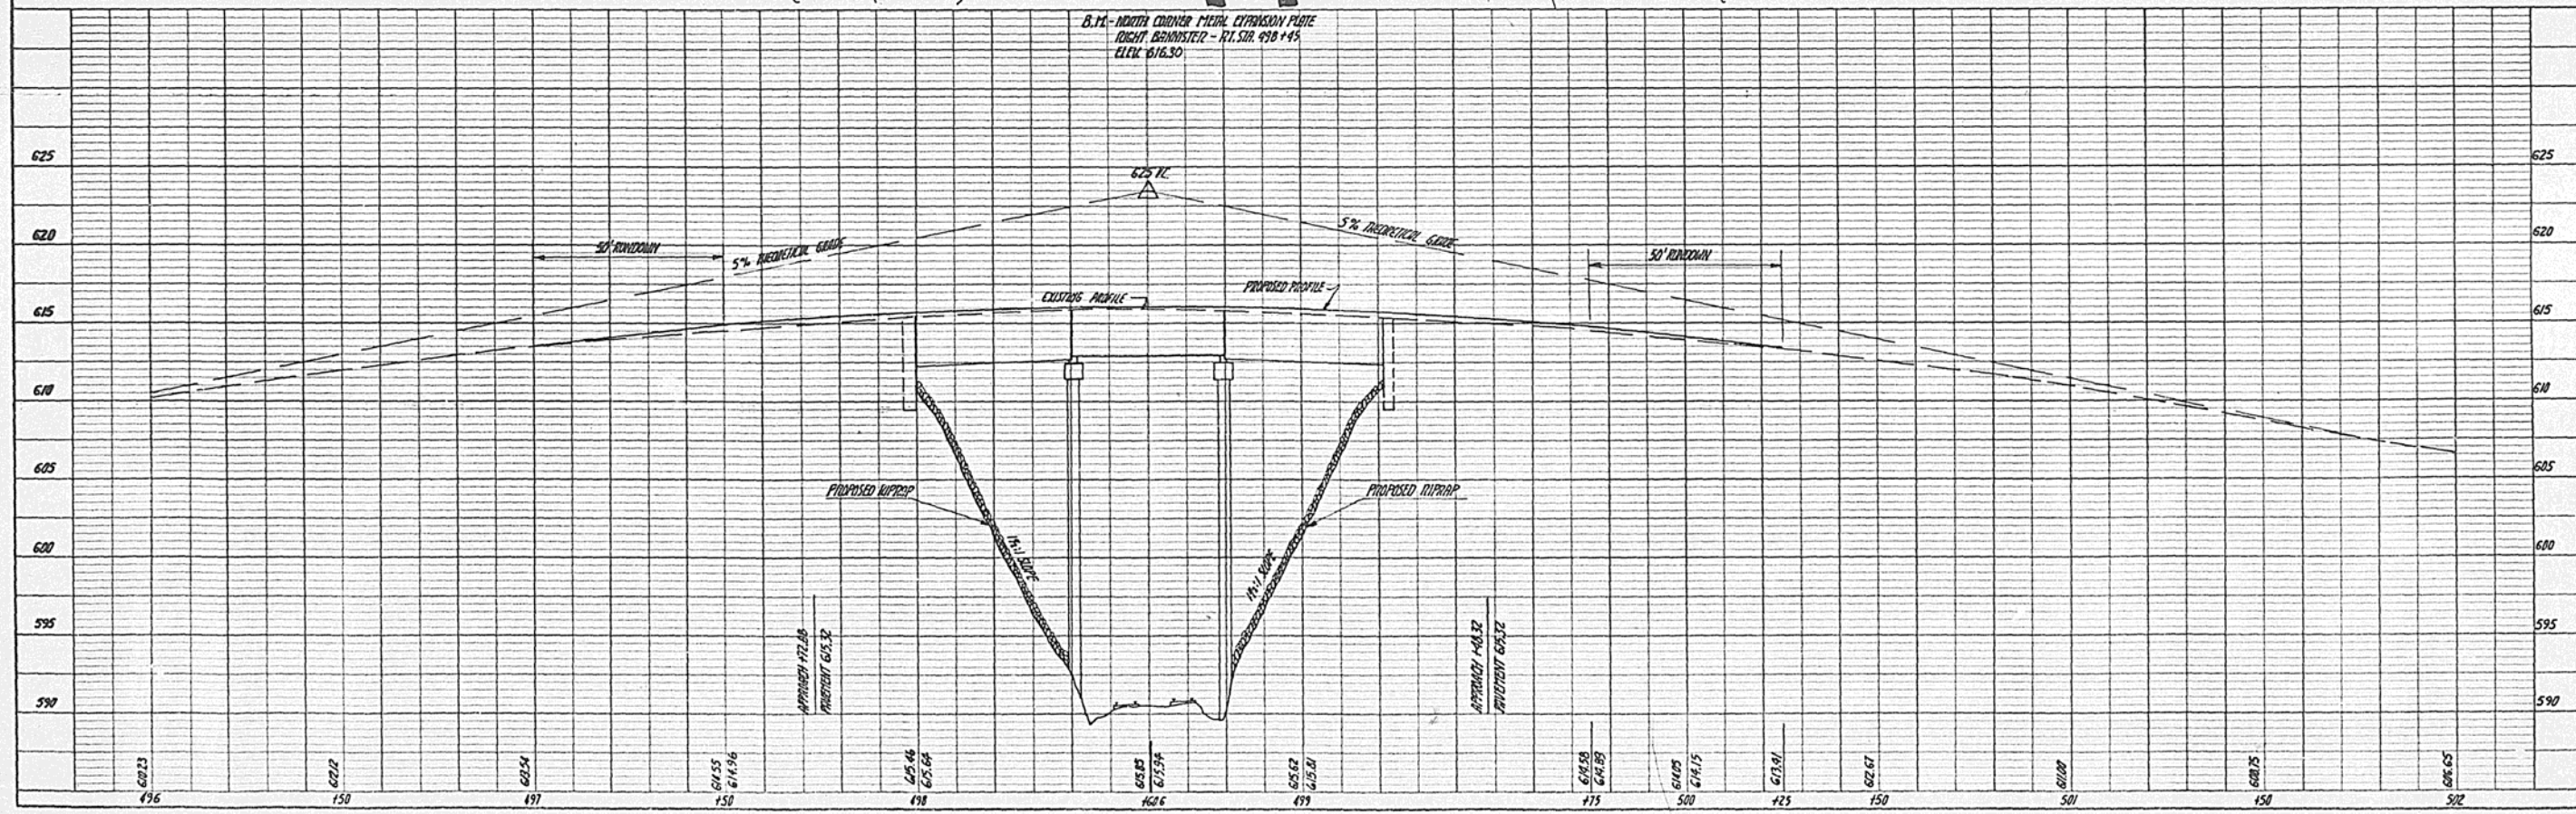
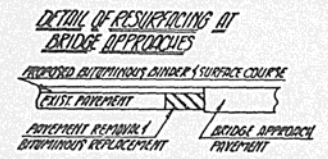
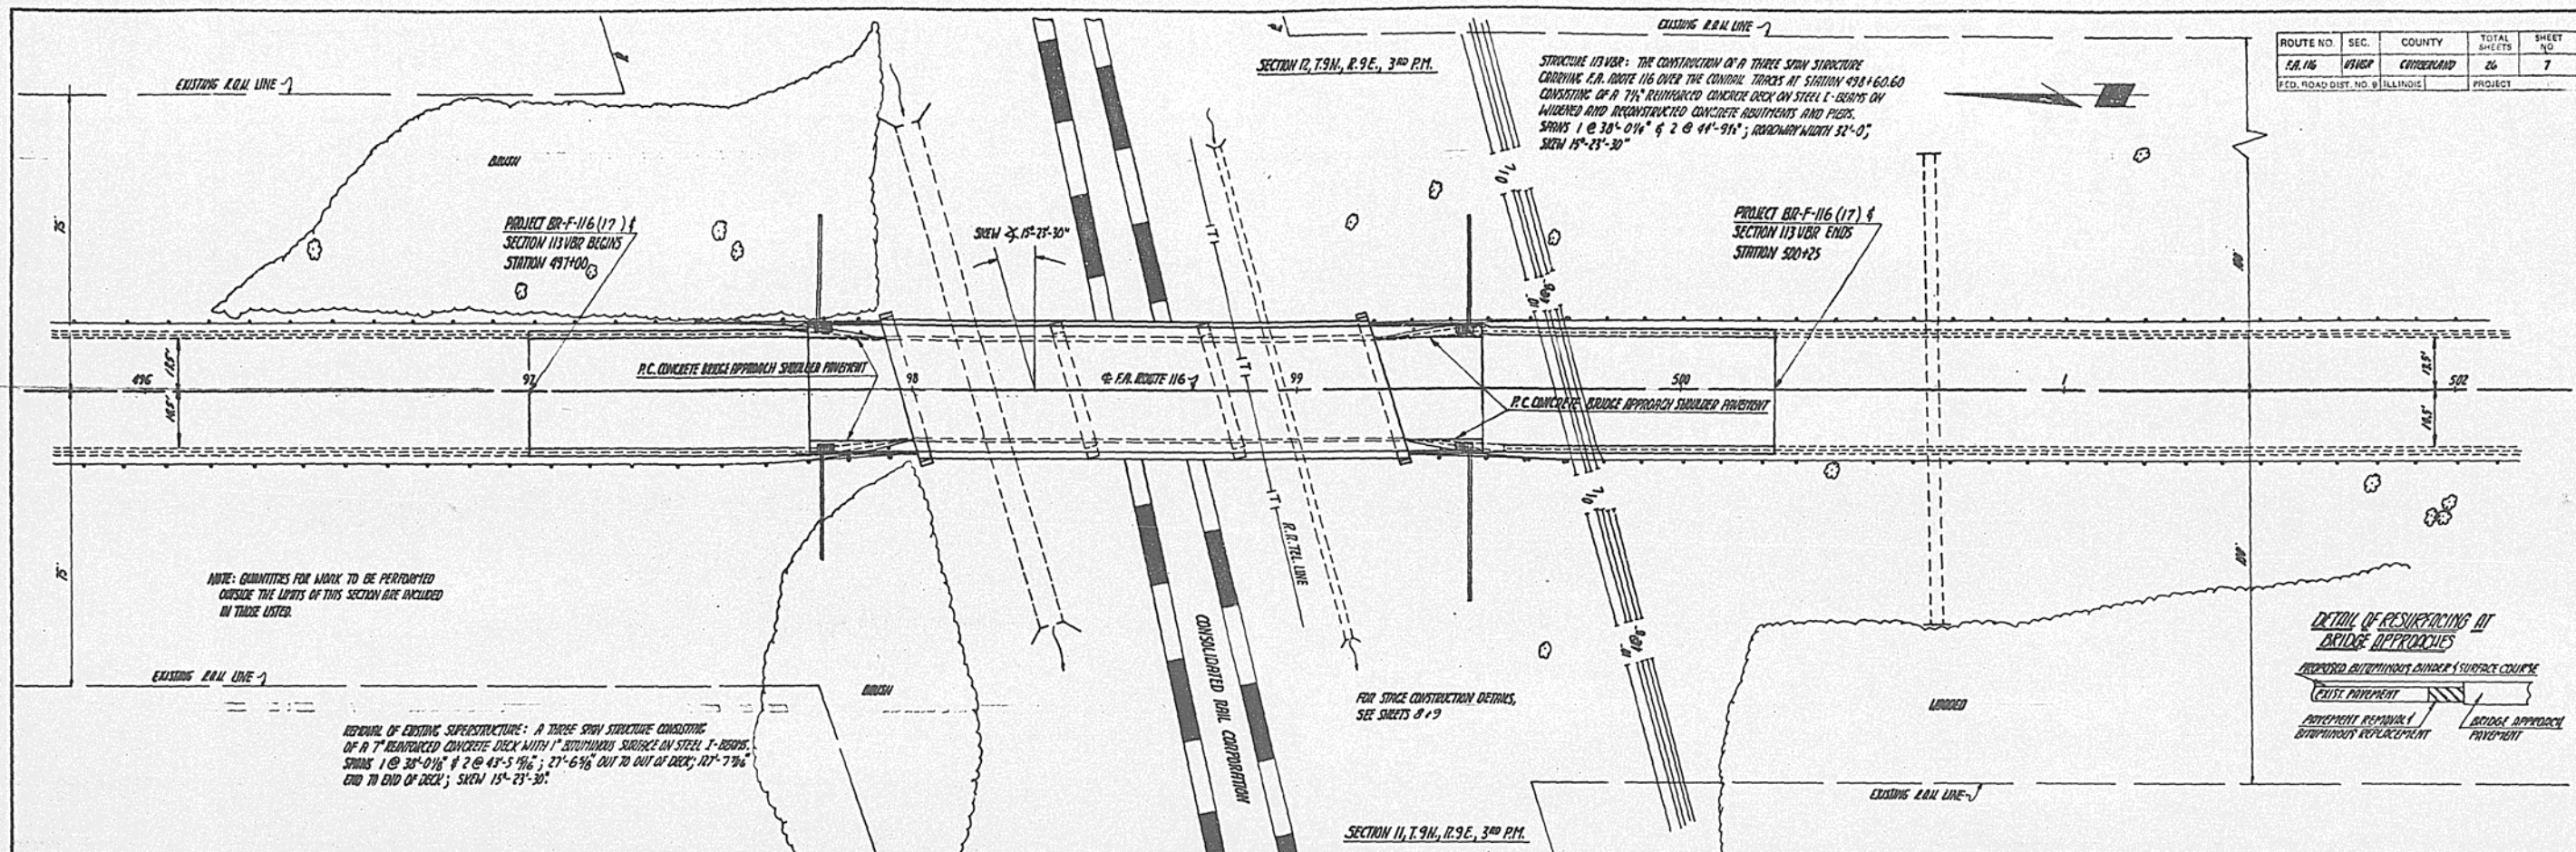


PLATE 1 PLAN-PROFILE B.P.R. STANDARD
 ENGINE DESIGN CO. CHICAGO, ILL. 60601

PLANS


DATE	
BY	
DESIGNED BY	
CHECKED BY	
IN CHARGE	
NO.	

PROFILE

DATE	
BY	
DESIGNED BY	
CHECKED BY	
IN CHARGE	
NO.	


ROUTE NO.	SEC.	COUNTY	TOTAL SHEETS	SHEET NO.
F.A. 116	8100	CUMBERLAND	26	8
FED. ROAD DIST. NO. 9 ILLINOIS			PROJECT	

STAGE I

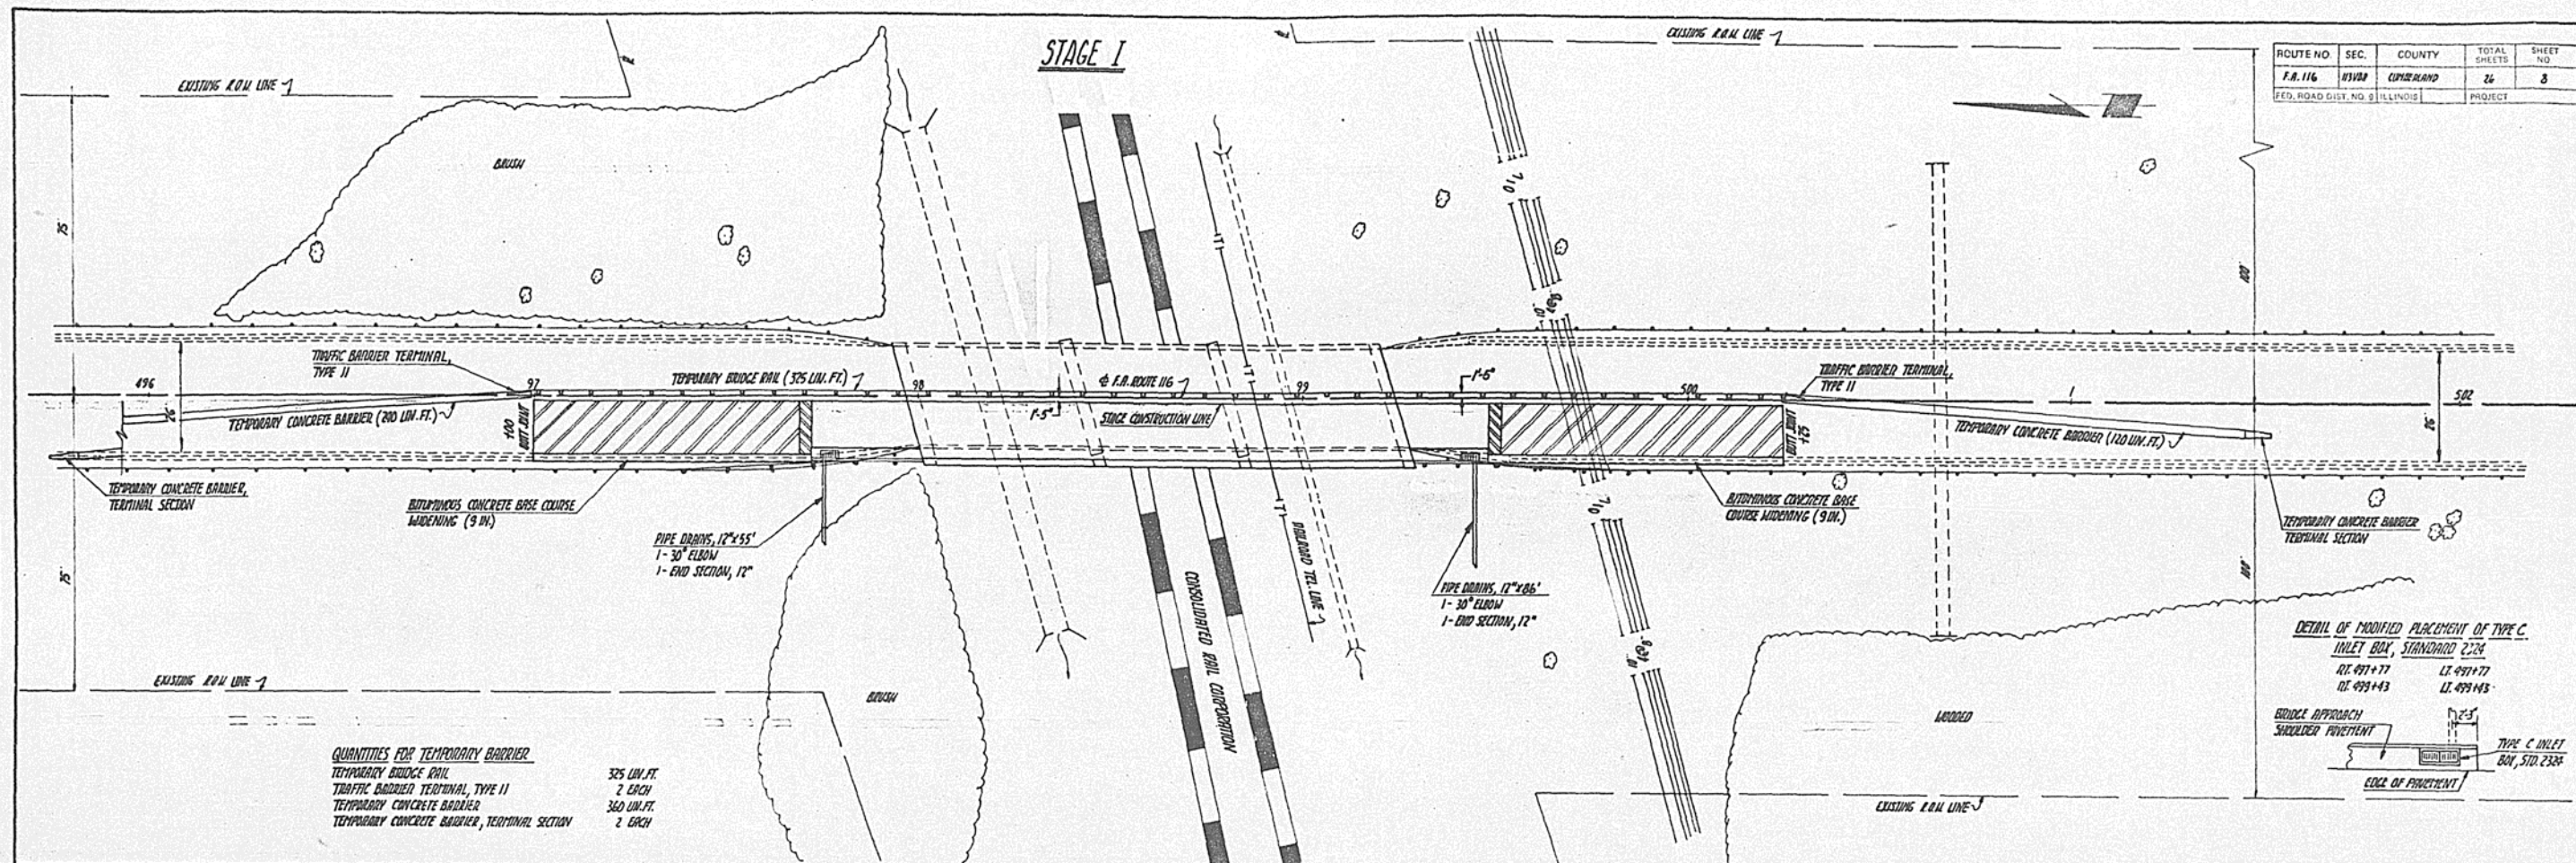

QUANTITIES FOR TEMPORARY BARRIER

TEMPORARY BRIDGE RAIL	325 LIN. FT.
TRAFFIC BARRIER TERMINAL, TYPE II	2 EACH
TEMPORARY CONCRETE BARRIER	300 LIN. FT.
TEMPORARY CONCRETE BARRIER, TERMINAL SECTION	2 EACH

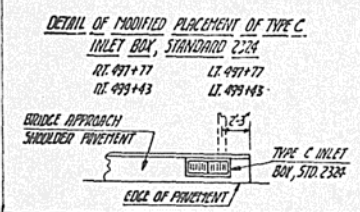

PLAN

DATE: _____

BY: _____

REVISIONS:

NO. 1: _____

NO. 2: _____

NO. 3: _____

NO. 100: _____

PROFILE

DATE: _____

BY: _____

REVISIONS:

NO. 1: _____

NO. 2: _____

NO. 3: _____

NO. 100: _____



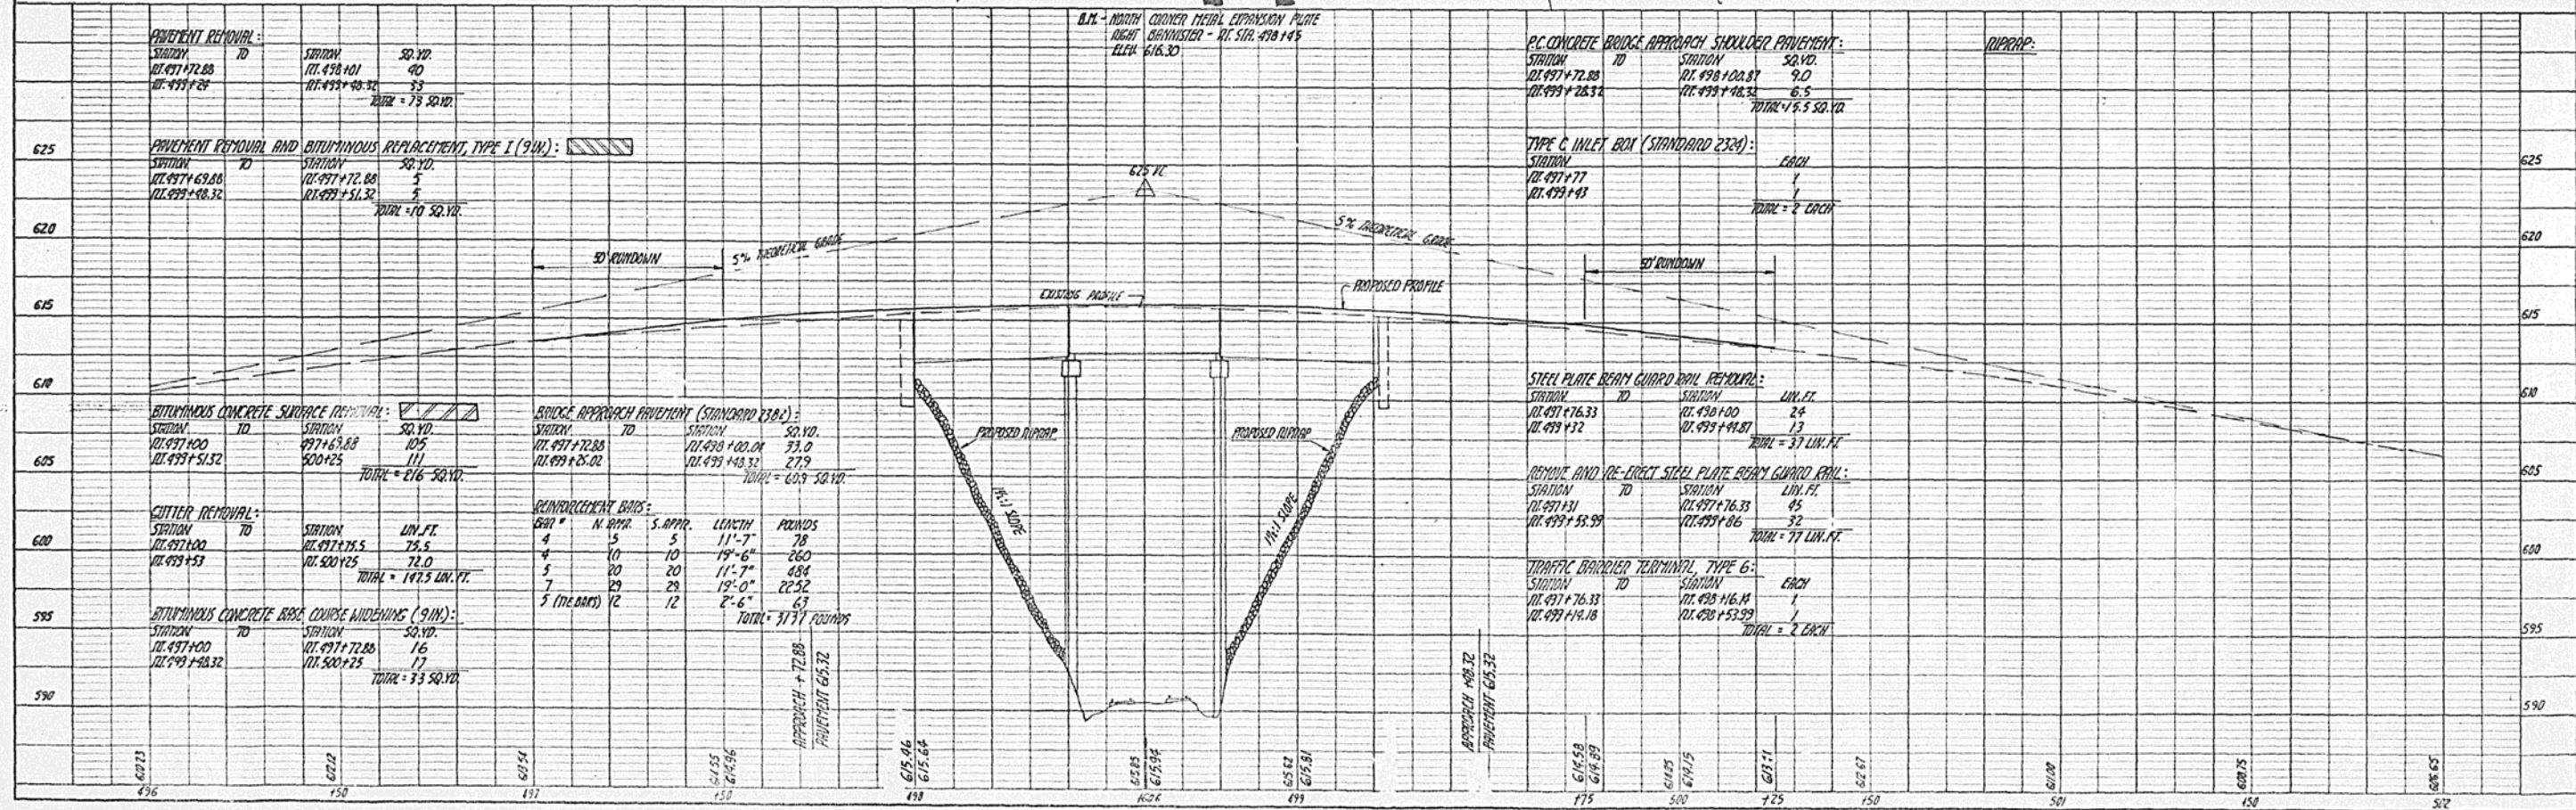


PLATE 1 PLAN-PROFILE D.P.R. STANDARD

ROUTE NO.	SEC.	COUNTY	TOTAL SHEETS	SHEET NO.
EA 116	1318A	CONDERLAND	26	9
FED. ROAD DIST. NO. 8 ILLINOIS			PROJECT	

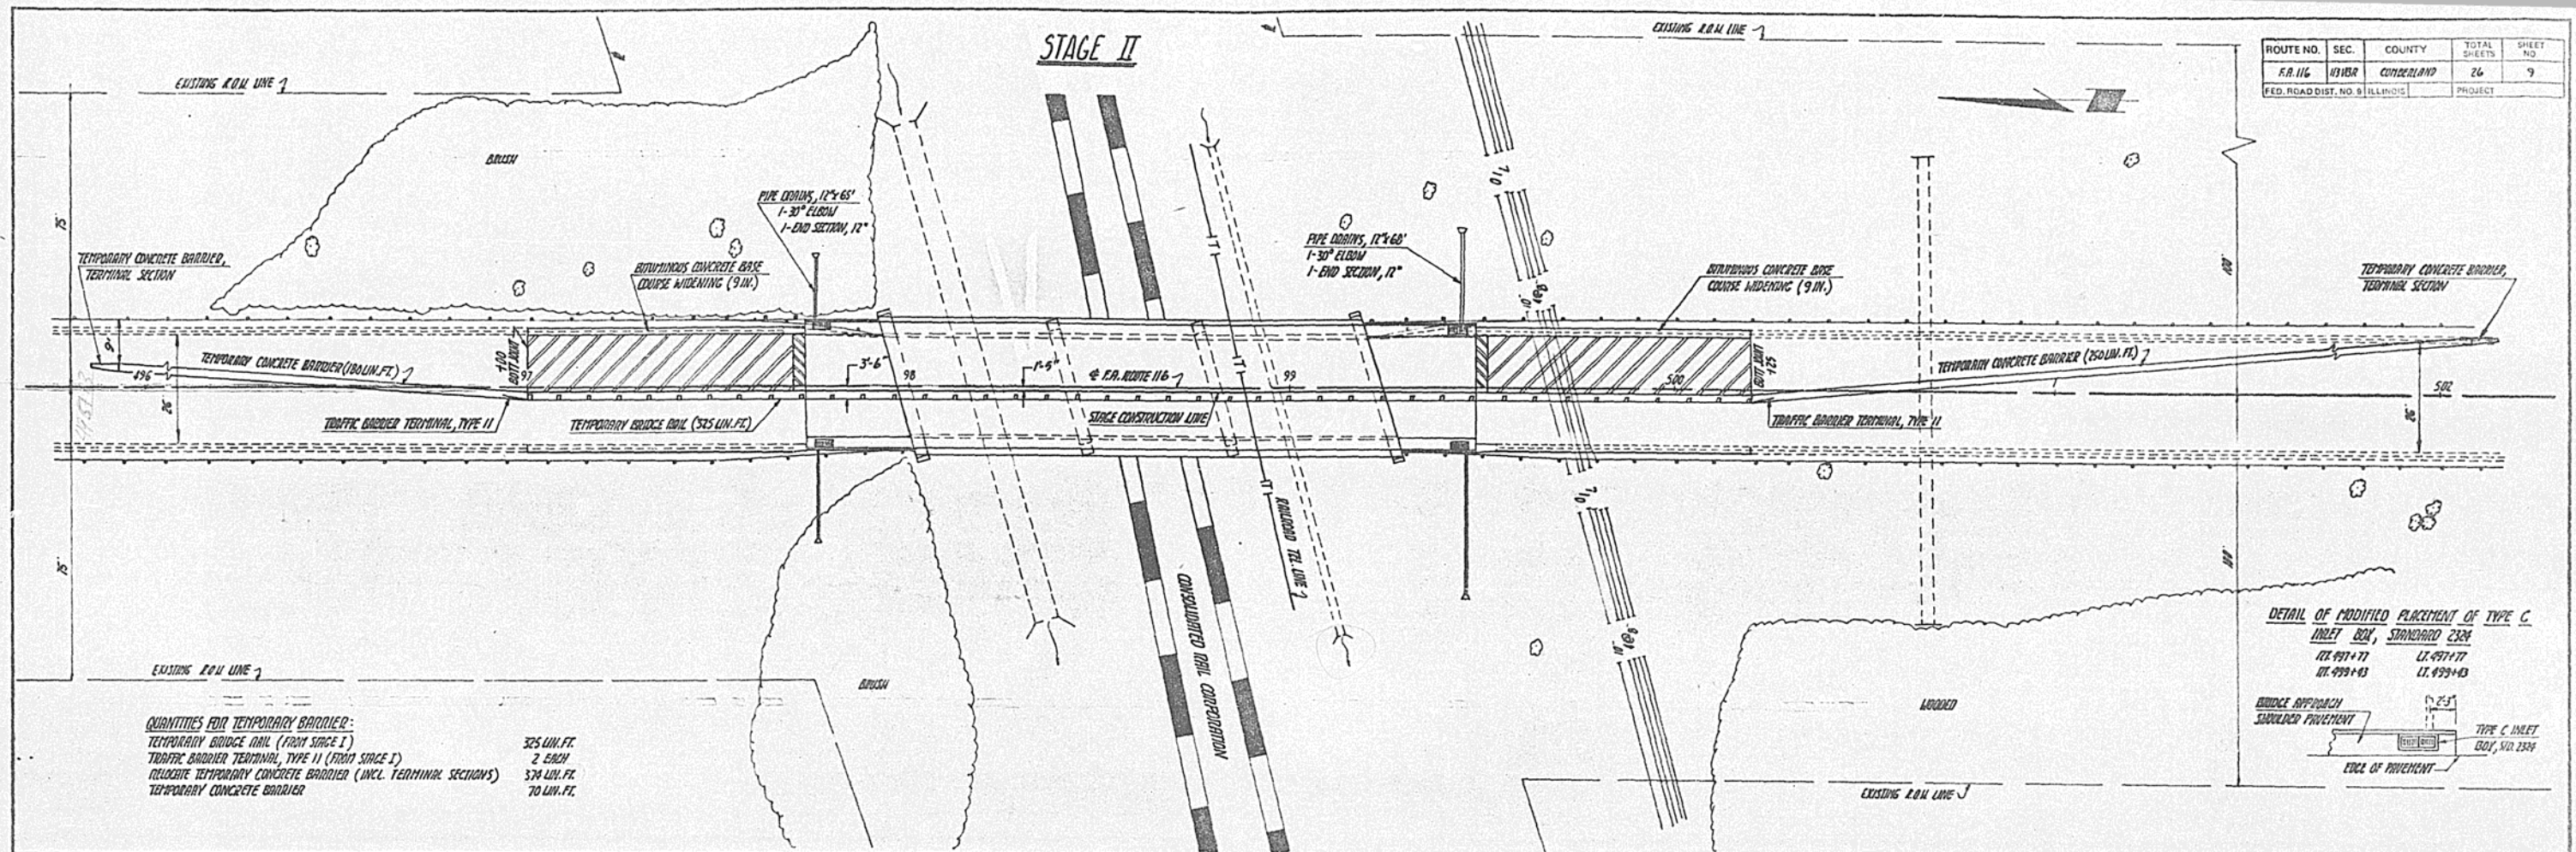

QUANTITIES FOR TEMPORARY BARRIER:
 TEMPORARY BRIDGE RAIL (FROM STAGE I) 325 LIN. FT.
 TRAFFIC BARRIER TERMINAL, TYPE II (FROM STAGE I) 2 EACH
 LOCATE TEMPORARY CONCRETE BARRIER (INCL. TERMINAL SECTIONS) 374 LIN. FT.
 TEMPORARY CONCRETE BARRIER 70 LIN. FT.

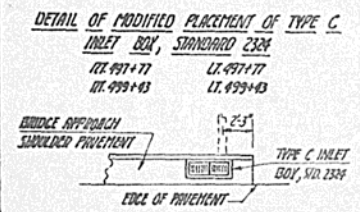


PLAN

DATE	
BY	
CHECKED	
DESIGNED	
NOTED	
APPROVED	
SCALE	
PROJECT	
NO.	

PROFILE

DATE	
BY	
CHECKED	
DESIGNED	
NOTED	
APPROVED	
SCALE	
PROJECT	
NO.	

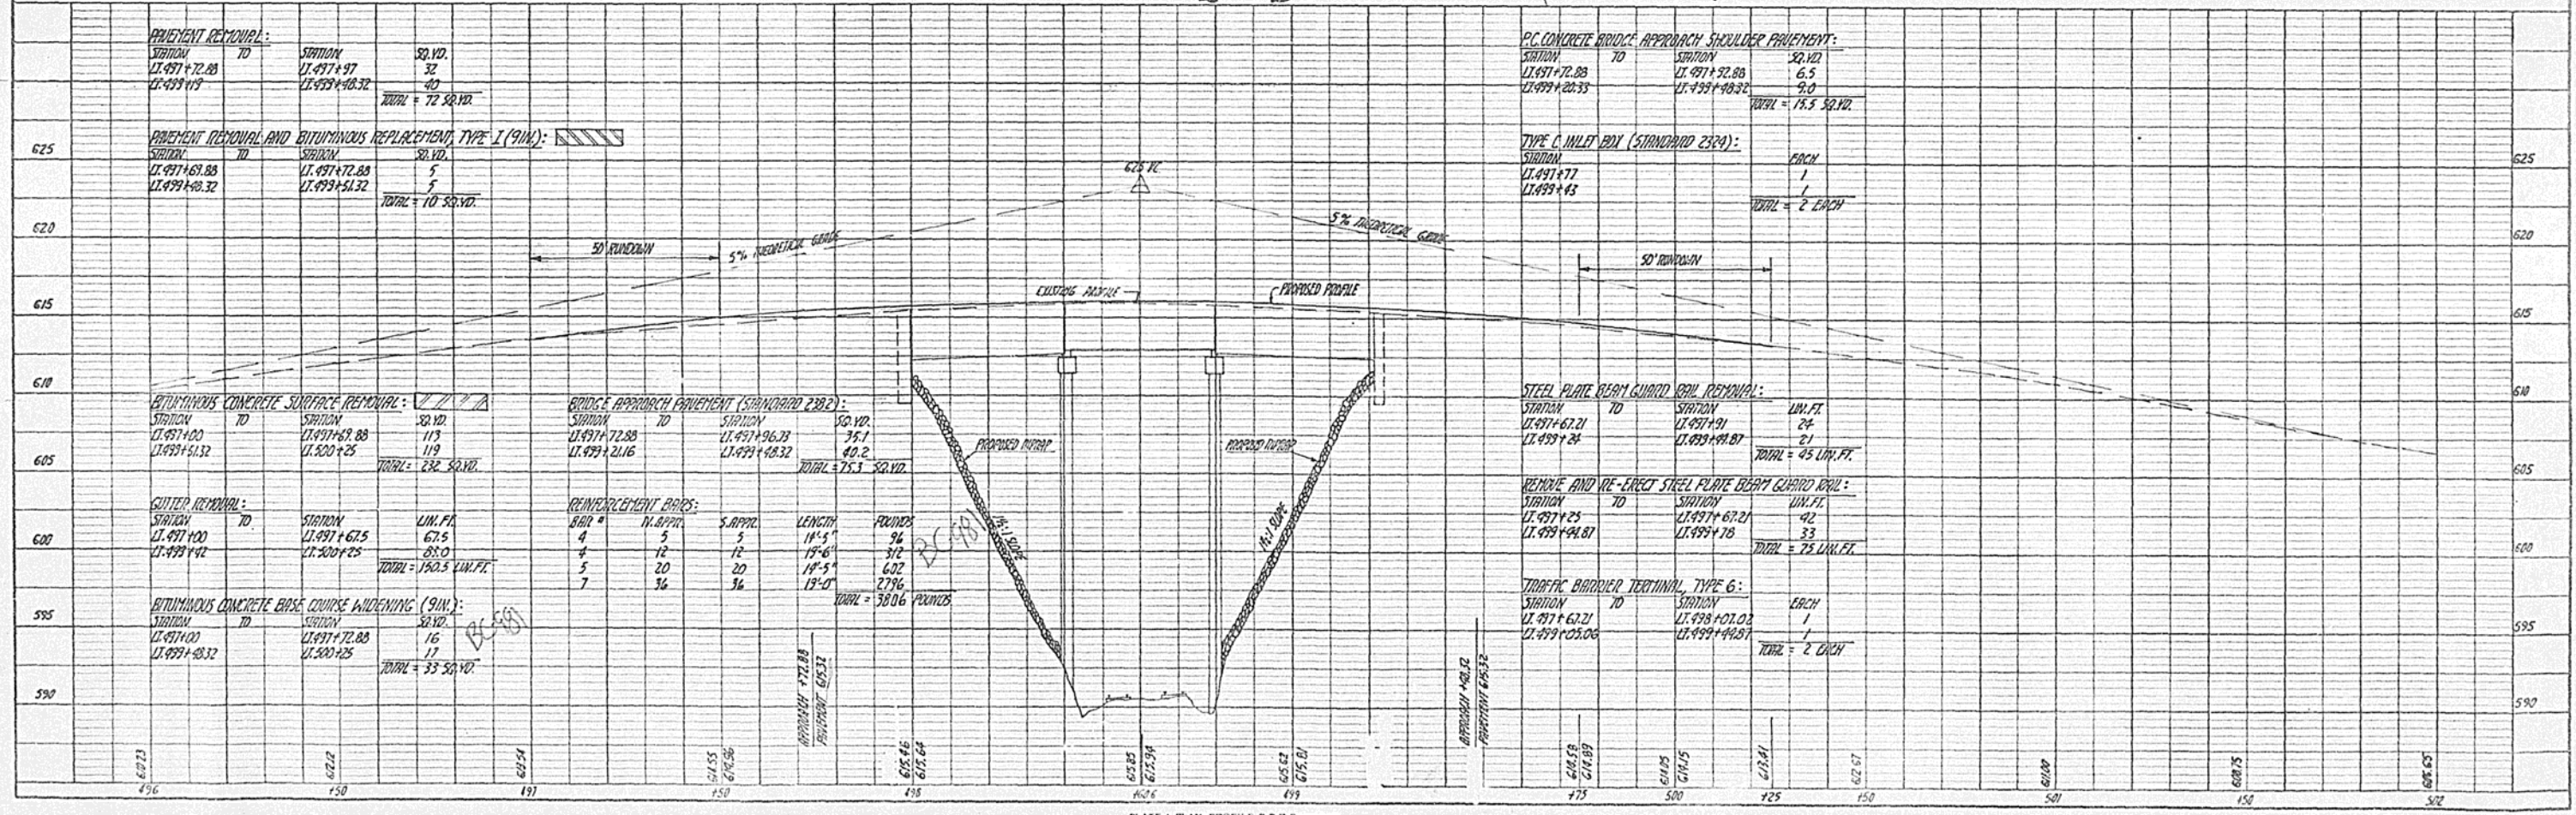

PAVEMENT REMOVAL:

STATION	TO	STATION	SO. YD.
LT. 497+72.88		LT. 497+97	32
LT. 499+119		LT. 499+48.32	40
			TOTAL = 72 SQ. YD.

PAVEMENT REMOVAL AND BITUMINOUS REPLACEMENT, TYPE I (9IN.):

STATION	TO	STATION	SO. YD.
LT. 497+67.88		LT. 497+72.88	5
LT. 499+48.32		LT. 499+51.32	5
			TOTAL = 10 SQ. YD.

BITUMINOUS CONCRETE SURFACE REMOVAL:

STATION	TO	STATION	SO. YD.
LT. 497+48.00		LT. 497+67.88	119
LT. 499+51.32		LT. 500+25	119
			TOTAL = 238 SQ. YD.

GUTTER REMOVAL:

STATION	TO	STATION	LIN. FT.
LT. 497+100		LT. 497+67.5	67.5
LT. 499+142		LT. 500+25	88.0
			TOTAL = 155.5 LIN. FT.

BITUMINOUS CONCRETE BASE COURSE WIDENING (9IN.):

STATION	TO	STATION	SO. YD.
LT. 497+100		LT. 497+72.88	16
LT. 499+48.32		LT. 500+25	11
			TOTAL = 33 SQ. YD.

BRIDGE APPROACH PAVEMENT (STANDARD 232):

STATION	TO	STATION	SO. YD.
LT. 497+72.88		LT. 497+96.77	36.1
LT. 499+21.16		LT. 499+48.32	40.2
			TOTAL = 75.3 SQ. YD.

REINFORCEMENT BARS:

BAR #	N. APPR.	S. APPR.	LENGTH	FOUNDS
4	5	5	14'-6"	34
5	12	12	14'-6"	312
4	20	20	14'-5"	602
7	36	36	12'-0"	2796
			TOTAL = 3806 FOUNDS	

P.C. CONCRETE BRIDGE APPROACH SHOULDER PAVEMENT:

STATION	TO	STATION	SO. YD.
LT. 497+72.88		LT. 497+92.88	6.5
LT. 499+20.35		LT. 499+48.32	9.0
			TOTAL = 15.5 SQ. YD.

TYPE C INLET BOX (STANDARD 2324):

STATION	EACH	
LT. 497+77	1	
LT. 499+43	1	
		TOTAL = 2 EACH

STEEL PLATE BEAM GUARD RAIL REMOVAL:

STATION	TO	STATION	LIN. FT.
LT. 497+67.21		LT. 497+91	24
LT. 499+24		LT. 499+48.87	21
			TOTAL = 45 LIN. FT.

REMOVE AND RE-ERECT STEEL PLATE BEAM GUARD RAIL:

STATION	TO	STATION	LIN. FT.
LT. 497+25		LT. 497+67.21	42
LT. 499+48.87		LT. 499+78	33
			TOTAL = 75 LIN. FT.

TRAFFIC BARRIER TERMINAL, TYPE 6:



STATION	TO	STATION	EACH
LT. 497+62.03		LT. 498+07.03	1
LT. 499+03.06		LT. 499+48.87	1
			TOTAL = 2 EACH

PLATE 1 PLAN-PROFILE, B.P.R. STANDARD
 GREAT BRITAIN LTD. CHICAGO, ILL. 1964

1902
 1906

**SPECIAL DETAIL FOR TRAFFIC CONTROL
BRIDGE DECK CONSTRUCTION
UTILIZING TEMPORARY BARRIERS
TYPICAL APPLICATION OF TRAFFIC CONTROL DEVICES**

ROUTE NO.	SEC.	COUNTY	TOTAL SHEETS	SHEET NO.
FRP 116	1130R	CUMBERLAND	26	10
FED. ROAD DIST. NO. 6 ILLINOIS			PROJECT	

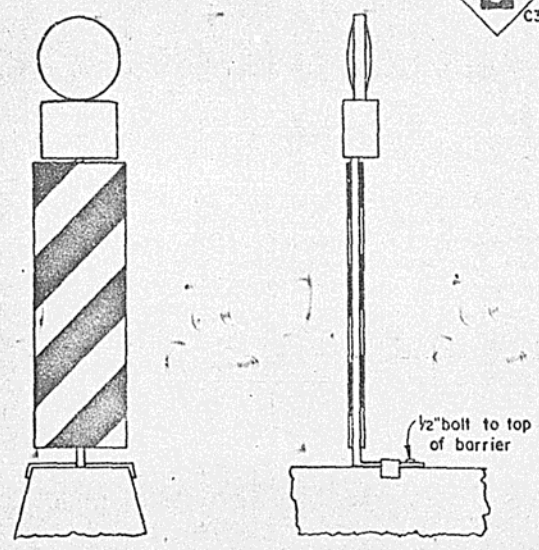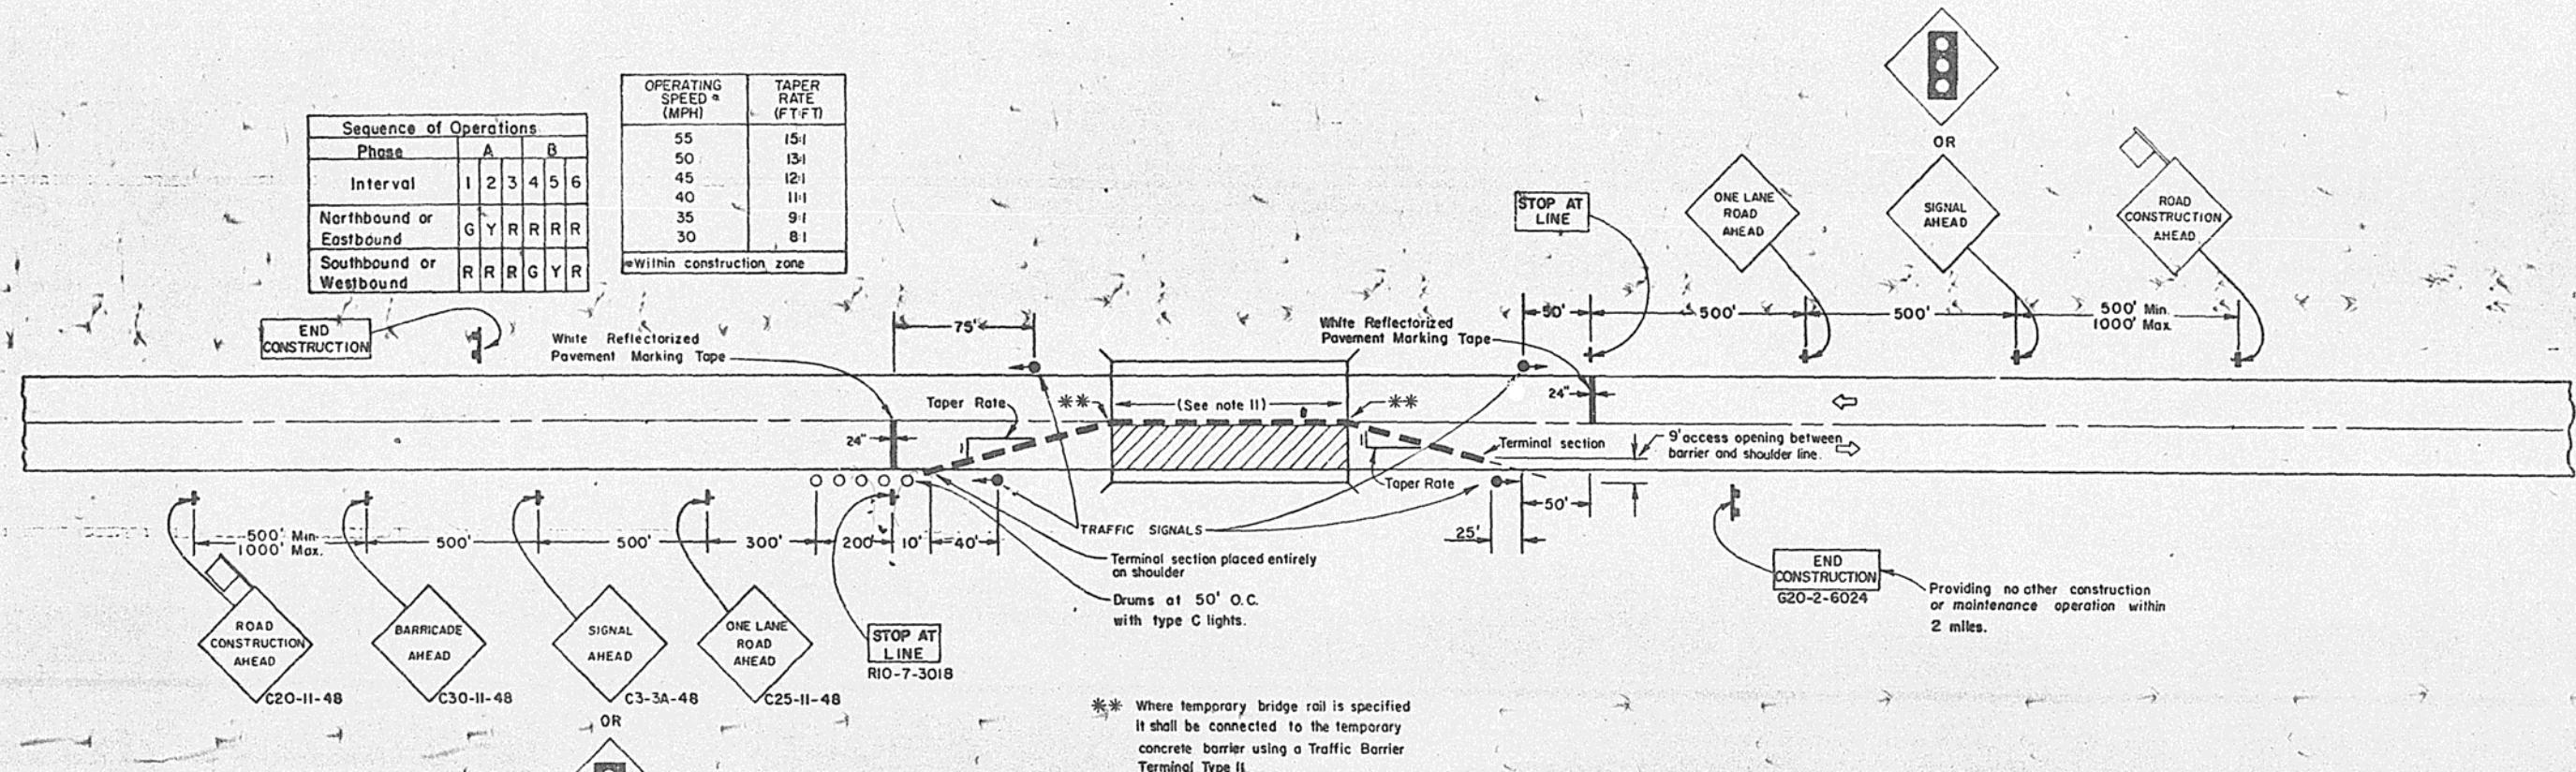







DETAIL A.
suggested mounting detail.

** Where temporary bridge rail is specified it shall be connected to the temporary concrete barrier using a Traffic Barrier Terminal Type II.

GENERAL NOTES

- The Engineer must be notified at least 72 hours prior to placing the temporary signals in operation so that arrangements can be made to inspect the installation and set the timing of the signals. The Contractor must furnish timing cycle gears of 60, 65, 70, 80, 90, 100, and 110 seconds for the controller.
- At any time that the signals are not operating the signal head shall be hooded and the SIGNAL AHEAD sign covered or removed.
- The left signal head shall normally be mounted at a height of 10 feet above the road surface measured to the bottom of the signal head. The right head shall normally be mounted at height of 14 feet above the road surface. Baffle plates will be required on all signals.
- All red lenses shall normally be 12 inch nominal diameter. The right signal head shall be aimed so the centers of the light beams of the indications are directed toward a point in the center of the approach lane 500 feet in advance of the signal. The left indication shall be aimed at a point in the center of the approach lane 100 feet in advance of the stop line.
- Bidirectional steady burning lights and double vertical panels shall be mounted on the barrier or bridge rail at 20 foot centers. Detail A shows a suggested mounting for the temporary concrete barrier. Other methods of mounting may be used upon the approval of the Engineer.
- All signs shall be post mounted, if the closure time exceeds four days.
- High intensity flashing lights shall be used on each approach in advance of the work area during hours of darkness and installed above the first two signs in each series.
- Longitudinal dimensions may be adjusted slightly to fit field conditions.
- All warning signs shall have minimum dimensions of 48 in. by 48 in. and have black legend and border on an orange reflectorized background. All signs other than warning signs shall have as a minimum the dimensions shown and shall have a black legend and border on a white reflectorized background.
- All vehicles, equipment, men and their activities are restricted at all times to one side of the pavement unless otherwise authorized by the Engineer.
- Temporary Bridge Rail shall be used across the bridge when specified in the plans.
- Form BT 725 is required.

SYMBOLS

-  Work Area
-  Sign with 18 in. by 18 in. (minimum) orange flag attached.
-  Sign on portable or permanent support.
-  Drum with steady burning light.
-  Temporary concrete barrier
-  Traffic signal.

**TWO-LANE, TWO WAY TRAFFIC,
RURAL ONE LANE CLOSURE ON
A BRIDGE DECK DAY OR NIGHT
OPERATIONS**



Where, at any time, any vehicle, equipment, men or their activities will encroach on one lane of a bridge deck and traffic signals are required.

TYPICAL APPLICATION OF TRAFFIC CONTROL DEVICES FOR ROAD CLOSURE

ROUTE NO	SECTION	COUNTY	TOTAL SHEETS	SHEET No.
F.A.P. 116	113VBR	CUMBERLAND	26	11

SYMBOLS

- ▬ TYPE III BARRICADE (SEE NOTE 1)
- ◊ 18" X 18" ORANGE FLAG
- ⚡ FLASHING AMBER LIGHT (HIGH INTENSITY)

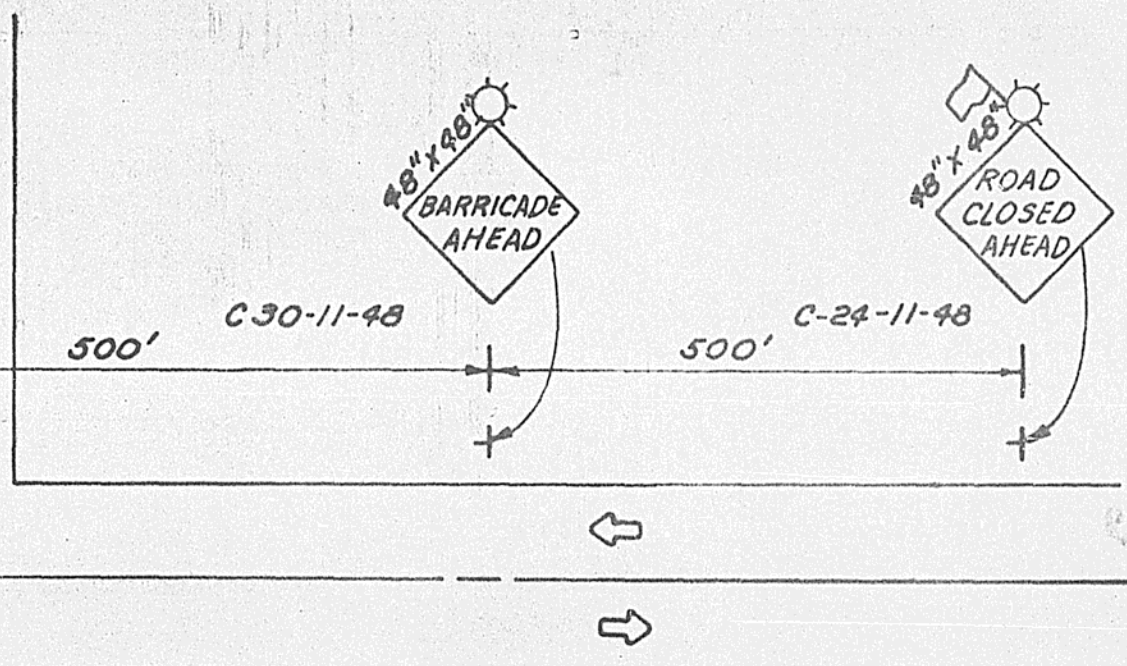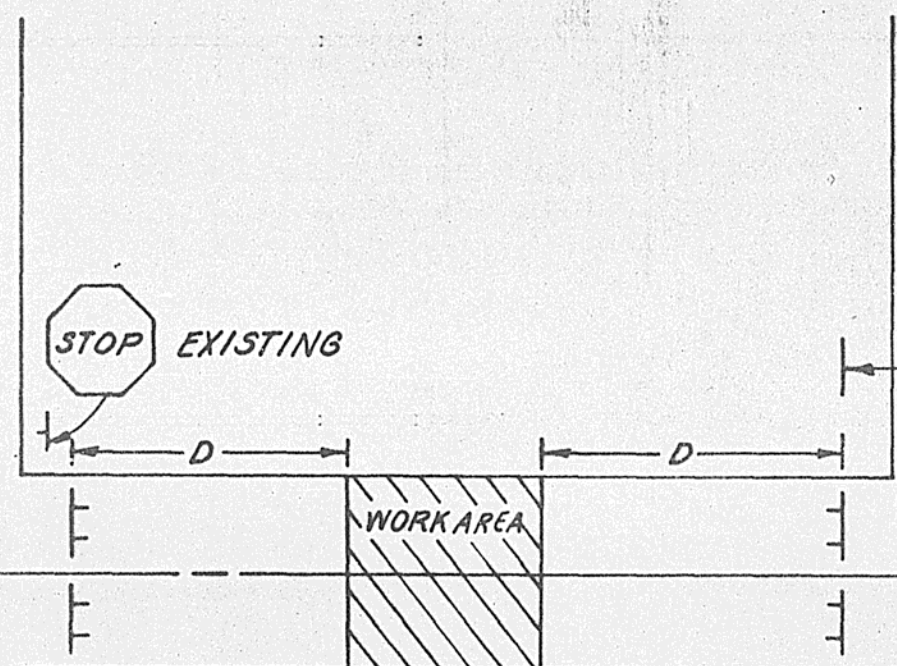

EXISTING

- GENERAL NOTES
1. TYPE III BARRICADES SHALL BE AS SHOWN ON "TYPICAL APPLICATIONS OF TYPE III BARRICADES CLOSING A ROAD" SIGN STD. R-11-1 OR R11-2 SHALL BE MOUNTED ABOVE THE BARRICADE. EACH TYPE III BARRICADE SHALL HAVE TWO FLASHING AMBER LIGHTS MOUNTED ABOVE IT.
 2. IF THE ROAD IS OPEN TO LOCAL TRAFFIC OR "D" EXCEEDS 1000', ANOTHER SET OF TYPE III BARRICADES, EQUIPPED AS IN NOTE 1 ABOVE, SHALL BE PLACED AT EACH END OF THE WORK AREA.
 3. WHEN A STOP CONDITION EXISTS, AS SHOWN ABOVE, NO SIGNS ARE REQUIRED IN ADVANCE OF THE "STOP" SIGN WHEN THE ROAD IS CLOSED WITHIN 100' OF THE INTERSECTION.

- GENERAL NOTES (CONT.)
4. STANDARDS 2298 & 2299 SHALL APPLY FOR THE PLACEMENT & MANUFACTURE OF TYPE III BARRICADES.
 5. ALL SIGNS SHALL BE POST MOUNTED IF THE CLOSURE TIME EXCEEDS FOUR DAYS.
 6. A MINIMUM OF TWO FLASHING LIGHTS SHALL BE USED AT NIGHT ON EACH APPROACH IN ADVANCE OF THE WORK AREA. FLASHING LIGHTS SHALL BE INSTALLED ABOVE THE FIRST TWO SIGNS IN THE SERIES OR, IF LESS THAN TWO SIGNS ARE PRESENT, MAY BE INSTALLED ON BARRICADES.
 7. LONGITUDINAL DIMENSIONS MAY BE ADJUSTED SLIGHTLY TO FIT FIELD CONDITIONS.
 8. ALL WARNING SIGNS SHALL HAVE MINIMUM DIMENSIONS OF 48 IN. BY 48 IN. AND HAVE BLACK LEGEND AND BORDER ON AN ORANGE REFLECTORIZED BACKGROUND.
 9. FORMS BT 725 AND BT 726 ARE REQUIRED.
 10. WHEN A SIDE ROAD INTERSECTS THE HIGHWAY ON WHICH WORK IS BEING PERFORMED, ADDITIONAL TRAFFIC DEVICES SHALL BE ERECTED AND PROVIDED AS DIRECTED BY THE ENGINEER.

STATE OF ILLINOIS DEPARTMENT OF TRANSPORTATION DIVISION OF HIGHWAYS	REVISED :
APPROVED: <i>May 23 1977</i>	G.H.H. 7-1-74
<i>Robert E. Kraus</i> DISTRICT ENGINEER	B.G.R. 5-20-77


STATE OF ILLINOIS
DEPARTMENT OF TRANSPORTATION

ROUTE NO.	SECTION	COUNTY	TOTAL SHEETS	SHEET NO.
R. 116	113VBR	CUMBERLAND	26	12
SHEET NO. 1 13 SHEETS				

B.M. North corner metal expansion plate right bannister,
Station 498+45, Elev. 616.30
Existing structure: #013-0026 built as SBI Rte. 130, Section
113 VB-NRS, of Sta. 498+60.6 in 1934. The existing, three span 127'-7" long x
27'-2" width, steel I-beam superstr. on pile bent abutments and concrete column piers.
Substructure shall be widened to accept new exterior wide flange
beams. Superstructure shall be widened to 35'-2".
Stage construction shall be utilized so as traffic can be
maintained during reconstruction.

GENERAL NOTES

- See Proposal for Boring Data.
- Fasteners shall be high strength bolts. Bolts $\frac{3}{4}$ ", open holes $\frac{15}{16}$ ", unless otherwise noted.
- Calculated weight of Structural Steel = 32,900 Lbs.
- The basic lead silico chromate paint system shall be used for shop and field painting of Structural Steel.
- Field welding of construction accessories will not be permitted to the bottom flange of beams nor to the top flange for a distance equal to one-fourth the span length each way from the pier supports. Field welding in other areas will be permitted only when approved by the Engineer.
- Anchor bolts shall be set before bolting diaphragms over supports.
- A Calcium Nitrite Corrosion Inhibitor, as covered in the Special Provisions, shall be used in the concrete for Class X Concrete for parapets.
- Plan dimensions and details relative to existing structure have been taken from existing plans and are subject to nominal construction variations. It shall be the Contractor's responsibility to verify such dimensions and details in the field and make necessary approved adjustments prior to construction or ordering of materials. Such variations shall not be cause for additional compensation for a change in the scope of the work, however, the Contractor will be paid for the quantity actually furnished at the unit price bid for the work.
- Expansion bolts shall consist of self drilling expansion anchors and $\frac{3}{4}$ " x 12" hooked bolts.
- All existing structural steel shall be cleaned by Method I and painted with three coats of the basic lead silico chromate paint system.
- Reinforcement bars shall conform to the requirements of AASHTO M-31 or M-53 Grade 60.
- The main load carrying member components subject to tensile stress shall conform to the Supplemental Requirements for Notch Toughness Zone 2. These components are the flanges and webs of the wide flange beams.

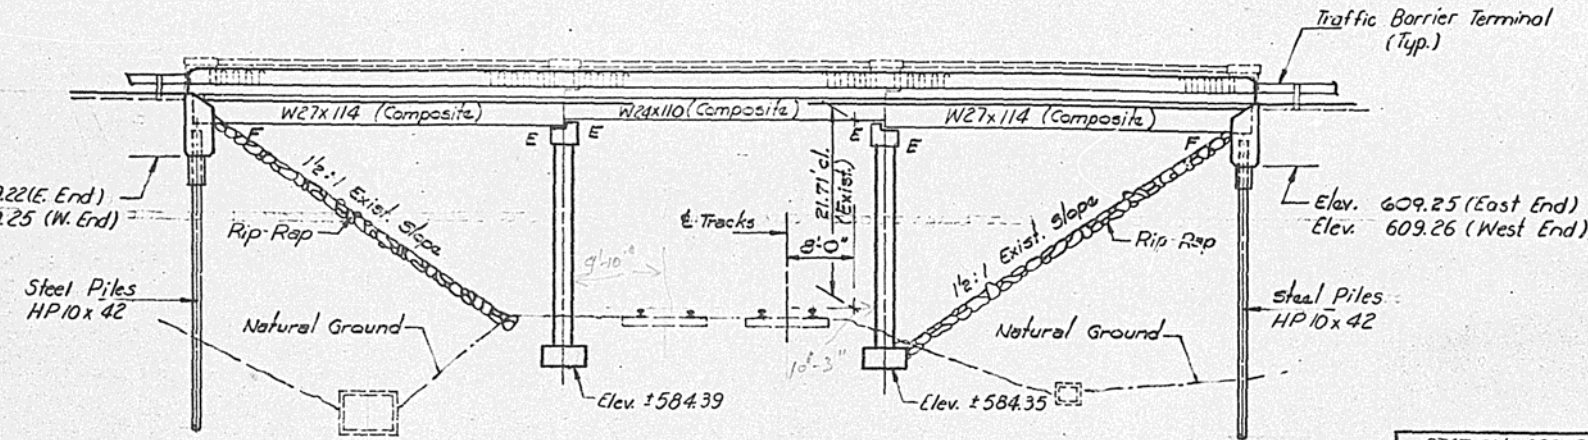


ELEVATION

STATION 498+60.60
REBUILT BY
STATE OF ILLINOIS
F.A.P. RT. 116 SEC. 113VBR
F.A. PROJECT: BR-F-116(17)
LOADING HS 20
*STR. NO.

NAME PLATE
(See Std. 2113)


*Structure Number to be
supplied by District.

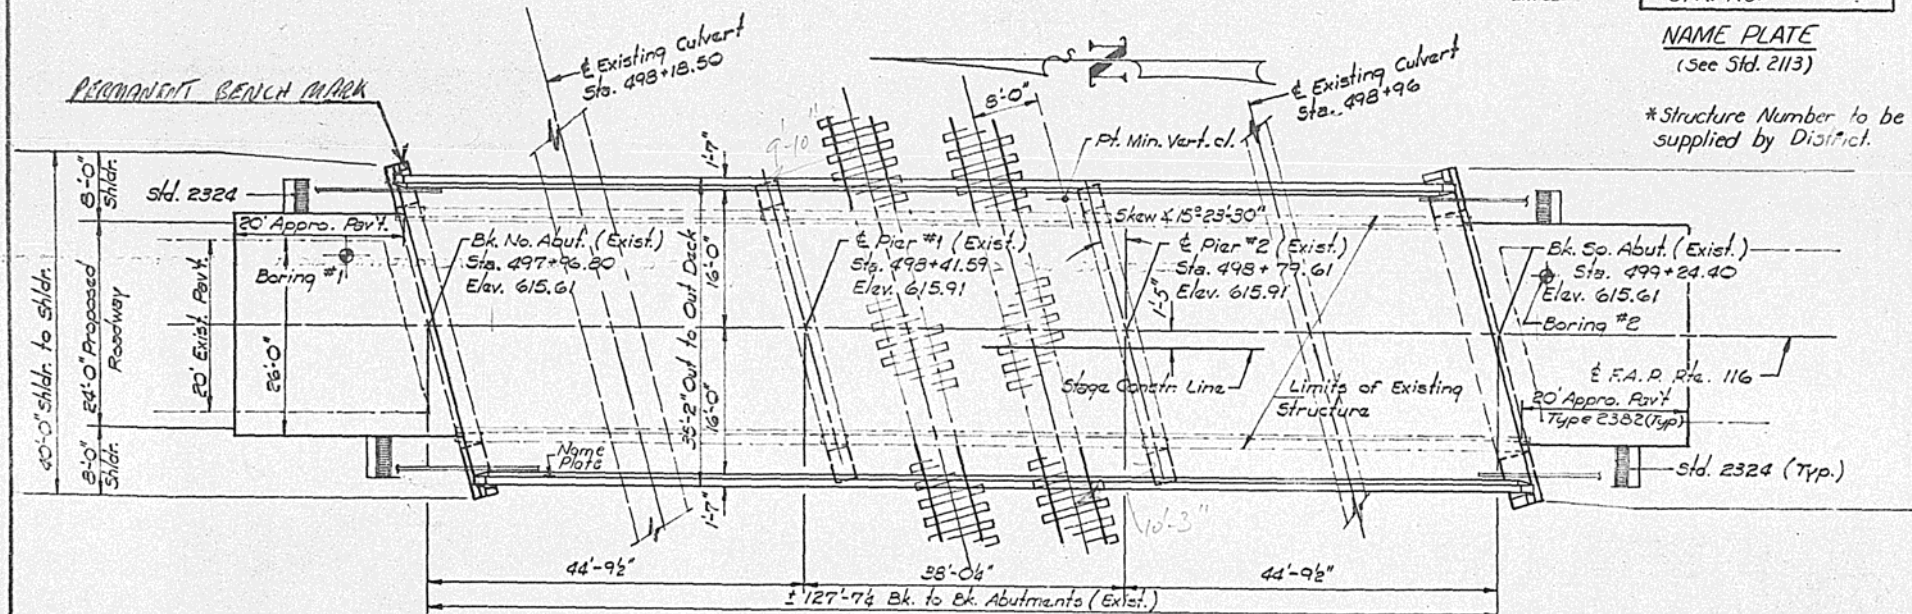

PLAN

Left (East)	Right (West)
591.56 S.	590.69 S.
591.46 S.	590.70 S.
591.37 N.	590.60 N.
591.28 N.	590.52 N.
591.24 S.	590.47 S.
591.32 S.	590.46 S.
591.15 N.	590.36 N.
591.04 N.	590.32 N.
591.09 S.	
591.01 S.	
590.93 N.	
590.82 N.	

PROFILE CONRAIL RAILROAD
(Top of rail elevations)

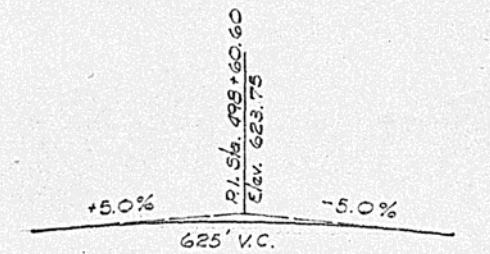

PROPOSED PROFILE GRADE F.A.P. 116

DESIGN STRESSES


- (New Construction)
- $f_c = 3,500$ psi
- $f_y = 60,000$ psi (Paint)
- $f_s = 20,000$ psi (Struct.)
- Top layer of reinforcement bars in deck shall be epoxy coated.

LOADING HS 20-44

Allow 25"/sq. ft. for future wearing surface.
Design Specification: 1977 AASHTO,
1978 and 1979 Interim Specification.

TOTAL BILL OF MATERIAL

Item	Unit	Super	Sub	Total
Removal of Existing Concrete Deck	Lump Sum	1		1
Concrete Removal	Cu. Yd.		4	4
Structure Excavation	Cu. Yd.		95	95
Protective Coat	Sq. Yd.	560		560
Structural Steel	Lump Sum	1		1
Stud Shear Connectors	Each	2214		2214
Class X Concrete	Cu. Yd.	141.7	42.0	183.7
Reinforcement Bars	Pound	15,100	4,480	19,580
Reinforcement Bars (Epoxy Coated)	Pound	16,480		16,480
Prefabricated Joint Seal 2 1/2"	Lin. Ft.	74		74
Expansion Bolts 3/4 Inch	Each		204	204
Temporary Bridge Rail	Lin. Ft.	128		128
Elastomeric Bearing Assembly, Type I	Each	8		8
Steel Piles (HP10x42)	Lin. Ft.		154	154
Riprap	Sq. Yd.		350	350
Cleaning and Painting Steel Bridge	Lump Sum	1		1
Name Plates	Each	1		1


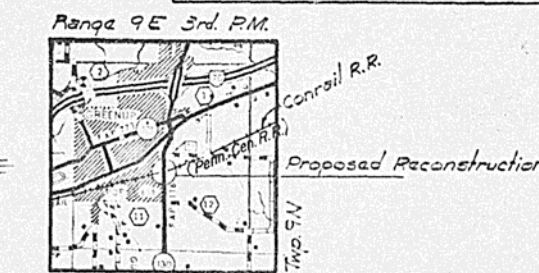


GENERAL PLAN & ELEVATION
F.A.P. Rte. 116 Over CONRAIL RAIL ROAD
F.A.P. Rte. 116 Section 113 VBR
CUMBERLAND COUNTY
Sta. 498+60.60

DESIGNED	Richard Brunette	EXAMINED	[Signature]
CHECKED	M. J. Ry...	PASSED	[Signature]
DRAWN	R. Doty	APPROVED	[Signature]
CHECKED	MJR		



STATE OF ILLINOIS
DEPARTMENT OF TRANSPORTATION

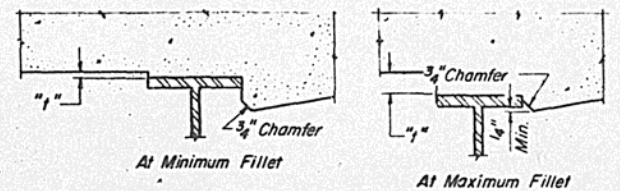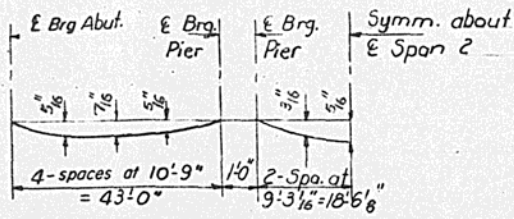

To determine "t": After all structural steel has been erected, elevations of the top flanges of the beams shall be taken at intervals shown below. These elevations subtracted from the "Theoretical Grade Elevations Adjusted for Dead Load Deflection" shown below, minus slab thickness, equals the fillet heights "t" above top flange of beams.

FILLET HEIGHTS

DEAD LOAD DEFLECTION DIAGRAM BMS. 1#8.

(Includes weight of concrete only)
Note: The above deflections are not to be used in the field if the engineer is working from the grade elevations adjusted for dead load deflections as shown below.

BEAM #1

Location	Station	Offset	Theoretical Grade Elevations	Theoretical Grade Elevations Adjusted For Dead Load Deflection
E Brg. No. Abut.	49794.082	-14.583	615.342	615.342
a	49804.082	-14.583	615.441	615.472
b	49814.082	-14.583	615.523	615.569
c	49824.082	-14.583	615.590	615.627
d	49834.082	-14.583	615.640	615.650
E Brg. Pier 1 (Span 1)	49837.077	-14.583	615.652	615.652
E Brg. Pier 1 (Span 2)	49838.077	-14.583	615.656	615.656
e	49848.077	-14.583	615.684	615.710
f	49858.077	-14.583	615.696	615.730
g	49868.077	-14.583	615.692	615.711
E Brg. Pier 2 (Span 2)	49875.087	-14.583	615.674	615.679
E Brg. Pier 2 (Span 3)	49876.087	-14.583	615.677	615.677
h	49886.087	-14.583	615.644	615.676
i	49896.087	-14.583	615.596	615.641
j	49906.087	-14.583	615.531	615.568
k	49916.087	-14.583	615.450	615.459
E Brg. So. Abut.	49919.082	-14.583	615.423	615.423

BEAM #2


Location	Station	Offset	Theoretical Grade Elevations	Theoretical Grade Elevations Adjusted For Dead Load Deflection
E Brg. No. Abut.	49794.656	-12.500	615.392	615.392
a	49804.656	-12.500	615.489	615.521
b	49814.656	-12.500	615.571	615.617
c	49824.656	-12.500	615.636	615.673
d	49834.656	-12.500	615.686	615.695
E Brg. Pier 1 (Span 1)	49837.651	-12.500	615.697	615.697
E Brg. Pier 1 (Span 2)	49838.651	-12.500	615.701	615.701
e	49848.651	-12.500	615.728	615.755
f	49858.651	-12.500	615.739	615.774
g	49868.651	-12.500	615.734	615.754
E Brg. Pier 2 (Span 2)	49875.661	-12.500	615.721	615.721
E Brg. Pier 2 (Span 3)	49876.661	-12.500	615.719	615.719
h	49886.661	-12.500	615.685	615.717
i	49896.661	-12.500	615.636	615.681
j	49906.661	-12.500	615.570	615.607
k	49916.661	-12.500	615.488	615.498
E Brg. So. Abut.	49919.656	-12.500	615.461	615.461

BEAM #3

Location	Station	Offset	Theoretical Grade Elevations	Theoretical Grade Elevations Adjusted For Dead Load Deflection
E Brg. No. Abut.	49795.032	-7.500	615.487	615.487
a	49805.032	-7.500	615.582	615.614
b	49815.032	-7.500	615.661	615.707
c	49825.032	-7.500	615.725	615.762
d	49835.032	-7.500	615.772	615.782
E Brg. Pier 1 (Span 1)	49839.027	-7.500	615.783	615.783
E Brg. Pier 1 (Span 2)	49840.027	-7.500	615.786	615.786
e	49850.027	-7.500	615.811	615.838
f	49860.027	-7.500	615.820	615.855
g	49870.027	-7.500	615.813	615.833
E Brg. Pier 2 (Span 2)	49877.037	-7.500	615.799	615.799
E Brg. Pier 2 (Span 3)	49878.037	-7.500	615.796	615.796
h	49888.037	-7.500	615.760	615.792
i	49898.037	-7.500	615.708	615.754
j	49908.037	-7.500	615.640	615.677
k	49918.037	-7.500	615.556	615.566
E Brg. So. Abut.	49921.032	-7.500	615.528	615.528

BEAM #4

Location	Station	Offset	Theoretical Grade Elevations	Theoretical Grade Elevations Adjusted For Dead Load Deflection
E Brg. No. Abut.	49797.409	-2.500	615.579	615.579
a	49807.409	-2.500	615.672	615.704
b	49817.409	-2.500	615.749	615.795
c	49827.409	-2.500	615.810	615.847
d	49837.409	-2.500	615.855	615.865
E Brg. Pier 1 (Span 1)	49840.404	-2.500	615.866	615.866
E Brg. Pier 1 (Span 2)	49841.404	-2.500	615.869	615.869
e	49851.404	-2.500	615.892	615.918
f	49861.404	-2.500	615.898	615.933
g	49871.404	-2.500	615.889	615.909
E Brg. Pier 2 (Span 2)	49878.414	-2.500	615.873	615.873
E Brg. Pier 2 (Span 3)	49879.414	-2.500	615.870	615.870
h	49889.414	-2.500	615.832	615.864
i	49899.414	-2.500	615.778	615.824
j	49909.414	-2.500	615.708	615.745
k	49919.414	-2.500	615.622	615.631
E Brg. So. Abut.	49922.409	-2.500	615.593	615.593

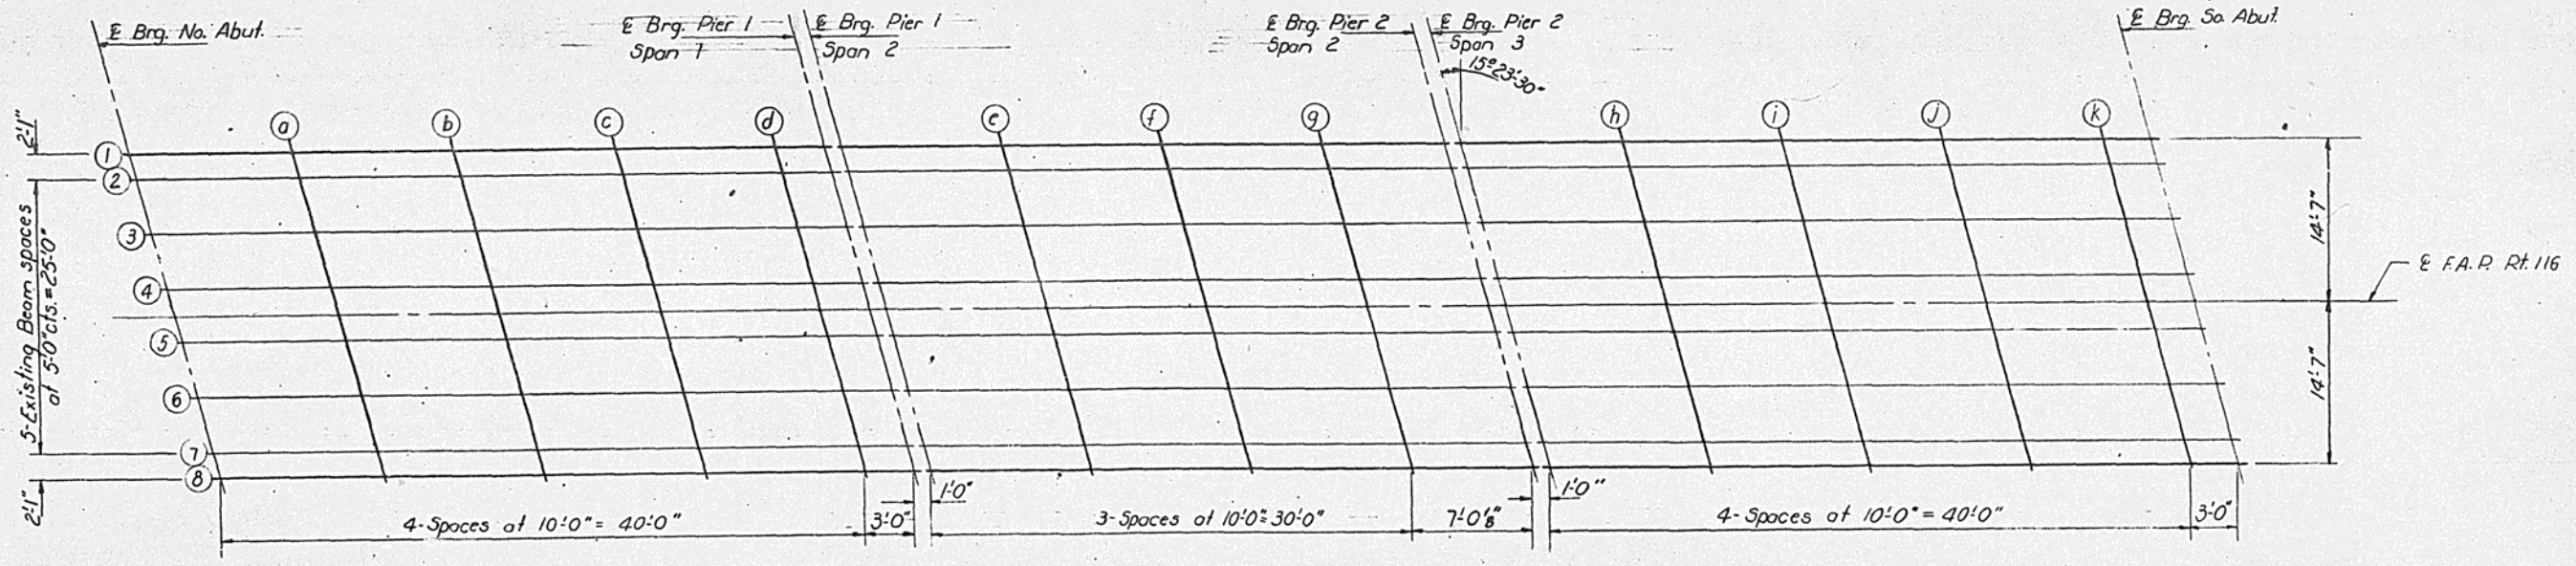


ELEVATIONS LOCATION PLAN

DESIGNED Richard Brunette
CHECKED Mabel J. Ryan
DRAWN P.G. Barnett R. Doty
CHECKED M.J.R.
E-S 8-1-65

EXAMINED [Signature] JUN 6 1980
PASSED [Signature]
APPROVED [Signature]
DIRECTOR OF HIGHWAYS

TOP OF SLAB ELEVATIONS
F.A.P. RT. 116 SEC. 113 VBR
CUMBERLAND COUNTY
STA. 498+60.60

STATE OF ILLINOIS
DEPARTMENT OF TRANSPORTATION

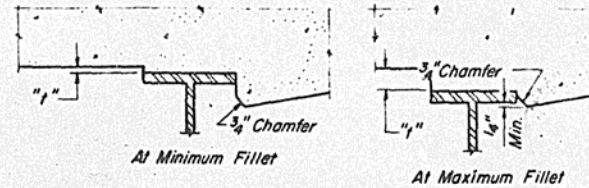

PROJECT NO.	116	SECTION	113VBR	COUNTY	CUMBERLAND	SHEET NO.	26	14	SHEET NO. 3
13 SHEETS									

To determine "f": After all structural steel has been erected, elevations of the top flanges of the beams shall be taken at intervals shown below. These elevations subtracted from the "Theoretical Grade Elevations Adjusted for Dead Load Deflection" shown below, minus slab thickness, equals the fillet heights "f" above top flange of beams.

FILLET HEIGHTS

F.A.P. RT. 116

BEAM #5

BEAM #6

BEAM #7

Location	Station	Offset	Theoretical Grade Elevations	Theoretical Grade Elevations Adjusted For Dead Load Deflection
E Brg. No. Abut.	49790.097	0.0	615.625	615.625
a	49808.097	0.0	615.717	615.749
b	49810.097	0.0	615.793	615.839
c	49828.097	0.0	615.853	615.890
d	49838.097	0.0	615.897	615.906
E Brg. Pier 1 (Span 1)	49841.092	0.0	615.907	615.907
E Brg. Pier 1 (Span 2)	49842.092	0.0	615.910	615.910
e	49852.092	0.0	615.932	615.958
f	49862.092	0.0	615.937	615.972
g	49872.092	0.0	615.927	615.947
E Brg. Pier 2 (Span 2)	49879.102	0.0	615.910	615.910
E Brg. Pier 2 (Span 3)	49880.102	0.0	615.907	615.907
h	49890.102	0.0	615.868	615.900
i	49900.102	0.0	615.813	615.859
j	49910.102	0.0	615.741	615.778
k	49920.102	0.0	615.654	615.664
E Brg. So. Abut.	49923.097	0.0	615.625	615.625

Location	Station	Offset	Theoretical Grade Elevations	Theoretical Grade Elevations Adjusted For Dead Load Deflection
E Brg. No. Abut.	49790.785	2.500	615.593	615.593
a	49808.785	2.500	615.684	615.715
b	49818.785	2.500	615.759	615.804
c	49828.785	2.500	615.817	615.854
d	49838.785	2.500	615.860	615.870
E Brg. Pier 1 (Span 1)	49841.780	2.500	615.870	615.870
E Brg. Pier 1 (Span 2)	49842.780	2.500	615.873	615.873
e	49852.780	2.500	615.894	615.920
f	49862.780	2.500	615.898	615.933
g	49872.780	2.500	615.887	615.906
E Brg. Pier 2 (Span 2)	49879.790	2.500	615.869	615.869
E Brg. Pier 2 (Span 3)	49880.790	2.500	615.866	615.866
h	49890.790	2.500	615.826	615.857
i	49900.790	2.500	615.769	615.815
j	49910.790	2.500	615.697	615.734
k	49920.790	2.500	615.609	615.618
E Brg. So. Abut.	49923.785	2.500	615.579	615.579

Location	Station	Offset	Theoretical Grade Elevations	Theoretical Grade Elevations Adjusted For Dead Load Deflection
E Brg. No. Abut.	49800.162	7.500	615.528	615.528
a	49810.162	7.500	615.617	615.649
b	49820.162	7.500	615.689	615.735
c	49830.162	7.500	615.746	615.783
d	49840.162	7.500	615.787	615.796
E Brg. Pier 1 (Span 1)	49843.157	7.500	615.796	615.796
E Brg. Pier 1 (Span 2)	49844.157	7.500	615.799	615.799
e	49854.157	7.500	615.817	615.844
f	49864.157	7.500	615.819	615.854
g	49874.157	7.500	615.806	615.825
E Brg. Pier 2 (Span 2)	49881.167	7.500	615.786	615.786
E Brg. Pier 2 (Span 3)	49882.167	7.500	615.783	615.783
h	49892.167	7.500	615.741	615.772
i	49902.167	7.500	615.682	615.728
j	49912.167	7.500	615.608	615.645
k	49922.167	7.500	615.517	615.527
E Brg. So. Abut.	49925.162	7.500	615.487	615.487

Location	Station	Offset	Theoretical Grade Elevations	Theoretical Grade Elevations Adjusted For Dead Load Deflection
E Brg. No. Abut.	49801.538	12.500	615.461	615.461
a	49811.538	12.500	615.547	615.579
b	49821.538	12.500	615.618	615.663
c	49831.538	12.500	615.672	615.709
d	49841.538	12.500	615.711	615.720
E Brg. Pier 1 (Span 1)	49844.533	12.500	615.719	615.719
E Brg. Pier 1 (Span 2)	49845.533	12.500	615.721	615.721
e	49855.533	12.500	615.738	615.764
f	49865.533	12.500	615.738	615.772
g	49875.533	12.500	615.722	615.741
E Brg. Pier 2 (Span 2)	49882.543	12.500	615.701	615.701
E Brg. Pier 2 (Span 3)	49883.543	12.500	615.697	615.697
h	49893.543	12.500	615.653	615.684
i	49903.543	12.500	615.592	615.638
j	49913.543	12.500	615.515	615.552
k	49923.543	12.500	615.423	615.432
E Brg. So. Abut.	49926.538	12.500	615.392	615.392

BEAM #8

Location	Station	Offset	Theoretical Grade Elevations	Theoretical Grade Elevations Adjusted For Dead Load Deflection
E Brg. No. Abut.	49802.112	14.583	615.423	615.423
a	49812.112	14.583	615.508	615.540
b	49822.112	14.583	615.578	615.624
c	49832.112	14.583	615.631	615.668
d	49842.112	14.583	615.669	615.678
E Brg. Pier 1 (Span 1)	49845.107	14.583	615.677	615.677
E Brg. Pier 1 (Span 2)	49846.107	14.583	615.679	615.679
e	49856.107	14.583	615.695	615.721
f	49866.107	14.583	615.694	615.729
g	49876.107	14.583	615.677	615.697
E Brg. Pier 2 (Span 2)	49883.117	14.583	615.656	615.656
E Brg. Pier 2 (Span 3)	49884.117	14.583	615.652	615.652
h	49894.117	14.583	615.606	615.638
i	49904.117	14.583	615.545	615.591
j	49914.117	14.583	615.467	615.504
k	49924.117	14.583	615.374	615.383
E Brg. So. Abut.	49927.112	14.583	615.342	615.342

Note: For Elevations Location Plan see sheet #2.

DESIGNED Richard Brunette
 CHECKED Michael J. Ryan
 DRAWN P.G. Barnett R. Doty
 CHECKED MJR


EXAMINED [Signature] JUNE 6 1980
 PASSED
 APPROVED
 DIRECTOR OF HIGHWAYS

E-5 8-1-65


TOP OF SLAB ELEVATIONS
 F.A.P. RT 116 SEC. 113VBR
 CUMBERLAND COUNTY
 STA. 498+60.60

STATE OF ILLINOIS
DEPARTMENT OF TRANSPORTATION

ROUTE NO.	SECTION	COUNTY	TOTAL SHEETS	SHEET NO.	SHEET NO. 4 13 SHEETS
P.A. 116	113 VBR	CUMBERLAND	26	15	
FED. ROAD DIST. NO. 1	ILLINOIS	FED. AID PROJECT			

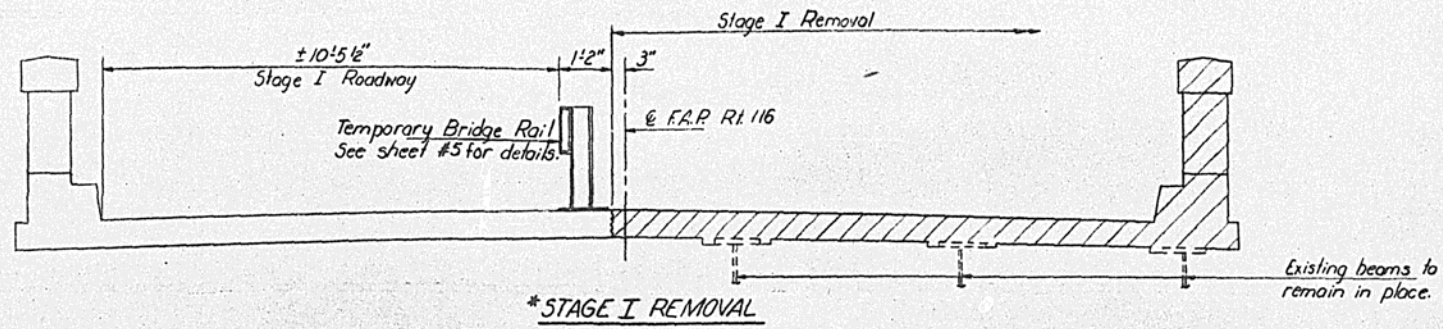


*STAGE I REMOVAL

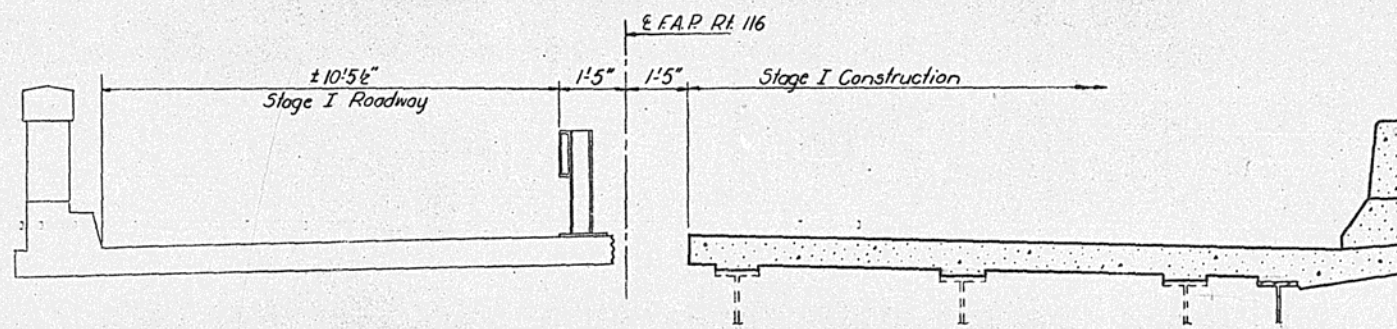


*STAGE I CONSTRUCTION

Note: Hatched area indicates existing concrete deck removal.

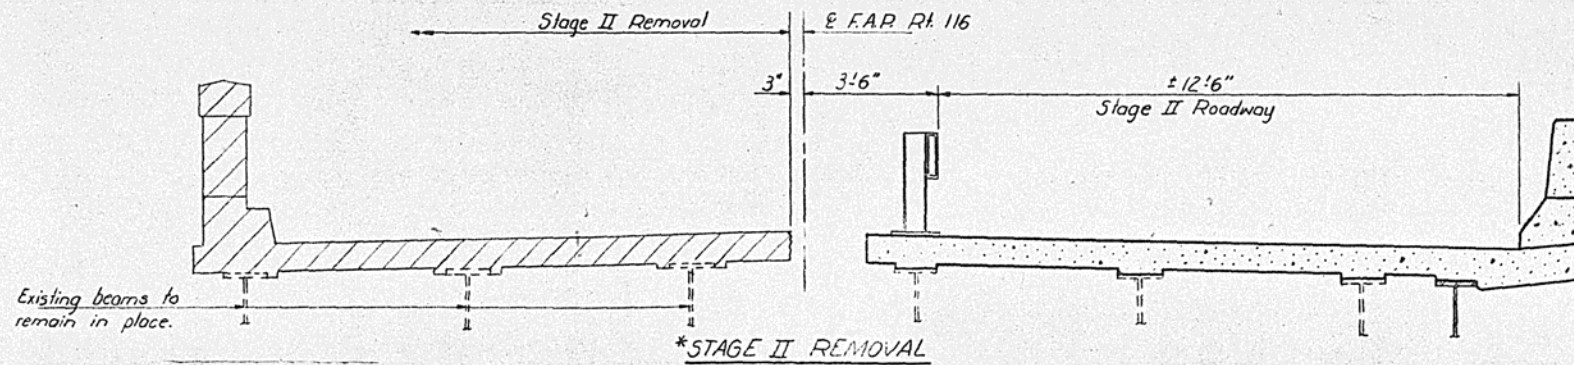

*STAGE II REMOVAL

*Looking South.

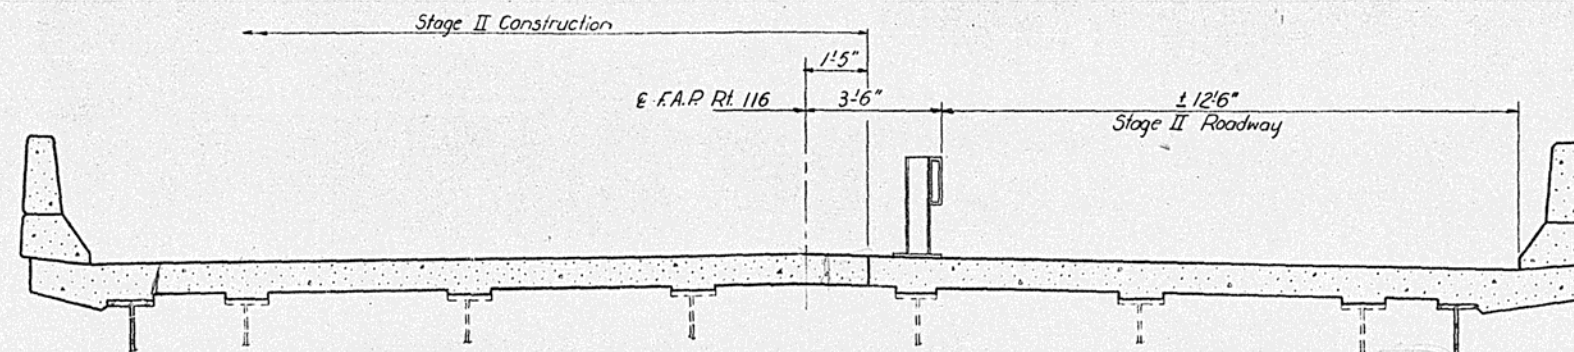

*STAGE II CONSTRUCTION




DESIGNED Richard Brunette
CHECKED Michael J. Ryan
DRAWN R. Doty
CHECKED MJR

EXAMINED *[Signature]* JUN 6 1980
PASSED
APPROVED
DIRECTOR OF HIGHWAYS

STAGE CONSTRUCTION DETAILS
E.A.P. RT 116 SEC. 113 VBR
CUMBERLAND COUNTY
STA. 498+60.60


STATE OF ILLINOIS
DEPARTMENT OF TRANSPORTATION

ROUTE NO.	SECTION	COUNTY	TOTAL SHEETS	SHEET NO.	SHEET NO. 5 13 SHEETS
116	113VBR	CUMBERLAND	26	16	
FED. ROAD DIST. NO. 7		ILLINOIS	FED. AID PROJECT		

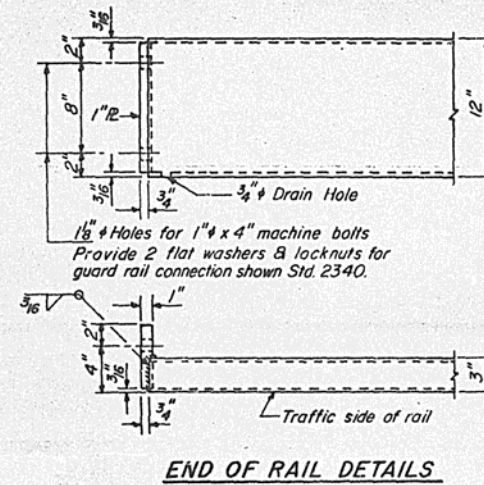
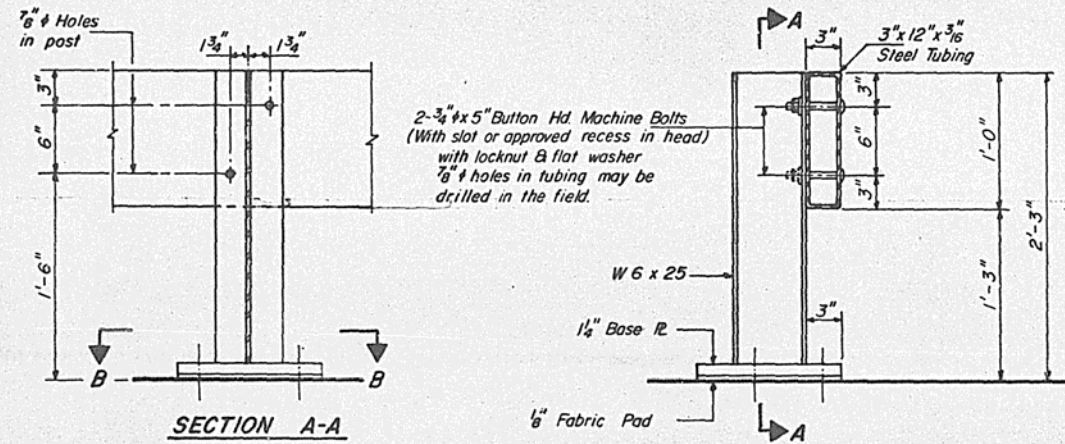
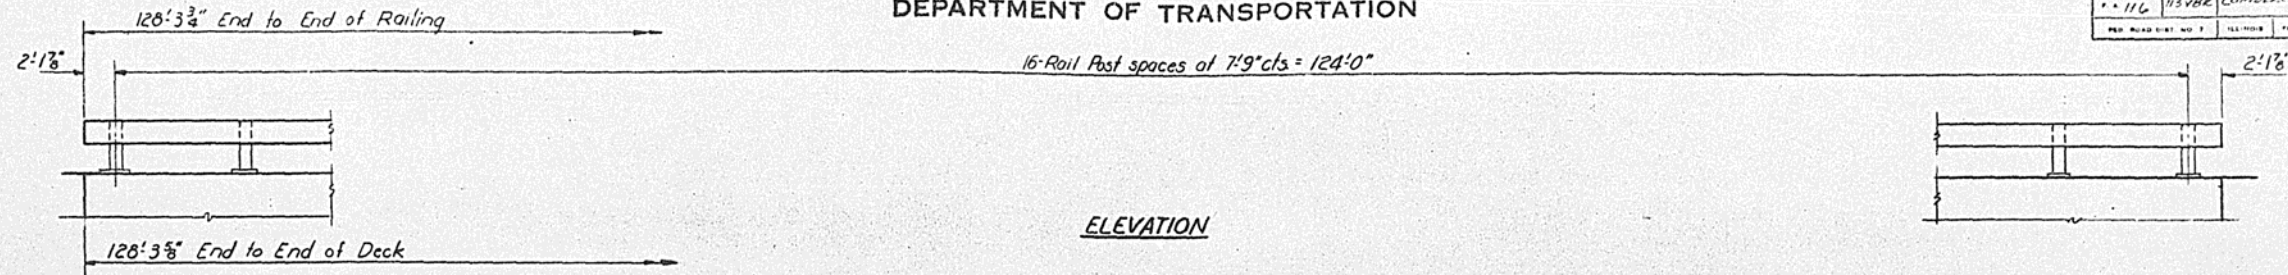


NOTES

Hollow structural steel tubing shall conform to the requirements of A.S.T.M. designation A-500 Grade B or A-501 Structural Steel Tubing.
All other steel shapes and plates shall conform to the requirements of A.A.S.H.T.O. M-183 except posts shall conform to A.A.S.H.T.O. M-223, Grade 50.
Bolts, cap screws, and nuts shall conform to the requirement of A.S.T.M. designation A-307 except for high strength bolts, threaded rods, nuts and washers noted which shall conform to A.A.S.H.T.O. M-164.
The bridge rail shall receive one shop coat of a steel prime paint.
The 1" high strength bolts or threaded rods used to connect the railposts shall be tightened in accordance with Article 507.04(g)(3) of the Standard Specification.
See Special Provisions for Temporary Bridge Rail.

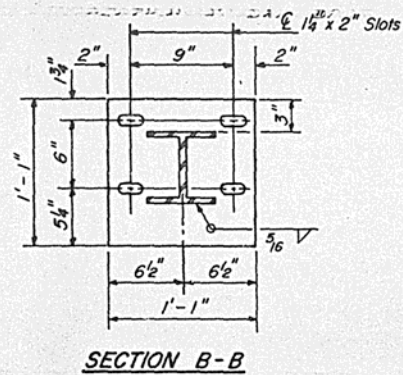


4 - Wing type threaded inserts for 1" H.S. bolts with flat washer
Grout holes after removal.

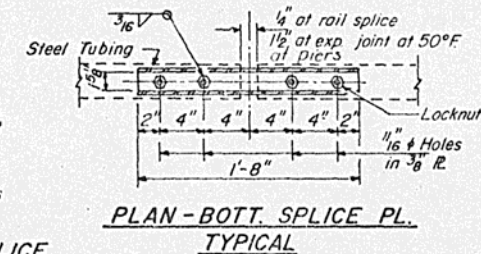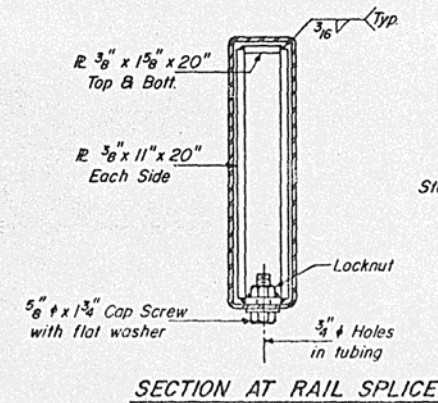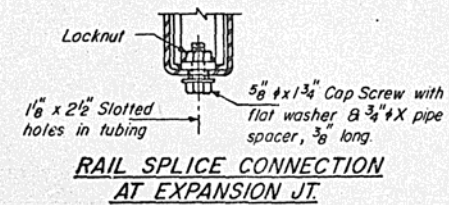

BILL OF MATERIAL






Item	Unit	Quantity
Temporary Bridge Rail	Lin. Ft.	128

TEMPORARY BRIDGE RAIL
E.A.P. RT. 116 SEC. 113VBR
CUMBERLAND COUNTY
STA. 498+60.60

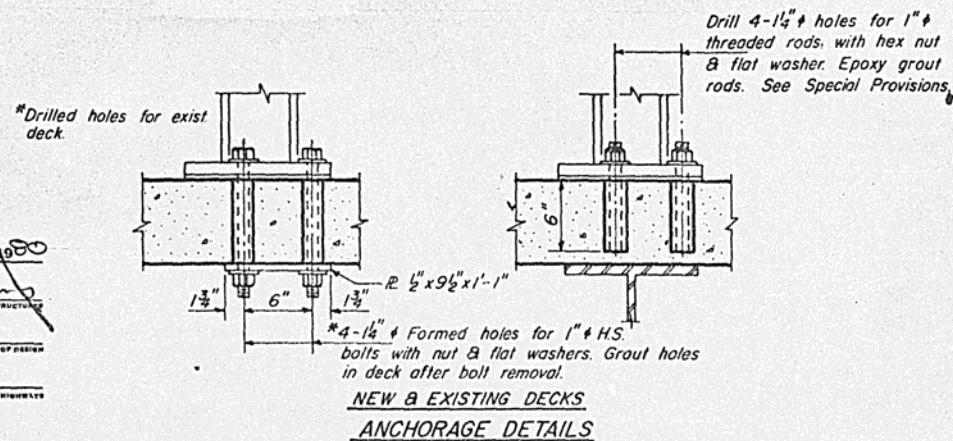


DESIGNED Richard Brunette
CHECKED Michael J Ryan
DRAWN R. Doly
CHECKED M.J.R.

EXAMINED June 6 1980
PASSED
APPROVED
DIRECTOR OF HIGHWAYS

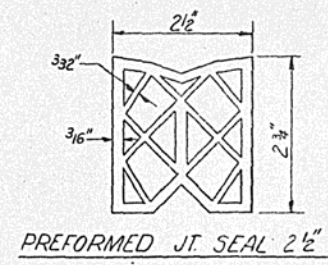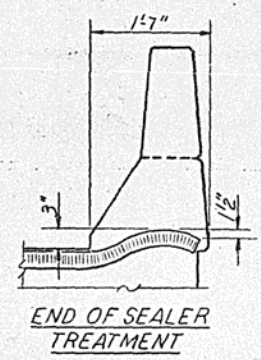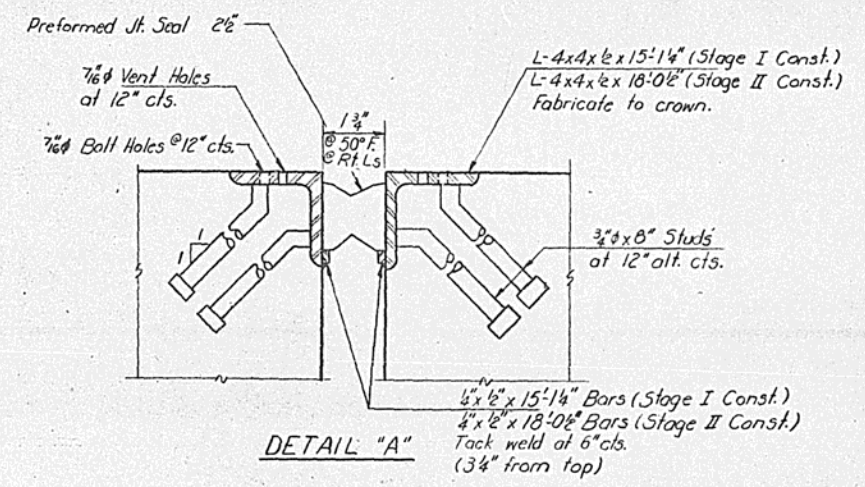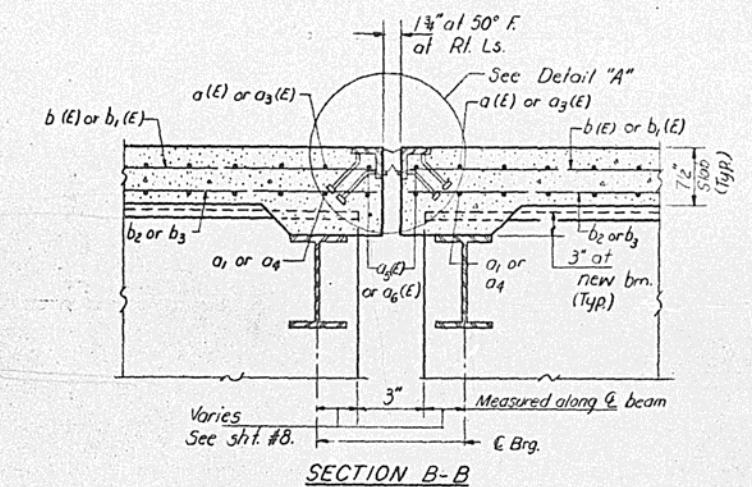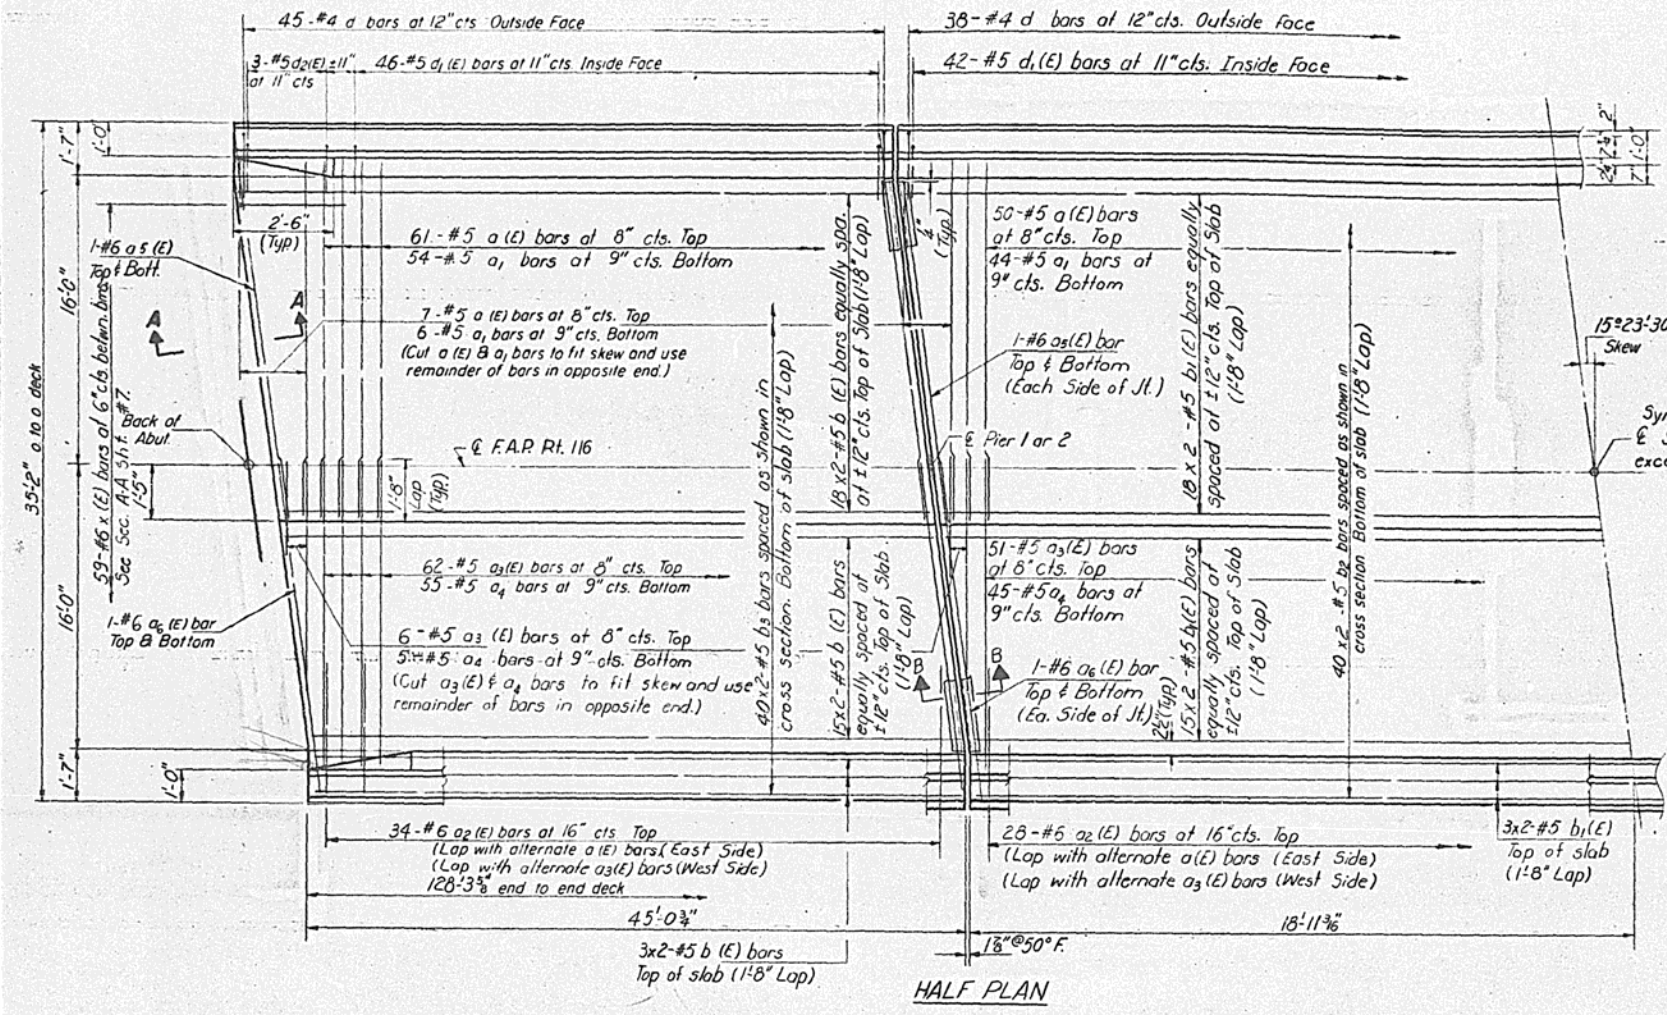

NOTES:
See sheet #7 for superstructure details and Bill of Material.
Reinforcement bars designated (E) shall be epoxy coated. See Special Provisions.
Bars indicated thus 20 x 3-#5 etc. indicates 20 lines of bars with 3 lengths per line.
For Section A-A see sheet #7.

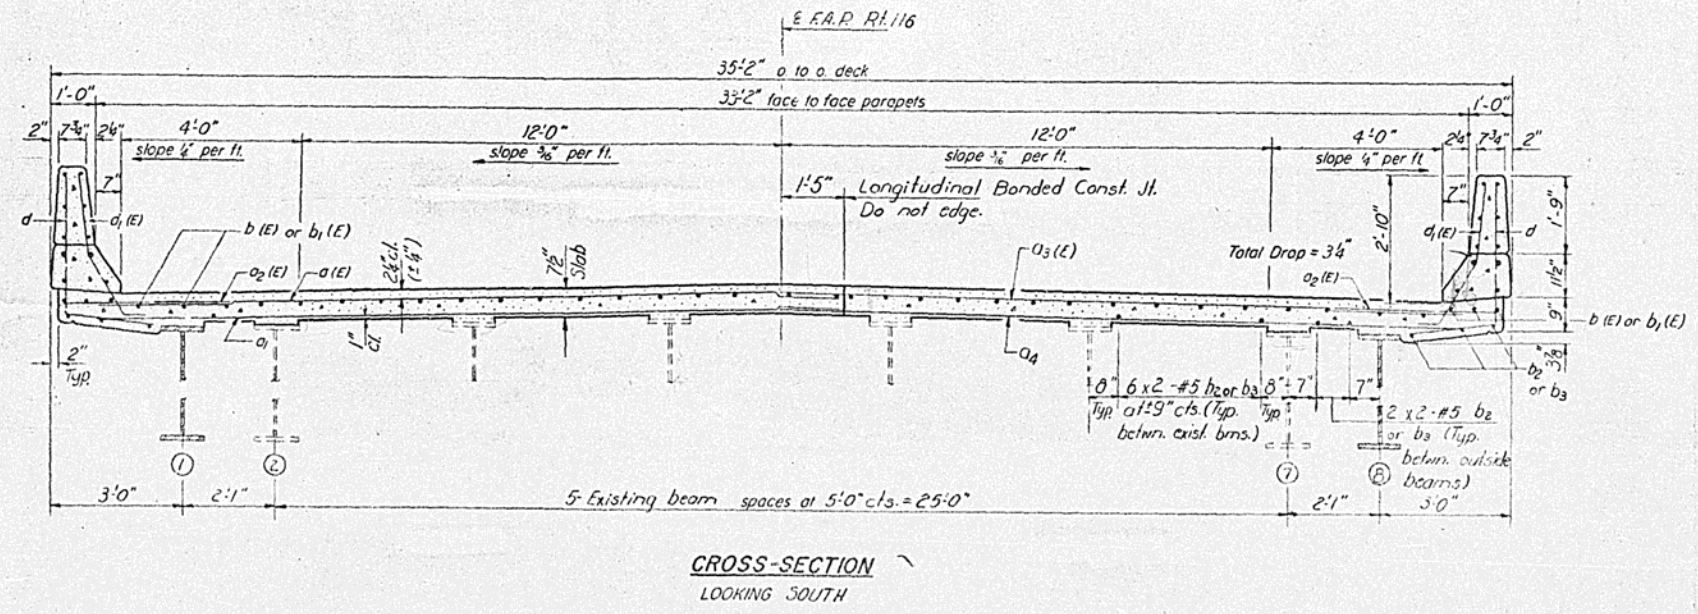


DESIGNED Richard Brunette
CHECKED Michael J. Ryan
DRAWN R. Doty
CHECKED mjr


EXAMINED [Signature]
PASSED [Signature]
APPROVED [Signature]

JUNE 6 1980
ENGINEER OF STRUCTURE AND TRAFFIC STRUCTURES
ENGINEER OF DESIGN
DIRECTOR OF HIGHWAYS


SUPERSTRUCTURE
F.A.P. RT. 116 SEC. 113VBR
CUMBERLAND COUNTY
STA. 498+60.60

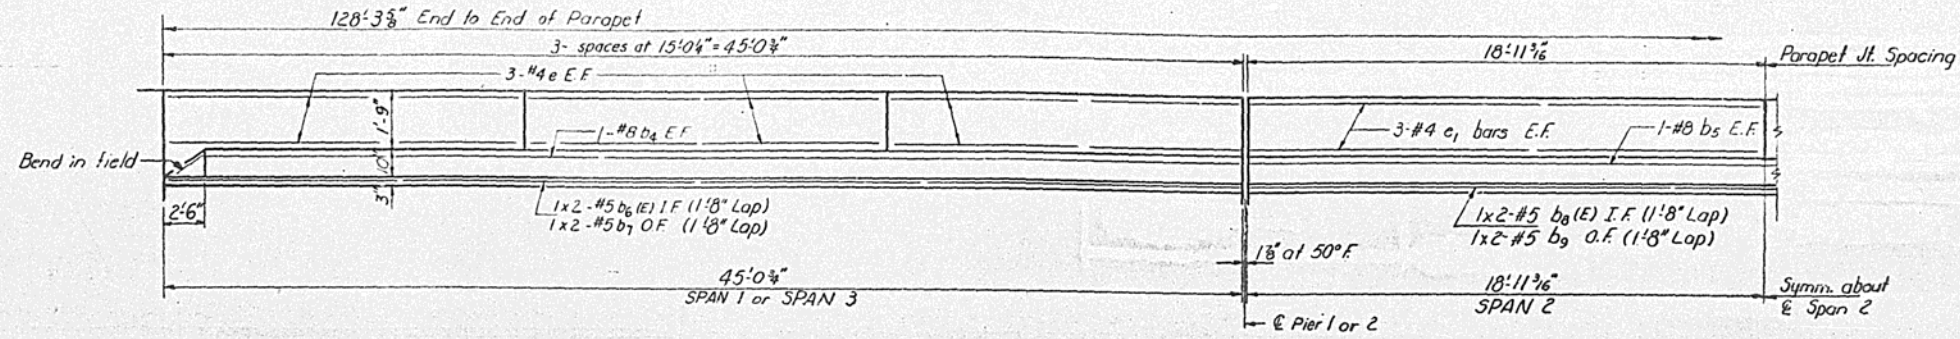


INSIDE ELEVATION OF PARAPET

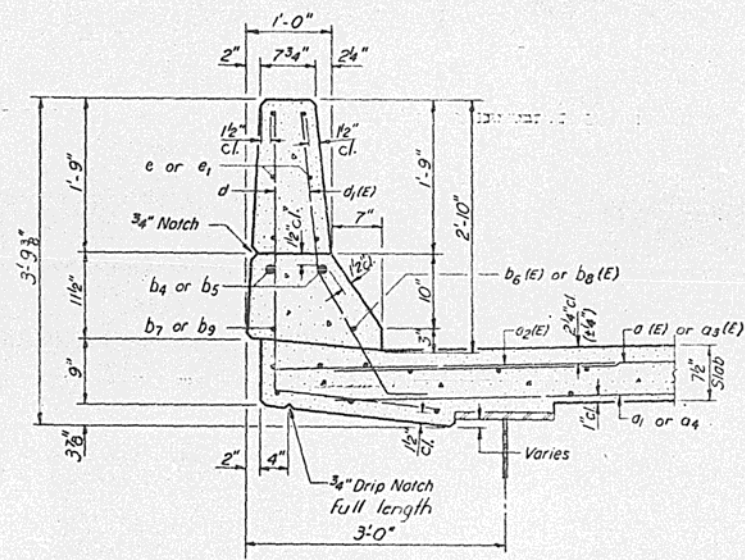

SECTION THRU PARAPET

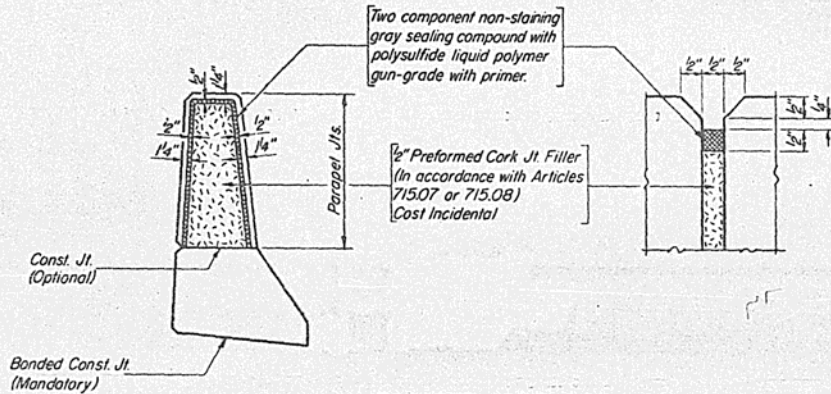


PARAPET JOINT DETAILS

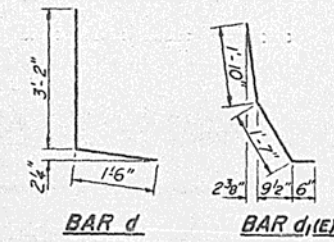


BAR d


BAR d1(E)

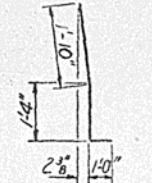

BAR d2(E)

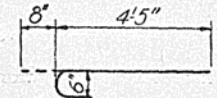

BAR x(E)

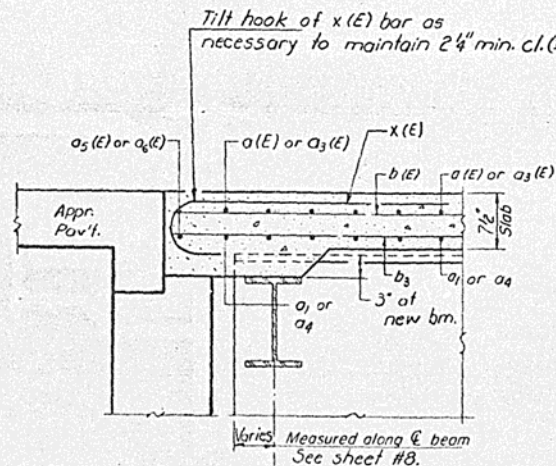

SECTION A-A

SUPERSTRUCTURE
BILL OF MATERIAL

Bar	No	Size	Length	Shape
a(E)	193	#5	18'-0"	—
a1	170	#5	18'-0"	—
a2(E)	192	#6	4'-0"	—
a3(E)	193	#5	16'-7"	—
a4	170	#5	16'-7"	—
a5(E)	12	#6	18'-6"	—
a6(E)	12	#6	17'-6"	—
b(E)	156	#5	23'-3"	—
b1(E)	78	#5	19'-9"	—
b2	80	#5	19'-9"	—
b3	160	#5	23'-3"	—
b4	8	#8	44'-9"	—
b5	4	#8	37'-7"	—
b6(E)	8	#5	23'-6"	—
b7	8	#5	23'-6"	—
b8(E)	4	#5	20'-0"	—
b9	4	#5	20'-0"	—
d	256	#4	4'-8"	L
d1(E)	268	#5	3'-11"	L
d2(E)	12	#5	4'-2"	L
e	72	#4	14'-9"	—
e1	24	#4	18'-6"	—
x(E)	118	#6	5'-1"	C
Reinforcement Bars		Lbs	15,100	
Reinforcement Bars (Epoxy Coated)		Lbs	16,480	
Class X Concrete		Cu Yds	141.7	

Reinforcement bars designated (E) shall be epoxy coated. See Special Provisions for location of Section A-A see sheet #6.

SUPERSTRUCTURE DETAILS
F.A.P. RT 116 SEC. 113VBR
CUMBERLAND COUNTY
STA. 498+60.60

DESIGNED Richard Brunette
CHECKED Michael J. Ryan
DRAWN R. Doly
CHECKED MJR


EXAMINED [Signature]
PASSED [Signature]
APPROVED [Signature]
DIRECTOR OF HIGHWAYS

JUNE 6 1980


STATE OF ILLINOIS
DEPARTMENT OF TRANSPORTATION

ROUTE NO.	SECTION	COUNTY	TOTAL SHEETS	SHEET NO.
116	113VBR	CUMBERLAND	26	19

13 SHEETS


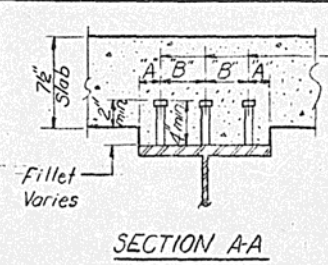


3/4" Granular or solid flux filled headed studs automatically end welded. (No. Reg'd.=2214)

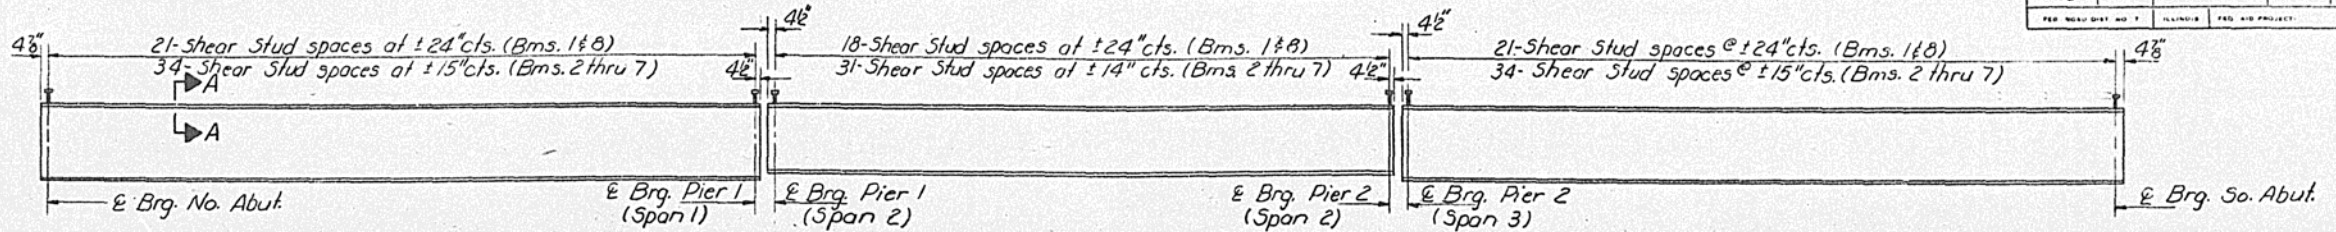


"A" & "B" DIMENSIONS


Span	"A"	"B"
1 & 3	2" ± 2"	3" ± 3"
2	2" ± 1 3/4"	4" ± 2 3/4"

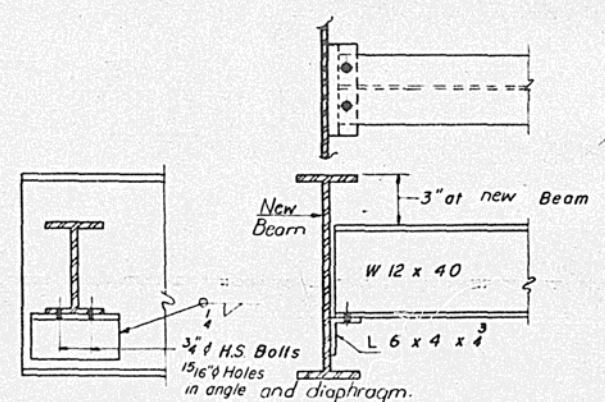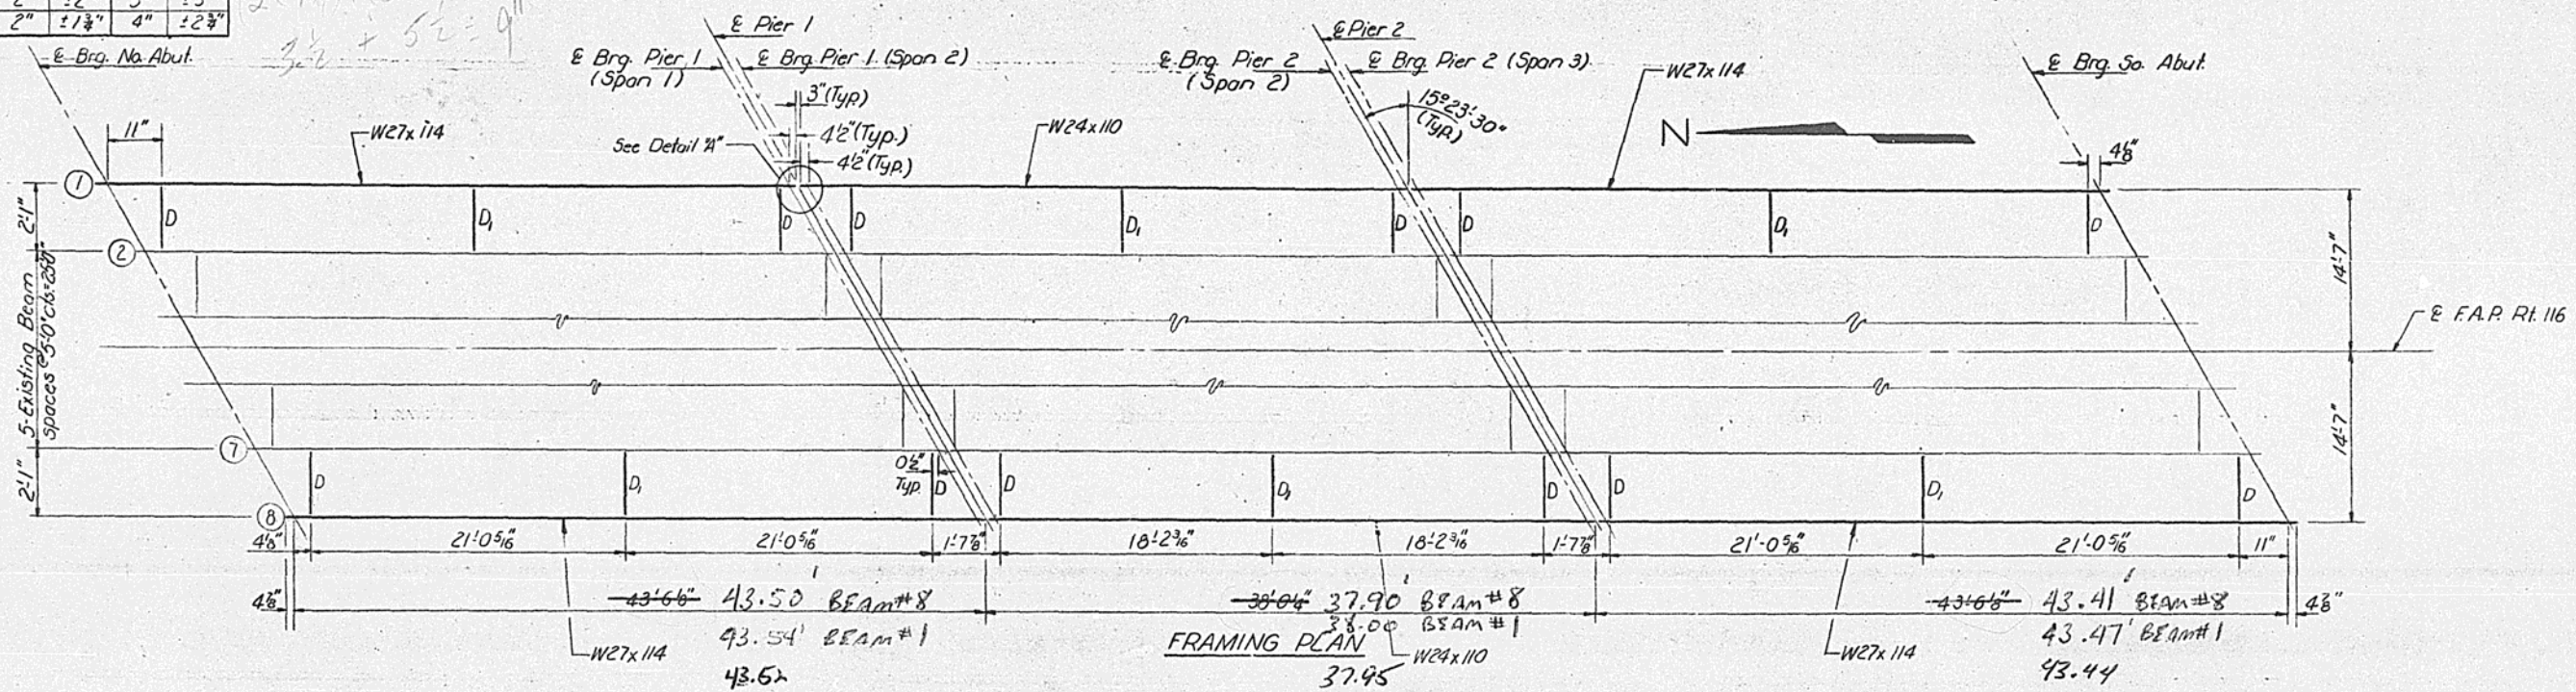


DIAPHRAGM D
AT OUTSIDE END
(12 Required)

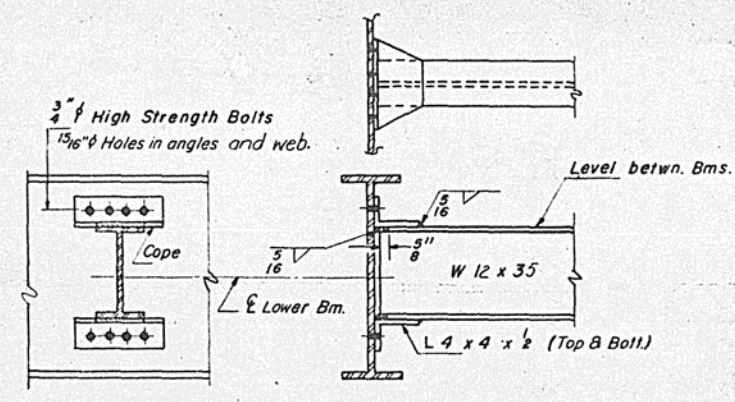

DIAPHRAGM D1
6 Required

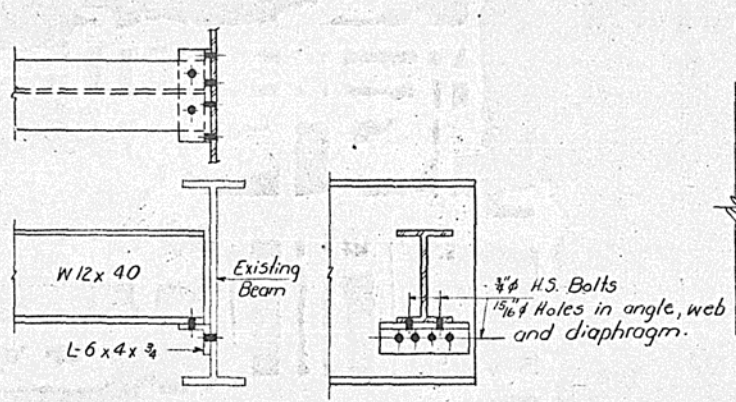

DIAPHRAGM D
AT INSIDE END

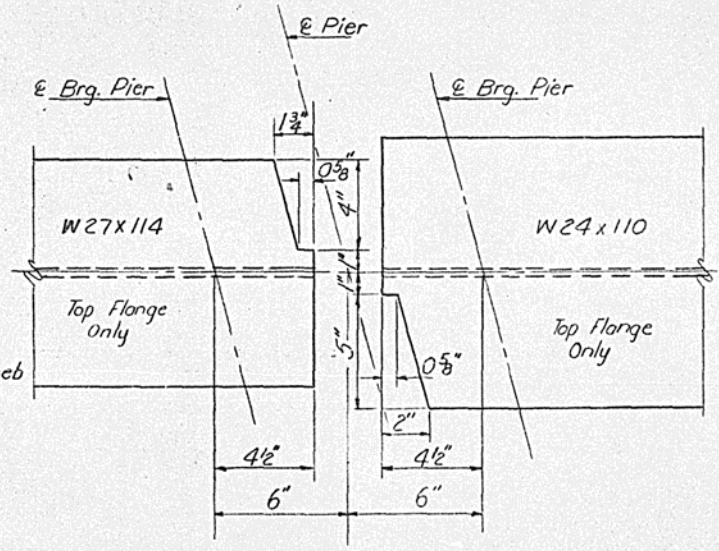

DETAIL "A"
(Pier 1 - Looking East)
(Pier 2 - Looking West)

Note: Hardened washers shall be required over 1 5/16" holes in angles. (2 washers per bolt).


Note:
It shall be necessary to drill 1 5/16" holes in the existing beam webs to attach the new diaphragm connecting angles.
All contact surfaces of joints for the diaphragms shall be free of paint or lacquer.

DESIGNED	Richard Brunette	EXAMINED	JUN 6 1980
CHECKED	Michael J. Ryan	PASSED	
DRAWN	R. Daly	APPROVED	
CHECKED	M.R.		


STRUCTURAL STEEL
F.A.P. RT. 116 SEC. 113VBR
CUMBERLAND COUNTY
STA. 498+60.60

STATE OF ILLINOIS
DEPARTMENT OF TRANSPORTATION


PROJECT NO.	SECTION	LOCATION	TOTAL SHEETS	SHEET NO.
116	H3VBR	CUMBERLAND	26	20
SHEET NO. 9			13 SHEETS	

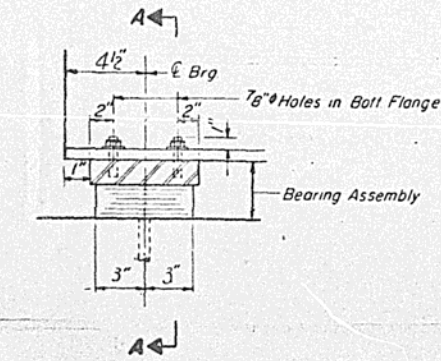


SECTION AT PIER

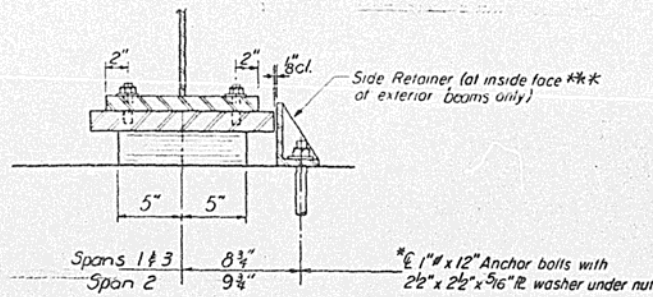

SECTION A-A

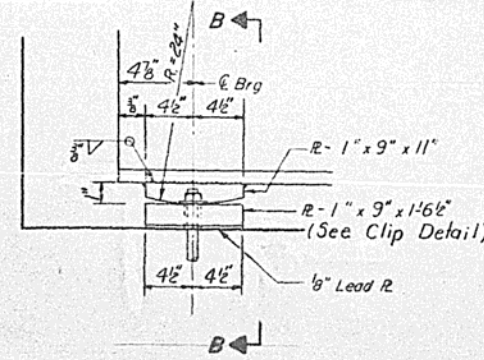

ELEVATION AT ABUT.

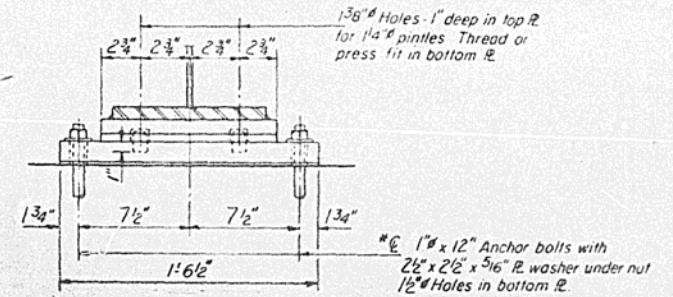


SECTION B-B


TYPE I ELASTOMERIC EXP. BRG.

FIXED BEARING


*Note: After beams have been erected holes at expansion bearings shall be drilled and anchor bolts grouted in place. Anchor bolts at fixed bearings may be built into the masonry.

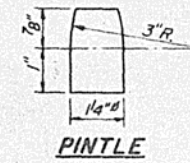

PINTLE

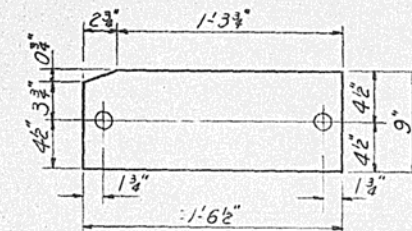

PLAN CLIPPED BOT. BRG. AT ABUT.

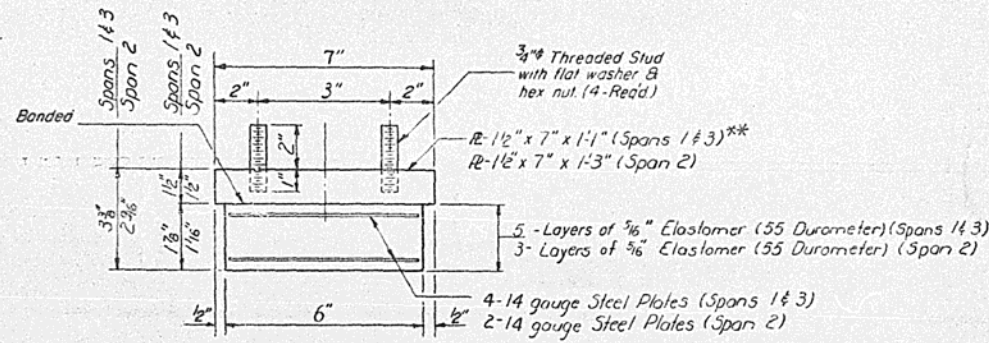


BEARING ASSEMBLY


Note: Shim plates shall not be placed under Bearing Assembly.

TOP OF FLANGE ELEVATIONS
(For fabrication only)


Location	Brig. No. Abut.	Brig. Pier 1 Span 1	Brig. Pier 1 Span 2	Brig. Pier 2 Span 2	Brig. Pier 2 Span 3	Brig. So. Abut.
Beam #1	614.67	614.91	614.84	614.80	614.87	614.70
Beam #8	614.70	614.91	614.84	614.85	614.92	614.71

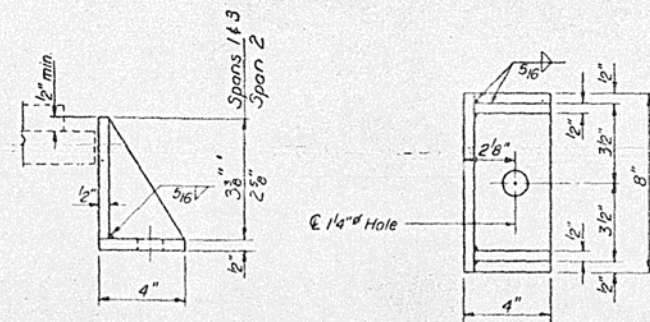

SIDE RETAINER

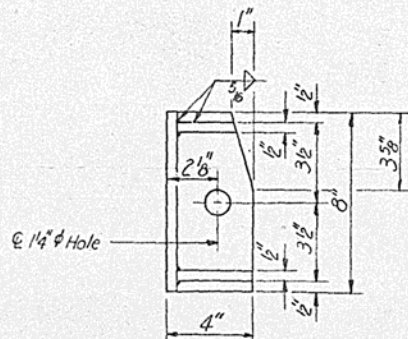

*** PLAN CLIPPED SIDE RETAINER AT PIER 1, SPAN 2, BM. 1 & PIER 2, SPAN 2, BM. 8

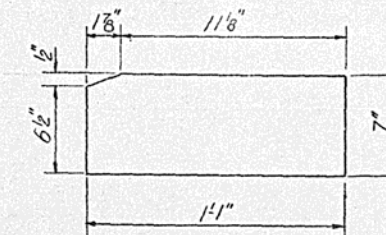

** PLAN CLIPPED TOP BRG. AT PIER 2, SPAN 3, BM. 8 & PIER 1, SPAN 1, BM. 1

BILL OF MATERIAL

Item	Unit	Total
Elastomeric Bearing Assembly, Type I	Each	8


DESIGNED Richard Brunette	EXAMINED [Signature]
CHECKED Michel J. P. [Signature]	PASSED [Signature]
DRAWN R. Doty	APPROVED [Signature]
CHECKED M.J.P.	DIRECTOR OF HIGHWAYS

I-2-E1 4-1-79


BEARING DETAILS
F.A.P. RT. 116 SEC. 113VBR
CUMBERLAND COUNTY
STA. 4.98+60.60

STATE OF ILLINOIS
DEPARTMENT OF TRANSPORTATION

ROUTE NO.	SECTION	COUNTY	TOTAL SHEETS	SHEET NO.
116	113VBR	CUMBERLAND	26	21
SHEET NO. 10 13 SHEETS				

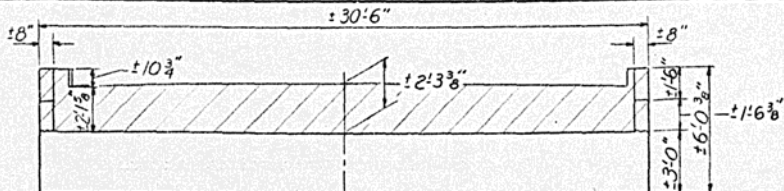

DETAIL OF EXISTING STRUCTURE

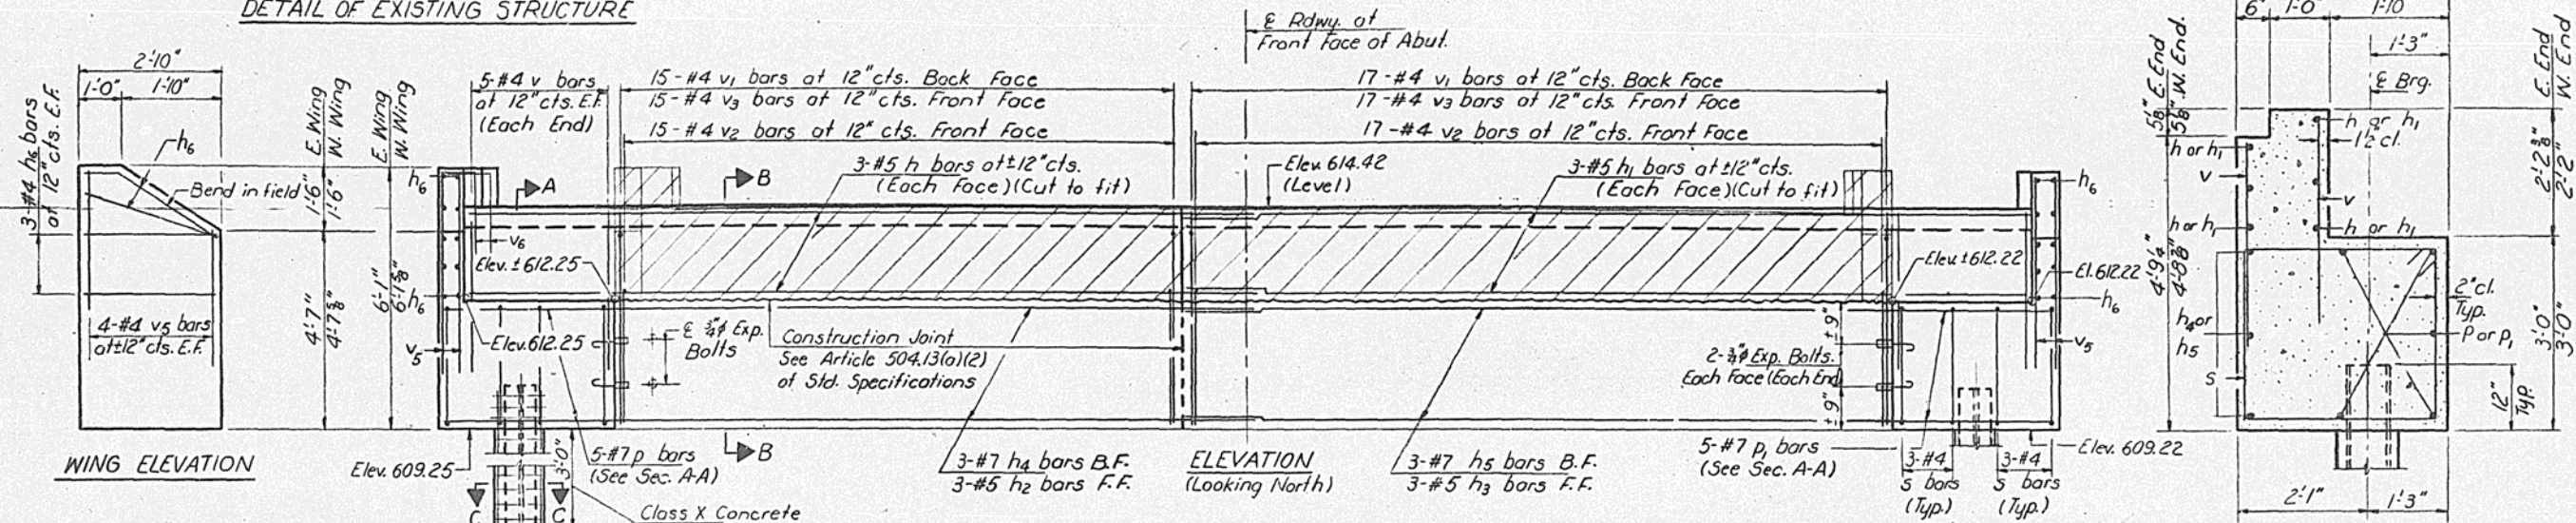


WING ELEVATION

ELEVATION (Looking North)

SECTION A-A (Dim. @ Rt. Ls)


Welded wire fabric 6x6-W40xW40 weighing 58#/100 sq. ft. The cost of Class X Concrete Encasement and Reinforcement is incidental to the cost of furnishing piles. Forms for encasement may be omitted when soil conditions will permit.

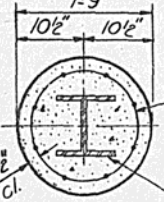


SEC. C-C

BILL OF MATERIAL

Bar No.	Size	Length	Shape
h	6	#5	20'-2"
h1	6	#5	20'-9"
h2	3	#5	16'-3"
h3	3	#5	16'-6"
h4	3	#7	20'-2"
h5	3	#7	20'-3"
h6	20	#4	2'-7"
p	5	#7	4'-0"
p1	5	#7	4'-1"
s	12	#4	12'-1"
v	20	#4	3'-9"
v1	32	#4	5'-9"
v2	32	#4	3'-8"
v3	32	#4	2'-0"
v4	27	#5	2'-6"
v5	16	#4	4'-4"
v6	2	#4	3'-3"
Class X Concrete		Cu.Yd.	10.8
Reinforcement Bars		Pound	1240
Concrete Removal		Cu.Yd.	2
Steel Piles (HP10x42)		Lin. Ft.	66
Expansion Bolts 3/4"		Each	48

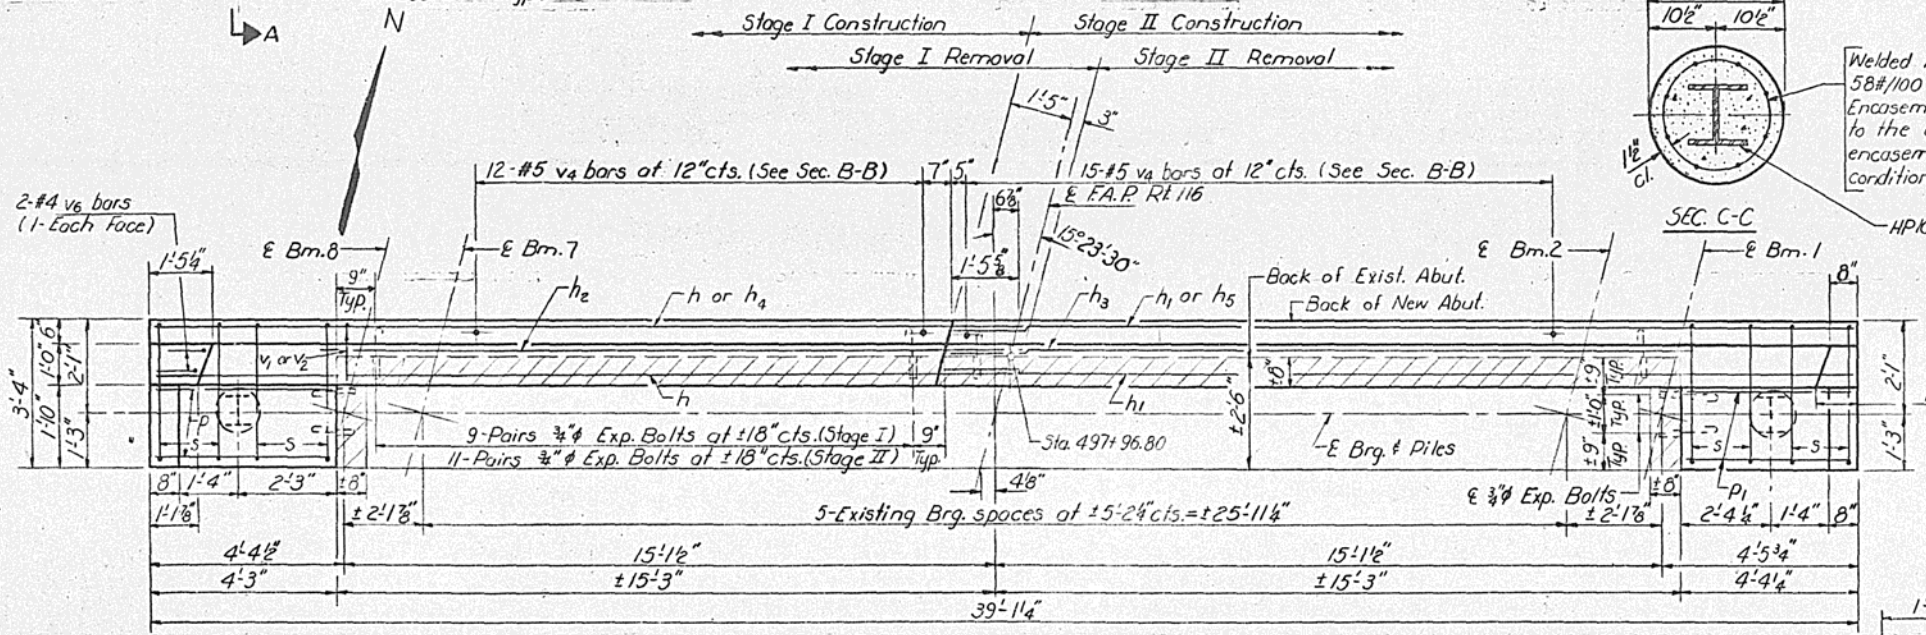


PLAN

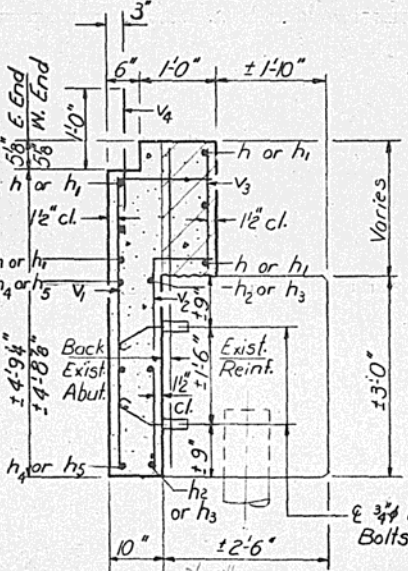


SECTION B-B (Dim. @ Rt. Ls)

PILE DATA
Type: Steel HP10x42
Capacity: 35 Tons
Est. Length: 33'
No. Required: 2

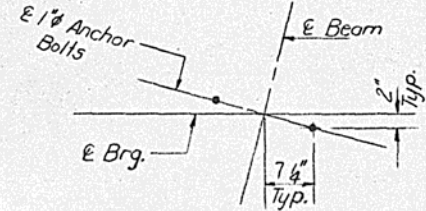


DETAIL OF BRG. OFFSETS

Notes:
Hatched area indicates Concrete Removal.
Reinforcement extending into removed area shall be cleaned and incorporated into the new construction.
Expansion bolts shall be anchored in sound concrete.
All edges shall have standard 3/4" chamfers except as noted.
Space reinforcement in cop to miss anchor bolts.

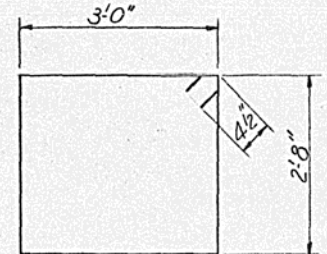

BAR S

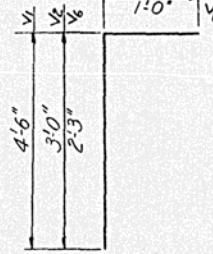

BARS v1, v2 & v3


DESIGNED	Richard Brunette
CHECKED	Michael J. Ryan
DRAWN	R. Doty
CHECKED	MJR

EXAMINED	JUNE 6 1980
PASSED	
APPROVED	


NORTH ABUTMENT
F.A.P. RT. 116 SEC. 113 VBR
CUMBERLAND COUNTY
STA. 498+60.60

STATE OF ILLINOIS
DEPARTMENT OF TRANSPORTATION

ROUTE NO.	SECTION	COUNTY	TOTAL SHEETS	SHEET NO.
116	VBR	CUMBERLAND	26	22
SHEET NO. 11 13 SHEETS				

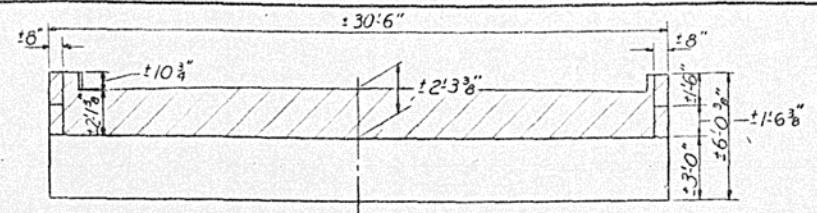

DETAIL OF EXISTING STRUCTURE


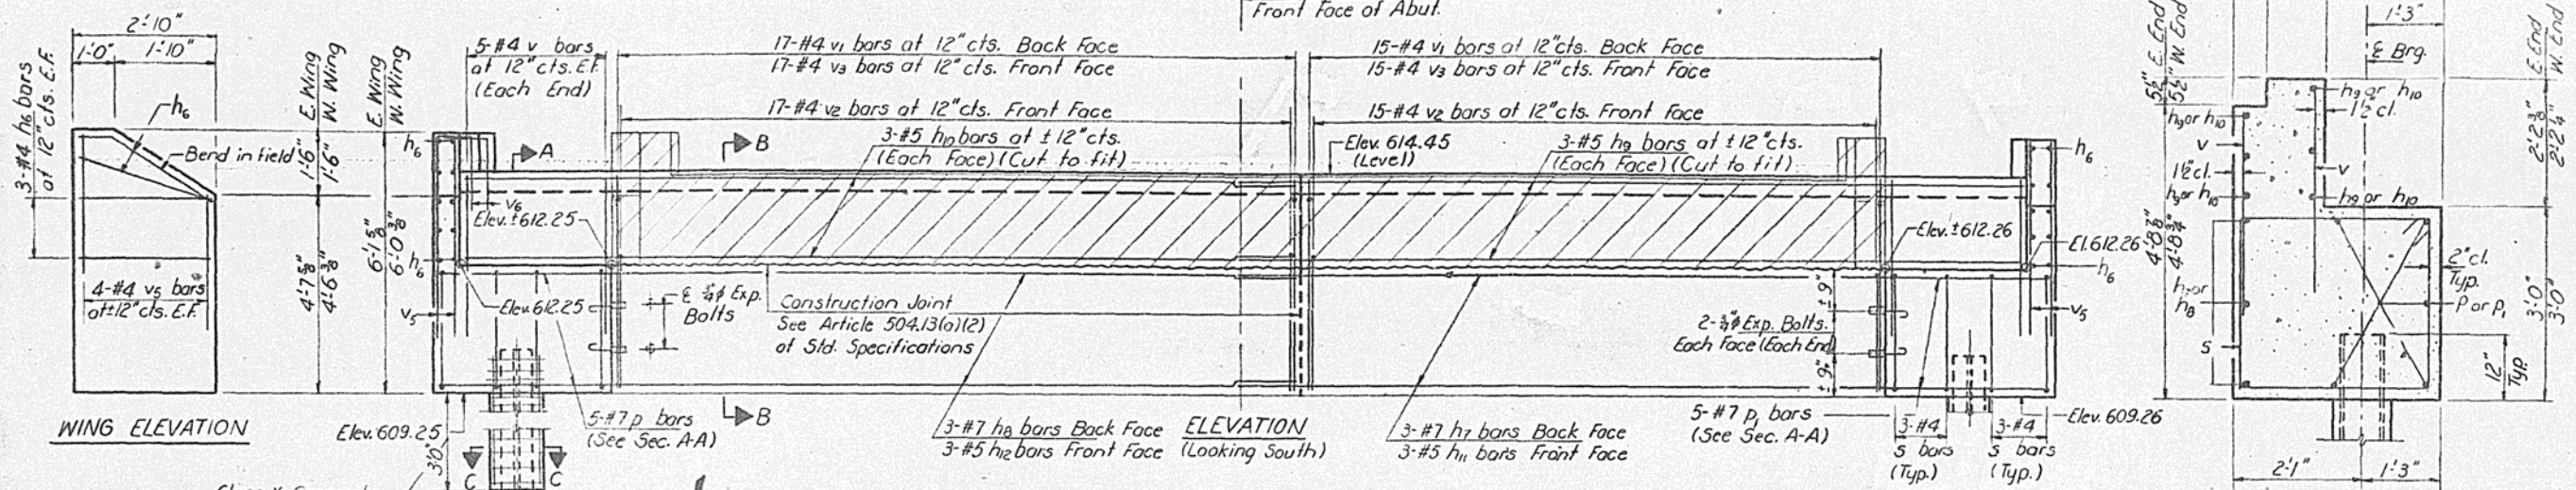


WING ELEVATION


ELEVATION (Looking South)

SECTION A-A (Dim. @ Rt. Ls)

Welded wire fabric 6x6-W40xW40 weighing 58#/100 sq. ft. The cost of Class X Concrete Encasement and Reinforcement is incidental to the cost of furnishing piles. Forms for encasement may be omitted when soil conditions will permit.

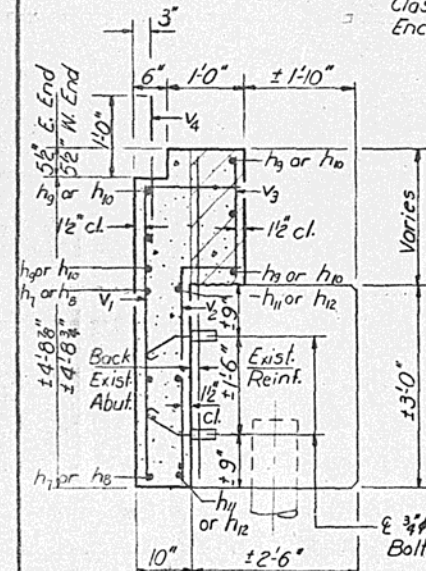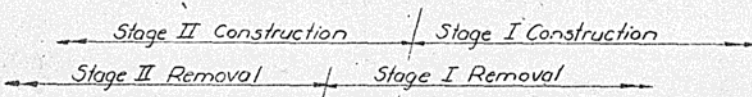

SECTION B-B (Dim. @ Rt. Ls)

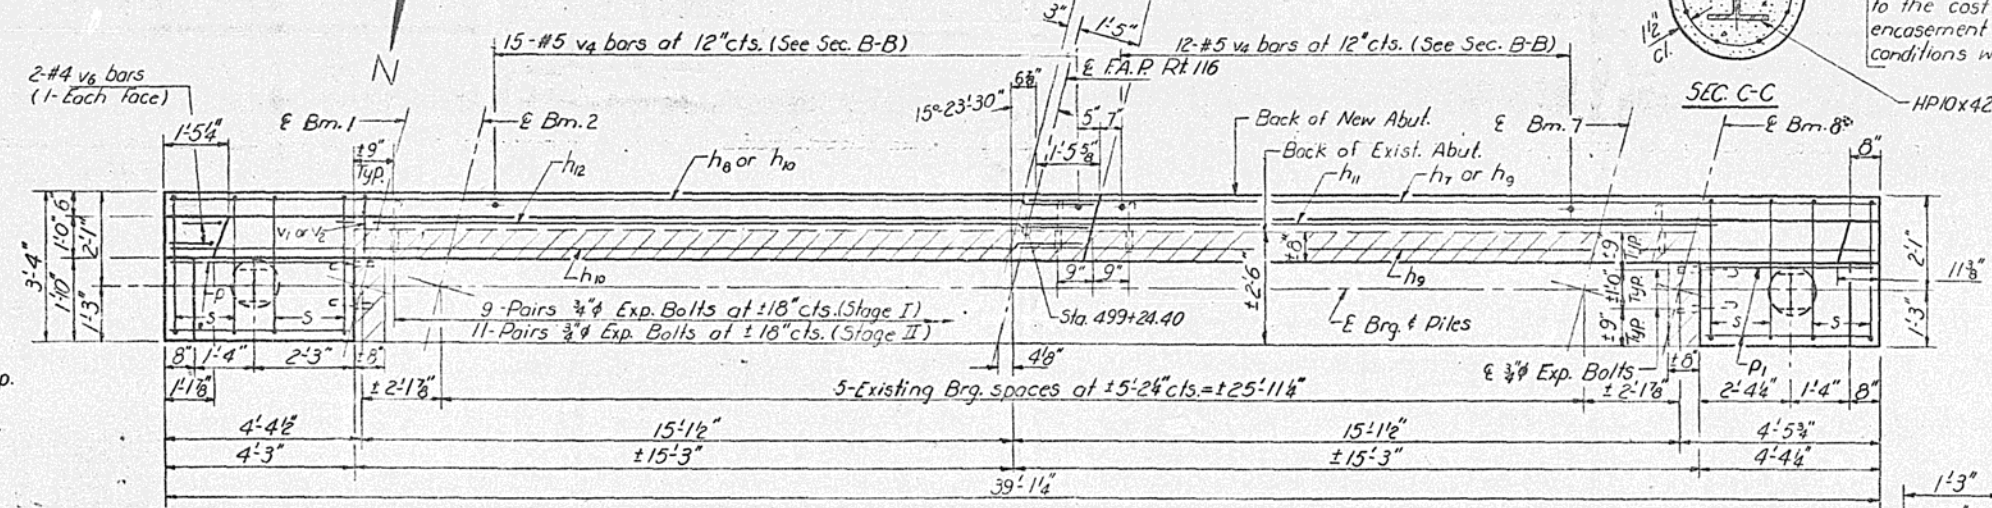


PLAN

SEC. C-C

BILL OF MATERIAL


Bar No.	Size	Length	Shape
h ₆	#4	2'-7"	—
h ₇	#7	19'-2"	—
h ₈	#7	21'-5"	—
h ₉	#5	19'-6"	—
h ₁₀	#5	21'-5"	—
h ₁₁	#5	15'-6"	—
h ₁₂	#5	17'-5"	—
p	#7	4'-0"	—
p ₁	#7	4'-1"	—
s	#4	12'-1"	□
v	#4	3'-9"	—
v ₁	#4	5'-9"	—
v ₂	#4	3'-8"	—
v ₃	#4	2'-10"	—
v ₄	#5	2'-6"	—
v ₅	#4	4'-4"	—
v ₆	#4	3'-3"	—
Class X Concrete	Cu.Yd.	10.8	
Reinforcement Bars	Pound	1240	
Concrete Removal	Cu.Yd.	2	
Steel Piles (HPIux 42)	Lin. Ft.	88	
Expansion Bolts 3/4"	Each	48	

PILE DATA
Type: Steel HPIux 42
Capacity: Drive to Refusal
Est. Length: 44'
No. Required: 2

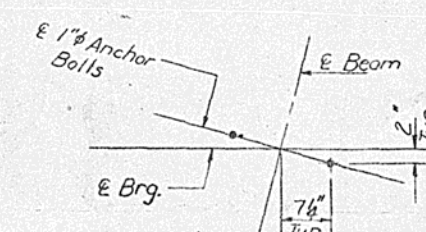


DETAIL OF BRG. OFFSETS

Notes:
Hatched area indicates Concrete Removal.
Reinforcement extending into removed area shall be cleaned and incorporated into the new construction.
Expansion bolts shall be anchored in sound concrete.
All edges shall have standard 3/8" chamfers except as noted.
Space reinforcement in cap to miss anchor bolts.

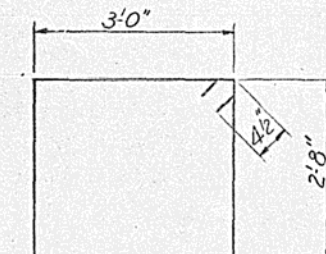

BAR S

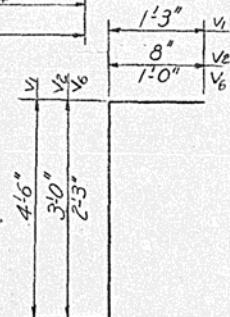

BARS v₁, v₂, v₃

DESIGNED Richard Brunette
CHECKED M. J. Ryan
DRAWN R. Doly
CHECKED M. J. Ryan

EXAMINED [Signature]
PASSED [Signature]
APPROVED [Signature]
JUNE 6 1980








SOUTH ABUTMENT
F.A.P. RT. 116 SEC. 113 VBR
CUMBERLAND COUNTY
STA. 498+6060

STATE OF ILLINOIS
DEPARTMENT OF TRANSPORTATION

ROUTE NO.	SECTION	COUNTY	TOTAL SHEETS	SHEET NO.
116	113VBR	CLAMBERLAND	26	23
PER ROAD DIST. NO. 7	ILLINOIS	PER AID PROJECT		

SHEET NO. 12
13 SHEETS

NOTES:
Hatched areas indicate Concrete Removal.
Reinforcement extending into removed areas shall be cleaned and incorporated into the new construction.
Expansion bolts shall be anchored in sound concrete.
All edges shall have standard $\frac{3}{8}$ " chamfers except as noted.
Space reinforcement in top to miss anchor bolts.

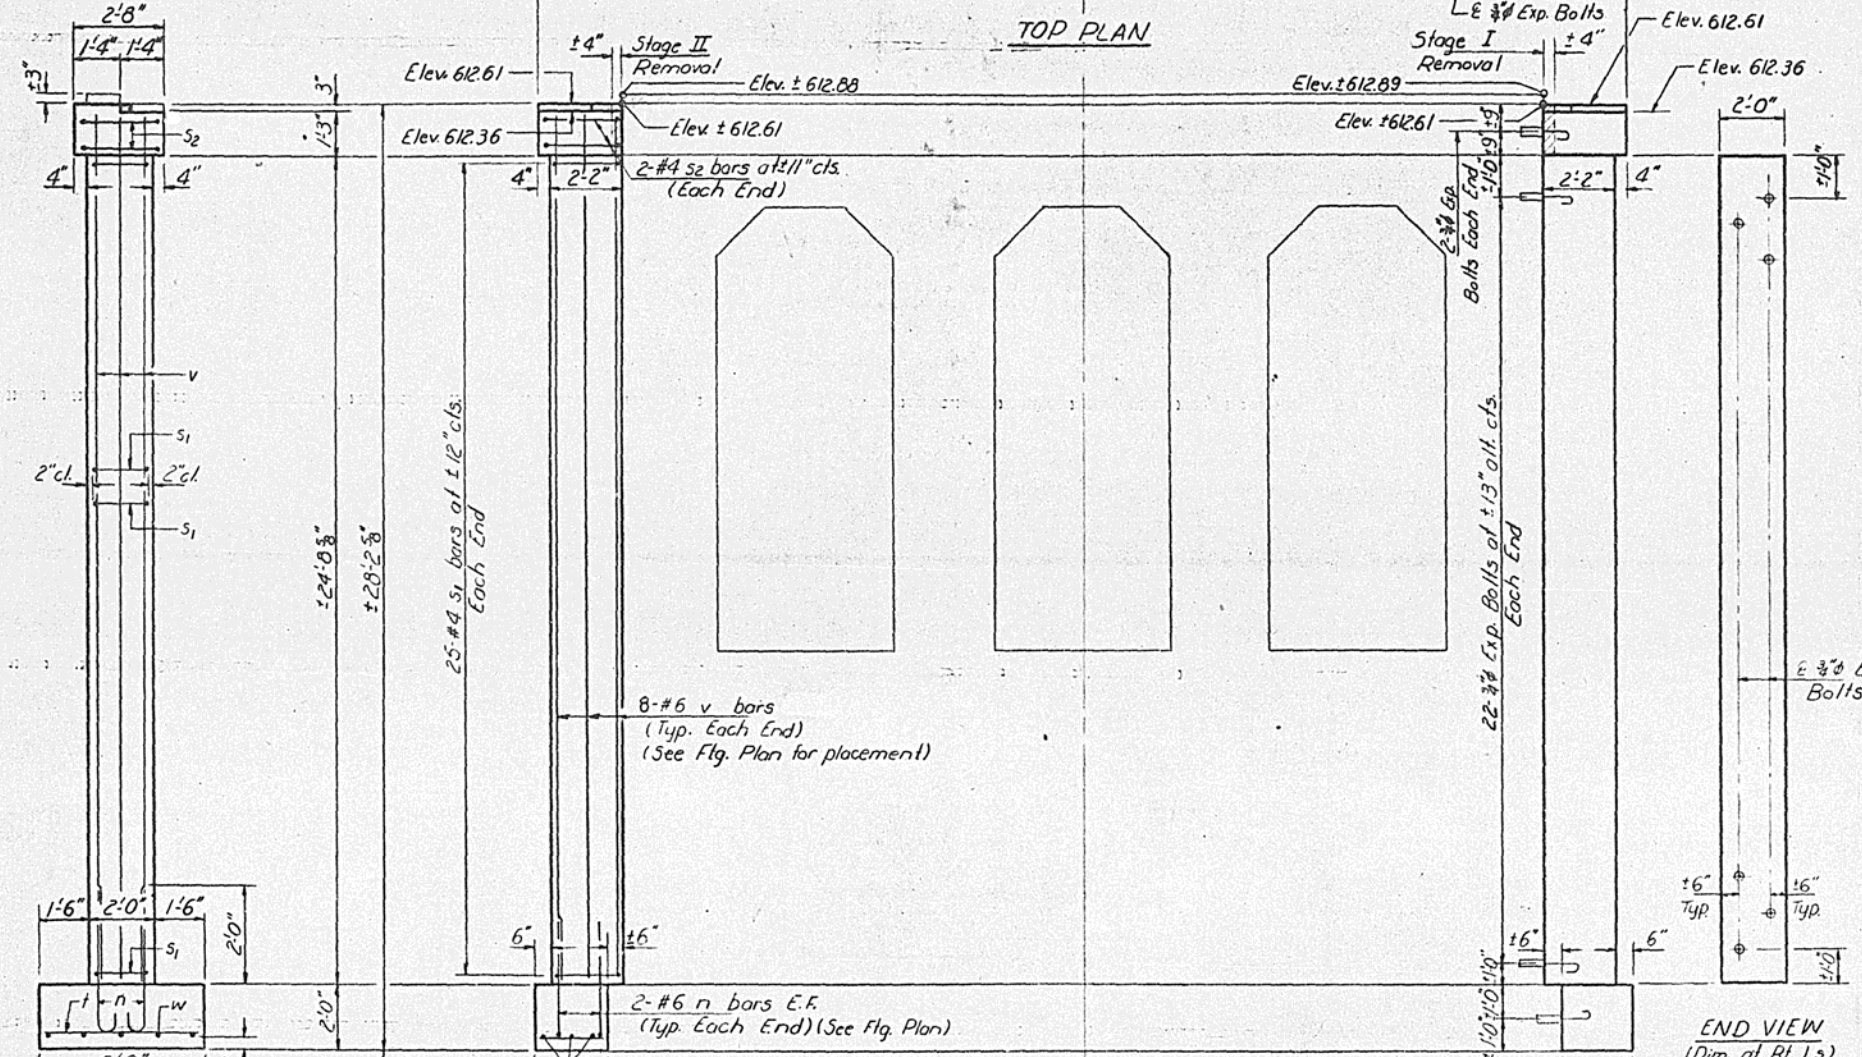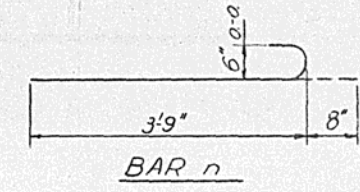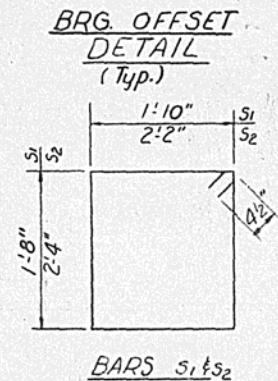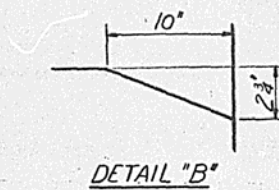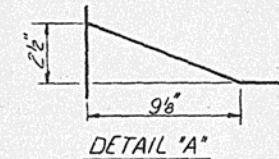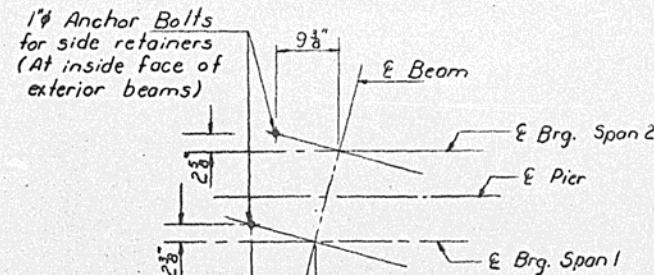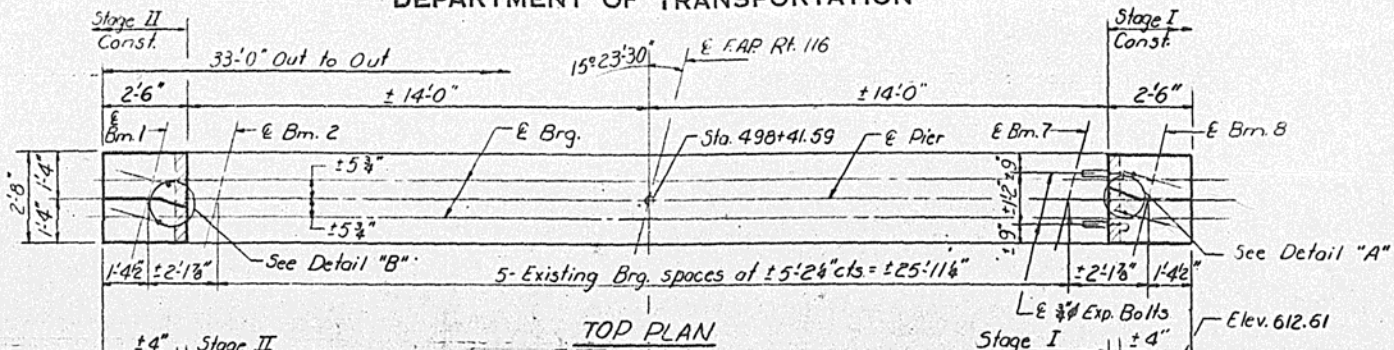

BILL OF MATERIAL


Bar	No	Size	Length	Shape
n	6	#6	4'-5"	→
s1	50	#4	7'-9"	□
s2	4	#4	9'-9"	□
v	16	#6	25'-8"	—
w	10	#5	1'-11"	—

Class X Concrete Cu. Yd. 10.2
Reinforcement Bars Pound 1000
Expansion Bolts $\frac{3}{8}$ " Each 54
Concrete Removal Cu. Yd. *

*Quantity included in Total Bill of Material on sheet #1.

DESIGNED Richard Brunette
CHECKED Michael J. Ryan
DRAWN P. Doty
CHECKED mjr

EXAMINED [Signature] June 6 1980
PASSED [Signature]
APPROVED [Signature]
ENGINEER OF DESIGN
DIRECTOR OF HIGHWAYS






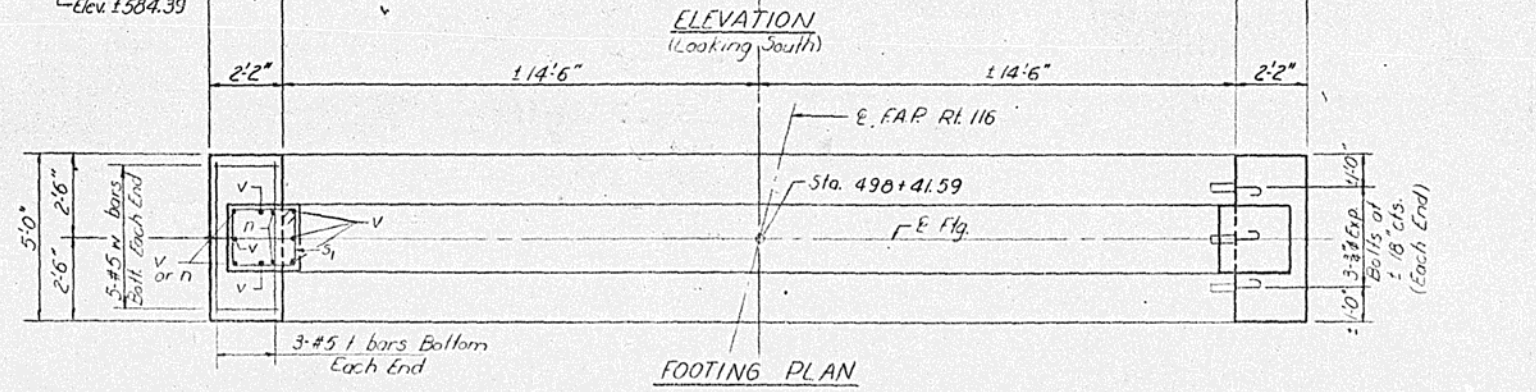


PIER 1
F.A.P. RT. 116 SEC. 113VBR
CLAMBERLAND COUNTY
STA. 498+60.60

STATE OF ILLINOIS
DEPARTMENT OF TRANSPORTATION

ROUTE NO.	SECTION	COUNTY	TOTAL SHEETS	SHEET NO.
116	113VBR	CUMBERLAND	26	74
FED. ROAD DIST. NO. 7		DISTRICT	FED. AID PROJECT	SHEET NO. 13
				13 SHEETS

NOTES:
Hatched areas indicate Concrete Removal.
Reinforcement extending into removed areas shall be cleaned and incorporated into the new construction.
Expansion bolts shall be anchored in sound concrete.
All edges shall have standard $\frac{3}{8}$ " chamfers except as noted.
Space reinforcement in top to miss anchor bolts.

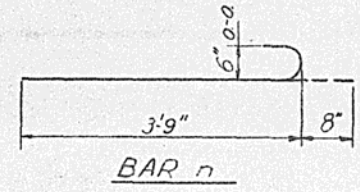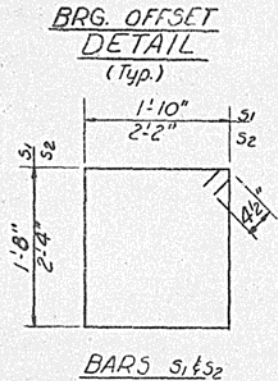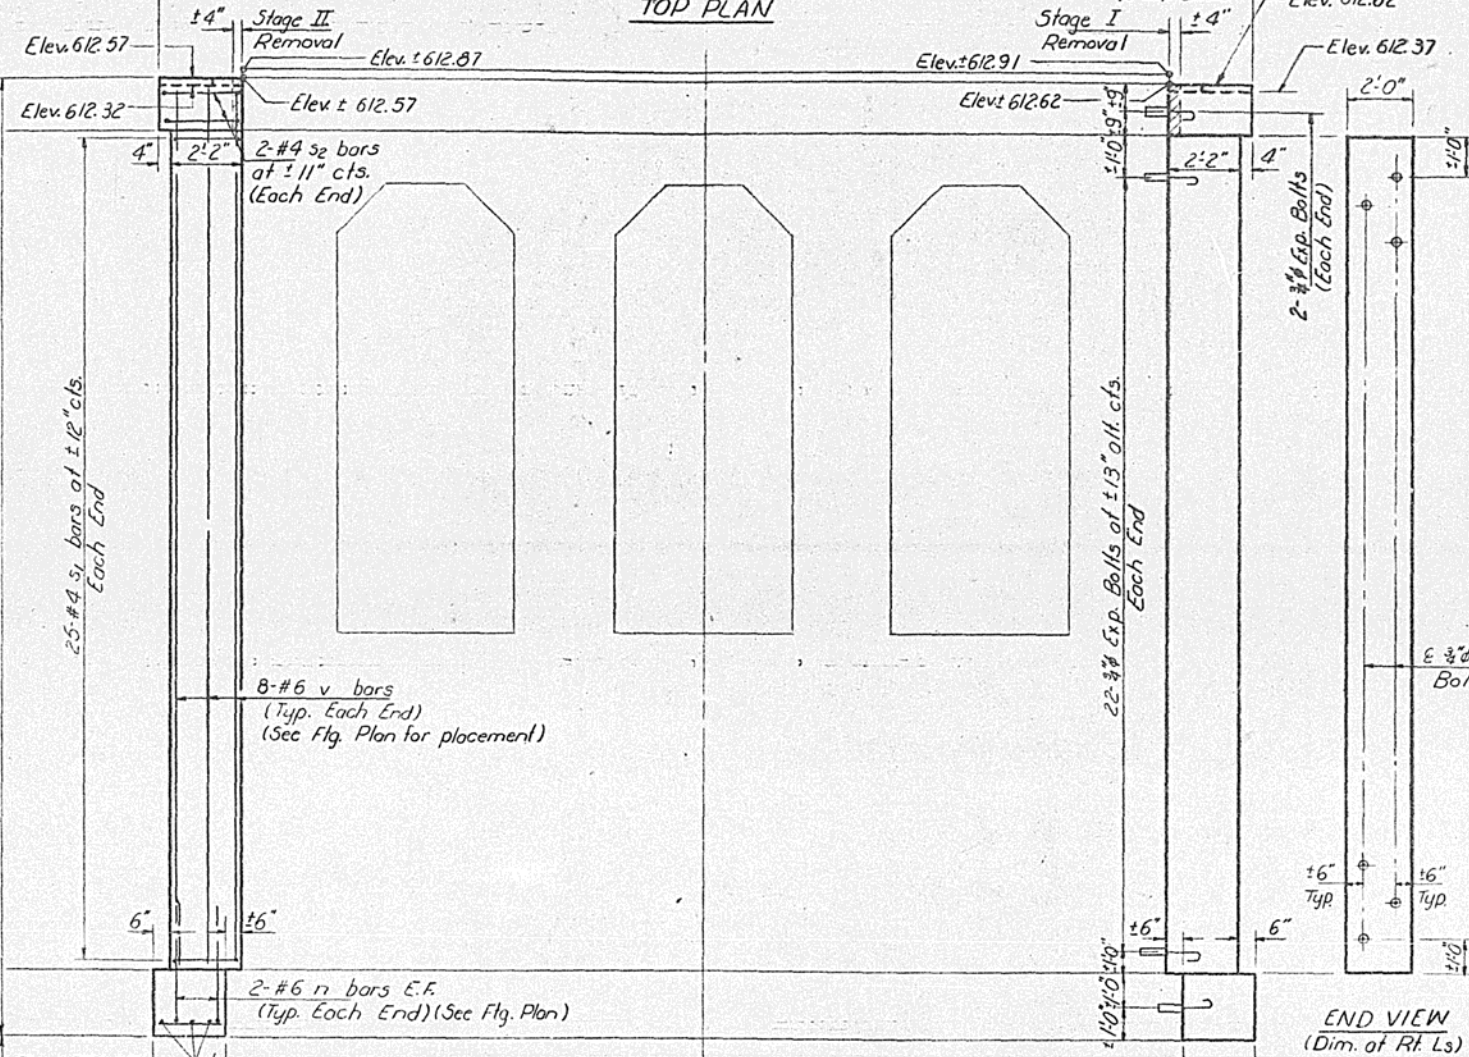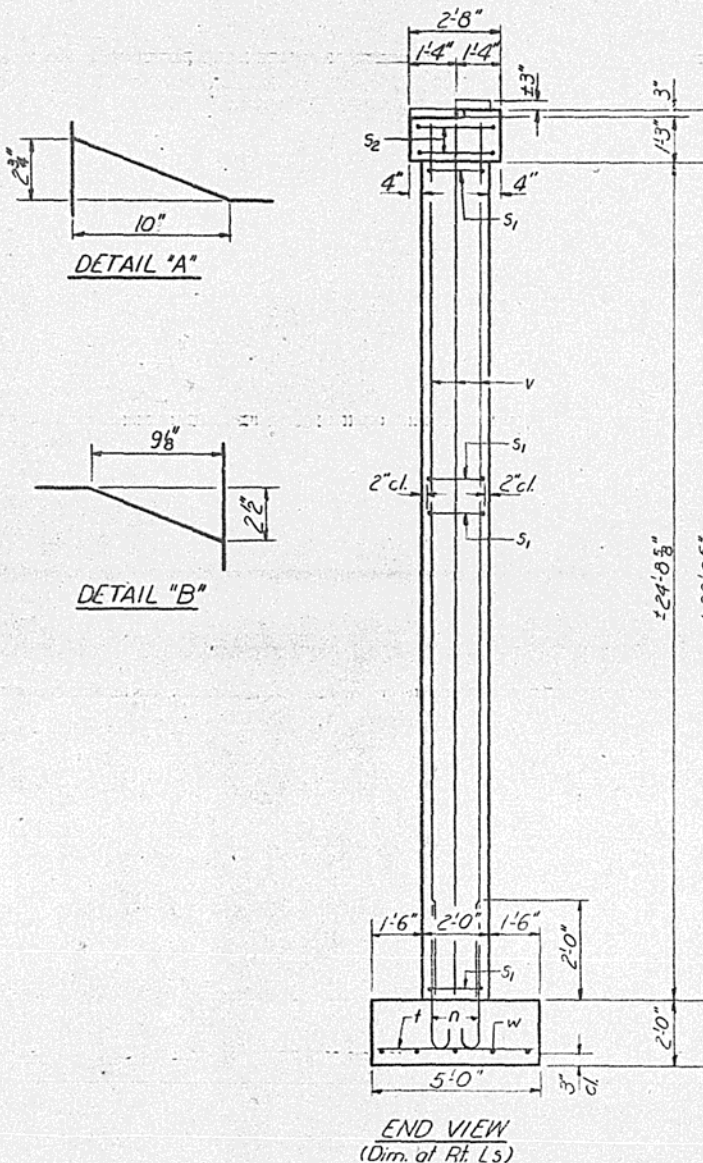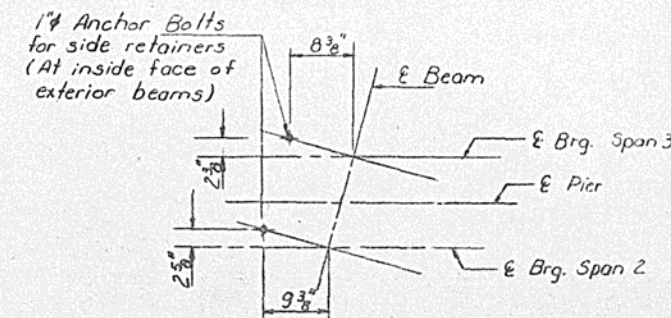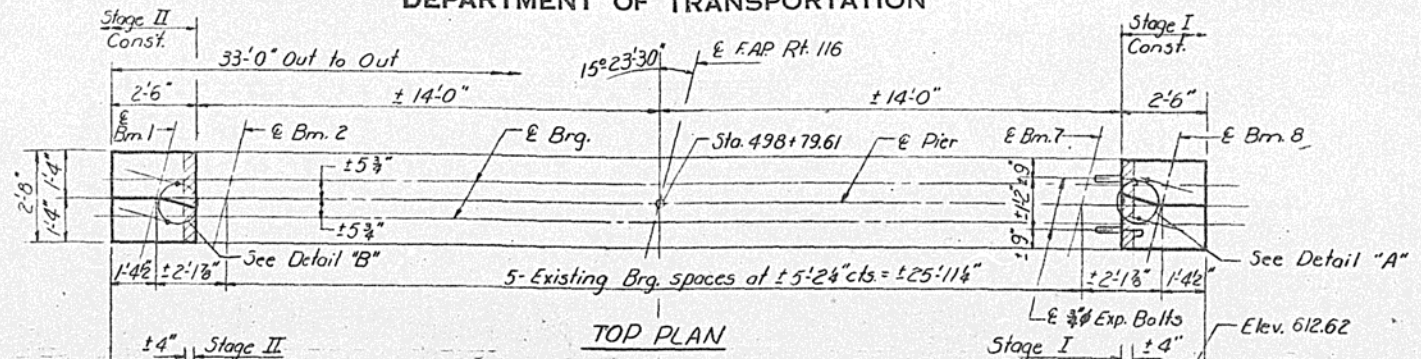


BILL OF MATERIAL

Bar	No.	Size	Length	Shape
n	8	#6	4'-5"	—
s1	50	#4	7'-9"	□
s2	4	#4	9'-9"	□
f	6	#5	4'-9"	—
v	16	#6	2'-8"	—
w	10	#5	1'-11"	—
Class X Concrete		Cu. Yd.	10.2	
Reinforcement Bars		Pound	1000	
Expansion Bolts $\frac{3}{8}$ "		Each	54	
Concrete Removal		Cu. Yd.	*	

*Quantity included in Total Bill of Material on sheet #1.

DESIGNED Richard Brunette
CHECKED Michael J. Ryan
DRAWN R. Doty
CHECKED MJR

EXAMINED
PASSED
APPROVED
JUNE 6 1980
ENGINEER OF BRIDGE AND TRAFFIC STRUCTURES
DIRECTOR OF HIGHWAYS

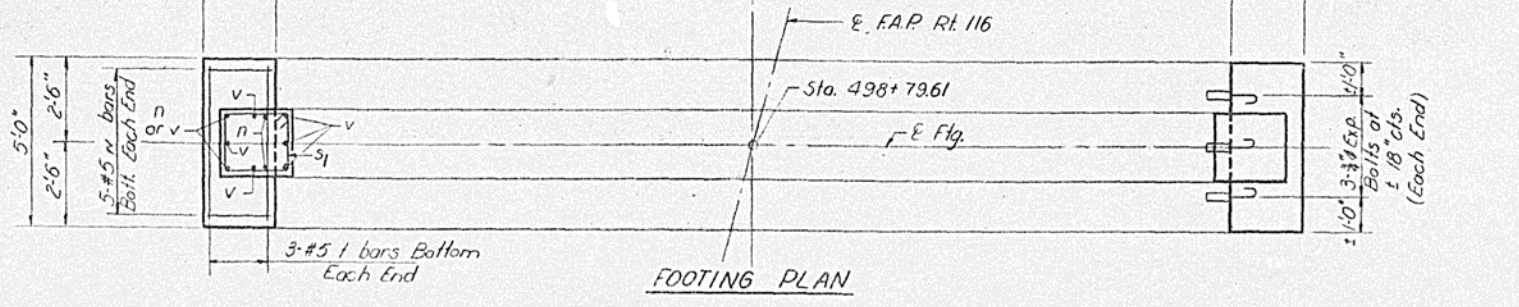

PIER 2
F.A.P. RT. 116 SEC. 113VBR
CUMBERLAND COUNTY
STA. 498+60.60

ROUTE NO.	SEC.	COUNTY	TOTAL SHEETS	SHEET NO.
F.A.P. 116	113WB	CUMBERLAND	26	25
REG. ROAD DIST. NO. 1 ILLINOIS			PROJECT	

DATE	BY

DATE	BY

DATE	BY


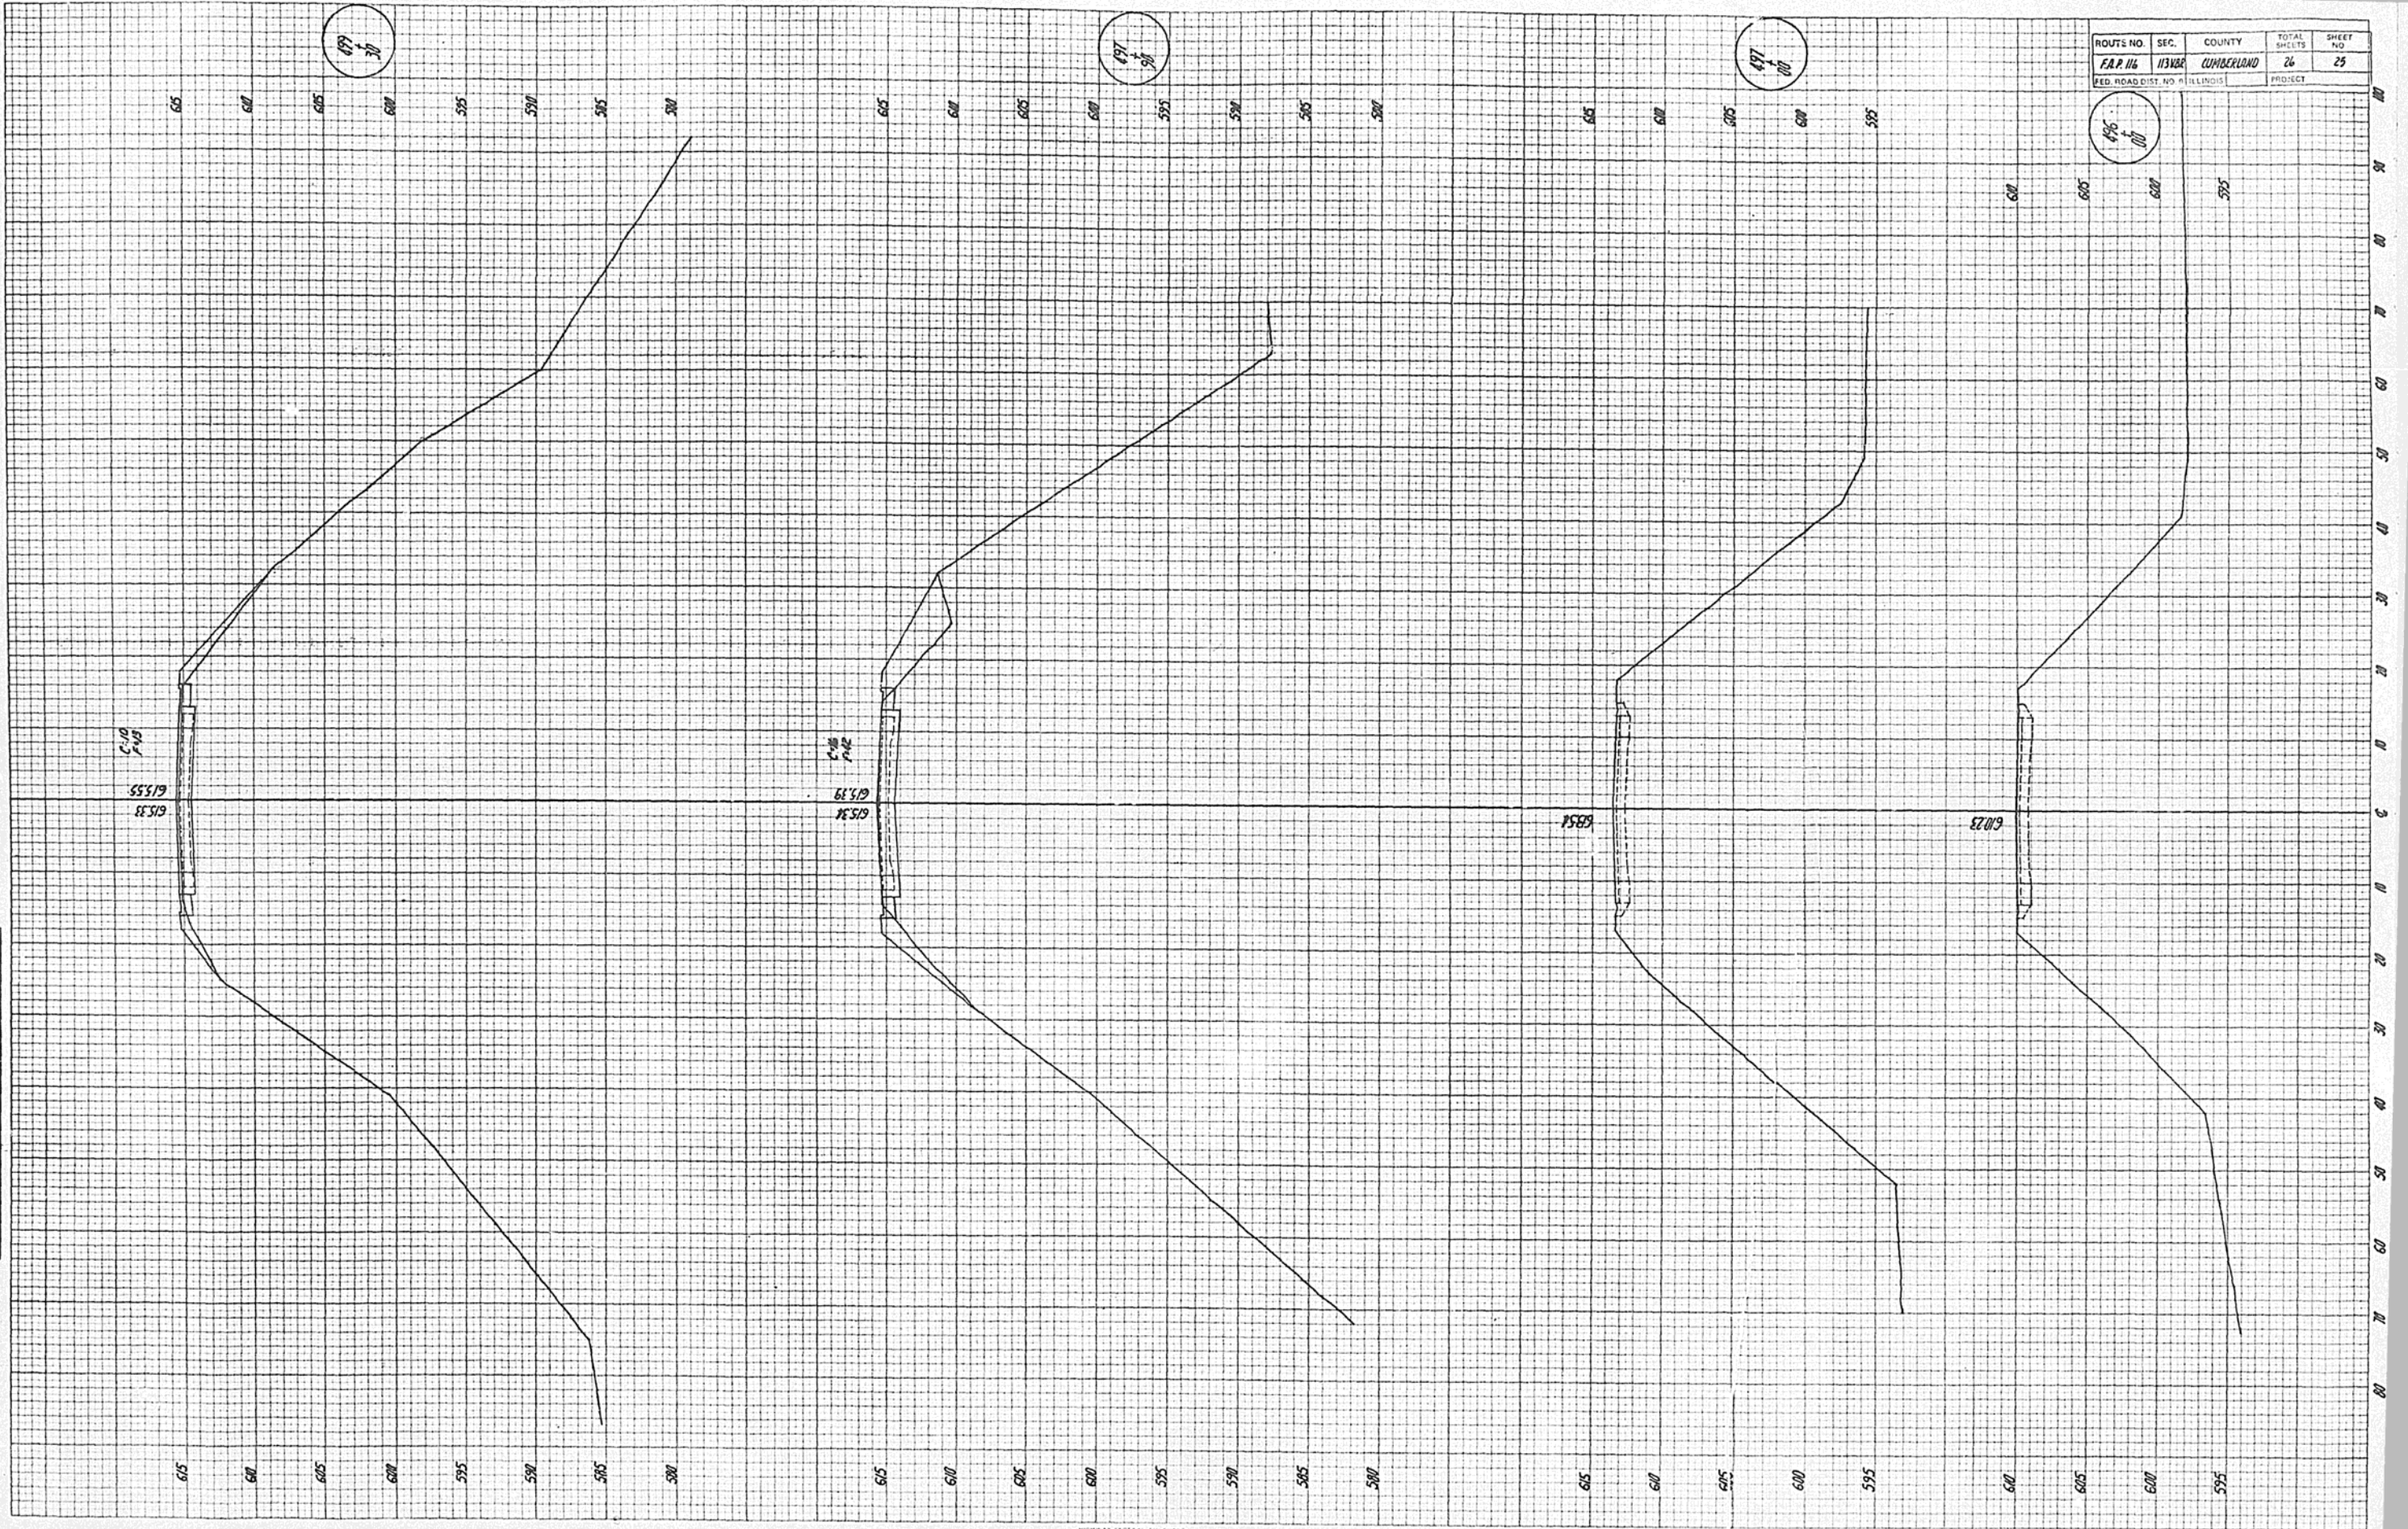


PLATE 3-FULL CROSS SECTION FULL LINE
 SETTLED
 PRINTED IN U.S.A.

DATE _____ BY _____
 FINAL SURVEY PLOTTED _____
 NOTE BOOK TEMPLATE _____
 NO. _____ AREA CHECKED _____

DATE _____ BY _____
 ORIGINAL SURVEY PLOTTED _____
 NOTE BOOK TEMPLATE _____
 NO. _____ AREA CHECKED _____

ROUTE NO.	SEC.	COUNTY	TOTAL SHEETS	SHEET NO.
F.A.P. 116	1137BE	CUMBERLAND	26	26
EEO. ROAD DIST. NO. 8 ILLINOIS			PROJECT	

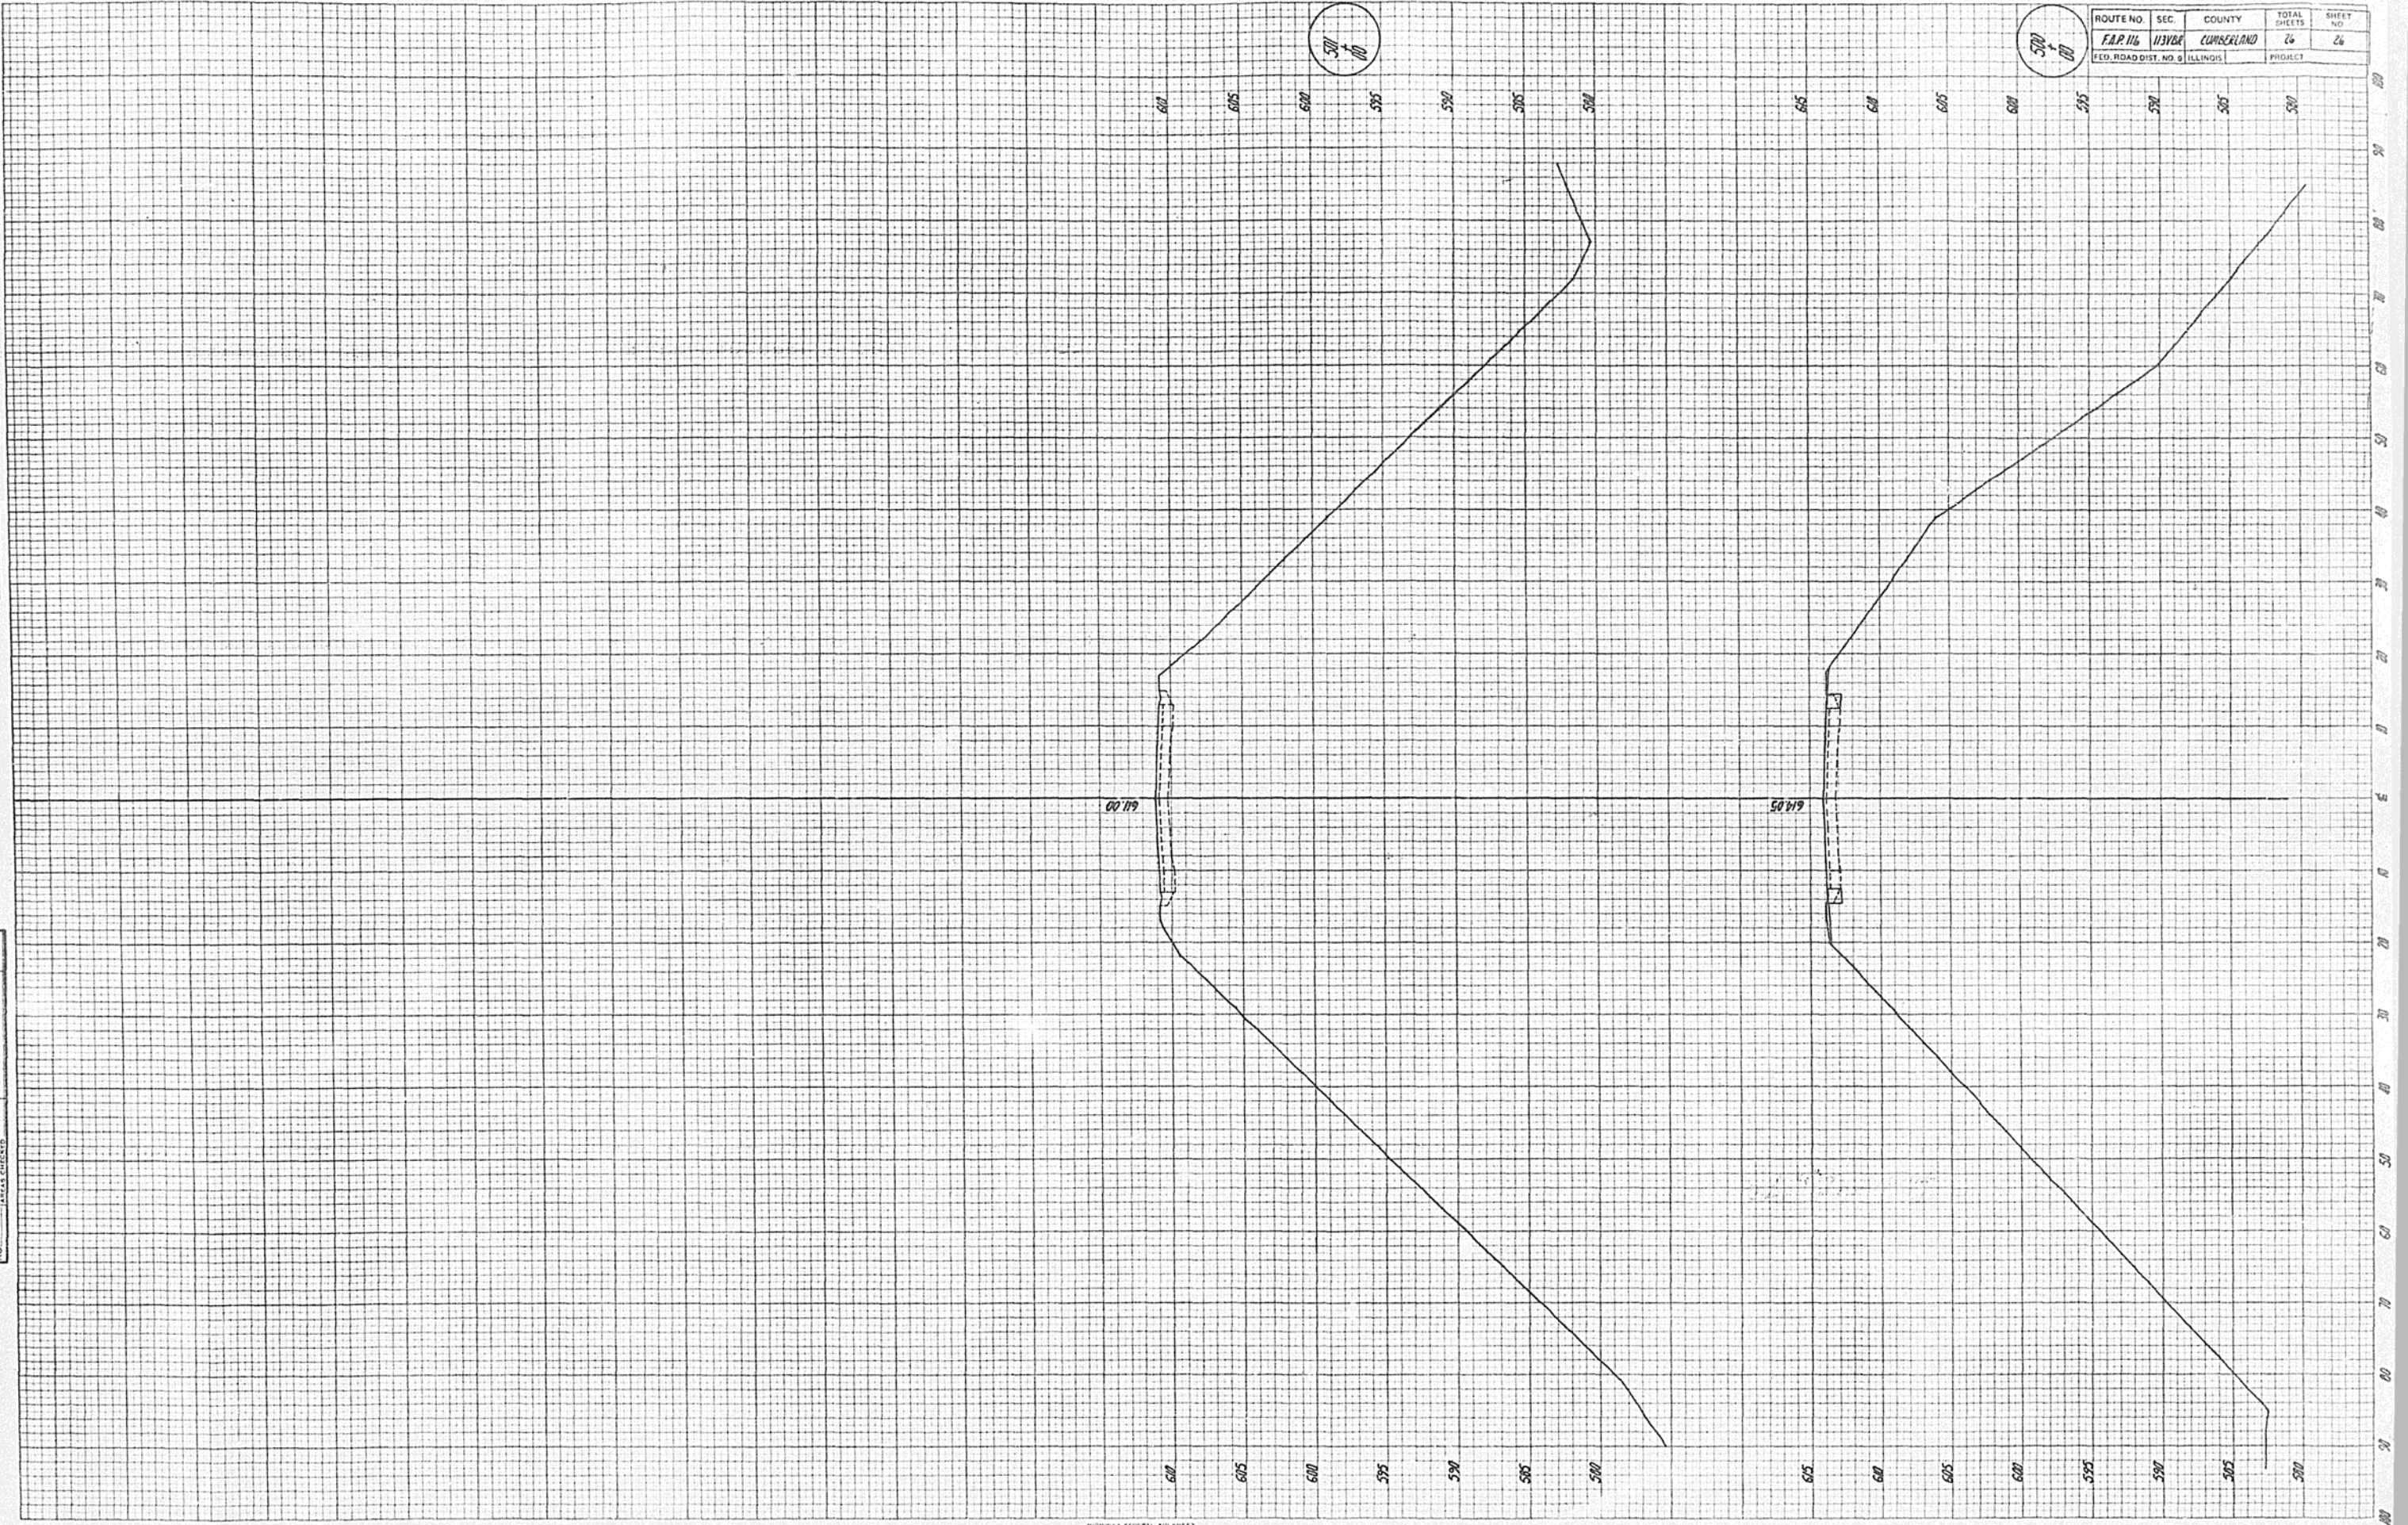

STANDARD SYMBOLS AND ABBREVIATIONS

THESE SYMBOLS AND ABBREVIATIONS ARE USED THROUGHOUT THESE PLANS UNLESS OTHERWISE NOTED

SYMBOLS

	North Arrow		Existing Storm or Sanitary Sewer		Catch Basin to be filled with Sand & Connection Sealed
	State Line		Railroad or Utility Tracks		Existing Manhole, Manhole to be Adjusted, or Manhole to be Reconstructed
	County Line		Curb Wall		Manhole to be Constructed
	Township Line		Retaining Wall		Manhole to be filled with Sand & Connection Sealed
	City, Village or Town Limits		Existing Drive or Traveled Way		Existing Valve Vault, Valve Vault to be Adjusted, or Valve Vault to be Reconstructed
	Section or Grant Line		Pipe Lines		Valve Vault to be Constructed
	Section Corner		Gas		Valve Vault to be filled with Sand & Connection Sealed
	Quarter Corner		Water		Existing Fire Hydrant, or Fire Hydrant to be Adjusted
	Same Ownership		Oil		Fire Hydrant & Auxiliary Valve to be Moved (Symbol with Letter Indicates New Location)
	Unfenced Property Line		Longitudinal Joint with Tie Bars (Sawed or Poly.)		Existing Light Standard, or Light Standard to be Adjusted
	Fenced Property Line		Longitudinal Joint with Tie Bars and Keyway		Light Standard to be Moved (Symbol with Letter Indicates New Location)
	Fence Line		Longitudinal Joint with Keyway only		Existing Traffic Signal, or Traffic Signal to be Adjusted
	Construction Identification Sign		Contraction Joint with Dowels		Traffic Signal to be Moved (Symbol with Letter Indicates New Location)
	Right of Way Marker		Contraction Joint without Dowels		Existing Traffic Sign, or Traffic Sign to be Adjusted
	Existing Right of Way Line		Expansion Joint with capped Dowels		Traffic Sign to be Moved (Symbol with Letter Indicates New Location)
	Existing Fenced Right of Way Line		Expansion Joint without Dowels		Existing House Service Box or House Meter Vault, or House Service Box or House Meter Vault to be Adjusted
	Proposed Right of Way Line		Wide Flange Beam Terminal Joint		House Service Box or House Meter Vault to be Moved (Symbol with Letter Indicates New Location)
	Proposed Right of Way Line coincident with access control line		Guard Rail		Existing Main Service Box or Main Meter Vault, or Main Service Box or Main Meter Vault to be Adjusted
	Access Control Line (Not coincident with Right of Way Line)		Existing Pavement, Curb & Gutter, Driveway Pavement & Sidewalk to be removed		Main Service Box or Main Meter Vault to be Moved (Symbol with Letter Indicates New Location)
	Proposed Right of Way Dimension		Existing Culvert		Trolley Pole
	Construction Limits		Culvert to be Constructed		Telephone or Telegraph Pole
	Base or Survey Line		Culvert with Drop Inlet		Power Line Pole
	Channel Change Easement		Elevation of Surface of Finished Pavement at Point Indicated		House
	Temporary Easement (Detour, Grading etc.)		Elevation of Top of Curb at Point Indicated		Church
	Stream		Elevation of Flow Line of Gutter at Point Indicated		Shed
	Lake or Pond		Storm Sewer (Direction of Flow & Invert Elevation Indicated)		Commercial Building
	Marsh		Tile Drain (Direction of Flow & Invert Elevation Indicated)		Barn
	Levee		Existing Inlet, Inlet to be Adjusted, or Inlet to be Reconstructed		School
	Summit		Inlet to be Constructed		Town Hall
	Deciduous Trees		Inlet to be filled with Sand & Connection Sealed		Roadway
	Evergreen Trees		Existing Catch Basin, Catch Basin to be Adjusted, or Catch Basin to be Reconstructed		Traffic Direction Arrow
	Hedge		Catch Basin to be Constructed		
	Centerline		Underground Electric Cable		
			Underground Telephone Cable		

ABBREVIATIONS

T.D. Tile Drain	℄-B. Centerline to Back of Curb	R.P.S. Reference Point Stake	Sec. Section
S.S. Storm Sewer (Existing)	Δ Central Angle	I.P. Iron Pipe	Sta. Station
S.S. Storm Sewer (Size, Length and Type)	D. Degree of Curve	N&W Nail & Washer	P.L. Property Line
S.S. Storm Sewer (Size, Length, Type and Material)	T. Tangent Length	T.P. Telephone Pole	F.E. Field Entrance
C.M.P. Corrugated Metal Pipe	L. Curve Length	P.P. Power Pole	P.E. Private Entrance
C.I.P. Cast Iron Pipe	R. Radius of Curve	F.P. Fence Post	F.A.I. Federal-aid Interstate
P.C. Pipe Culvert (Existing)	E. External Distance	F.H. Fire Hydrant	F.A. Federal-aid
P. Pipe Culvert (Size, Length and Type)	S. Superelevation (ft. per ft. of width)	B.M. Bench Mark	F.A.S. Federal-aid Secondary
P. Pipe Culvert (Size, Length, Type and Material)	P.C. Point of Curvature	R.R.S. Railroad Spike	S.B.I. State Bond Issue
P.C.C. Portland Cement Concrete	P.I. Point of Intersection	R.O.W. Right of Way	M.F.T. Motor Fuel Tax
F.-F. Face to Face of Curb	P.T. Point of Tangency	Inv. Invert	S.R. State-Route
B.-B. Back to Back of Curb	P.O.T. Point on Tangent	F.L. Flow Line	C.H. County Highway
℄-F. Centerline to Face of Curb	P.C.C. Point of Compound Curvature	S.M. State of Illinois Survey Marker	T.R. Township Road
	P.R.C. Point of Reverse Curvature	U.S.C.&G.S. U.S. Coast & Geodetic Survey	C.S. City Street
	V.C. Vertical Curve	U.S.G.S. U.S. Geological Survey	Proj. Project
	X. External Distance of Vertical Curve	Elev. Elevation	A.C. Access Control
	S.A.N.S. Sanitary Sewer	Rt. Route	F.A.U.S. Federal-aid Urban System

Illinois Department of Transportation


PASSED *[Signature]* July 15 1977
 Engineer of Design Operations

APPROVED *[Signature]* July 15 1977
 Engineer of Design


REVISIONS	
BY	DATE
J.F.L.	11-18-58
W.F.	9-9-59
W.F.	11-19-62
W.F.	5-12-66
D.W.W.	7-15-77

● If it is definitely known that adjustment or reconstruction is required, place A or R inside the symbol. If a new casting is required, show the casting number. Use P for open, C for closed lid. Example - Catch Basin to be reconstructed with new type 5 frame, open lid = (R) 5P.

●● First character denotes type of structure. Use Sp. for special design. Second character denotes number of frame or grate. Example - Type A manhole with type I frame and closed lid = (A) I-C

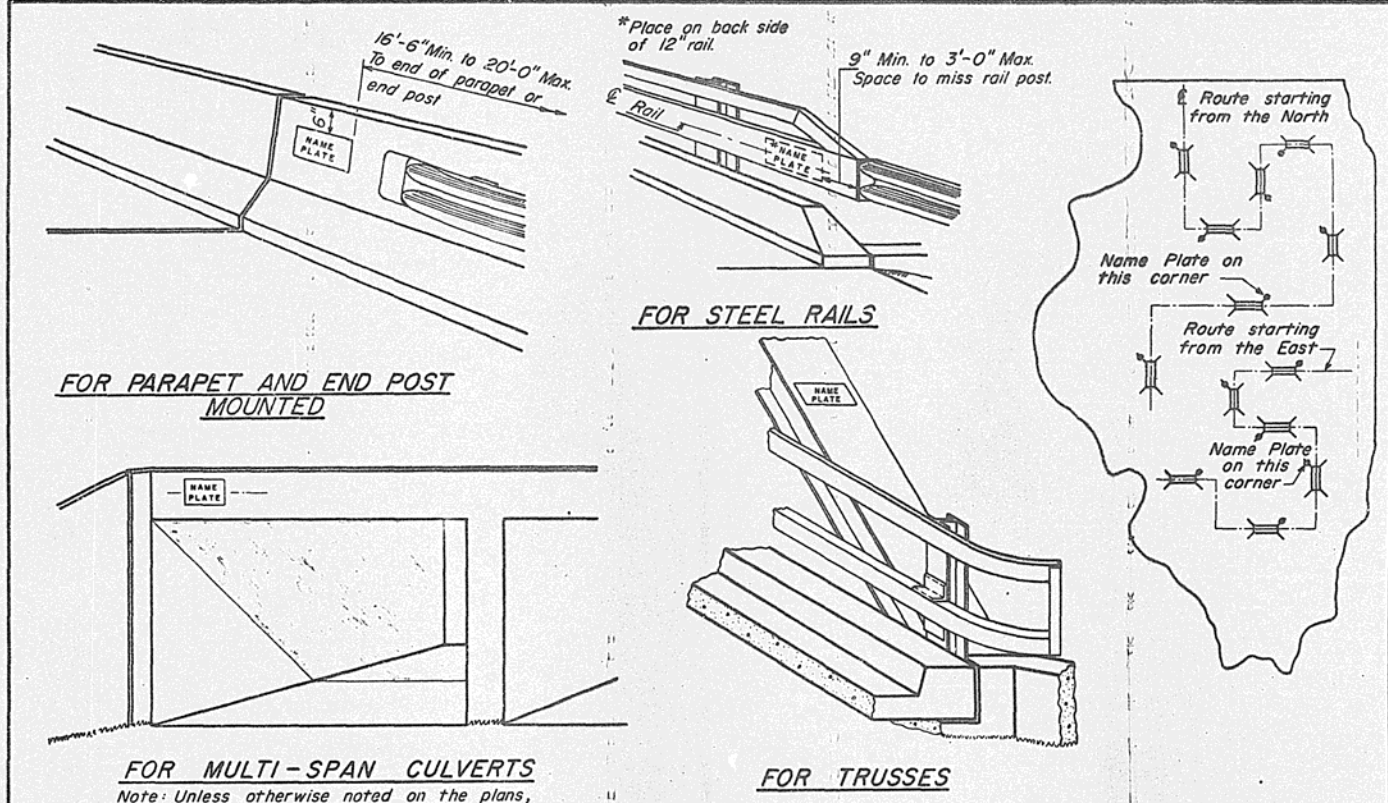

Note: Unless otherwise noted on the plans, Name Plates are not required for single box culverts.

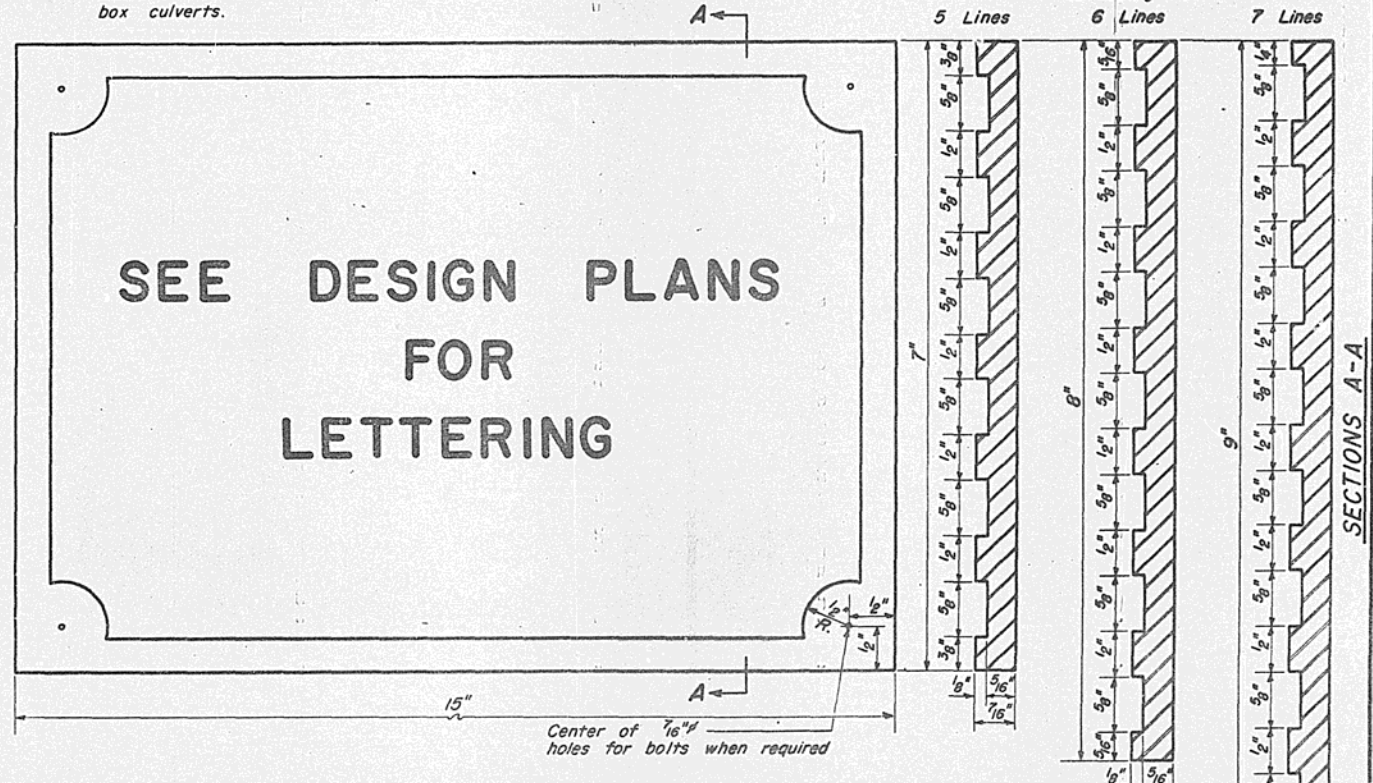


- Material: Best quality brass or bronze.
- Border & Lettering: Raised 1/8 inch. Square cut and not tapered. Top surface polished.
- For Concrete Parapets, Culverts -- Four lugs at least three inches long, cast on back of plate.
 - For Steel Truss Span --- Plate to be fastened on steel member at fabricating shop by brazing around entire perimeter of plate.
 - For Steel Rails --- Plate to be bolted on with 4 - 3/8" x 1" Stainless Steel or Brass Cap Screws, self tapping or drill and tap in field.
 - For Concrete Parapets --- Plate to be placed 15'-6" min. to 20'-0" max. to end of parapet.
 - For Steel Truss Span --- Braze to end post about five feet above roadway.
 - For Steel Rails --- Place on back side of 12" rail.
 - For Subways --- See design plans for location.

Illinois Department of Transportation

PASSED FEBRUARY 15, 1980

APPROVED FEBRUARY 15, 1980

DETAILS OF PERMANENT SURVEY MARKERS

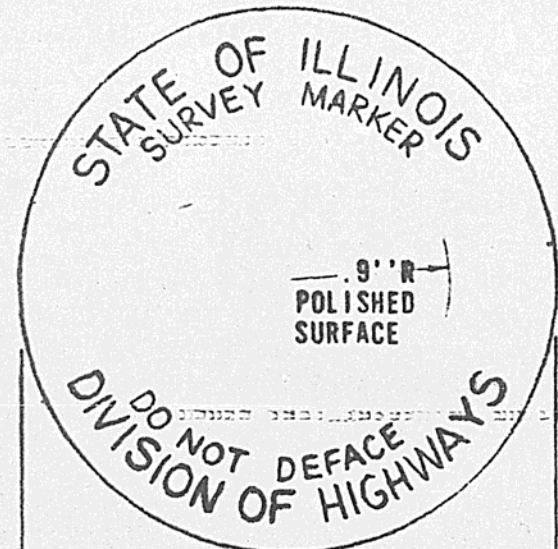

THE MARKERS MAY BE EITHER PRECAST OR CONSTRUCTED ON THE SITE EXCEPT WHERE IT IS NECESSARY TO INSTALL THE TABLET IN AN EXISTING ROCK LEDGE, THE CONCRETE PAVEMENT, OR A STRUCTURE.


THE LOCATION OF THE MARKERS SHALL BE IN ACCORDANCE WITH THE PLANS. IN GENERAL, THE MARKERS WILL BE PLACED AT THE P.T.'S AND P.C.'S OF HORIZONTAL CURVES AND SPACED ALONG THE TANGENTS IN A WAY THAT A MINIMUM OF TWO MARKERS ARE ALWAYS INTER-VISIBLE.

THE MARKERS SHALL BE PLACED UNDER THE DIRECTION OF THE ENGINEER AND SHALL BE INSTALLED IN A WORKMANLIKE MANNER IN ORDER THAT THERE BE NO FUTURE SETTLEMENT OR HORIZONTAL

SHIFTING. THE MONUMENTS SHALL BE PLACED IN A WAY THAT THE SURVEY POINT WILL FALL WITHIN THE PORTION OF THE PLAQUE PROVIDED FOR THAT PURPOSE.

THE PROJECT DESIGNATION, THE CENTERLINE STATION, THE SURVEY POINT, AND THE ELEVATION SHALL BE PERMANENTLY MARKED BY THE USE OF METAL DIES AFTER THE MARKER HAS BEEN INSTALLED.


THE CONTRACT UNIT PRICE FOR PERMANENT SURVEY MARKERS WILL BE PAYMENT IN FULL FOR FURNISHING, INSTALLING, AND PERMANENTLY MARKING THE TYPE SPECIFIED.

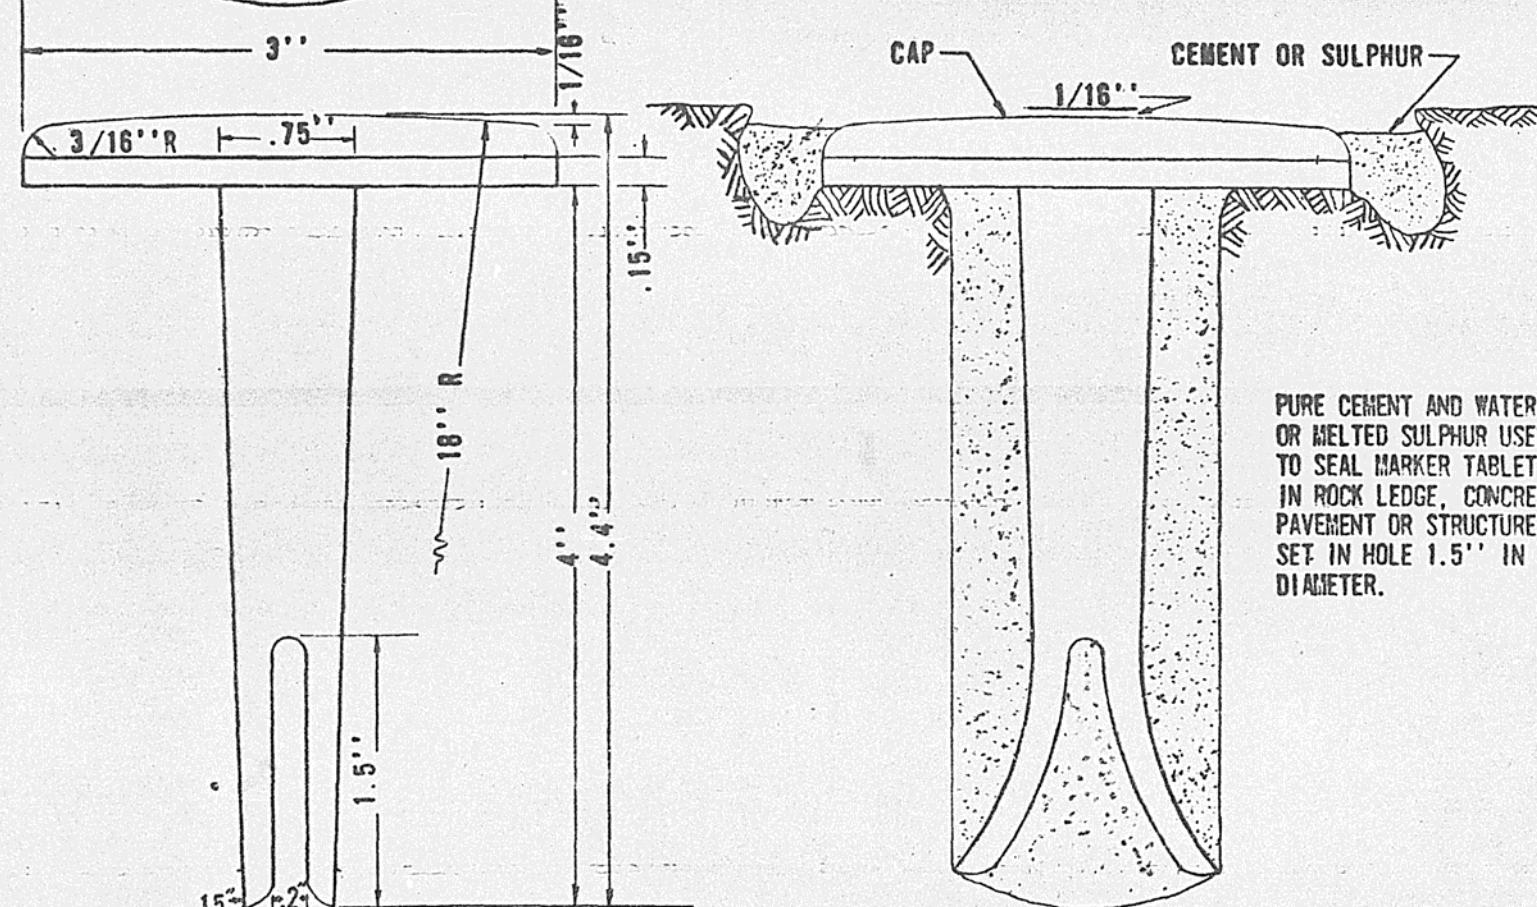

BRONZE TABLET
SCALE FULL SIZE

TABLET CONSTRUCTED IN
ROCK LEDGE OR CONCRETE.
SCALE FULL SIZE

PURE CEMENT AND WATER
OR MELTED SULPHUR USED
TO SEAL MARKER TABLET
IN ROCK LEDGE, CONCRETE
PAVEMENT OR STRUCTURE
SET IN HOLE 1.5" IN
DIAMETER.

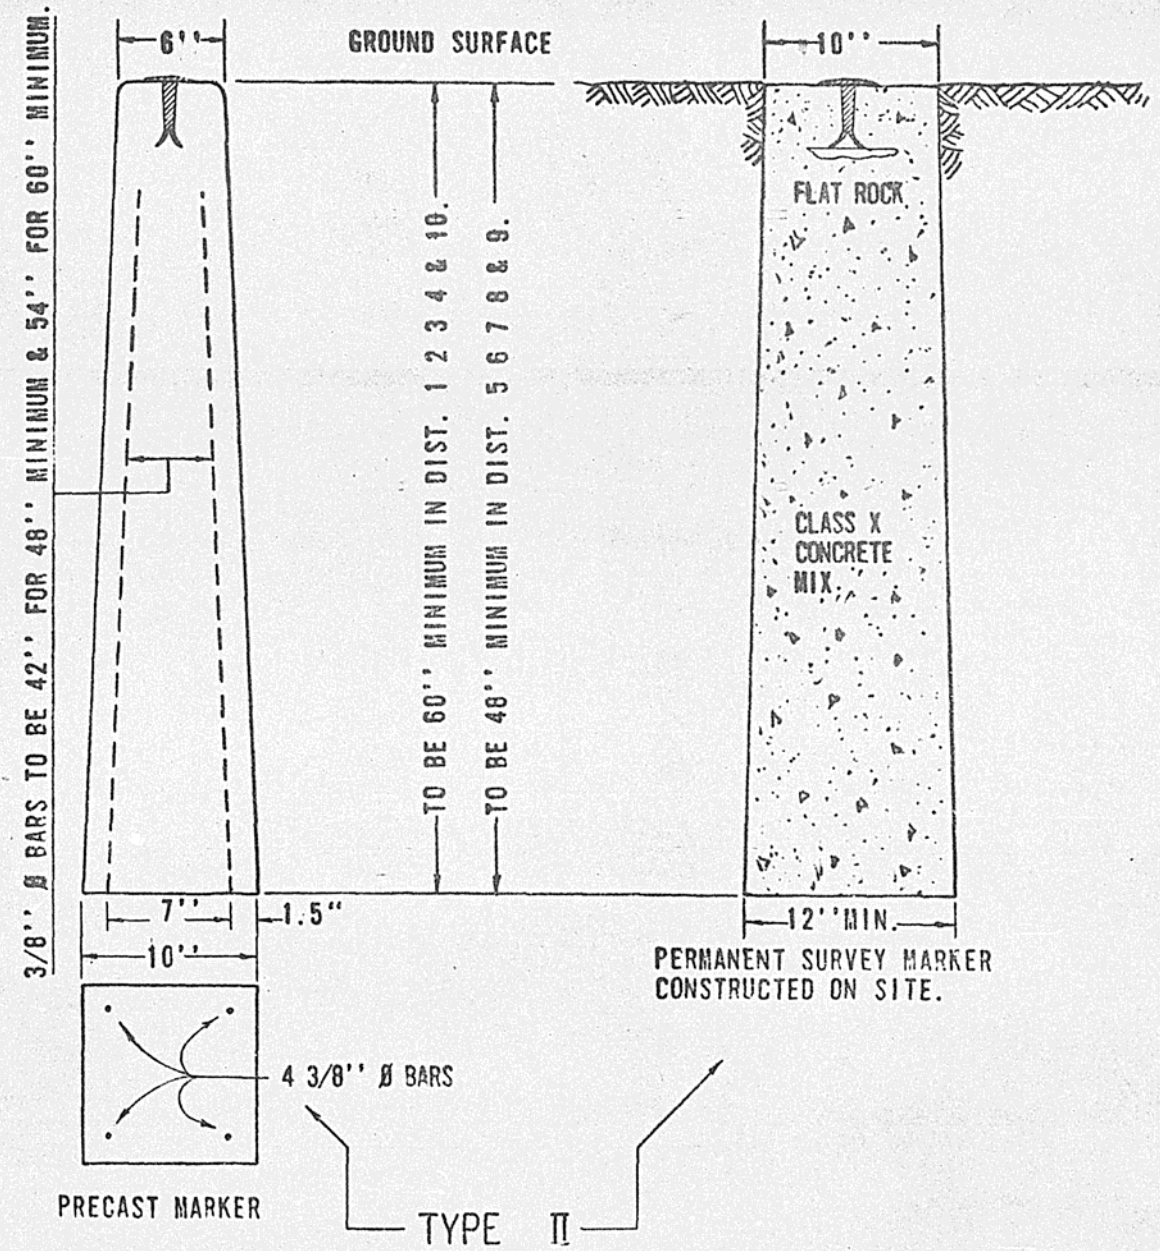

PRECAST MARKER




PERMANENT SURVEY MARKER
CONSTRUCTED ON SITE.

STATE OF ILLINOIS DEPARTMENT OF PUBLIC WORKS AND BUILDINGS DIVISION OF HIGHWAYS		REVISIONS	
PASSED	DATE	BY	DATE
PASSED	August 8 1958		
A. U. Van Arsdale ENGINEER OF ROAD PLANS AND CONTRACTS			
APPROVED	August 8 1958		
C. L. Stewart ENGINEER OF DESIGN			

TYPE I

TYPE II



STANDARD DESIGN METAL END SECTION FOR PIPE CULVERTS

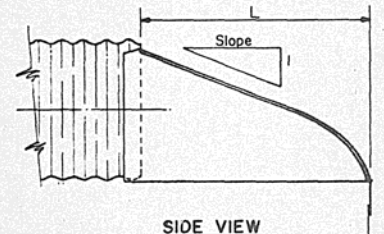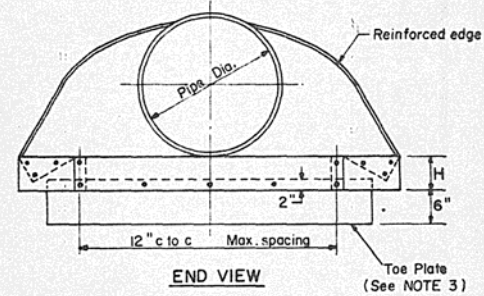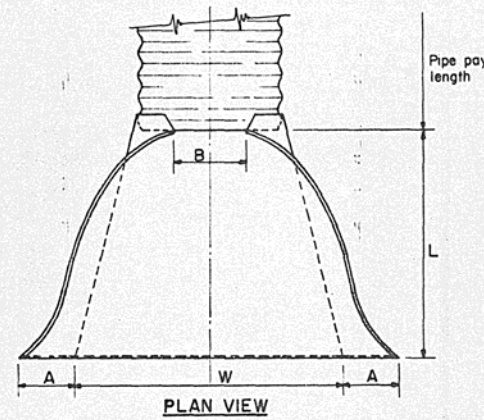

PIPE DIA.	THICKNESS, INCHES	DIMENSIONS					SLOPE (Approx.)	BODY
		A (1"±)	B (Max.)	H (1"±)	L (1 1/2"±)	W (2"±)		
12	0.064	6	6	6	21	24	2 1/2	1 Pc.
15	0.064	7	8	6	26	30	2 1/2	1 Pc.
18	0.064	8	10	6	31	36	2 1/2	1 Pc.
21	0.064	9	12	6	36	42	2 1/2	1 Pc.
24	0.064	10	13	6	41	48	2 1/2	1 Pc.
30	0.079	12	16	8	51	60	2 1/2	1 Pc.
36	0.079	14	19	9	60	72	2 1/2	2 Pc.
42	0.109	16	22	11	69	84	2 1/2	2 Pc.
48	0.109	18	27	12	78	90	2 1/4	2 Pc.
54	0.109	18	30	12	84	102	2	2 Pc.
60	0.109	18	33	12	87	114	1 3/4	3 Pc.
66	0.109	18	36	12	87	120	1 1/2	3 Pc.
72	0.109	18	39	12	87	126	1 1/3	3 Pc.
78	0.109	18	42	12	87	132	1 1/4	3 Pc.
84	0.109	18	45	12	87	138	1 1/6	3 Pc.

- NOTES:**
- All 3 piece bodies shall have .109 inch sides and .138 inch center panels. Width of center panels shall be greater than 20% of the pipe periphery. Multiple panel bodies shall have lap seams which shall be tightly jointed with 3/8" rivets or bolts.
 - For 60" thru 84" sizes, reinforced edges shall be supplemented with stiffener angles. The angles shall be 2" x 2" x 1/4" for 60" thru 72" diameter and 2 1/2" x 2 1/2" x 1/4" for 78" and 84" diameter. The angles shall be attached by 3/8" rivets or bolts.
 - The toe plate shall be the same thickness metal as the end section.


CONNECTIONS OF END SECTIONS

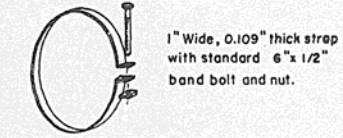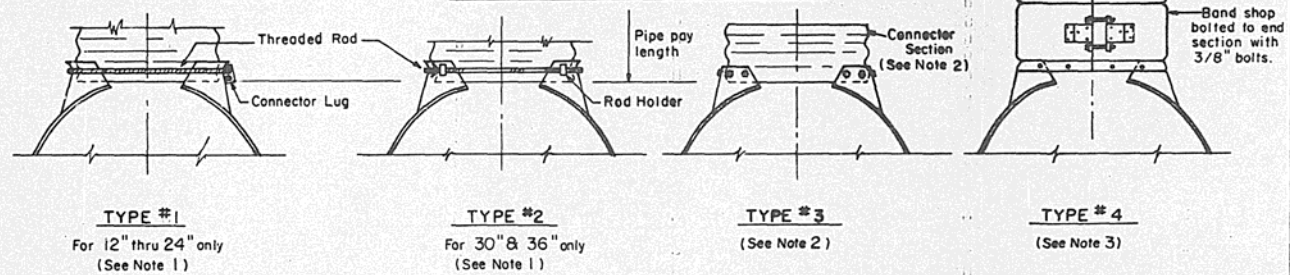


ALTERNATE STRAP CONNECTOR (For TYPE 1 only)

- NOTE:**
- Types #1 and #2 for pipes with annular ends only.
 - Type #3 connection can be used for all pipe sizes and includes 1 foot of the pipe length. The connector section shall be attached to the end section by rivets or bolts and shall be the same metal thickness as the end section. Stub to be either 2-2/3" pitch x 1/2" depth or 3" pitch x 1" depth annular corrugated pipe.
 - Type #4 connection can be used for all pipe sizes. Coupler shall be 2-2/3" x 1/2" dimple, hugger or annular band or 3" x 1" annular band. The dimple, hugger, or annular band may be used with corrugated metal pipes having annular ends. For corrugated metal pipes having helical ends, only the dimple band will be allowed.
 - When the pipe is bituminous coated, it will not be necessary to coat end sections or connector sections.


<p>Illinois Department of Transportation</p>	<p>ISSUED 12-9-65</p> <p>REVISIONS</p>
<p>PASSED June 1 1977</p> <p><i>D. E. Humming</i> Engineer of Design Operations</p>	<p>G.R. 8-1-68</p> <p>W.F. 1-17-72</p> <p>D.W.W.Sr. 8-25-76</p> <p>D.W.W.Sr. 6-1-77</p>
<p>APPROVED June 1 1977</p> <p><i>Thomas R. Bright</i> Engineer of Design</p>	

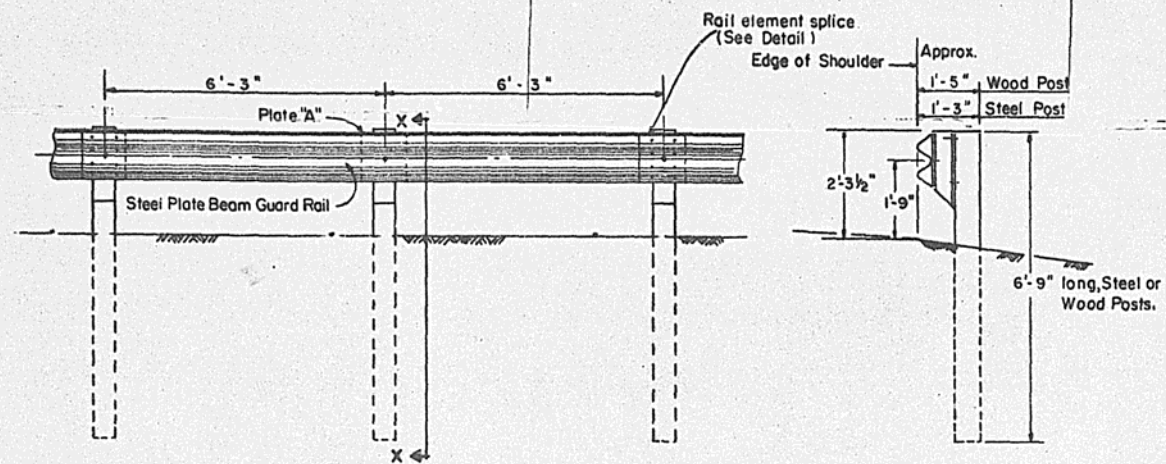


TYPE A
(6'-3" Typical Post Spacing)

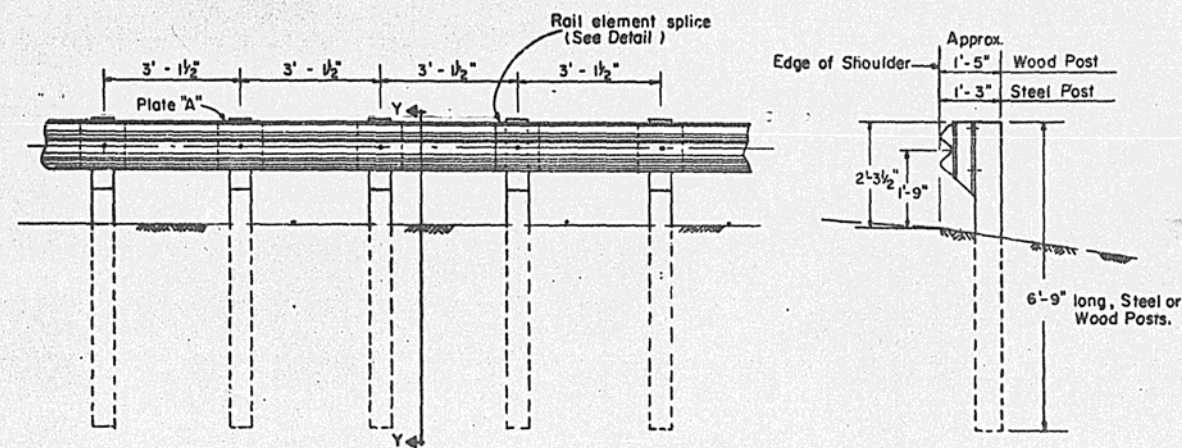

TYPE B
(3'-1 1/2" Closed Post Spacing)

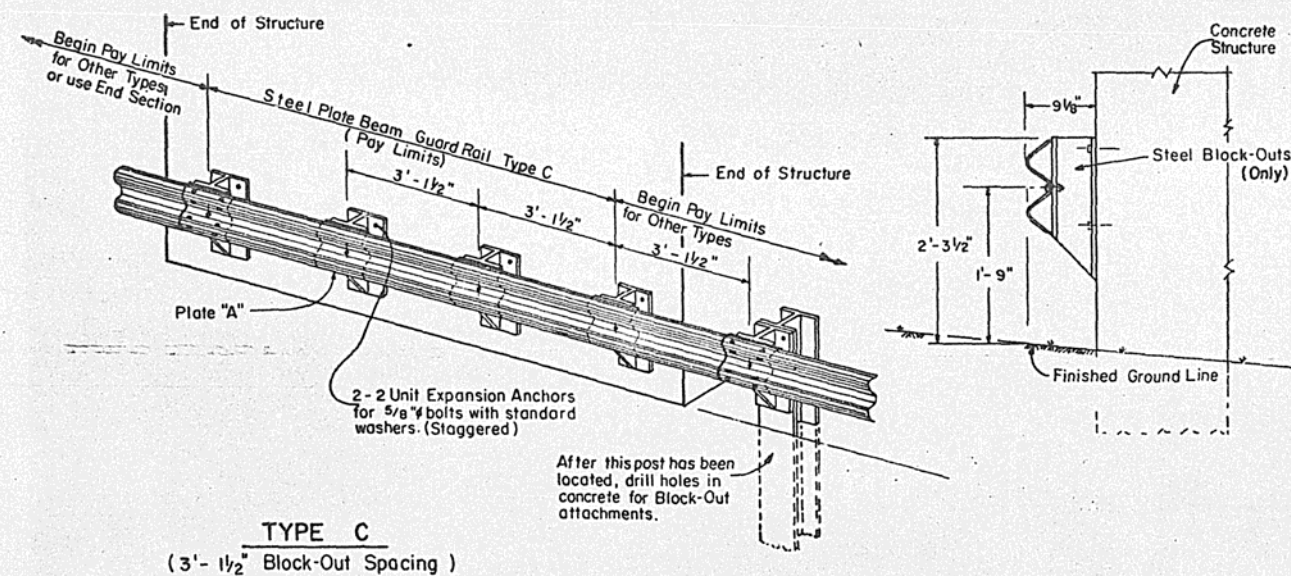

TYPE C
(3'-1 1/2" Block-Out Spacing)

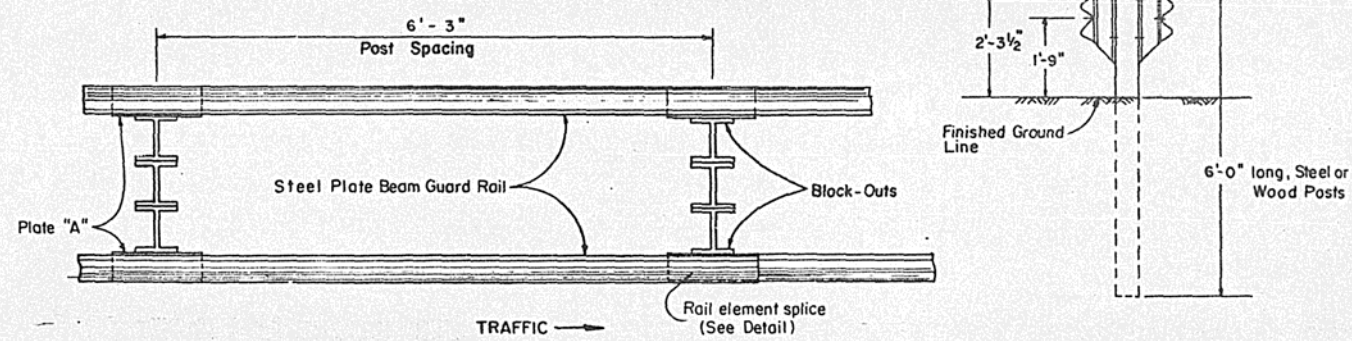

TYPE D
(Double Steel Plate Beam Guard Rail,
with 6'-3" Typical Post Spacing)

Illinois Department of Transportation
 PASSED July 25 1979
 APPROVED July 25 1979
 ISSUED 2-11-80

STEEL PLATE BEAM GUARD RAIL
 TYPES A, B, C & D


Sheet 1 of 2 Sheets

STANDARD 2230-13


Full Size

OWW Sr.


F-31K

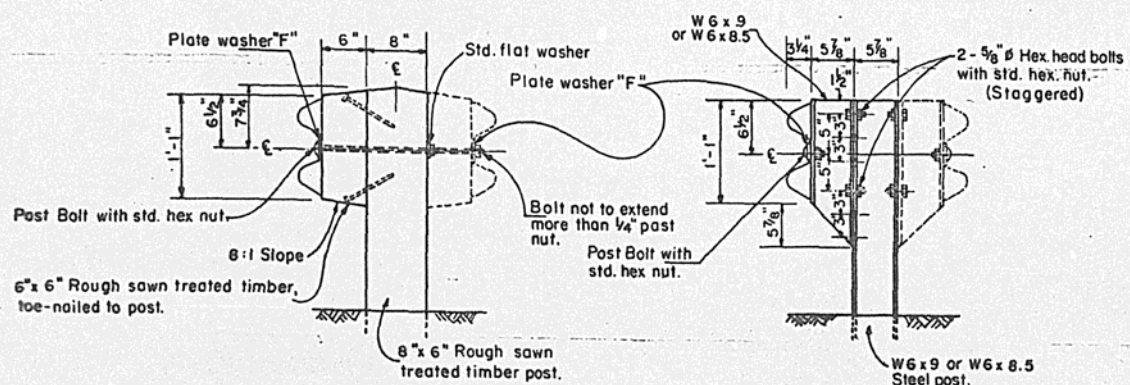


TYPICAL DETAIL OF WOOD POST CONSTRUCTION

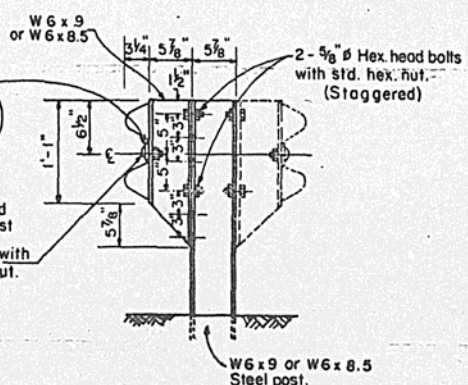


TYPICAL DETAIL OF STEEL POST CONSTRUCTION

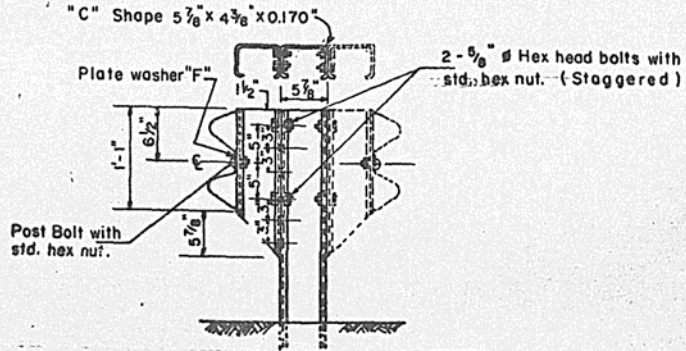


TYPICAL DETAIL OF STEEL POST CONSTRUCTION (ALTERNATE "C" SHAPE)

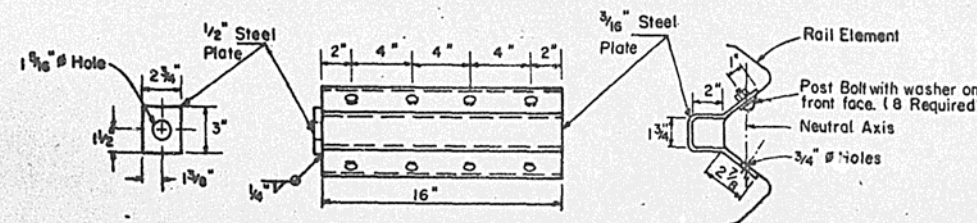


ANCHOR PLATE "T" DETAILS
Anchor Plate "T" shall be used to attach cable assembly to guard rail when required on Traffic Barrier Terminals.

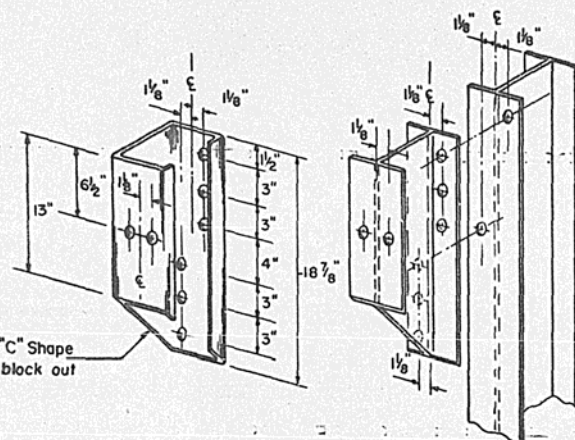


BLOCK-OUT DETAILS

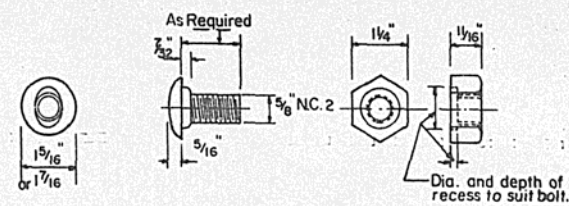


POST OR SPLICE BOLT & NUT

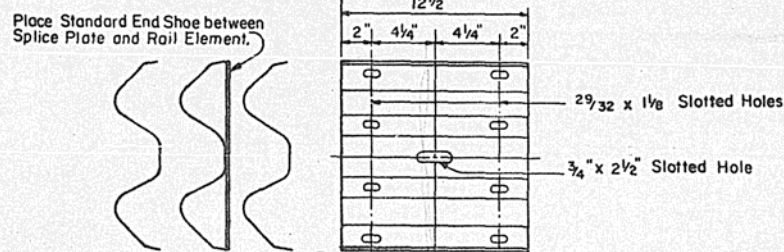

SPLICE PLATE

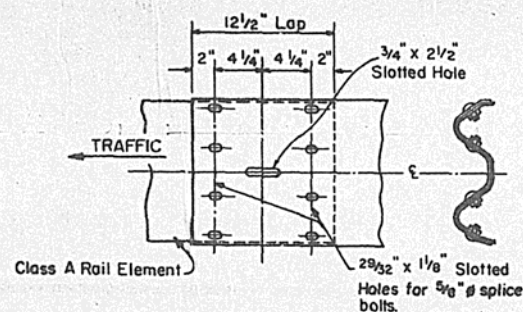

RAIL ELEMENT SPLICE

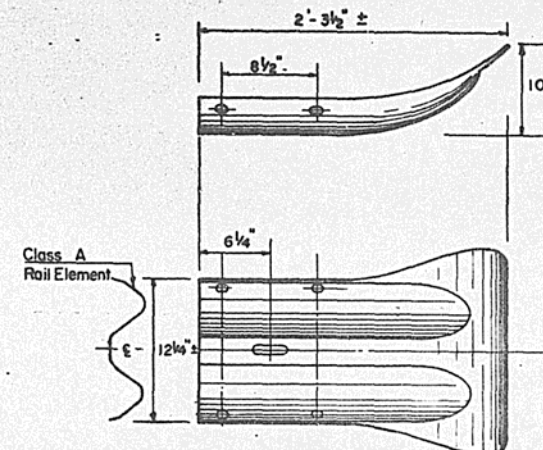

END SECTION

NOTE:
End Section shall be used only when specified on the contract plans.
Cost included in the bid unit price for Guard Rail.

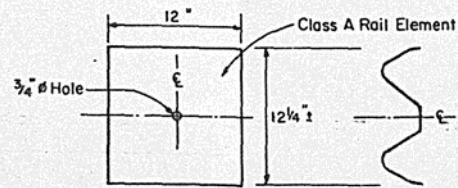


PLATE "A"

NOTE:
"Plate A" shall be placed between rail element and block-out at all non-splice mounting points.


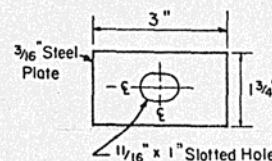



PLATE WASHER "F"

Plate Washer "F" shall be used at all locations where rail element is bolted to a block-out unless otherwise noted.

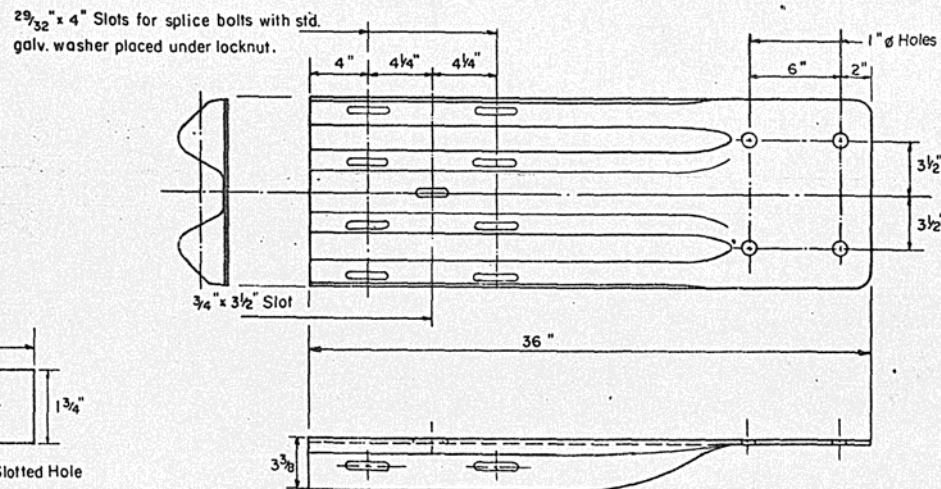

STANDARD END SHOE

When end shoe is attached to a bridge parapet which has an expansion joint, the bolts shall be provided with a locknut or double nut and shall be tightened only to a point that will allow guard rail movement.
The Standard End Shoe shall be attached to the concrete with Pre-drilled or Self-drilling anchor bolts. The anchor cone shall be set flush with the surface of the concrete.
Externally threaded studs protruding from the surface of the concrete will not be permitted.

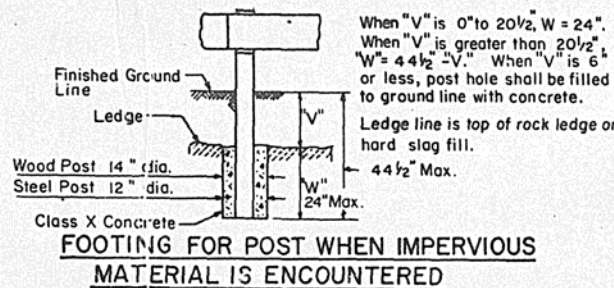


FOOTING FOR POST WHEN IMPERVIOUS MATERIAL IS ENCOUNTERED

GENERAL NOTES


All rail element shall be Class A unless otherwise noted.
All holes in posts and block-outs shall be 3/4 inch.
All concrete, and accessories used in the placing of the guard rail shall be included in the bid unit price for guard rail.
Rail element may be furnished in nominal lengths of either 12'-6" or 25'-0".
All rail elements and accessories shall conform to AASHTO M-180 unless otherwise noted.
For steel block-outs attached to wood posts, use 2-5/8 inch lag bolts (staggered) in pre-drilled post holes.
The Contractor shall load test 10% of all expansion anchor bolts in guard rail installations in the presence of the Engineer. The equipment and method used shall meet the approval of the Engineer. The minimum test load shall be 8,000 pounds for 5/8 inch bolts and 3,000 pounds for 3/8 inch bolts in direct pull.
For each anchor that fails the test requirements, two (2) more anchor bolts, picked by the Engineer shall be tested. Each anchor bolt that fails to meet the test requirement shall be reset or removed and the hole drilled deeper. All reset anchor bolts shall meet minimum test requirements.

Illinois Department of Transportation
PASSED July 25, 1979
APPROVED July 25, 1979
ISSUED 2-11-66

STEEL PLATE BEAM GUARD RAIL
(Sheet 2 of 2 Sheets)
STANDARD 2230-13
Full Size D.W.W. Sr.

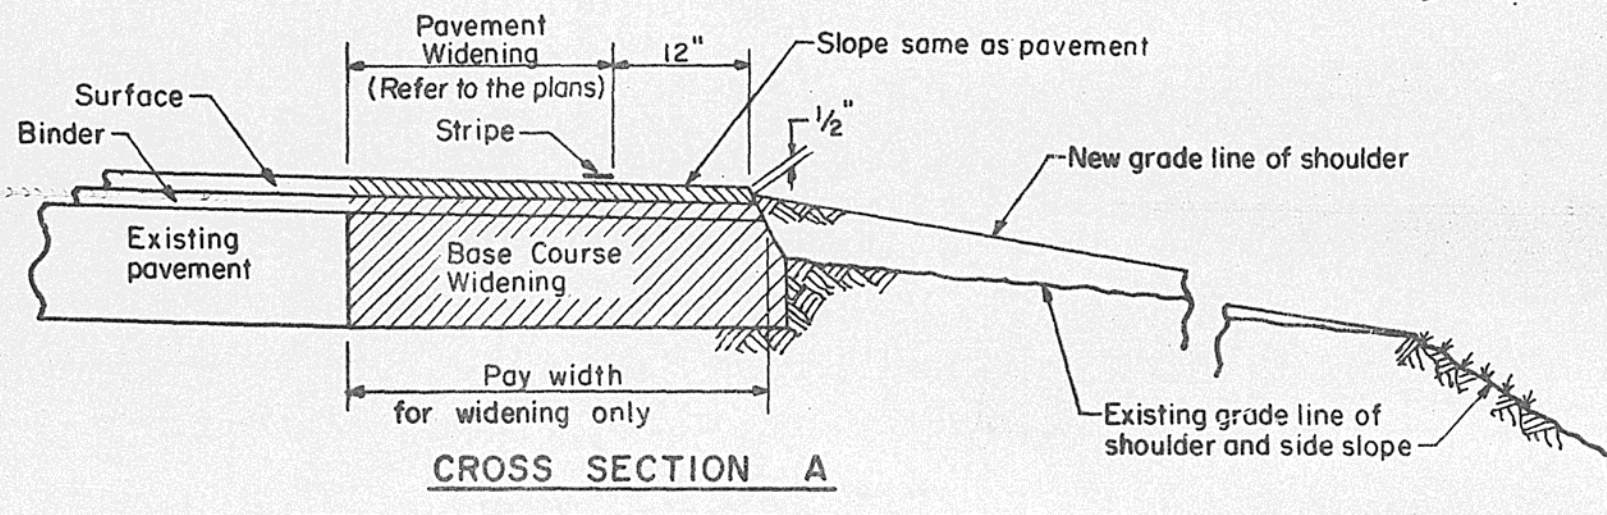

CROSS SECTION A
DETAIL OF WIDENING WITH SHOULDER

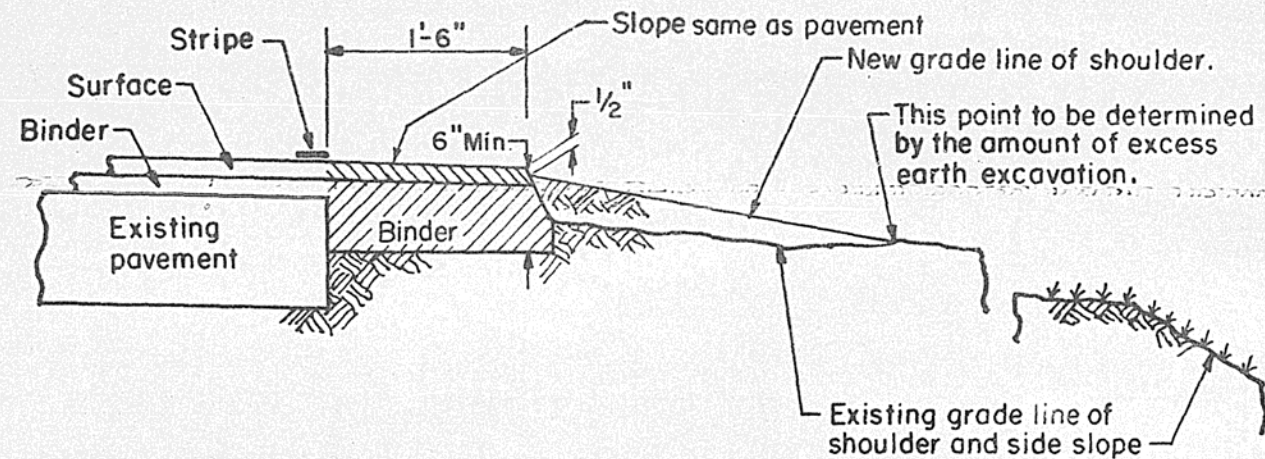

CROSS SECTION B
DETAIL OF BITUMINOUS SHOULDER

GENERAL NOTES

Refer to the plans for the thickness of the bituminous binder and surface on pavement.

The Bituminous Binder shoulder material for Section B may be placed in one or two layers at the option of the Contractor.

The bituminous mixture for Section B shall be compacted to a density of not less than 85% of the theoretical density. The compaction equipment shall be as determined by the Engineer.

The bituminous binder and surface mixtures for shoulders will be paid for at the contract unit price per ton of the type specified for the adjacent resurfacing except that the thickness of surface course paid for will be limited to that specified for the resurfacing or 1/2" whichever is less. Surface course used in excess of this amount will be paid for as binder course.

The earthwork required as shown in Section A will be measured to the neat lines as shown and will be paid for at the contract unit price per cubic yard for EARTH EXCAVATION WIDENING which price shall include use of earth excavation to regrade the shoulders to the new grade line and disposal of excess as specified in the Standard Specifications.

The earthwork required as shown in Section B will be paid for at the contract unit price per unit (100 lineal feet) measured separately on the right and left hand sides for EXCAVATING AND GRADING EXISTING SHOULDER which price shall include use of excess earth excavation to regrade the shoulders to the new grade line.

Stripe at edge of pavement to be furnished by others.

 Illinois Department of Transportation

PASSED April 15 1977

A. E. Hennings
Engineer of Design Operations

APPROVED April 15 1977

Thomas B. Bright
Engineer of Design

ISSUED 5-10-67

REVISIONS

W.F.	12-1-69
W.F.	3-18-70
W.F.	1-18-71
W.F.	12-17-71
D.W.W.	4-15-77

Redrawn 12-1-69


**WIDENING AND SHOULDERS
FOR PAVEMENT RESURFACING**

STANDARD 2239-6

(1/4 Size) W.F.


C-22.15 e

TYPICAL APPLICATIONS OF TYPE III BARRICADES CLOSING A ROAD

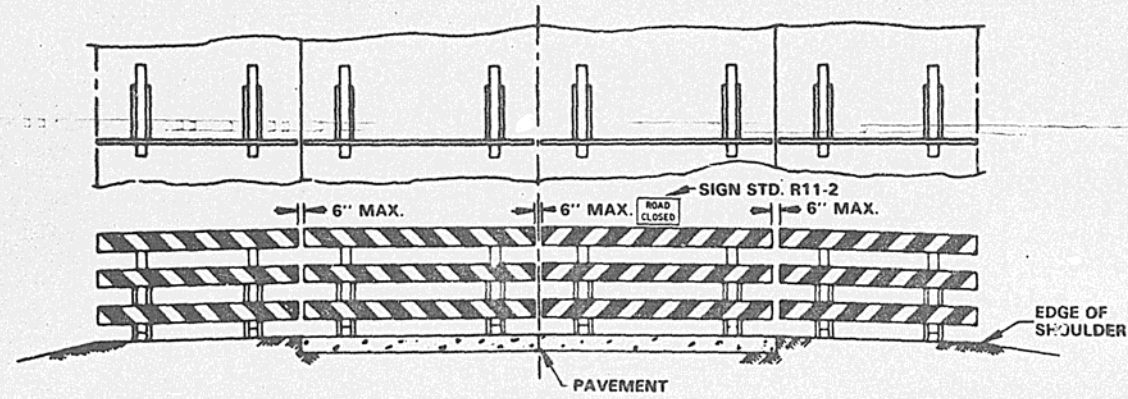

ROAD CLOSED TO ALL TRAFFIC


Reflectorized striping may be omitted on the back side of the barricades. The barricades shall be to the edge of the shoulders except when otherwise directed by the Engineer or shown on the detailed construction plans.

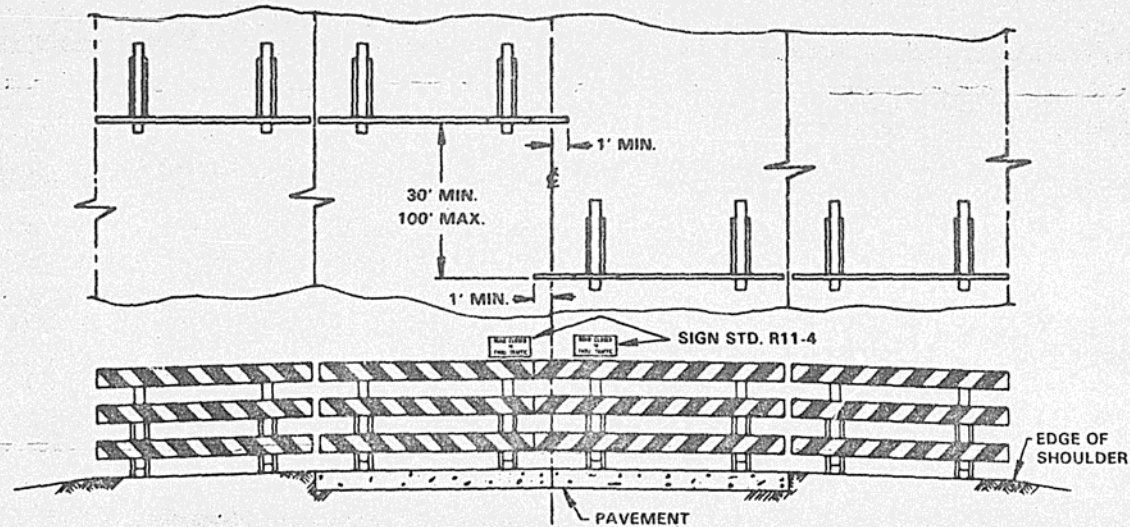

ROAD CLOSED TO ALL THRU TRAFFIC


Reflectorized striping shall appear on both sides of barricades. The barricades shall be to the edge of the shoulders, except when otherwise directed by the Engineer or shown on the detailed construction plans

ARROW BOARDS

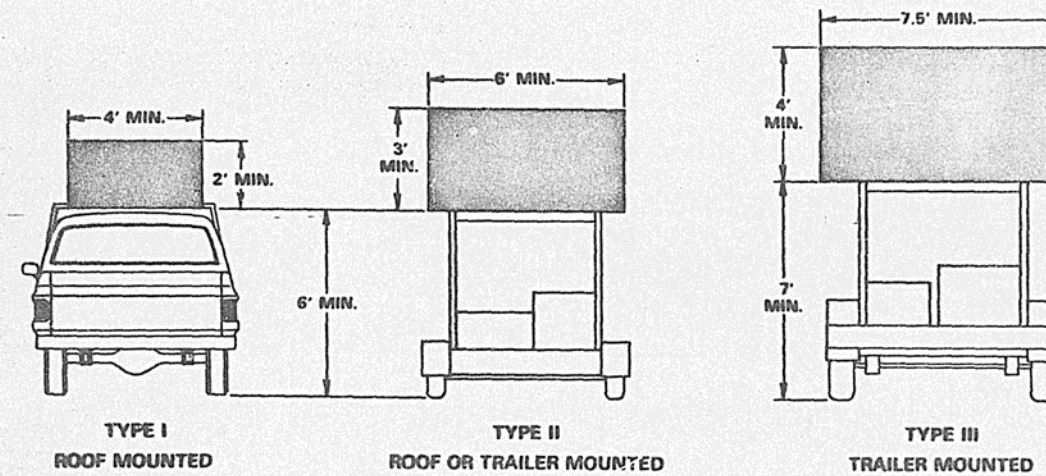

Arrow boards shall conform to Article 718.22 of the Standard Specifications. On roads with speeds of 45 miles per hour and above, Type III units are to be used for all operations 24 hours or more in duration and Type II units may be used for operations less than 24 hours in duration. Type I, II or III units may be used for all operations on roads with speeds less than 45 miles per hour. Arrow boards shall not be used to direct passing moves into lanes used by opposing traffic.

TYPICAL SIGN INSTALLATIONS

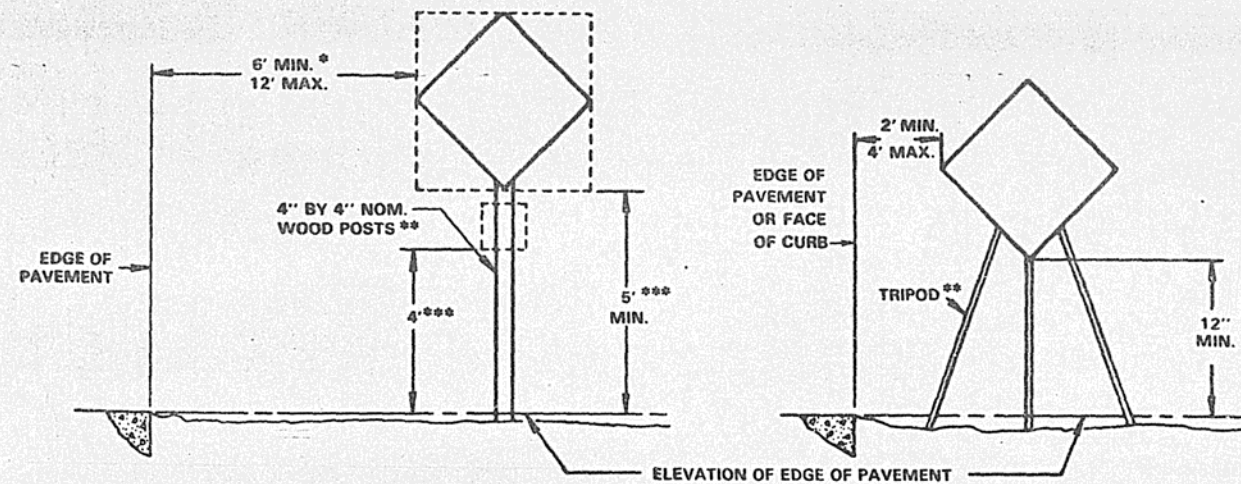

* 2 ft. minimum to face of curb.

** Alternate designs and or materials may be permitted when authorized by the Engineer. All materials shall be substantial and durable.

*** Add 2 ft. if parking exists within 200 ft. in advance of the sign location at any time during the project.

Signs on temporary supports shall be within 20° of a vertical position.

Weights of concrete, stone, or brick will not be allowed and all weights used to stabilize signs other than sandbags must be rigidly attached to the sign support as close to the ground as possible.

Illinois Department of Transportation

Approved MAY 1 1980

L. E. Moberg
Engineer of Traffic

Issued 4-3-69



TYPICAL APPLICATION OF TRAFFIC CONTROL DEVICES
HIGHWAY CONSTRUCTION AND MAINTENANCE

STANDARD 2298-5


GENERAL NOTES

1. Type I Barricades are intended for use on lower speed roadways and shall not be used where normal posted speeds are greater than 40 MPH unless the upper rail is at least 12 inches deep.
2. Type I and Type II Barricades shall not be intermixed within an individual string of barricades.
3. Type III Barricades are intended for road and lane closures and shall not be used for channelization or delineation.
4. All heights shown shall be measured above the pavement surface.
5. The reflective sheeting used for barricades, drums, and vertical panels shall meet the requirements of Article 718.17 and 718.18 of the Standard Specifications for Road and Bridge Construction.
6. All barricades and vertical panels shall have alternating reflectorized white and reflectorized orange stripes sloping downward at 45° toward the side on which traffic will pass. Barricade stripes shall be 6 inches in width on barricades 36 inches or greater in width and 4 inches in width on barricades less than 36 inches in length. Barricade rails may be sloping or vertical.
7. Type I and Type II Barricades shall be striped on both sides. Type III Barricades shall be striped on both sides where traffic approaches from either direction. Vertical panels placed on the outside of curves shall be striped on both sides.
8. Drums shall have alternating reflectorized orange and reflectorized white horizontal, circumferential stripes 4 inches to 8 inches in width. There shall be at least two orange and at least two white stripes on each drum. If nonreflective spaces are left between the orange and white stripes, they shall be no more than 2 inches in width. All nonreflectorized portions of the drums shall be painted orange or white. Drums may be slightly conical in shape and may have one or more flat surfaces to minimize rolling when hit.
9. Frames for Type I and Type II Barricades shall be designed so as to provide a stable support and should be constructed of light weight steel or aluminum angles or tubing, wood, plastic, or rubber and have no rigid stay bracing for "A" frame designs. As Type III Barricades are only used at closures, they may be constructed of heavier materials than Type I or Type II Barricades. However, they should not have any vertical or sloping supports heavier than 4-inch by 4-inch lumber, 2-inch by 2-inch by 1/8-inch steel tubing, or 2-inch by 2-inch by 3-1/16-inch steel angles or rails heavier than 2-inch by 12-inch lumber. Nominal lumber sizes are acceptable to satisfy dimensions.
10. The name of the agency, contractor, or supplier shall not be shown on the face parts of any barricades, whether such parts are striped or not. Identification markings may be placed only on the back side of the barricade rails.
11. When used, warning lights on barricades, drums, or vertical panels shall be mounted above the top of the device to the side on which traffic will pass and shall not obscure any reflectorized portion of the device.
12. Weights of concrete, stone, or brick will not be allowed and all weights used to stabilize barricades other than sandbags must be rigidly attached to the legs of the barricades as close to the ground as possible. No sandbags will be allowed on the top rail of barricades. Sandbags may be placed on barricade legs, over striped bottom rails not facing traffic, over unstriped bottom rails, or suspended from the barricade rail or frame in such a manner so that the bulk of the sand is at least 18 inches below the top of the barricade. Drums may be weighted internally with just enough sand, water, or other material to provide stability.



TYPE I BARRICADES

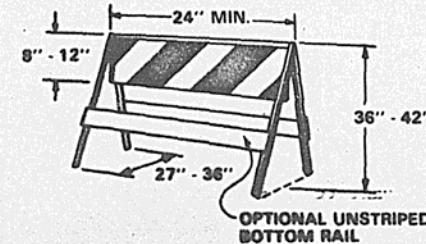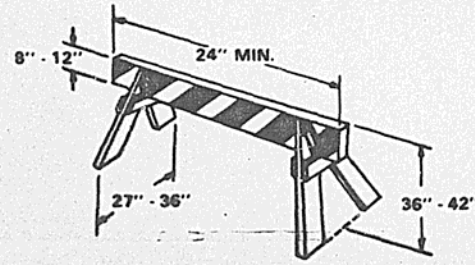


TYPE II BARRICADES

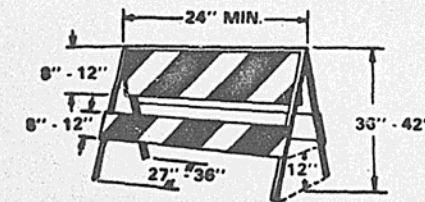

TYPE III BARRICADES

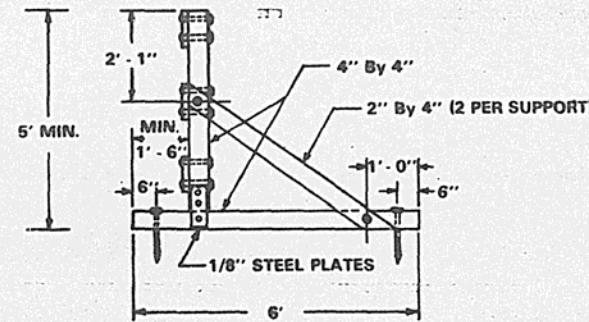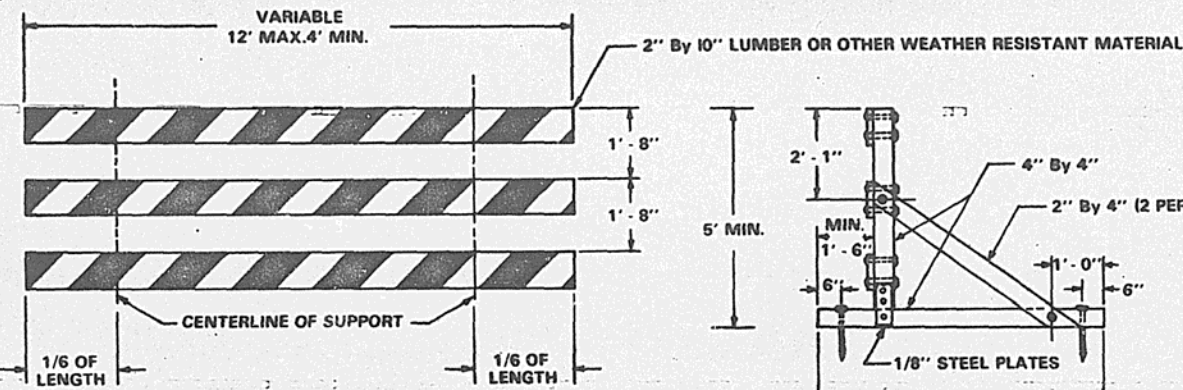


TYPICAL WOOD SUPPORT

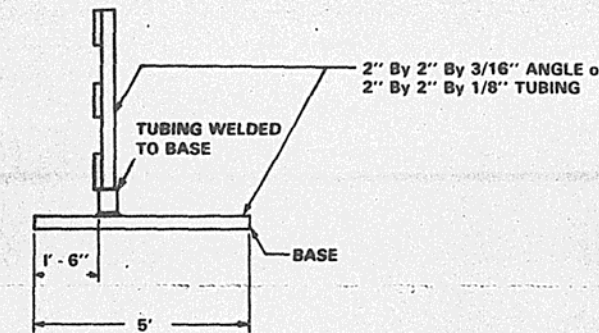


TYPICAL STEEL SUPPORT


HIGH LEVEL WARNING DEVICE

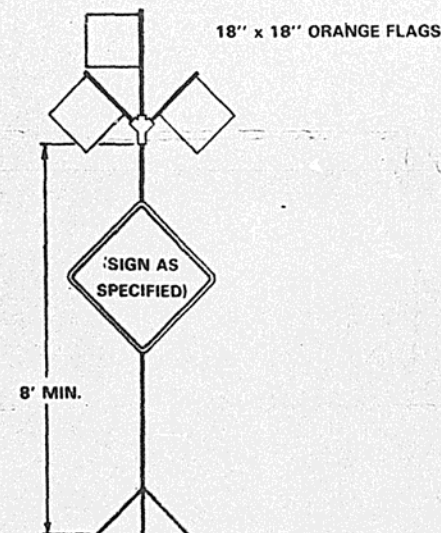


DRUMS

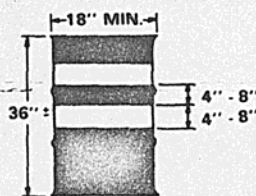

CONES

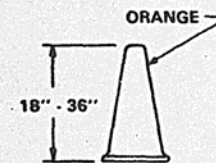


VERTICAL PANELS

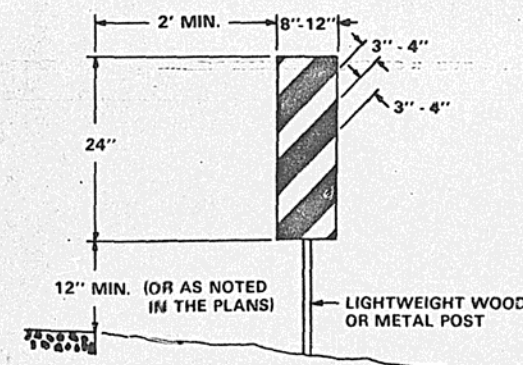


Missouri Department of Transportation
 Approved January 23, 1980
 L. E. Nobility
 Engineer of Traffic
 Issued 4-3-69

DESIGN OF TRAFFIC CONTROL DEVICES FOR
 HIGHWAY CONSTRUCTION AND MAINTENANCE
STANDARD 2299-8


F-6.02e

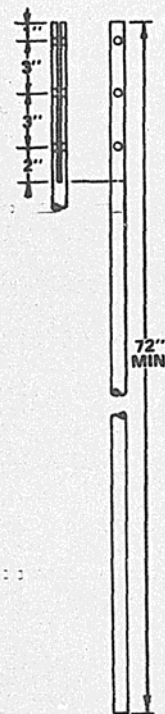

STAFF

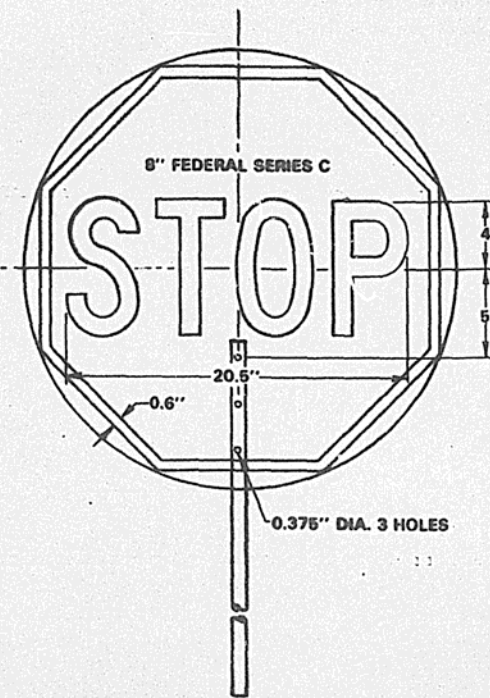

FRONT SIDE

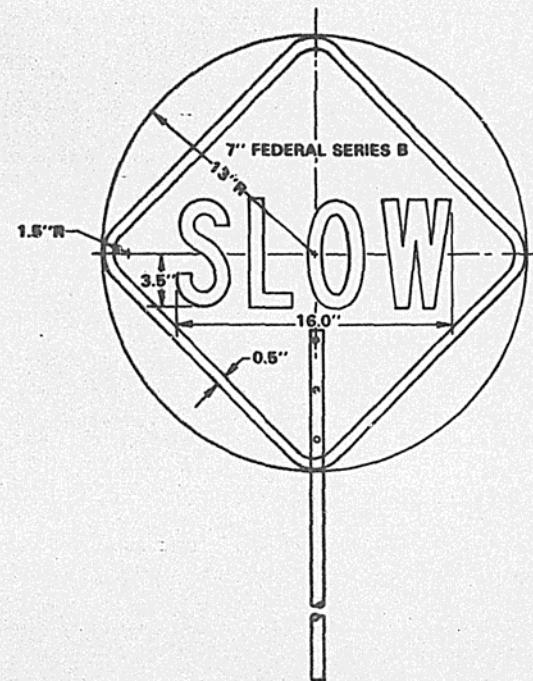

REVERSE SIDE

GENERAL NOTES

1. The "STOP" face shall consist of white letters and border on a red reflectorized background.
2. The "SLOW" face shall consist of black letters and border on an orange reflectorized background.
3. Areas outside sign borders shall be light blue or black.
4. The sign blank may be octagonal in shape in lieu of circular.
5. The portion of the staff within the sign face shall match the sign colors.
6. All colors and letters shall meet applicable federal standards.
7. The staff shall consist of two sections joined by a coupling located 60 in. from the bottom of the staff. Alternate designs may be used when approved by the Engineer. All materials shall be substantial and durable.
8. This sign shall be furnished by the contractor and shall be used by the flagger in lieu of flags or other signaling devices. The cost of furnishing and maintaining the sign shall be considered incidental to the contract and no additional compensation will be allowed.

Illinois Department of Transportation

Approved MAY 1 1980

L. E. Madenly
Engineer of Traffic


69-C-1-panels

FLAGGER TRAFFIC CONTROL SIGN

STANDARD 2300-2

STANDARD DESIGN

TYPICAL APPLICATION OF TRAFFIC CONTROL DEVICES FOR HIGHWAY CONSTRUCTION AND MAINTENANCE

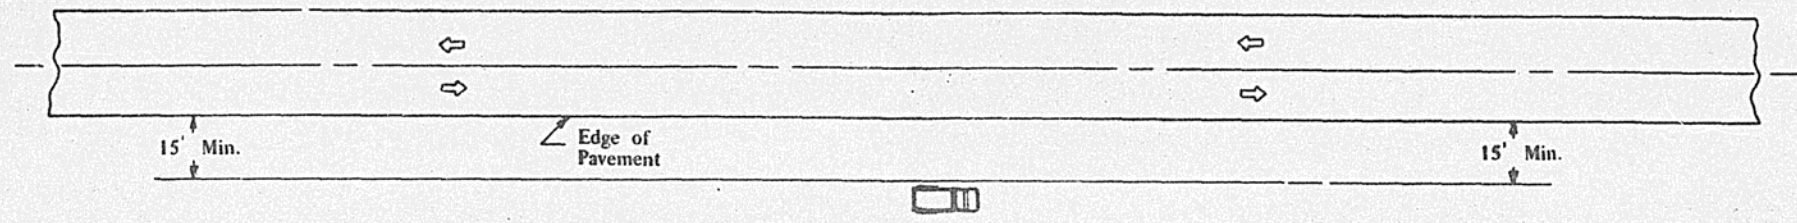

CASE I

**TWO-LANE, TWO WAY TRAFFIC,
RURAL DAY OR NIGHT
OPERATIONS**

Where, at all times, all vehicles, equipment, men and their activities are more than 15 ft. from the edge of pavement.

F-606 D

TYPICAL APPLICATIONS


- Landscaping Work
- Utility Operations
- Fencing Contracts and Maintenance
- Cleaning Culverts

GENERAL NOTES

1. No special signing is required.
2. If the work operation requires that two or more work vehicles cross the 15 ft. clear zone in any one hour, traffic control will be in conformance with Case II.

STATE OF ILLINOIS DEPARTMENT OF TRANSPORTATION APPROVED <u>6-12</u> 197 <u>3</u> <i>L. E. Moberly</i> Engineer of Traffic	ISSUED 4-3-69 REVISED BY DATE _____ _____
---	--

STANDARD 2301-3

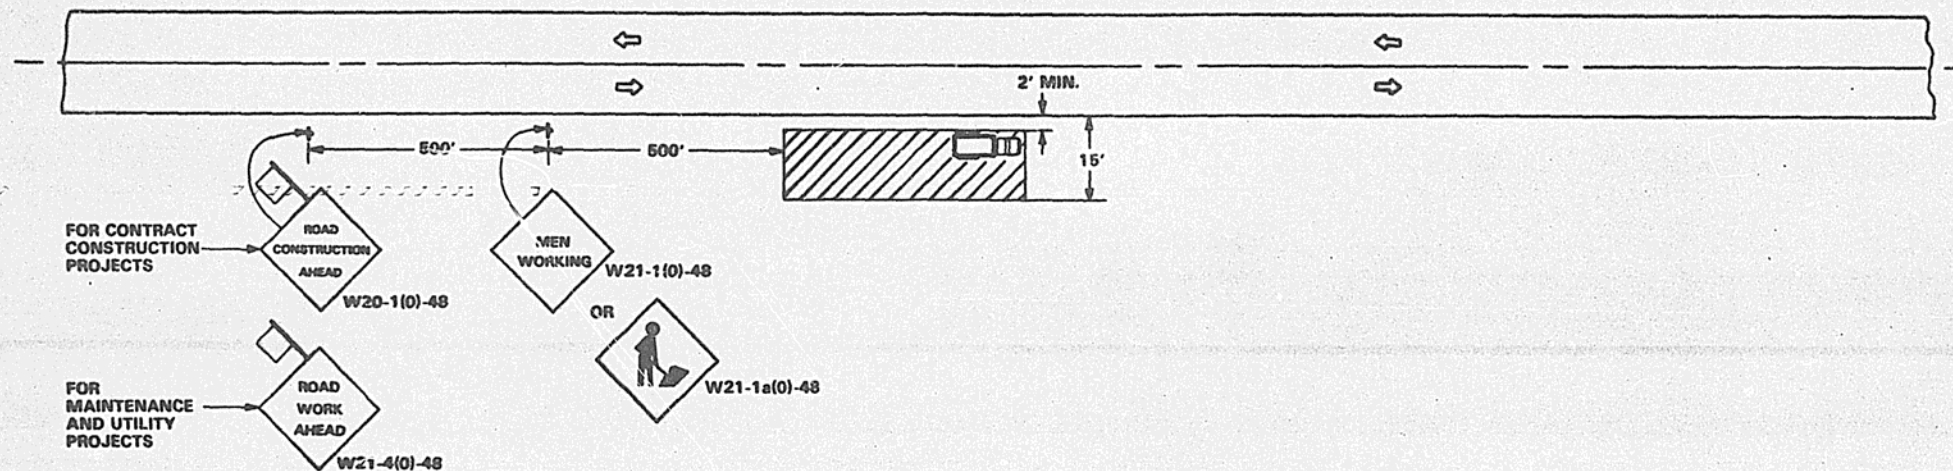

GENERAL NOTES

1. If the work operation does not exceed 60 minutes, traffic control may be in conformance with STANDARD 2307.
2. Worker signs are to be removed when no work is being performed. Any unattended obstacle or excavation in the work area which in the opinion of the Engineer constitutes a hazard shall be protected by barricades at 50 ft. centers, with flashing lights at night. If the hazard exceeds 100 ft. in length, steady burning lights shall be substituted for flashing lights. When the distance is greater than 250 ft., barricade spacing may be increased to 100 ft.
3. If the work operation requires that four or more work vehicles enter through traffic lanes in a one hour period, a flagger shall be provided and a Flagger sign shall be substituted for the Worker sign.
4. Longitudinal dimensions may be adjusted to fit field conditions.
5. All vehicles, equipment, workers and their activities are restricted at all times to one side of the pavement unless otherwise authorized by the Engineer.

SYMBOLS

- Work Area
- 18 in. X 18 in. (minimum) Orange Flag
- Sign on Portable or Permanent Support

TYPICAL APPLICATIONS

- Utility Operations
- Culvert Extensions
- Side Slope Changes
- Guard Rail Installation and Maintenance
- Defineator Installation and Maintenance
- Landscaping Operations
- Cleaning Ditches and Drainage Structures
- Sign Installation and Maintenance
- Shoulder Repair

**TYPICAL APPLICATION OF TRAFFIC CONTROL DEVICES
HIGHWAY CONSTRUCTION AND MAINTENANCE**

**TWO-LANE, TWO-WAY TRAFFIC,
RURAL DAY OR NIGHT OPERATIONS**

Where at any time, any vehicle, equipment, workers or their activities will encroach in the area closer than 15 ft. but not closer than 2 ft. to the edge of pavement.

STANDARD 2302-4



Michigan Department of Transportation

Approved MAY 1 1980

G. E. Moberly
Engineer of Traffic

Issued 4-3-69

F-607c

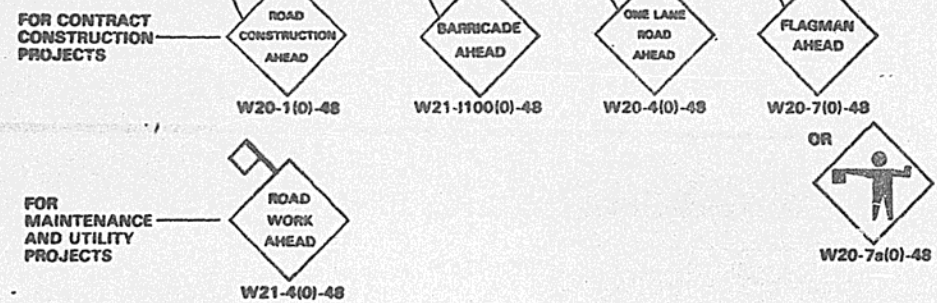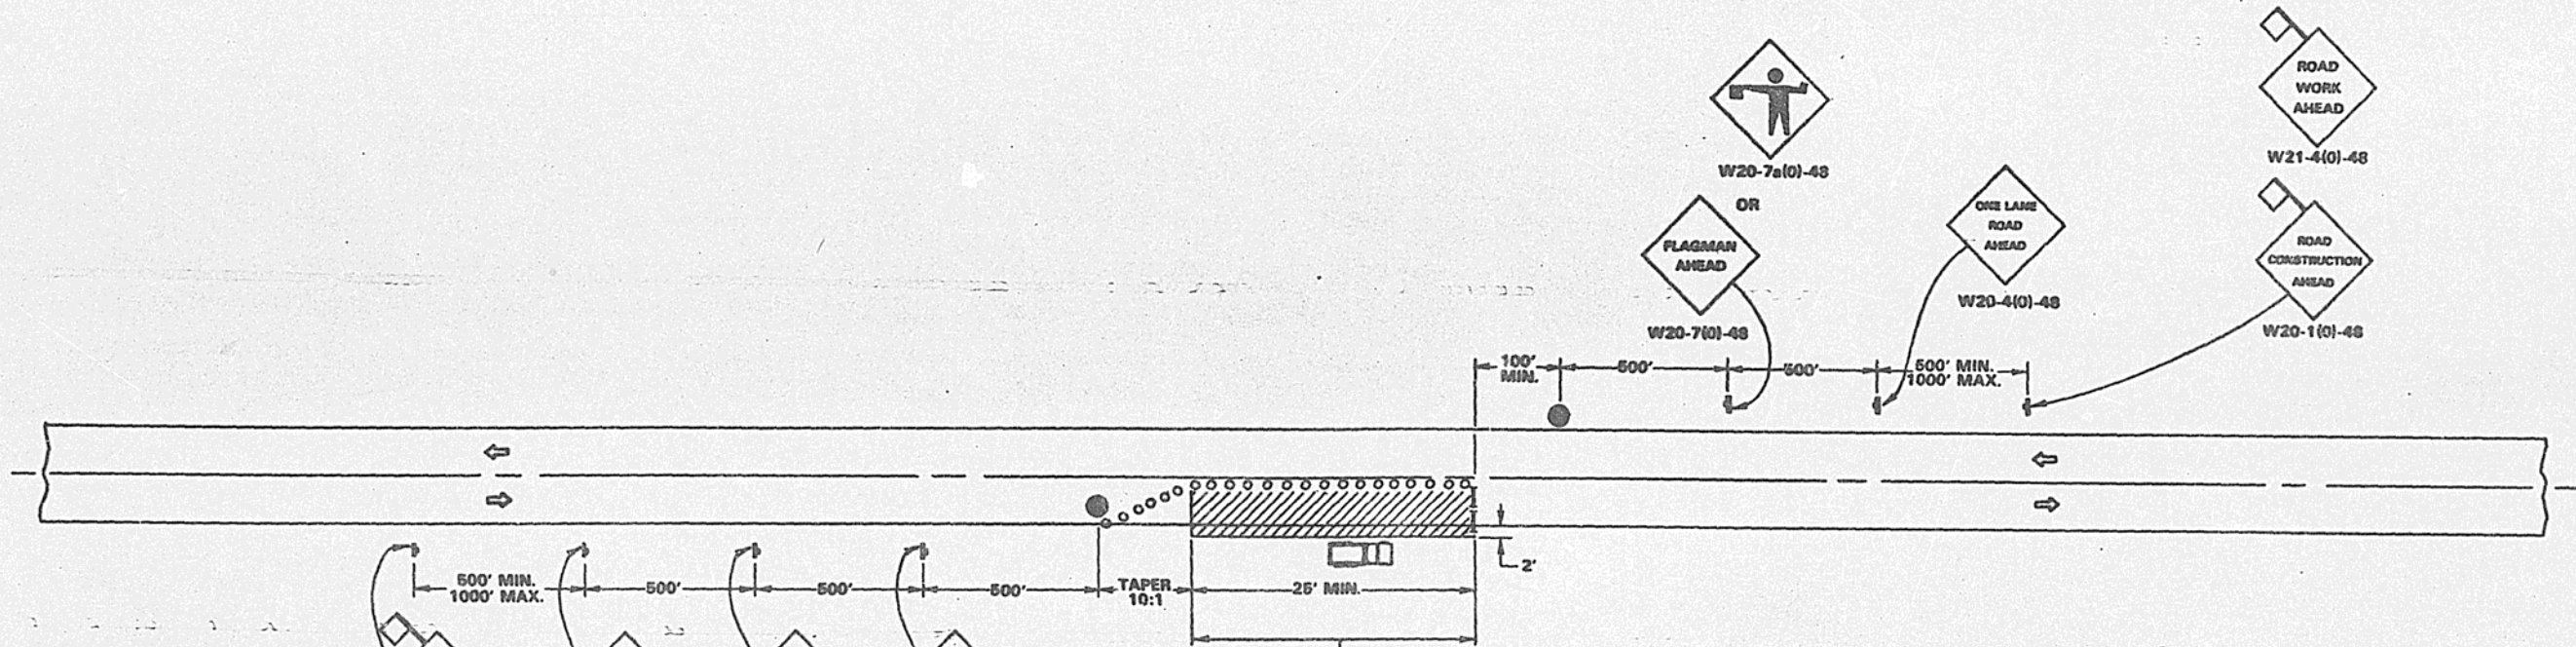

CONES AT 25 FT. CENTERS FOR 250 FT. ADDITIONAL CONES MAY BE PLACED AT 50 FT. CENTERS. WHEN DRUMS OR BARRICADES ARE USED, THE INTERVAL BETWEEN DEVICES MAY BE DOUBLED.

SYMBOLS

- Work Area
- 18 in. X 18 in. (minimum) Orange Flag
- Cone, Drum or Barricade
- Sign on Portable or Permanent Support
- Flagger with Traffic Control Sign
- Barricade or Drum

GENERAL NOTES

1. The taper shall be formed by placing one cone for each foot of lane width or a drum or barricade for each two foot of lane width.
2. Construction operations shall be confined to one traffic lane, leaving the opposite lane open to traffic. At least 500 ft. of both traffic lanes shall be available for traffic movement at intervals not greater than 1,000 ft.
3. If the work operation does not exceed 60 minutes, traffic control may be in conformance with STANDARD 2307.
4. The flaggers shall be in sight of each other or in direct communication at all times.
5. When no work is being performed, the flaggers will not be required. If the flaggers are not present, the Flagger signs shall be removed or covered.
6. All signs, cones, barricades and drums are to be removed at completion of the day's operations and the work area opened to traffic.
7. Longitudinal dimensions may be adjusted to fit field conditions. The lateral placement of the flagger may be varied from that shown.
8. All vehicles, equipment, workers (except flaggers) and their activities are restricted at all times to one side of the pavement unless otherwise authorized by the Engineer.

TYPICAL APPLICATION

- Pavement Patch
- Utility Operations

**TYPICAL APPLICATION OF TRAFFIC CONTROL DEVICES
HIGHWAY CONSTRUCTION AND CONTRACT MAINTENANCE**

**TWO-LANE, TWO-WAY TRAFFIC
RURAL DAY OPERATIONS ONLY**

Where, at any time, any vehicle, equipment, workers or their activities will encroach in the area between the center line and a line 2 ft. outside the edge of pavement

STANDARD 2303-5



Illinois Department of Transportation

Approved MAY 1 1980

L. E. Moberly
Engineer of Traffic

Issued 4-3-89

F-608C

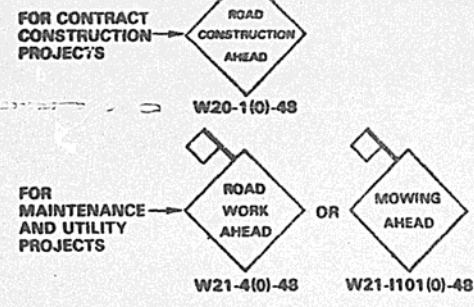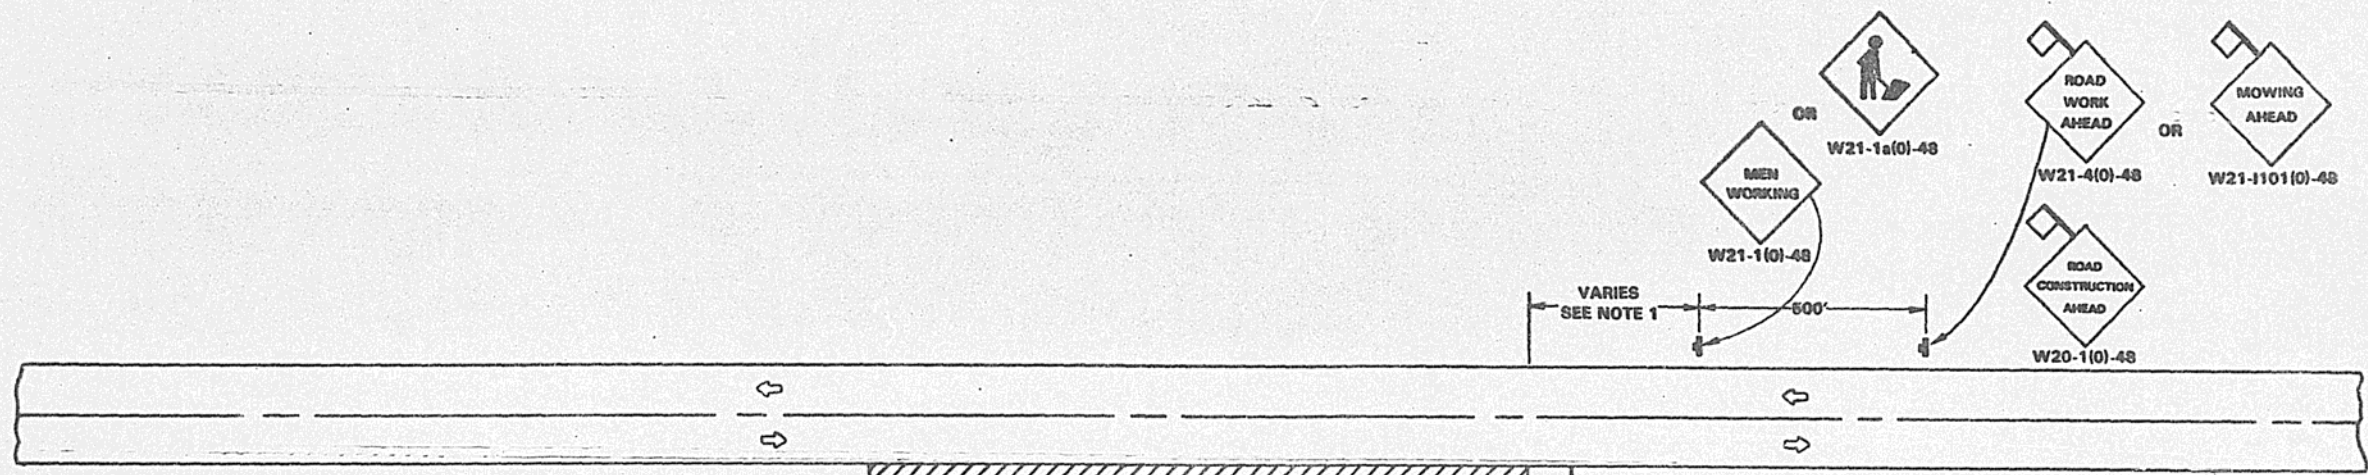

GENERAL NOTES

1. Minimum distance is 200 ft. Maximum distance to be determined by the Engineer but should not exceed 1/2 the length required for one normal working day's operation.
2. If the work operation does not exceed 60 minutes, traffic control may be in conformance with STANDARD 2307.
3. All signs are to be removed at completion of the day's operations.
4. For divided roadways the required advance warning signs shall be posted on both the right and left side of the roadway.
5. Signs mounted in the median may be omitted when the median is less than 10 ft. wide.
6. For multilane roadways the advance warning signs for traffic approaching from the opposite direction will be omitted.
7. Worker signs are to be removed when no work is being performed. Any unattended obstacle or excavation in the work area, which in the opinion of the Engineer constitutes a hazard, shall be protected by barricades at 50-foot centers, with flashing lights at night. If the hazard exceeds 100 ft. in length, steady burning lights shall be substituted for flashing lights. When the distance is greater than 250 ft., barricade spacing may be increased to 100 ft.
8. If the work operation requires that four or more work vehicles enter the through traffic lanes in a one hour period, a flagger shall be provided and the Flagger sign shall be substituted for the Worker sign.
9. Longitudinal dimensions may be adjusted to fit field conditions.
10. All vehicles, equipment, workers and their activities are restricted at all times to one side of the pavement unless otherwise authorized by the Engineer.

SYMBOLS

- Work Area
- 18 in. X 18 in. (minimum) Orange Flag
- Sign on Portable or Permanent Support

TYPICAL APPLICATIONS

- Shoulder Work
- Mowing
- Utility Operations

TYPICAL APPLICATION OF TRAFFIC CONTROL DEVICES HIGHWAY CONSTRUCTION AND MAINTENANCE
RURAL MOVING OPERATIONS DAY OPERATIONS ONLY
Where, at any time, any vehicle, equipment, workers or their activities require an intermittent or continuous moving operation on the shoulder.
STANDARD 2305-4

Illinois Department of Transportation

Approved MAY 1 1980


G. E. T. Hobley
Engineer of Traffic

Issued 4-3-69

F-610c

STANDARD DESIGN

TYPICAL APPLICATION OF TRAFFIC CONTROL DEVICES FOR HIGHWAY CONSTRUCTION AND CONTRACT MAINTENANCE

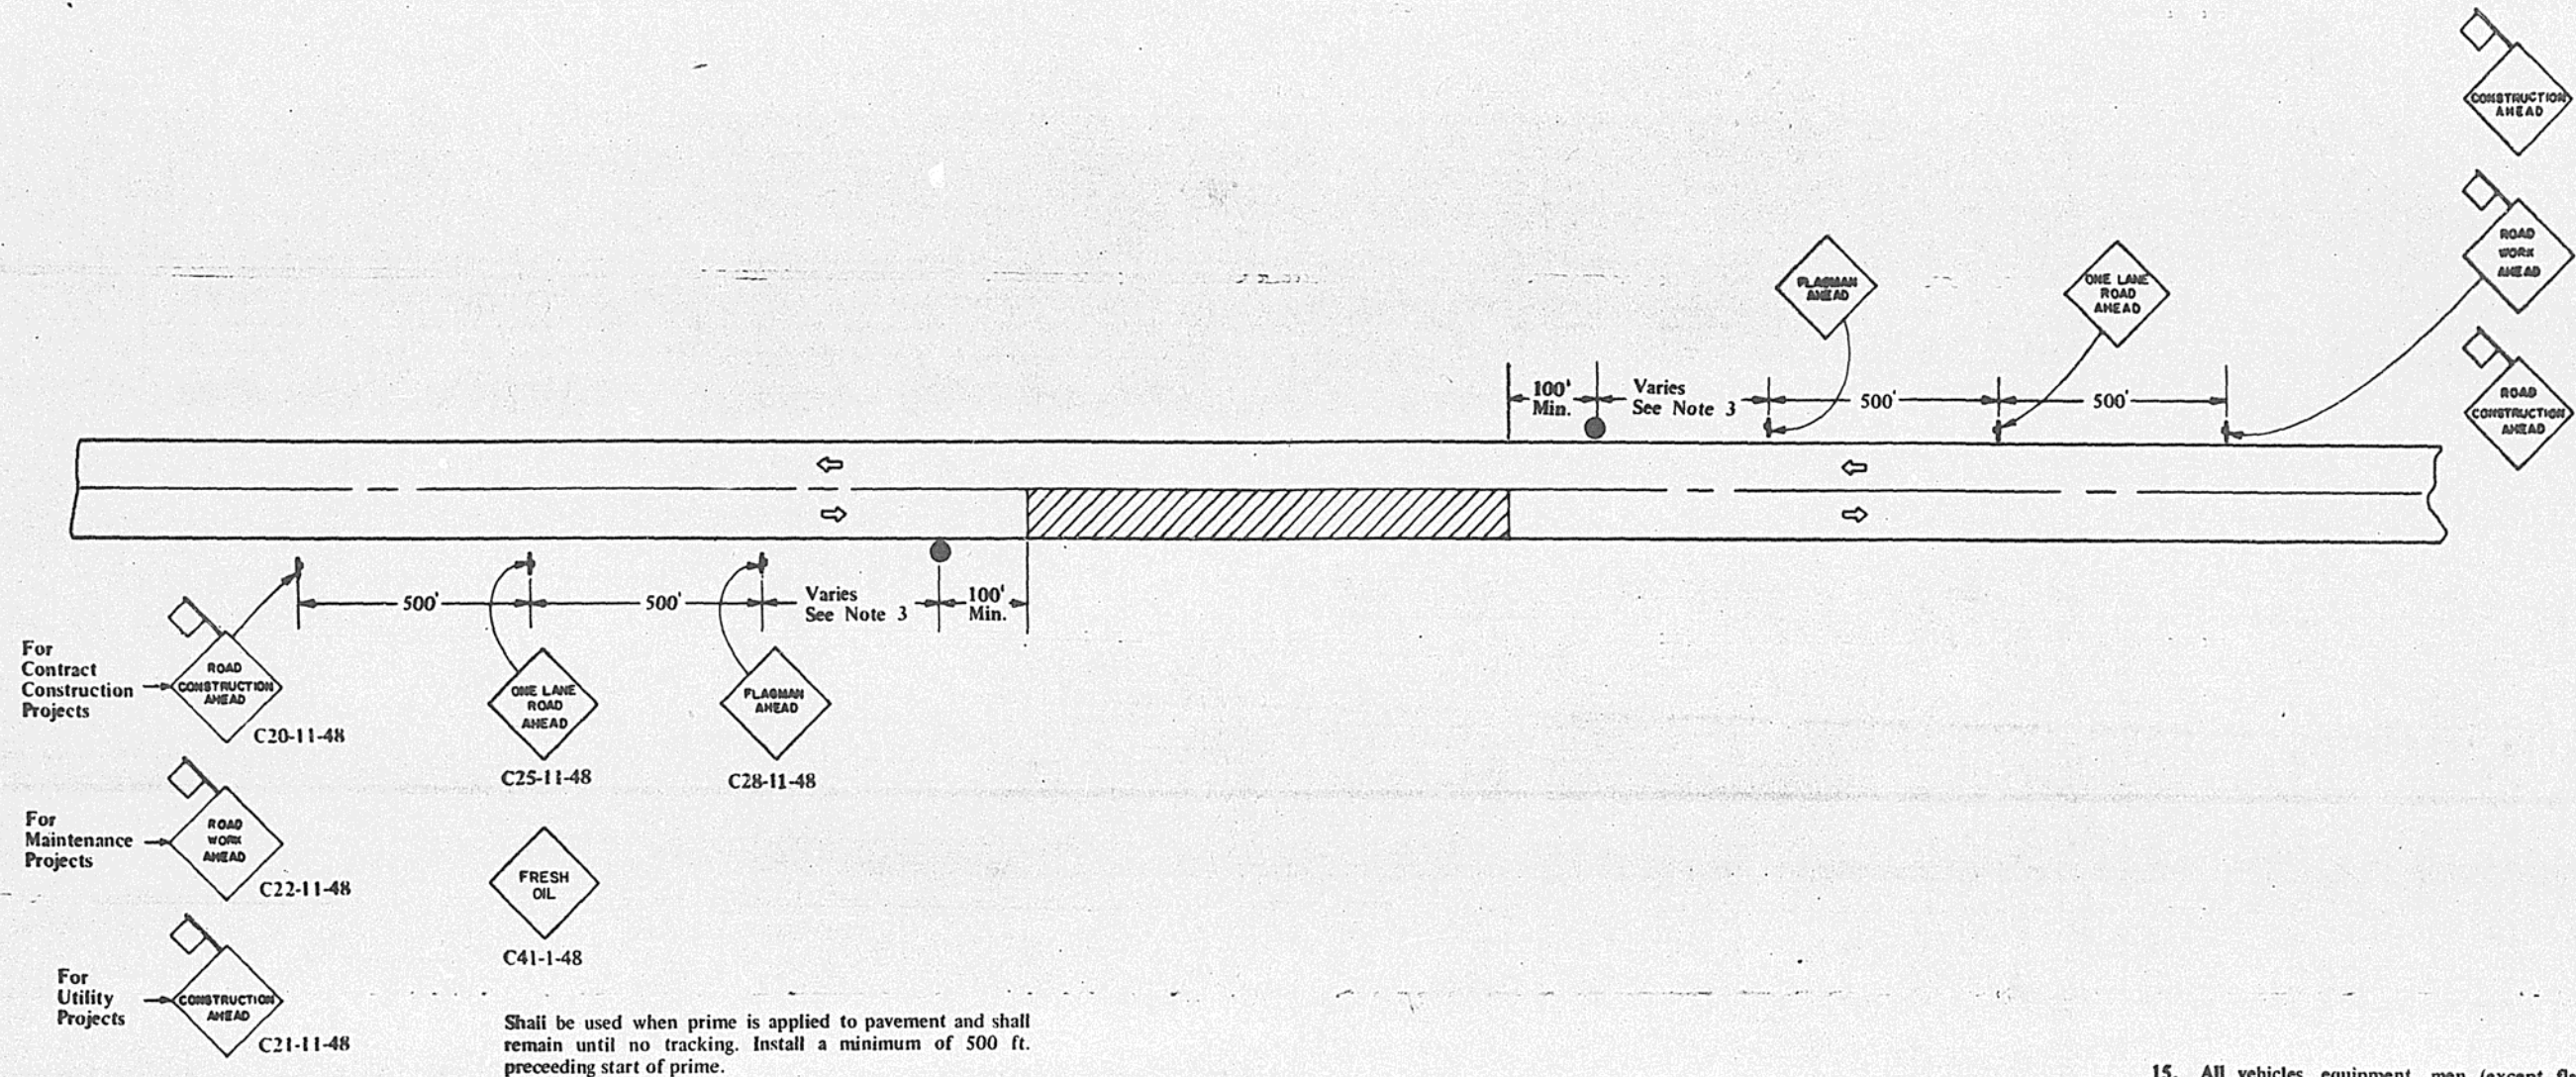

TYPICAL APPLICATIONS

Bituminous Resurfacing
Crack Pouring
Utility Operations

SYMBOLS

- Work Area.
- Sign with 18 in. by 18 in. (minimum) orange flag attached.
- Sign on portable or permanent support.
- Flagman with Traffic Control sign.

GENERAL NOTES

1. Construction operations shall be confined to one traffic lane. On two-lane roads, at least 500 ft. of both traffic lanes shall be available for traffic movement at intervals not greater than 1,000 ft. and a complete traffic control plan must be approved for any project expected to exceed 1,000 ft. in length.
2. The flagmen shall be in sight of each other or in direct communication at all times.
3. Minimum distance is 200 ft. Maximum distance to be determined by the Engineer but in no case to exceed the length of 1/2 day's operation or four miles, whichever is less.
4. If the work operation does not exceed 60 minutes, traffic control will be in conformance with Case VII.
5. All signs are to be removed at completion of the day's operations.
6. For divided roadways the required advance warning signs shall be posted on both the right and left side of the roadway.
7. Signs mounted in the median may be omitted when the median is less than 10 feet wide.
8. For multilane roadways the flagman shown for traffic approaching from the opposite direction will be positioned as directed by the Engineer and the advance warning signs for traffic approaching from the opposite direction omitted.
9. For multilane roadways the advance warning signs for traffic approaching from the opposite direction will be omitted and RIGHT LANE CLOSED AHEAD signs shall be substituted for the ONE LANE ROAD AHEAD signs.
10. This case also applies when work is being performed in lanes adjacent to the centerline of an undivided multilane highway or adjacent to the median on a divided highway. Under these conditions, LEFT LANE CLOSED AHEAD signs shall be substituted for RIGHT LANE CLOSED AHEAD signs.
11. This case does not apply when work is being performed in the middle lane(s) of a six or more lane highway. Special plans approved by the Engineer will be required.
12. ONE LANE ROAD AHEAD and FLAGMAN AHEAD signs are to be removed or covered when no work is being performed.
13. Longitudinal dimensions may be adjusted slightly to fit field conditions. The lateral placement of the flagmen may be varied from that shown.
14. All warning signs shall have minimum dimensions of 48 in. by 48 in. and have black legend and border on an orange reflectorized background.

15. All vehicles, equipment, men (except flagmen) and their activities are restricted at all times to one side of the pavement unless otherwise authorized by the Engineer.

CASE VI

RURAL MOVING OPERATIONS DAY OPERATIONS ONLY

Where, at any time, any vehicle, equipment, men or their activities require an intermittent or continuous moving operation on the pavement where the average speed of movement is less than four miles per hour.

STATE OF ILLINOIS DEPARTMENT OF TRANSPORTATION	ISSUED 4-3-69
APPROVED <i>A. E. Moberly</i> 6-12-1973 Engineer of Traffic	REVISOR BY DATE


STANDARD 2306-4

F-611b


STANDARD DESIGN

TYPICAL APPLICATION OF TRAFFIC CONTROL DEVICES FOR HIGHWAY CONSTRUCTION AND CONTRACT MAINTENANCE


A. For any operation that encroaches in the area between the center line and a line 2 ft. outside the edge of the pavement for a period of less than 15 minutes.

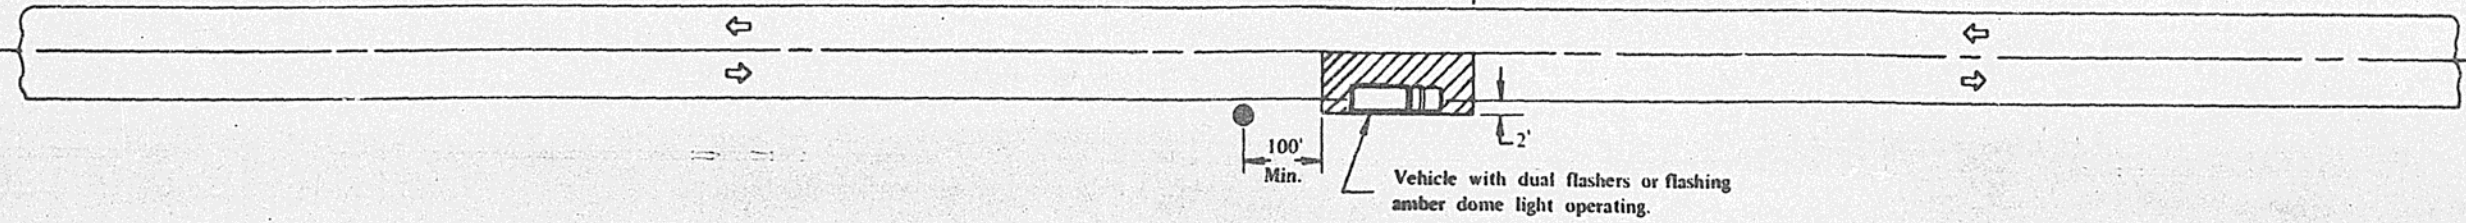

B. For any operation that encroaches in the area between the center line and a line 2 ft. outside the edge of the pavement for a period in excess of 15 minutes but less than 60 minutes.

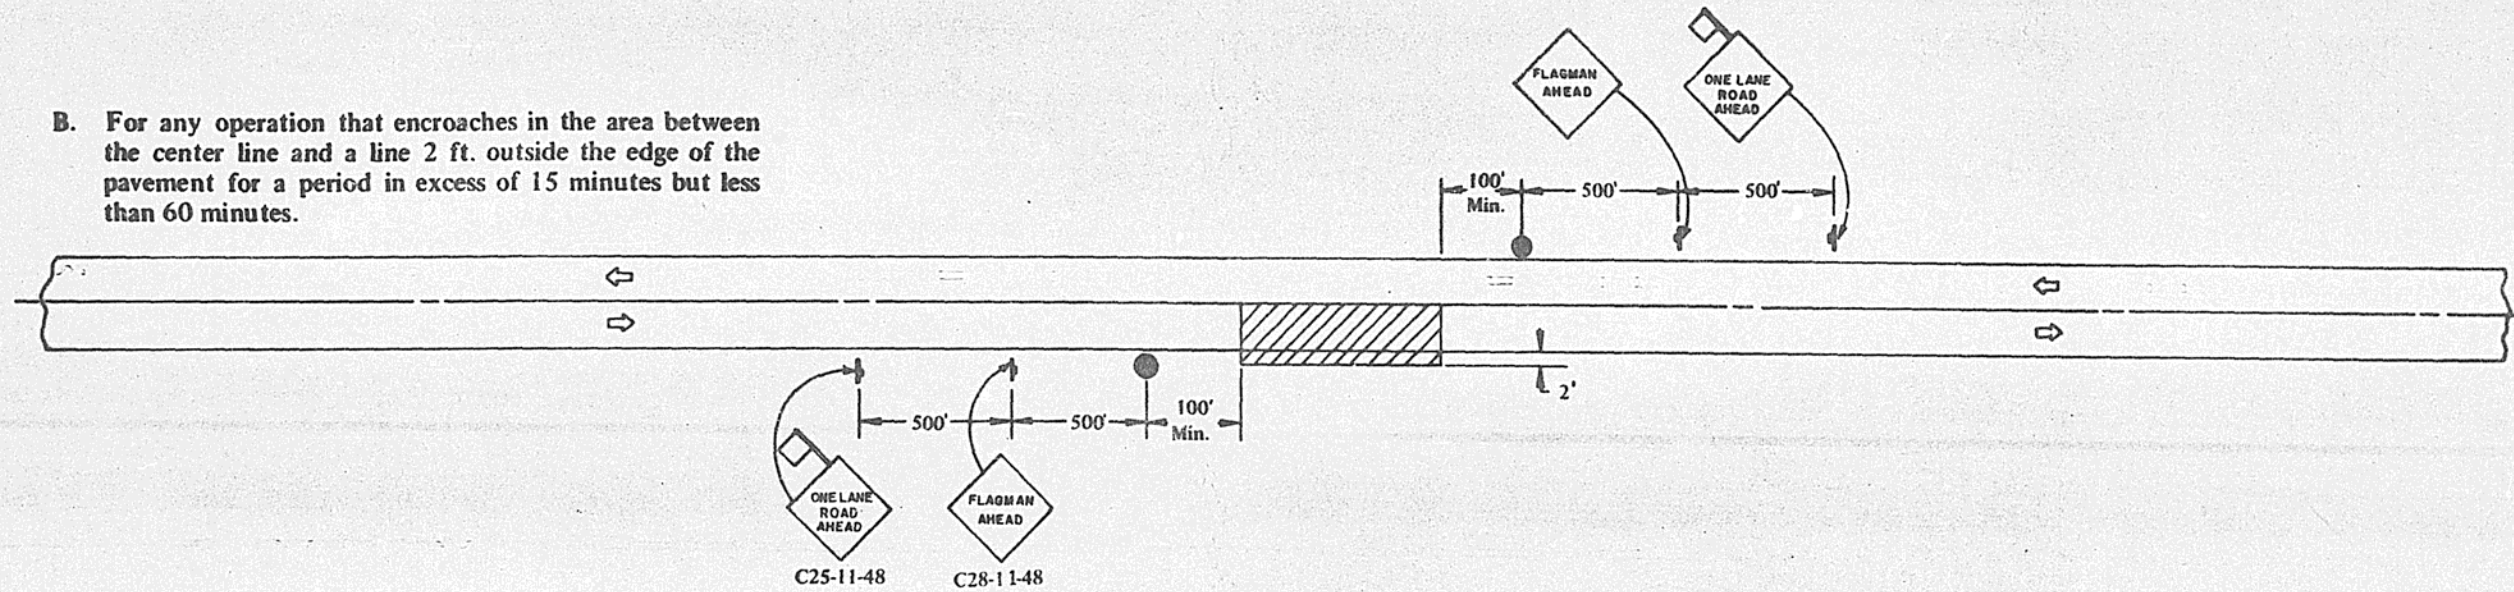

C. For any operation that is more than 2 ft. outside the edge of the pavement for a period of less than 60 minutes.

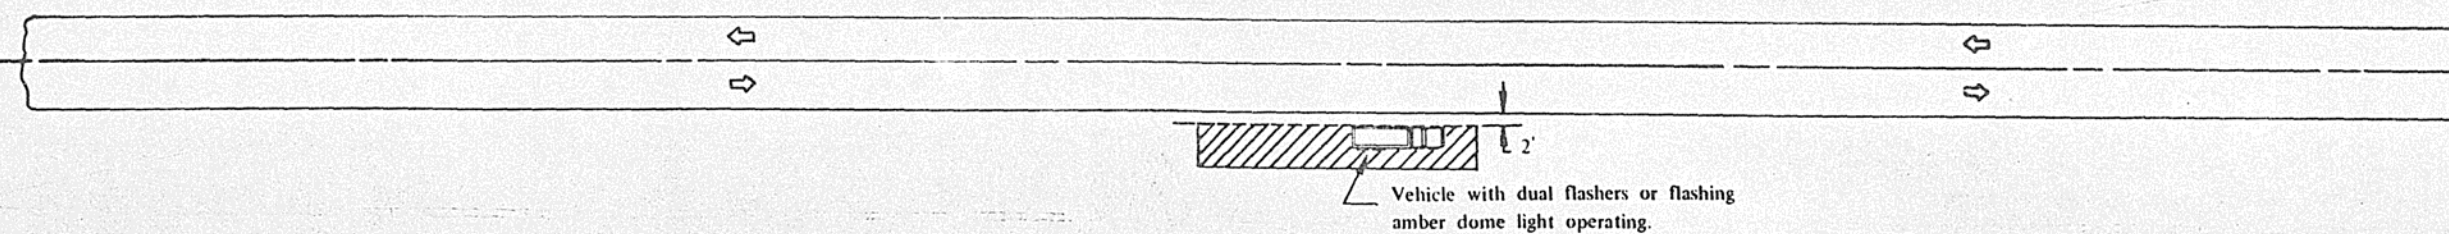

TYPICAL APPLICATIONS

- Marking Patches
- Field Survey
- String Line
- Utility Operation
- Cleaning Up Debris on Pavement

SYMBOLS

- Work Area.
- Sign with 18 in. by 18 in. (minimum) orange flag attached.
- Sign on portable or permanent support.
- Flagman with Traffic Control sign.

GENERAL NOTES

- Construction operations shall be confined to one traffic lane. On two-lane roads, at least 500 ft. of both traffic lanes shall be available for traffic movement at intervals not greater than 1,000 ft. and a complete traffic control plan must be approved for any project expected to exceed 1,000 ft. in length.
- The flagmen shall be in sight of each other or in direct communication at all times.
- All signs are to be removed at completion of each operation.
- For multilane roadways the flagman shown for traffic approaching from the opposite direction will be positioned as directed by the Engineer and the advance warning signs for traffic approaching from the opposite direction omitted.
- Longitudinal dimensions may be adjusted slightly to fit field conditions. The lateral placement of the flagmen may be varied from that shown.
- All warning signs shall have minimum dimensions of 48 in. by 48 in. and have black legend and border on an orange reflectorized background.
- All vehicles, equipment, men (except flagmen) and their activities are restricted at all times to one side of the pavement unless otherwise authorized by the Engineer.


CASE VII

SHORTTIME OPERATIONS DAY OR NIGHT OPERATIONS

STANDARD 2307-4

STATE OF ILLINOIS DEPARTMENT OF TRANSPORTATION	ISSUED 4-3-69
APPROVED 6-12-1973 <i>A.E. Mobley</i> Engineer of Traffic	REVISOR BY DATE




E-612 b

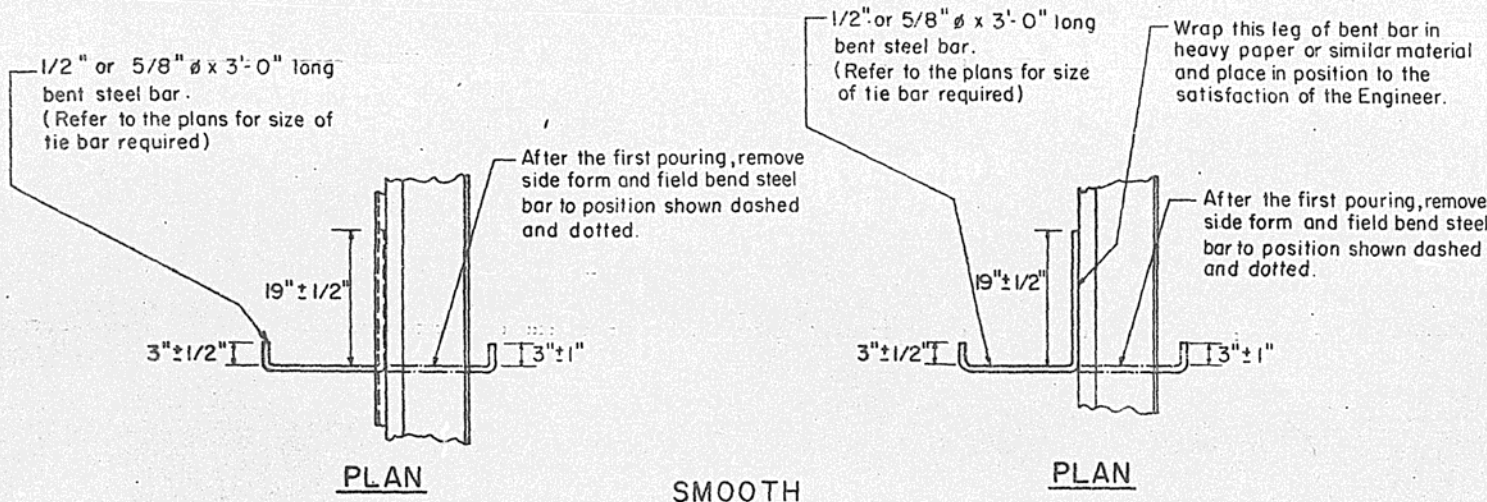


PLAN

PLAN


SMOOTH HOOKED TIE BARS

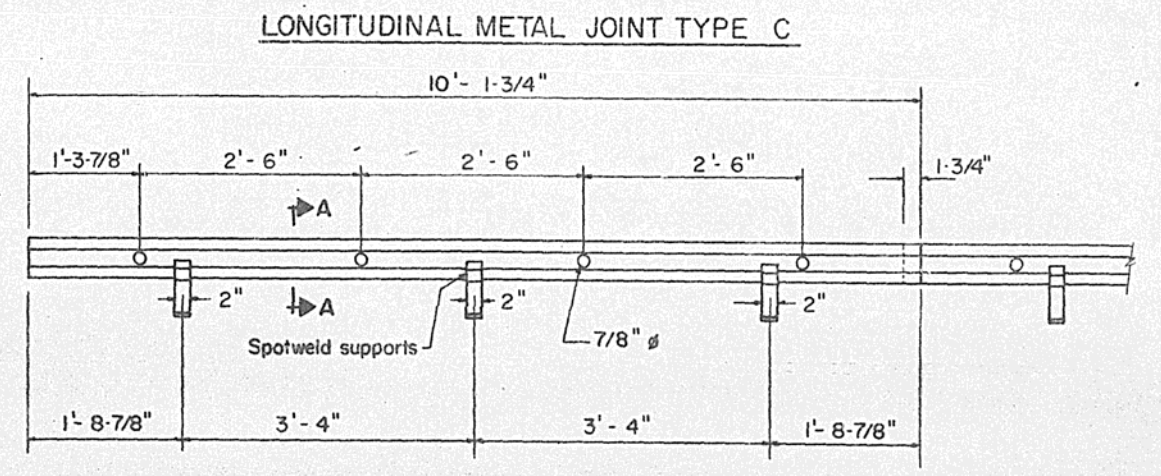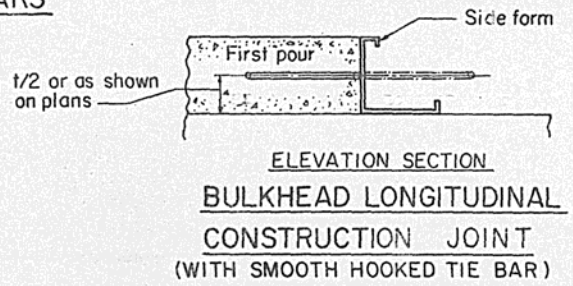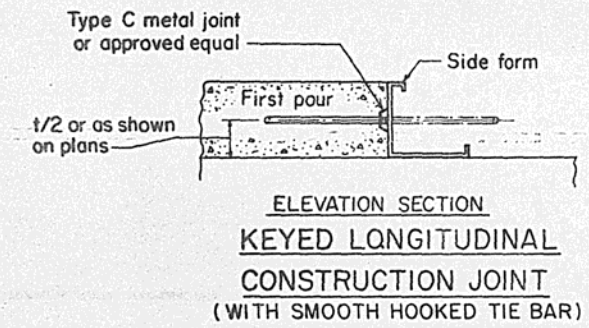

LONGITUDINAL METAL JOINT TYPE C

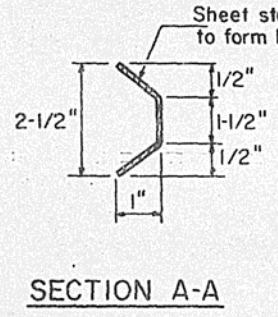


SECTION A-A

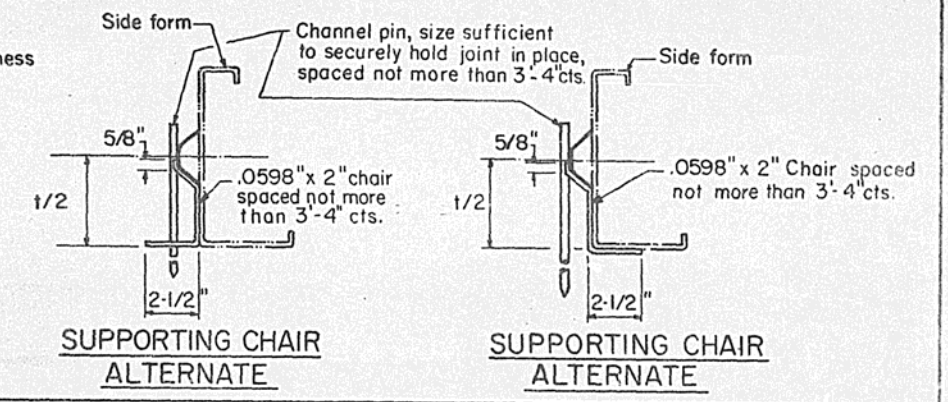


SUPPORTING CHAIR ALTERNATE


SUPPORTING CHAIR ALTERNATE

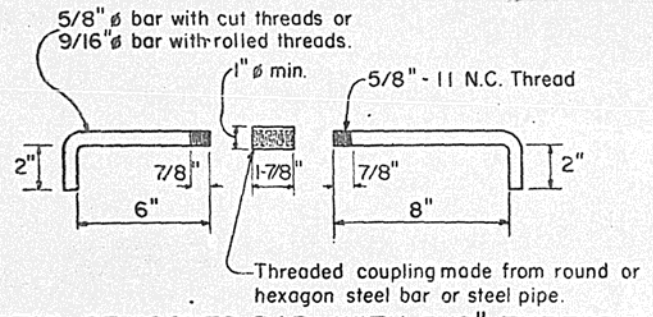

DETAIL OF HOOKED BAR WITH 5/8" THREAD

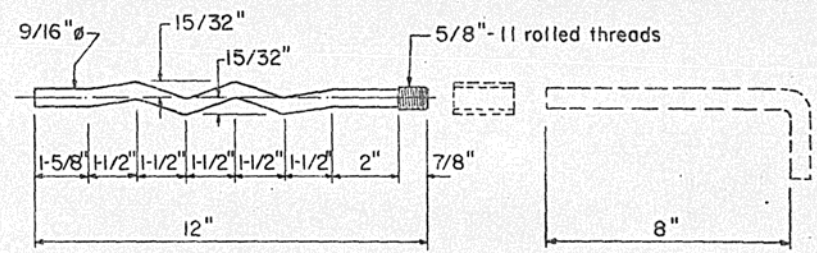


DETAIL OF OPTIONAL "W" BAR

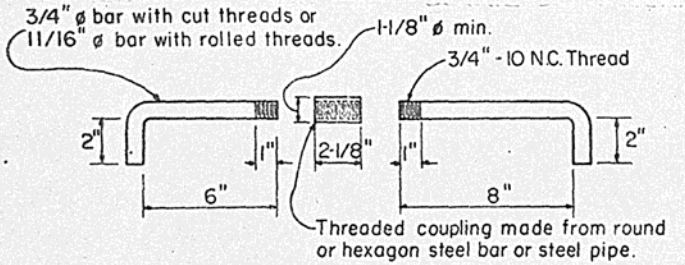


DETAIL OF HOOKED BAR WITH 3/4" THREAD

THREADED HOOKED TIE BARS

NOTE:
Refer to the plans for size of tie bar required. Use the hooked bars with 5/8" thread when 1/2" φ tie bars are specified and with 3/4" thread when 5/8" φ tie bars are specified.

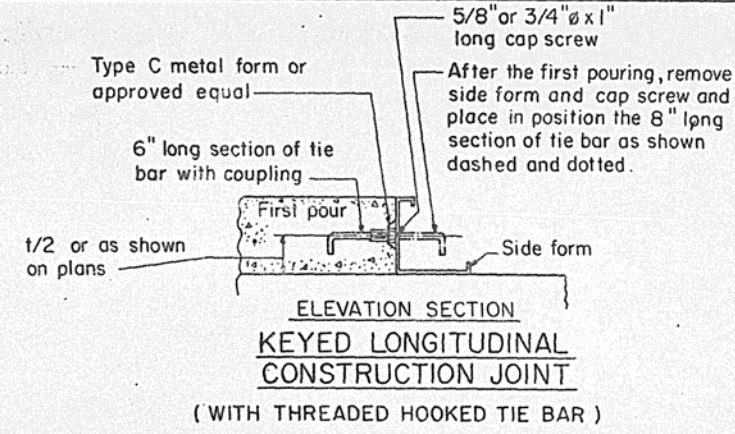

ELEVATION SECTION KEYED LONGITUDINAL CONSTRUCTION JOINT (WITH THREADED HOOKED TIE BAR)

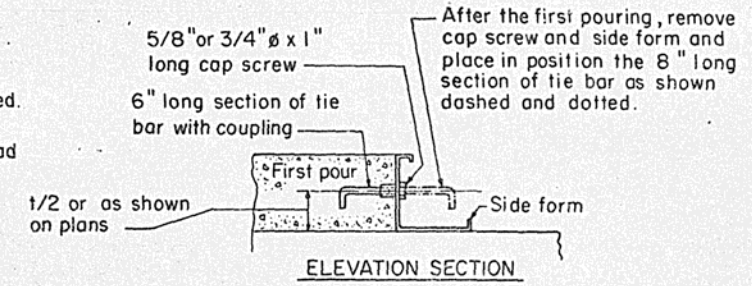


ELEVATION SECTION BULKHEAD LONGITUDINAL CONSTRUCTION JOINT (WITH THREADED HOOKED TIE BAR)

GENERAL NOTES

The bent steel bars shall be plain, round bars conforming to the requirements of AASHTO M-31 or M-53 grade 40.
Hex head bolts meeting the requirements of Article 710.10 of the Standard Specifications may be used in lieu of the hooked tie bar. Minimum embedment shall be 4" for 5/8" bolts and 6" for 3/4" bolts.
The steel pipe for the threaded coupling shall be ASTM A-53, Types E or S, Grade A or equivalent.
The Contractor may use at his option for form paving or slip form paving, either the smooth hooked tie bars or the threaded hooked tie bars, as detailed, or deformed tie bars as noted below.
Deformed bar conforming to the requirements of AASHTO M-31 or M-53 may be used for tie bars in lieu of smooth or threaded hooked tie bars, except that the elongation shall not be less than 20%. Deformed tie bars shall be comparable in size to the smooth bar, 2'-6" long, without hooks at the ends.
Support pins for tie bars, when required, shall be of a size and strength sufficient to firmly hold the bar in place.
t = pavement thickness.

Illinois Department of Transportation
PASSED Dec 18 1979
APPROVED Dec 18 1979
ISSUED 10-10-66

PAVEMENT JOINTS
STANDARD 2323 - 5
Full Size D.W.W. Sr.

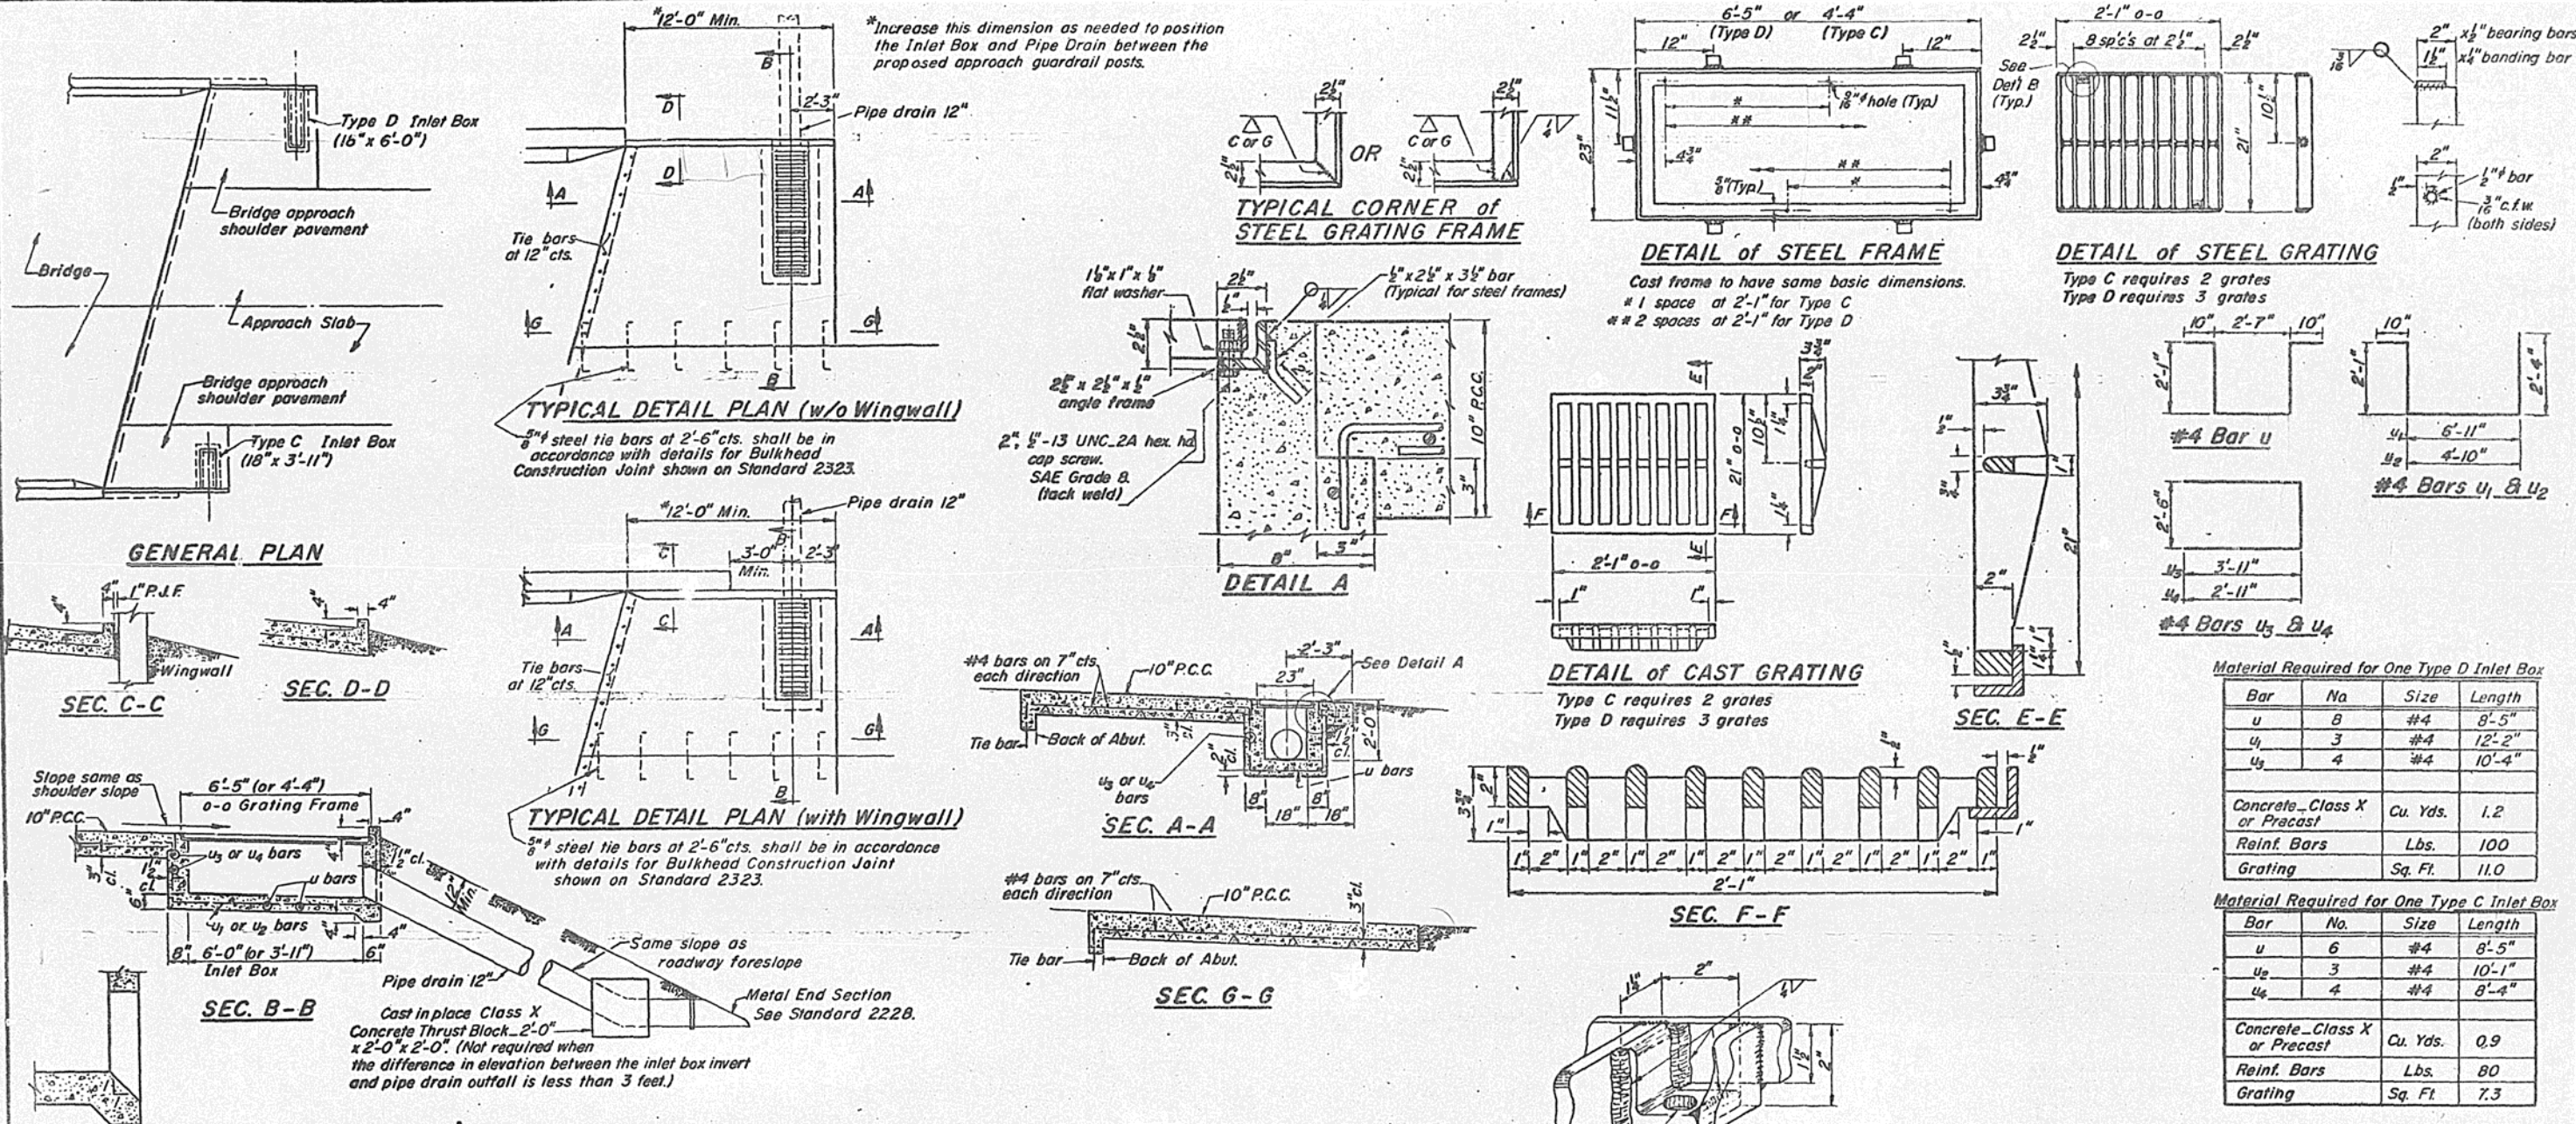

*Increase this dimension as needed to position the Inlet Box and Pipe Drain between the proposed approach guardrail posts.

5/8" steel tie bars at 2'-6" cts. shall be in accordance with details for Bulkhead Construction Joint shown on Standard 2323.

5/8" steel tie bars at 2'-6" cts. shall be in accordance with details for Bulkhead Construction Joint shown on Standard 2323.

Cast in place Class X Concrete Thrust Block... 2'-0" x 2'-0" x 2'-0". (Not required when the difference in elevation between the inlet box invert and pipe drain outfall is less than 3 feet.)

The lengths of #4 bars used in the approach shoulder pavement shall be as required to accommodate the length, width and skew of the slab.

Class X concrete or precast concrete shall be used for the inlet. Precast concrete shall be in accordance with Sections 505.01 thru 505.05 of the Standard Specifications except that the concrete strength shall be 4000 p.s.i. after 28 days.

All exposed edges of the inlet, except the upper perimeter, shall be beveled 3/4".

Shop drawings will not be required for precast Inlet Boxes.

A 3" deep sand bedding conforming to Article 703.01 (FA 1 or FA 2) shall be provided under full length and width of precast units, and all voids around the pipe drain entrance, both inside and outside, shall be sealed with mortar.

The grating shall seat firmly in the frame and steel grates shall be secured to the frame with a locking device as shown. Cast grates will not require the locking device.

Steel grating and frames shall conform to Article 710.04 of the Standard Specifications and shall be galvanized to AASHTO Specification M III after fabrication.

Cast grating and frames shall conform to Article 710.17 of the Standard Specifications. Cast grating and frames shall not be galvanized.

Pipe drains shall be installed, measured and paid for in accordance with Section 607 of the Standard Specifications.

Metal End Sections shall be installed, measured and paid for in accordance with Section 511 of the Standard Specifications.

Bridge approach shoulder pavement will be measured in place and paid for in square yards as P.C. CONCRETE BRIDGE APPROACH SHOULDER PAVEMENT which shall include the cost of subgrade preparation, expansion anchor ties, reinforcement and joint fillers. In computing the area for payment, a deduction will be made for the area displaced by the inlet. (1.2 Sq. Yds. Type C; 1.7 Sq. Yds. Type D)

The contract unit price "Each" for TYPE D INLET BOX STANDARD 2324 or TYPE C INLET BOX STANDARD 2324, in place, shall include the frames and grating, class X or precast concrete, reinforcement bars, excavation, bedding when required, and compacted backfilling.

The contract unit price "Each" for CONCRETE THRUST BLOCKS, in place, shall include excavation and compacted backfilling.

Material Required for One Type D Inlet Box

Bar	No.	Size	Length
u	8	#4	8'-5"
u ₁	3	#4	12'-2"
u ₂	4	#4	10'-4"
Concrete - Class X or Precast			Cu. Yds. 1.2
Reinf. Bars			Lbs. 100
Grating			Sq. Ft. 11.0

Material Required for One Type C Inlet Box

Bar	No.	Size	Length
u	6	#4	8'-5"
u ₂	3	#4	10'-1"
u ₄	4	#4	8'-4"
Concrete - Class X or Precast			Cu. Yds. 0.9
Reinf. Bars			Lbs. 80
Grating			Sq. Ft. 7.3

BRIDGE APPROACH SHOULDER PAVEMENT

STANDARD 2324-5
(Full Size)

Illinois Department of Transportation

PASSED June 18, 1980








APPROVED June 18, 1980

Engineer of Bridge and Traffic Structures

Engineer of Design

ISSUED 12-1-69

H-125e

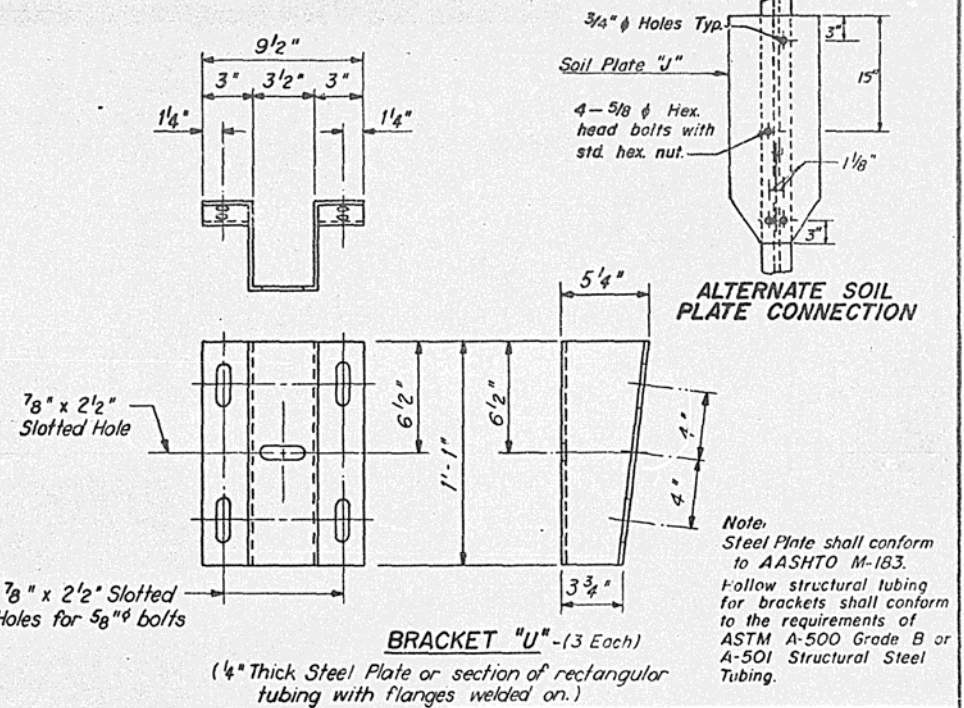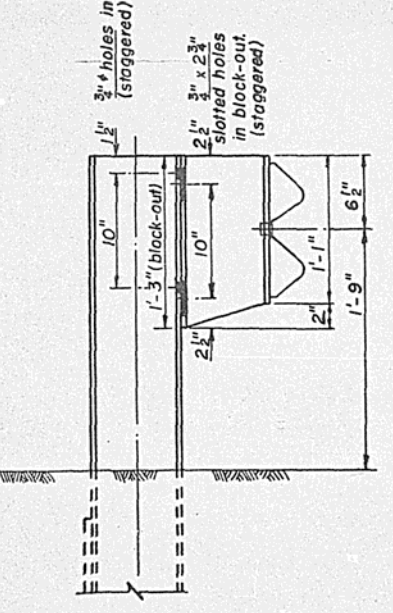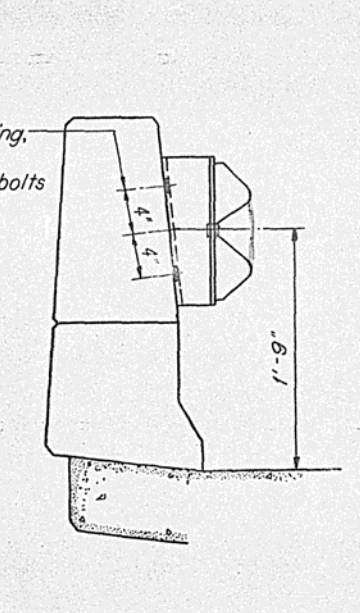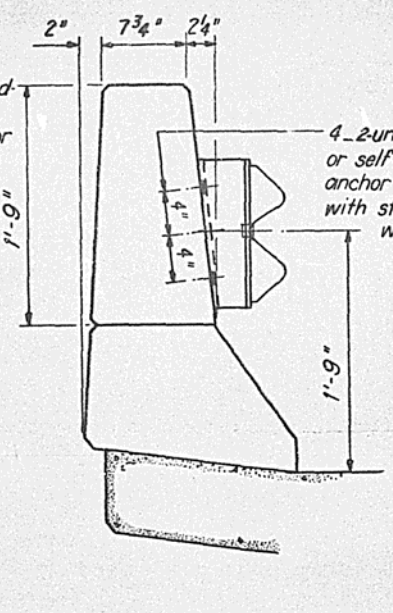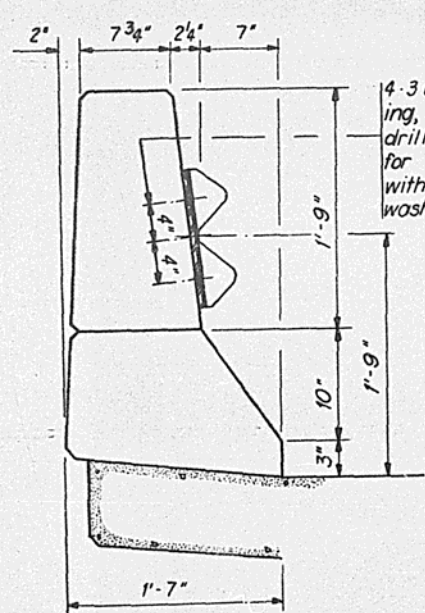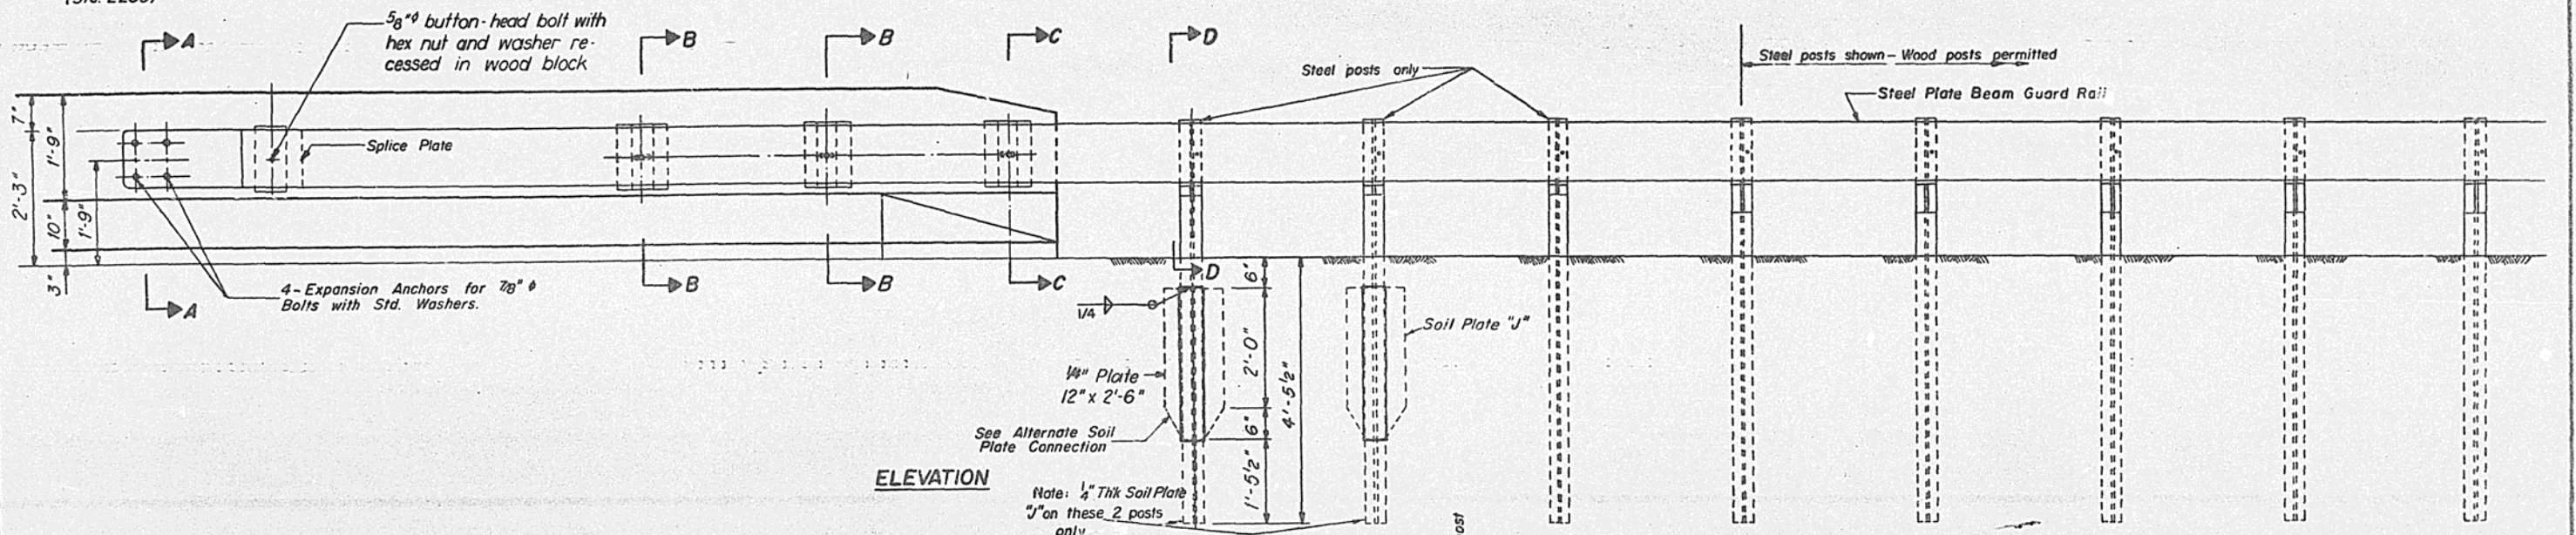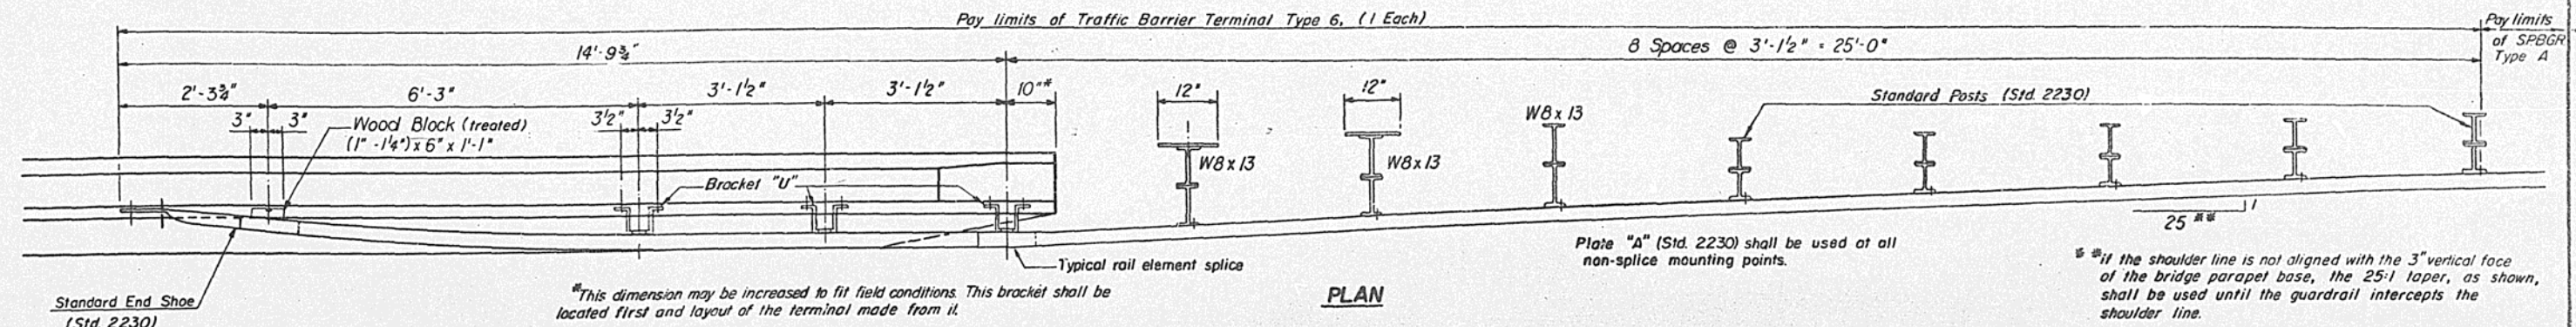

GENERAL NOTES:

For details of guardrail not shown see Standard 2230

When a bridge expansion joint exists between the End Shoe and the first post, all splice bolts at the End Shoe and post bolts at the brackets shall be fitted with a locknut or double nuts tightened only to a point that will allow guardrail movement.

Illinois Department of Transportation

PASSED Aug. 31, 1979

Engineer of Bridge and Traffic Structures

APPROVED Aug. 31, 1979

Engineer of Design


ISSUED 8-1-77

**TRAFFIC BARRIER
TERMINAL TYPE 6**

STANDARD 234I-1


(Full Size)

F-330 D

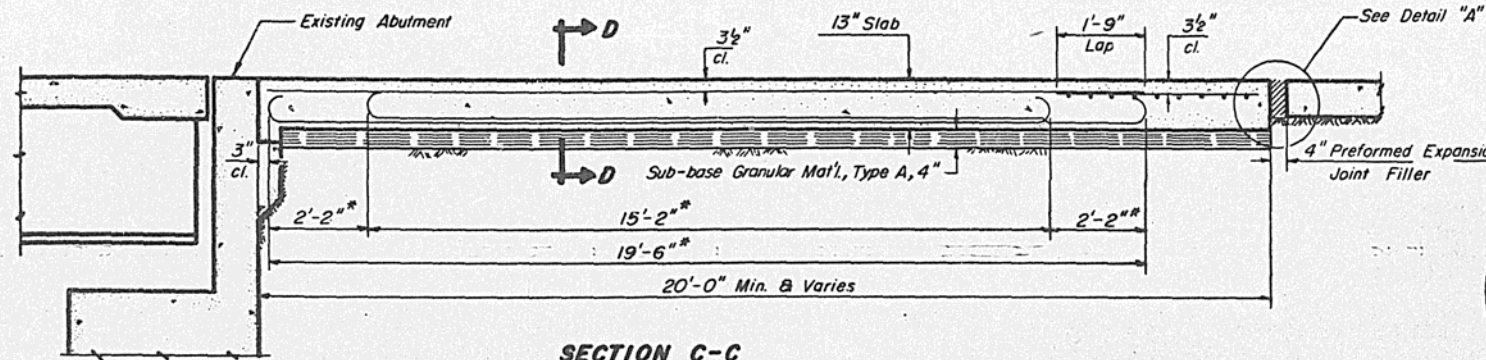


SECTION C-C

*Stagger alternate #7 bars as shown on plan - full width.

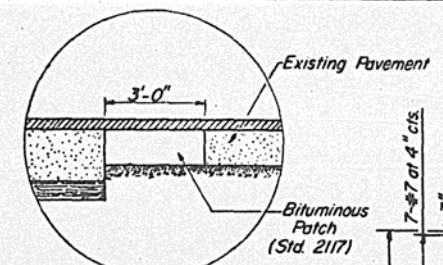

DETAIL "A"


(When bituminous surface is being placed)

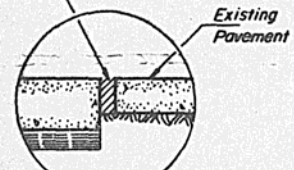


DETAIL "A"

(P.C.C. Pavement Construction)

Keyed Longitudinal Construction Joint in accordance with details shown on Standard 2323.

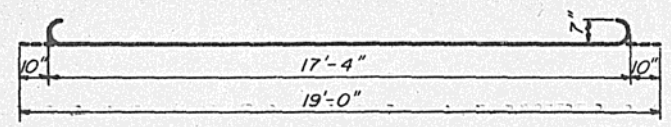


#7 BARS

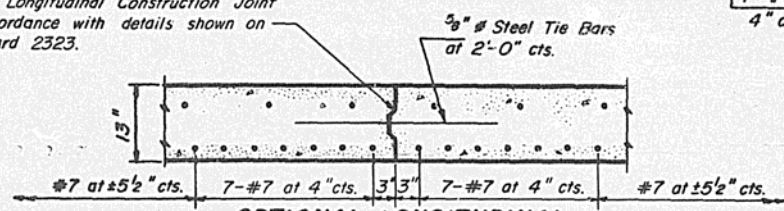


OPTIONAL LONGITUDINAL CONSTRUCTION JOINT

As approved by the Engineer, the Contractor may elect to reduce the widths of pour by use of the Optional Longitudinal Construction Joint shown. Joints shall be located at the edge of a traffic lane.

When the road plans show curb and gutter, gutter, or bridge approach shoulder pavement adjacent to approach slabs, place 1/2 inch diameter steel tie bars at 2 feet 6 inches centers in accordance with the detail for Bulkhead Longitudinal Construction Joint shown on Standard 2323. Cost of the tie bars will be included in the contract unit price for the adjacent item. Transitions for curb and gutter or gutter shall be as shown on the plans.

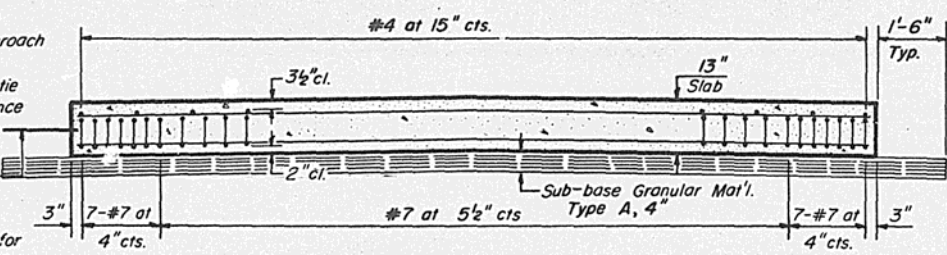

SECTION D-D

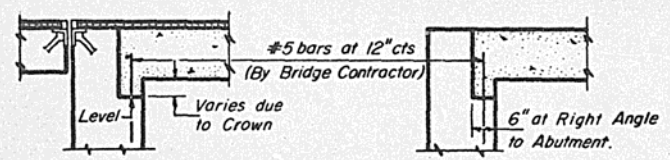

SECTION E-E


Notes:
 For skews of less than 10 degrees omit wire fabric. For skews of 10 degrees or more use Welded Wire Fabric, 6"x6"-W5.5 x W5.5, placed 3/2 inch below top of slab. Expanded Metal weighing not less than 78 Pounds per 100 Sq. Ft. or a welded bar mat weighing not less than 78 Pounds per 100 Sq. Ft. having members of equal size in both directions and spaced not over 8" apart may be used instead of the Welded Wire Fabric, 6"x6"-W5.5 x W5.5, provided the expanded metal or bar mat is furnished at no additional cost to the State. Reinforcement bars shall conform to the requirements of A.A.S.H.T.O. M 31 or M 53, Grade 60.

DESIGN STRESSES


$f_y = 60,000$ p.s.i.
 $f'_c = 3500$ psi
 $n = 8.5$

GENERAL NOTES

The cost of tie bars, expansion joint filler, sub-base, welded wire fabric and bituminous prime when required shall be considered as included in the unit cost of the Bridge Approach Pavement.
 Preformed Expansion Joint Filler shall conform to Section 715 of the Standard Specifications. Width of Bridge Approach Slab shall be determined before the reinforcement bars are fabricated.
 The bituminous patch, when required, will be paid for in accordance with Section 620 of the Standard Specifications.

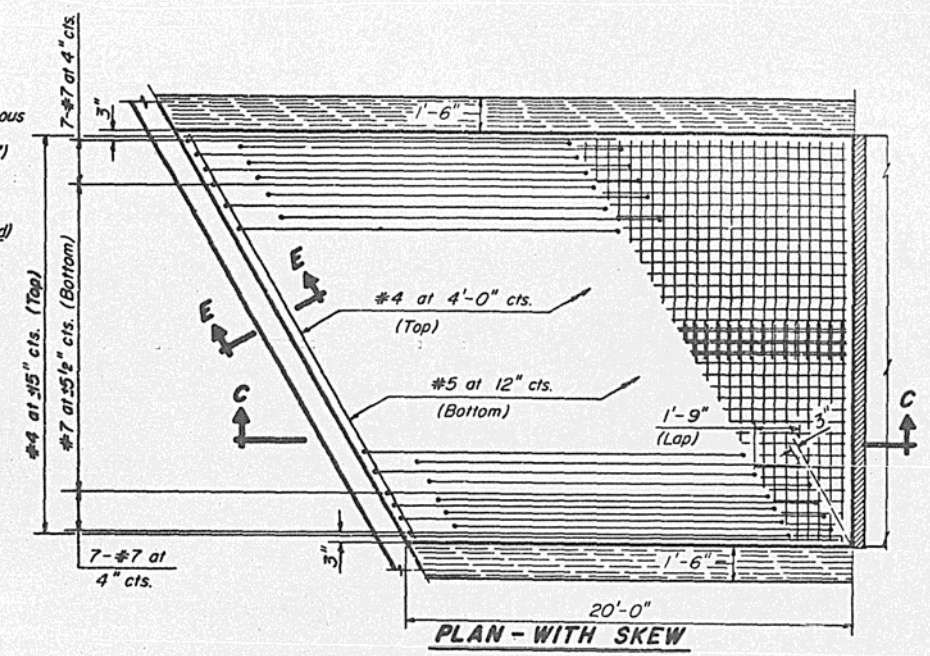

PLAN - WITH SKEW

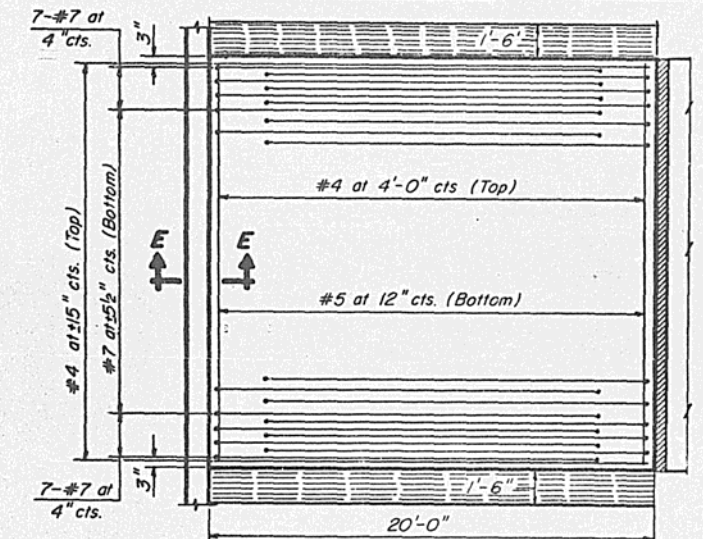

PLAN - WITHOUT SKEW

Illinois Department of Transportation

PASSED Sept 4, 1979
Carl C. Thurman
 Engineer of Bridge and Traffic Structures

APPROVED Sept 4, 1979
Thomas R. Bryant
 Engineer of Design

ISSUED 3-9-79

BRIDGE APPROACH PAVEMENT

Sheet 1 of 2

STANDARD 2382-1

H-5.304


Note: The notation for the number of bars given as "4 x 2" indicates 4 lines of bars with 2 lengths per line. Min. bar lap = 1'-3"

Skew Angle Degrees	Bottom Reinforcement		Top Reinforcement		Reinforcement (Total Weight) (Pounds)	Slab Area (Sq.Yds.)	6x6-W5.5xW5.5 W.W.F.	
	Transverse #5 No.	Longitudinal #7 Length	Transverse #4 No.	Longitudinal #4 Length			Dimensions L(ft.)xW(ft.)	Area* (Sq.Yds.)
18'-0" PAVEMENT								
0	20	17'-6"	6	17'-6"	2300	40.0		
5	20	17'-7"	6	17'-7"	2302	41.6		
10	20	17'-9"	6	17'-9"	2306	43.2	7'-0" x 9'-6"	7.4
15	20	18'-1"	5	18'-1"	2303	44.8	8'-6" x 9'-6"	9.0
20	19	18'-8"	5	18'-8"	2297	46.6	10'-6" x 9'-6"	11.1
25	18	19'-4"	5	19'-4"	2292	48.4	12'-3" x 9'-6"	12.9
30	18	20'-3"	5	20'-3"	2313	50.4	14'-3" x 9'-6"	15.0
35	17	21'-4"	5	21'-4"	2315	52.6	16'-6" x 9'-6"	17.4
40	16	22'-10"	4	22'-10"	2307	55.1	19'-0" x 9'-6"	20.1
45	14	24'-9"	4	24'-9"	2293	58.0	21'-9" x 9'-6"	23.0
50	13	27'-3"	4	27'-3"	2308	61.5	25'-6" x 9'-6"	26.9
55	12x2	15'-9"	3x2	15'-9"	2322	65.7	29'-9" x 9'-6"	31.4
60	10x2	18'-0"	3x2	18'-0"	2313	71.2	35'-3" x 9'-6"	37.2
24'-0" PAVEMENT								
0	20	23'-6"	6	23'-6"	3019	53.3		
5	20	23'-7"	6	23'-7"	3021	56.1		
10	20	23'-10"	6	23'-10"	3028	58.9	8'-0" x 12'-6"	11.1
15	20	24'-4"	5	24'-4"	3024	61.9	10'-3" x 12'-6"	14.2
20	19	25'-0"	5	25'-0"	3014	64.9	12'-6" x 12'-6"	17.4
25	18	25'-11"	5	25'-11"	3008	68.2	15'-0" x 12'-6"	20.8
30	18	27'-2"	5	27'-2"	3036	71.8	17'-9" x 12'-6"	24.7
35	17	28'-8"	5	28'-8"	3039	75.7	20'-9" x 12'-6"	28.8
40	16x2	16'-0"	4x2	16'-0"	3055	80.2	24'-0" x 12'-6"	33.3
45	14x2	17'-3"	4x2	17'-3"	3031	85.3	27'-6" x 12'-6"	38.2
50	13x2	18'-10"	4x2	18'-10"	3046	91.4	32'-9" x 12'-6"	45.5
55	12x2	21'-1"	3x2	21'-1"	3047	99.0	38'-3" x 12'-6"	53.1
60	10x2	24'-0"	3x2	24'-0"	3032	108.7	45'-6" x 12'-6"	63.2

*Area does not include 8" longitudinal laps.
W.W.F.=Welded Wire Fabric

Skew Angle Degrees	Bottom Reinforcement		Top Reinforcement		Reinforcement (Total Weight) (Pounds)	Slab Area (Sq.Yds.)	6x6-W5.5xW5.5 W.W.F.	
	Transverse #5 No.	Longitudinal #7 Length	Transverse #4 No.	Longitudinal #4 Length			Dimensions L(ft.)xW(ft.)	Area* (Sq.Yds.)
26'-0" PAVEMENT								
0	20	25'-6"	6	25'-6"	3238	57.8		
5	20	25'-7"	6	25'-7"	3240	61.1		
10	20	25'-11"	6	25'-11"	3249	64.4	8'-6" x 13'-6"	12.8
15	20	26'-5"	5	26'-5"	3243	67.8	11'-0" x 13'-6"	16.5
20	19	27'-2"	5	27'-2"	3233	71.4	13'-6" x 13'-6"	20.3
25	18	28'-2"	5	28'-2"	3227	75.3	16'-3" x 13'-6"	24.4
30	18x2	15'-3"	5x2	15'-3"	3278	79.5	19'-0" x 13'-6"	28.5
35	17x2	16'-1"	5x2	16'-1"	3282	84.1	22'-3" x 13'-6"	33.4
40	16x2	17'-2"	4x2	17'-2"	3269	89.3	25'-9" x 13'-6"	38.6
45	14x2	18'-6"	4x2	18'-6"	3243	95.3	30'-0" x 13'-6"	45.0
50	13x2	20'-4"	4x2	20'-4"	3264	102.5	35'-0" x 13'-6"	52.5
55	12x2	22'-9"	3x2	22'-9"	3265	111.4	41'-3" x 13'-6"	61.9
60	10x2	26'-0"	3x2	26'-0"	3251	122.8	49'-0" x 13'-6"	73.5
36'-0" PAVEMENT								
0	20x2	18'-3"	6x2	18'-3"	4471	80.0		
5	20x2	18'-4"	6x2	18'-4"	4475	86.3		
10	20x2	18'-6"	6x2	18'-6"	4483	92.7	10'-0" x 18'-6"	20.6
15	20x2	18'-10"	5x2	18'-10"	4475	99.3	13'-6" x 18'-6"	27.7
20	19x2	19'-5"	5x2	19'-5"	4462	106.2	17'-0" x 18'-6"	34.9
25	18x2	20'-2"	5x2	20'-2"	4455	113.6	20'-6" x 18'-6"	42.1
30	18x2	21'-0"	5x2	21'-0"	4492	121.6	24'-9" x 18'-6"	50.8
35	17x2	22'-3"	5x2	22'-3"	4501	130.4	29'-0" x 18'-6"	59.6
40	16x2	23'-9"	4x2	23'-9"	4483	140.4	33'-9" x 18'-6"	69.4
45	14x2	25'-8"	4x2	25'-8"	4450	152.0	39'-6" x 18'-6"	81.2
50	13x2	28'-2"	4x2	28'-2"	4477	165.8	46'-6" x 18'-6"	95.6
55	12x3	21'-4"	3x3	21'-4"	4492	182.8	55'-0" x 18'-6"	113.0
60	10x3	24'-4"	3x3	24'-4"	4471	204.7	65'-9" x 18'-6"	135.1

*Area does not include 8" longitudinal laps.

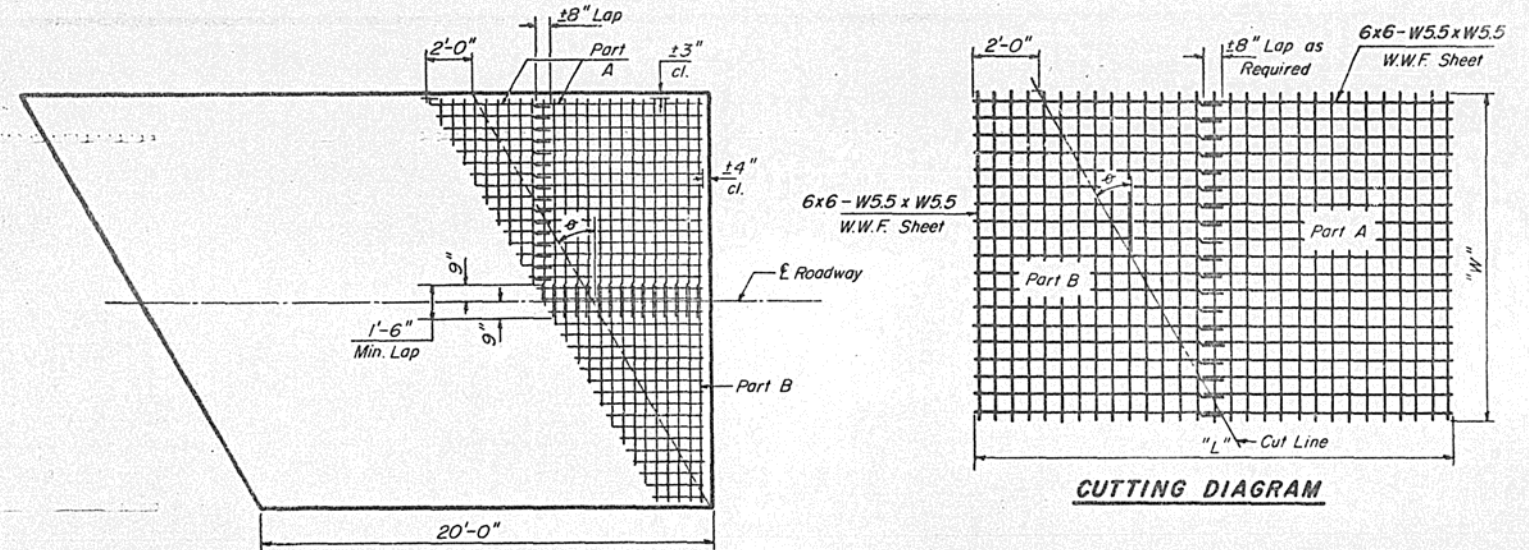

PLACEMENT OF 6x6-W5.5xW5.5

W.W.F. only required on skews $\geq 10^\circ$

CUTTING DIAGRAM


Missouri Department of Transportation
 PASSED Sept. 4, 1979
 Carl W. ...
 Engineer of Bridge and Traffic Structures
 APPROVED Sept. 4, 1979
 ...
 Engineer of Design

BRIDGE APPROACH PAVEMENT


Sheet 2 of 2

STANDARD 2382-1


H-5-310

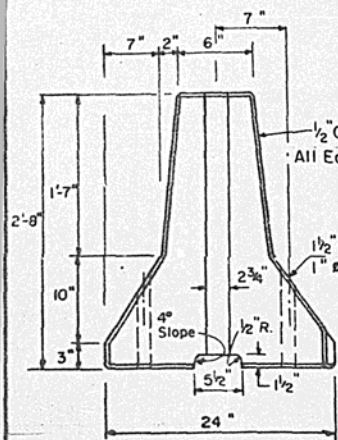


END VIEW

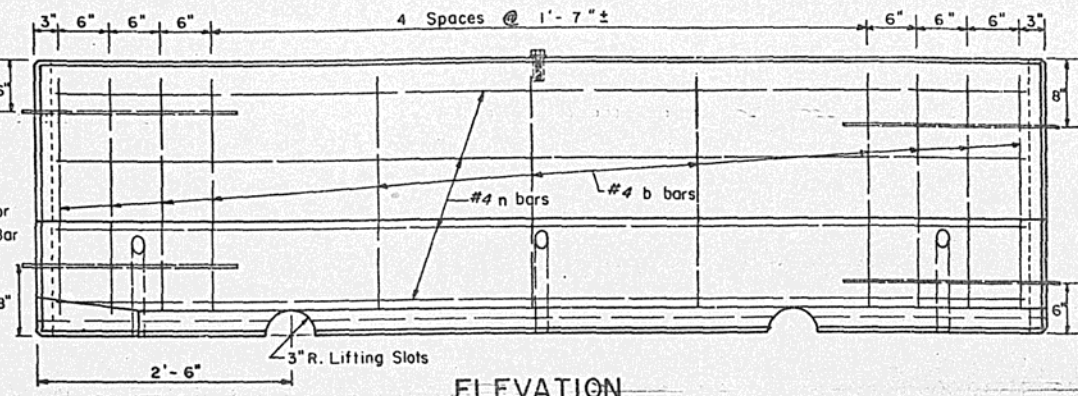


ELEVATION

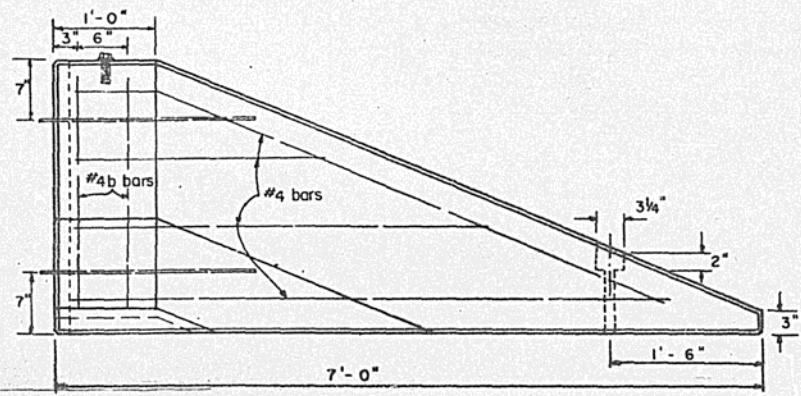


TERMINAL SECTION

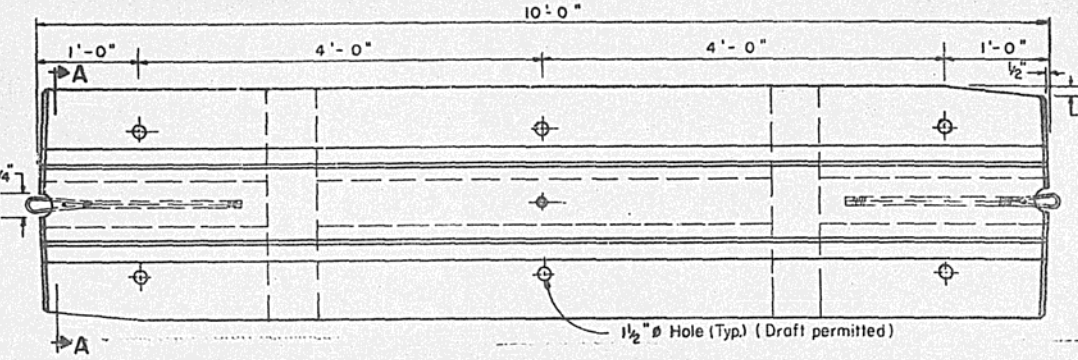


PLAN

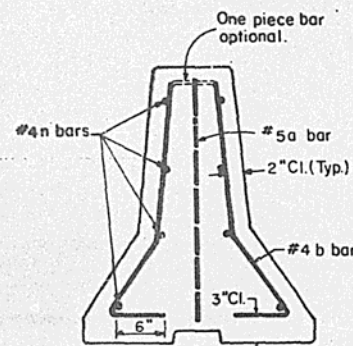


SECTION A-A
(Showing Bar Reinforcement)

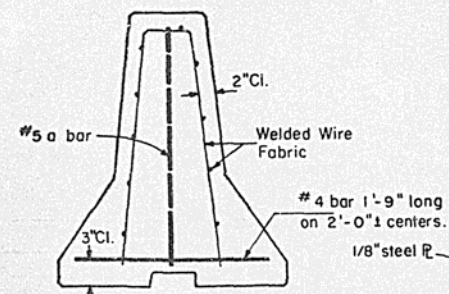


SECTION A-A
(Showing Alternate Welded Wire Reinforcement)

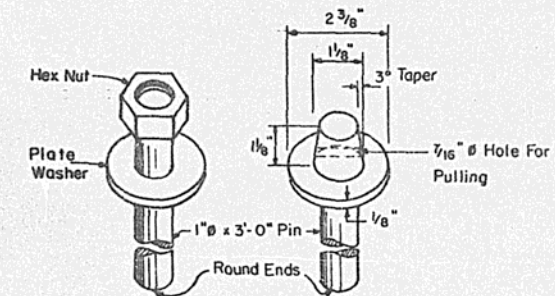


ALTERNATE DRIFT PINS

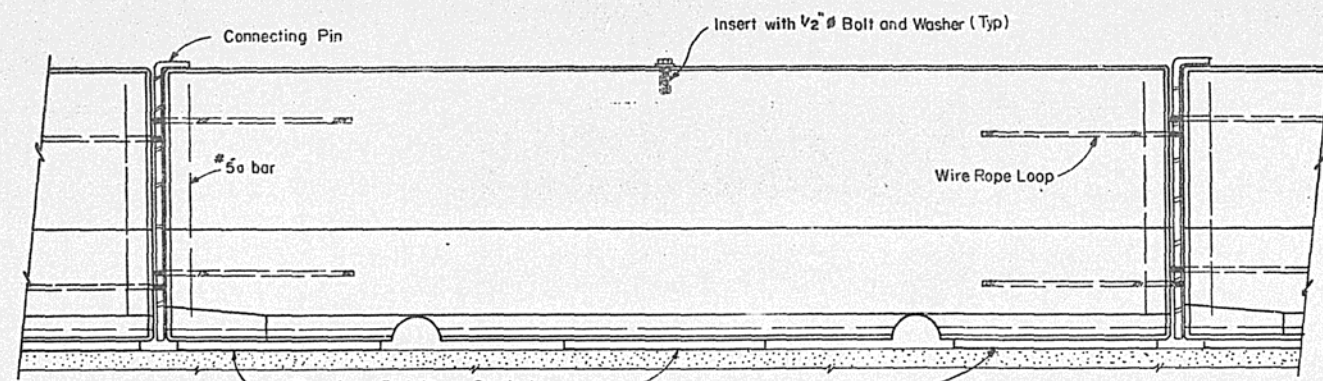

TYPICAL INSTALLATION WITH STYROFOAM PADS

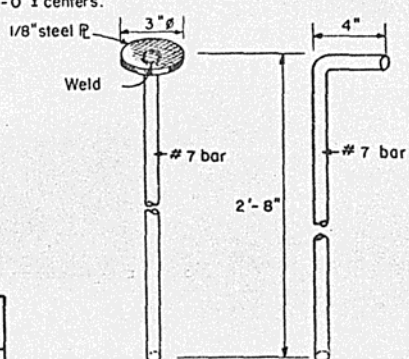

ALTERNATE CONNECTING PINS

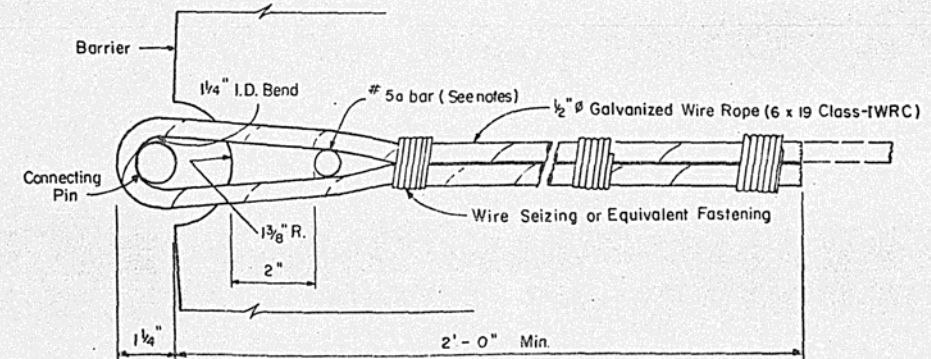

WIRE ROPE LOOP DETAIL
(20,000 lbs. min. breaking strength)

GENERAL NOTES

- Barrier units shall be pinned one to another in continuous smooth line at the exact locations provided by the Engineer.
- The wall units shall be reinforced with either bar reinforcement or welded wire fabric. Welded Wire Fabric shall be 6x6-W4xW4, weighing approximately 58lbs. per 100 sq.ft., conforming to the requirements of AASHTO M-55.
- Barrier units placed on rigid pavement or median surfaces shall be seated with styrofoam pads. Units placed on flexible pavement or shoulders shall be secured with dowel bars. Dowel bars shall be one inch in diameter, at least 12 inches long, shall be embedded at least 8 inches into base material, and shall not project above the outer surface of the barrier. After pin removal all holes in the base shall be grout filled.
- Alternate lifting devices meeting the approval of the Engineer may be substituted for the lifting slots shown.
- When the Terminal Section is used, the hex nut on the drift pin shall be threaded half way onto the pin and tack welded, or a coupling nut tightened sufficiently to prevent loosening may be used. Fill nut with grease to exclude contaminants.
- Inserts for 1/2 inch bolts shall be capable of 3000 lbs. pull out strength and shall be furnished with a galvanized bolt and washer.
- The #5 bar may be omitted if 2 continuous wire ropes are substituted for the 4 wire rope loops shown. The continuous ropes shall be looped and fastened on each end as shown in the wire rope loop detail.

Illinois Department of Transportation

PASSED: Feb 5, 1980
 Engineer of Design Operations

APPROVED: Feb 5, 1980
 Engineer of Design

ISSUED 6-18-79

TEMPORARY CONCRETE BARRIER

STANDARD 2383 - I

(Full Size) D.W.W. Sr.

Not to scale

F-7.05 d