


AS-BUILT PLANS FOR INFORMATION ONLY

STATE OF ILLINOIS
DEPARTMENT OF TRANSPORTATION

ROUTE NO.	SECTION	SUBJECT	TOTAL SHEETS	SHEET NO.	SHEET NO. 5 11 SHEETS
132	(C-X) BR	Edgar	53	38	

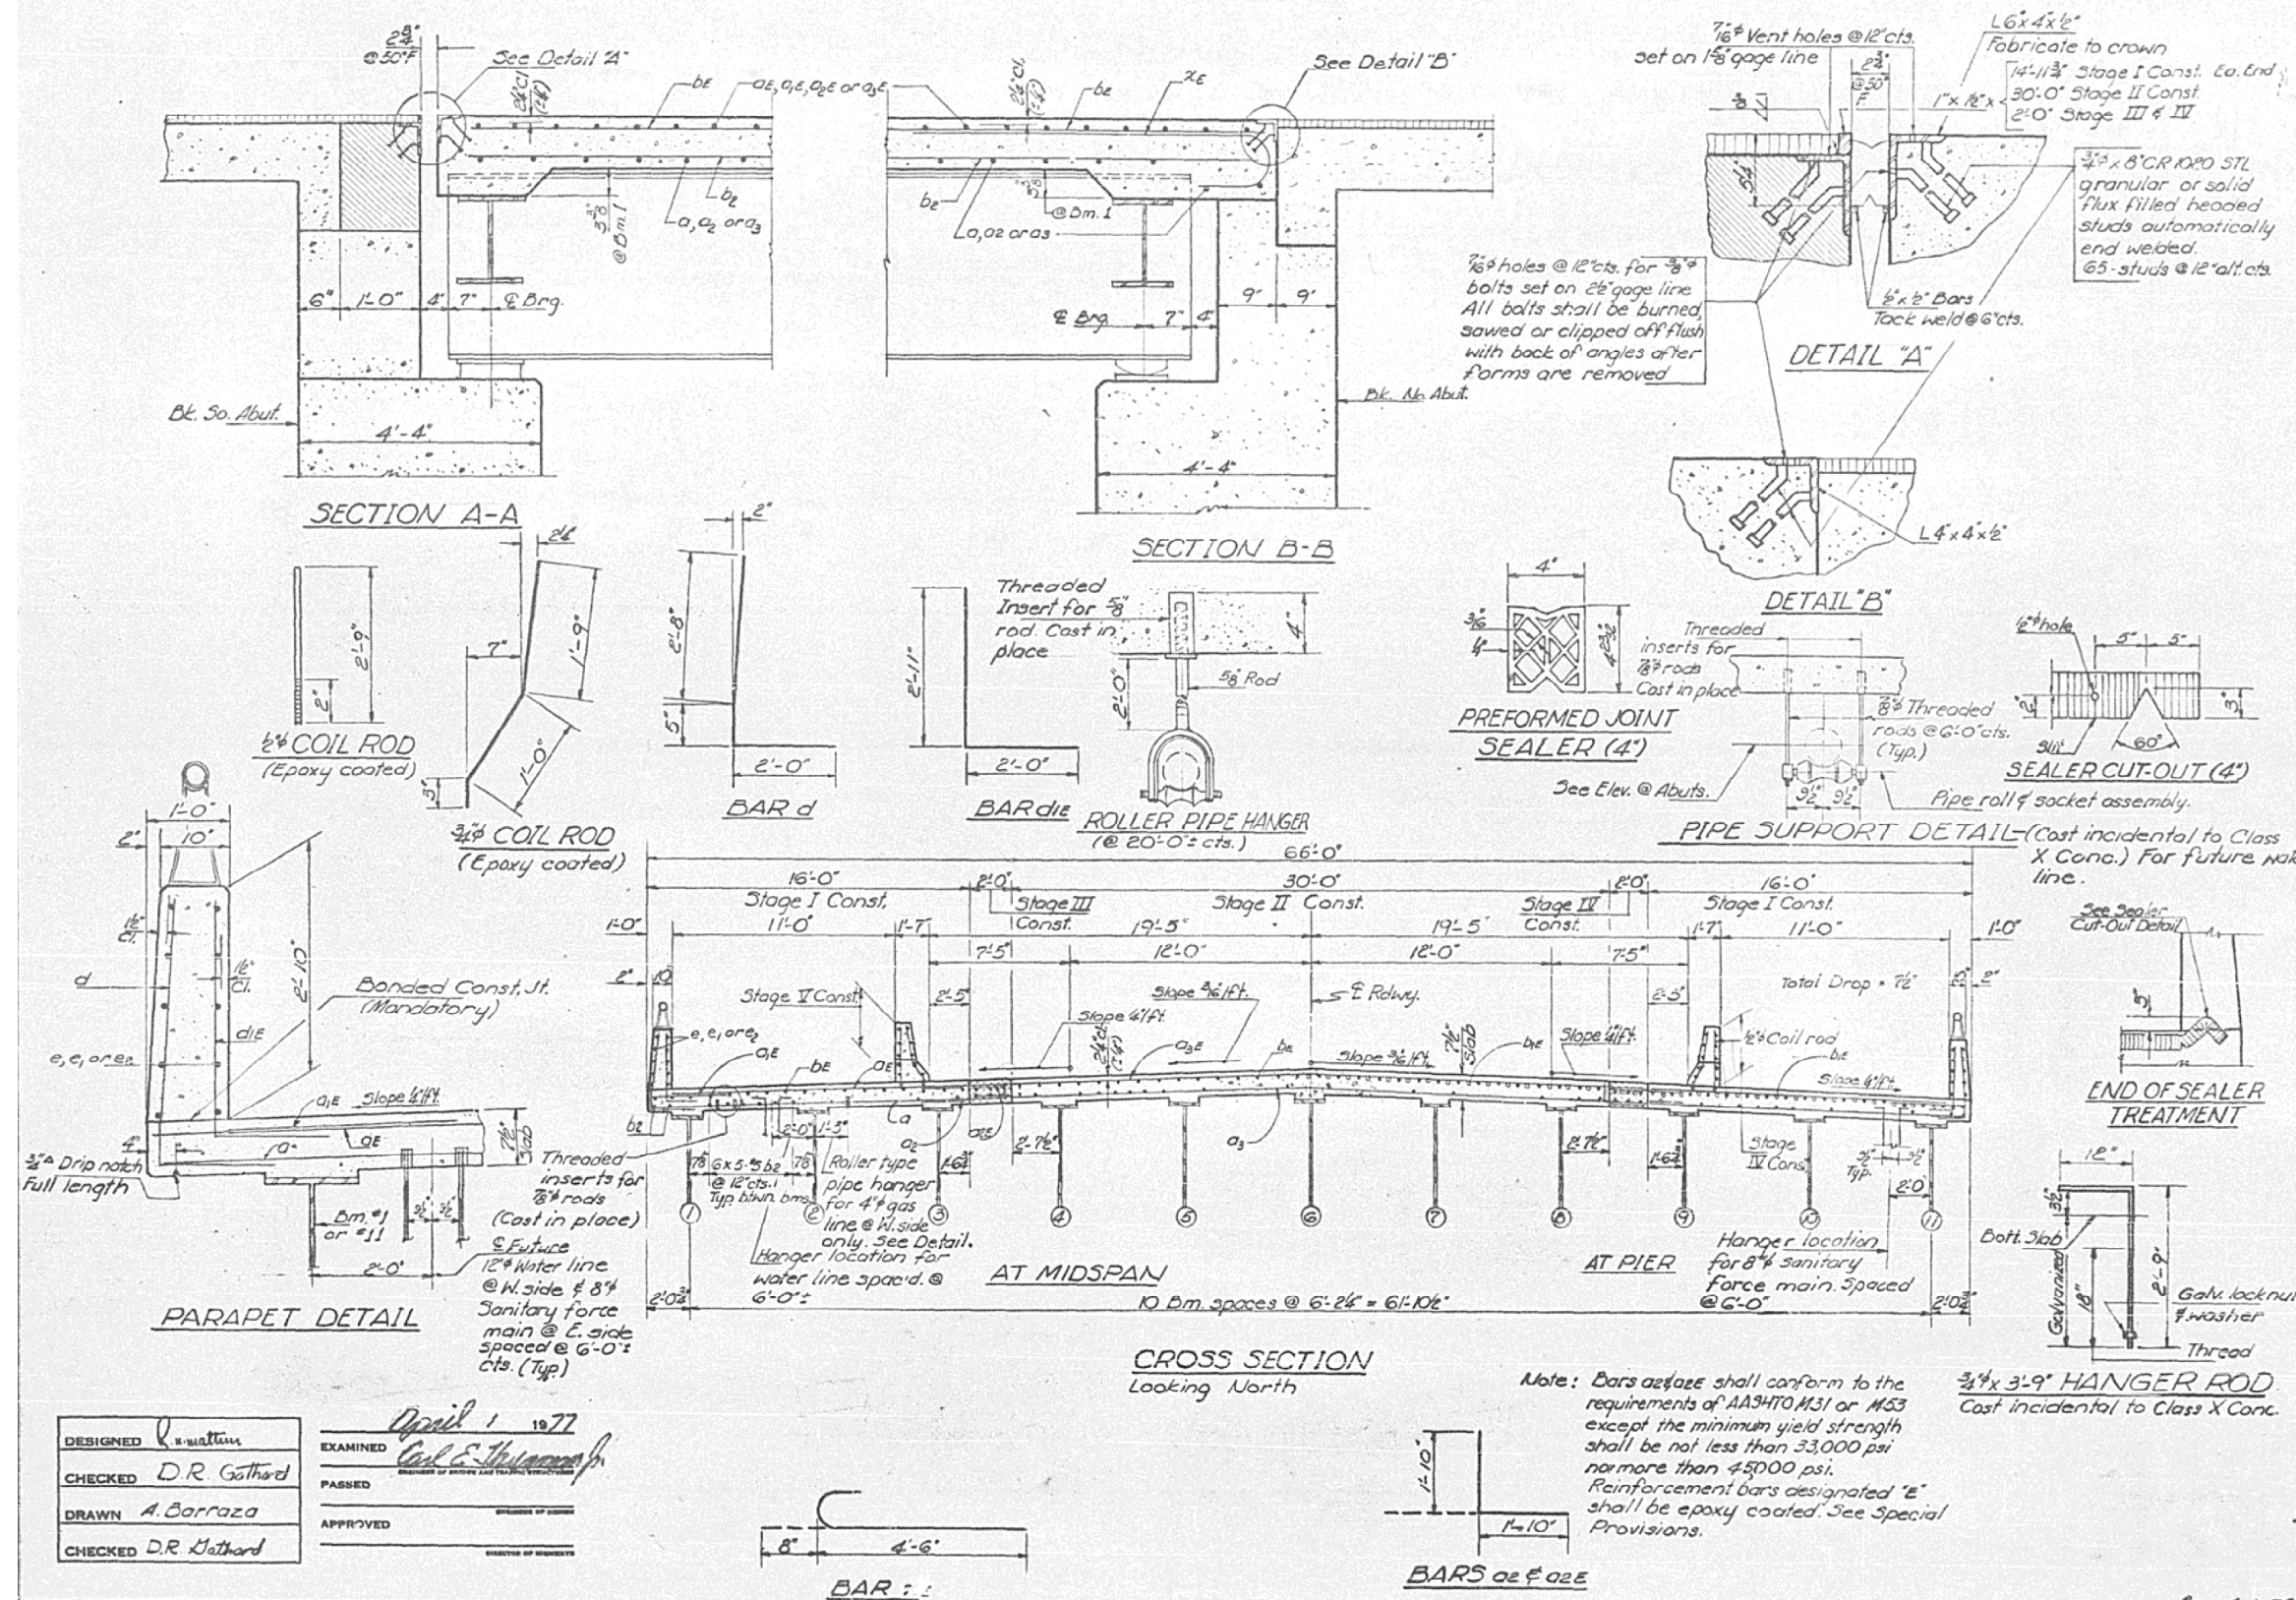

BILL OF MATERIAL STAGE I CONST.

Bar	No.	Size	Length	Shape
a	358	#5	15'-9"	—
a1	506	#5	15'-9"	—
a2	254	#8	4'-0"	—
a3	358	#5	3'-8"	—
a4	506	#5	3'-8"	—
b	136	#5	32'-9"	—
b1	32	#6	34'-4"	—
b2	150	#5	26'-6"	—
c	254	#4	5'-1"	—
c1	276	#5	4'-11"	—
c2	60	#4	17'-5"	—
c3	40	#4	9'-3"	—
c4	60	#4	17'-9"	—
c5	66	#6	5'-2"	—
d	254	#4	5'-1"	—
d1	276	#5	4'-11"	—
d2	60	#4	17'-5"	—
d3	40	#4	9'-3"	—
d4	60	#4	17'-9"	—
d5	66	#6	5'-2"	—
ze	136	#5	32'-9"	—
ze1	32	#6	34'-4"	—
ze2	150	#5	26'-6"	—
zc	254	#4	5'-1"	—
zc1	276	#5	4'-11"	—
zc2	60	#4	17'-5"	—
zc3	40	#4	9'-3"	—
zc4	60	#4	17'-9"	—
zc5	66	#6	5'-2"	—
ze	136	#5	32'-9"	—
ze1	32	#6	34'-4"	—
ze2	150	#5	26'-6"	—
zc	254	#4	5'-1"	—
zc1	276	#5	4'-11"	—
zc2	60	#4	17'-5"	—
zc3	40	#4	9'-3"	—
zc4	60	#4	17'-9"	—
zc5	66	#6	5'-2"	—

STAGE II CONST.

Bar	No.	Size	Length	Shape
a3	179	#5	33'-9"	—
a3e	253	#5	33'-9"	—
b1	124	#5	32'-9"	—
b1e	30	#6	34'-4"	—
b2	140	#5	26'-6"	—
ze	61	#6	5'-2"	—
c	254	#4	5'-1"	—
c1	276	#5	4'-11"	—
c2	60	#4	17'-5"	—
c3	40	#4	9'-3"	—
c4	60	#4	17'-9"	—
c5	66	#6	5'-2"	—

STAGE III, IV AND V CONST.

Bar	No.	Size	Length	Shape
b5	24	#5	32'-9"	—
b5e	4	#6	34'-4"	—
b2	30	#5	26'-6"	—
b3e	16	#5	27'-4"	—
b4	16	#8	27'-8"	—
b5e	8	#5	9'-3"	—
b6	8	#8	9'-3"	—
e	36	#4	17'-5"	—
e1	24	#4	9'-3"	—
e2	36	#4	17'-9"	—
ze	10	#6	5'-2"	—
c	254	#4	5'-1"	—
c1	276	#5	4'-11"	—
c2	60	#4	17'-5"	—
c3	40	#4	9'-3"	—
c4	60	#4	17'-9"	—
c5	66	#6	5'-2"	—

DESIGNED	R. Carroll	EXAMINED	April 1, 1977 Carl E. Thompson
CHECKED	D.R. Gothard	PASSED	
DRAWN	A. Barraza	APPROVED	
CHECKED	D.R. Gothard		

Note: Bars a2/a2e shall conform to the requirements of AA3470 M31 or M53 except the minimum yield strength shall be not less than 33,000 psi nor more than 45,000 psi. Reinforcement bars designated "E" shall be epoxy coated. See Special Provisions.

SUPERSTRUCTURE DETAILS
FA. RTE. 132 SEC. (C-X) BR
EDGAR COUNTY
STA. 911+2795