INDEX OF SHEETS

SHEET NO. DESCRIPTION

- COVER SHEET
- GENERAL NOTES AND INDEX OF SHEETS
- 3-4 SUMMARY OF QUANTITIES
- 5-8 SCHEDULE OF QUANTITIES
- TYPICAL SECTIONS 9-13
- 14-20 ALIGNMENT. TIES AND BENCHMARKS
- MAINTENANCE OF TRAFFIC GENERAL NOTES 21-22
- MAINTENANCE OF TRAFFIC UTILITY STAGING STAGE 1 23 24
- MAINTENANCE OF TRAFFIC UTILITY STAGING STAGE 2 25
- MAINTENANCE OF TRAFFIC UTILITY STAGING STAGE 3 MAINTENANCE OF TRAFFIC TYPICAL SECTIONS 26-29
- MAINTENANCE OF TRAFFIC PLANS STAGE 1 30-38
- 39-51 MAINTENANCE OF TRAFFIC PLANS - STAGE 2
- MAINTENANCE OF TRAFFIC PLANS STAGE 3 52-63
- 64-78 RÉMOVAL PLAN
- DESIGN PLAN AND PROFILE 79-93
- 94-108 DRAINAGE AND UTILITIES PLAN AND PROFILE
- 109-123 DRAINAGE PROFILE
- DRAINAGE SCHEDULE 124-129
- FROSION AND SEDIMENT CONTROL 130-137
- 138-152 PROPOSED AND EXISTING FLEVATIONS
- 153-157 PAVEMENT MARKING PLAN
- SIGN LEGEND
- 159-165 SIGNING PLAN
- LANDSCAPE PLANTING NOTES 166
- 167-181 LANDSCAPING PLAN
- LANDSCAPE SCHEDULE AND DETAILS 182 183-193 LANDSCAPE DETAILS
- 194-220 TRAFFIC SIGNAL PLANS
- ELECTRICAL NOTES, LEGEND AND ELECTRICAL LOAD SCHEDULE 221
- 222-223 VOLTAGE DROP CALCULATION FOR CABINETS
- WIRING DIAGRAM FOR RECEPTACLE CABINET FOR ONE RECEPTACLE 224
- 225 WIRING DIAGRAM FOR RECEPTACLE CABINET FOR TWO RECEPTACLES WIRING DIAGRAM FOR RECEPTACLE CABINET FOR THREE RECEPTACLES 226
- 227-242 LIGHTING INSTALLATION AND REMOVAL PLAN
- 243-245 ELECTRICAL CABINET SINGLE LINE DIAGRAM AND LEGEND

000001-05 STANDARD SYMBOLS, ABBREVIATIONS AND PATTERNS

COMBINATION CONCRETE CURB AND GUTTER

URBAN LANE CLOSURE, 2L, 2W, UNDIVIDED

URBAN LANE CLOSURE, MULTILANE, 2W WITH

URBAN LANE CLOSURE, MULTILANE INTERSECTION

LANE CLOSURE MULTILANE 1W OR 2W CROSSWALK

ISER NAME = IDOT

OT SCALE = 20.0000 '/ IN

OT DATE = 4/2/2010

URBAN LANE CLOSURE, 2L, 2W, WITH

BIDIRECTIONAL LEFT TURN LANE

BIDIRECTIONAL LEFT TURN LANE

OR SIDEWALK CLOSURE

TRAFFIC CONTROL DEVICES

TEMPORARY CONCRETE BARRIER

SIGN PANEL MOUNTING DETAILS

SIGN PANEL ERECTION DETAILS

720016-02 MAST ARM MOUNTED STREET NAME SIGNS

TYPICAL PAVEMENT MARKINGS

- LIGHTING POLE, WIRING IN TRENCH, SPLICING ELECTRICAL CABLES 246
- AND HANDHOLE DETAILS 247 AUSTIN CABINET WIRING DIAGRAM-EXISTING
- 248 AUSTIN CABINET WIRING DIAGRAM-REMOVAL
- AUSTIN CABINET WIRING DIAGRAM-PROPOSED
- 250-258 PROJECT SPECIFIC DETAILS
- 259-274 DISTRICT 1 DETAILS

HIGHWAY STANDARDS

606001-04

701501-05

701502-03

701602-04

701701-06

701801-04

704001-06

720001-01

720006-02

780001-02

814001-01

ILE NAME =

IRTE38-sht-gennoteØ1.dg

424001-05 CURB RAMPS FOR SIDEWALKS

CONCRETE CURB TYPE B AND

604001-03 FRAME AND LIDS TYPE 1

HANDHOLES

GENERAL NOTES

- THE LOCATION OF DRAINAGE STRUCTURES, STORM SEWERS, WATER MAINS, SANITARY SEWERS, AND OTHER PUBLIC OR PRIVATE UTILITIES AS SHOWN ON THE PLANS IS APPROXIMATE AND THEIR EXACT LOCATION IS TO BE DETERMINED IN THE FIELD BY THE CONTRACTOR. THIS WORK SHALL BE CONSIDERED INCLUDED IN THE COST OF MOBILIZATION UNIT BID PRICE OF THE CONTRACT, AND NO ADDITIONAL COMPENSATION WILL BE ALLOWED.
- 2. ALL AREAS DISTURBED DURING CONSTRUCTION OPERATIONS AND NOT PART OF THE WORK AS SHOWN HEREON SHALL BE RESTORED TO ORIGINAL CONDITION TO THE SATISFACTION OF THE ENGINEER AT NO ADDITIONAL COMPENSATION TO THE CONTRACTOR. IT IS INCUMBENT UPON THE CONTRACTOR TO SHOW THAT DAMAGED AREAS WERE NOT DISTURBED BY CONSTRUCTION OPERATIONS.
- 3. THESE DRAWINGS ASSUME THAT THE CONTRACTOR WILL UTILIZE AN ELECTRONIC DRAWING FILE AND STAKE ALL SITE IMPROVEMENTS USING COORDINATES TIED INTO THE PROVIDED CONTROL POINTS. THE DIMENSIONS INDICATED ON THE DRAWINGS ARE FOR THE CONVENIENCE OF THE CONTRACTOR ONLY.
- 4. THE CONTRACTOR SHALL TAKE ALL NECESSARY SAFETY PRECAUTIONS TO PROTECT ABUTTING PROPERTY, UTILITIES, PEDESTRIANS, AND VEHICULAR
- 5. THE CONTRACTOR IS RESPONSIBLE FOR ADJUSTING ALL EXISTING UTILITIES AND STRUCTURES AS NECESSARY TO THE FINAL PROPOSED SURFACE PROFILE GRADES. CONTRACTOR SHALL OBTAIN ALL PERMITS NECESSARY FOR ADJUSTING EXISTING UTILITIES AND STRUCTURES AND ALL COORDINATION WITH CITY AND/OR VILLAGE DEPARTMENTS AND UTILITY OWNERS.
- 6. CONTRACTOR IS RESPONSIBLE FOR REMOVAL, STORAGE, AND RE-INSTALLATION OF ALL EXISTING SIGNAGE, BENCHES, SIDEWALK RAILINGS, AND OTHER ITEMS THAT ARE IMPACTED BY THIS CONTRACT AND ARE NOT SHOWN AS BEING REPLACED. THE CONTRACTOR IS RESPONSIBLE FOR REPLACING ANY OF THESE ITEMS THAT ARE DAMAGED AS A RESULT OF THIS CONTRACT FOR NO ADDITIONAL COST. THE REMOVAL AND RE-INSTALLATION OF THESE ITEMS IS NOT QUANTIFIED SEPARATELY AND ARE INCLUDED IN THE COST OF MOBILIZATION.

DETAIL OF STORM SEWER CONNECTION TO EXISTING SEWER

DETAIL FOR FRAMES AND LIDS ADJUSTMENT WITH MILLING

LIGHT POLE FOUNDATION 30' (9.144 m) TO 35' (10.668 m)

TRAFFIC CONTROL AND PROTECTION FOR SIDE ROADS.

TYPICAL APPLICATIONS RAISED REFLECTIVE PAVEMENT

PAVEMENT PATCHING FOR HMA SURFACED PAVEMENT

HMA TAPER AT EDGE OF P.C.C. PAVEMENT

7. THE CONTRACTOR SHALL MAINTAIN SURFACE DRAINAGE OF THE ROAD DURING CONSTRUCTION.

DISTRICT 1 STANDARD DETAILS

DROP MANHOLE DETAILS

FIRE HYDRANT TO BE MOVED

LIGHT CONTROLLER SINGLE DOOR

LIGHT POLE FOUNDATION, METAL

INTERSECTIONS, AND DRIVEWAYS

MARKERS (SNOW-PLOW RESISTANT)

ARTERIAL ROAD INFORMATION SIGN

04/02/2010 1

DISTRICT ONE TYPICAL PAVEMENT MARKINGS

PAVEMENT MARKING LETTERS AND SYMBOLS FOR

M.H. 11 1/2" (292 mm) BOLT CIRCLE

MISC. ELECTRICAL DETAILS SHEET A

BD400-05 (BD-32) BUTT JOINT AND HMA TAPER DETAILS

TRAFFIC STAGING

REVISED

REVISED

REVISED

REVISED

BD500-01 (BD-7)

BD600-03 (BD-8)

BD600-05 (BD-16)

BD400-04 (BD-22)

BD400-06 (BD-33)

BD-36

BE215

BE300

BE305

BE702

TC-10

TC-11

TC-13

TC-16

TC-22

DESIGNED - TM

JB

DRAWN

DATE

CHECKED

- 8. THE CONTRACTOR SHALL NOTIFY ALL UTILITY COMPANIES FOR FIELD LOCATIONS OF THEIR FACILITIES PRIOR TO BEGINNING CONSTRUCTION. THE CONTRACTOR WILL BE RESPONSIBLE FOR THE MAINTENANCE AND PRESERVATION OF THESE FACILITIES. ALL UTILITY LOCATIONS SHOWN MUST BE VERIFIED BY THE CONTRACTOR IN THE FIELD.
- 9. CARE MUST BE TAKEN FOR ANY EARTH EXCAVATION NEAR EXISTING TREES SO THAT DAMAGE TO THE TREE ROOTS DOES NOT OCCUR.
- 10. WHEN CONCRETE REMOVAL IS REQUIRED, IT MUST BE ACCOMPLISHED BY SAWCUT, SLEDGES, AND PNEUMATIC HAND TOOLS, EQUIPMENT AND METHODS USED MUST BE SUCH AS TO PREVENT CRACKING, SHATTERING OR SPALLING OF CONCRETE THAT IS TO REMAIN.
- 11. ACCESS MUST BE MAINTAINED TO ALL EXISTING PROPERTIES DURING CONSTRUCTION PER ARTICLE 107.09 UNLESS ARRANGEMENTS ARE MADE IN WRITING BY THE CONTRACTOR WITH THE PROPERTY OWNERS WITH A COPY TO THE ENGINEER FOR SHORT TERM CLOSURES.
- 12. IF THE CONTRACTOR CAUSES DEBRIS TO ENTER THE EXISTING SEWERS, THAT ENTIRE SECTION OF SEWER BETWEEN MANHOLES MUST AT ONCE BE THOROUGHLY CLEANED AND RODDED BY THE CONTRACTOR AT NO ADDITIONAL COST TO THE CONTRACT. ALL SEWER AND WATER STRUCTURES SO CONTAMINATED MUST AT ONCE BE THOROUGHLY CLEANED BY THE CONTRACTOR AT NO ADDITIONAL COST TO THE CONTRACT.
- 13. IN LOCATIONS WHERE THE MAIN STORM SEWER IS NOT BEING REPLACED AND THE EXISTING DRAINAGE FACILITIES ARE DISTURBED OR DAMAGED DURING CONSTRUCTION BY THE CONTRACTOR, THE CONTRACTOR MUST RESTORE AND REPLACE THE DAMAGE AT HIS/HER EXPENSE TO THE SATISFACTION OF THE ENGINEER. THE STORM SEWER FLOW MUST BE MAINTAINED AT ALL TIMES.
- 14. ALL HMA PAVEMENT SURFACE COURSES, CONCRETE BASE COURSES, CONCRETE PAVEMENTS, CURBS, GUTTERS AND SIDEWALKS WHICH ARE TO BE REMOVED MUST BE SAW CUT AT THE LIMITS OF REMOVAL. SAW CUTTING SHALL BE INCLUDED WITHIN THE REMOVAL PAY ITEM FOR WHICH THE SAW CUTTING IS BEING PROVIDED.
- 15. CONTRACTOR MUST SAWCUT AND HAND BREAK FOR SIDEWALK REMOVAL AT THE R.O.W/ BUILDING LINE TO AVOID DAMAGE TO ADJACENT PROPERTIES. SAW CUTTING SHALL BE INCLUDED WITHIN THE REMOVAL PAY ITEM FOR WHICH THE SAW CUTTING IS BEING PROVIDED.
- 16. WHEN PLACING CONCRETE ADJACENT TO PRIVATE PROPERTY, THE CONTRACTOR MUST PROTECT PROPERTY (VISQUEEN, ETC.) TO AVOID CONCRETE SPLATTER AND/OR DAMAGE.
- 17. THE CONTRACTOR SHALL CONTACT THE DISTRICT ONE TRAFFIC CONTROL SUPERVISOR AT (847) 705-4470 A MINIMUM OF 72 HOURS IN ADVANCE OF BEGINING OF WORK FOR LOCATIONS OF UDERGROUND TRAFFIC SIGNAL LINES AND INTERCONNECT CABLES AND (847) 221-3078 TO LOCATE UNDERGROUND LIGHTING CABLE.
- 18. THE CONTRACTOR SHALL ADVISE THE POLICE AND FIRE DEPARTMENTS DAILY AS TO WHAT STREETS, IF ANY, ARE TO BE CLOSED OR PARTIALLY BLOCKED SO THAT THEY CAN EFFICIENTLY ROUTE THEIR EMERGENCY VEHICLES.

	POLICE DEPARTMENT TELEPHONE NO.	FIRE DEPARTMENT TELEPHONE NO.
VILLAGE OF OAK PARK	(708) 386-3800	(708) 445-3300
CITY OF BERWYN	(708) 795-5600 EXT. 3100	(708) 788-2660 EXT. 3280
TOWN OF CICERO	(708) 652-2130	(708) 652-0174

- 19. THE RESIDENT ENGINEER SHALL CONTACT MS. PATRICE HARRIS, AREA TRAFFIC FIELD TECHNICIAN, AT 708-597-9800 A MINIMUM OF 2 WEEKS PRIOR TO PLACEMENT OF FINAL PAVEMENT MARKINGS.
- . 20. THE GENERAL CONTRACTOR IS REQUIRED TO HIRE AN ENVIRONMENTAL FIRM WITH AT LEAST FIVE (5) DOCUMENTED LEAKING UNDERGROUND STORAGE TANK (LUST) CLEANUPS OR THAT IS PRE-QUALIFIED IN HAZARDOUS WASTE BY THE DEPARTMENT TO REMEDIATE THE SOIL CONTAMINATION AND MONITOR FOR WORKER PROTECTION.

MWRD GENERAL NOTES

- 1. THE MWRD LOCAL SEWER SYSTEMS SECTION FIELD OFFICE MUST BE NOTIFIED AT LEAST TWO (2) WORKING DAYS PRIOR TO THE COMMENCEMENT OF ANY WORK (CALL 708-588-4055).
- 2. ELEVATIONS ARE BASED ON VILLAGE OF OAK PARK DATUM, VILLAGE OF OAK PARK DATUM IS BASED ON CITY OF CHICAGO ELEVATION DATUM WHERE A FACTOR OF 579.48 CAN BE ADDED TO THE ELEVATIONS TO ACHIEVE NGVD 1929 ELEVATIONS.
- 3. NO FLOOR DRAINS EXCEPT AS NOTED.
- 4. NO FOOTING DRAINS AND DOWNSPOUTS.
- 5. ALL SANITARY PIPE MATERIALS AND JOINTS (AND STORM SEWER PIPE MATERIALS AND JOINTS IN A COMBINED SEWER AREA) SHALL CONFORM TO: WATER MAIN QUALITY PVC SDR 26 8" TO 12" DIAMETER PRESSURE PIPE AND EARRICATED FITTINGS IN ACCORDANCE WITH ASTM D 2241, PVC MATERIAL SHALL CONFORM TO NSF STANDARD 14 AND BE DESIGNATED CLASS 12454 C (PVC 1120) IN CONFORMANCE WITH ASTM D 1784. THE SDR RATING SHALL BE LIMITED TO A MINIMUM PRESSURE RATING OF 160 PSI OR GREATER AT 23°C (73.4°F).

ELASTOMERIC SEALS (GASKETS) USED FOR PUSH-ON JOINTS SHALL COMPLY WITH ASTM STANDARD F477 AND SHALL BE PRESSURE RATED IN ACCORDANCE WITH ASTM D3139.

- 6. ALL SANITARY SEWER CONSTRUCTION (AND STORM SEWER CONSTRUCTION IN COMBINED SEWER AREAS), REQUIRES STONE BEDDING WITH STONE 1/4" TO 1" IN SIZE, WITH MINIMUM BEDDING THICKNESS EQUAL TO 1/4 THE OUTSIDE DIAMETER OF THE SEWER PIPE, BUT NOT LESS THAN FOUR (4) INCHES NOR MORE THAN EIGHT (8) INCHES. MATERIAL SHALL BE CA-11 OR CA-13 AND SHALL BE EXTENDED AT LEAST 12" ABOVE THE TOP OF THE PIPE WHEN USING PVC.
- 7. "BAND SEAL" OR SIMILAR FLEXIBLE-TYPE COUPLINGS SHALL BE USED IN THE CONNECTION OF SEWER PIPES OF DISSIMILAR MATERIALS.
- 8. WHEN CONNECTING TO AN EXISTING SEWER MAIN BY MEANS OTHER THAN AN EXISTING WYE, TEE, OR AN EXISTING MANHOLE, ONE OF THE FOLLOWING METHODS SHALL BE USED:
 - 1. CIRCULAR SAW-CUT OF SEWER MAIN BY PROPER TOOLS ("SHEWER-TAP" OR SIMILAR) AND PROPER INSTALLATION OF HUB-WYF SADDLE OR HUB-TEE SADDLE.
 - REMOVE AN ENTIRE SRCTION OF PIE (BREAKING ONLY THR TOP OF ONE BELL) AND REPLACE WITH A WYE OR TEE BRANCH
 - WITH PIPE CUTTER, NEATLY AND ACCURATELY CUT OOT DESIRED LENGTH OF PIPE FOR INSERTION OF PROPER FITTING, USING "BAND SEAL" OR SIMILAR COUPLINGS TO HOLD IT FIRMLY IN PLACE.
- 9. WHENEVER A SANITARY/COMBINED SEWER CROSSES UNDER A WATERMAIN, THE MINIMUM VERTICAL DISTANCE FROM THE TOP OF THE SEWER TO THE BOTTOM OF THE WATERMAIN SHALL BE 18 INCHES, FURTHEREMORE, A MINIMUM HORIZONTAL DISTANCE OF 10 FEET BETWEEN SANITARY/COMBINED SEWERS AND WATERMAINS SHALL BE MAINTAINED UNLESS: THE SEWER IS LAID IN A SEPARATE TRENCH, KEEPING A MINIMUM 18" VERTICAL SEPARATION; OR THE SEWER IS LAID IN THE SAME TRENCH WITH THE WATERMAIN LOCATED AT THE OPPOSITE SIDE ON A BENCH OF UNDISTURBED EARTH, KEEPING A MINIMUM 18" VERTICAL SEPARATION. IF EITHER THE VERTICAL OR HORIZONTAL DISTANCES DESCRIBED ABOVE CAN NOT BE MAINTAINED, OR THE SEWER CROSSES ABOVE THE WATERMAIN, THE SEWER SHALL BE CONSTRUCTED TO WATERMAIN STANDARDS.
- 10. ALL SANITARY MANHOLES, (AND STORM MANHOLES IN COMBINED SEWER AREAS), SHALL HAVE A MINIMUM INSIDE DIAMETER OF 48 INCHES, AND SHALL BE CAST IN PLACE OR PRE-CAST REINFORCED CONCRETE.
- 11. ALL CONNECTIONS TO MANHOLES AND CATCH BASINS SHALL INCORPORATE A RUBBER BOOT CONNECTION CONFOTMING TO ASTM C-923.
- 12. MANHOLE, TYPE A AND CATCH BASIN, TYPE A SHALL CONFORM TO THE PROJECT SPECIFIC DETAILS, A "DOGHOUSE MANHOLE" SHALL BE USED FOR MANHOLE, TYPE A 5' DIAMETER FOR THOSE MANHOLES INSTALLED ON EXISTING LIVE SEWERS HAVING A 15" DIAMETER OR GREATER.

TERRA 225 W. OHIO ST., FOURTH FL CHICAGO, IL 60654 (312)467-0123

STATE OF ILLINOIS **DEPARTMENT OF TRANSPORTATION**

İ	GENERAL NOTES	F.A.P. RTE.	SECTION	TOTAL	SHEET NO.	
l	AND INDEX OF SHEETS	347	09-00248-00-RS	COOK	274	2
l	AND INDEX OF SHELTS			CONTRACT	NO. 6	3432
1	SCALE: 1" = 20' SHEET NO. OF SHEETS STA. TO STA.		ILLINOIS FED. AI	D PROJECT		

PAY ITEM CODE	The second secon				LANDSCAPING (80/20)	LIGHTING (80/20)	LIGHTING (50/50)	ROADWAY	TRAFFIC SIGNALS		1	1	1
NO.	SI SP F	PAY ITEM DESCRIPTION	UNIT	TOTAL	Y003	YO30-1E	YO30-1E	1000	Y031-1F	Y007	LANDSCAPING	G ROADWAY	LIGHTIN
20100110	TREE REMOVAL (6 TO 15 UNITS DIAMETER)		UNIT	40	40								
20101000	TEMPORARY FENCE		FOOT	39	39								
20101200	TREE ROOT PRUNING		EACH	17	5				*****		12		
20101350	TREE PRUNING (OVER 10 INCH DIAMETER)		EACH	17	5						12	404	ļ
20800150	TRENCH BACKFILL		CUYD	3,694	2808			762			0500	124	
21101615	TOPSOIL FURNISH AND PLACE, 4"		SQ YD	2,586							2586		
21101810	COMPOST FURNISH AND PLACE, 3"		SQ YD	456	351						105 2.40		
25000400	NITROGEN FERTILIZER NUTRIENT		POUND	12	9.60					<u> </u>	0.80		
25000500	PHOPHORUS FERTILIZER NUTRIENT		POUND	4	3.20						1.70		
25000600	POTASSIUM FERILIZER NUTRIENT	,	POUND	8 0.746	6.30						2716		
25200110	SODDING, SALT TOLERANT		SQ YD	2,716	12.79						3.55		
25400100	PERENNIAL PLANTS		UNIT	16		ļ					3.00		
28000400	PERIMETER EROSION BARRIER		FOOT	117	117 65						68		
28000510	INLET FILTERS FILTER FABRIC		EACH SQ YD	133 1,742	1633						109		
28200200 31101000	SUB-BASE GRANULAR MATERIAL, TYPE B		TON	10,643	6671			2854			792	326	
35200600	EARTH EXCAVATION		CUYD	9,490	6356.0			2353			490.0	291	
35300500	P.C.C. BASE COURSE 10"		SQYD	1,138	775		†	363					
35400500	PORTLAND CEMENT CONCRETE BASE COURSE WIDEN	NING 10"	SQYD	82	82								
40300200	BITUMINOUS MATERIALS (PRIME COAT)		TON	90.2				84.90				5.30	
40600300	AGGREGATE (PRIME COAT)		TON	111				104.00				7.00	
40600525	LEVELING BINDER (HAND METHOD), N50		TON	60				60.00					
40600895	CONSTRUCTING TEST STRIP		EACH	2				2					
40600982	HOT-MIX ASPHALT SURFACE REMOVAL - BUTT JOINT		↑ SQ YD	4,326				3,654				672	
40600990	TEMPORARY RAMP		(- sq yp					-3020					
40603240	POLYMERIZED HOT-MIX ASPHALT BINDER COURSE, IL-	-19.0, N90	TON	6,164				5797.20				366.30	
40603595	POLYMERIZED HOT-MIX ASPHALT SURFACE COURSE, I		TON	4,315				4058.50				256.80	ļ
42001300	PROTECTIVE COAT		SQ YD	21,429	18148.0							3280.7	ļ
42300400	PORTLAND CEMENT CONCRETE DRIVEWAY PAVEMEN	T, 8 INCH	SQ YD	1,249	1249								
42400430	* PCC SIDEWALK 5 INCH, SPECIAL		SQFT	131,570	110631							20939	
42400800	DETECTABLE WARNINGS		SQFT	1,028	1028								-
44000100	PAVEMENT REMOVAL		SQ YD	5,779	4797		12.	363				619	
44000198	* HOT-MIX ASPHALT SURFACE REMOVAL, VARIABLE DEI	PTH	SQ YD	41,766				39777		-		1989	
44000200	DRIVEWAY PAVEMENT REMOVAL		SQ YD	1,289	1281							8	
44000500	COMBINATION CURB AND GUTTER REMOVAL		FOOT	17,385	3814			12011				1560	
44000600	SIDEWALK REMOVAL		SQFT	106,149	91411							14738	<u> </u>
44002000	* CONCRETE CURB REMOVAL		FOOT	45	11							34	
44201325	CLASS C PATCHES, TYPE I, 8 INCH		SQ YD	7								11	
44201329	CLASS C PATCHES, TYPE II, 8 INCH		SQ YD	11								11	
44201737	CLASS D PATCHES TYPE I, 8 INCH		SQ YD	4	4			ļ					
44201741	CLASS D PATCHES TYPE II, 8 INCH		SQ YD	44	38							6	_
44201745	CLASS D PATCHES TYPE III, 8 INCH		SQYD	237	237	<u> </u>		 	***************************************			46	
44201747	CLASS D PATCHES TYPE IV, 8 INCH		SQ YD	577	531			43074				40	
44300100	AREA REFLECTIVE CRACK CONTROL TREATMENT		SQ YD	43,074	4142			43074				2089	
50800305	* WELDED WIRE FABRIC 6X6		SQ YD FOOT	6,231 14357.00	4142			 		14357.00		2000	
55039700 56400100	* STORM SEWERS TO BE CLEANED FIRE HYDRANTS TO BE MOVED		EACH	14337.00	1					1,000.00			†
	* DOMESTIC WATER SERVICE BOXES TO BE ADJUSTED		EACH	172	158			8				6	†
56500600	PIPE UNDERDRAINS 4"		FOOT	959	828						131		
60107600 60200105	CATCH BASINS, TYPE A, 4'-DIAMETER, TYPE 1 FRAME, (OPENTID	EACH	95	54		 	38			7,0,	3	
60218400	MANHOLES, TYPE A, 4' - DIAMETER, TYPE 1 FRAME, CLO		EACH	61	40			16				5	
60221100	MANHOLES, TYPE A, 5' DIAMETER, TYPE 1 FRAME CLOS		EACH	9	4			5					
60250200	CATCH BASINS TO BE ADJUSTED		EACH	80				55				25	
60500040	REMOVING MANHOLES		EACH	9	9								
60500050	REMOVING CATCH BASINS		EACH	15	15		1						
60600605	CONCRETE CURB, TYPE B		FOOT	200	200								
60611600	* COMBINATION CONCRETE CURB AND GUTTER, (SPECI	IAL)	FOOT	18,961				12297				1465	1
66900200	NON-SPECIAL WASTE DISPOSAL		ĊŪŶĠ	715	5199 457		1 1 1 1 1 1 1 1 1 1 1 1 1 1 1 1 1 1 1	165		1	93	1	
66900450	SPECIAL WASTE PLANS AND REPORT	The second secon	LSUM	1							1		
66900530	SOIL DISPOSAL ANALYSIS		EAGH	J. 1.5.	· · · · · · · · · · · · · · · · · · ·			1			Julian Ju	Julia	سيا
67000400	ENGINEER'S FIELD OFFICE, TYPE A		CAL MO					15					
67100100	MOBILIZATION		LSUM		0.61			0.29				0.10	
70101800	* TRAFFIC CONTROL AND PROTECTION, (SPECIAL)		L SUM					1.00					
70300220	TEMPORARY PAVEMENT MARKING - LINE 4"		FOOT	67,922				67922					
70300240	TEMPORARY PAVEMENT MARKING - LINE 6"		FOOT	7,579	7579		2 1	_					-
70300260	TEMPORARY PAVEMENT MARKING - LINE 12"		FOOT	1,519			<u> </u>	1519	-				-
70300280	TEMPORARY PAVEMENT MARKING - LINE 24"		FOOT	3,153				3153					
	X SIGN PANEL - TYPE 1		SQFT	256	256			1			-		
	X REMOVE SIGN PANEL ASSEMBLY - TYPE A		EACH	76	76						-		+
	X REMOVE SIGN PANEL - TYPE 1		SQFT	398	398	 		 					-
	X RELOCATE SIGN PANEL - TYPE 1	D CAMBO! C	SQFT	1,086	1086	 	 	1555				+	
	X THERMOPLASTIC PAVEMENT MARKING - LETTERS AND	U O IMBULO	SQFT	1,555 14,304				14304					
	X THERMOPLASTIC PAVEMENT MARKING - LINE 4"		FOOT		3472	-		1910					
	X THERMOPLASTIC PAVEMENT MARKING - LINE 6"		FOOT FOOT	5,382 298	3412			298				-	
	X THERMOPLASTIC PAVEMENT MARKING - LINE 12"	· · · · · · · · · · · · · · · · · · ·			_			925			1	-	+
	X THERMOPLASTIC PAVEMENT MARKING - LINE 24"		FOOT	925			<u> </u>	923 402				·	-
	X RAISED REFLECTIVE PAVEMENT MARKER		EACH	402 402				402				-	-
78300200	X RAISED REFLECTIVE PAVEMENT MARKER REMOVAL		EACH	1 402	L			1 402	L				
2	USER NAME = IDOT DESIGNED - BB	REVISED - 04/02/2010 1								F.A.P. RTE.	SECTION	CO	UNTY SH
nt-\$0001.dgn	DRAWN - TM	REVISED -	STATE OF ILL	INOIS			SUMMARY	OF QUANT	ITIES	347	09-00248-00		00K 2
	PLOT SCALE = 20.0000 '/ IN. CHECKED - JB	REVISED -	DEPARTMENT OF TRA		TION		2 7						NTRACT N
		REVISED -					ET NO. OF	SHEETS STA	A. TO ST	ra —		OIS FED. AID PROJ	

Ź ∐ U	ENGINEERIN

1000800	DHOLE TO BE ADJUSTED VY-DUTY HANDHOLE TO BE ADJUSTED TOUCT, 600V, 2-1C NO. 10, 1/C NO. 10 GROUND, (EPR-TYPE RHW), 3/4" DIA. POLYETHYLENE DUCT, 600V, 2-1C NO. 4, 1/C NO. 6 GROUND, (EPR-TYPE RHW), 1" DIA. POLYETHYLENE DUCT, 600V, 3-1C NO. 2, 1/C NO. 6 GROUND, (EPR-TYPE RHW), 1 1/4" DIA. POLYETHYLENE DUCT, 600V, 3-1C NO. 2, 1/C NO. 6 GROUND, (EPR-TYPE RHW), 1 1/4" DIA. POLYETHYLENE DUCT, 600V, 3-1C NO. 4, 1/C NO. 6 GROUND, (EPR-TYPE RHW), 1 1/4" DIA. POLYETHYLENE TUCT, 600V, 3-1C NO. 4, 1/C NO. 6 GROUND, (EPR-TYPE RHW), 1 1/4" DIA. POLYETHYLENE TUCT, 600V, 3-1C NO. 6 GROUND, (EPR-TYPE RHW), 1 1/4" DIA. POLYETHYLENE TUCT, 600V, 3-1C NO. 6 GROUND, (EPR-TYPE RHW), 1 1/4" DIA. POLYETHYLENE TUCT, 600V, 3-1C NO. 6 GROUND, (EPR-TYPE RHW), 1 1/4" DIA. POLYETHYLENE TUCT, 600V, 3-1C NO. 6 GROUND, (EPR-TYPE RHW), 1 1/4" DIA. POLYETHYLENE TUCT, 600V, 3-1C NO. 6 GROUND, (EPR-TYPE RHW), 1 1/4" DIA. POLYETHYLENE TUCT, 600V, 3-1C NO. 6 GROUND, (EPR-TYPE RHW), 1 1/4" DIA. POLYETHYLENE TUCT, 600V, 3-1C NO. 6 GROUND, (EPR-TYPE RHW), 1 1/4" DIA. POLYETHYLENE TUCT, 600V, 3-1C NO. 6 GROUND, (EPR-TYPE RHW), 1 1/4" DIA. POLYETHYLENE TUCT, 600V, 3-1C NO. 6 GROUND, (EPR-TYPE RHW), 1 1/4" DIA. POLYETHYLENE TUCT, 600V, 3-1C NO. 6 GROUND, (EPR-TYPE RHW), 1 1/4" DIA. POLYETHYLENE TUCT, 600V, 3-1C NO. 6 GROUND, (EPR-TYPE RHW), 1 1/4" DIA. POLYETHYLENE TUCT, 600V, 3-1C NO. 6 GROUND, (EPR-TYPE RHW), 1 1/4" DIA. POLYETHYLENE TUCT, 600V, 3-1C NO. 6 GROUND, (EPR-TYPE RHW), 1 1/4" DIA. POLYETHYLENE TUCT, 600V, 3-1C NO. 6 GROUND, (EPR-TYPE RHW), 1 1/4" DIA. POLYETHYLENE TUCT, 600V, 3-1C NO. 6 GROUND, (EPR-TYPE RHW), 1 1/4" DIA. POLYETHYLENE TUCT, 600V, 3-1C NO. 6 GROUND, (EPR-TYPE RHW), 1 1/4" DIA. POLYETHYLENE TUCT, 600V, 3-1C NO. 6 GROUND, (EPR-TYPE RHW), 1 1/4" DIA. POLYETHYLENE TUCT, 600V, 3-1C NO. 6 GROUND, (EPR-TYPE RHW), 1 1/4" DIA. POLYETHYLENE TUCT, 600V, 3-1C NO. 6 GROUND, (EPR-TYPE RHW), 1 1/4" DIA. POLYETHYLENE TUCT, 600V, 3-1C NO. 6 GROUND, (EPR-TYPE RWICH), 1 1/4" DIA. POLYETHYLENE TUCT, 600V, 3-1C NO. 6 GROUN	UNIT EACH FOOT EACH EACH FOOT FOOT FOOT FOOT FOOT FOOT FOOT FOO	TOTAL 6 1,400 4,600 77 59 9 1,310 6,919 2,700 13,377 15,620 1,540 23,762 6 1,524 7 138 137 5 5 4 5 1 2,183 5	48 48 5	1310 6713 2700 13377 15620 1380 7 138 137 5 5 4	Y030-1E	5 8	TRAFFIC SIGNALS Y031-1F	MAINTENANCE YOO7	LANDSCAPING R	6 1	LIGH
0400100 X ELECTF 1000800 X CONDU 1018700 X CONDU 1400100 X HANDH 1400115 X HANDH 1400215 X HANDH 1603130 X UNIT DL 1603200 X UNIT DL 1603210 X UNIT DL 1700355 X ELECTF 1900200 X TRENCI 2500360 X LIGHTIN 3600200 X LIGHTIN 4200500 X REMOV 4200600 X REMOV 4200600 X REMOV 4500110 X REMOV 4500120 X REMOV 4500130 X REMOV 4500130 X REMOV 4500130 X REMOV 4500100 X PAINTE 7900200 X DETEC 9000100 X	CTRIC SERVICE INSTALLATION DUIT IN TRENCH, 3" DIA, GALVANIZED STEEL DUIT PUSHED, 3" DIA, GALVANIZED STEEL DHOLE DHOLE TO BE ADJUSTED VY-DUTY HANDHOLE TO BE ADJUSTED DUCT, 600V, 2-1C NO. 10, 1/C NO. 10 GROUND, (EPR-TYPE RHW), 3/4" DIA. POLYETHYLENE DUCT, 600V, 2-1C NO. 4, 1/C NO. 6 GROUND, (EPR-TYPE RHW), 1" DIA. POLYETHYLENE DUCT, 600V, 2-1C NO. 2, 1/C NO. 4 GROUND, (EPR-TYPE RHW), 1" DIA. POLYETHYLENE DUCT, 600V, 3-1C NO. 4, 1/C NO. 6 GROUND, (EPR-TYPE RHW), 1 1/4" DIA. POLYETHYLENE DUCT, 600V, 3-1C NO. 4, 1/C NO. 6 GROUND, (EPR-TYPE RHW), 1 1/4" DIA. POLYETHYLENE DUCT, 600V, 3-1C NO. 4, 1/C NO. 6 GROUND, (EPR-TYPE RHW), 1 1/4" DIA. POLYETHYLENE DUCT, 600V, 3-1C NO. 4, 1/C NO. 6 GROUND, (EPR-TYPE RHW), 1 1/4" DIA. POLYETHYLENE DUCT, 600V, 3-1C NO. 4, 1/C NO. 6 GROUND, (EPR-TYPE RHW), 1 1/4" DIA. POLYETHYLENE DUCT, 600V, 3-1C NO. 4, 1/C NO. 5 GROUND, (EPR-TYPE RHW), 1 1/4" DIA. POLYETHYLENE DUCT, 600V, 3-1C NO. 4, 1/C NO. 5 GROUND, (EPR-TYPE RHW), 1 1/4" DIA. POLYETHYLENE DUCT, 600V, 3-1C NO. 4, 1/C NO. 5 GROUND, (EPR-TYPE RHW), 1 1/4" DIA. POLYETHYLENE DUCT, 600V, 3-1C NO. 4, 1/C NO. 5 GROUND, (EPR-TYPE RHW), 1 1/4" DIA. POLYETHYLENE DUCT, 600V, 3-1C NO. 4, 1/C NO. 5 GROUND, (EPR-TYPE RHW), 1 (EPR-TYPE RHW), 1 1/4" D	EACH FOOT EACH EACH EACH EACH EACH EACH FOOT FOOT FOOT FOOT FOOT EACH EACH EACH EACH EACH EACH EACH EACH	6 1,400 4,600 77 59 9 1,310 6,919 2,700 13,377 15,620 1,540 23,762 6 1,524 7 138 137 5 5 4 5 1	48	6 1400 4284 62 1310 6713 2700 13377 15620 1540 23762 6 1380 7 138 137 5		5				6	
1000800	DUIT IN TRENCH, 3" DIA., GALVANIZED STEEL DUIT PUSHED, 3" DIA., GALVANIZED STEEL DHOLE DHOLE DHOLE TO BE ADJUSTED YY-DUITY HANDHOLE TO BE ADJUSTED DUCT, 600V, 2-1C NO. 10, 1/C NO. 10 GROUND, (EPR-TYPE RHW), 3/4" DIA. POLYETHYLENE DUCT, 600V, 2-1C NO. 4, 1/C NO. 6 GROUND, (EPR-TYPE RHW), 1" DIA. POLYETHYLENE DUCT, 600V, 3-1C NO. 4, 1/C NO. 6 GROUND, (EPR-TYPE RHW), 1" DIA. POLYETHYLENE DUCT, 600V, 3-1C NO. 4, 1/C NO. 6 GROUND, (EPR-TYPE RHW), 1" DIA. POLYETHYLENE DUCT, 600V, 3-1C NO. 4, 1/C NO. 6 GROUND, (EPR-TYPE RHW), 1" DIA. POLYETHYLENE DUCT, 600V, 3-1C NO. 4, 1/C NO. 6 GROUND, (EPR-TYPE RHW), 1" DIA. POLYETHYLENE CTRIC GABLE IN CONDUIT, 600V (EPR-TYPE RHW) 1/C NO.10 CTRIC CABLE IN CONDUIT, 600V (EPR-TYPE RHW) 3-1/C NO.2 NOCH AND BACKFILL FOR ELECTRICAL WORK TING CONTROLLER, BASE MOUNTED, 480 VOLT, 100 AMP T POLE FOUNDATION, 24" DIAMETER OVAL OF EXISTING LIGHTING UNIT, NO SALVAGE OVAL OF EXISTING LIGHTING UNIT, NO SALVAGE OVAL OF EXISTING LIGHTING UNIT, NO SALVAGE OVAL OF POLE FOUNDATION OVAL OF LIGHTING CONTROLLER OVAL OF LIGHTING CONTROLLER FOUNDATION IT EXISTING TRAFFIC SIGNAL EQUIPMENT L EXISTING HANDHOLE ECTOR LOOP REPLACEMENT PORARY TRAFFIC SIGNAL INSTALLATION OVE ELECTRIC SANAL INSTALLATION OVE ELECTRIC CABLE FROM CONDUIT E, GINKGO BILOBA (GINKGO), 3" CALIPER, BALLED AND BURLAPPED E, GYMNOCLADUS DIOICUS (KENTUCKY COFFEETREE), 3" CALIPER, BALLED AND BURLAPPED E, GYMNOCLADUS DIOICUS (KENTUCKY COFFEETREE), 3" CALIPER, BALLED AND BURLAPPED E, GYMNOCLADUS DIOICUS (KENTUCKY COFFEETREE), 3" CALIPER, BALLED AND BURLAPPED E, PYRUS CALLERYANA CHANTICLEER (CHANTICLEER CALLERY PEAR), 3" CALIPER, TREE FORM, BALLED AND BURLAPPED E, PYRUS CALLERYANA CHANTICLEER (CHANTICLEER CALLERY PEAR), 3" CALIPER, TREE FORM, BALLED AND BURLAPPED	FOOT FOOT FOOT FOOT FOOT FOOT FOOT FOOT	1,400 4,600 77 59 9 1,310 6,919 2,700 13,377 15,620 1,540 23,762 6 1,524 7 138 137 5 5 4 5		1400 4284 62 1310 6713 2700 13377 15620 1540 23762 6 1380 7 138 137 5	144						
1018700	DUIT PUSHED, 3" DIA., GALVANIZED STEEL DHOLE DHOLE TO BE ADJUSTED VY-DUTY HANDHOLE TO BE ADJUSTED DUCT, 600V, 2-1C NO. 10, 1/C NO. 10 GROUND, (EPR-TYPE RHW), 3/4" DIA. POLYETHYLENE DUCT, 600V, 2-1C NO. 10, 1/C NO. 6 GROUND, (EPR-TYPE RHW), 1" DIA. POLYETHYLENE DUCT, 600V, 3-1C NO. 2, 1/C NO. 6 GROUND, (EPR-TYPE RHW), 11/4" DIA. POLYETHYLENE DUCT, 600V, 3-1C NO. 2, 1/C NO. 6 GROUND, (EPR-TYPE RHW), 1 11/4" DIA. POLYETHYLENE DUCT, 600V, 3-1C NO. 4, 1/C NO. 6 GROUND, (EPR-TYPE RHW), 1 11/4" DIA. POLYETHYLENE DUCT, 600V, 3-1C NO. 4, 1/C NO. 6 GROUND, (EPR-TYPE RHW), 1 11/4" DIA. POLYETHYLENE CTRIC CABLE IN CONDUIT, 600V (EPR-TYPE RHW), 3-1/C NO.2 NCH AND BACKFILL FOR ELECTRICAL WORK TING CONTROLLER, BASE MOUNTED, 480 VOLT, 100 AMP T POLE FOUNDATION, 24" DIAMETER OVAL OF EXISTING LIGHTING UNIT, SALVAGE OVAL OF EXISTING LIGHTING UNIT, NO SALVAGE OVAL OF EXISTING LIGHTING UNIT, NO SALVAGE OVAL OF POLE FOUNDATION OVAL OF LIGHTING CONTROLLER OVAL OF LIGHTING CONTROLLER OVAL OF LIGHTING CONTROLLER OVAL OF LIGHTING CONTROLLER FOUNDATION OVAL OF LIGHTING CONTROLLER OVAL OF LIGHTING CONTROLLER OVAL OF LIGHTING CONTROLLER FOUNDATION T EXISTING TRAFFIC SIGNAL EQUIPMENT L EXISTING TRAFFIC SIGNAL INSTALLATION OVER ELECTRIC CABLE FROM CONDUIT PORRY TRAFFIC SIGNAL INSTALLATION OVER ELECTRIC CABLE FROM CONDUIT E, GINKGO BILOBA (GINKGO), 3" CALIPER, BALLED AND BURLAPPED E, GYMNOCLADUS DIOICUS (KENTUCKY COFFEETREE), 3" CALIPER, BALLED AND BURLAPPED E, GYMNOCLADUS DIOICUS (KENTUCKY COFFEETREE), 3" CALIPER, BALLED AND BURLAPPED E, GYMNOCLADUS DIOICUS (KENTUCKY COFFEETREE), 3" CALIPER, TREE FORM, BALLED AND BURLAPPED E, PYRUS CALLERYANA CHANTICLEER (CHANTICLEER CALLERY PEAR), 3" CALIPER, TREE FORM, BALLED AND BURLAPPED E, PYRUS CALLERYANA CHANTICLEER (CHANTICLEER CALLERY PEAR), 3" CALIPER, TREE FORM, BALLED AND BURLAPPED	FOOT EACH EACH FOOT FOOT FOOT FOOT FOOT FOOT FOOT FOO	4,600 77 59 9 1,310 6,919 2,700 13,377 15,620 1,540 23,762 6 1,524 7 138 137 5 5 4 5 1 2,183		4284 62 1310 6713 2700 13377 15620 1540 23762 6 1380 7 138 137 5	144						
1400100	DHOLE DHOLE TO BE ADJUSTED VY-DUTY HANDHOLE TO BE ADJUSTED DUCT, 600V, 2-1C NO. 10, 1/C NO. 10 GROUND, (EPR-TYPE RHW), 3/4" DIA. POLYETHYLENE DUCT, 600V, 2-1C NO. 4, 1/C NO. 6 GROUND, (EPR-TYPE RHW), 1" DIA. POLYETHYLENE DUCT, 600V, 3-1C NO. 4, 1/C NO. 4 GROUND, (EPR-TYPE RHW), 1 1/4" DIA. POLYETHYLENE DUCT, 600V, 3-1C NO. 4, 1/C NO. 6 GROUND, (EPR-TYPE RHW), 1 1/4" DIA. POLYETHYLENE DUCT, 600V, 3-1C NO. 4, 1/C NO. 6 GROUND, (EPR-TYPE RHW), 1 1/4" DIA. POLYETHYLENE TOUCT, 600V, 3-1C NO. 4, 1/C NO. 6 GROUND, (EPR-TYPE RHW), 1 1/4" DIA. POLYETHYLENE CTRIC CABLE IN CONDUIT, 600V (EPR-TYPE RHW) 1/C NO.10 CTRIC CABLE IN CONDUIT, 600V (EPR-TYPE RHW) 3-1/C NO.2 NCH AND BACKFILL FOR ELECTRICAL WORK TING CONTROLLER, BASE MOUNTED, 480 VOLT, 100 AMP IT POLE FOUNDATION, 24" DIAMETER OVAL OF EXISTING LIGHTING UNIT, NO SALVAGE OVAL OF EXISTING LIGHTING UNIT, NO SALVAGE OVAL OF POLE FOUNDATION OVAL OF LIGHTING CONTROLLER OVAL OF LIGHTING CONTROLLER FOUNDATION IT EXISTING TRAFFIC SIGNAL EQUIPMENT L EXISTING HANDHOLE ECTOR LOOP REPLACEMENT PORARY TRAFFIC SIGNAL INSTALLATION OVE LIGHTING CONTROLLER FOUNDATION OVE LIGHTING CONTROLLER FOUNDATION TEXISTING HANDHOLE ECTOR LOOP REPLACEMENT PORARY TRAFFIC SIGNAL INSTALLATION OVE LIGHTING CONTROLLER FOUNDATION OVE LIGHTING CONTROLLER FOUNDATION TO SALVE TRAFFIC SIGNAL INSTALLATION OVE LIGHTING CONTROLLER FOUNDATION TO SALVE TRAFFIC SIGNAL INSTALLATION OVE LIGHTING CONTROLLER FOUNDATION TO SALVE TRAFFIC SIGNAL INSTALLATION OVE ELECTRIC CABLE FROM CONDUIT E, GINKGO BILOBA (GINKGO), 3" CALIPER, BALLED AND BURLAPPED E, GYMNOCLADUS DIOICUS (KENTUCKY COFFEETREE), 3" CALIPER, BALLED AND BURLAPPED E, GYMNOCLADUS DIOICUS (KENTUCKY COFFEETREE), 3" CALIPER, TREE FORM, BALLED AND BURLAPPED E, PYRUS CALLERYANA ARISTOCRAT (ARISTOCRAT CALLERY PEAR), 3" CALIPER, TREE FORM, BALLED AND BURLAPPED E, PYRUS CALLERYANA ARISTOCRAT (ARISTOCRAT CALLERY PEAR), 3" CALIPER, TREE FORM, BALLED AND BURLAPPED	EACH EACH FOOT FOOT FOOT FOOT FOOT EACH EACH EACH EACH EACH EACH EACH EACH	77 59 9 1,310 6,919 2,700 13,377 15,620 1,540 23,762 6 1,524 7 138 137 5 5 4 5 1		62 1310 6713 2700 13377 15620 1540 23762 6 1380 7 138 137 5	144						
1400115	DHOLE TO BE ADJUSTED VY-DUTY HANDHOLE TO BE ADJUSTED TOUCT, 600V, 2-1C NO. 10, 1/C NO. 10 GROUND, (EPR-TYPE RHW), 3/4" DIA. POLYETHYLENE DUCT, 600V, 2-1C NO. 4, 1/C NO. 6 GROUND, (EPR-TYPE RHW), 1" DIA. POLYETHYLENE DUCT, 600V, 3-1C NO. 2, 1/C NO. 6 GROUND, (EPR-TYPE RHW), 1 1/4" DIA. POLYETHYLENE DUCT, 600V, 3-1C NO. 2, 1/C NO. 6 GROUND, (EPR-TYPE RHW), 1 1/4" DIA. POLYETHYLENE DUCT, 600V, 3-1C NO. 4, 1/C NO. 6 GROUND, (EPR-TYPE RHW), 1 1/4" DIA. POLYETHYLENE TUCT, 600V, 3-1C NO. 4, 1/C NO. 6 GROUND, (EPR-TYPE RHW), 1 1/4" DIA. POLYETHYLENE TUCT, 600V, 3-1C NO. 6 GROUND, (EPR-TYPE RHW), 1 1/4" DIA. POLYETHYLENE TUCT, 600V, 3-1C NO. 6 GROUND, (EPR-TYPE RHW), 1 1/4" DIA. POLYETHYLENE TUCT, 600V, 3-1C NO. 6 GROUND, (EPR-TYPE RHW), 1 1/4" DIA. POLYETHYLENE TUCT, 600V, 3-1C NO. 6 GROUND, RHW), 1 1/4" DIA. POLYETHYLENE TUCT, 600V, 3-1C NO. 6 GROUND, (EPR-TYPE RHW), 1 1/4" DIA. POLYETHYLENE TUCT, 600V, 3-1C NO. 6 GROUND, (EPR-TYPE RHW), 1 1/4" DIA. POLYETHYLENE TUCT, 600V, 3-1C NO. 6 GROUND, (EPR-TYPE RHW), 1 1/4" DIA. POLYETHYLENE TUCT, 600V, 3-1C NO. 6 GROUND, (EPR-TYPE RHW), 1 1/4" DIA. POLYETHYLENE TUCT, 600V, 3-1C NO. 6 GROUND, (EPR-TYPE RWICH), 1 1/4" DIA. POLYETHYLENE TUCT, 600V, 3-1C NO. 6 GROUN	EACH EACH FOOT FOOT FOOT FOOT FOOT EACH EACH EACH EACH EACH EACH EACH EACH	59 9 1,310 6,919 2,700 13,377 15,620 1,540 23,762 6 1,524 7 138 137 5 5 4 5 1 2,183		1310 6713 2700 13377 15620 1540 23762 6 1380 7 138 137 5	144						
1400215 X	VY-DUTY HANDHOLE TO BE ADJUSTED DUCT, 600V, 2-1C NO. 10, 1/C NO. 10 GROUND, (EPR-TYPE RHW), 3/4" DIA. POLYETHYLENE DUCT, 600V, 2-1C NO. 2, 1/C NO. 4 GROUND, (EPR-TYPE RHW), 1" DIA. POLYETHYLENE DUCT, 600V, 3-1C NO. 2, 1/C NO. 4 GROUND, (EPR-TYPE RHW), 1 1/4" DIA. POLYETHYLENE DUCT, 600V, 3-1C NO. 2, 1/C NO. 5 GROUND, (EPR-TYPE RHW), 1 1/4" DIA. POLYETHYLENE DUCT, 600V, 3-1C NO. 4, 1/C NO. 6 GROUND, (EPR-TYPE RHW), 1 1/4" DIA. POLYETHYLENE CTRIC CABLE IN CONDUIT, 600V (EPR-TYPE RHW) 1/C NO.10 CTRIC CABLE IN CONDUIT, 600V (EPR-TYPE RHW) 1/C NO.2 NCH AND BACKFILL FOR ELECTRICAL WORK TING CONTROLLER, BASE MOUNTED, 480 VOLT, 100 AMP T POLE FOUNDATION, 24" DIAMETER OVAL OF EXISTING LIGHTING UNIT, SALVAGE OVAL OF EXISTING LIGHTING UNIT, NO SALVAGE OVAL OF EXISTING LIGHTING UNIT, NO SALVAGE OVAL OF LECTRIC SERVICE INSTALLATION OVAL OF LECTRIC SERVICE INSTALLATION OVAL OF LIGHTING CONTROLLER OVAL OF LECTRIC SERVICE INSTALLATION OVAL OF LIGHTING CONTROLLER FOUNDATION IT EXISTING TRAFFIC SIGNAL EQUIPMENT L EXISTING TRAFFIC SIGNAL EQUIPMENT L EXISTING TRAFFIC SIGNAL EQUIPMENT L EXISTING TRAFFIC SIGNAL INSTALLATION OVE ELECTRIC CABLE FROM CONDUIT E, GINKGO BILOBA (GINKGO), 3" CALIPER, BALLED AND BURLAPPED E, GINKGO BILOBA (GINKGO), 3" CALIPER, BALLED AND BURLAPPED E, GINKGO BILOBA (GINKGO), 3" CALIPER, BALLED AND BURLAPPED E, GYMNOCLADUS DIOICUS (KENTUCKY COFFEETREE), 3" CALIPER, BALLED AND BURLAPPED E, GYMNOCLADUS DIOICUS (KENTUCKY COFFEETREE), 3" CALIPER, BALLED AND BURLAPPED E, PYRUS CALLERYANA CHANTICLEER (CHANTICLEER CALLERY PEAR), 3" CALIPER, TREE FORM, BALLED AND BURLAPPED E, PYRUS CALLERYANA ARISTOCRAT (ARISTOCRAT CALLERY PEAR), 3" CALIPER, TREE FORM, BALLED AND BURLAPPED	EACH FOOT FOOT FOOT FOOT FOOT FOOT EACH EACH EACH EACH EACH EACH EACH EACH	9 1,310 6,919 2,700 13,377 15,620 1,540 23,762 6 1,524 7 138 137 5 5 4 4 5 1 2,183		6713 2700 13377 15620 1540 23762 6 1380 7 138 137 5	144						
603130 X * UNIT DU 603150 X UNIT DU 603150 X UNIT DU 603200 X UNIT DU 603200 X UNIT DU 603201 X UNIT DU 700110 X ELECTE 700355 X ELECTE 700355 X ELECTE 900200 X TRENCI 500360 X LIGHT N 600200 X LIGHT N 600200 X REMOV 200500 X REMOV 500110 X REMOV 60000 X PAINT E 600600 X PAINT E 600600 X PAINT E 600600 X TEMPO 600300 X TEMPO 6005024 X TREE, G 6005025 X TREE, G 6005024 X TREE, G 6005025 X TREE, G 6005024 X TREE, G 6005024 X TREE, G 6005024 X TREE, G 6005025 X TREE, G 600	DUCT, 600V, 2-1C NO. 10, 1/C NO. 10 GROUND, (EPR-TYPE RHW), 3/4" DIA. POLYETHYLENE DUCT, 600V, 2-1C NO. 4, 1/C NO. 6 GROUND, (EPR-TYPE RHW), 1" DIA. POLYETHYLENE DUCT, 600V, 3-1C NO. 2, 1/C NO. 4 GROUND, (EPR-TYPE RHW), 1 1/4" DIA. POLYETHYLENE DUCT, 600V, 3-1C NO. 4, 1/C NO. 6 GROUND, (EPR-TYPE RHW), 1 1/4" DIA. POLYETHYLENE DUCT, 600V, 3-1C NO. 4, 1/C NO. 6 GROUND, (EPR-TYPE RHW), 1 1/4" DIA. POLYETHYLENE CTRIC CABLE IN CONDUIT, 600V (EPR-TYPE RHW) 3-1/C NO.2 NCH AND BACKFILL FOR ELECTRICAL WORK TING CONTROLLER, BASE MOUNTED, 480 VOLT, 100 AMP T POLE FOUNDATION, 24" DIAMETER OVAL OF EXISTING LIGHTING UNIT, NO SALVAGE OVAL OF EXISTING LIGHTING UNIT, NO SALVAGE OVAL OF EXISTING LIGHTING UNIT, NO SALVAGE OVAL OF LIGHTING CONTROLLER OVAL OF LIGHTING CONTROLLER OVAL OF LIGHTING CONTROLLER FOUNDATION UNAL OF LIGHTING CONTROLLER FOUNDATION IT EXISTING TRAFFIC SIGNAL EQUIPMENT L EXISTING TRAFFIC SIGNAL EQUIPMENT L EXISTING TRAFFIC SIGNAL INSTALLATION OVE LIGHTING CONTROLLER FOUNDATION OVE LIGHTING CONTROLLER FOUNDATION OVE LIGHTING CONTROLLER FOUNDATION DOVE SELECTRIC CABLE FROM CONDUIT E. GINKGO BILOBA (GINKGO), 3" CALIPER, BALLED AND BURLAPPED E. GINKGO BILOBA (GINKGO), 3" CALIPER, BALLED AND BURLAPPED E. GINKGO BILOBA (GINKGO), 3" CALIPER, BALLED AND BURLAPPED E. GYMNOCLADUS DIOICUS (KENTUCKY COFFEETREE), 3" CALIPER, BALLED AND BURLAPPED E. PYRUS CALLERYANA CHANTICLEER (CHANTICLEER CALLERY PEAR), 3" CALIPER, TREE FORM, BALLED AND BURLAPPED E. PYRUS CALLERYANA ARISTOCRAT (ARISTOCRAT CALLERY PEAR), 3" CALIPER, TREE FORM, BALLED AND BURLAPPED	FOOT FOOT FOOT FOOT FOOT FOOT EACH FOOT EACH EACH EACH EACH EACH EACH EACH EACH	1,310 6,919 2,700 13,377 15,620 1,540 23,762 6 1,524 7 138 137 5 5 4 5 1	5	6713 2700 13377 15620 1540 23762 6 1380 7 138 137 5	144	8					
603150 X UNIT DU 603200 X UNIT DU 603200 X UNIT DU 603210 X UNIT DU 603210 X UNIT DU 603210 X UNIT DU 700110 X ELECTF 700355 X ELECTF 700355 X ELECTF 900200 X TRENCI 500360 X LIGHT P 200500 X REMOV 200600 X REMOV 500110 X REMOV 500120 X REMOV 500120 X REMOV 500130 X REMOV 600600 X DRILLE 600600 X TEMPO 502300 X REMOV 60040424 X TREE, C 605726 X TREE, C 605726 X TREE, F 6005726 X TREE, F 600	DUCT, 600V, 2-1C NO. 4, 1/C NO. 6 GROUND, (EPR-TYPE RHW), 1" DIA. POLYETHYLENE DUCT, 600V, 3-1C NO. 2, 1/C NO. 4 GROUND, (EPR-TYPE RHW), 1 1/4" DIA. POLYETHYLENE DUCT, 600V, 3-1C NO. 4, 1/C NO. 6 GROUND, (EPR-TYPE RHW), 1 1/4" DIA. POLYETHYLENE CTRIC CABLE IN CONDUIT, 600V (EPR-TYPE RHW) 1/C NO.10 CTRIC CABLE IN CONDUIT, 600V (EPR-TYPE RHW) 3-1/C NO.2 NCH AND BACKFILL FOR ELECTRICAL WORK TING CONTROLLER, BASE MOUNTED, 480 VOLT, 100 AMP T POLE FOUNDATION, 24" DIAMETER OVAL OF EXISTING LIGHTING UNIT, SALVAGE OVAL OF EXISTING LIGHTING UNIT, NO SALVAGE OVAL OF EXISTING LIGHTING UNIT, NO SALVAGE OVAL OF LIGHTING CONTROLLER OVAL OF LIGHTING	FOOT FOOT FOOT FOOT FOOT EACH FOOT EACH EACH EACH EACH EACH EACH EACH EACH	6,919 2,700 13,377 15,620 1,540 23,762 6 1,524 7 138 137 5 5 4 5 1 1 2,183	5	6713 2700 13377 15620 1540 23762 6 1380 7 138 137 5	144						
603200 X UNIT DU 603210 X UNIT DU 603210 X UNIT DU 603210 X UNIT DU 700110 X ELECTF 7001355 X ELECTF 900200 X TRENCI 500360 X LIGHTIN 600200 X LIGHT PU 200500 X REMOV 200600 X REMOV 500110 X REMOV 500110 X REMOV 500110 X REMOV 500110 X REMOV 600100 X PAINT E 900200 X DRILL E 600600 X TEMPOU 600300 X TEMPOU 600300 X TREE, F 6005024 X T	DUCT, 600V, 3-1C NO. 2, 1/C NO. 4 GROUND, (EPR-TYPE RHW), 1 1/4" DIA. POLYETHYLENE DUCT, 600V, 3-1C NO. 4, 1/C NO. 6 GROUND, (EPR-TYPE RHW), 1 1/4" DIA. POLYETHYLENE CTRIC CABLE IN CONDUIT, 600V (EPR-TYPE RHW) 3-1/C NO.2 NCH AND BACKFILL FOR ELECTRICAL WORK TING CONTROLLER, BASE MOUNTED, 480 VOLT, 100 AMP T POLE FOUNDATION, 24" DIAMETER OVAL OF EXISTING LIGHTING UNIT, SALVAGE OVAL OF EXISTING LIGHTING UNIT, NO SALVAGE OVAL OF EXISTING LIGHTING UNIT, NO SALVAGE OVAL OF POLE FOUNDATION OVAL OF LIGHTING CONTROLLER OUNDATION IT EXISTING HANDHOLE ECTOR LOOP REPLACEMENT DORARY TRAFFIC SIGNAL INSTALLATION OVE ELECTRIC CABLE FROM CONDUIT E, GINKGO BILOBA (GINKGO), 3" CALIPER, BALLED AND BURLAPPED E, GYMNOCLADUS DIOICUS (KENTUCKY COFFEETREE), 3" CALIPER, BALLED AND BURLAPPED E, GYMNOCLADUS DIOICUS (KENTUCKY COFFEETREE), 3" CALIPER, BALLED AND BURLAPPED E, PYRUS CALLERYANA CHANTICLEER (CHANTICLEER CALLERY PEAR), 3" CALIPER, TREE FORM, BALLED AND BURLAPPED E, PYRUS CALLERYANA ARISTOCRAT (ARISTOCRAT CALLERY PEAR), 3" CALIPER, TREE FORM, BALLED AND BURLAPPED E, PYRUS CALLERYANA ARISTOCRAT (ARISTOCRAT CALLERY PEAR), 3" CALIPER, TREE FORM, BALLED AND BURLAPPED	FOOT FOOT FOOT FOOT FOOT FOOT EACH FOOT EACH EACH EACH EACH EACH EACH EACH EACH	2,700 13,377 15,620 1,540 23,762 6 1,524 7 138 137 5 5 4 5 1 1 2,183	5	2700 13377 15620 1540 23762 6 1380 7 138 137 5	144						
1603200	DUCT, 600V, 3-1C NO. 2, 1/C NO. 4 GROUND, (EPR-TYPE RHW), 1 1/4" DIA. POLYETHYLENE DUCT, 600V, 3-1C NO. 4, 1/C NO. 6 GROUND, (EPR-TYPE RHW), 1 1/4" DIA. POLYETHYLENE CTRIC CABLE IN CONDUIT, 600V (EPR-TYPE RHW) 3-1/C NO.2 NCH AND BACKFILL FOR ELECTRICAL WORK TING CONTROLLER, BASE MOUNTED, 480 VOLT, 100 AMP T POLE FOUNDATION, 24" DIAMETER OVAL OF EXISTING LIGHTING UNIT, SALVAGE OVAL OF EXISTING LIGHTING UNIT, NO SALVAGE OVAL OF EXISTING LIGHTING UNIT, NO SALVAGE OVAL OF POLE FOUNDATION OVAL OF LIGHTING CONTROLLER OUNDATION IT EXISTING HANDHOLE ECTOR LOOP REPLACEMENT DORARY TRAFFIC SIGNAL INSTALLATION OVE ELECTRIC CABLE FROM CONDUIT E, GINKGO BILOBA (GINKGO), 3" CALIPER, BALLED AND BURLAPPED E, GYMNOCLADUS DIOICUS (KENTUCKY COFFEETREE), 3" CALIPER, BALLED AND BURLAPPED E, GYMNOCLADUS DIOICUS (KENTUCKY COFFEETREE), 3" CALIPER, BALLED AND BURLAPPED E, PYRUS CALLERYANA CHANTICLEER (CHANTICLEER CALLERY PEAR), 3" CALIPER, TREE FORM, BALLED AND BURLAPPED E, PYRUS CALLERYANA ARISTOCRAT (ARISTOCRAT CALLERY PEAR), 3" CALIPER, TREE FORM, BALLED AND BURLAPPED E, PYRUS CALLERYANA ARISTOCRAT (ARISTOCRAT CALLERY PEAR), 3" CALIPER, TREE FORM, BALLED AND BURLAPPED	FOOT FOOT FOOT FOOT FOOT FOOT EACH FOOT EACH EACH EACH EACH EACH EACH EACH EACH	2,700 13,377 15,620 1,540 23,762 6 1,524 7 138 137 5 5 4 5 1 1 2,183	5	2700 13377 15620 1540 23762 6 1380 7 138 137 5	144						
1603210	DUCT, 600V, 3-1C NO. 4, 1/C NO. 6 GROUND, (EPR-TYPE RHW), 1 1/4" DIA. POLYETHYLENE CTRIC CABLE IN CONDUIT, 600V (EPR-TYPE RHW) 1/C NO.10 CTRIC CABLE IN CONDUIT, 600V (EPR-TYPE RHW) 3-1/C NO.2 NCH AND BACKFILL FOR ELECTRICAL WORK TING CONTROLLER, BASE MOUNTED, 480 VOLT, 100 AMP T POLE FOUNDATION, 24" DIAMETER OVAL OF EXISTING LIGHTING UNIT, SALVAGE OVAL OF EXISTING LIGHTING UNIT, NO SALVAGE OVAL OF POLE FOUNDATION OVAL OF LIGHTING CONTROLLER OVAL OF POLE FOUNDATION OVAL OF LIGHTING CONTROLLER OVAL OF ELECTRIC SERVICE INSTALLATION OVAL OF LIGHTING CONTROLLER FOUNDATION IT EXISTING TRAFFIC SIGNAL EQUIPMENT L EXISTING HANDHOLE ECTOR LOOP REPLACEMENT PORARY TRAFFIC SIGNAL INSTALLATION OVE ELECTRIC CABLE FROM CONDUIT E, GINKGO BILOBA (GINKGO), 3" CALIPER, BALLED AND BURLAPPED E, GYMNOCLADUS DIOICUS (KENTUCKY COFFEETREE), 3" CALIPER, BALLED AND BURLAPPED E, GYMNOCLADUS DIOICUS (KENTUCKY COFFEETREE), 3" CALIPER, BALLED AND BURLAPPED E, PYRUS CALLERYANA CHANTICLEER (CHANTICLEER CALLERY PEAR), 3" CALIPER, TREE FORM, BALLED AND BURLAPPED E, PYRUS CALLERYANA ARISTOCRAT (ARISTOCRAT CALLERY PEAR), 3" CALIPER, TREE FORM, BALLED AND BURLAPPED E, LUMUS X PATRIOT (PATRIOT ELM), 3" CALIPER, TREE FORM, BALLED AND BURLAPPED	FOOT FOOT FOOT FOOT EACH EACH EACH EACH EACH EACH EACH EACH	13,377 15,620 1,540 23,762 6 1,524 7 138 137 5 5 4 4 5 1 2,183	5	13377 15620 1540 23762 6 1380 7 138 137 5	144						
1700110	CTRIC CABLE IN CONDUIT, 600V (EPR-TYPE RHW) 1/C NO.10 CTRIC CABLE IN CONDUIT, 600V (EPR-TYPE RHW) 3-1/C NO.2 NCH AND BACKFILL FOR ELECTRICAL WORK TING CONTROLLER, BASE MOUNTED, 480 VOLT, 100 AMP T POLE FOUNDATION, 24" DIAMETER OVAL OF EXISTING LIGHTING UNIT, SALVAGE OVAL OF EXISTING LIGHTING UNIT, NO SALVAGE OVAL OF EXISTING LIGHTING UNIT, NO SALVAGE OVAL OF POLE FOUNDATION OVAL OF LIGHTING CONTROLLER OVAL OF ELECTRIC SERVICE INSTALLATION OVAL OF LIGHTING CONTROLLER FOUNDATION IT EXISTING TRAFFIC SIGNAL EQUIPMENT IL EXISTING HANDHOLE ECTRIC CABLE FROM CONDUIT E, GINKGO BILOBA (GINKGO), 3" CALIPER, BALLED AND BURLAPPED E, GYMNOCLADUS DIOICUS (KENTUCKY COFFEETREE), 3" CALIPER, BALLED AND BURLAPPED E, GLEDITSIA TRIACANTOS INERMIS SKYLINE (SKYLINE THORNLESS COMMON HONEYLOCUST), 3" CALIPER, BALLED AND BUR E, PYRUS CALLERYANA CHANTICLEER (CHANTICLEER CALLERY PEAR), 3" CALIPER, TREE FORM, BALLED AND BURLAPPED E, PYRUS CALLERYANA ARISTOCRAT (ARISTOCRAT CALLERY PEAR), 3" CALIPER, TREE FORM, BALLED AND BURLAPPED E, ULMUS X PATRIOT (PATRIOT ELM), 3" CALIPER, TREE FORM, BALLED AND BURLAPPED	FOOT FOOT EACH FOOT EACH EACH EACH EACH EACH EACH EACH EACH	15,620 1,540 23,762 6 1,524 7 138 137 5 5 4 5 1 1 2,183	5	15620 1540 23762 6 1380 7 138 137 5	144						
1700355	CTRIC CABLE IN CONDUIT, 600V (EPR-TYPE RHW) 3-1/C NO.2 NCH AND BACKFILL FOR ELECTRICAL WORK TING CONTROLLER, BASE MOUNTED, 480 VOLT, 100 AMP T POLE FOUNDATION, 24" DIAMETER OVAL OF EXISTING LIGHTING UNIT, SALVAGE OVAL OF EXISTING LIGHTING UNIT, NO SALVAGE OVAL OF POLE FOUNDATION OVAL OF POLE FOUNDATION OVAL OF LIGHTING CONTROLLER OVAL OF ELECTRIC SERVICE INSTALLATION OVAL OF LIGHTING CONTROLLER FOUNDATION IT EXISTING TRAFFIC SIGNAL EQUIPMENT L EXISTING TRAFFIC SIGNAL EQUIPMENT L EXISTING HANDHOLE ECTOR LOOP REPLACEMENT PORARY TRAFFIC SIGNAL INSTALLATION OVE ELECTRIC CABLE FROM CONDUIT E, GINKGO BILOBA (GINKGO), 3" CALIPER, BALLED AND BURLAPPED E, GYMNOCLADUS DIOICUS (KENTUCKY COFFEETREE), 3" CALIPER, BALLED AND BURLAPPED E, GYENG SALLERYANA CHANTICLEER (CHANTICLEER CALLERY PEAR), 3" CALIPER, TREE FORM, BALLED AND BURLAPPED E, PYRUS CALLERYANA ARISTOCRAT (ARISTOCRAT CALLERY PEAR), 3" CALIPER, TREE FORM, BALLED AND BURLAPPED E, PYRUS CALLERYANA ARISTOCRAT (ARISTOCRAT CALLERY PEAR), 3" CALIPER, TREE FORM, BALLED AND BURLAPPED E, ULMUS X PATRIOT (PATRIOT ELM), 3" CALIPER, TREE FORM, BALLED AND BURLAPPED	FOOT FOOT EACH FOOT EACH EACH EACH EACH EACH EACH EACH EACH	1,540 23,762 6 1,524 7 138 137 5 5 4 4 5 1 2,183	5	1540 23762 6 1380 7 138 137 5	144						
1900200	NCH AND BACKFILL FOR ELECTRICAL WORK TING CONTROLLER, BASE MOUNTED, 480 VOLT, 100 AMP T POLE FOUNDATION, 24" DIAMETER OVAL OF EXISTING LIGHTING UNIT, SALVAGE OVAL OF EXISTING LIGHTING UNIT, NO SALVAGE OVAL OF POLE FOUNDATION OVAL OF LIGHTING CONTROLLER OVAL OF ELECTRIC SERVICE INSTALLATION OVAL OF LIGHTING CONTROLLER FOUNDATION IT EXISTING TRAFFIC SIGNAL EQUIPMENT L EXISTING TRAFFIC SIGNAL EQUIPMENT L EXISTING HANDHOLE ECTOR LOOP REPLACEMENT PORARY TRAFFIC SIGNAL INSTALLATION OVE ELECTRIC CABLE FROM CONDUIT E, GINKGO BILOBA (GINKGO), 3" CALIPER, BALLED AND BURLAPPED E, GYMNOCLADUS DIOICUS (KENTUCKY COFFEETREE), 3" CALIPER, BALLED AND BURLAPPED E, GLEDITSIA TRIACANTHOS INERMIS SKYLINE (SKYLINE THORNLESS COMMON HONEYLOCUST), 3" CALIPER, BALLED AND BURLAPPED E, PYRUS CALLERYANA CHANTICLEER (CHANTICLEER CALLERY PEAR), 3" CALIPER, TREE FORM, BALLED AND BURLAPPED E, PYRUS CALLERYANA ARISTOCRAT (ARISTOCRAT CALLERY PEAR), 3" CALIPER, TREE FORM, BALLED AND BURLAPPED E, ULMUS X PATRIOT (PATRIOT ELM), 3" CALIPER, TREE FORM, BALLED AND BURLAPPED	FOOT EACH FOOT EACH EACH EACH EACH EACH EACH EACH EACH	23,762 6 1,524 7 138 137 5 5 4 5 1 2,183	5	23762 6 1380 7 138 137 5	144						
Section Sect	TING CONTROLLER, BASE MOUNTED, 480 VOLT, 100 AMP T POLE FOUNDATION, 24" DIAMETER OVAL OF EXISTING LIGHTING UNIT, SALVAGE OVAL OF EXISTING LIGHTING UNIT, NO SALVAGE OVAL OF POLE FOUNDATION OVAL OF POLE FOUNDATION OVAL OF LIGHTING CONTROLLER OVAL OF ELECTRIC SERVICE INSTALLATION OVAL OF LIGHTING CONTROLLER FOUNDATION IT EXISTING TRAFFIC SIGNAL EQUIPMENT L EXISTING TRAFFIC SIGNAL EQUIPMENT L EXISTING HANDHOLE ECTOR LOOP REPLACEMENT PORARY TRAFFIC SIGNAL INSTALLATION OVE ELECTRIC CABLE FROM CONDUIT E, GINKGO BILOBA (GINKGO), 3" CALIPER, BALLED AND BURLAPPED E, GYMNOCLADUS DIOICUS (KENTUCKY COFFEETREE), 3" CALIPER, BALLED AND BURLAPPED E, GLEDITSIA TRIACANTHOS INERMIS SKYLINE (SKYLINE THORNLESS COMMON HONEYLOCUST), 3" CALIPER, BALLED AND BUR E, PYRUS CALLERYANA CHANTICLEER (CHANTICLEER CALLERY PEAR), 3" CALIPER, TREE FORM, BALLED AND BURLAPPED E, PYRUS CALLERYANA ARISTOCRAT (ARISTOCRAT CALLERY PEAR), 3" CALIPER, TREE FORM, BALLED AND BURLAPPED E, ULMUS X PATRIOT (PATRIOT ELM), 3" CALIPER, TREE FORM, BALLED AND BURLAPPED	EACH FOOT EACH EACH EACH EACH EACH EACH EACH EACH	6 1,524 7 138 137 5 5 4 5 1 2,183	5	6 1380 7 138 137 5	144						
1000000 X	T POLE FOUNDATION, 24" DIAMETER OVAL OF EXISTING LIGHTING UNIT, SALVAGE OVAL OF EXISTING LIGHTING UNIT, NO SALVAGE OVAL OF POLE FOUNDATION OVAL OF LIGHTING CONTROLLER OVAL OF LIGHTING CONTROLLER OVAL OF LIGHTING CONTROLLER FOUNDATION OVAL OF LIGHTING CONTROLLER FOUNDATION IT EXISTING TRAFFIC SIGNAL EQUIPMENT LEXISTING TRAFFIC SIGNAL EQUIPMENT LEXISTING HANDHOLE ECTOR LOOP REPLACEMENT PORARY TRAFFIC SIGNAL INSTALLATION OVE ELECTRIC CABLE FROM CONDUIT E, GINKGO BILOBA (GINKGO), 3" CALIPER, BALLED AND BURLAPPED E, GYMNOCLADUS DIOICUS (KENTUCKY COFFEE TREE), 3" CALIPER, BALLED AND BURLAPPED E, GLEDITSIA TRIACANTHOS INERMIS SKYLINE (SKYLINE THORNLESS COMMON HONEYLOCUST), 3" CALIPER, BALLED AND BUR E, PYRUS CALLERYANA CHANTICLEER (CHANTICLEER CALLERY PEAR), 3" CALIPER, TREE FORM, BALLED AND BURLAPPED E, PYRUS CALLERYANA ARISTOCRAT (ARISTOCRAT CALLERY PEAR), 3" CALIPER, TREE FORM, BALLED AND BURLAPPED E, ULMUS X PATRIOT (PATRIOT ELM), 3" CALIPER, TREE FORM, BALLED AND BURLAPPED	FOOT EACH EACH EACH EACH EACH EACH EACH EACH	1,524 7 138 137 5 5 4 5 1 2,183	5	1380 7 138 137 5	144						
200500 X REMOV. 200600 X REMOV. 200806 X REMOV. 500110 X REMOV. 500110 X REMOV. 500110 X REMOV. 500110 X REMOV. 500130 X REMOV. 500130 X REMOV. 600600 X PAINTE 600600 X DRILL E 600600 X REMOV. 6004424 X TREE, G 6005024 X TREE, G 600502000 TREE, G 600502000 TREE, G 600502000 TREE, G 600502000 TREE,	OVAL OF EXISTING LIGHTING UNIT, SALVAGE OVAL OF EXISTING LIGHTING UNIT, NO SALVAGE OVAL OF POLE FOUNDATION OVAL OF LIGHTING CONTROLLER OVAL OF LIGHTING CONTROLLER OVAL OF LIGHTING CONTROLLER FOUNDATION OVAL OF LIGHTING CONTROLLER FOUNDATION IT EXISTING TRAFFIC SIGNAL EQUIPMENT L EXISTING HANDHOLE EXISTING H	EACH EACH EACH EACH EACH EACH EACH EACH	7 138 137 5 5 4 5 1 2,183	5	7 138 137 5 5	144						
200600 X REMOV. 200806 X REMOV. 500110 X REMOV. 500130 X REMOV. 600600 X DRILL E. 600600 X DETEC. 600600 X TEMPO. 600424 X TREE, G. 600425 X TREE, G. 600424 X TREE, G. 6004424 X	OVAL OF EXISTING LIGHTING UNIT, NO SALVAGE OVAL OF POLE FOUNDATION OVAL OF LIGHTING CONTROLLER OVAL OF ELECTRIC SERVICE INSTALLATION OVAL OF LIGHTING CONTROLLER FOUNDATION IT EXISTING TRAFFIC SIGNAL EQUIPMENT L EXISTING HANDHOLE ECTOR LOOP REPLACEMENT PORARY TRAFFIC SIGNAL INSTALLATION OVE ELECTRIC CABLE FROM CONDUIT E, GINKGO BILOBA (GINKGO), 3" CALIPER, BALLED AND BURLAPPED E, GYMNOCLADUS DIOICUS (KENTUCKY COFFEETREE), 3" CALIPER, BALLED AND BURLAPPED E, GLEDITSIA TRIACANTHOS INERMIS SKYLINE (SKYLINE THORNLESS COMMON HONEYLOCUST), 3" CALIPER, BALLED AND BURLAPPED E, PYRUS CALLERYANA CHANTICLEER (CHANTICLEER CALLERY PEAR), 3" CALIPER, TREE FORM, BALLED AND BURLAPPED E, PYRUS CALLERYANA ARISTOCRAT (ARISTOCRAT CALLERY PEAR), 3" CALIPER, TREE FORM, BALLED AND BURLAPPED E, ULMUS X PATRIOT (PATRIOT ELM), 3" CALIPER, TREE FORM, BALLED AND BURLAPPED	EACH EACH EACH EACH EACH EACH EACH EACH	138 137 5 5 4 5 1 2,183	5	138 137 5 5						-	
200806 X REMOV. 500110 X PAINT E. 500200 X DRILL E. 500600 X DRILL E. 500600 X DRILL E. 500600 X TEMPO. 502300 X REMOV. 6005024 X TREE, G. 6004824 X TREE, G. 6004824 X TREE, G. 6004824 X TREE, F. 6005726 X TREE, F. 6005726 X TREE, F. 6005726 X TREE, F. 6005726 X TREE, F. 6008750 X TREE, F. 60	OVAL OF POLE FOUNDATION OVAL OF LIGHTING CONTROLLER OVAL OF ELECTRIC SERVICE INSTALLATION OVAL OF ELECTRIC SERVICE INSTALLATION OVAL OF LIGHTING CONTROLLER FOUNDATION IT EXISTING TRAFFIC SIGNAL EQUIPMENT IL EXISTING HANDHOLE ECTOR LOOP REPLACEMENT PORARY TRAFFIC SIGNAL INSTALLATION OVE ELECTRIC CABLE FROM CONDUIT E, GINKGO BILOBA (GINKGO), 3" CALIPER, BALLED AND BURLAPPED E, GYMNOCLADUS DIOICUS (KENTUCKY COFFEETREE), 3" CALIPER, BALLED AND BURLAPPED E, GLEDITSIA TRIACANTHOS INERMIS SKYLINE (SKYLINE THORNLESS COMMON HONEYLOCUST), 3" CALIPER, BALLED AND BURLAPPED E, PYRUS CALLERYANA CHANTICLEER (CHANTICLEER CALLERY PEAR), 3" CALIPER, TREE FORM, BALLED AND BURLAPPED E, PYRUS CALLERYANA ARISTOCRAT (ARISTOCRAT CALLERY PEAR), 3" CALIPER, TREE FORM, BALLED AND BURLAPPED E, ULMUS X PATRIOT (PATRIOT ELM), 3" CALIPER, TREE FORM, BALLED AND BURLAPPED	EACH EACH EACH EACH EACH EACH EACH FOOT EACH EACH EACH EACH	137 5 5 4 5 1 2,183	5	137 5 5							
500110 X REMOV. 500120 X REMOV. 500130 X REMOV. 500130 X REMOV. 500130 X REMOV. 500130 X PAINT E 900200 X DAILL E 600600 X DETEC. 000100 X TEMPO. 502300 X REMOV. 004424 X TREE, G 005024 X TREE, G 005024 X TREE, G 005726 X TREE, F 005524 X TREE, F 005726 X TREE, F 008750 X TREE,	OVAL OF LIGHTING CONTROLLER OVAL OF ELECTRIC SERVICE INSTALLATION OVAL OF LIGHTING CONTROLLER FOUNDATION IT EXISTING TRAFFIC SIGNAL EQUIPMENT L EXISTING HANDHOLE ECTOR LOOP REPLACEMENT PORARY TRAFFIC SIGNAL INSTALLATION OVE ELECTRIC CABLE FROM CONDUIT E, GINKGO BILOBA (GINKGO), 3" CALIPER, BALLED AND BURLAPPED E, GYMNOCLADUS DIOICUS (KENTUCKY COFFEETREE), 3" CALIPER, BALLED AND BURLAPPED E, GLEDITSIA TRIACANTHOS INERMIS SKYLINE (SKYLINE THORNLESS COMMON HONEYLOCUST), 3" CALIPER, BALLED AND BUR E, PYRUS CALLERYANA CHANTICLEER (CHANTICLEER CALLERY PEAR), 3" CALIPER, TREE FORM, BALLED AND BURLAPPED E, PYRUS CALLERYANA ARISTOCRAT (ARISTOCRAT CALLERY PEAR), 3" CALIPER, TREE FORM, BALLED AND BURLAPPED E, ULMUS X PATRIOT (PATRIOT ELM), 3" CALIPER, TREE FORM, BALLED AND BURLAPPED	EACH EACH EACH EACH EACH FOOT EACH EACH EACH EACH	5 5 4 5 1 2,183	5	5 5							
Section	OVAL OF ELECTRIC SERVICE INSTALLATION OVAL OF LIGHTING CONTROLLER FOUNDATION IT EXISTING TRAFFIC SIGNAL EQUIPMENT L EXISTING HANDHOLE ECTOR LOOP REPLACEMENT PORARY TRAFFIC SIGNAL INSTALLATION OVE ELECTRIC CABLE FROM CONDUIT E, GINKGO BILOBA (GINKGO), 3" CALIPER, BALLED AND BURLAPPED E, GYMNOCLADUS DIOICUS (KENTUCKY COFFEETREE), 3" CALIPER, BALLED AND BURLAPPED E, GLEDITSIA TRIACANTHOS INERMIS SKYLINE (SKYLINE THORNLESS COMMON HONEYLOCUST), 3" CALIPER, BALLED AND BUR E, PYRUS CALLERYANA CHANTICLEER (CHANTICLEER CALLERY PEAR), 3" CALIPER, TREE FORM, BALLED AND BURLAPPED E, PYRUS CALLERYANA ARISTOCRAT (ARISTOCRAT CALLERY PEAR), 3" CALIPER, TREE FORM, BALLED AND BURLAPPED E, ULMUS X PATRIOT (PATRIOT ELM), 3" CALIPER, TREE FORM, BALLED AND BURLAPPED	EACH EACH EACH EACH FOOT EACH FOOT EACH EACH	5 4 5 1 2,183	5	5							1
Section Sect	OVAL OF LIGHTING CONTROLLER FOUNDATION IT EXISTING TRAFFIC SIGNAL EQUIPMENT IL EXISTING HANDHOLE ECTOR LOOP REPLACEMENT PORARY TRAFFIC SIGNAL INSTALLATION OVE ELECTRIC CABLE FROM CONDUIT E, GINKGO BILOBA (GINKGO), 3" CALIPER, BALLED AND BURLAPPED E, GYMNOCLADUS DIOICUS (KENTUCKY COFFEE TREE), 3" CALIPER, BALLED AND BURLAPPED E, GLEDITSIA TRIACANTHOS INERMIS SKYLINE (SKYLINE THORNLESS COMMON HONEYLOCUST), 3" CALIPER, BALLED AND BUR E, PYRUS CALLERYANA CHANTICLEER (CHANTICLEER CALLERY PEAR), 3" CALIPER, TREE FORM, BALLED AND BURLAPPED E, PYRUS CALLERYANA ARISTOCRAT (ARISTOCRAT CALLERY PEAR), 3" CALIPER, TREE FORM, BALLED AND BURLAPPED E, ULMUS X PATRIOT (PATRIOT ELM), 3" CALIPER, TREE FORM, BALLED AND BURLAPPED	EACH EACH FOOT EACH FOOT EACH EACH	4 5 1 2,183	5								
Section Sect	OVAL OF LIGHTING CONTROLLER FOUNDATION IT EXISTING TRAFFIC SIGNAL EQUIPMENT IL EXISTING HANDHOLE ECTOR LOOP REPLACEMENT PORARY TRAFFIC SIGNAL INSTALLATION OVE ELECTRIC CABLE FROM CONDUIT E, GINKGO BILOBA (GINKGO), 3" CALIPER, BALLED AND BURLAPPED E, GYMNOCLADUS DIOICUS (KENTUCKY COFFEE TREE), 3" CALIPER, BALLED AND BURLAPPED E, GLEDITSIA TRIACANTHOS INERMIS SKYLINE (SKYLINE THORNLESS COMMON HONEYLOCUST), 3" CALIPER, BALLED AND BUR E, PYRUS CALLERYANA CHANTICLEER (CHANTICLEER CALLERY PEAR), 3" CALIPER, TREE FORM, BALLED AND BURLAPPED E, PYRUS CALLERYANA ARISTOCRAT (ARISTOCRAT CALLERY PEAR), 3" CALIPER, TREE FORM, BALLED AND BURLAPPED E, ULMUS X PATRIOT (PATRIOT ELM), 3" CALIPER, TREE FORM, BALLED AND BURLAPPED	EACH EACH FOOT EACH FOOT EACH EACH	4 5 1 2,183	5								
100100 X * PAINTE 900200 X DRILL E 600600 X * DETEC' 000100 X TEMPOO 502300 X REMOV 004424 X TREE, G 005024 X TREE, G 005524 X TREE, F 0005524 X TREE, F 0005524 X TREE, F 0005524 X TREE, F 0005524 X TREE, F 0005726 X TREE, F 0005720 X REMOV 301578 X BEMOV 301578 X BEMOV 301578 X BEMOV 301578 X TREE 3022712 TREE 3022712 TREE 3022712 TREE 3022712 TREE 3022712 TREE 3022712 TREE 3022713 TREE 3022714 TREE 3022715 TREE 3022716 TREE 3022717 TREE 3022717 TREE 3022717 TREE 3022718 TREE 3022718 TREE 3022719 TREE 3022719 TREE 3022719 TREE 3022710 TR	IT EXISTING TRAFFIC SIGNAL EQUIPMENT L EXISTING HANDHOLE ECTOR LOOP REPLACEMENT PORARY TRAFFIC SIGNAL INSTALLATION OVE ELECTRIC CABLE FROM CONDUIT E, GINKGO BILOBA (GINKGO), 3" CALIPER, BALLED AND BURLAPPED E, GYMNOCLADUS DIOICUS (KENTUCKY COFFEETREE), 3" CALIPER, BALLED AND BURLAPPED E, GLEDITSIA TRIACANTHOS INERMIS SKYLINE (SKYLINE THORNLESS COMMON HONEYLOCUST), 3" CALIPER, BALLED AND BURLAPPED E, PYRUS CALLERYANA CHANTICLEER (CHANTICLEER CALLERY PEAR), 3" CALIPER, TREE FORM, BALLED AND BURLAPPED E, PYRUS CALLERYANA ARISTOCRAT (ARISTOCRAT CALLERY PEAR), 3" CALIPER, TREE FORM, BALLED AND BURLAPPED E, ULMUS X PATRIOT (PATRIOT ELM), 3" CALIPER, TREE FORM, BALLED AND BURLAPPED	EACH FOOT EACH FOOT EACH EACH	5 1 2,183	5		No. of the second second	1 3 - 10 - 10 0					
900200 X DRILL E 600600 X * DETEC 000100 X TEMPO 502300 X REMOV 004424 X TREE, G 005024 X TREE, G 004824 X TREE, G 005726 X TREE, F 005524 X TREE, F 005524 X TREE, F 005524 X TREE, F 005524 X TREE, F 005726 X TREE, F 008750 X TREE, F 008750 X REMOV 301578 X REMOV 301578 X REMOV 301578 X REMOV 301578 X TREE 322917 POPOTIL 323434 FILL EX 323574 X MAINTE 322577 X TEMPO 323434 TEMPO 326654 X ORNAM 326737 X TEMPO 326654 X ORNAM 326737 X TEMPO 326000 TEMPO 022000 TEMPO 023000 TEMPO 013798 CONSTI	L EXISTING HANDHOLE ECTOR LOOP REPLACEMENT PORARY TRAFFIC SIGNAL INSTALLATION OVE ELECTRIC CABLE FROM CONDUIT E, GINKGO BIOBA (GINKGO), 3" CALIPER, BALLED AND BURLAPPED E, GYMNOCLADUS DIOICUS (KENTUCKY COFFEETREE), 3" CALIPER, BALLED AND BURLAPPED E, GLEDITSIA TRIACANTHOS INERMIS SKYLINE (SKYLINE THORNLESS COMMON HONEYLOCUST), 3" CALIPER, BALLED AND BUR E, PYRUS CALLERYANA CHANTICLEER (CHANTICLEER CALLERY PEAR), 3" CALIPER, TREE FORM, BALLED AND BURLAPPED E, PYRUS CALLERYANA ARISTOCRAT (ARISTOCRAT CALLERY PEAR), 3" CALIPER, TREE FORM, BALLED AND BURLAPPED E, ULMUS X PATRIOT (PATRIOT ELM), 3" CALIPER, TREE FORM, BALLED AND BURLAPPED	EACH FOOT EACH FOOT EACH EACH	1 2,183			to a contract to the second of						[
600600 X * DETECTION 000100 X TEMPO 502300 X REMOV 004424 X TREE, G 005024 X TREE, G 005726 X TREE, F 005524 X TREE, F 005524 X TREE, F 005524 X TREE, F 005524 X TREE, F 006750	ECTOR LOOP REPLACEMENT PORARY TRAFFIC SIGNAL INSTALLATION OVE ELECTRIC CABLE FROM CONDUIT E, GINKGO BILOBA (GINKGO), 3" CALIPER, BALLED AND BURLAPPED E, GYMNOCLADUS DIOICUS (KENTUCKY COFFEETREE), 3" CALIPER, BALLED AND BURLAPPED E, GLEDITSIA TRIACANTHOS INERMIS SKYLINE (SKYLINE THORNLESS COMMON HONEYLOCUST), 3" CALIPER, BALLED AND BUR E, PYRUS CALLERYANA CHANTICLEER (CHANTICLEER CALLERY PEAR), 3" CALIPER, TREE FORM, BALLED AND BURLAPPED E, PYRUS CALLERYANA ARISTOCRAT (ARISTOCRAT CALLERY PEAR), 3" CALIPER, TREE FORM, BALLED AND BURLAPPED E, ULMUS X PATRIOT (PATRIOT ELM), 3" CALIPER, TREE FORM, BALLED AND BURLAPPED	FOOT EACH FOOT EACH EACH	2,183		1							
DODG	PORARY TRAFFIC SIGNAL INSTALLATION OVE ELECTRIC CABLE FROM CONDUIT E, GINKGO BILOBA (GINKGO), 3" CALIPER, BALLED AND BURLAPPED E, GYMNOCLADUS DIOICUS (KENTUCKY COFFEETREE), 3" CALIPER, BALLED AND BURLAPPED E, GLEDITSIA TRIACANTHOS INERMIS SKYLINE (SKYLINE THORNLESS COMMON HONEYLOCUST), 3" CALIPER, BALLED AND BUR E, PYRUS CALLERYANA CHANTICLEER (CHANTICLEER CALLERY PEAR), 3" CALIPER, TREE FORM, BALLED AND BURLAPPED E, PYRUS CALLERYANA ARISTOCRAT (ARISTOCRAT CALLERY PEAR), 3" CALIPER, TREE FORM, BALLED AND BURLAPPED E, ULMUS X PATRIOT (PATRIOT ELM), 3" CALIPER, TREE FORM, BALLED AND BURLAPPED	EACH FOOT EACH EACH		1				2183				1
S02300	OVE ELECTRIC CABLE FROM CONDUIT E, GINKGO BILOBA (GINKGO), 3" CALIPER, BALLED AND BURLAPPED E, GYMNOCLADUS DIOICUS (KENTUCKY COFFEETREE), 3" CALIPER, BALLED AND BURLAPPED E, GLEDITSIA TRIACANTHOS INERMIS SKYLINE (SKYLINE THORNLESS COMMON HONEYLOCUST), 3" CALIPER, BALLED AND BUR E, PYRUS CALLERYANA CHANTICLEER (CHANTICLEER CALLERY PEAR), 3" CALIPER, TREE FORM, BALLED AND BURLAPPED E, PYRUS CALLERYANA ARISTOCRAT (ARISTOCRAT CALLERY PEAR), 3" CALIPER, TREE FORM, BALLED AND BURLAPPED E, ULMUS X PATRIOT (PATRIOT ELM), 3" CALIPER, TREE FORM, BALLED AND BURLAPPED	FOOT EACH EACH	5	1			I	5	 	1		t
1004424	E, GINKGO BILOBA (GINKGO), 3" CALIPER, BALLED AND BURLAPPED E, GYMNOCLADUS DIOICUS (KENTUCKY COFFEETREE), 3" CALIPER, BALLED AND BURLAPPED E, GLEDITSIA TRIACANTHOS INERMIS SKYLINE (SKYLINE THORNLESS COMMON HONEYLOCUST), 3" CALIPER, BALLED AND BUR E, PYRUS CALLERYANA CHANTICLEER (CHANTICLEER CALLERY PEAR), 3" CALIPER, TREE FORM, BALLED AND BURLAPPED E, PYRUS CALLERYANA ARISTOCRAT (ARISTOCRAT CALLERY PEAR), 3" CALIPER, TREE FORM, BALLED AND BURLAPPED E, ULMUS X PATRIOT (PATRIOT ELM), 3" CALIPER, TREE FORM, BALLED AND BURLAPPED	EACH EACH						3	 	1		-
105024	E, GYMNOCLADUS DIOICUS (KENTUCKY COFFEETREE), 3" CALIPER, BALLED AND BURLAPPED E, GLEDITSIA TRIACANTHOS INERMIS SKYLINE (SKYLINE THORNLESS COMMON HONEYLOCUST), 3" CALIPER, BALLED AND BUR E, PYRUS CALLERYANA CHANTICLEER (CHANTICLEER CALLERY PEAR), 3" CALIPER, TREE FORM, BALLED AND BURLAPPED E, PYRUS CALLERYANA ARISTOCRAT (ARISTOCRAT CALLERY PEAR), 3" CALIPER, TREE FORM, BALLED AND BURLAPPED E, ULMUS X PATRIOT (PATRIOT ELM), 3" CALIPER, TREE FORM, BALLED AND BURLAPPED	EACH	210		210		 		 	4		-
104824	E, GLEDITSIA TRIACANTHOS INERMIS SKYLINE (SKYLINE THORNLESS COMMON HONEYLOCUST), 3" CALIPER, BALLED AND BUR E, PYRUS CALLERYANA CHANTICLEER (CHANTICLEER CALLERY PEAR), 3" CALIPER, TREE FORM, BALLED AND BURLAPPED E, PYRUS CALLERYANA ARISTOCRAT (ARISTOCRAT CALLERY PEAR), 3" CALIPER, TREE FORM, BALLED AND BURLAPPED E, ULMUS X PATRIOT (PATRIOT ELM), 3" CALIPER, TREE FORM, BALLED AND BURLAPPED		7	7						+		1
105726	E, PYRUS CALLERYANA CHANTICLEER (CHANTICLEER CALLERY PEAR), 3" CALIPER, TREE FORM, BALLED AND BURLAPPED E, PYRUS CALLERYANA ARISTOCRAT (ARISTOCRAT CALLERY PEAR), 3" CALIPER, TREE FORM, BALLED AND BURLAPPED E, ULMUS X PATRIOT (PATRIOT ELM), 3" CALIPER, TREE FORM, BALLED AND BURLAPPED	FACH	14	14					<u> </u>	4		-
05524	E, PYRUS CALLERYANA ARISTOCRAT (ARISTOCRAT CALLERY PEAR), 3" CALIPER, TREE FORM, BALLED AND BURLAPPED E, ULMUS X PATRIOT (PATRIOT ELM), 3" CALIPER, TREE FORM, BALLED AND BURLAPPED		14	13						1 1		1
08750	E, ULMUS X PATRIOT (PATRIOT ELM), 3" CALIPER, TREE FORM, BALLED AND BURLAPPED	EACH	2	2								
08750	E, ULMUS X PATRIOT (PATRIOT ELM), 3" CALIPER, TREE FORM, BALLED AND BURLAPPED	EACH	19	12						7		100
10218		EACH	6	6								
20010 * PORTL/ 30050 X * CONCR 01578 X * BEMOV 01828 ENGINE 21631 X * REMOV 21905 * STORM 22712 * STREE 22917 * PROPO 23434 * FILL EX 23574 X * MAINTE 25737 X * TEMPO 26654 X * ORNAM 26737 X * SANITA 50800 * BOLLAI 39800 X * TREE G 22000 * TEMPO 23000 *	UB, SPIREA JAPONICA LITTLE PRINCESS (LITTLE PRINCESS JAPANESE SPIREA), 18" HEIGHT, CONTAINER	EACH	13	13								
CONCR	TLAND CEMENT CONCRETE PAVEMENT (SPECIAL)	SQ YD	2,215	2215								
1578	CRETE PAVER SIDEWALK	SQYD	2,640	1801							839	
21631 X * REMOV 21905 * STORM 22712 * STREE 22917 * PROPO 23434 * FILL EX 23574 X * MAINTE 25737 X * TEMPO 26263 X * EQUIPN 26654 X * ORNAM 26737 X * SANITA 50800 * BOLLAI 39800 X * TREE G 22000 * TEMPO 23000 * TEMPO 13798 * CONSTI										-	- 000	H
21631	OVE EXISTING EQUIPMENT INFERED BARRIER	LSUM	\sim	~~~~~~~~~~~~~~~~~~~~~~~~~~~~~~~~~~~~~~	+	$\sim\sim\sim$	~~~	$+\sim\sim\sim$	+	+~~~	~~~	~
321905		SQ YD	150	haman	ture the	~~~~	150	www.		- www	$\overline{}$	\leftarrow
322712 * STREE 322917 * PROPO 323434 * FILL EX 323574 X * MAINTE 325737 X * TEMPO 326654 X * ORNAM 326737 X * SANITA 350800 * BOLLAI 503800 X * TEMPO 023000 * TEMPO 013798 * CONST	OVAL OF LUMINAIRE	EACH			2				 			+
322917	RM SEWERS, TYPE 1, WATER MAIN QUALITY PIPE, 12"	FOOT	2,453	1930			523					+
323434 * FILL EX 323574 X * MAINTE 325737 X * TEMPOI 326663 X * EQUIPN 326654 X * ORNAM 326737 X * SANITA 350800 * BOLLAI 539800 X * TEMPOI 022000 * TEMPOI 013798 * CONSTI	EET NAME SIGN	EACH	124	124					***************************************			-
323574 X * MAINTE 325737 X * TEMPO 326263 X * EQUIPN 326654 X * ORNAM 326737 X * SANITA 326737 X * SANITA 539800 X * TREE G 022000 * TEMPO 023000 * TEMPO 013798 * CONST 018500 * DRAINA	POSED STORM SEWER CONNECTION TO EXISTING MANHOLE	EACH	32	20			10				2	<u> </u>
325737 X * TEMPO 326263 X * EQUIPN 326654 X * ORNAM 326737 X * SANITA 350800 * BOLLAI 539800 X * TREE G 022000 * TEMPO 023000 * TEMPO 013798 * CONST 018500 * DRAINA	EXISTING STRUCTURES	EACH	35	35								
326263 X * EQUIPN 326654 X * ORNAM 326737 X * SANITA 350800 * BOLLAI 539800 X * TREE G 022000 * TEMPO 023000 * TEMPO 013798 * CONST 018500 * DRAINA	ITENANCE OF LIGHTING SYSTEM	CAL MO	16		16							
326654 X * ORNAM 326737 X * SANITA 350800 * BOLLAI 539800 X * TREE G 022000 * TEMPO 023000 * TEMPO 013798 * CONST 018500 * DRAINA	PORARY TRAFFIC SIGNAL TIMING	EACH	5					5				1
326737 X * SANITA 350800 * BOLLAI 539800 X * TREE G 022000 * TEMPO 023000 * TEMPO 013798 * CONST 018500 * DRAINA	PMENT CABINET	EACH	20		12							
326737 X * SANITA 350800 * BOLLAI 539800 X * TREE G 022000 * TEMPO 023000 * TEMPO 013798 * CONST 018500 * DRAINA	AMENTAL LIGHT UNIT. COMPLETE	EACH	117		117							
350800	ITARY SEWER PVC SDR 26 (WATER MAIN QUALITY), 8"	FOOT	2,233	1409			699				125	
39800 X * TREE G 22000 * TEMPO 23000 * TEMPO 13798 * CONST 18500 * DRAINA		EACH	3	3								
022000 * TEMPO 023000 * TEMPO 013798 * CONST 018500 * DRAINA		EACH	21	21				* ************************************				1
023000 * TEMPO 013798 * CONST 018500 * DRAINA	PORARY ACCESS (COMMERCIAL ENTRANCE)	EACH	60	60								
13798 * CONST 18500 * DRAINA		EACH	41	41	+							1
018500 * DRAINA	PORARY ACCESS (ROAD)						0.29				0,10	+
***************************************	STRUCTION LAYOUT	LSUM	1 04	0.61			0.29		84		V.19	1
18900 * DRILL A	INAGE STRUCTURES TO BE CLEANED	EACH	84	100 100 100 100 100 100 100 100 100 100					04	+		1
	L AND GROUT DOWEL BARS	EACH	11,598	4716			6149		 	1	733	+
	T CONTROL WATERING	UNIT	100	100								1:::
76600 * TRAINE		HOUR	2,500	1525			725			التاليات التالات	250	4
000541 * EXPLOI	LORATORY EXCAVATION	CU YD	16								16	1
00856 * MAILBO	BOX REMOVAL AND RELOCATION	EACH	6	3						3		
	CLE RACKS	EACH	12	8						4		1
	INAIRE, HIGH PRESSURE SODIUM, SPECIAL	EACH	2			2						
	JECT SIGN	EACH	8	8							a a da da b	
	UCTURES TO BE ADJUSTED	EACH	243	55			141				47	1
	PORARY ACCESS WALK	EACH	310	310								1
			60	49				 		1		1
	EPTACLE (GFI TYPE) WITH WEATHERPROOF COVER	EACH								43		+
	AMENTAL METAL FENCE	FOOT	75	32						43		+
	PLANTING MIXTURE	CU YD	346	346					 	 		+
	UNDERDRAIN CLEANOUT, COMPLETE	EACH	67	59		A 95	ļ		4	8		+
the state of the s	AMENTAL SIGN POST	EACH	100	100	_		ļ	 		4		+
05735 * PLANTI		FOOT		1769			.	 	 	374		+
	ITIONAL GROUND ROD INSTALLATION)	EACH			-153			<u> </u>		<u> </u>		1
06736 X * PLANTI		FOOT	2,143	1769						374		1
006775 X * ARCHIT	NTER FENCE (SPECIAL)	EACH	47	36						11	<u> </u>	
		EACH	126	126								
	NTER FENCE (SPECIAL)	LAUI	15	11.2						3.3		
	NTER FENCE (SPECIAL) HITECTURAL PRE-CAST CONCRETE - BENCH PLANTER SYSTEM (SPECIAL) I PANEL, FURNISHED AND INSTALLED		13	10					1	3		1
·	NTER FENCE (SPECIAL) HITECTURAL PRE-CAST CONCRETE - BENCH PLANTER SYSTEM (SPECIAL) I PANEL, FURNISHED AND INSTALLED ICRETE PLANTER WALL	CU YD	10			10				1		1
	NTER FENCE (SPECIAL) HITECTURAL PRE-CAST CONCRETE - BENCH PLANTER SYSTEM (SPECIAL) I PANEL, FURNISHED AND INSTALLED ICRETE PLANTER WALL ICRETE PLANTER WALL	CU YD EACH					 	I I I I I I I I I I I I I I I I I I I	1	105		+
	NTER FENCE (SPECIAL) HITECTURAL PRE-CAST CONCRETE - BENCH PLANTER SYSTEM (SPECIAL) I PANEL, FURNISHED AND INSTALLED ICRETE PLANTER WALL ICLE RACKS - FURNISH HITECTURAL LIGHTING SYSTEM	CU YD EACH EACH		175			 ************************************	approximately and a first first transfer of the first transfer of	The second of th			1
72G3 X * SHRUB	NTER FENCE (SPECIAL) HITECTURAL PRE-CAST CONCRETE - BENCH PLANTER SYSTEM (SPECIAL) I PANEL, FURNISHED AND INSTALLED ICRETE PLANTER WALL ICLE RACKS - FURNISH HITECTURAL LIGHTING SYSTEM NTING SOIL FURNISH AND PLACE, 24"	CU YD EACH EACH SQ YD	540	435 197						30		-
USER NAME	NTER FENCE (SPECIAL) HITECTURAL PRE-CAST CONCRETE - BENCH PLANTER SYSTEM (SPECIAL) I PANEL, FURNISHED AND INSTALLED ICRETE PLANTER WALL ICLE RACKS - FURNISH HITECTURAL LIGHTING SYSTEM	CU YD EACH EACH	540	435 197						38		

DATE - BB REVISED REVISED REVISED PLOT SCALE = 20.00000 '/ IN.
PLOT DATE = 3/11/20120

STATE OF ILLINOIS
DEPARTMENT OF TRANSPORTATION

		Y OF QU	F.A.P. RTE.	SECTION	COUNTY	TOTAL	SHEET NO.		
	SUMMAR	347	09-00248-00-RS	COOK	274	4			
					CONTRACT	NO. 6	53432		
SCALE: 1" = 20'	SHEET NO. OF	SHEETS	STA.	TO STA.	ILLINOIS FED. AID PROJECT				

1. THE STAGING PROCEDURES PRESENTED HERIN ARE THE SUGGESTED SEQUENCE OF CONSTRUCTION OPERATIONS. IT IS THE CONTRACTORS OPTION TO SUBMIT AN ALTERNATIVE STAGING PLAN TO THE ENGINEER FOR APPROVAL.

- 2. TRAFFIC CONTROL AND PROTECTION SHALL BE PERFORMED IN ACCORDANCE WITH THE TRAFFIC CONTROL PLAN AND SECTION 701 OF THE STANDARD SPECIFICATIONS 14. ALL ADVANCED WARNING SIGNS AND TEMPORARY AS AMENDED BY THE SPECIAL PROVISION FOR CONSTRUCTION ZONE TRAFFIC CONTROL LRS-3.
- 3. EXISTING TRAFFIC CONTROL SIGNS AND DEVICES WILL BE REMOVED BY THE CONTRACTOR AFTER THE PROPOSED TRAFFIC CONTROL REQUIREMENTS ARE MET OR AS AUTHORIZED BY THE ENGINEER. ANY SIGNS OR DEVICES LEFT IN PLACE AT THIS TIME ARE TO BE PROTECTED FROM DAMAGE BY THE CONTRACTOR AND ANY DAMAGE CAUSED BY THIS WORK WILL BE PAID FOR BY THE CONTRACTOR.
- 4. THE FOLLOWING TRAFFIC CONTROL STANDARDS ARE THE MINIMUM REQUIREMENTS FOR THE TRAFFIC CONTROL FOR THIS PROJECT: 701501, 701502, 701602, 701701, 701801, 701901, TC-10, TC-14, TC-22 AND TC-26.
- 5. TEMPORARY CONCRETE BARRIER, DRUMS, AND TEMPORARY PAVEMENT MARKINGS SHALL BE INSTALLED THROUGHOUT THE LIMITS OF THE WORK ZONE AS SHOWN ON THE MAINTENANCE OF TRAFFIC TYPICAL SECTIONS AND PLAN SHEETS.
- 6. THE CONTRACTOR SHALL MAINTAIN TWO-WAY TRAFFIC ON ROOSEVELT RD. THROUGHOUT THE DURATION OF CONSTRUCTION. TRUCK ACCESS TO BUSINESS SHALL BE MAINTAINED AT ALL TIMES.
- 7. THE CONTRACTOR SHALL BEGIN WORK FROM HARLEM AVE. AND PROGRESS EAST ALONG ROOSEVELT RD. TO AUSTIN BLVD.
- 8. EACH STAGE, INCLUDING THE THREE CORRESPONDING SUB-STAGES, SHALL BE COMPLETED PROIR TO STARTING THE NEXT STAGE.
- 9. THE CONTRACTOR WILL BE PERMITTED TO CLOSE A QUADRANT OF EACH SIDE STREET AT A TIME.
- 10. THE CONTRACTOR SHALL REMOVE ALL EXISTING PAVEMENT MARKINGS AND SIGNS WHEN IN CONFLICT WITH PROPOSED TEMPORARY PAVEMENT MARKINGS AND SIGNS.
- 11. WHERE THE PROPOSED WORK WILL IMPACT ALL OF THE ENTRANCES TO A PROPERTY ALL TIMES. STAGING SHALL BE COORDINATED WITH THE PROPERTY OWNER AND APPROVED BY THE ENGINEER.
- OF THE OUTSIDE SHOULDER WHERE SHOWN IN THE PLANS. SPACING SHALL BE AT 25 FOOT CENTERS ON THE TAPER SECTIONS AND AT 25 FOOT CENTERS ON TANGENTS UNLESS OTHERWISE SHOWN

MAINTENANCE OF TRAFFIC GENERAL NOTES - ALL STAGES

- 13. DRUMS SHALL BE EQUIPPED WITH STEADY BURNING LIGHTS AND PLACED AT 25 FOOT CENTERS ON TAPER SECTIONS AND AT 25 FOOT CENTERS ON TANGENT
- PAVEMENT MARKINGS SHALL BE IN PLACE AND APPROVED BY THE ENGINEER PRIOR TO THE COMMENCEMENT OF ANY STAGE OR SUBSTAGE OF CONSTRUCTION.
- 15. TRAFFIC CONTROL SHALL BE PAID FOR AS TRAFFIC CONTROL AND PROTECTION (SPECIAL).
- 16. ARROW BOARDS ARE REQUIRED FOR LANE CLOSURES AS SHOWN ON THE TRAFFIC CONTROL STANDARDS AND PLAN SHEETS. ARROW BOARDS WILL NOT BE PAID FOR SEPARATELY, BUT SHALL BE INCLUDED IN THE COST OF TRAFFIC CONTROL AND PROTECTION (SPECIAL)
- 17. WHERE THE HEIGHT DIFFERENCE BETWEEN ADJACENT PAVEMENT SURFACES EXCEEDS 1 INCH THE CONTRACTOR SHALL MILL AND/OR PLACE HMA PAVEMENT TO REDUCE THE DROP OFF TO LESS THAN 1 INCH. THIS WILL BE REQUIRED AT LOCATIONS WHERE TRAFFIC MUST CROSS THE DROP OFF SUCH AS ENTRANCES AND INTERSECTIONS, OR AS DIRECTED BY THE ENGINEER. NO MILLING OR LEVELING BINDER SHALL BE PLACED ON THE PROPOSED HMA PAVEMENT SURFACE, IT MAY BE NECESSARY TO DELAY MILLING OF THE EXISTING PAVEMENT AT THESE LOCATIONS UNTIL THE CONTRACTOR IS PREPARED TO PLACE THE PROPOSED HMA PAVEMENT. THIS WORK SHALL BE MEASURED ON A SQUARE YARD BASIS AND PAID FOR AS HMA SURFACE REMOVAL BUTT JOINT.
- TEMPORARY TRAFFIC CONTROL DEVICES SHALL BE IN DEVICES AND THE STATE STANDARD SPECIFICATIONS. THIS WORK SHALL BE INCLUDED IN THE LUMP SUM COST FOR

- 19. ALL CONFLICTING TRAFFIC SIGNS SHALL BE COVERED AS DIRECTED BY THE ENGINEER. THIS WORK SHALL NOT BE PAID FOR SEPARATELY, BUT SHALL BE CONSIDERED INCIDENTAL TO THE LUMP SUM COST FOR TRAFFIC CONTROL AND PROTECTION (SPECIAL).
- 20.ALL SIDE STREETS AND DRIVEWAYS SHALL BE MAINTAINED DURING ALL STAGES OF CONSTRUCTION, WITH THE EXCEPTION OF SHORT TERM CLOSURES FOR HOT-MIX ASPHALT PAVING. ALL CLOSURES SHALL BE COORDINATED WITH THE ENGINEER AND THE PROPERTY OWNER.
- 21. PROPOSED STORM SEWER SHALL BE CONSTRUCTED PRIOR TO PLACING THE PROPOSED HMA PAVEMENT FOR EACH STAGE. STORM SEWER PIPES THAT EXTEND ACROSS SUB-STAGES SHALL BE PLACED TO THE LIMITS POSSIBLE IN EACH SUB-STAGE AND COMPLETED PRIOR TO COMMENCING WITH THE NEXT SUB-STAGE UNLESS OTHERWISE APPROVED BY THE ENGINEER. SHORT TERM LANE CLOSURES, SUCH AS IDOT STANDARD DRAWINGS 701502 AND 701602, SHALL BE USED TO COMPLETE THE CONNECTION OF THE PROPOSED STORM SEWER PIPES TO THE EXISTING STORM SEWER SYSTEM. ONE 11 FOOT LANE MUST BE MAINTAINED IN EACH DIRECTION AT ALL TIMES EXCEPT AS NOTED IN THE MAINTENANCE OF TRAFFIC PLANS.
- 22. FINAL PAVEMENT SURFACE SHALL BE PLACED CONTINUOUSLY AFTER COMPLETING ALL THREE STAGES. PLACEMENT OF FINAL PAVEMENT SURFACE BY INDIVIDUAL STAGE WILL NOT BE PERMITTED.
- 23. PROPOSED CURB & GUTTER, SIDEWALK, AND LANDSCAPING SHALL BE PLACED PRIOR TO PLACING FINAL PAVEMENT SURFACE TO AVOID DAMAGE TO THE PAVEMENT.
- 24. THE CONTRACTOR SHALL COORDINATE ALL BUS STOP ACCOMMODATIONS WITH THE CTA TO MAINTAIN BUS ACCESS.
- 25. CONTRACTOR SHALL PROTECT PROPOSED MEDIAN ISLANDS AND DECORATIVE CROSSWALKS DURING SUBSEQUENT STAGES OF CONSTRUCTION. SURFACE OF ISLANDS AND DECORATIVE CROSSWALKS SHALL BE PROTECTED FROM CONSTRUCTION EQUIPMENT, IMPACT DAMAGE, AND MARRING BY CONSTRUCTION DEBRIS SUCH AS ASPHALT, CONCRETE, AND LANDSCAPING MATERIALS. METHOD OF PROTECTION SHALL BE APPROVED BY THE ENGINEER PRIOR TO USE. MEDIAN ISLANDS AND DECORATIVE CROSSWALKS SHALL BE STAIN FREE AT THE TIME OF ACCEPTANCE.

MAINTENANCE OF TRAFFIC SUGGESTED STAGING PLAN SUB-STAGE A (SOUTH SIDE OF ROOSEVELT ROAD)

INSTALL TEMPORARY TRAFFIC CONTROL FOR STAGE CONSTRUCT NEW LIGHT POLE FOUNDATIONS INSTALL STORM SEWER STRUCTURES AND LATERALS REMOVE AND REPLACE EXISTING SIDEWALK, CROSSWALK, AND CURB & GUTTER INSTALL LANDSCAPING

MILL EXISTING PAVEMENT AND CONSTRUCT CURB BUMP OUTS PAVE PROPOSED HMA BINDER COURSE

INSTALL PROPOSED TRAFFIC CONTROL SUB-STAGE B (CENTER OF ROOSEVELT ROAD) INSTALL TEMPORARY TRAFFIC CONTROL FOR STAGE

INSTALL/EXTEND STORM SEWER LATERALS MILL EXISTING PAVEMENT PAVE PROPOSED HMA BINDER COURSE

INSTALL PROPOSED TRAFFIC CONTROL SUB-STAGE C3 (NORTH SIDE OF ROOSEVELT ROAD)

INSTALL TEMPORARY TRAFFIC CONTROL FOR STAGE CONSTRUCT NEW LIGHT POLE FOUNDATIONS INSTALL STORM SEWER STRUCTURES AND LATERALS REMOVE AND REPLACE EXISTING SIDEWALK, CROSSWALK, AND CURB & GUTTER

INSTALL NEW LANDSCAPING MILL EXISTING PAVEMENT AND CONSTRUCT CURB BUMP OUTS

PAVE PROPOSED HMA BINDER COURSE


PROJECT COMPLETION

PAVE PROPOSED HMA SURFACE

INSTALL REMAINDER OF PROPOSED TRAFFIC CONTROL

REMOVE ALL TEMPORARY TRAFFIC CONTROL AND REOPEN ENTIRE ROADWAY

MAINTENANCE OF TRAFFIC SCHEMATIC

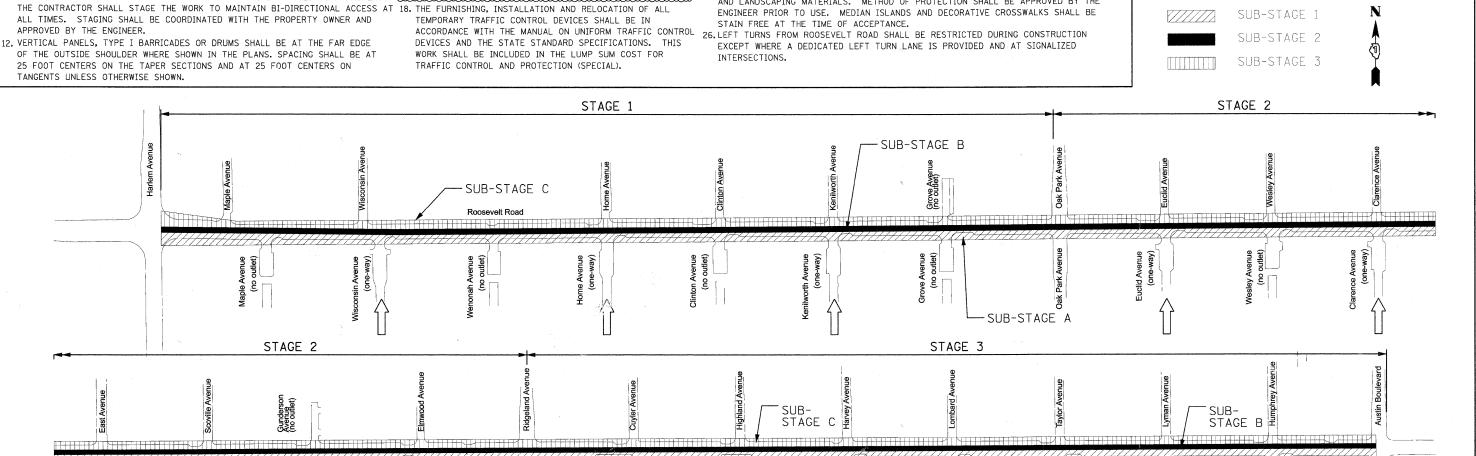

04/09/2010 2 DESIGNED - MD REVISED FILE NAME : 1RTE38-sht-staging01.dgr DRAWN REVISED CHECKED REVISED

Roosevelt Road


-SUB-STAGE A

STATE OF ILLINOIS **DEPARTMENT OF TRANSPORTATION**

MAINTENANCE OF TRAFFIC **GENERAL NOTES** SCALE: 1" = 20' SHEET NO. OF SHEETS STA.

TO STA.

TOTAL SHEE SECTION COUNTY COOK 09-00248-00-RS CONTRACT NO. 63432

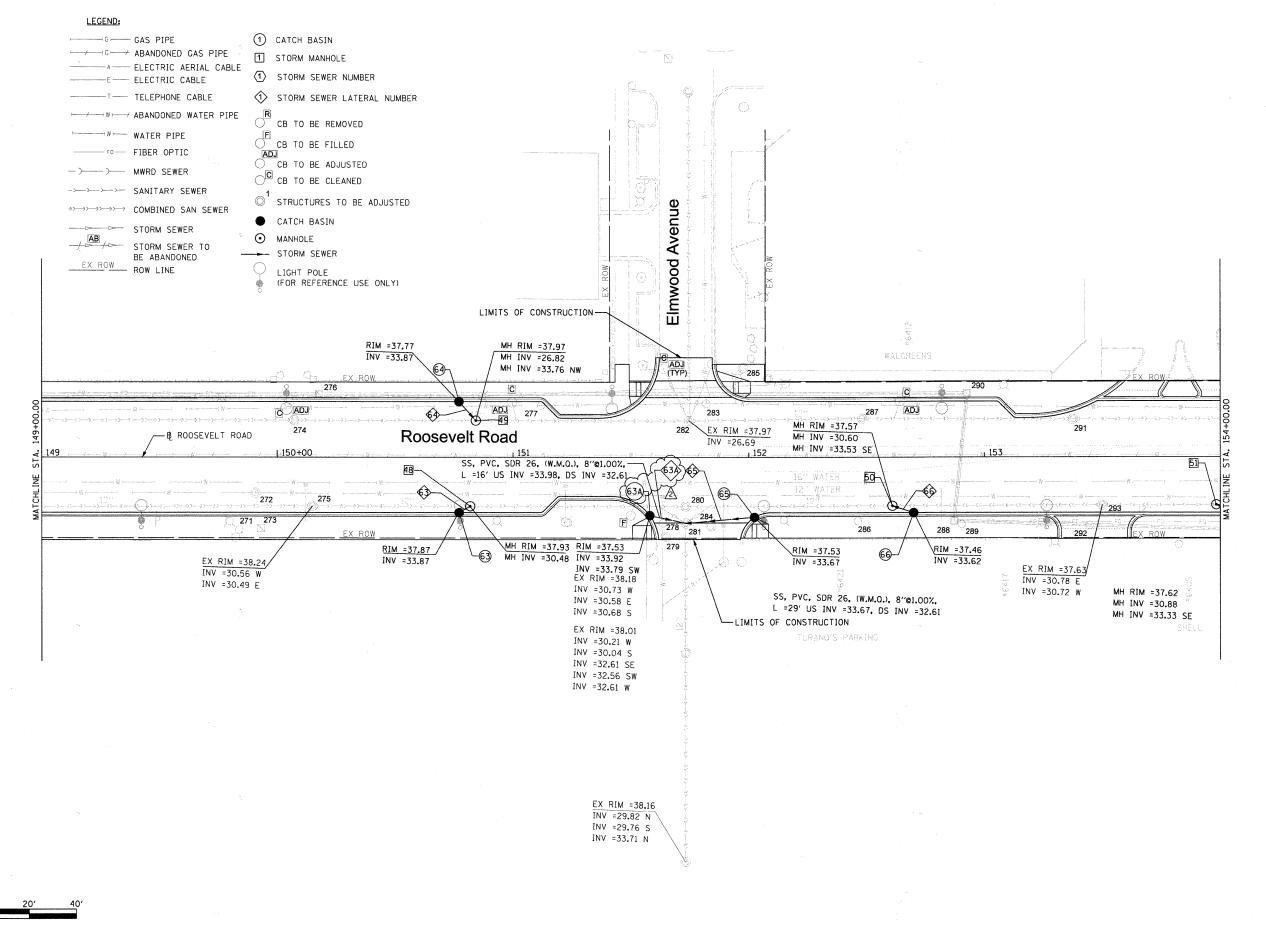

FILE NAME = DIRTE38-sht-drain10.dgn

STATE OF ILLINOIS
DEPARTMENT OF TRANSPORTATION

 DRAINAGE AND UTILITIES PLAN

 SCALE: 1" = 20' SHEET NO. 10 OF 30 SHEETS STA. 149+00.00 TO STA. 154+00.00

P. SECTION COUNTY TOTAL SHEET
7 09-00248-00-RS COOK 274 103
CONTRACT NO. 63432

ELECTRICAL NOTES

PART 1: GENERAL

A. DESCRIPTION

Provide all requirements and criteria for safety and reliability to furnish and install complete operating electrical system, including materials, labor, necessary equipment as herein specified. Comply with local codes, National Electrical Code, IDOT, and all applicable codes and standards. The equipment and installation shall confirm with the standard specifications for road and bridge construction of the Illinois Department Of Transportation including latest revision and supplemental specifications, as well as the special

B. Scope of Work

- 1. Contractor shall furnish, install, and test complete street lighting system with all lighting poles, luminaries, foundations, lighting control cobinet, conduits, hangers, supports, devices, wiring, etc., required for a complete and operational installation. After installation, contractor shall completely test all components in compliance with IDOT standards to ensure complete functional installation.
- 2. The work shall be performed in accordance with the rules and regulations set forth in the local governing code. The work shall also meet the laws and ordinance required by those agencies having jurisdiction.
- Contractor shall visit the site and make himself thoroughly familiar with existing conditions. Prior to submitting the proposal, include any relocation and/or alternations to the existing electrical system, components or equipment required to accommodate the new
- 4. Contractor shall obtain all permits required to perform his work. Prepare and submit to the authorities any and all data, drawings and details required for approva: before commencing the installation.
- 5. Mcintain existing street lighting system operation during construction until new construction of street lighting system is completed. Maintain existing lighting as temporary lighting during the construction period. Remove same upon completion of the project
- 6. Contractor shall coordinate work with all trades and avoid conflicts and delays.
- Notify the engineer in writing of any discrepancies between the existing conditions and the new work. Lack of notification shall indicate that no discrepancies or conflicts exist.
- 8. All light poles shall be non-breakaway type.

TAG

F1

F2

DESCRIPTION

METAL HALIDE FIXTURE ON 27 FT. POLE WITH PEDESTRIAN ARM

METAL HALIDE FIXTURE ON 30 FT. POLE WITH PEDESTRIAN ARM

- 9. Contractor shall coordinate work with utility companies, including electric, water, gas, sewer, cable, etc.
- 10. Rigid Steel Conduit shall be pushed under street or driveway and extended 3'-0" on each side.
- 11. As part of this work Owner shall have first salvage rights to any item removed as part of this project. Dispose of all others. Any unused equipment or wiring will not be allowed to be abandoned in place.
- 12. Red tape or marking shall be 10" below grade to mark electrical conduit routing.
- After construction of new system remove old lighting poles, foundation and wiring.
 Abandon in place the conduit system.
- 14. The contractor shall be responsible for damage incurred by him in any area of the project such as pavement, driveways, and sidewalks and shall restore them to their original condition as directed by the engineer. Landscaped areas shall be restored and damaged plant materials replaced to the satisfaction of the engineer.
- 15. Lighting poles shall be located to provice unobstructed access to pedestrians

MANUFACTURER

STERNBERG-OMEGA

STERNBERG-OMEGA

16. Contractor is responsible to identify all underground and overhead utility conflicts and ensure adequate clearances between utilitiés and new lighting system.

MOG/ED28-MHP70/MED/BK
ANTIQUE STREET LAMP EM17RT-70M-MOD-GCF-SR2-240/

MOG/ED28-MHP70/MED/BK
ANTIQUE STREET LAMP EM17RT-70M-MOD-GCF-SR2-240/

foundation payitems. Refer to electrical details of cabinets and/or pole foundation for more informati

CATALOG NUMBER

2-1527RFG/OD/70MHP/RO2H-L/OF/

EM25RT-250M-MOG-GCF-SR3-240/

-1527RFG/OD/70MHP/RO2H-L/OF/

50MHP240/R03H-L/MHP250/

EM25RT-250M-MOG-GCF-SR3-240/

LIGHTING UNIT SCHEDULE

NO.

TYPE

250W METAL

(STREET LIGHT

(PEDESTRIAN)

250W METAL HALIDE

(STREET LIGHT

70W METAL HALIDE (PEDESTRIAN)

70W METAL

WATTS

(240V)

C. <u>Guarantee</u>

- 1. Guarantee in writing all electrical equipment for a period of one year following date of substantial completion. State the additional amount for a five year full guarantee and full maintenance contract of electrical system.
- 2. All apparatus shall be built and installed so as to deliver its full rated capacity at the efficiency for which it was designed.

D. Construction Phase Submittals

Submit shop drawings to the engineer for approval. Prepare and provide the engineer with a complete set of circuited "record" drawings at project completion. Such drawings shall be submitted on a clear and legible reproducible form.

PART 2: PRODUCTS

A. Quality Level

All material and equipment used for this project shall be UL listed and approved for the intended applications unless otherwise noted.

B. Material

- Unit duct shall be Type MC 600 volt, EPR rated insulation, PVC jacket, Steel interlock armor,
- Site lighting branch circuits shall be #4 AWG minimum, unless otherwise noted. Control wiring shall be #14 AWG minimum.

PART 3: EXECUTION

- Provide a complete properly operating system for each item of equipment called for under this notes. Install in accord with the equipment manufacturer's instructions, the best industry practices and under competent supervision at all time.
- 2. Prior to inspection to determine substantial completion the contractor shall operate all electrical system to demonstrate that the installation and performance of the system conform to the requirements specified above and on the drawings.

LEGEND

- Existing street light
- Proposed 27'-0" street light 250W Metal Halide at 240V with 3' pedant arm at 27' high for roadway, & 70W Metal Halide at 240V with 1' pedant arm at 15' high for sidewalk.
- Proposed 30'-0" street light 250W Vetal Halide at 240V with 3' pedant arm at 30' high for roadway, & 70W Metal Halide at 240V with 1' pedant arm at 15' high for sidewalk.
- Controller, 100A, 240/480V, 1PH, 3W

POLE & BASE

- Conduit, pushed, rigid galvanized steel 3'-0" below grade, extend 3'-0" on each side of the curb
- 3" galvanized steel conduit 3'-0" below grade
- Unit duct (Refer to plan for exact size).
- \bowtie_{ER} Existing street light to be removed (light pole and foundation)
- Fixture type
 - Proposed vandal proof receptacle (Weatherproof and Ground Fault Interrupter) UL listed, corrosion resistant and cover NEC 406.8.B.2a compliant
- ---
 - Weatherproof, corrusion resistant cabinet. Refer to detail for more information.


PANEL	CIRCUIT NUMBER	SIZE OF BREAKER	NO. OF LTG FIXTURE	(AT 240V)	(AT 240V)
	A	50A, 240V	(5) 340W	1700VA	/////////
A1	В	50A, 240V	(5) 340W	1////////	1700VA
(BERWYN)	C	50A, 240V	(6) 340W	2040VA	
100A, 240/480V, 1PH, 3W	D	50A, 240V	(6) 340W	7////////	2040VA
1111, 51	E,F,G,H	50A, 240V	SPARE.		
			SUBTOTAL	3740VA	3740VA
		CABINET A1	TOTAL LOAD (480V, 1PH)	7480VA*,	15.6A
	A	50A, 240V	(6) 340W	2040VA	7////////
A2 .	В	50A, 240V	(5) 340W	1////////	1700VA
(BERWYN)	С	50A, 240V	(10) 340W	3400VA	
100A, 240/480V,	D	50A, 24CV	(11) 340W	1///////	3740VA
1PH, 3W	E,F,G,H	50A, 24CV	SPARE		
			SUBTOTAL	5440VA	5440VA
		CABINET A2	TOTAL LOAD (480V, 1PH)	10880VA,	22.7A
B† (CICERO)	В	50A, 240V	SERVE EXISTING LIGHTING (EAST OF AUSTIN)		2700VA
(CICERO) 100A. 240/480V.	С	50A, 240V	(4) 340W	1360VA	
100A, 240/480V. 1PH, 3W	D	50A, 240V	(5) 340W		1700VA
	A,E,F,G,H	50A, 240V	SPARE		
	·		SUBTOTAL	1360VA	4400VA
		CABINET B1	TOTAL LOAD (480V, 1PH)	5760VA, 1	2A
	A	50A, 240V	(5) 340W	1700VA	
C1	В	50A, 240V	(6) 340W		2040VA
(OAK PARK) 100A, 240/480V,	С	50A, 240V	(6) 340W	2040VA	
1PH, 3W	D	50A, 240V	(6) 340W		2040VA
,	E,F,G,H	50A, 240V	SPARE		
			SUBTOTAL	3740VA	4080VA
		CABINET C1	TOTAL LOAD (480V, 1PH)	7820VA*,	16.3A
	A	50A, 24CV	(7) 340W	2380VA	V////////
C2	В	50A, 240V	(6) 340W	1/////////	2040VA
(OAK PARK)	C	50A, 24CV	(4) 340W	1360VA	77777777
100A, 240/480V,	D	50A, 240V	(4) 340W	7////////	1360VA
1PH, 3W	E,F,G,H	50A, 240V	SPARE		
7 1			SUBTOTAL	3740VA	3400VA
		CABINET C2	TOTAL LOAD (480V, 1PH)	7140VA*,	14.9A
	A	50A, 240V	(5) 340W	1700VA	V////////
C3	В	50A, 240V	(5) 340W	1//////////////////////////////////////	1700VA
(OAK PARK)	С	50A, 240V	(5) 340W	1700VA	77777777
100A, 240/480V,	D	50A, 240V	(5) 340W	///////////////////////////////////////	1700VA
1PH, 3W	E,F,G,H	50A, 240V	SPARE	<i>\/////////</i>	V///////
			SUBTOTAL	3550VA	3400VA
Y 91		CABINET C3	TOTAL LOAD (480V, 1PH)	6950VA, 1	
	L	TACLE LOAD IS INCL			


ELECTRICAL LOAD SCHEDULE

*120V RECEPTACLE LOAD IS INCLUDED

Pole Identification

- C1 Control cabinet number
- Circuit number 1 Pole number of the circuit
- $^{\star}\text{All}$ poles shall be offset 1.9 ft from back of curb to centerline of pole, unless roadway has bump—outs.
- *All poles in bump—outs areas shall be offset from back of curb to centerline of pole as required to be inline with other poles.
- *All poles shall have the same offset from the roadway centerline to maintain visual alignment.
- New foundation and poles shall be located away from any existing utilities. Contractor shall identify all utilities and dig by hand to expose utility lines. Final exact location of foundation and pole shall be coordinated and approved prior to installation.

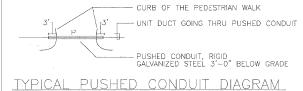

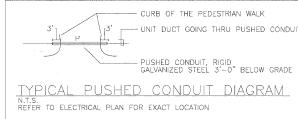

			TERR	225 W. 0	HIO ST.		
)				Thrones,		<u></u>	
HT)	340	1.42	STRATFORD 22/32/A/ RSS/DBA/RSB4/BK WITH STRATFORD BASE COMPLETE ASSEMBLY N99-B483 (30FT)	(REFER TO DETAIL FOR EXACT MOUNTING OF FIXTURES)	CWA	240	OD SINGLE ARM FOR PEDESTRIAN OF SINGLE ARM FOR STREET
)			COMPLETE ASSEMBLY N99-B483 (27FT)	MOUNTING OF FIXTURES)			
IT)	340	1.42	STRATFORD 22/30/A/ RSS/DBA/RSB4/BK WITH STRATFORD BASE	(REFER TO DETAIL FOR EXACT	CWA	240	OD SINGLE ARM FOR PEDESTRIAN OF SINGLE ARM FOR STREET

	ENGINEERING LTD.
09/2010 🛕	
	STATE OF
	DEDARTMENT OF

225 W. OHIO ST., FOURTH FL. CHICAGO, IL 60654 (312)467 - 0123

BALLAST VOLT

STATE OF ILLINOIS	ELECTRI
DEPARTMENT OF TRANSPORTATION	
	SCALE: 1" = 20"

											221	10 217		
							AND ELECTRICAL LOAD COUEDING				SECTION	COUNTY	TOTAL SHEETS	SHEET NO.
RICAL NOTES, LEGEND AND ELECTRICAL LOAD SCHEDULE						347	09-00248-00-RS	COOK	274	221				
												CONTRACT	T NO. 6	3432
20'	SHEET	NO.	1	OF	29	SHEETS	S STA.		TO STA.		ILLINOIS FED. A	ID PROJECT		

Exp 11/30/201

For Elec. Sheets

FILE NAME = DESIGNED - EE REVISED 04/0 USER NAME = IDOT D1RTE38-sht-lightØ1.dgn DRAWN REVISED PY CHECKED JB REVISED LOT DATE = 4/8/2010 DATE REVISED