

MODEL: Default
FILE: M:\11616 - Sangamon dot.illinois.gov\PIVDOT\Documents\DOT_Offices\District 8\Projects\06721671\CAD\data\CADsheets\06721671-811-500.dgn

				90% FED 10% STATE	084-0014 & 0015	084-0016 & 0017	084-0018 & 0019
					PPS: 6-00597-0000		PPS: 6-00597-0100
CODE			TOTAL		BRIDGE	BRIDGE	BRIDGE
					0059	0059	0059
					URBAN	URBAN	URBAN
50800205	REINFORCEMENT BARS, EPOXY COATED	POUND	9030		5020	4010	
50800515	BAR SPLICERS	EACH	48		24	24	
51100100	SLOPE WALL 4 INCH	SQ YD	7			7	
52000110	PREFORMED JOINT STRIP SEAL	FOOT	690		284	406	
64200116	SHOULDER RUMBLE STRIP	FOOT	7554		2671		4883
* 63000001	STEEL PLATE BEAM GUARDRAIL, TYPE A, 6 FOOT POSTS	FOOT	1235		425	810	
* 63100045	TRAFFIC BARRIER TERMINAL, TYPE 2	EACH	3		3		
* 63100070	TRAFFIC BARRIER TERMINAL, TYPE 5	EACH	2			2	
* 63100085	TRAFFIC BARRIER TERMINAL, TYPE 6	EACH	4		2	2	
* 63100167	TRAFFIC BARRIER TERMINAL, TYPE 1 (SPECIAL) TANGENT	EACH	6		4	2	
63200310	GUARDRAIL REMOVAL	FOOT	1554		519	1036	
67000400	ENGINEER'S FIELD OFFICE, TYPE A	CAL MO	9		3	3	3
67100100	MOBILIZATION	L SUM	1		0.33	0.33	0.34
70100207	TRAFFIC CONTROL AND PROTECTION, STANDARD 701402	EACH	4		1	1	2
70100310	TRAFFIC CONTROL AND PROTECTION, STANDARD 701421	L SUM	1		1		
70100420	TRAFFIC CONTROL AND PROTECTION, STANDARD 701411	EACH	8		6		2

* SPECIALTY ITEM


△ REVISED 4-5-2021

REV. - MS


F.A.I RTE.	SECTION	COUNTY	TOTAL SHEETS	SHEET NO.
55	(84-2)BDR,(84-2-2)BDR-1	SANGAMON	94	4
CONTRACT NO. 72L67				
ILLINOIS FED. AID PROJECT				

STATE OF ILLINOIS DEPARTMENT OF TRANSPORTATION	SUMMARY OF QUANTITIES			
SCALE:	SHEET 2	OF 5	SHEETS	STA. TO STA.


USER NAME = EDWARDSJD	DESIGNED -	REVISED -
DRAWN -	REVISD -	
PLOT SCALE = 100.0000 ' / in.	CHECKED -	REVISED +
PLOT DATE = 12/18/2020	DATE -	REVISED +

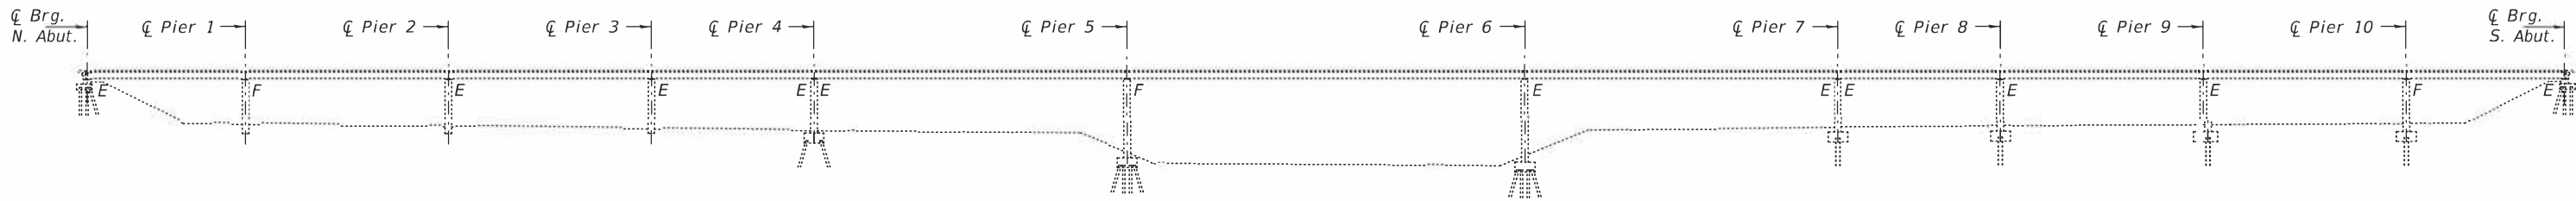

ELEVATION

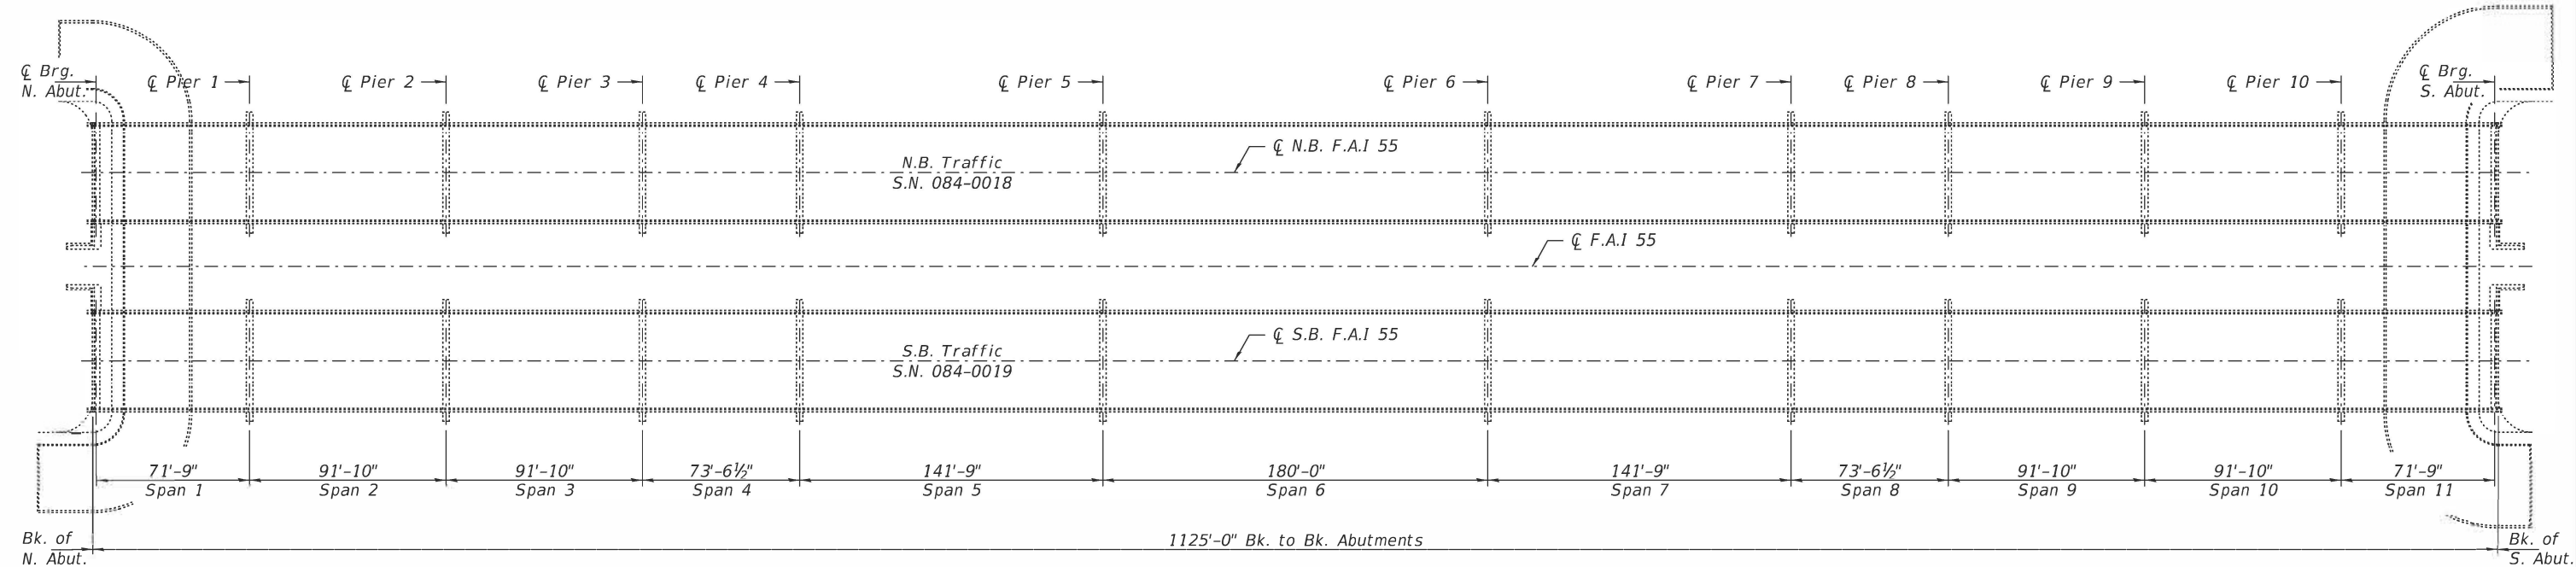

PLAN

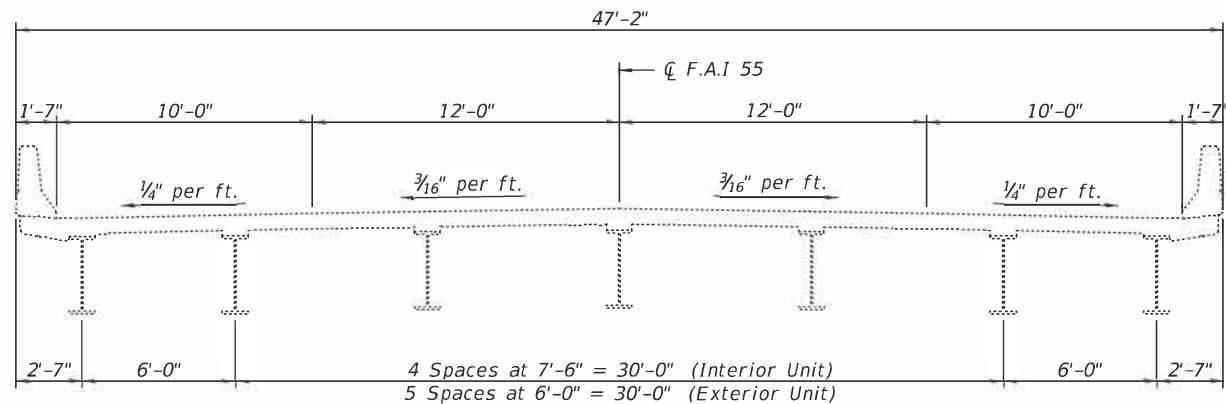

CROSS SECTION

(084-0018 Looking South)
(084-0019 Looking South)

Note:
Refer to roadway plans for staging information.

GENERAL NOTES

Areas of deck repairs shown are estimated. The Engineer shall show actual locations of deck repairs on As-built Plans.

Plan dimensions and details relative to existing plans are subject to nominal construction variations. The Contractor shall field verify existing dimensions and details affecting new construction and make necessary approved adjustments prior to construction or ordering of materials. Such variations shall not be cause for additional compensation for a change in scope of the work, however, the Contractor will be paid for the quantity actually furnished at the unit price bid for the work.

Work to be completed under road closure.

Bridge Deck Concrete Sealer shall apply to the deck slab repaired area only.

TOTAL BILL OF MATERIAL

ITEM	UNIT	QUANTITY
Deck Slab Repair (Partial)	Sq. Yd.	1000
Deck Slab Repair (Full Depth, Type II)	Sq. Yd.	100
Bridge Deck Concrete Sealer	Sq. Ft.	11250
Joint Sealing (Patches)	Foot	1250

REV. - MS

REVISD 4-5-2021

EXPIRES 11-30-2022

DESIGNED - Chi-Cheung Chau	EXAMINED - <i>Twing A. Dett</i>	DATE - JANUARY 31, 2021	STATE OF ILLINOIS DEPARTMENT OF TRANSPORTATION	GENERAL PLAN AND ELEVATION FAS 55 OVER SANGAMON RIVER SN 084-0018 (NB) & 0019 (SB)	SHEET NO. 1 OF 7 SHEETS	F.A.I. RTE.	SECTION	COUNTY	TOTAL SHEETS	SHEET NO.
CHECKED - Stephen M. Ryan	ENGINEER OF STRUCTURAL SERVICES	REVISD -				55	(84-2)BDR, (84-2-2)BDR-1	SANGAMON	94	81
DRAWN - Venkat Reddy	PASSED - <i>Sh. Carl Pappas</i>	REVISD -				CONTRACT NO. 72L67				
CHECKED - CCC SMR	ENGINEER OF BRIDGES AND STRUCTURES					ILLINOIS FED. AID PROJECT				