


SHEET NO 48

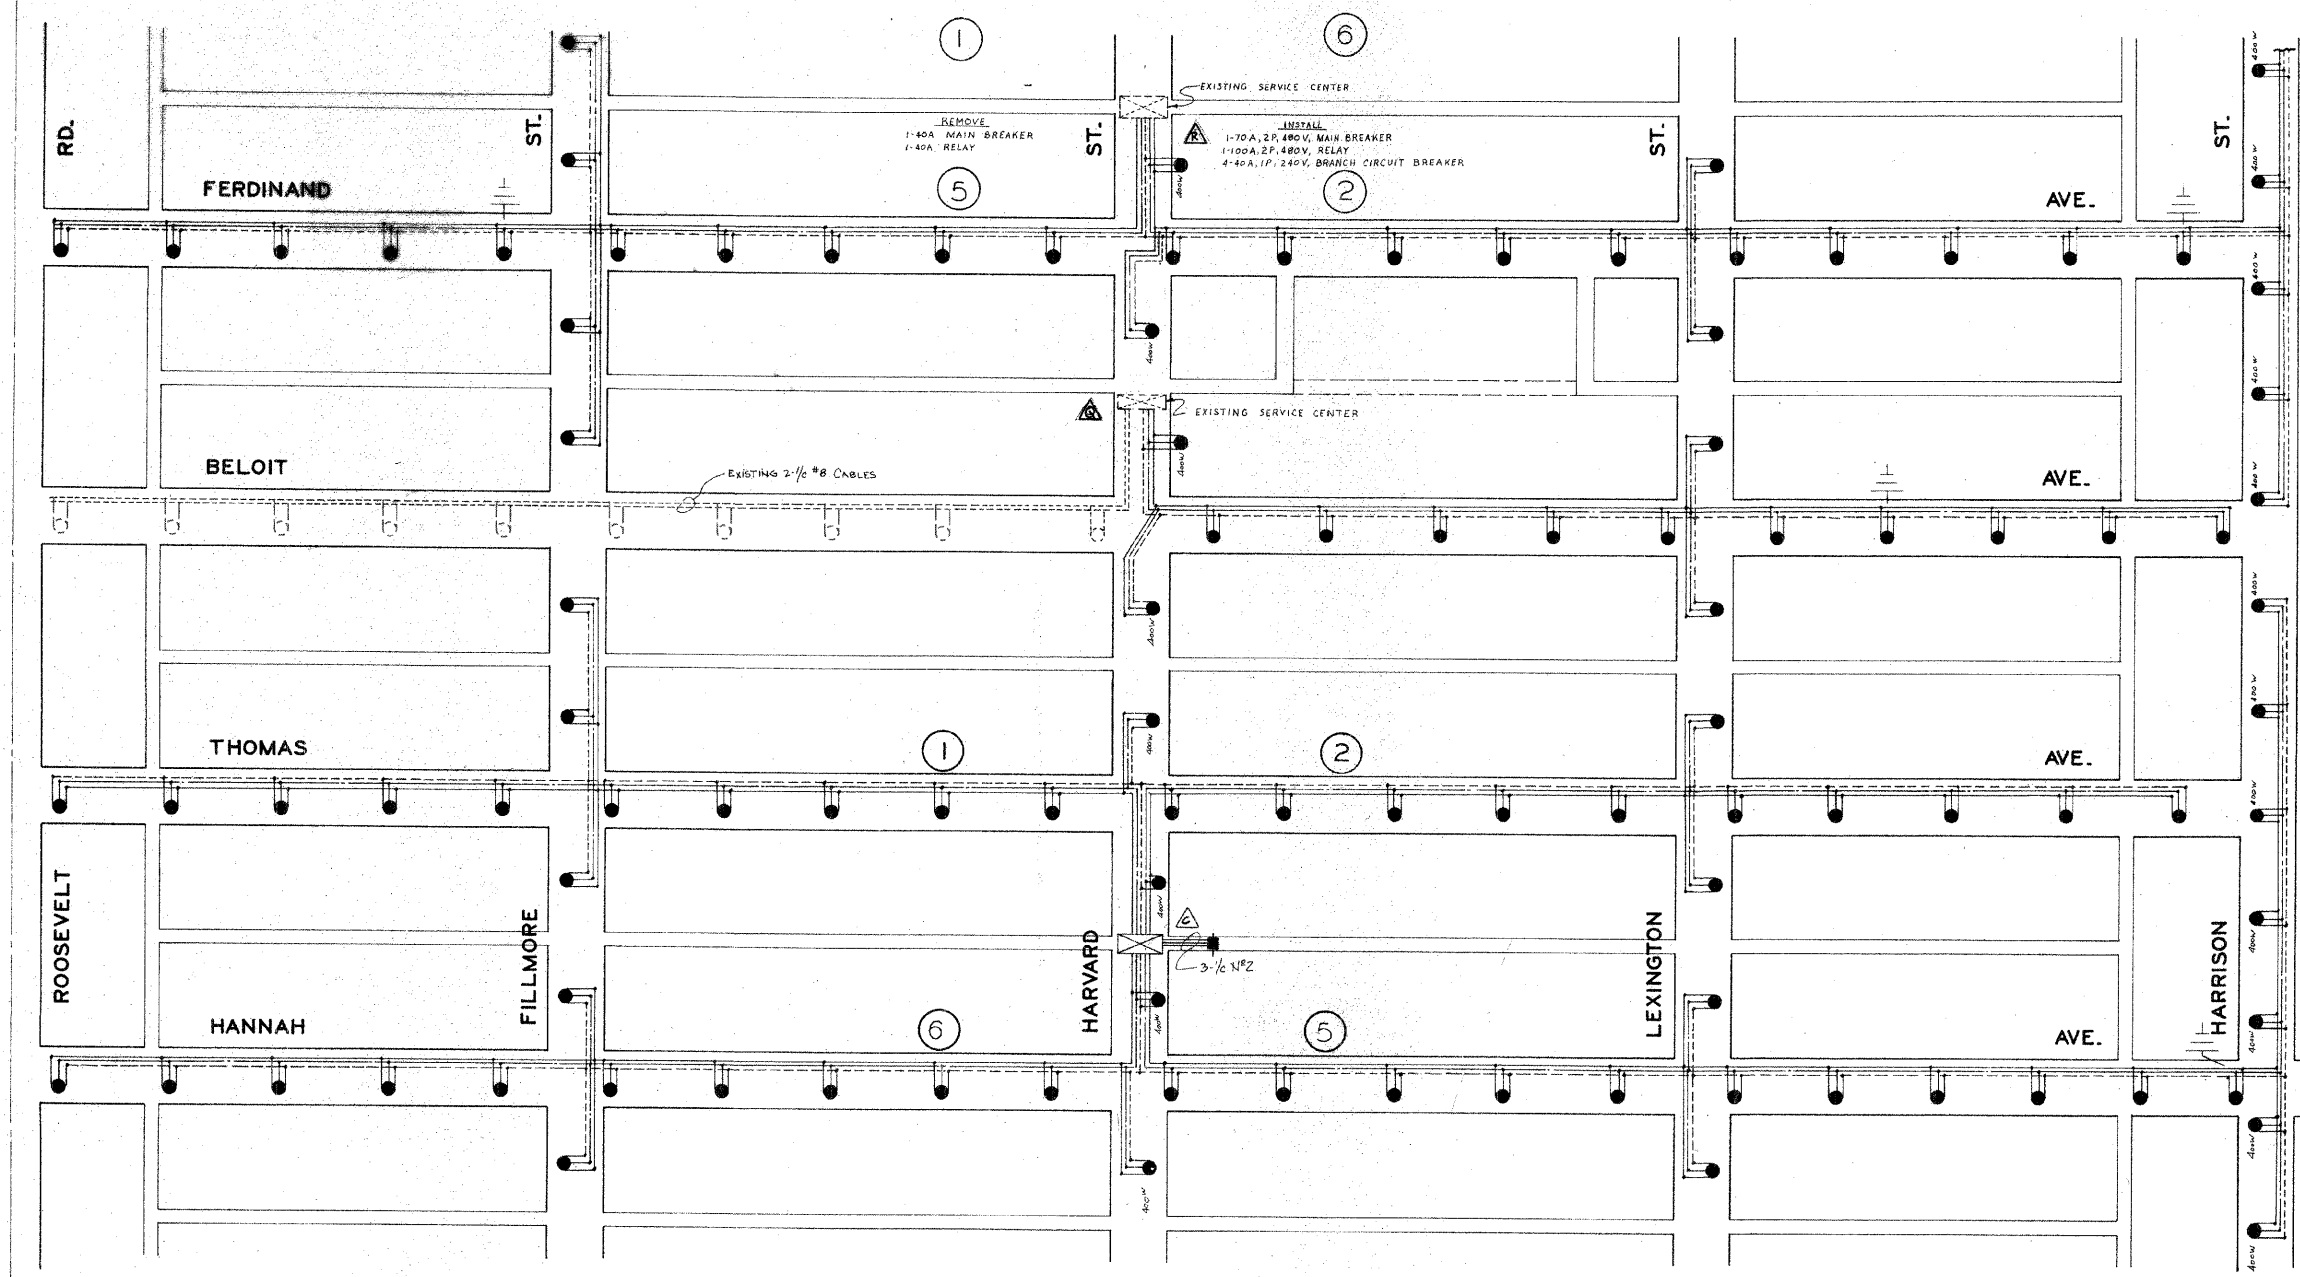

SHEET NO 46

WIRING DIAGRAM

STREET LIGHTING IMPROVEMENT PROJECT

REVISIONS DATE BY 11/1/75 MK AS BUILT		DRAWN BY COMB CHECKED BY APPROVED BY DATE 2-14-74 SCALE 1" = 100' SHEET NO. 47 OF 56 SHEETS
FOREST PARK, ILL. EDWIN HANCOCK ENGINEERING CO. CONSULTING ENGINEERS 7521 MADISON ST. FOREST PARK, ILL. 60130		BOOK NO. 804-809 FIELD NOTES MK COUNTY COOK TOTAL SHEETS 75 SHEET NO. 49

FILE NAME =	USER NAME = JBARNETT	DESIGNED -	REVISED -
Na\FORSTPARK\070082\Mech\REC.070082.05.SHT		DRAWN -	REVISED -
PLOT SCALE = 20'		CHECKED -	REVISED -
PLOT DATE = 2/18/2009		DATE -	REVISED -

STATE OF ILLINOIS
DEPARTMENT OF TRANSPORTATION

ROADWAY LIGHTING IMPROVEMENTS - HARVARD ST.
EXISTING CIRCUIT DIAGRAM (2 OF 2) RECORD DRAWING

F.A.U. RTE. 1702	SECTION 07-00106-00-PV	COUNTY COOK	TOTAL SHEETS 75	SHEET NO. 49
CONTRACT NO. 63148			FED. ROAD DIST. NO. 1 ILLINOIS FED. AID PROJECT	