


FOR INFORMATION ONLY

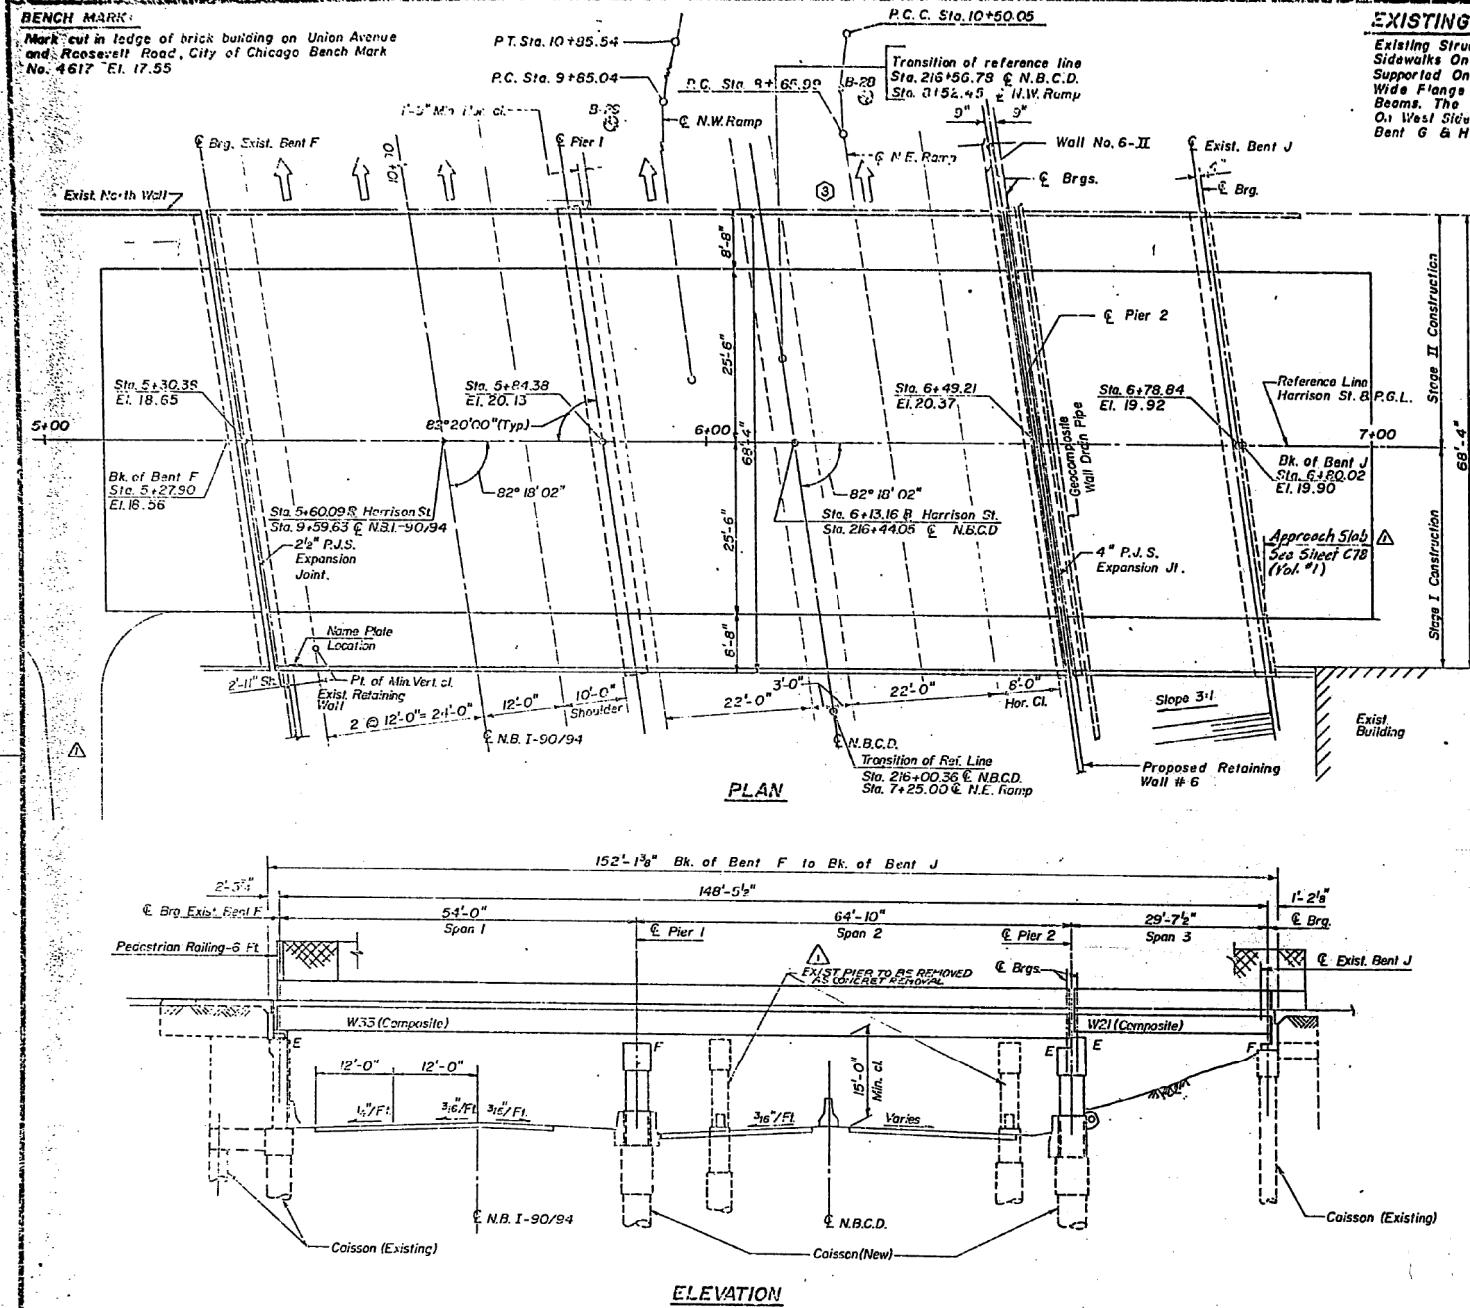

EXISTING STRUCTURE
 Existing Structure No. 016-1088 is 68'-4" Wide With 8'-0" Sidewalks On Each Side. The Deck is A Concrete Slab Supported On Two Span 66'-10" & 40'-9" Continuous Steel Wide Flange Beams And A 40'-0" Single Span Concrete Beam. The Substructure Consists Of A Closed Abutment On West Side, Dam F, Two Multiple C. Line Girders Center Bent G & H And A Copped Abutment On East Side, Bent J

DATE	10/94	BY	CDM
DATE	11/94	BY	CDM
DATE	12/94	BY	CDM

MAJOR WORK ITEMS:
 Remove and replace existing Superstructure and Piers. Rehabilitate Bent F & Bent J. No salvage value.
 Traffic is to be maintained during construction.


TOTAL BILL OF MATERIAL

ITEMS	UNIT	SUPER	SUBC	TOTAL
Removal of Existing Superstructure	L. Sum	68		68
Concrete Removal	Cu. Yd.		113.5	113.5
Expansion Bolts (3/4" x 6")	Each		222	222
Structure Excavation	Cu. Yd.		364	364
Protective Coat	Sq. Yd.	1217	25	1242
Class X Concrete	Cu. Yd.		341.4	341.4
Furnishing and Erecting Structural Steel	L. Sum	15		15
Stud Shear Connectors	Each	5,520		5,520
Reinforcement Bars	Pound		52,280	52,280
Reinforcement Bars (Epoxy Coated)	Pound	47,510		47,510
Elastomeric Bearing Assembly Type I	Each	36		36
Pedestrian Railing - 6 Ft.	Ln. Ft.	344		344
Formed Concrete Repair (Depth > 1 1/2")	Sq. Ft.		150	150
Epoxy Crack Sealing	Ln. Ft.		20	20
Name Plates	Each	1		1
Preformed Joint Seal, 2 1/2"	Ln. Ft.	71		71
Preformed Joint Seal, 4"	Ln. Ft.	71		71
Caisson Shafts, 36" x 6"	Cu. Ft.		2,190	2,190
Caisson Bells	Cu. Ft.		882	882
Protective Shield	Sq. Yd.	2,140		2,140
Geocomposite Wall Drain	Sq. Yd.		65	65
Class X Concrete Superstructure	Cu. Yd.	364		364
Pipe Underdrain - Perf. Corrugated - 6"	Ln. Ft.		115	115

① Substructure quantities also include Retaining Wall # 6.

STATION 5+60.09
 REBUILT 198 BY
 STATE OF ILLINOIS
 HARRISON STREET SEC.
 F.A. PROJ. 102-94-3(268)
 LOADING HS 20
 STR. NO. 016-1088

NAME PLATE
 (See Std. 2113)

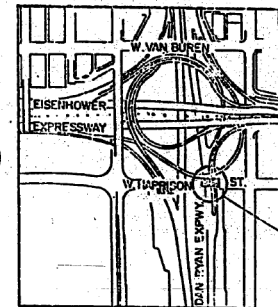

DESIGN CRITERIA
 DESIGN SPECIFICATIONS:
 A.A.S.H.T.O. 1983 Standard Specifications For Highway Bridges & 1984 & 1985 Interims.

DESIGN CRITERIA:
 Live Load: HS 20-44 & Alternate
 Sidewalk Live Load: 60 Lbs./S.F.
 Soil Pressure: 40 #/C.F. Equivalent Fluid Pressure
 Allowable Bearing Pressure For Caisson = 12 Kips/S.F.
 Allow 25 / Sq Ft. For Future Wearing Surface.

DESIGN STRESSES

Concrete	f _c = 3,500 PSI	Proposed Structure
Reinforcing Steel (Grade 60)	F _y = 60,000 PSI	
Structural Steel (M 223) GR 50	F _y = 50,000 PSI	Proposed Structure
(M 183)	F _y = 36,000 PSI	
Concrete	f _c = 1,400 PSI	Existing Structure
Reinforcing Steel	f _s = 20,000 PSI	

LEGEND
 ⊙ Proposed Soil Boring
 △ Existing Structure

SHEET S-1 OF S-17

STATE OF ILLINOIS
 DEPARTMENT OF TRANSPORTATION
 F.A. ROUTE 90/94 (DAN RYAN EXPRESSWAY)
 SECTION 1985-080 R - COOK COUNTY
 HARRISON STREET OVER DAN RYAN EXPRESSWAY
 GENERAL PLAN & ELEVATION
 S.N. 016-1088

Scale: None
 Date: AUGUST 14, 1997
 Drawn By: S.D.D.
 Checked By:

ENVIRONMENTAL ENGINEERS INC.
 Chicago, Illinois

REVISIONS	Name	Date
①	Revision	3-11-88

APPROVED
 James J. Boyle
 P.G. ENGINEERING ASSOCIATES, INC.
 603 WEST JACKSON BLVD.
 CHICAGO, ILLINOIS, 60606

USER NAME = dunkerleyb	DESIGNED -	REVISED
	CHECKED -	REVISED
PLOT SCALE = N.T.S.	DRAWN -	REVISED
PLOT DATE = 11/26/2013	CHECKED -	REVISED

STATE OF ILLINOIS
 DEPARTMENT OF TRANSPORTATION

EXISTING AS-BUILTS SN 016-1088

SHEET NO. AS-04 OF AS-72 SHEETS

F.A.I. R.T.E.	SECTION	COUNTY	TOTAL SHEETS	SHEET NO.
90/94/290	2013-036R	COOK	256	146
CONTRACT NO. 60W71				

ILLINOIS FED. AID PROJECT -NUMBER-