


FOR INFORMATION ONLY

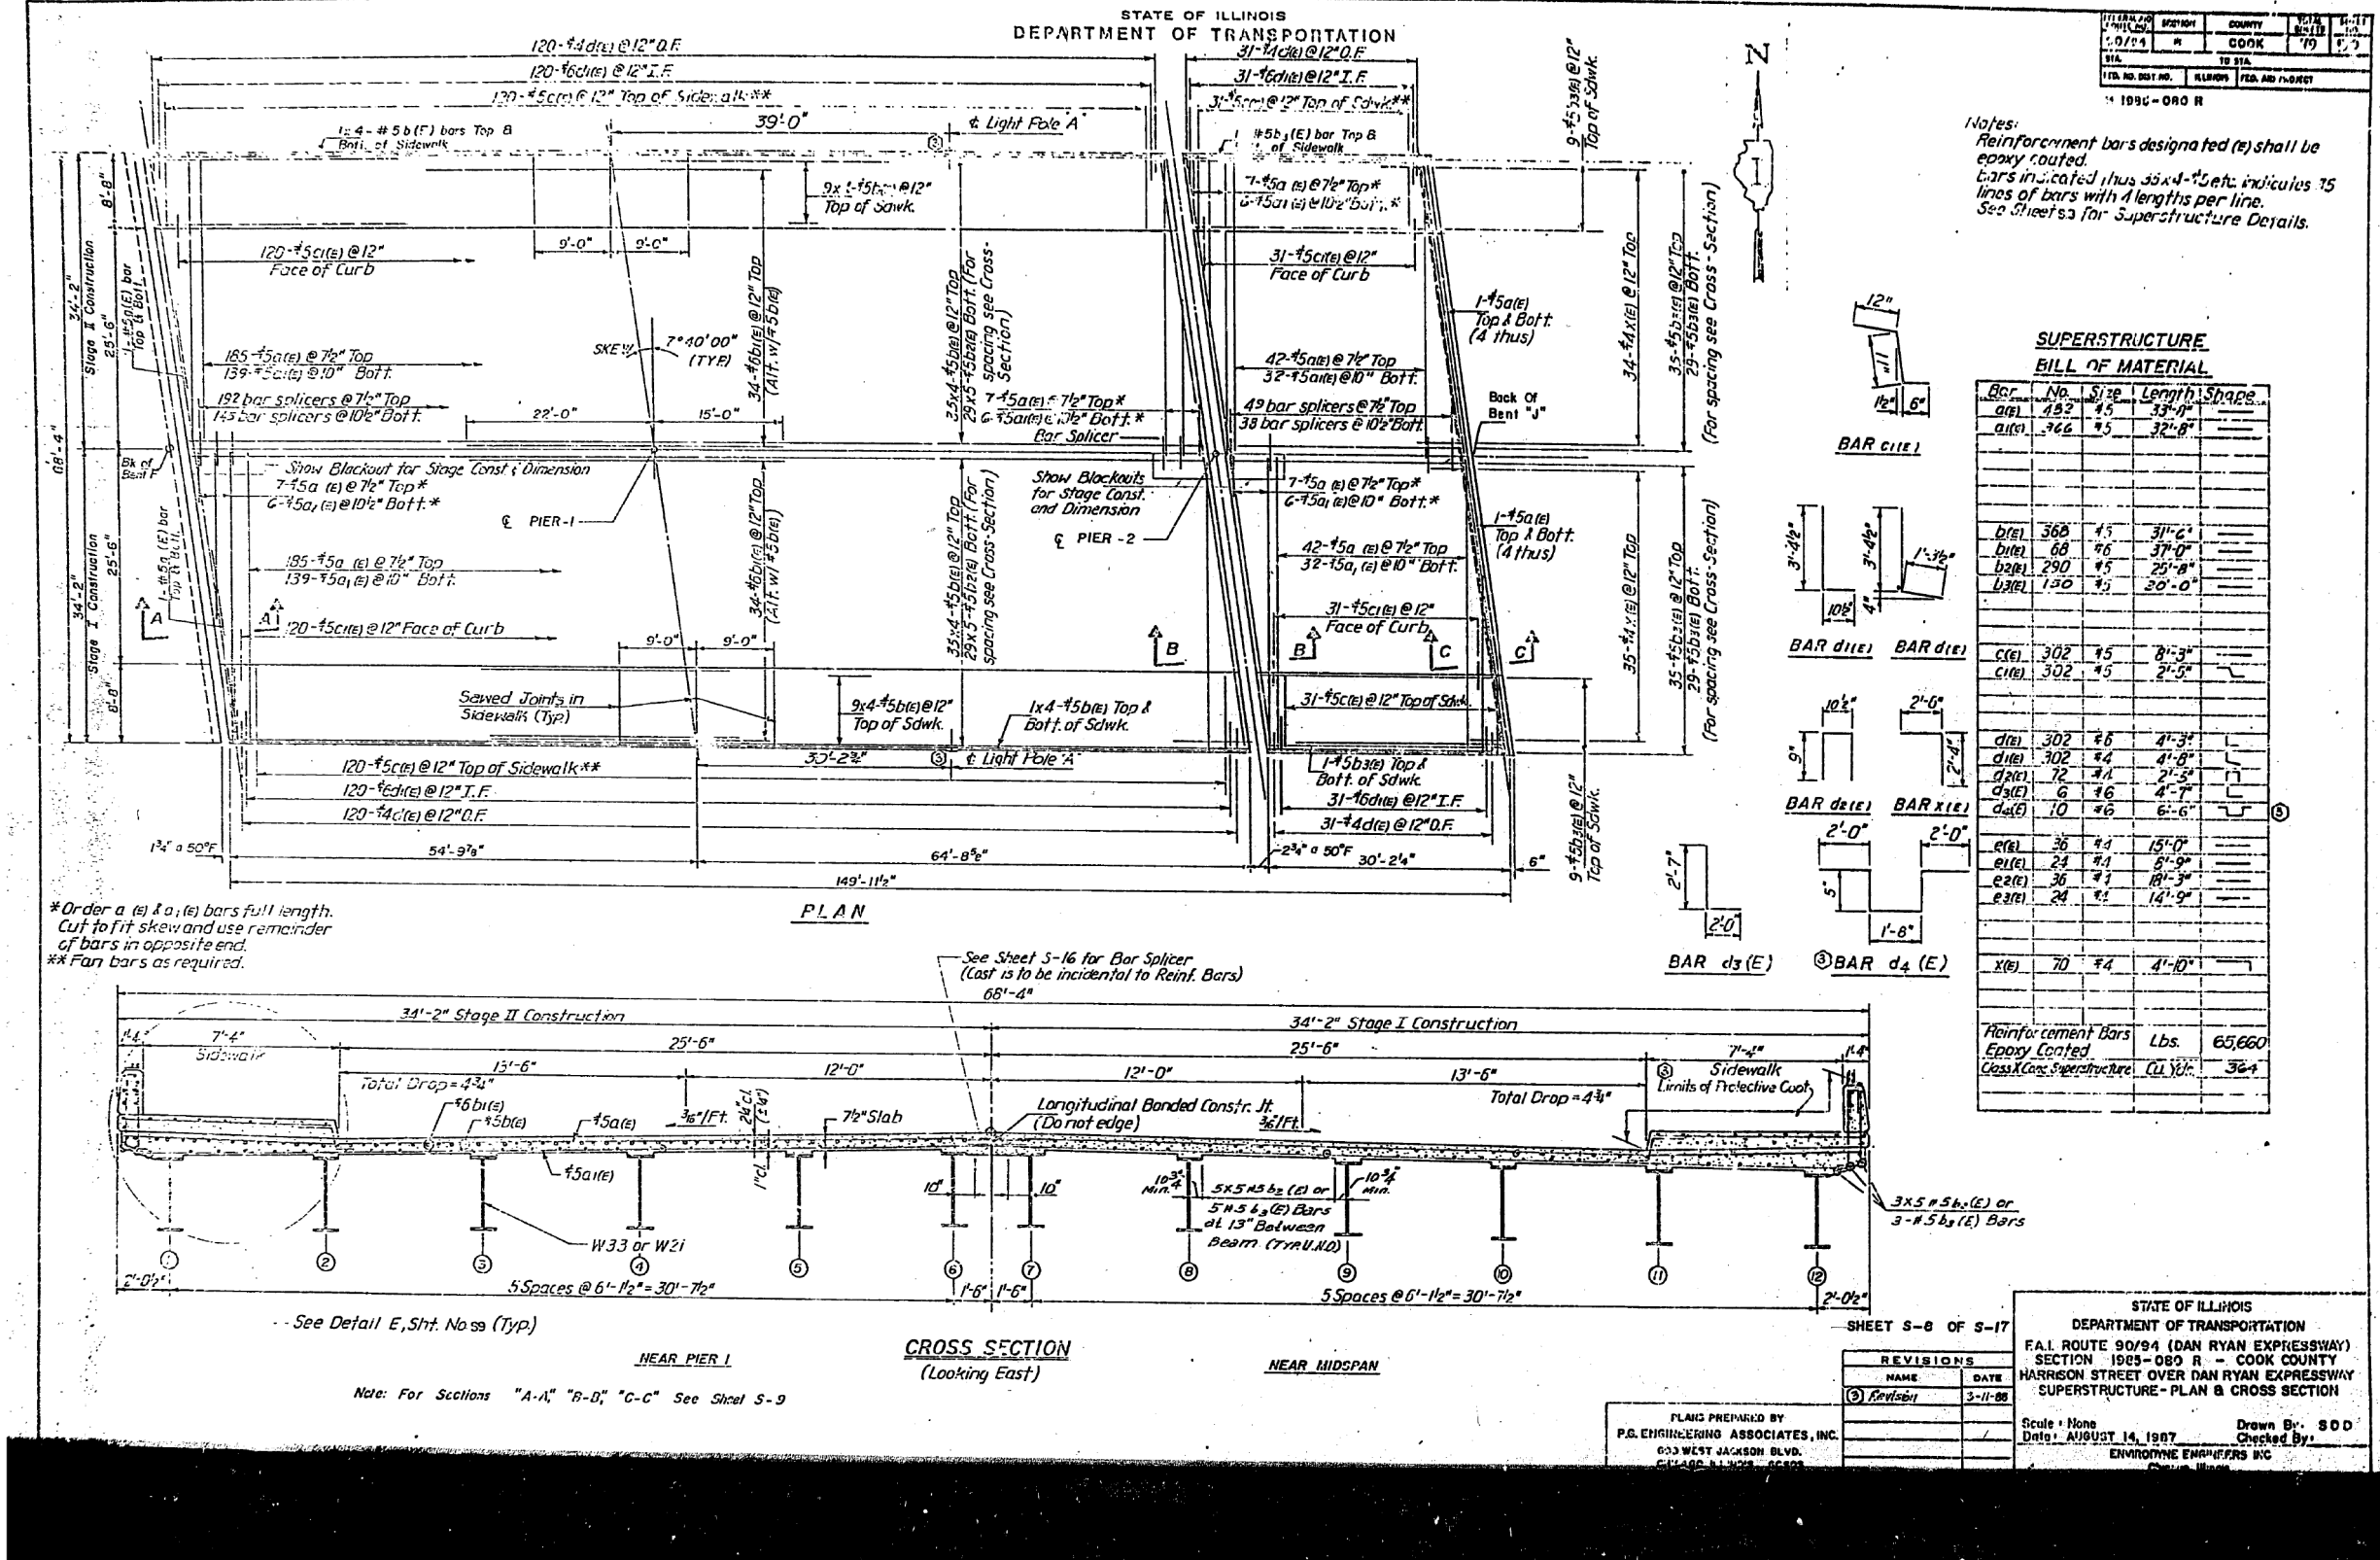

Notes:
 Reinforcement bars designated (e) shall be epoxy coated.
 Bars indicated thus 35x4-5e indicates 15 lines of bars with 4 lengths per line.
 See Sheets for Superstructure Details.

SUPERSTRUCTURE BILL OF MATERIAL

Bar	No.	Size	Length	Shape
a1(e)	432	45	33'-0"	
a1(e)	766	45	32'-8"	
b1(e)	368	45	31'-6"	
b1(e)	68	46	37'-0"	
b2(e)	290	45	25'-8"	
b3(e)	150	45	30'-0"	
c1(e)	302	45	2'-3"	
c1(e)	302	45	2'-5"	
d1(e)	302	46	4'-3"	
d1(e)	302	44	4'-8"	
d2(e)	72	41	2'-5"	
d3(e)	6	46	4'-7"	
d4(e)	10	46	6'-6"	
e1(e)	36	44	15'-0"	
e1(e)	24	41	8'-9"	
e2(e)	36	41	14'-3"	
e3(e)	24	41	14'-9"	
x(e)	70	44	4'-10"	
Reinforcement Bars		Lbs.	65,660	
Epoxy Coated				
Class II Cast Superstructure		CU Yds.	364	

*Order a (e) & a, (e) bars full length. Cut to fit skew and use remainder of bars in opposite end.
 ** Fan bars as required.

STATE OF ILLINOIS
 DEPARTMENT OF TRANSPORTATION
 F.A.I. ROUTE 90/94 (DAN RYAN EXPRESSWAY)
 SECTION 1925-080 R - COOK COUNTY
 HARRISON STREET OVER DAN RYAN EXPRESSWAY
 SUPERSTRUCTURE-PLAN B CROSS SECTION

Scale: None
 Date: AUGUST 14, 1987
 Drawn By: SDD
 Checked By: ENVIROTECH ENGINEERS INC

PLANS PREPARED BY
 P.E. ENGINEERING ASSOCIATES, INC.
 633 WEST JACKSON BLVD.
 CHICAGO, ILL. 60601

REVISIONS

NAME	DATE
(3) Revise	3-11-88

SHEET S-8 OF S-17

D:\60W71-SHT-AS-BUILT-11.dgn