


FOR INFORMATION ONLY

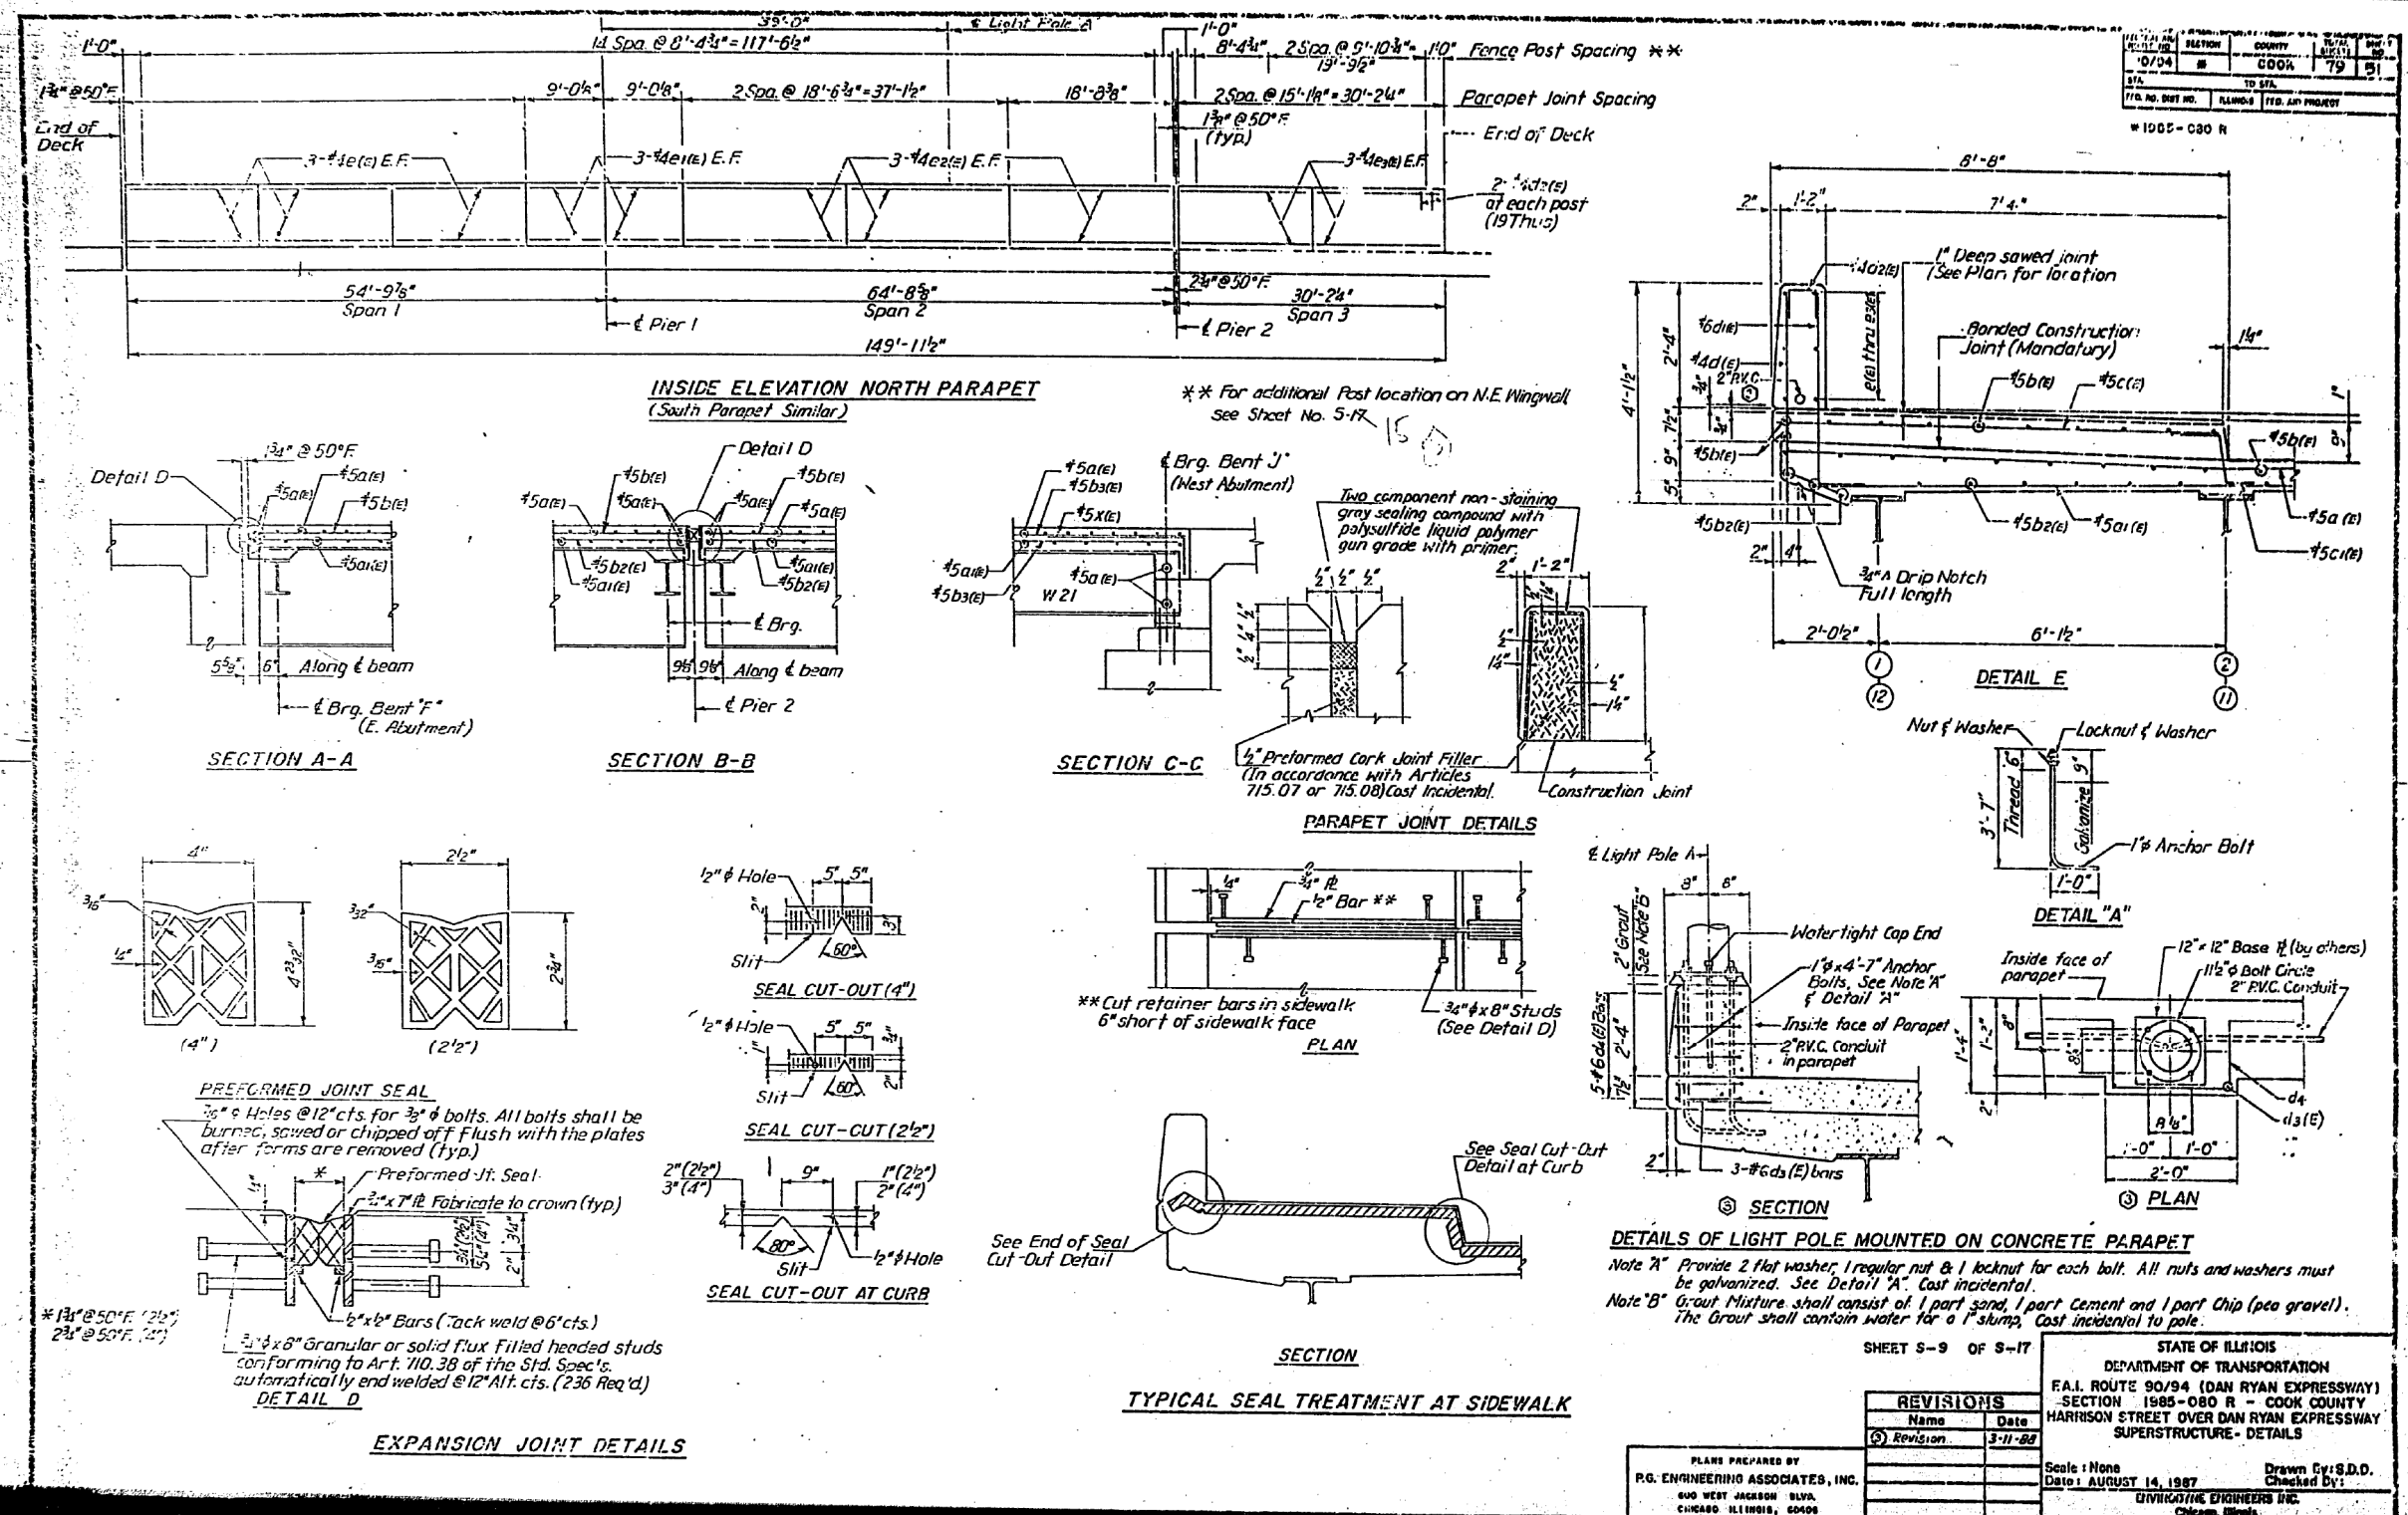

SECTION	COUNTY	TOTAL SHEETS	SHEET NO.
0/04	COOK	79	51
TO STA.			
F.I.D. NO. DIST. NO. ILLINOIS FED. AID PROJECT			
W 1005-080 R			

STATE OF ILLINOIS DEPARTMENT OF TRANSPORTATION F.A.I. ROUTE 90/94 (DAN RYAN EXPRESSWAY) SECTION 1985-080 R - COOK COUNTY HARRISON STREET OVER DAN RYAN EXPRESSWAY SUPERSTRUCTURE - DETAILS	
PLANS PREPARED BY P.G. ENGINEERING ASSOCIATES, INC. 600 WEST JACKSON BLVD. CHICAGO, ILLINOIS, 60606	Scale: None Date: AUGUST 14, 1987 Drawn By: S.D.D. Checked By:
REVISIONS	
Name	Date
(1) Revision	3-11-88

USER NAME = dunkerleyb	DESIGNED -	REVISED -
PLOT SCALE = N.T.S.	CHECKED -	REVISED -
PLOT DATE = 11/26/2013	DRAWN -	REVISED -
	CHECKED -	REVISED -

STATE OF ILLINOIS
DEPARTMENT OF TRANSPORTATION

EXISTING AS-BUILTS SN 016-1088

F.A.I. R.T.E.	SECTION	COUNTY	TOTAL SHEETS	SHEET NO.
90/94/290	2013-036R	COOK	256	154
CONTRACT NO. 60W71				
ILLINOIS FED. AID PROJECT -NUMBER-				

SHEET NO. AS-12 OF AS-72 SHEETS

D:\60W71-SHT-AS-BUILT-12.dgn