


FOR INFORMATION ONLY

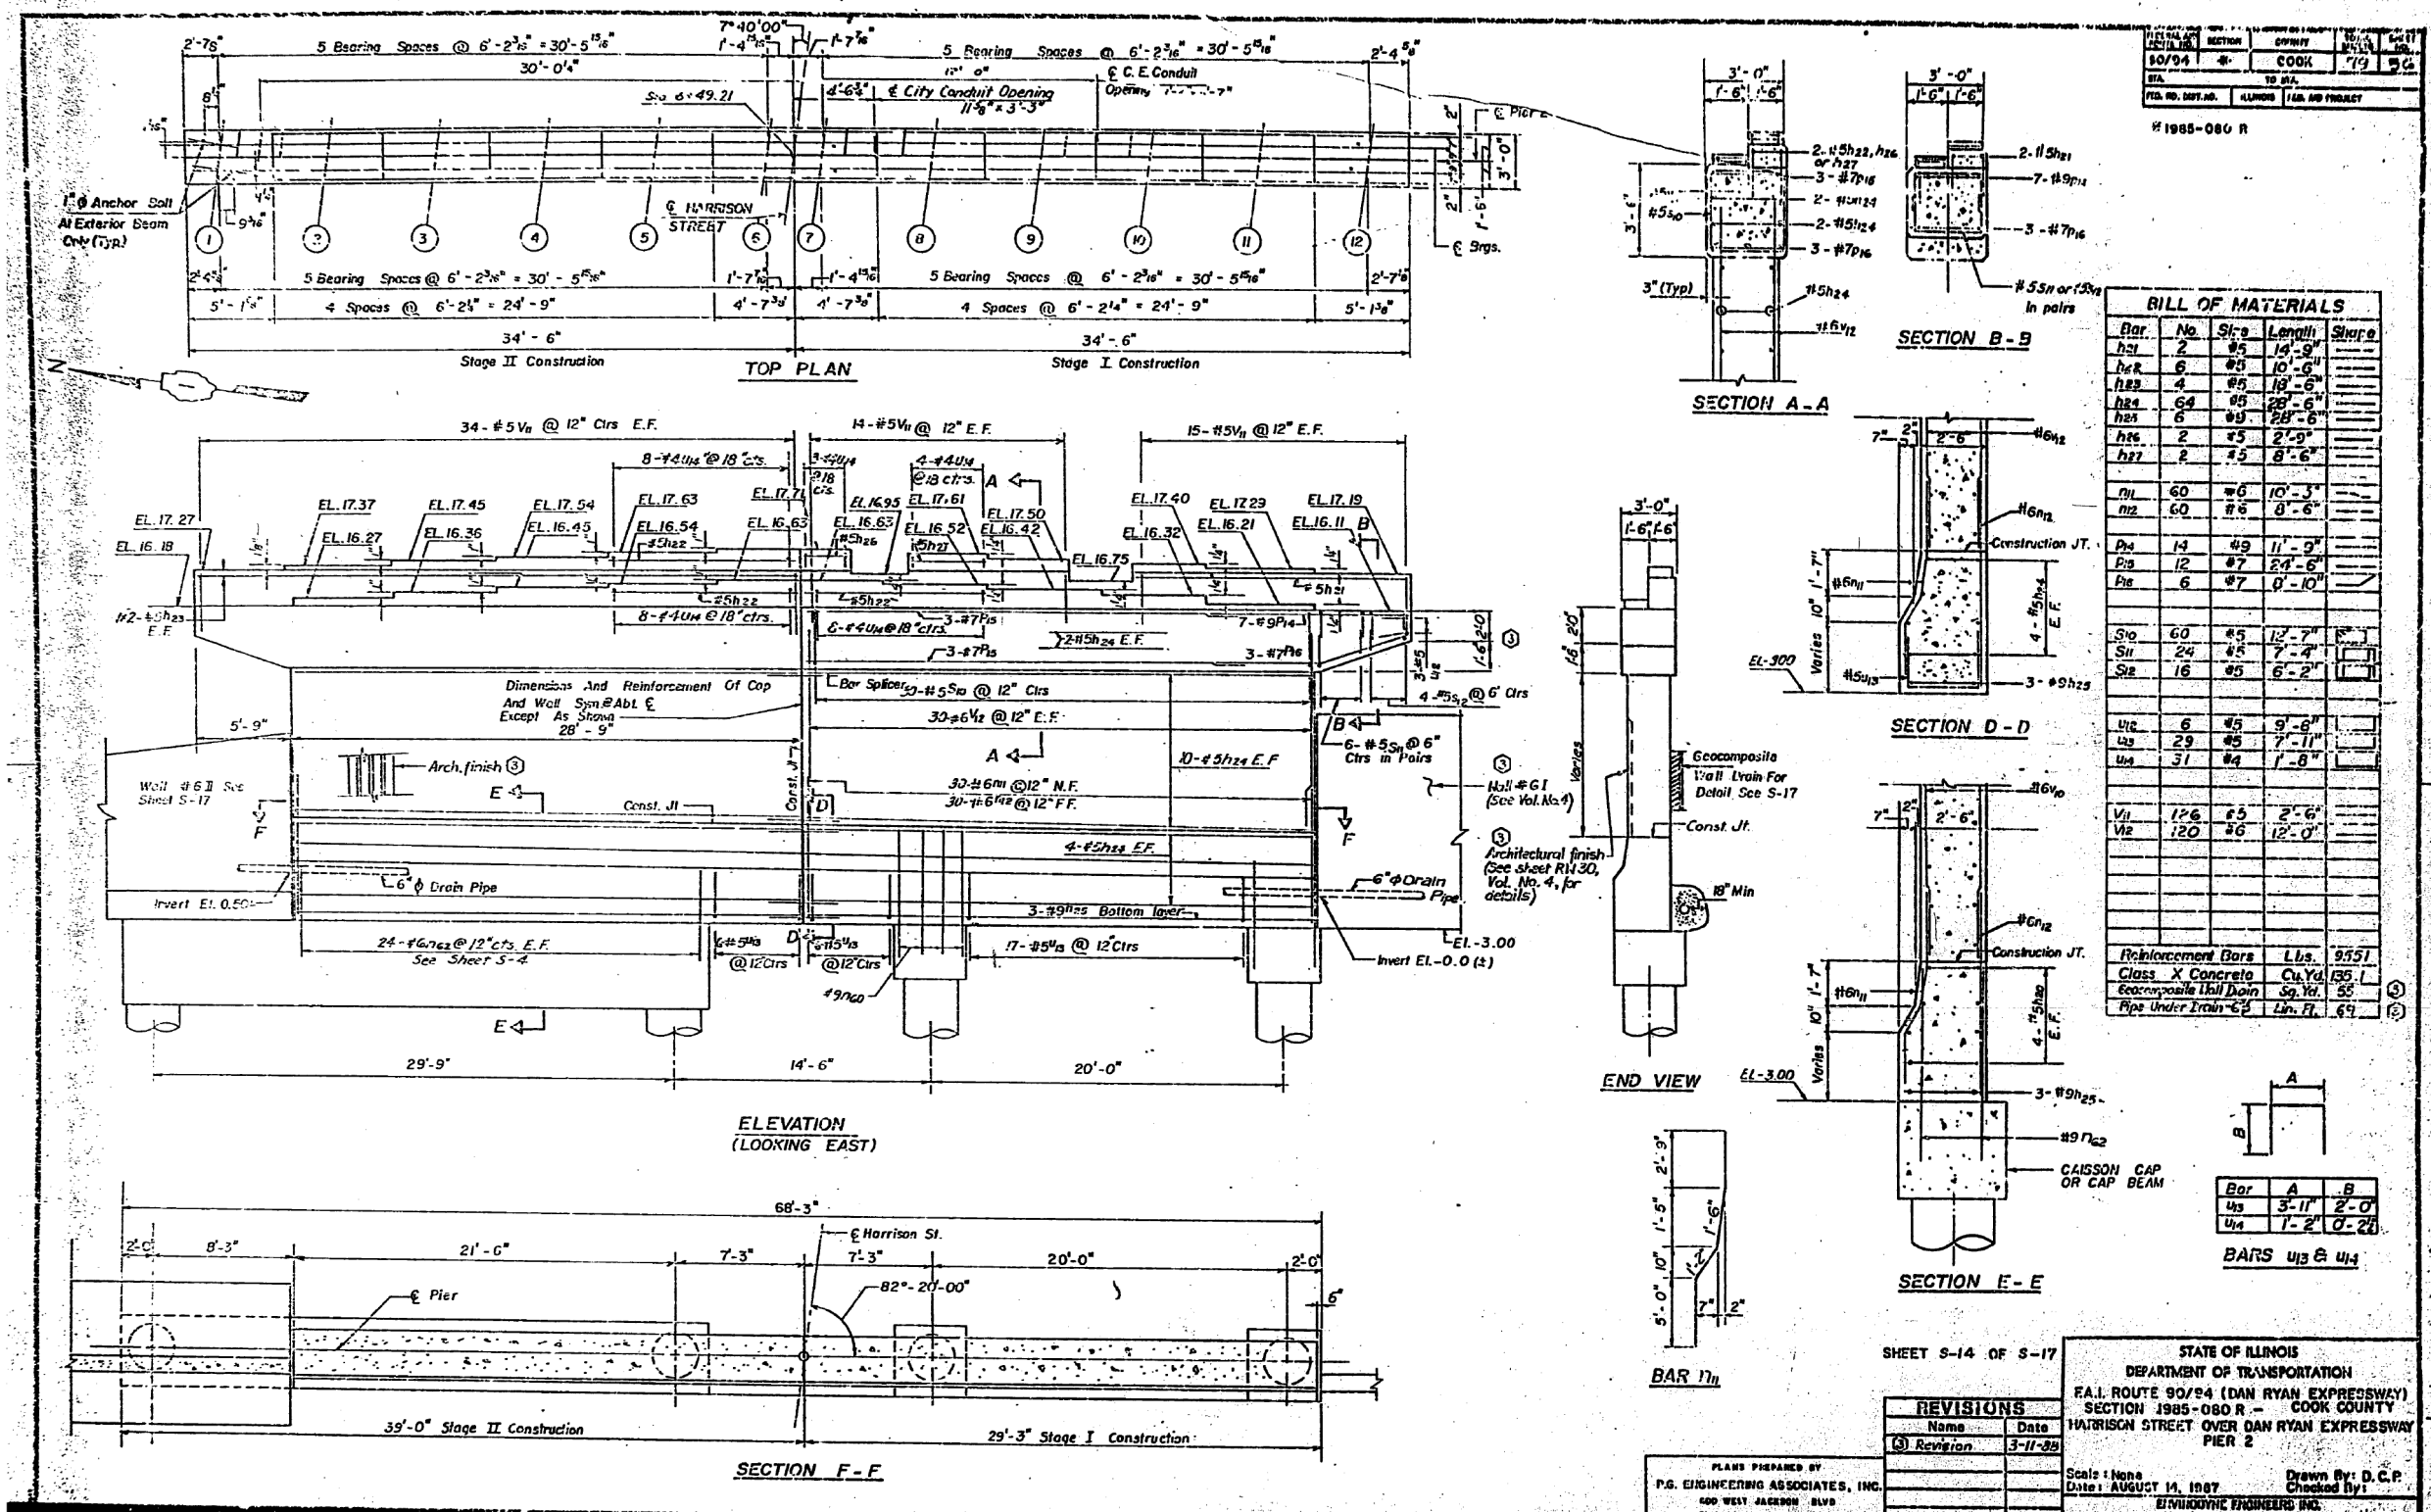

DATE	10/94	SECTION	COOK	79	52
DESIGNED BY		CHECKED BY			
DRAWN BY		DATE			
PROJECT NO.	1985-080 R	CONTRACT NO.			

Bar	No	Size	Length	Weight
h21	2	#5	14'-9"	
h22	6	#5	10'-6"	
h23	4	#5	18'-6"	
h24	64	#5	28'-6"	
h25	6	#5	28'-6"	
h26	2	#5	2'-9"	
h27	2	#5	8'-6"	
n11	60	#6	10'-3"	
n12	60	#6	8'-6"	
D1	14	#9	11'-9"	
D2	12	#7	24'-6"	
D3	6	#7	9'-10"	
S10	60	#5	12'-7"	
S11	24	#5	7'-4"	
S12	16	#5	6'-2"	
u12	6	#5	9'-6"	
u13	29	#5	7'-11"	
u14	31	#4	1'-8"	
v11	176	#5	2'-6"	
v12	120	#6	12'-0"	

Reinforcement Bars	Lts.	Weight
Class X Concrete		135.1
Geocomposite Half Drain		55
Pipe Under Drain		69

STATE OF ILLINOIS
DEPARTMENT OF TRANSPORTATION
F.A.I. ROUTE 90/94 (DAN RYAN EXPRESSWAY)
SECTION 1985-080 R - COOK COUNTY
HARRISON STREET OVER DAN RYAN EXPRESSWAY
PIER 2

REVISIONS

Name	Date
(3) Revision	3-11-85

Scale: None
Date: AUGUST 14, 1987
Drawn By: D.C.P.
Checked By:

PLANS PREPARED BY:
P.G. ENGINEERING ASSOCIATES, INC.
400 WEST JACKSON BLVD
CHICAGO, ILLINOIS, 60606

ILLINOIS ENGINEERS INC.
Chicago, Illinois

USER NAME = dunkerleyb	DESIGNED -	REVISED -
PLOT SCALE = N.T.S.	CHECKED -	REVISED -
PLOT DATE = 11/26/2013	DRAWN -	REVISED -
	CHECKED -	REVISED -

STATE OF ILLINOIS
DEPARTMENT OF TRANSPORTATION

EXISTING AS-BUILTS SN 016-1088

SHEET NO. AS-17 OF AS-72 SHEETS

F.A.I. RTE.	SECTION	COUNTY	TOTAL SHEETS	SHEET NO.
90/94/290	2013-036R	COOK	256	159
CONTRACT NO. 60W71			ILLINOIS FED. AID PROJECT -NUMBER-	

DIGOW71-SHT-AS-BUILT-17.dgn