


FOR INFORMATION ONLY

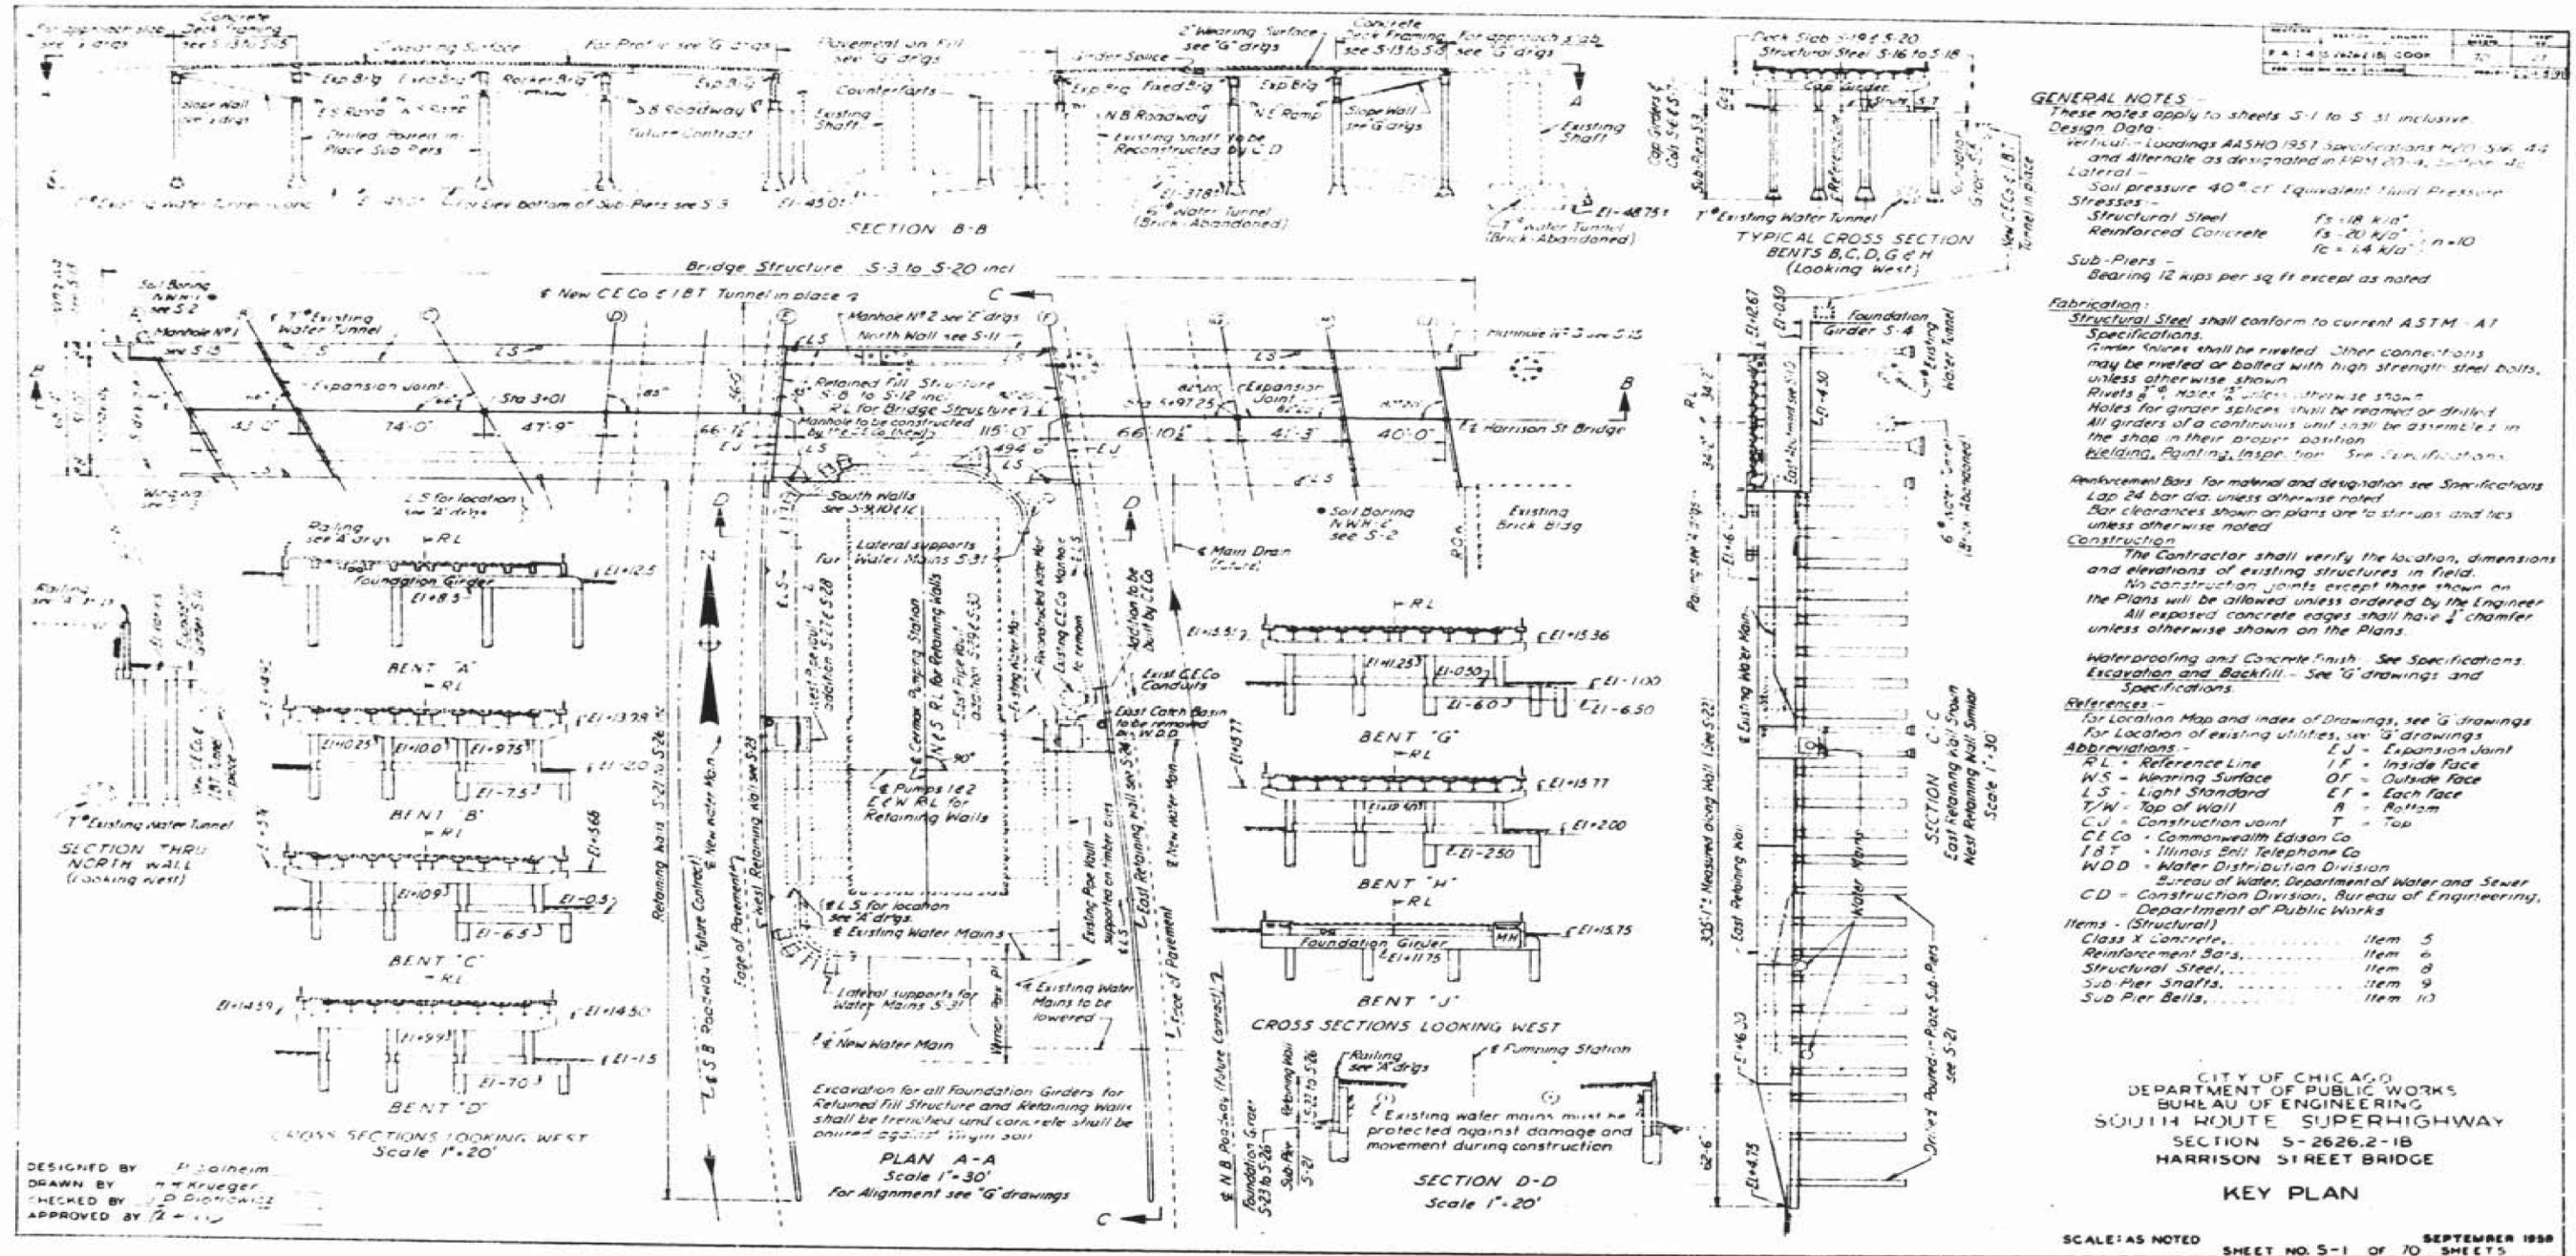

DESIGNED BY P. J. J. J.
 DRAWN BY M. K. K.
 CHECKED BY J. P. P.
 APPROVED BY J. J. J.

PLAN A-A
 Scale 1"=30'
 For Alignment see "G" drawings

SECTION D-D
 Scale 1"=20'

SCALE: AS NOTED
 SHEET NO. S-1 OF 70 SHEETS
 SEPTEMBER 1958

USER NAME = dunkerleyb	DESIGNED -	REVISED
	CHECKED -	REVISED
PLOT SCALE = N.T.S.	DRAWN -	REVISED
PLOT DATE = 11/26/2013	CHECKED -	REVISED

STATE OF ILLINOIS
 DEPARTMENT OF TRANSPORTATION

EXISTING AS-BUILTS SN 016-1088

SHEET NO. AS-30 OF AS-72 SHEETS

F.A.I. R.E.	SECTION	COUNTY	TOTAL SHEETS	SHEET NO.
90/94/290	2013-036R	COOK	256	172
				CONTRACT NO. 60W71
ILLINOIS FED. AID PROJECT -NUMBER-				