


FOR INFORMATION ONLY

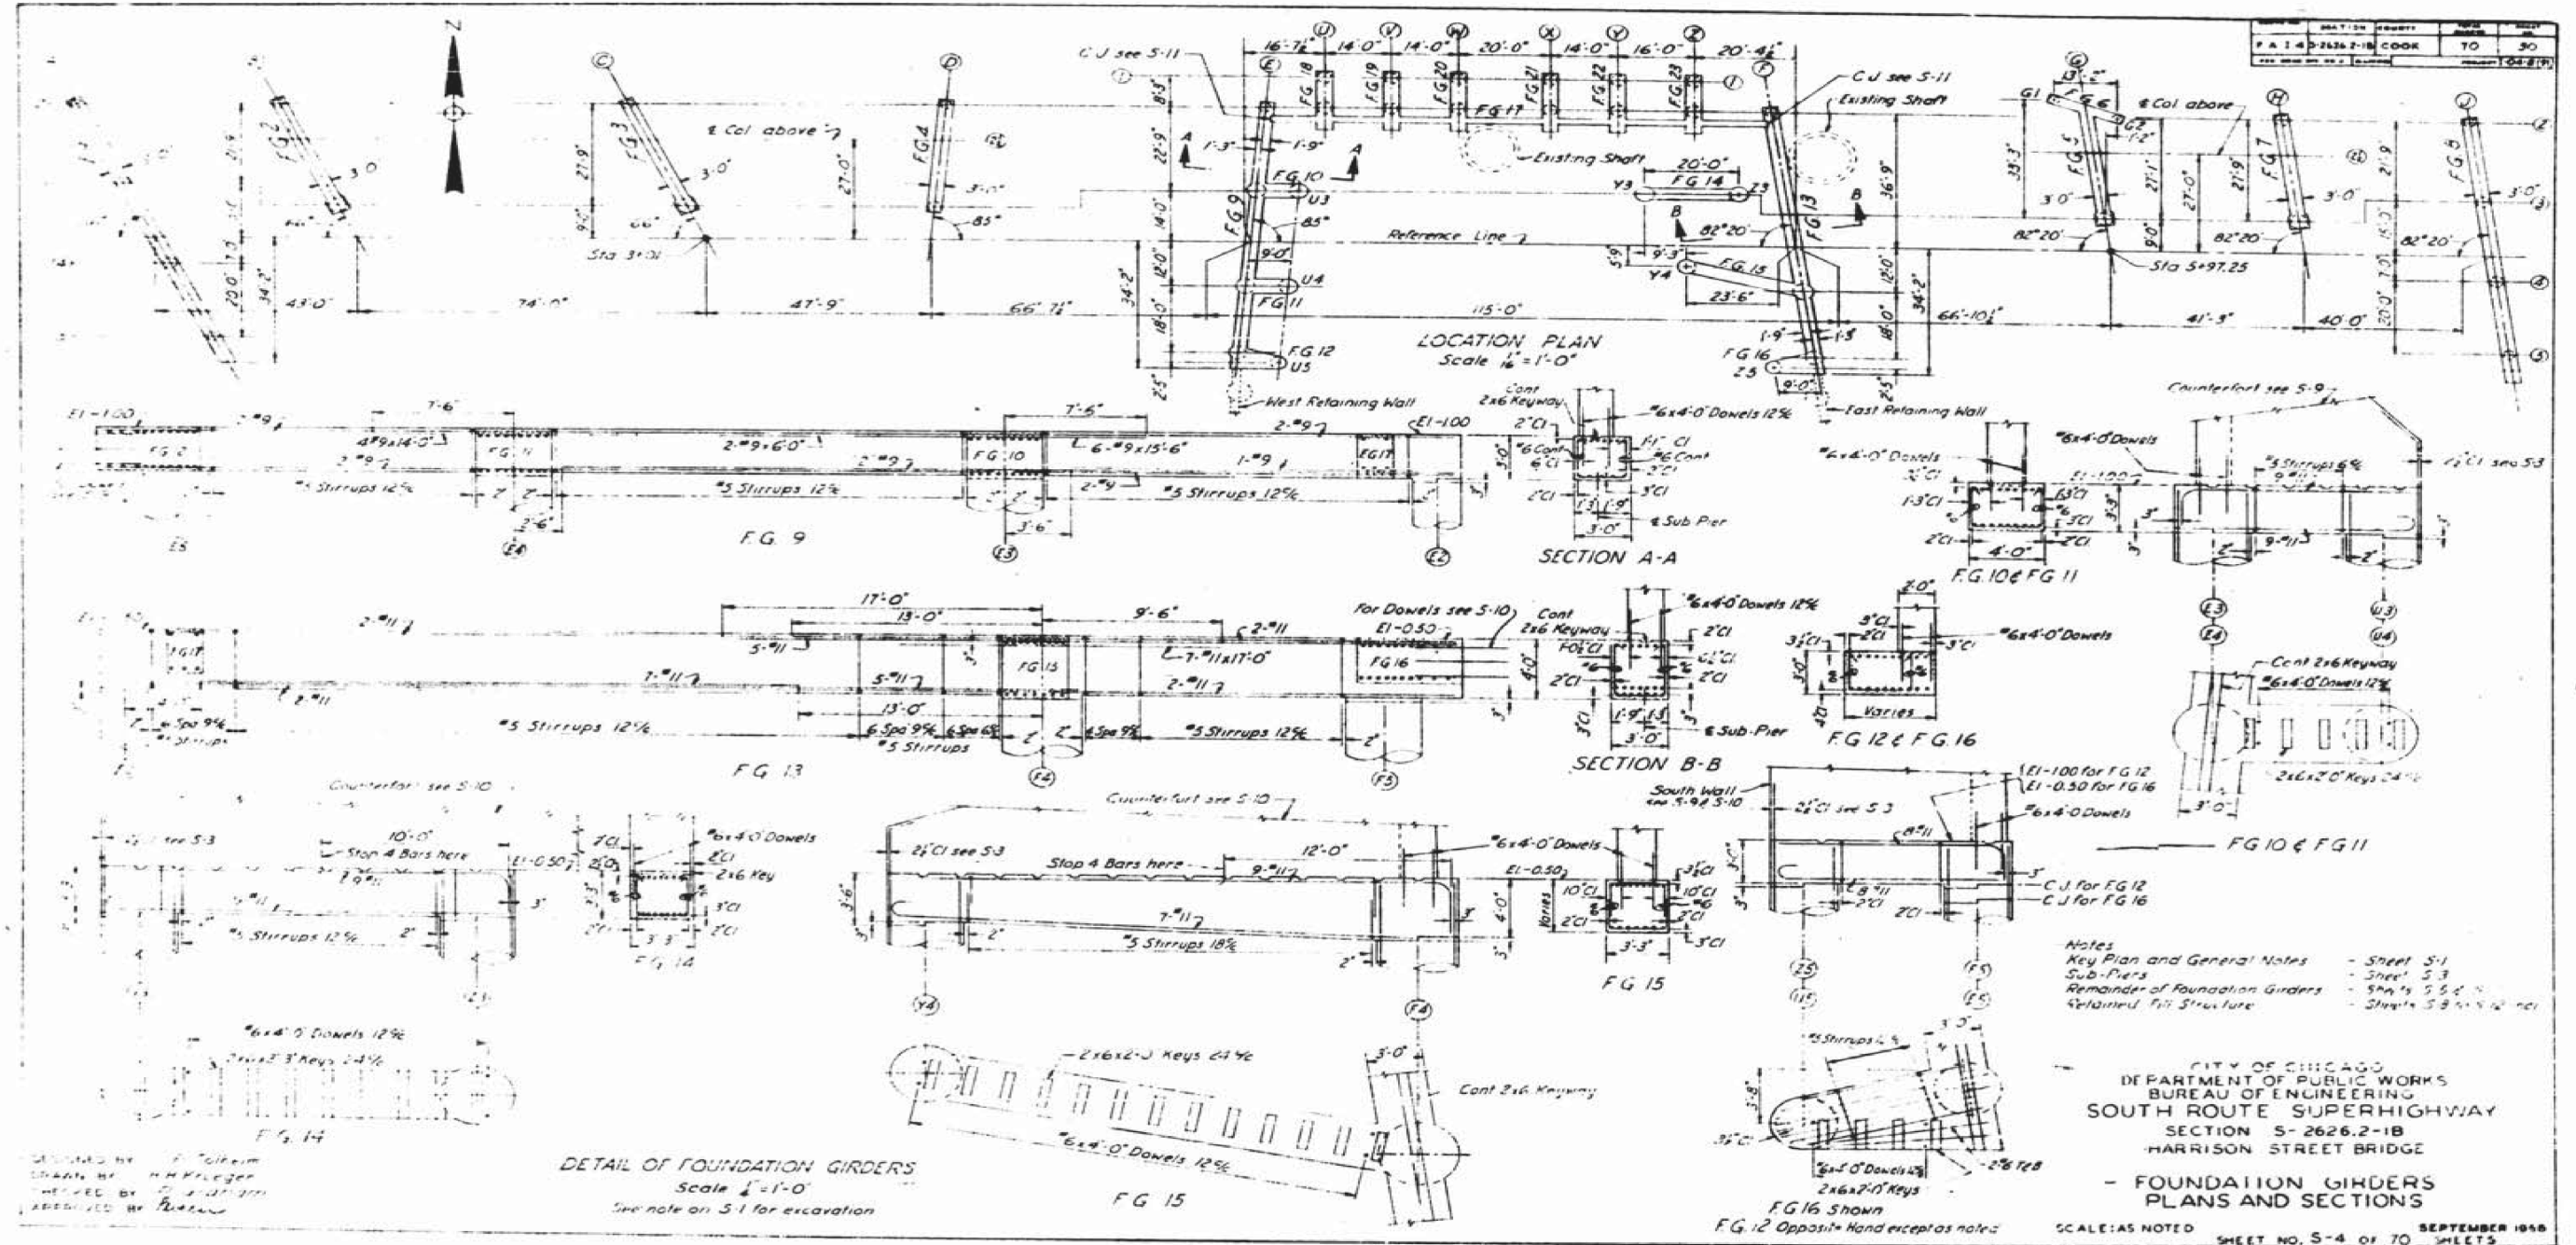

DESIGNED BY: J. Tolson  
 CHECKED BY: H.H. Klinger  
 APPROVED BY: [Signature]

DETAIL OF FOUNDATION GIRDERS  
 Scale 1/2" = 1'-0"  
 See note on S-1 for excavation

Notes:  
 Key Plan and General Notes - Sheet S-1  
 Sub-Piers - Sheet S-3  
 Remainder of Foundation Girders - Sheet S-4  
 Retained Fill Structure - Sheet S-9 & S-12

CITY OF CHICAGO  
 DEPARTMENT OF PUBLIC WORKS  
 BUREAU OF ENGINEERING  
 SOUTH ROUTE SUPERHIGHWAY  
 SECTION 5-2626.2-1B  
 HARRISON STREET BRIDGE  
 - FOUNDATION GIRDERS  
 PLANS AND SECTIONS

D:\6071-sht-AS-BUILT-33.dgn

USER NAME = dunkerleyb	DESIGNED -	REVISED -
	CHECKED -	REVISED -
PLOT SCALE = N.T.S.	DRAWN -	REVISED -
PLOT DATE = 11/26/2013	CHECKED -	REVISED -

STATE OF ILLINOIS  
 DEPARTMENT OF TRANSPORTATION

EXISTING AS-BUILTS SN 016-1088

SHEET NO. AS-33 OF AS-72 SHEETS

F.A.I. R.E.	SECTION	COUNTY	TOTAL SHEETS	SHEET NO.
90/94/290	2013-036R	COOK	256	175
CONTRACT NO. 60W71				
ILLINOIS FED. AID PROJECT -NUMBER-				