


FOR INFORMATION ONLY

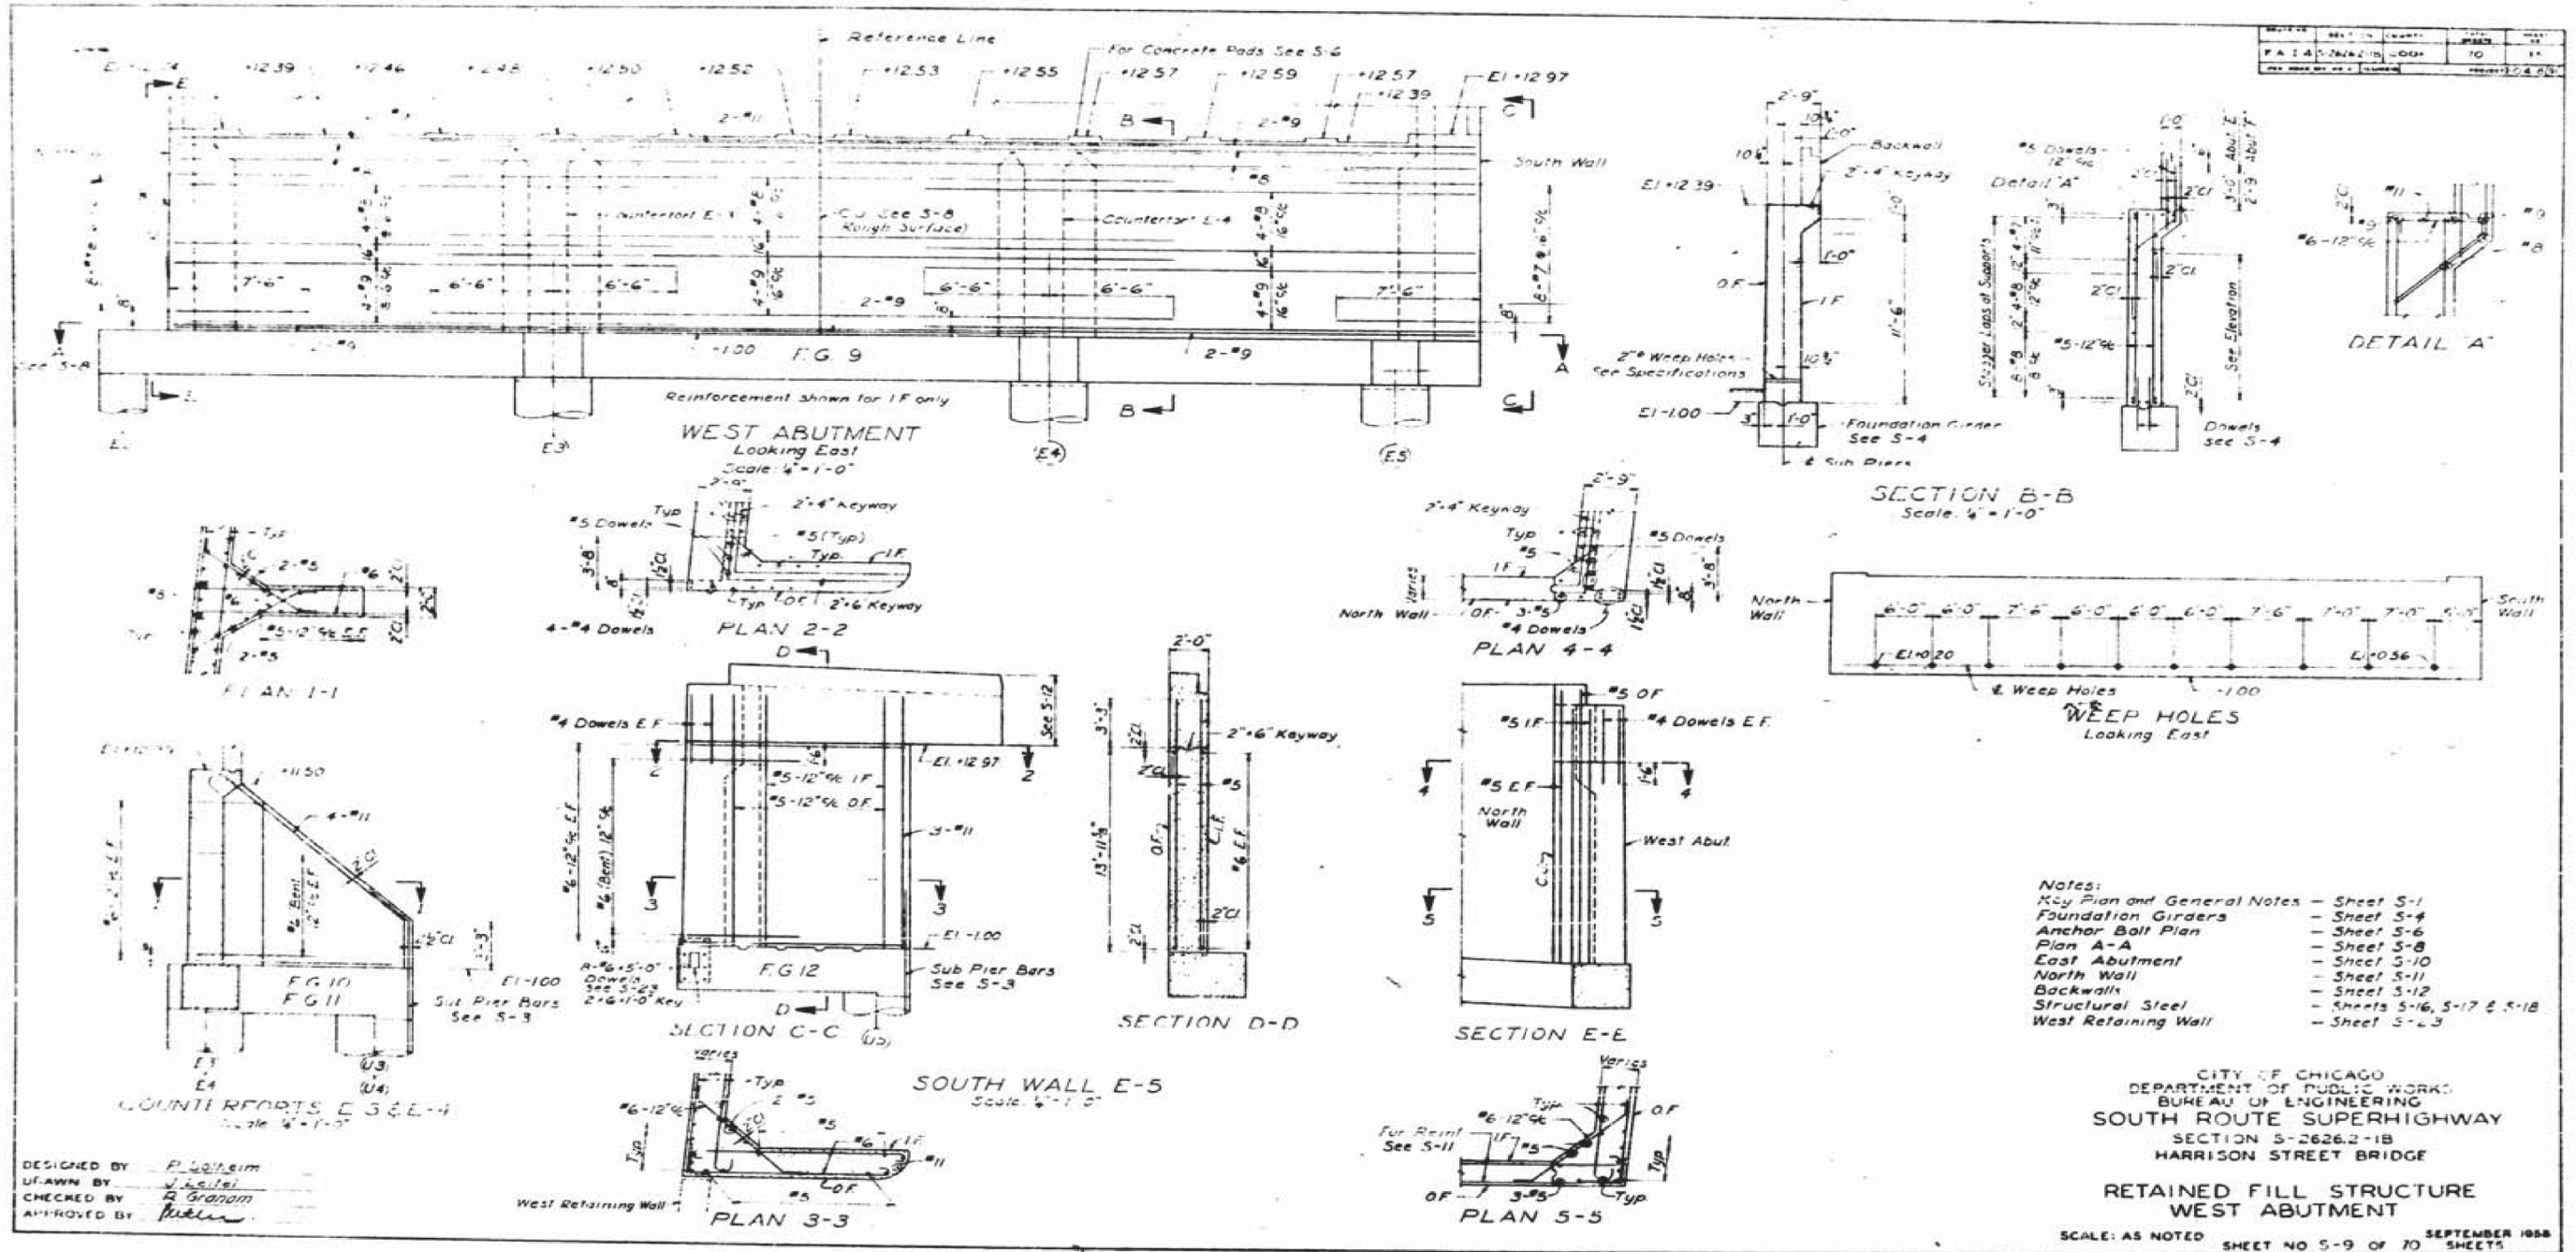

DESIGNED BY P. Soltheim
 DRAWN BY J. Kotel
 CHECKED BY R. Granom
 APPROVED BY [Signature]

- Notes:
 Key Plan and General Notes - Sheet S-1
 Foundation Girders - Sheet S-4
 Anchor Bolt Plan - Sheet S-6
 Plan A-A - Sheet S-8
 East Abutment - Sheet S-10
 North Wall - Sheet S-11
 Backwalls - Sheet S-12
 Structural Steel - Sheets S-16, S-17 & S-18
 West Retaining Wall - Sheet S-23

CITY OF CHICAGO
 DEPARTMENT OF PUBLIC WORKS
 BUREAU OF ENGINEERING
 SOUTH ROUTE SUPERHIGHWAY
 SECTION S-2626.2-1B
 HARRISON STREET BRIDGE
 RETAINED FILL STRUCTURE
 WEST ABUTMENT
 SCALE: AS NOTED SHEET NO. S-9 OF 70 SHEETS
 SEPTEMBER 1958

D:\60W71-sht-AS-BUILT-38.dgn

USER NAME = dunkerleyb	DESIGNED -	REVISED
	CHECKED -	REVISED
PLOT SCALE = N.T.S.	DRAWN -	REVISED
PLOT DATE = 11/26/2013	CHECKED -	REVISED

STATE OF ILLINOIS
 DEPARTMENT OF TRANSPORTATION

EXISTING AS-BUILTS SN 016-1088

SHEET NO. AS-38 OF AS-72 SHEETS

F.A.I. R.E.	SECTION	COUNTY	TOTAL SHEETS	SHEET NO.
90/94/290	2013-036R	COOK	256	180
				CONTRACT NO. 60W71
ILLINOIS FED. AID PROJECT -NUMBER-				