


FOR INFORMATION ONLY

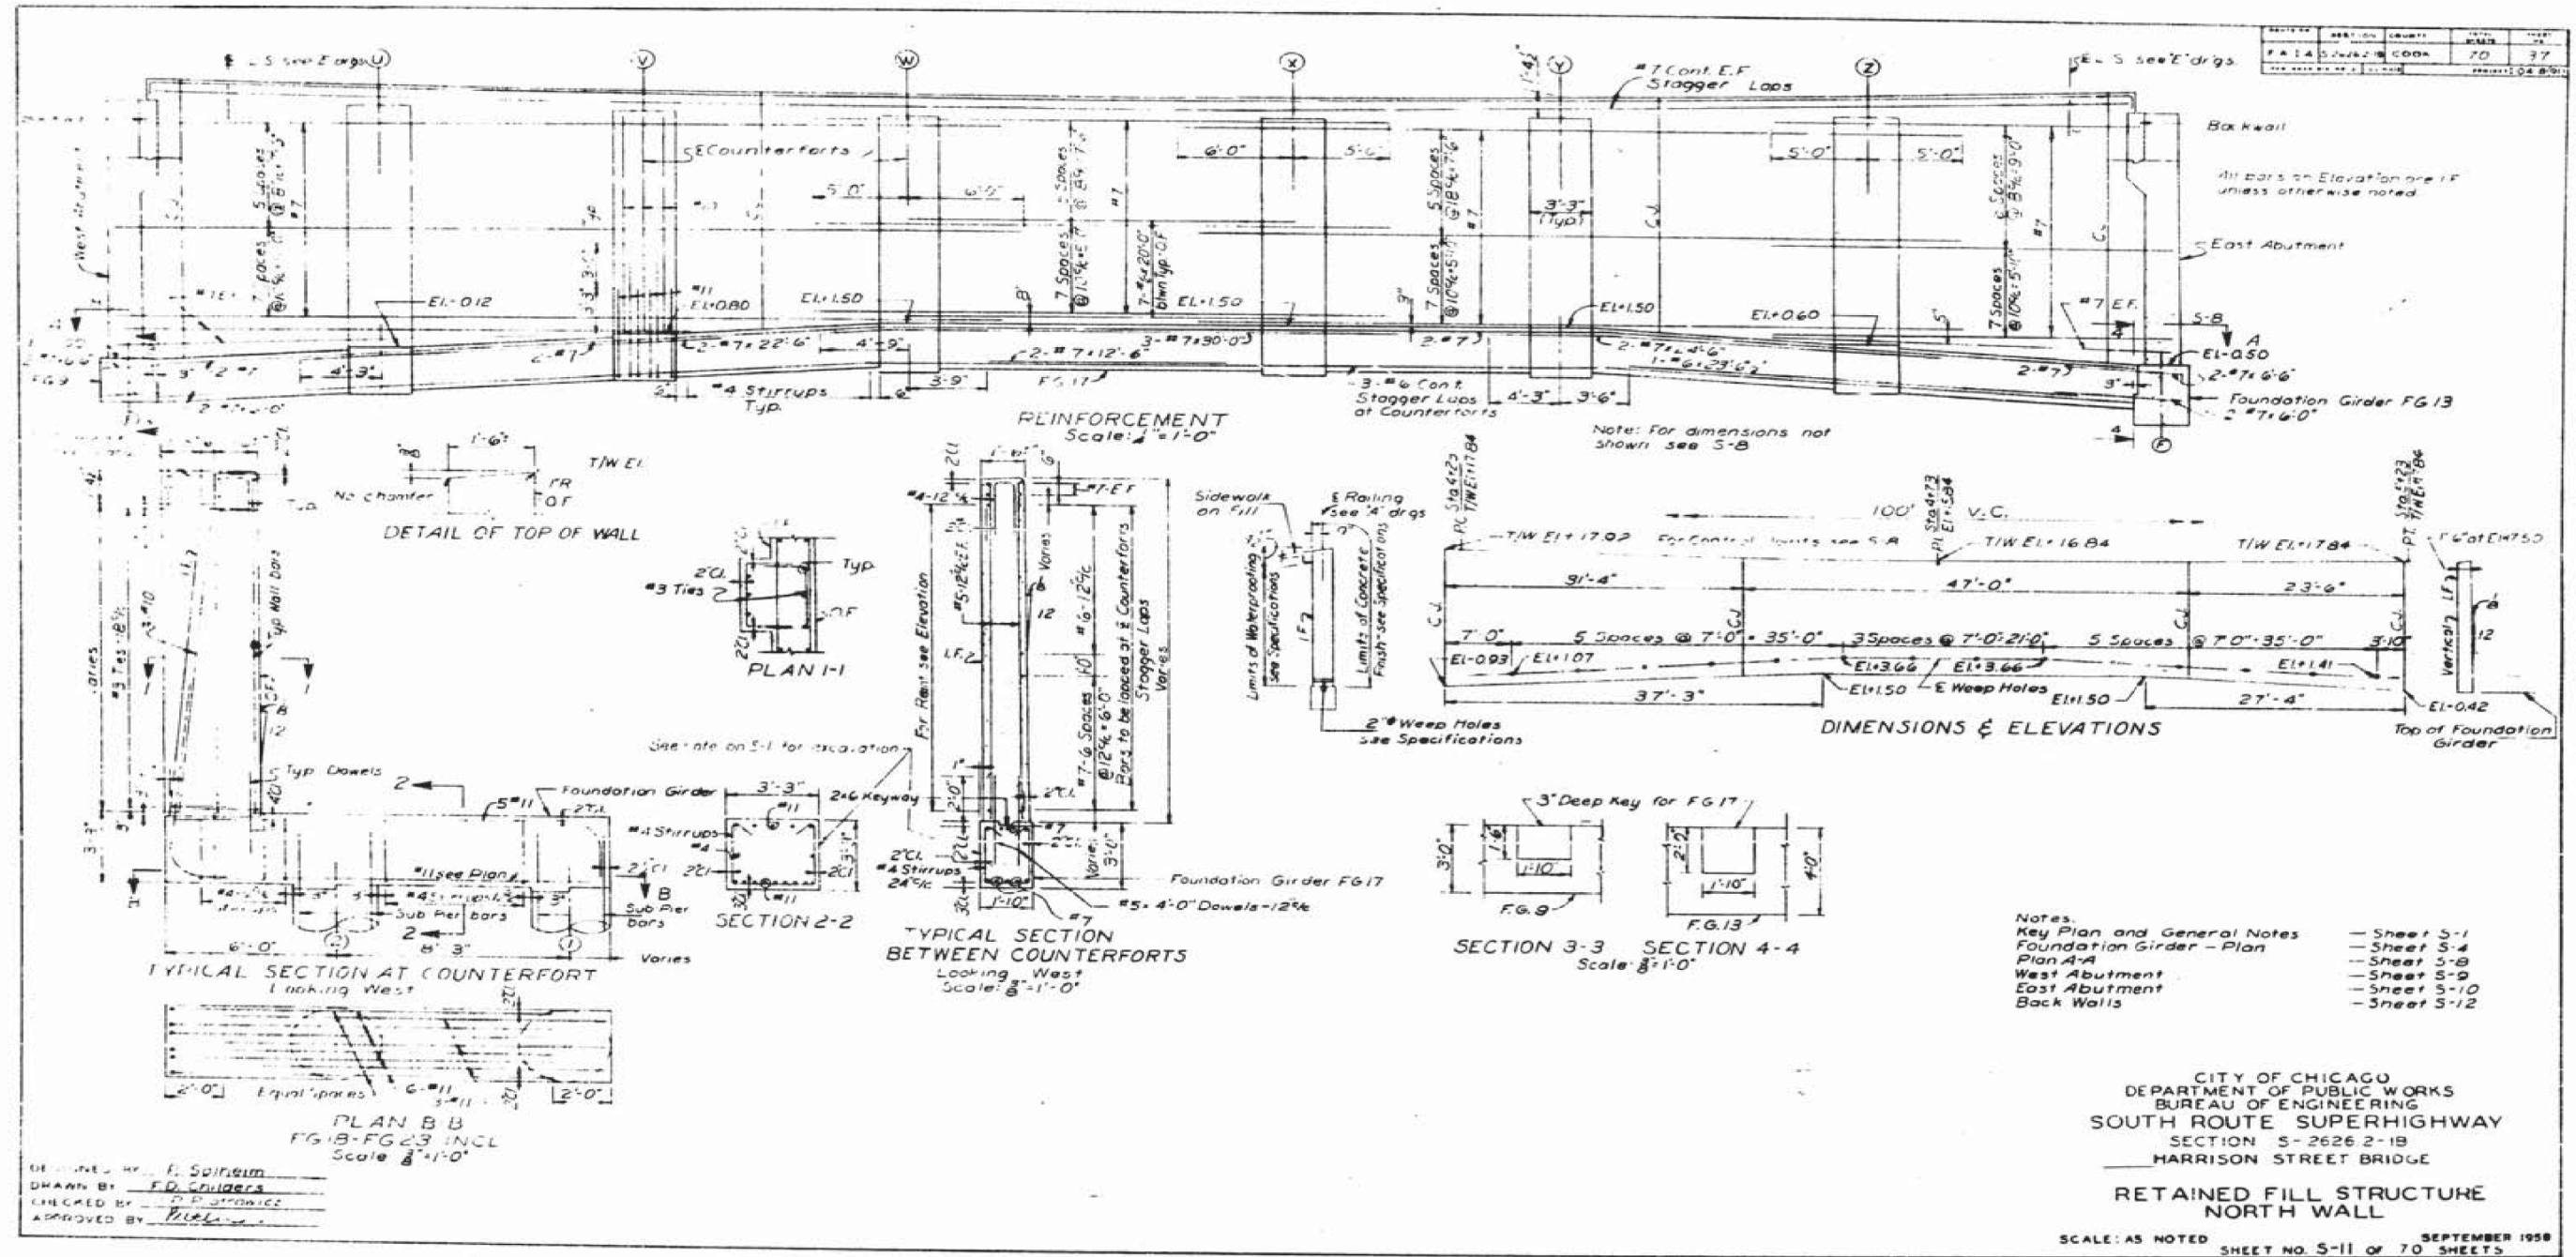

D:\GOW71-sht-AS-BUILT-41.dgn

|                        |            |         |
|------------------------|------------|---------|
| USER NAME = dunkerleyb | DESIGNED - | REVISED |
|                        | CHECKED -  | REVISED |
| PLOT SCALE = N.T.S.    | DRAWN -    | REVISED |
| PLOT DATE = 11/26/2013 | CHECKED -  | REVISED |

STATE OF ILLINOIS  
DEPARTMENT OF TRANSPORTATION

EXISTING AS-BUILTS SN 016-1088

SHEET NO. AS-41 OF AS-72 SHEETS

|             |           |        |              |                                    |
|-------------|-----------|--------|--------------|------------------------------------|
| F.A.I. R.E. | SECTION   | COUNTY | TOTAL SHEETS | SHEET NO.                          |
| 90/94/290   | 2013-036R | COOK   | 256          | 183                                |
|             |           |        |              | CONTRACT NO. 60W71                 |
|             |           |        |              | ILLINOIS FED. AID PROJECT -NUMBER- |