


FOR INFORMATION ONLY

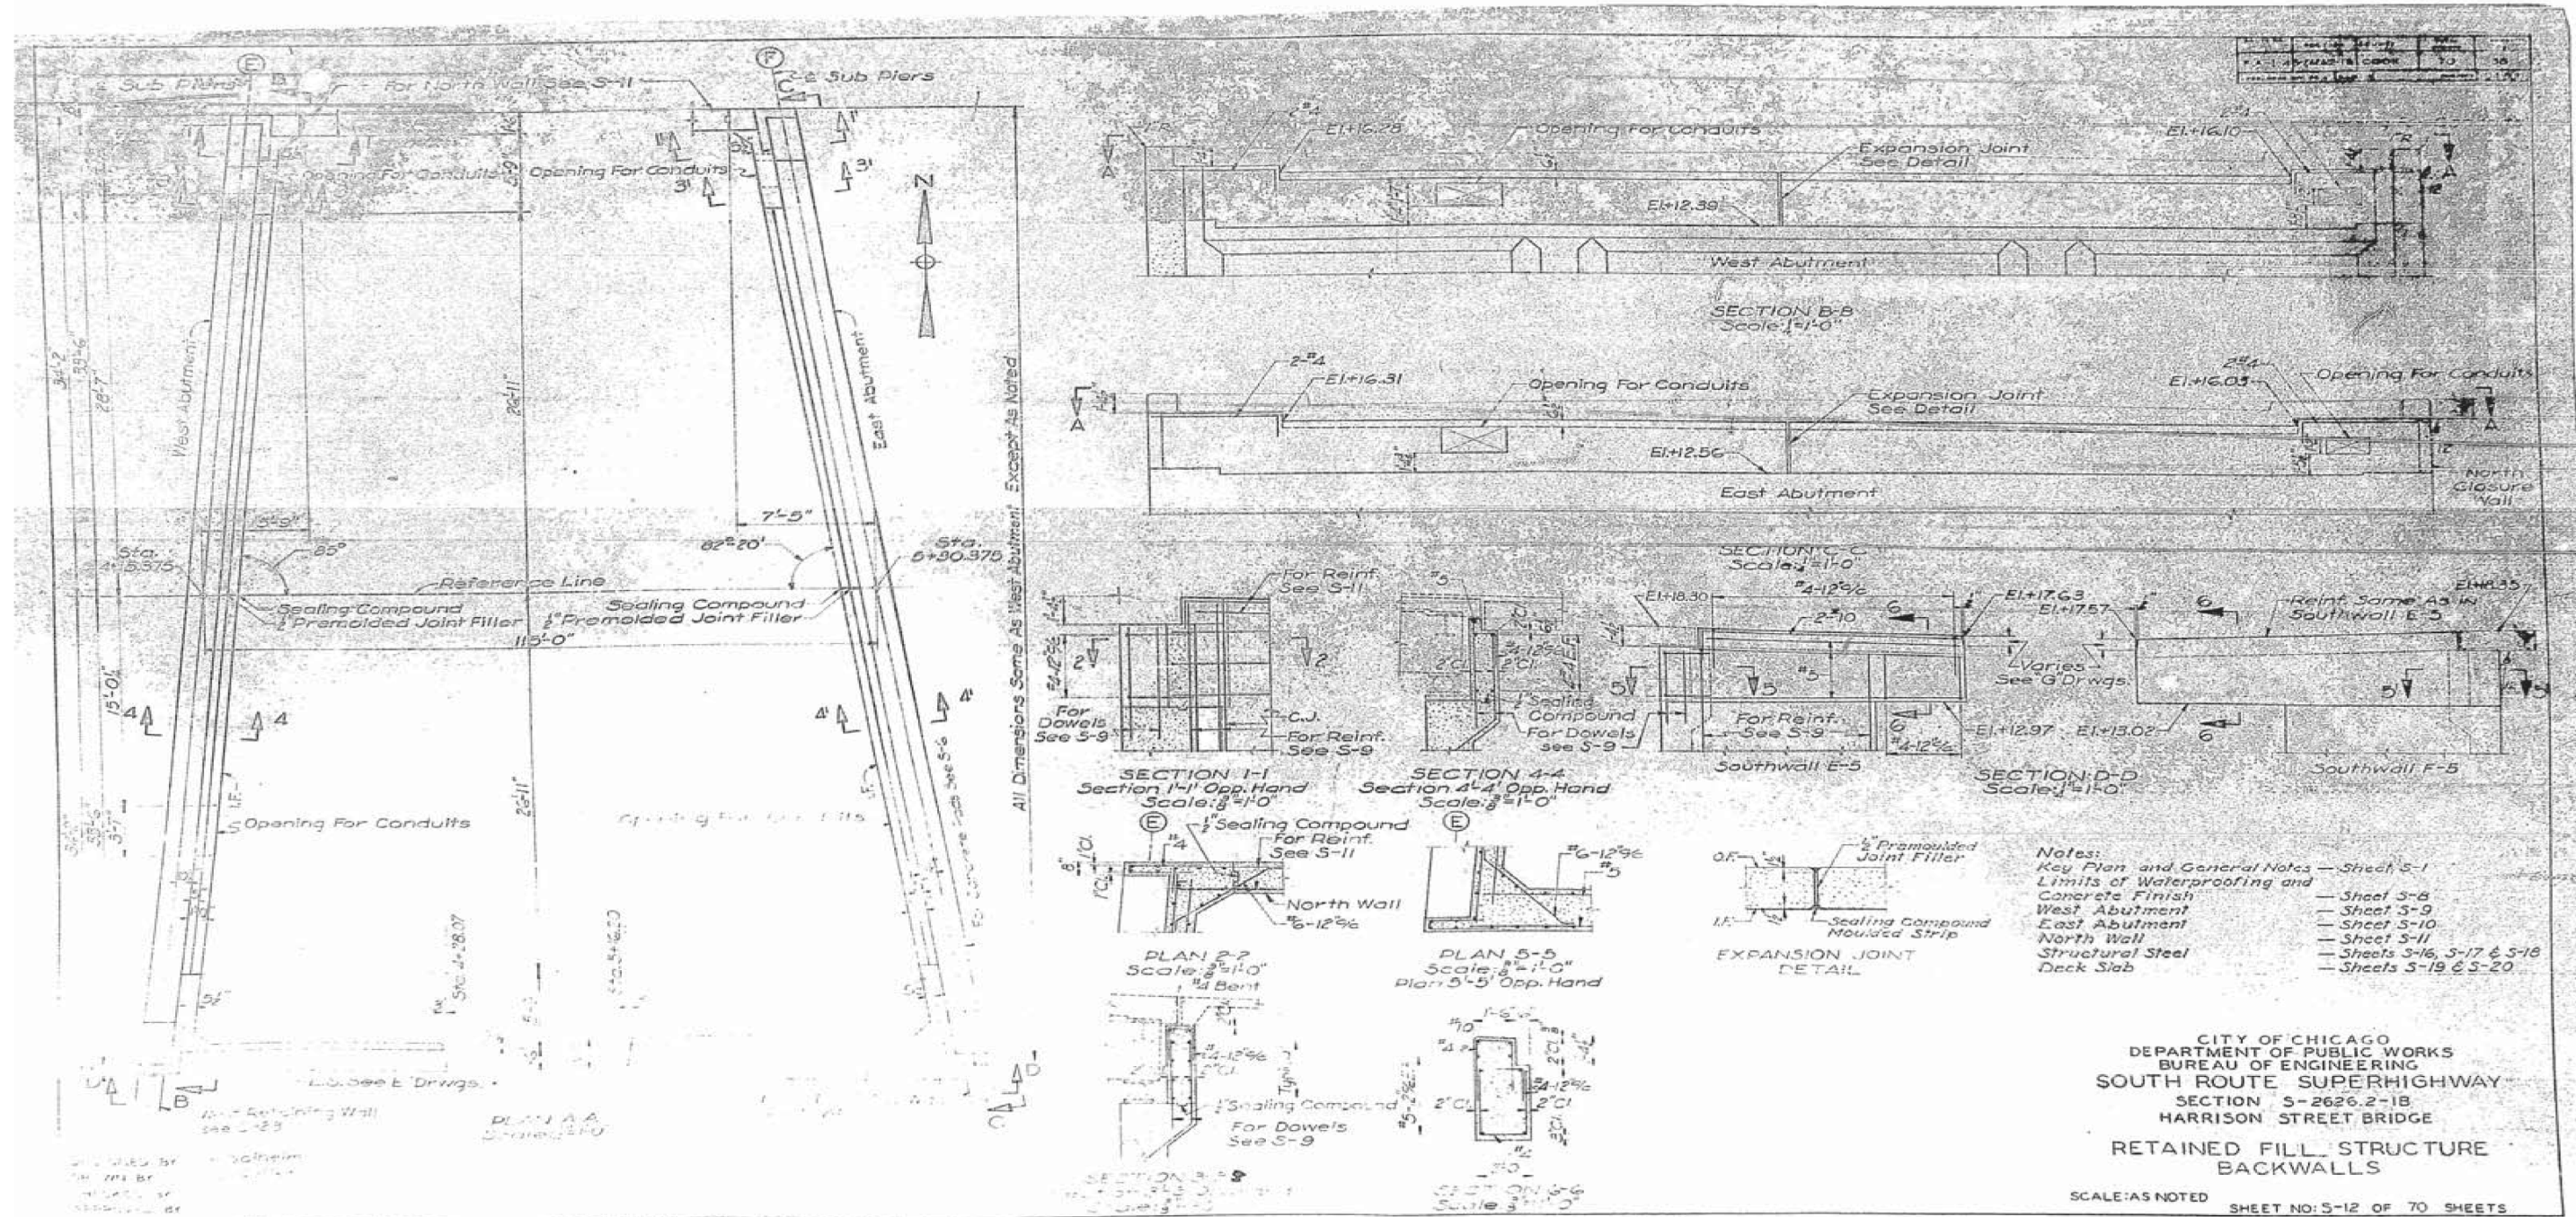

CITY OF CHICAGO
 DEPARTMENT OF PUBLIC WORKS
 BUREAU OF ENGINEERING
 SOUTH ROUTE SUPERHIGHWAY
 SECTION S-2626.2-1B
 HARRISON STREET BRIDGE
 RETAINED FILL STRUCTURE
 BACKWALLS

SCALE: AS NOTED SHEET NO: S-12 OF 70 SHEETS

USER NAME = dunkerleyb	DESIGNED -	REVISED
	CHECKED -	REVISED
PLOT SCALE = N.T.S.	DRAWN -	REVISED
PLOT DATE = 11/26/2013	CHECKED -	REVISED

STATE OF ILLINOIS
 DEPARTMENT OF TRANSPORTATION

EXISTING AS-BUILTS SN 016-1088

SHEET NO. AS-42 OF AS-72 SHEETS

F.A.I. RTE.	SECTION	COUNTY	TOTAL SHEETS	SHEET NO.
90/94/290	2013-036R	COOK	256	184
CONTRACT NO. 60W71				
ILLINOIS FED. AID PROJECT -NUMBER-				

D:\60W71-sht-AS-BUILT-42.dgn