


FOR INFORMATION ONLY

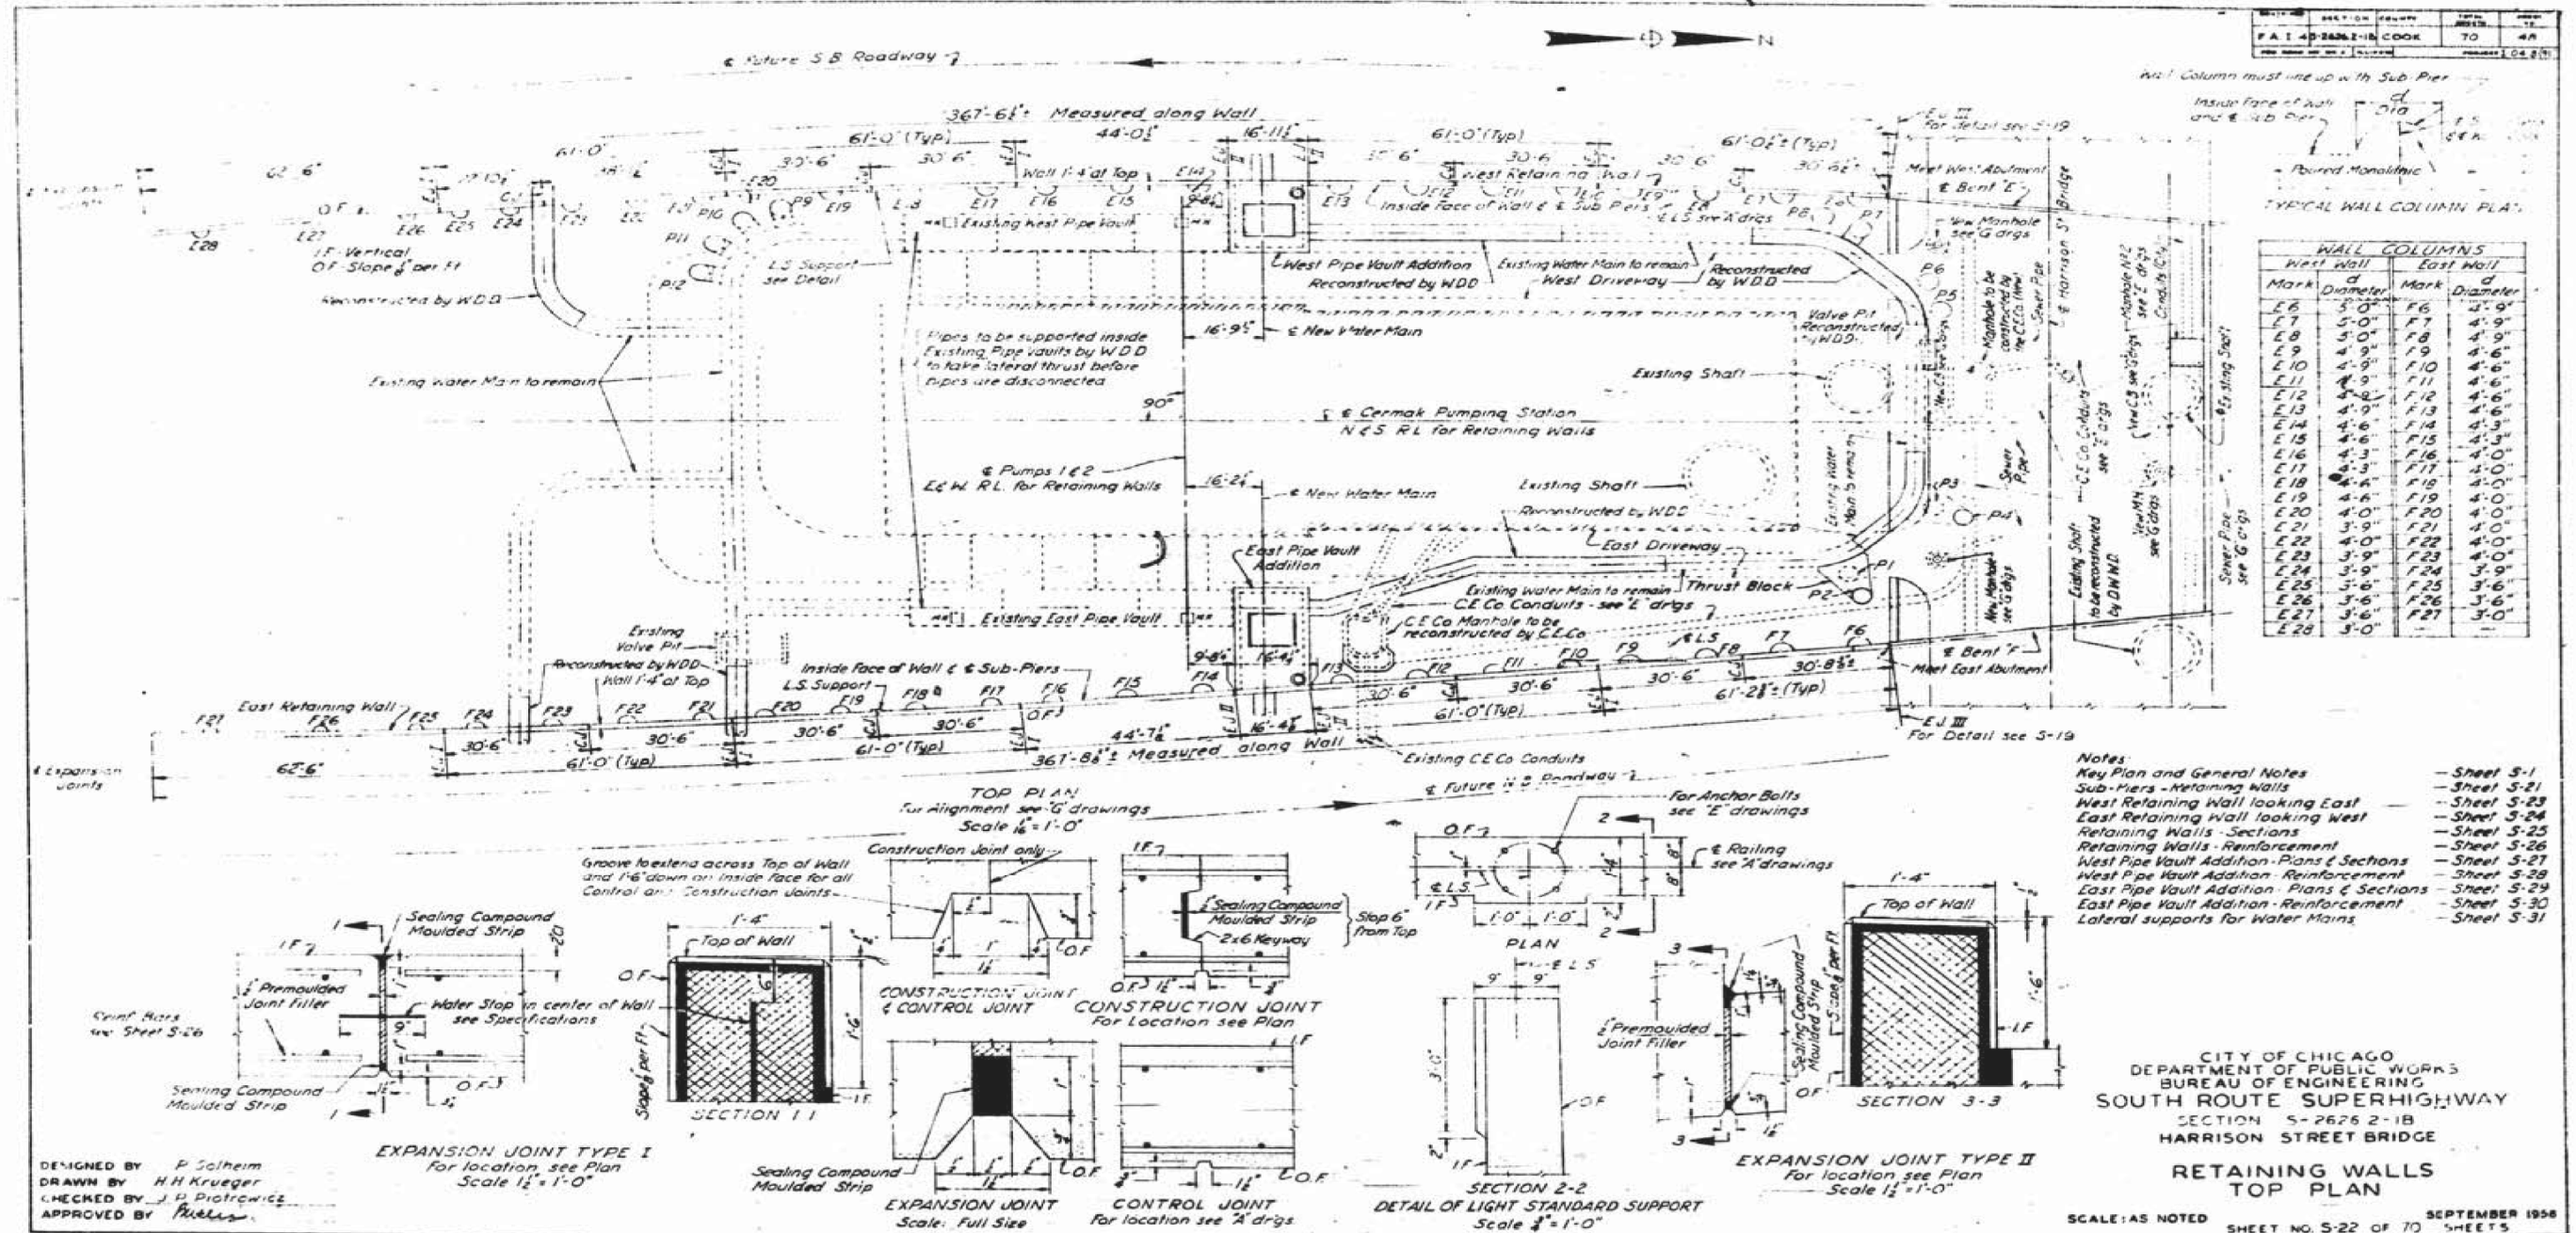

- Notes
- Key Plan and General Notes - Sheet S-1
 - Sub-Piers - Retaining Walls - Sheet S-21
 - West Retaining Wall looking East - Sheet S-23
 - East Retaining Wall looking West - Sheet S-24
 - Retaining Walls - Sections - Sheet S-25
 - Retaining Walls - Reinforcement - Sheet S-26
 - West Pipe Vault Addition - Plans & Sections - Sheet S-27
 - West Pipe Vault Addition - Reinforcement - Sheet S-28
 - East Pipe Vault Addition - Plans & Sections - Sheet S-29
 - East Pipe Vault Addition - Reinforcement - Sheet S-30
 - Lateral supports for Water Mains - Sheet S-31

CITY OF CHICAGO
 DEPARTMENT OF PUBLIC WORKS
 BUREAU OF ENGINEERING
 SOUTH ROUTE SUPERHIGHWAY
 SECTION S-2625 2-1B
 HARRISON STREET BRIDGE
 RETAINING WALLS
 TOP PLAN
 SCALE: AS NOTED
 SHEET NO. S-22 OF 70 SHEETS
 SEPTEMBER 1958

DESIGNED BY P. Solheim
 DRAWN BY H.H. Krueger
 CHECKED BY J.P. Piotrowski
 APPROVED BY [Signature]

USER NAME = dunkerleyb	DESIGNED -	REVISED
	CHECKED -	REVISED
PLOT SCALE = N.T.S.	DRAWN -	REVISED
PLOT DATE = 11/26/2013	CHECKED -	REVISED

STATE OF ILLINOIS
 DEPARTMENT OF TRANSPORTATION

EXISTING AS-BUILTS SN 016-1088

SHEET NO. AS-53 OF AS-72 SHEETS

F.A.I. R.E.	SECTION	COUNTY	TOTAL SHEETS	SHEET NO.
90/94/290	2013-036R	COOK	256	195
CONTRACT NO. 60W71				
ILLINOIS FED. AID PROJECT -NUMBER-				

D:\60W71-sht-AS-BUILT-53.dgn