


FOR INFORMATION ONLY

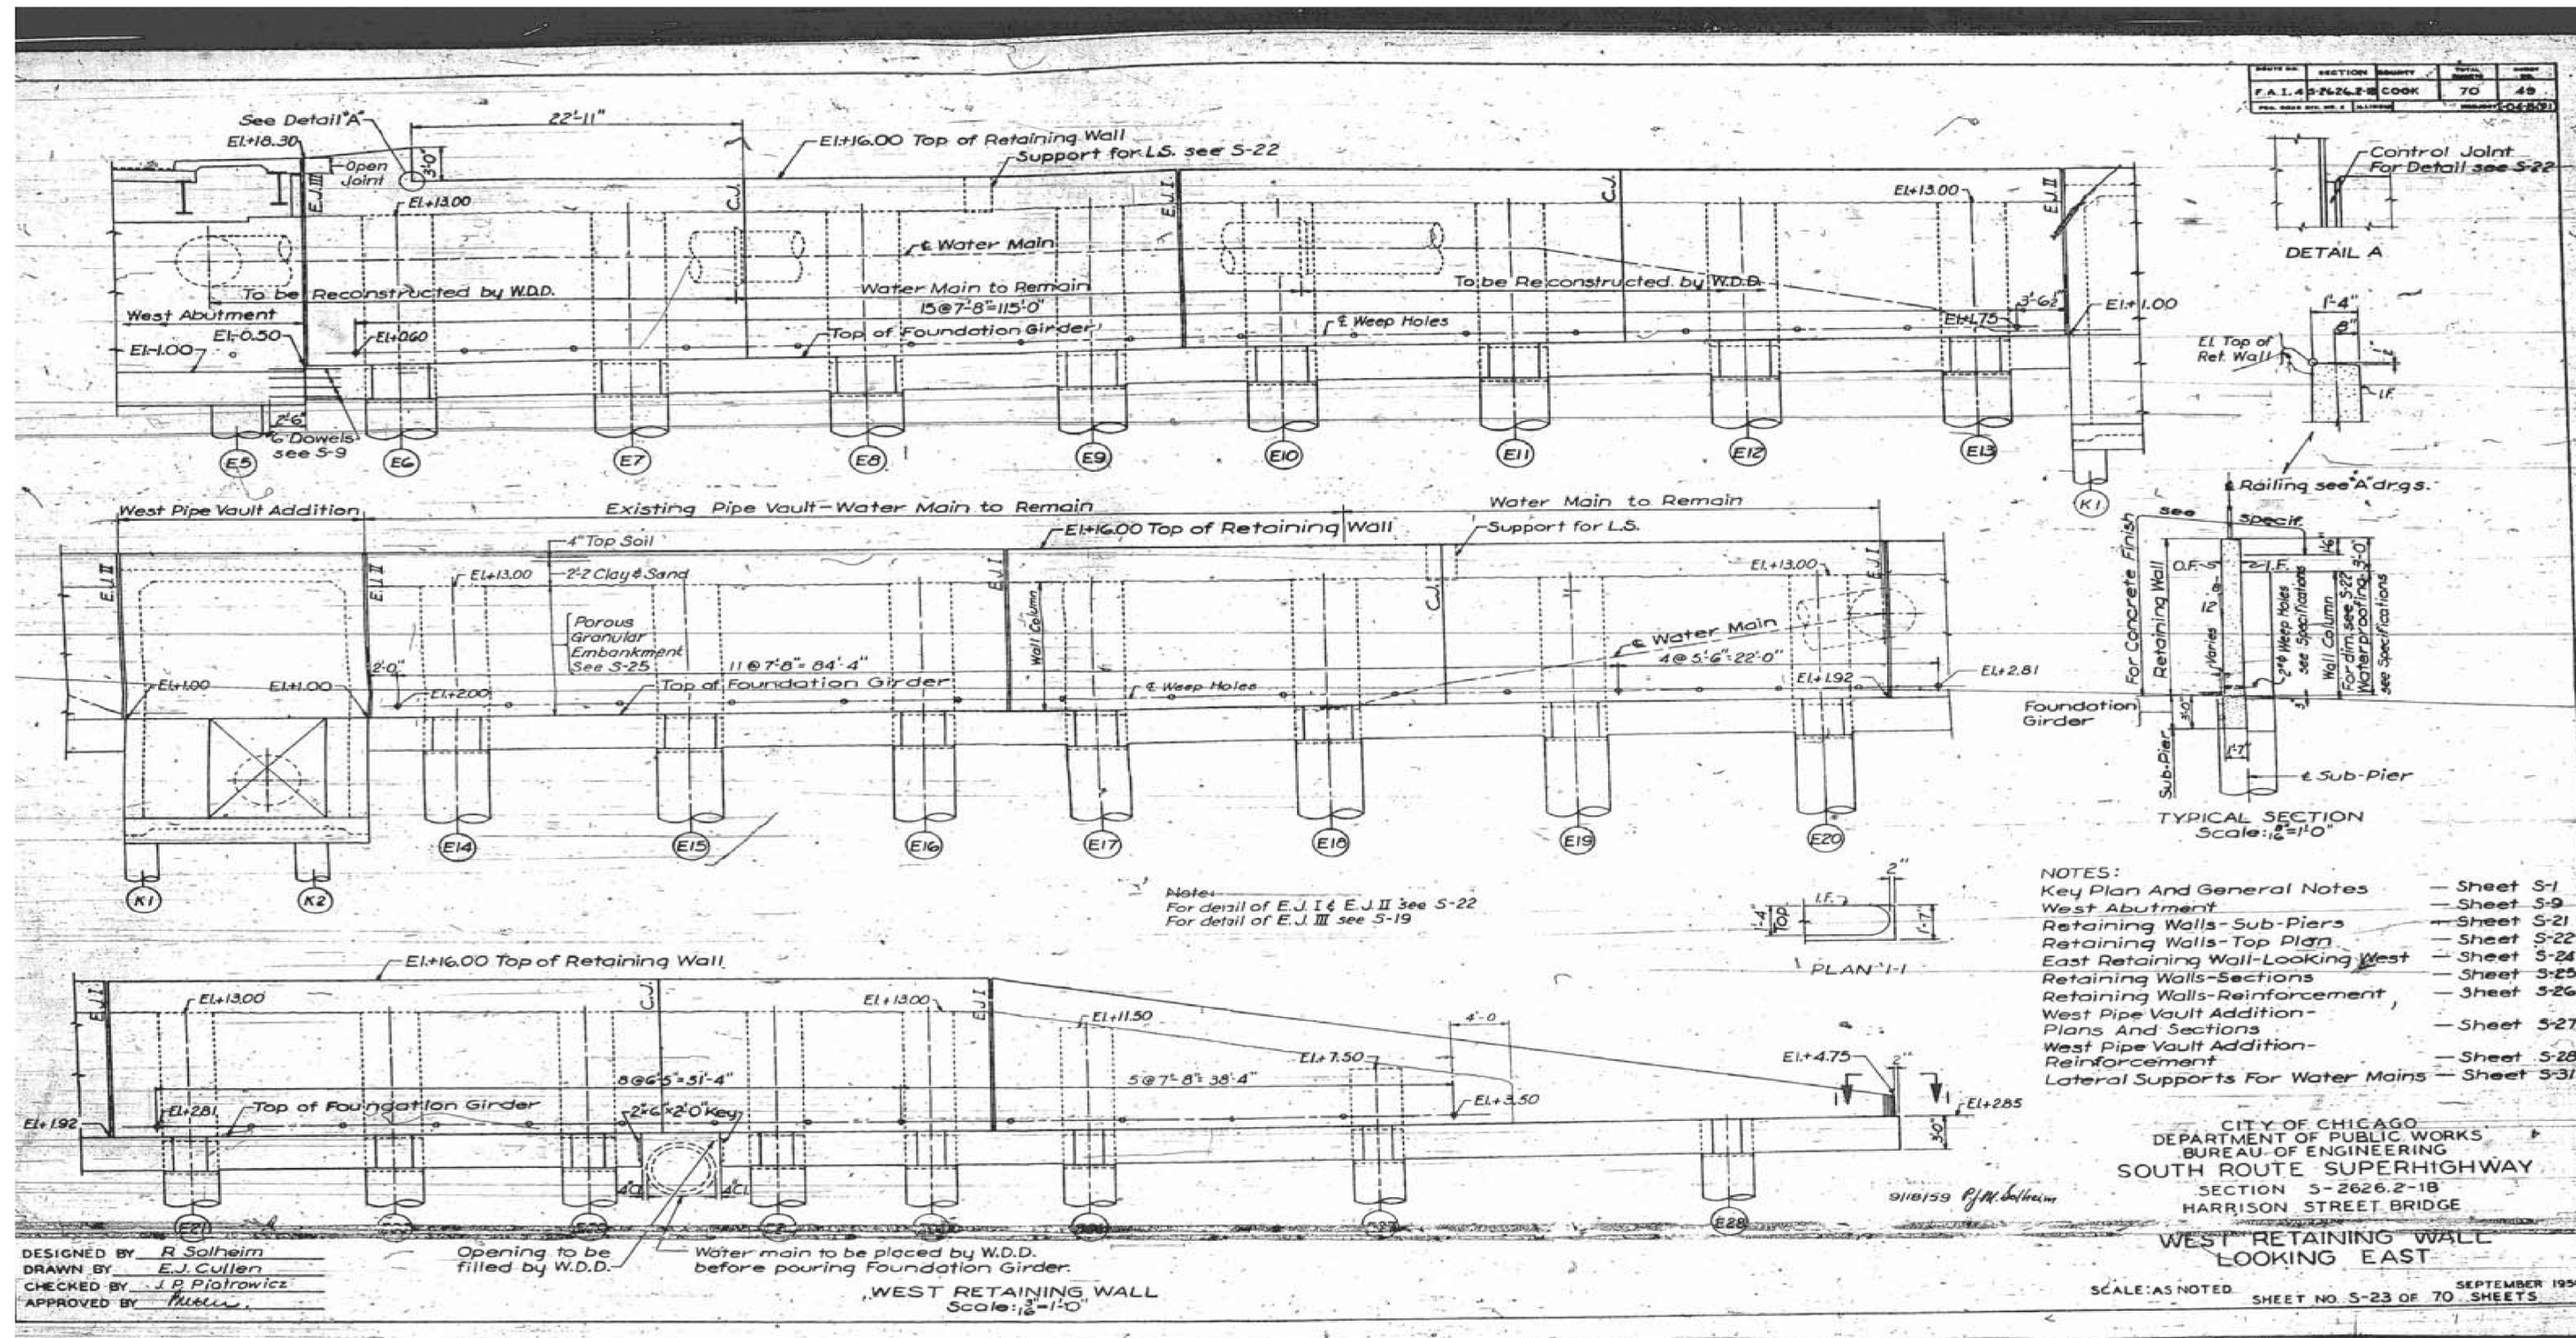

DESIGNED BY R Solheim
 DRAWN BY E.J. Cullen
 CHECKED BY J.P. Piotrowicz
 APPROVED BY [Signature]

Opening to be filled by W.D.D.
 Water main to be placed by W.D.D. before pouring Foundation Girder.
WEST RETAINING WALL
 Scale: 1/2" = 1'-0"

- NOTES:
- Key Plan And General Notes - Sheet S-1
 - West Abutment - Sheet S-9
 - Retaining Walls-Sub-Piers - Sheet S-21
 - Retaining Walls-Top Plan - Sheet S-22
 - East Retaining Wall-Looking West - Sheet S-24
 - Retaining Walls-Sections - Sheet S-25
 - Retaining Walls-Reinforcement - Sheet S-26
 - West Pipe Vault Addition-Plans And Sections - Sheet S-27
 - West Pipe Vault Addition-Reinforcement - Sheet S-28
 - Lateral Supports For Water Mains - Sheet S-31

CITY OF CHICAGO
 DEPARTMENT OF PUBLIC WORKS
 BUREAU OF ENGINEERING
 SOUTH ROUTE SUPERHIGHWAY
 SECTION 5-2626.2-1B
 HARRISON STREET BRIDGE
WEST RETAINING WALL
 LOOKING EAST

SCALE: AS NOTED SHEET NO. S-23 OF 70 SHEETS SEPTEMBER 1959

D:\GOW71-sht-AS-BUILT-54.dgn

| | | |
|------------------------|------------|---------|
| USER NAME = dunkerleyb | DESIGNED - | REVISED |
| | CHECKED - | REVISED |
| PLOT SCALE = N.T.S. | DRAWN - | REVISED |
| PLOT DATE = 11/26/2013 | CHECKED - | REVISED |

STATE OF ILLINOIS
 DEPARTMENT OF TRANSPORTATION

EXISTING AS-BUILTS SN 016-1088

SHEET NO. AS-54 OF AS-72 SHEETS

| | | | | |
|------------------------------------|-----------|--------|--------------|-----------|
| F.A.I. R.E. | SECTION | COUNTY | TOTAL SHEETS | SHEET NO. |
| 90/94/290 | 2013-036R | COOK | 256 | 196 |
| CONTRACT NO. 60W71 | | | | |
| ILLINOIS FED. AID PROJECT -NUMBER- | | | | |