


FOR INFORMATION ONLY

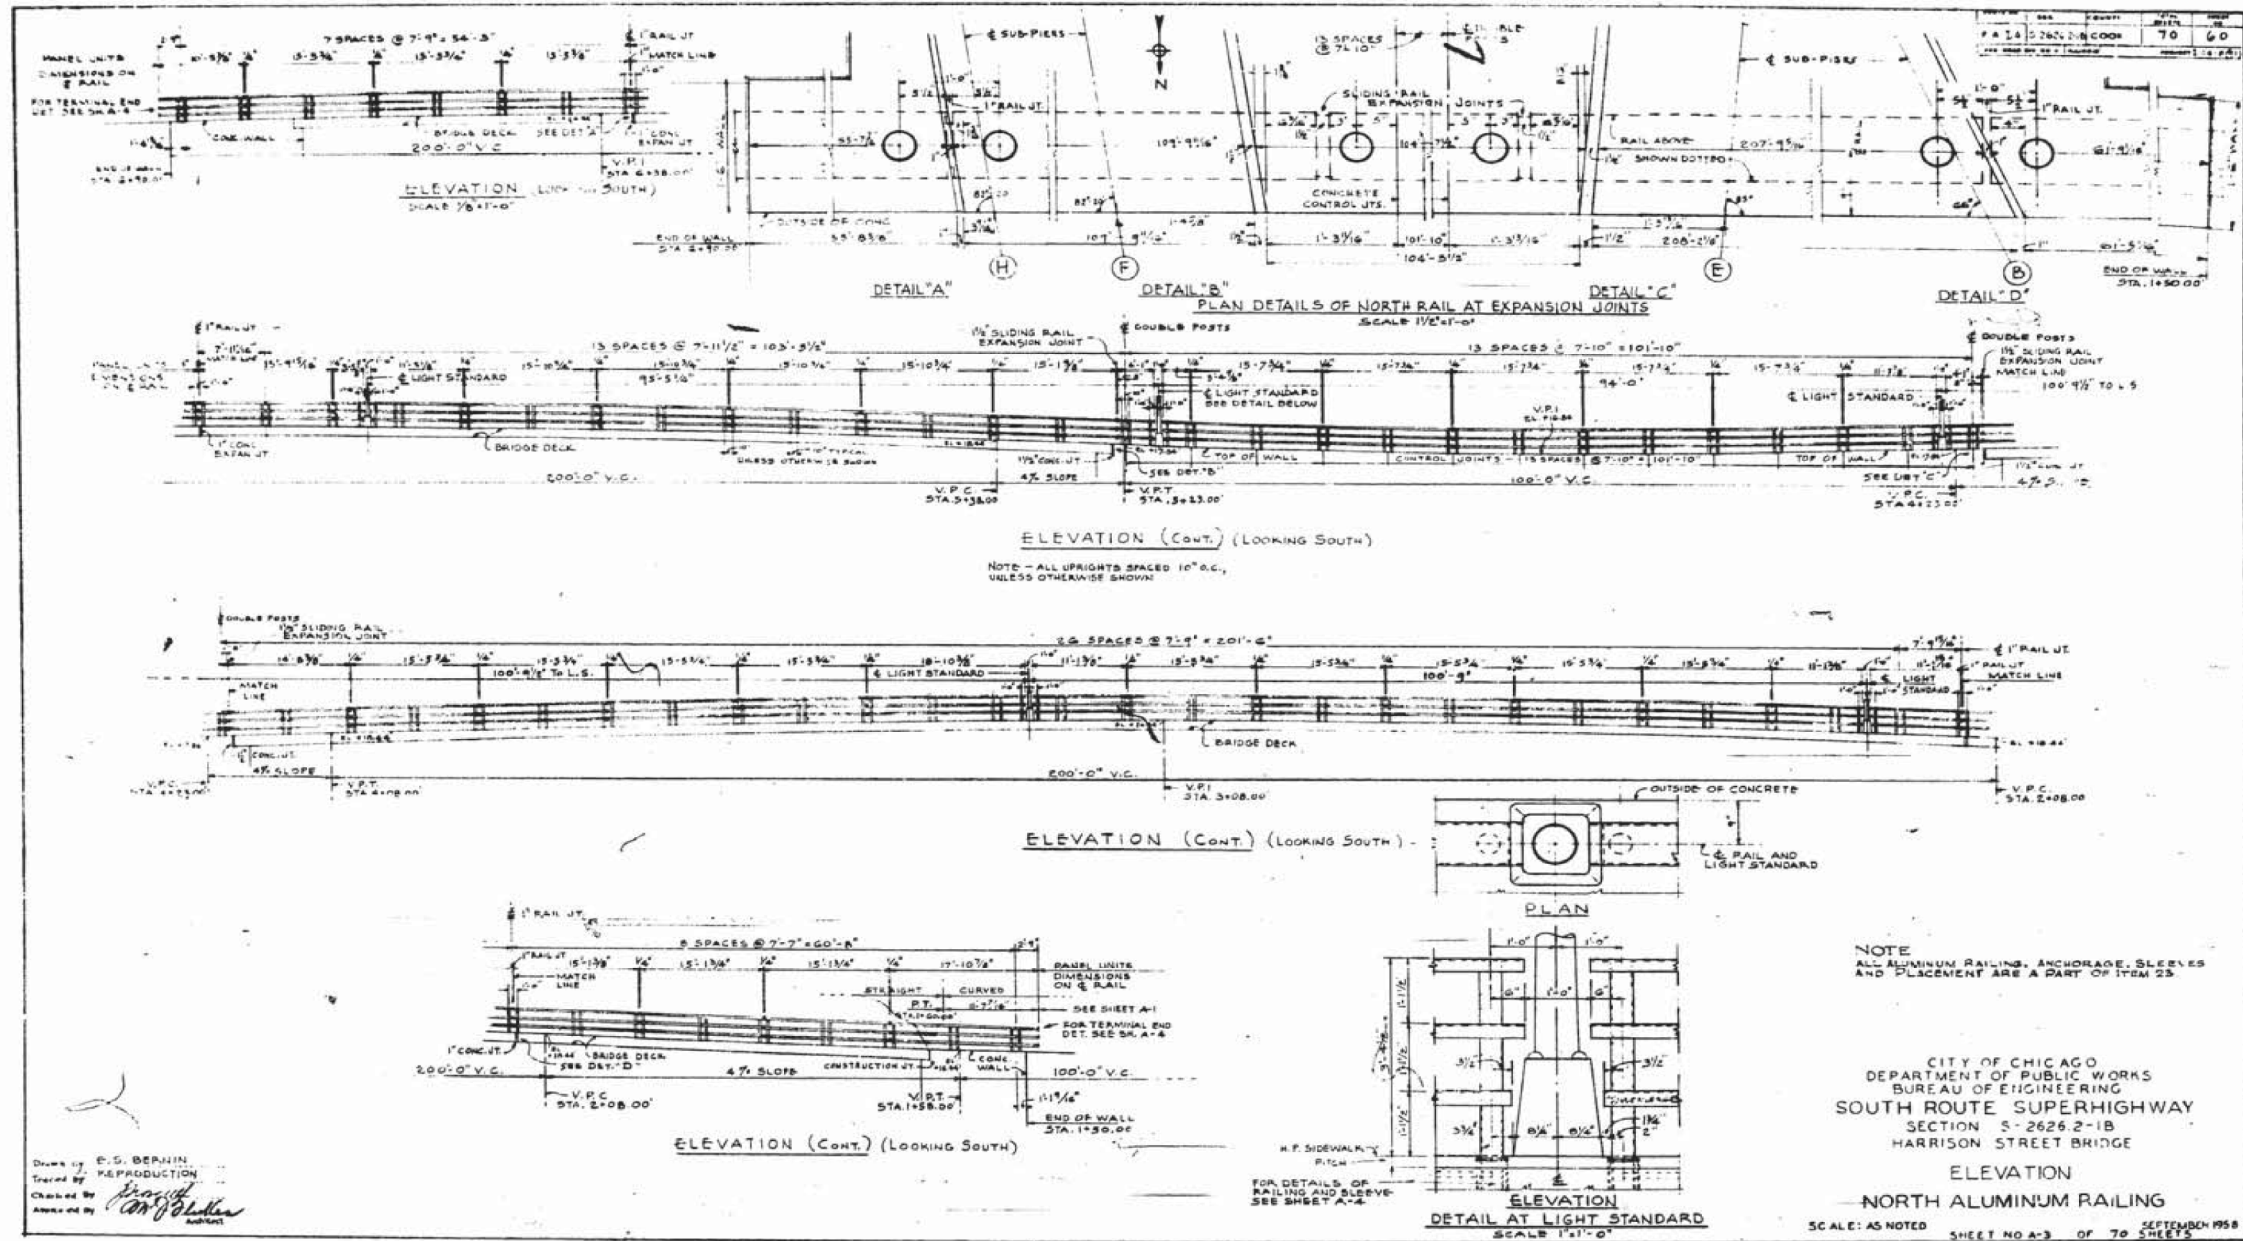

Drawn by E.S. BERNIN
 Checked by [Signature]
 Approved by [Signature]

NOTE
 ALL ALUMINUM RAILING, ANCHORAGE, SLEEVES
 AND PLACEMENT ARE A PART OF ITEM 23

CITY OF CHICAGO
 DEPARTMENT OF PUBLIC WORKS
 BUREAU OF ENGINEERING
 SOUTH ROUTE SUPERHIGHWAY
 SECTION S-2626.2-1B
 HARRISON STREET BRIDGE

ELEVATION
 NORTH ALUMINUM RAILING

SCALE: AS NOTED SHEET NO. A-3 OF 70 SHEETS
 SEPTEMBER 1958

D:\60W71-sht-AS-BUILT-63.dgn

USER NAME = dunkerleyb	DESIGNED -	REVISED -
PLOT SCALE = N.T.S.	CHECKED -	REVISED -
PLOT DATE = 11/26/2013	DRAWN -	REVISED -
	CHECKED -	REVISED -

STATE OF ILLINOIS
 DEPARTMENT OF TRANSPORTATION

EXISTING AS-BUILTS SN 016-1088

SHEET NO. AS-63 OF AS-72 SHEETS

F.A.I. R.T.E. 90/94/290	SECTION 2013-036R	COUNTY COOK	TOTAL SHEETS 256	SHEET NO. 205
CONTRACT NO. 60W71				ILLINOIS FED. AID PROJECT -NUMBER-