


FOR INFORMATION ONLY

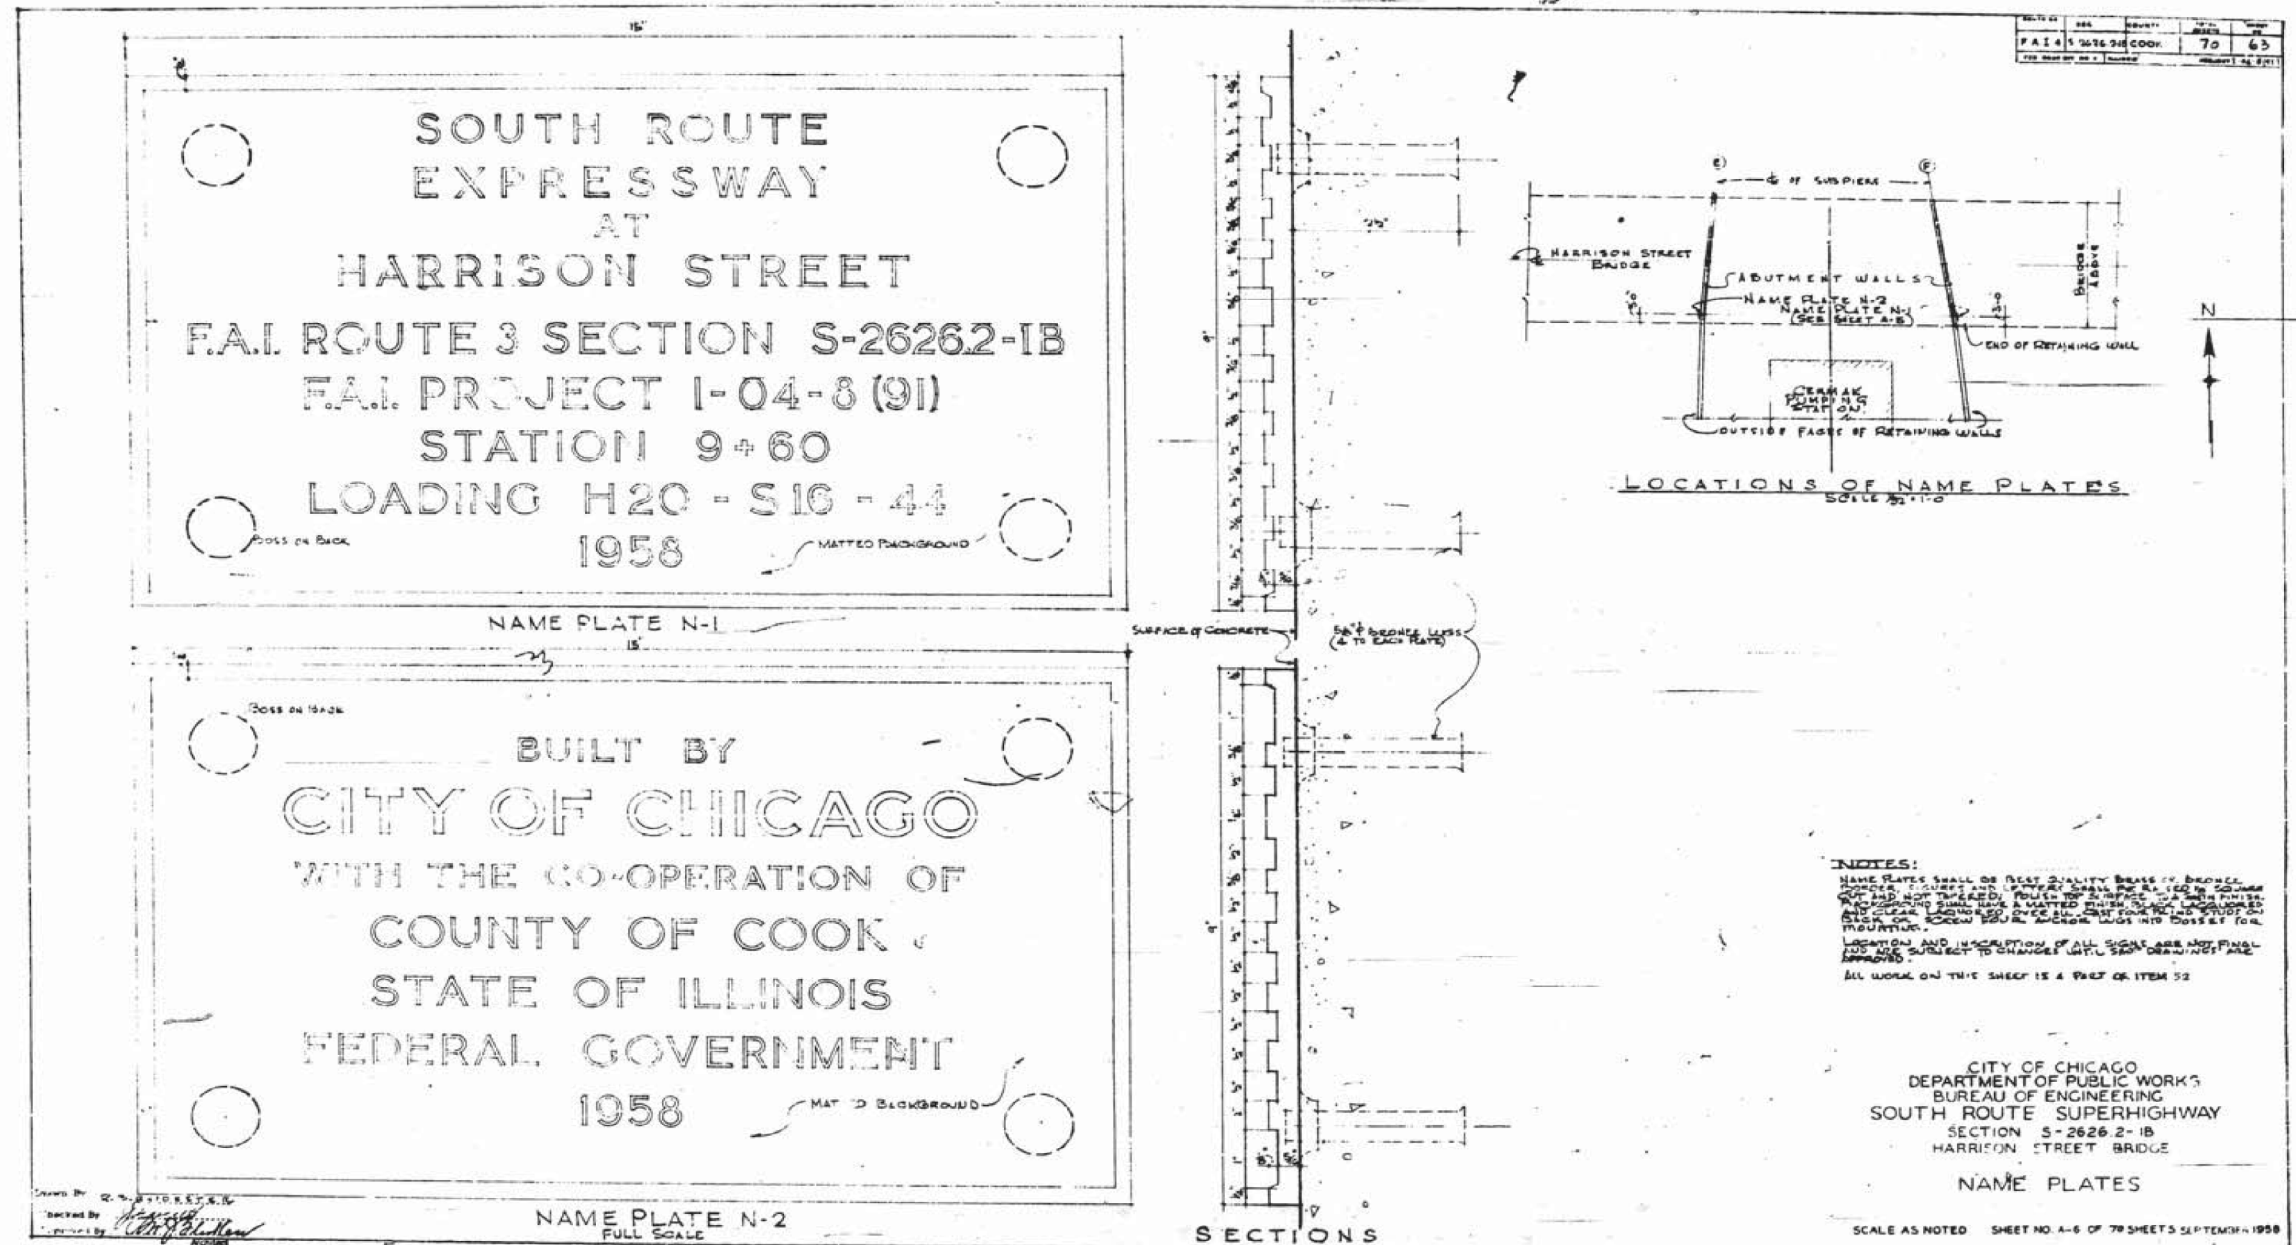

NOTES:
 NAME PLATES SHALL BE BEST QUALITY BRASS OR BRONZE.
 LETTERS, FIGURES AND SYMBOLS SHALL BE AS SET IN STANDARD
 FONT AND NOT THIN-LINED. FINISH OF SURFACE OF BRASS SHALL
 BE POLISHED. NAME PLATES SHALL BE MOUNTED ON THE BRIDGE
 STRUCTURE WITH A MATTED BRUSH OF BRASS BRUSHES
 BEING USED TO REMOVE ALL OXIDE AND TO PREPARE THE
 SURFACE FOR THE BRASS ANCHOR WEDGES INTO HOLES FOR
 MOUNTING.
 LOCATION AND INSCRIPTION OF ALL SIGNS ARE NOT FINAL
 AND ARE SUBJECT TO CHANGE UNTIL SIGN ORDINANCES ARE
 APPROVED.
 ALL WORK ON THIS SHEET IS A PART OF ITEM 52

CITY OF CHICAGO
 DEPARTMENT OF PUBLIC WORKS
 BUREAU OF ENGINEERING
 SOUTH ROUTE SUPERHIGHWAY
 SECTION S-2626.2-1B
 HARRISON STREET BRIDGE
NAME PLATES

SCALE AS NOTED SHEET NO. A-6 OF 78 SHEETS SEPTEMBER 1958

D:\60W71-shr-AS-BUILT-66.dgn

| | | |
|------------------------|------------|---------|
| USER NAME = dunkerleyb | DESIGNED - | REVISED |
| | CHECKED - | REVISED |
| PLOT SCALE = N.T.S. | DRAWN - | REVISED |
| PLOT DATE = 11/26/2013 | CHECKED - | REVISED |

STATE OF ILLINOIS
 DEPARTMENT OF TRANSPORTATION

EXISTING AS-BUILTS SN 016-1088

SHEET NO. AS-66 OF AS-72 SHEETS

| | | | | |
|------------------------------------|-----------|--------|--------------|-----------|
| F.A.I. RTE. | SECTION | COUNTY | TOTAL SHEETS | SHEET NO. |
| 90/94/290 | 2013-036R | COOK | 256 | 208 |
| CONTRACT NO. 60W71 | | | | |
| ILLINOIS FED. AID PROJECT -NUMBER- | | | | |