


FOR INFORMATION ONLY

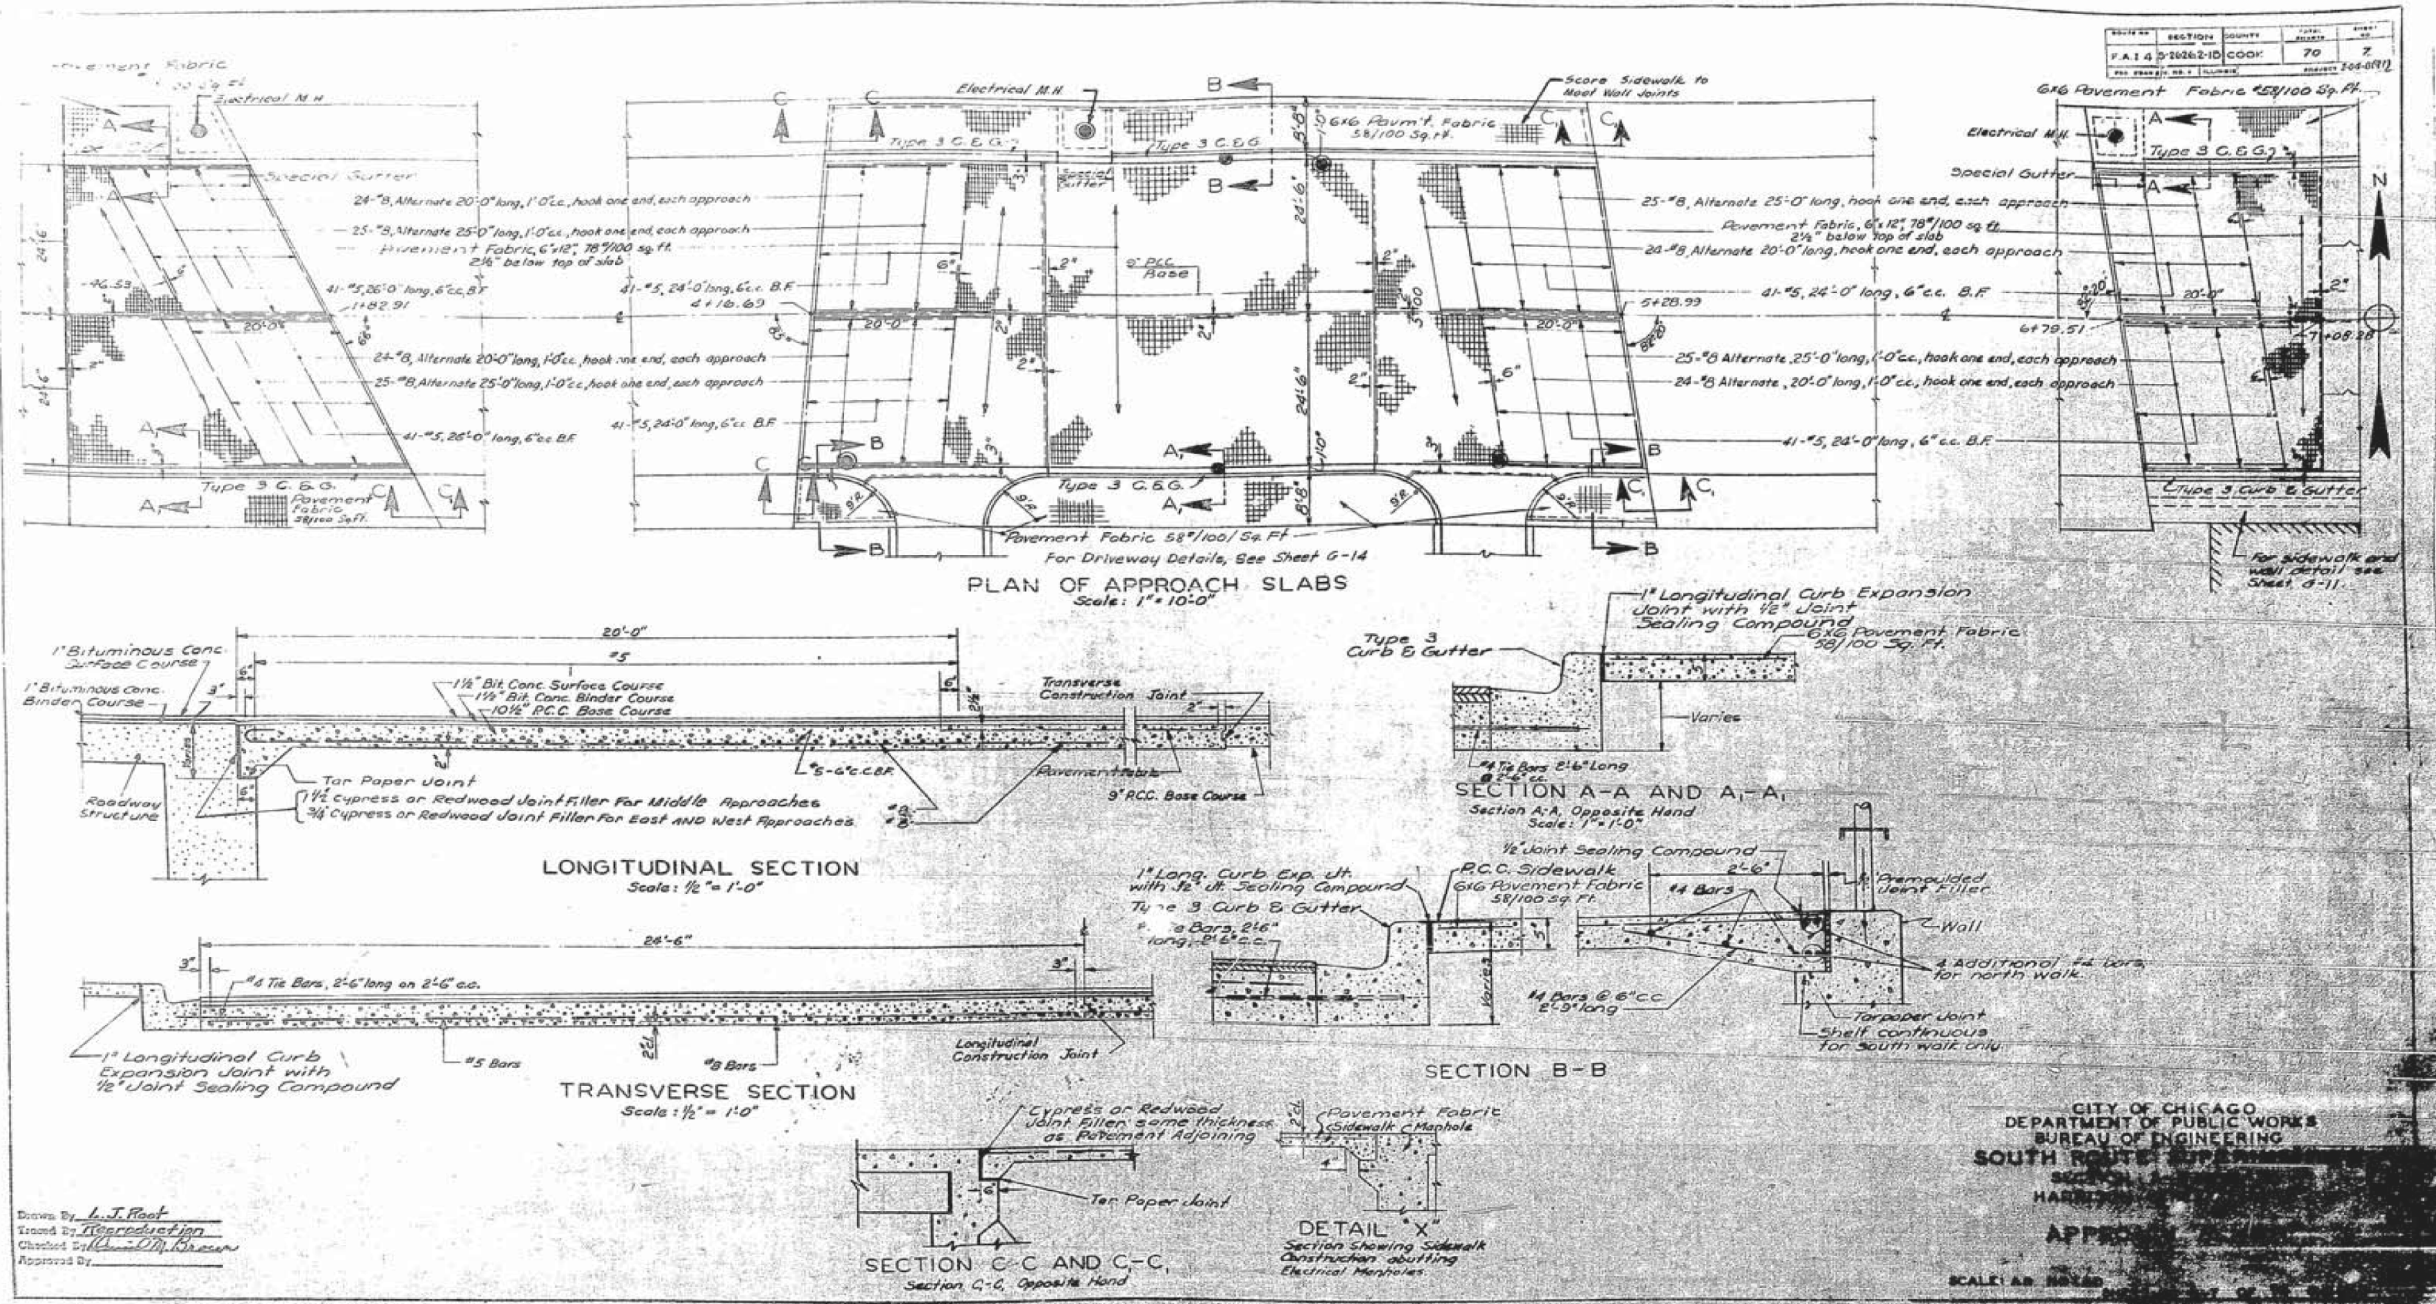

Drawn By: L.J. Root
 Traced By: [Signature]
 Checked By: [Signature]
 Approved By:

CITY OF CHICAGO
 DEPARTMENT OF PUBLIC WORKS
 BUREAU OF ENGINEERING
 SOUTH ROUTE 1
 HARRISBURG, ILL.
 APPROPRIATE TO THE PROJECT
 SCALE: AS SHOWN

D:\6071-sht-AS-BUILT-70.dgn

USER NAME = dunkerleyb	DESIGNED -	REVISED
	CHECKED -	REVISED
PLOT SCALE = N.T.S.	DRAWN -	REVISED
PLOT DATE = 11/26/2013	CHECKED -	REVISED

STATE OF ILLINOIS
 DEPARTMENT OF TRANSPORTATION

EXISTING AS-BUILTS SN 016-1088

SHEET NO. AS-70 OF AS-72 SHEETS

F.A.I. R.E. 90/94/290	SECTION 2013-036R	COUNTY COOK	TOTAL SHEETS 256	SHEET NO. 212
				CONTRACT NO. 60W71
ILLINOIS FED. AID PROJECT -NUMBER-				