


FOR INFORMATION ONLY

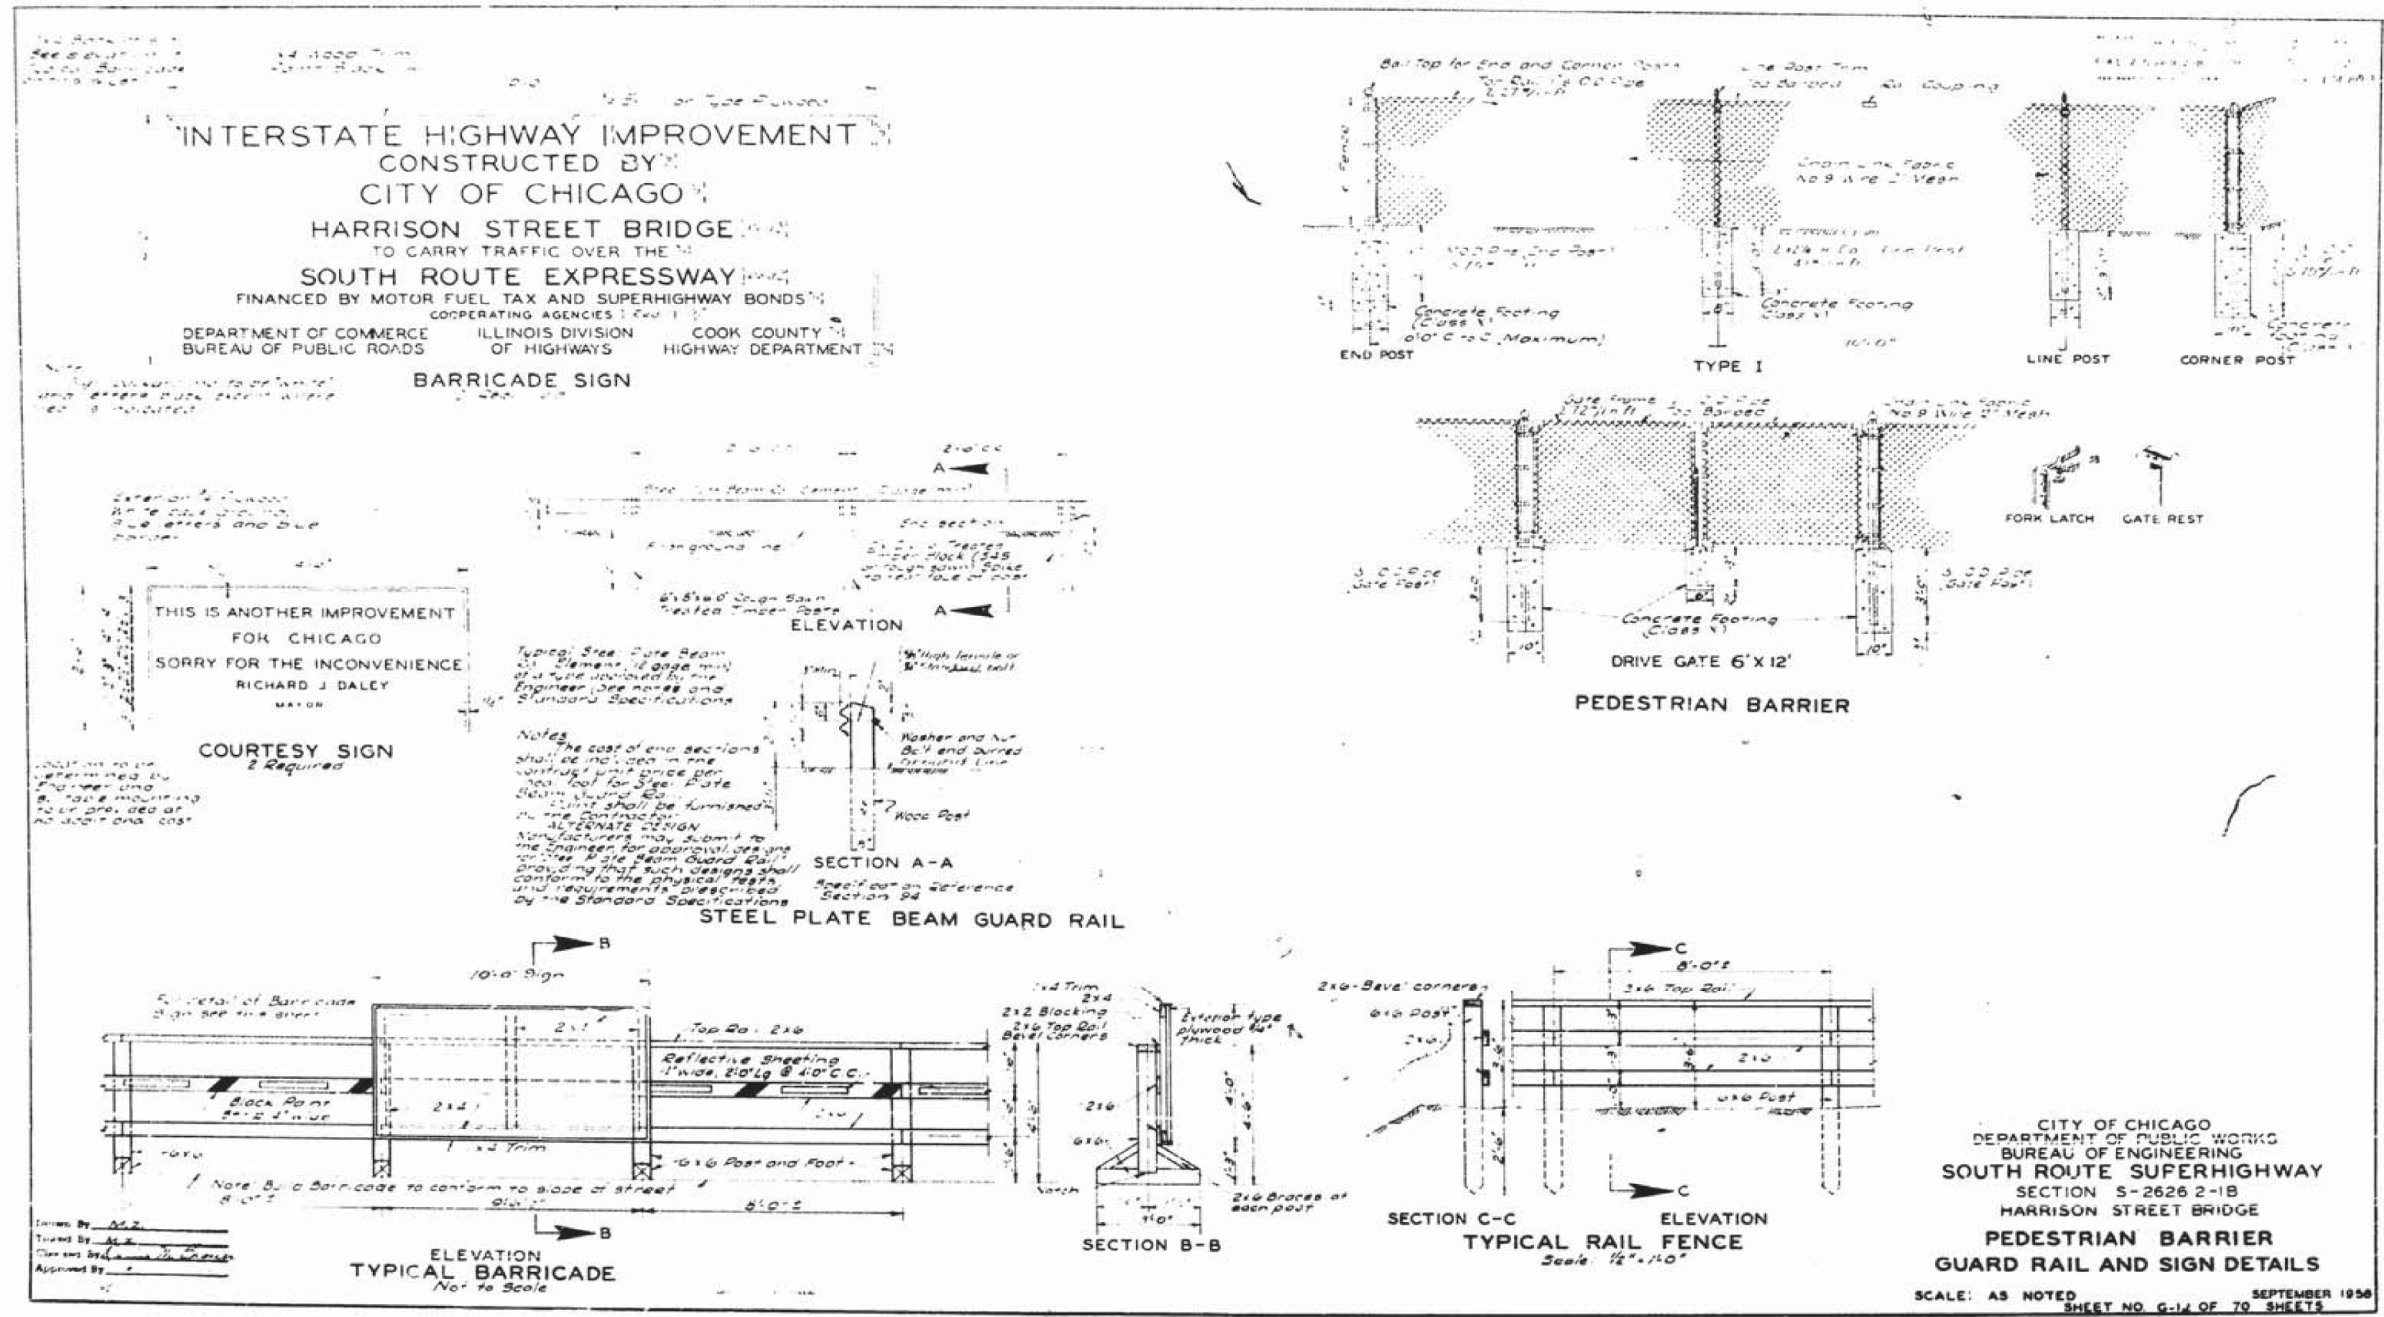

D:\60W71-sht-AS-BUILT-72.dgn

USER NAME = dunkerleyb	DESIGNED -	REVISED -
PLotted By =	CHECKED -	REVISED -
PLot SCALE = N.T.S.	DRAWN -	REVISED -
PLot DATE = 11/26/2013	CHECKED -	REVISED -

STATE OF ILLINOIS
DEPARTMENT OF TRANSPORTATION

EXISTING AS-BUILTS SN 016-1088

SHEET NO. AS-72 OF AS-72 SHEETS

F.A.I. RTE. 90/94/290	SECTION 2013-036R	COUNTY COOK	TOTAL SHEETS 256	SHEET NO. 214
				CONTRACT NO. 60W71
ILLINOIS FED. AID PROJECT -NUMBER-				