


F.A.P. RTE.	SECTION	COUNTY	TOTAL SHEETS	SHEET NO.
612	101B-1	SCHUYLER	15	3
FED. ROAD DIST. NO.	ILLINOIS	FED. AID PROJECT		

CONTRACT NO. 72310

**SUMMARY OF QUANTITIES**

PAY CODE NUMBER	ITEM DESCRIPTION	UNIT	TOTAL QUANTITY	ROADWAY 80% FEDERAL 20% STATE
20100110	TREE REMOVAL (6-15 UNITS DIAMETER)	UNIT	111	111
20100210	TREE REMOVAL (OVER 15 UNITS DIAMETER)	UNIT	180	180
20300100	CHANNEL EXCAVATION	CU YD	1840	1840
25001100	SEEDING, CLASS 3 (SPECIAL)	ACRE	2.3	2.3
25100630	EROSION CONTROL BLANKET	SQ YD	1069	1069
28000250	TEMPORARY EROSION CONTROL SEEDING	POUND	230	230
28000300	TEMPORARY DITCH CHECKS	EACH	3	3
28000400	PERIMETER EROSION BARRIER	FOOT	303	303
<b>28100207</b>	STONE RIPRAP, CLASS A4	<b>TON</b>	<b>280</b>	<b>280</b>
<b>28100209</b>	STONE RIPRAP, CLASS A5	<b>TON</b>	<b>760</b>	<b>760</b>
28200200	FILTER FABRIC	SQ YD	1055	1055
67000400	ENGINEER'S FIELD OFFICE, TYPE A	CAL MO	2	2
67100100	MOBILIZATION	L SUM	1	1
70100450	TRAFFIC CONTROL AND PROTECTION, STANDARD 701201	L SUM	1	1
<del>X0325305</del>	<del>STRUCTURAL REPAIR OF CONCRETE (DEPTH EQUAL TO OR LESS THAN 5")</del>	<del>SQ FT</del>	<del>18</del>	<del>18</del>
<del>59000210</del>	<del>EPOXY CRACK SEALING</del>	<del>FOOT</del>	<del>30</del>	<del>30</del>
<b>59000210</b>	<b>EPOXY CRACK INJECTION</b>	<b>FOOT</b>	<b>30</b>	<b>30</b>
Z0005300	BOX CULVERT TO BE CLEANED	EACH	2	2
<del>X0333500</del>	<del>FORMED CONCRETE REPAIR</del>	<del>SQ FT</del>	<del>18</del>	<del>18</del>

△

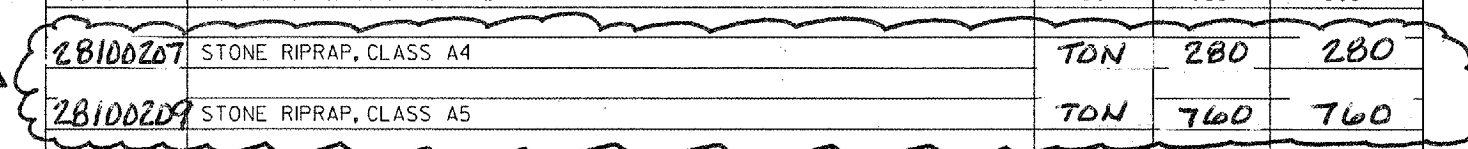

△

△ NON-PARTICIPATING

REVISIONS		ILLINOIS DEPARTMENT OF TRANSPORTATION
NAME	DATE	
		<p align="center"><b>SUMMARY OF QUANTITIES</b></p> <p align="right">DRAWN BY MLO CHECKED BY SJK</p> <p>DATE 11/03</p>

△ Rev. 3-2-07

Rev.