


CONTRACT NO. 62417

F.A. RTE.	SECTION	COUNTY	TOTAL SHEETS	SHEET NO.
	113&114R-5	WILL	525	255
STA.		TO STA.		
FED. ROAD DIST. NO.	ILLINOIS	FED. AID PROJECT		

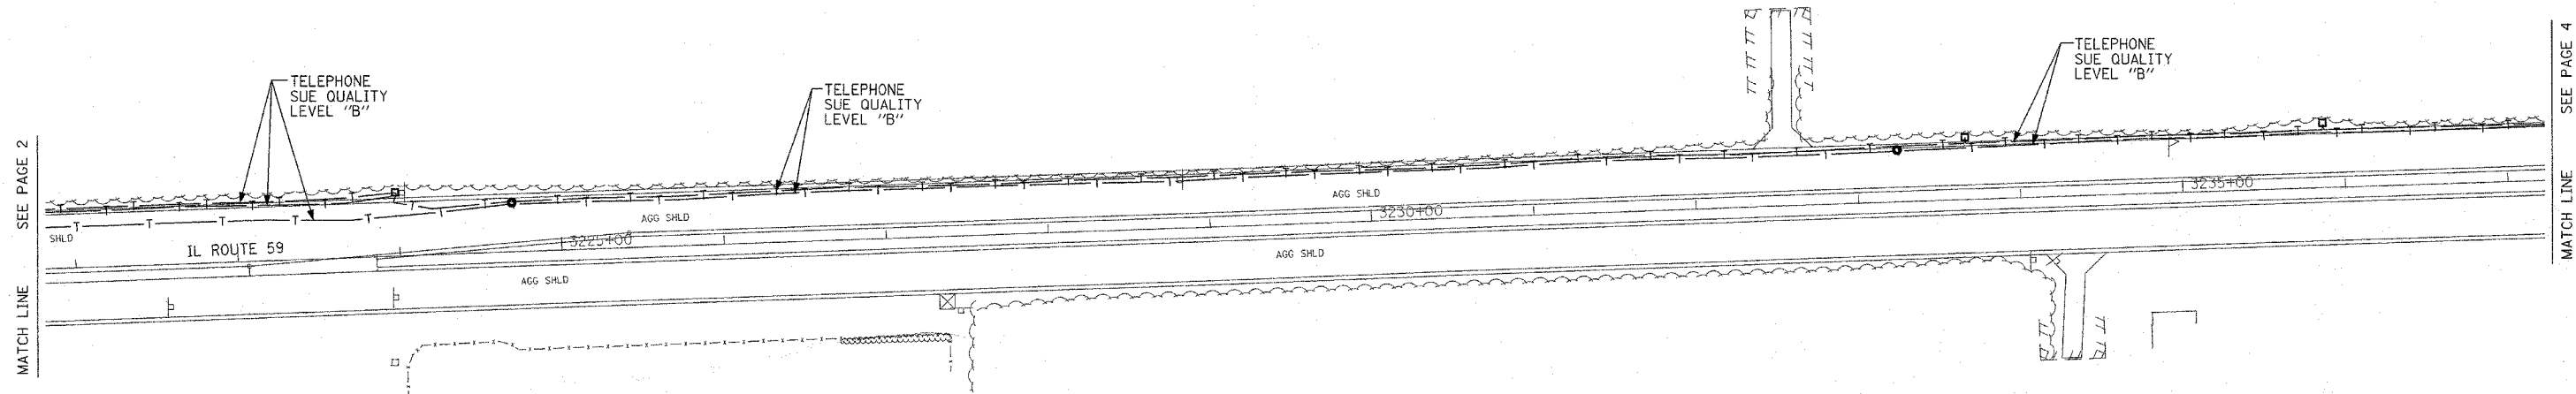

SEE PAGE 2
MATCH LINE

MATCH LINE
SEE PAGE 4

SBC will not provide TBE as-built plans for review purposes only.




TBE GROUP, INC.
 CIVIL ENGINEERING * TRANSPORTATION * ENVIRONMENTAL
 * PLANNING * UTILITY ENGINEERING/LOCATING
 SOUTHERN REGION: FL, GA, SC, NC
 NORTHERN REGION: IL, IN, MI, OH, MD, NJ, NY
 PA, VA, CANADA
 WESTERN REGION: AZ, NV, NM, TX, CA, OR, UT, WA

IL09500215, IL09500218
 TBE SUE PAGE NO: 3 of 11
 Checked by: *Sandra Jones*

SUE Quality Level "A" : Test Holes
 SUE Quality Level "B" : Designating

— T — T —	TELEPHONE
— W — — —	WATER
— G — — —	GAS
— CTV — CTV —	CABLE TELEVISION
— FO — FO —	FIBER OPTIC
— E — — —	ELECTRIC
⊙	TEST HOLE

Utilities shown on these plans as depicted in the legend have been investigated by TBE Group, Inc in accordance with SUE Industry Standards. All other information shown has been provided to TBE Group, Inc by others.


 205 W. WACKER DRIVE
 SUITE 1020
 CHICAGO, IL 60606
 (312) 704-1970

REVISIONS	
NAME	DATE

ILLINOIS DEPARTMENT OF TRANSPORTATION
 SUE Investigation of Underground Utilities
 Caton Farm Rd. to Renwick Rd.
 Contract Number: 62417
 SQL "B" DATE : 6/15/04
 DRAWN BY : KLC
 SCALE : 1" = 50'