
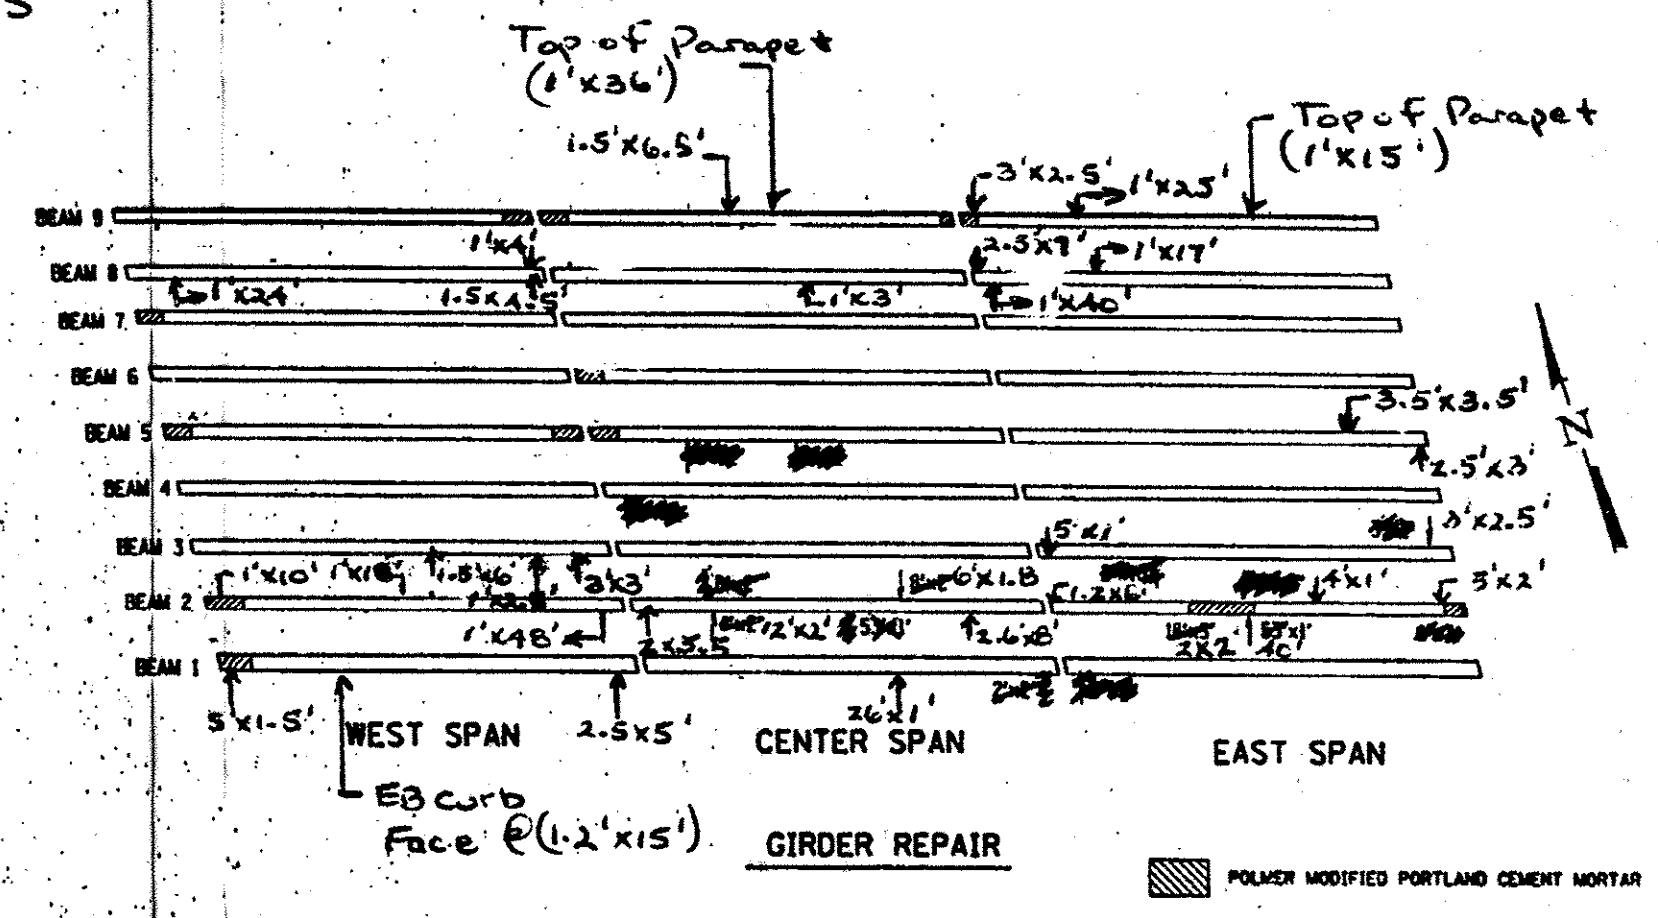


STATE	SECTION	COUNTY	TRAIL	SHEET
3523	12891	COOK	22	8
STA.	TO STA.			

SHEET 3 OF 9


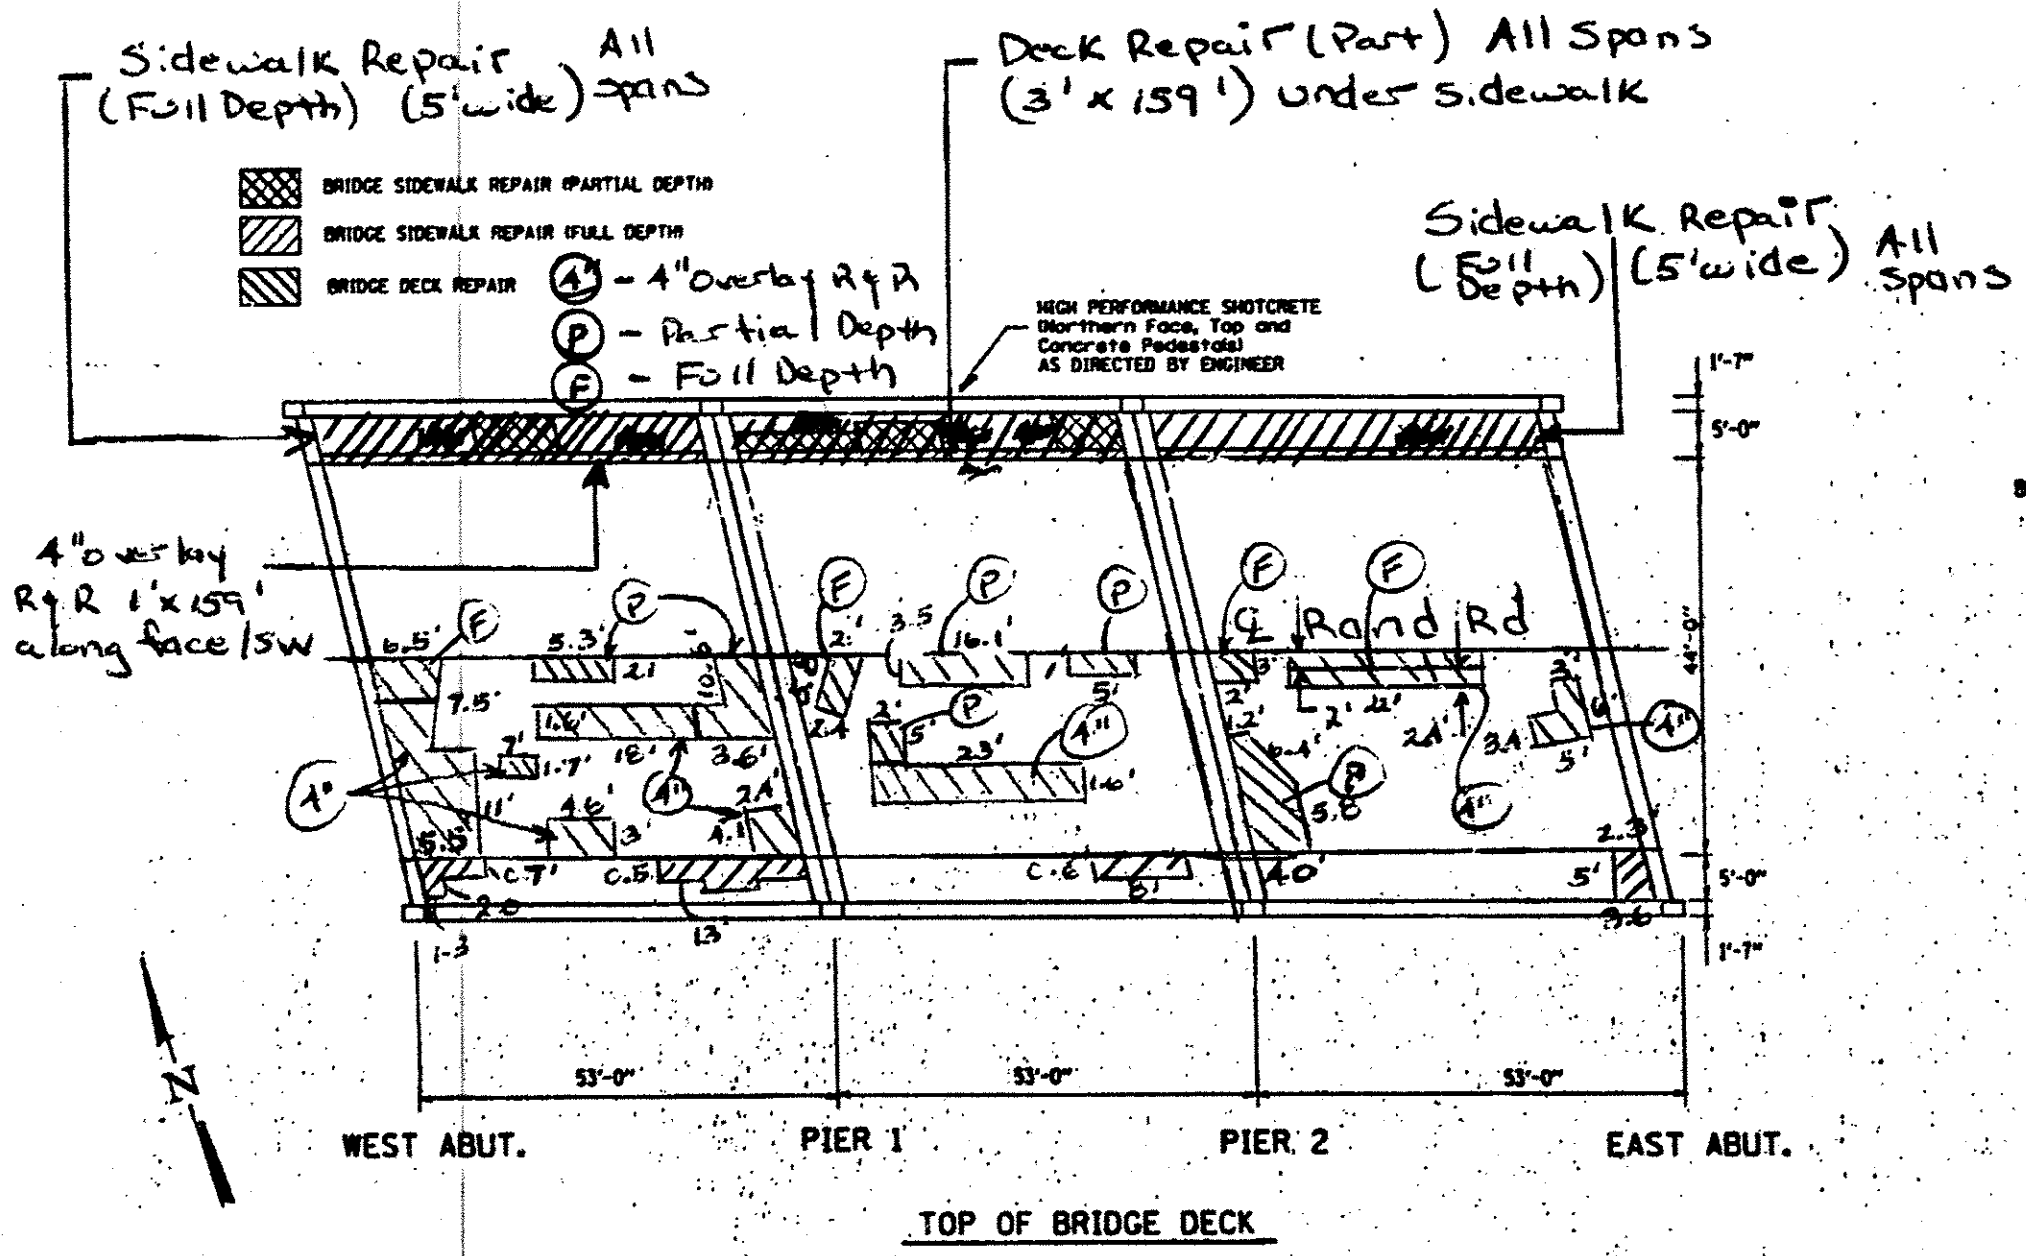


NOTES:
 Exact repair locations are to be determined by the Engineer during construction.
 The Engineer shall mark the locations of the actual repairs on the As-built plans.
 Date of field survey - August 1997.

The removal and replacement of the existing four inch concrete wearing surface is included in the cost of "Deck Slab Repair (Partial or Full Depth)".

BILL OF MATERIALS

Item	Unit	Quantity
Polymer Modified Portland Cement Mortar	Sq. Ft.	1221.5
Deck Slab Repair (Partial)	Sq. Yd.	63.5
Deck Slab Repair (Full Depth)	Sq. Yd.	2.5
Bridge Sidewalk Repair (Partial)	Sq. Ft.	144
Bridge Sidewalk Repair (Full Depth)	Sq. Ft.	765.05
High Performance Shotcrete	Sq. Ft.	

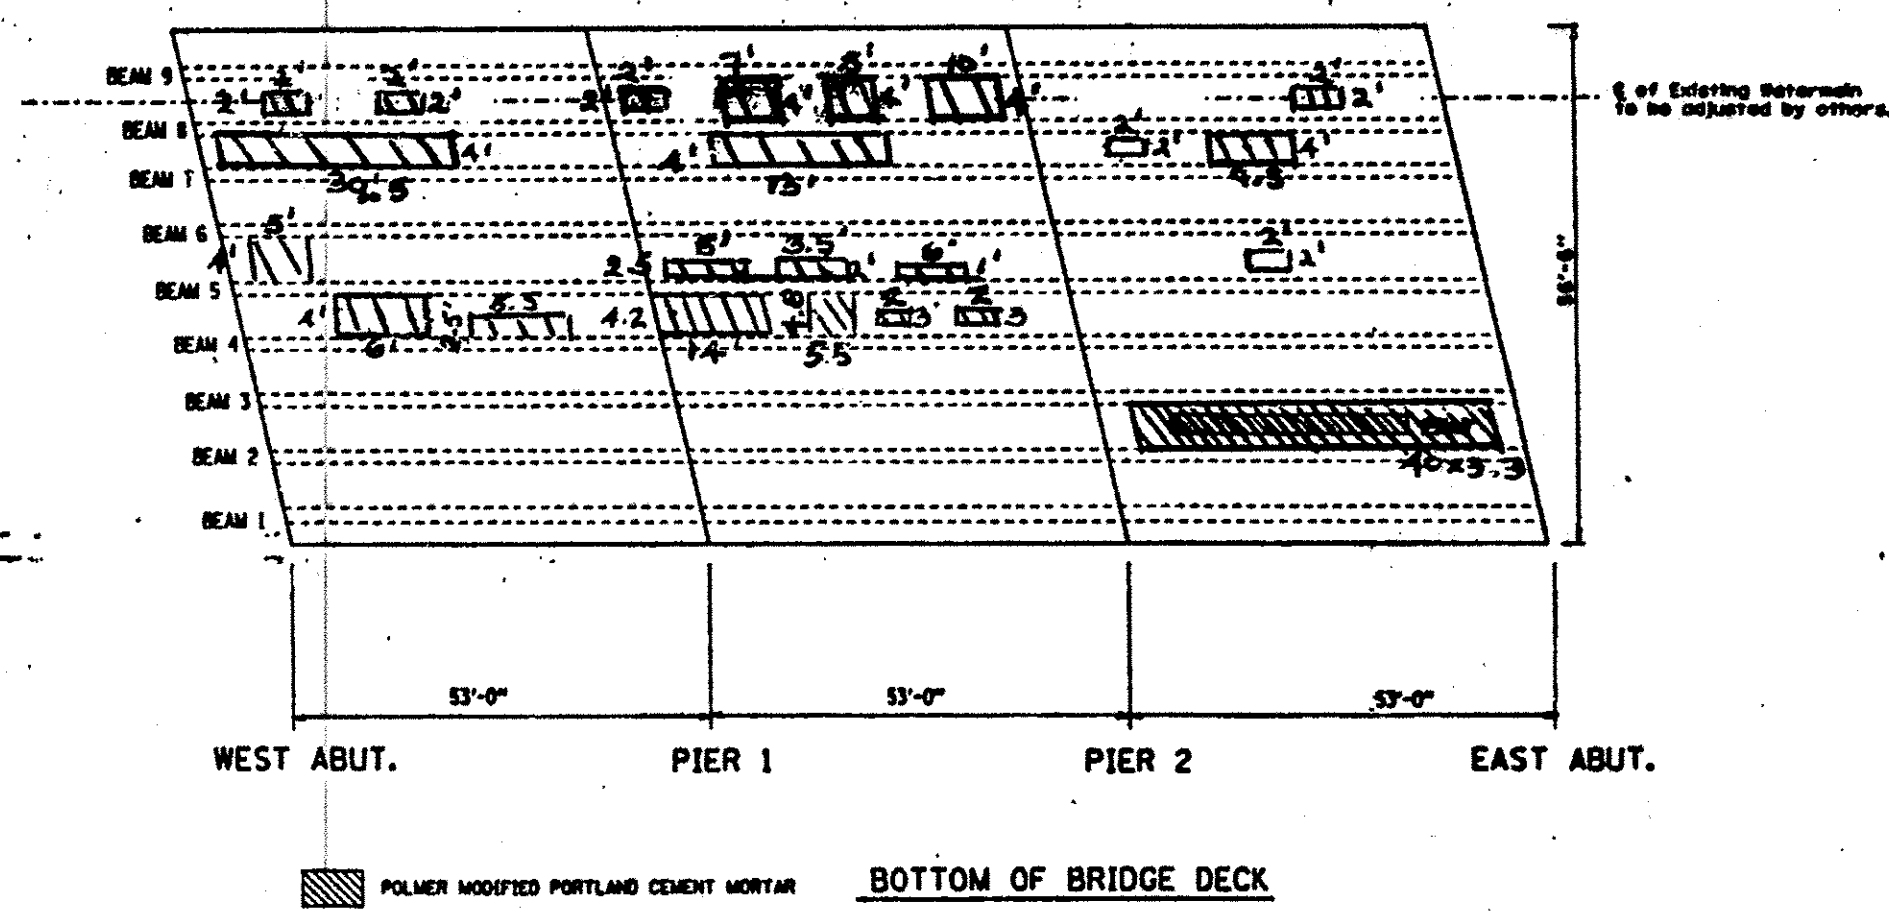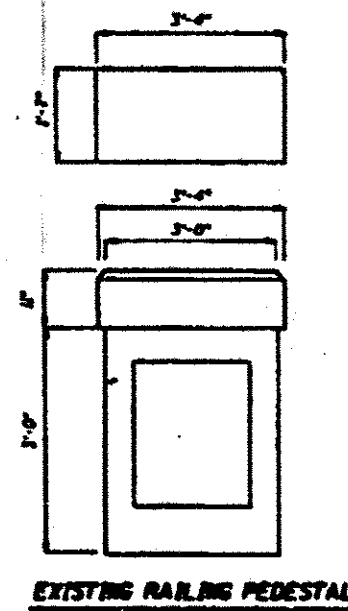

REVISIONS	
NAME	DATE

ILLINOIS DEPARTMENT OF TRANSPORTATION

RAND ROAD
 OVER DES PLAINES RIVER
 SN 016-0362

SCALE: VERT. DATE: 01/27/98
 HORIZ. DATE: 01/27/98

DRAWN BY: CADD
 CHECKED BY: TMS

The Jan 27 1998 10:00 AM