


FOR INFORMATION ONLY

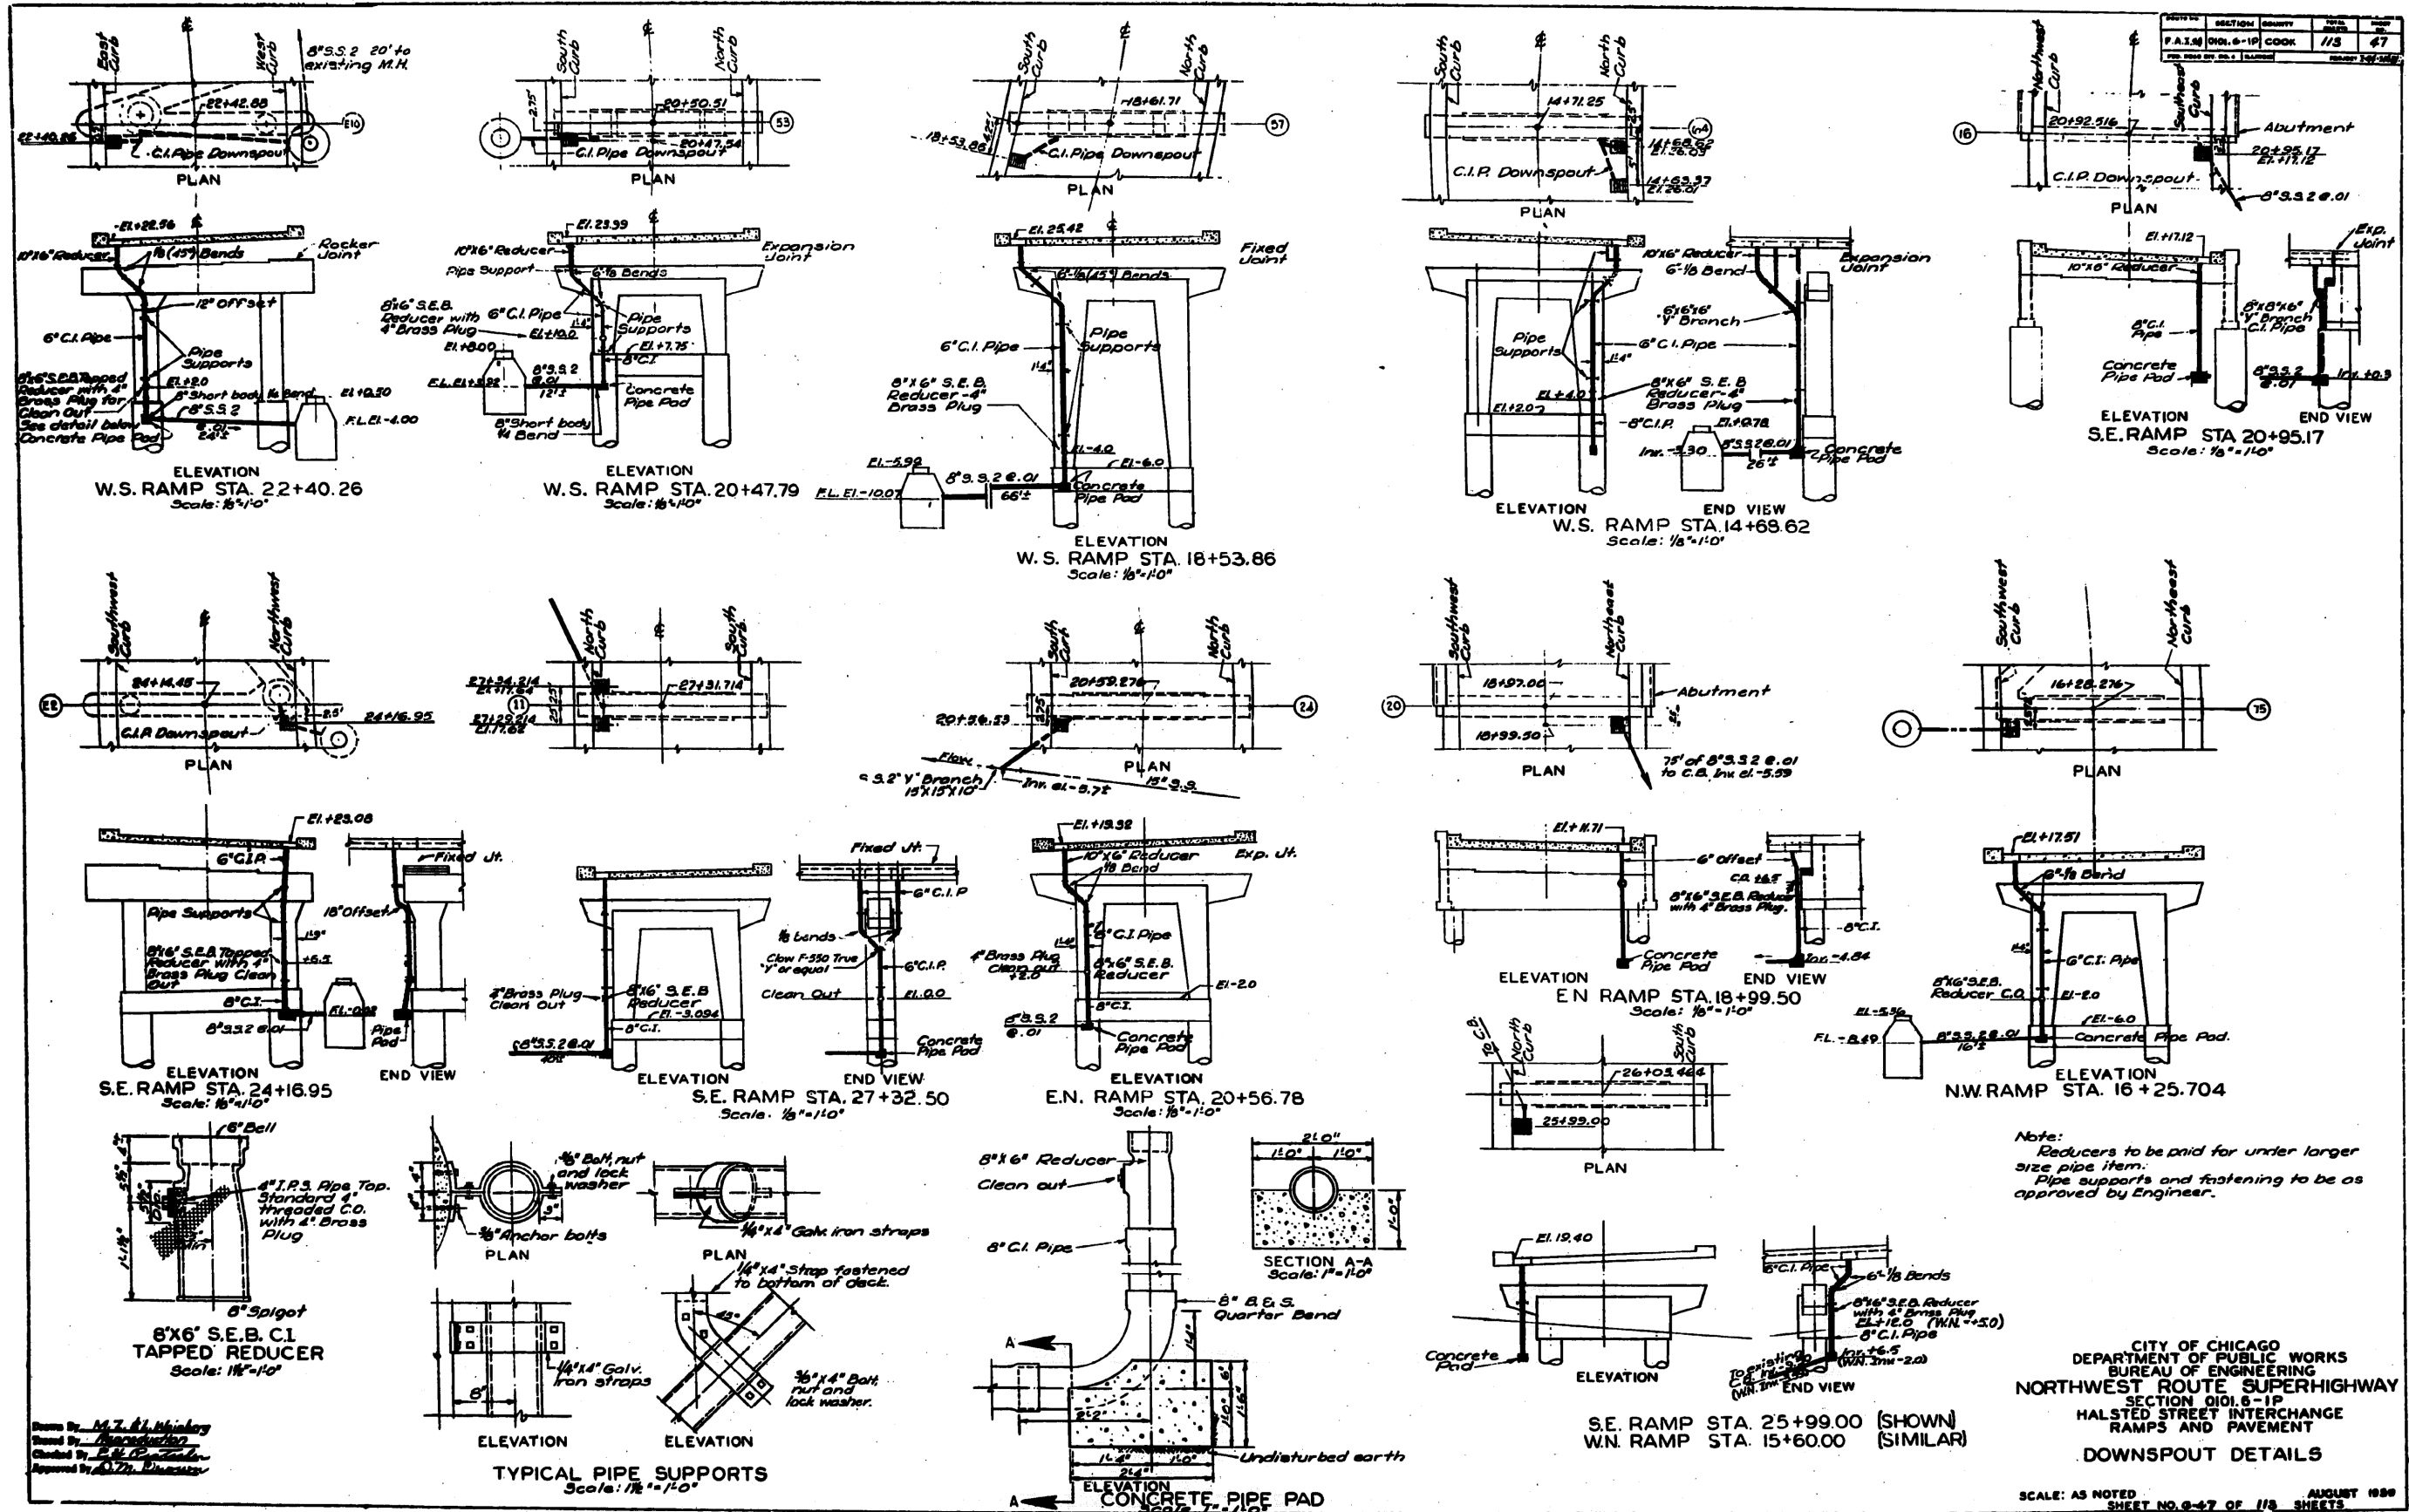

Note:
Reducers to be paid for under larger size pipe item.
Pipe supports and fastening to be as approved by Engineer.

CITY OF CHICAGO
DEPARTMENT OF PUBLIC WORKS
BUREAU OF ENGINEERING
NORTHWEST ROUTE SUPERHIGHWAY
SECTION 010.6-1P
HALSTED STREET INTERCHANGE
RAMPS AND PAVEMENT
DOWNSPOUT DETAILS

SCALE: AS NOTED
SHEET NO. 9-47 OF 118 SHEETS
AUGUST 1999

FILE PATH = C:\Project\14-0425 - 60W28-StruckBuilts\14-0425-AS-BUILT-05.dgn



D160W28-sht-AS-BUILT-05.dgn
USER NAME = auyeeungh
PLOT SCALE = 1.0000 / in.
PLOT DATE = 4/25/2014

DESIGNED -	REVISED -
DRAWN -	REVISED -
CHECKED -	REVISED -
DATE - 04/28/14	REVISED -

STATE OF ILLINOIS
DEPARTMENT OF TRANSPORTATION

EXISTING AS-BUILTS
SN 016-2449 & SN 016-2451

SCALE: NTS SHEET 5 OF 48 SHEETS STA. TO STA.

F.A.I. RTE.	SECTION	COUNTY	TOTAL SHEETS	SHEET NO.
90/94/290	2013-010R	COOK	747	475
CONTRACT NO. 60W28			ILLINOIS FED. AID PROJECT	