


FOR INFORMATION ONLY

1.94 01016-1P 113 G2
1-94-3(1)-51

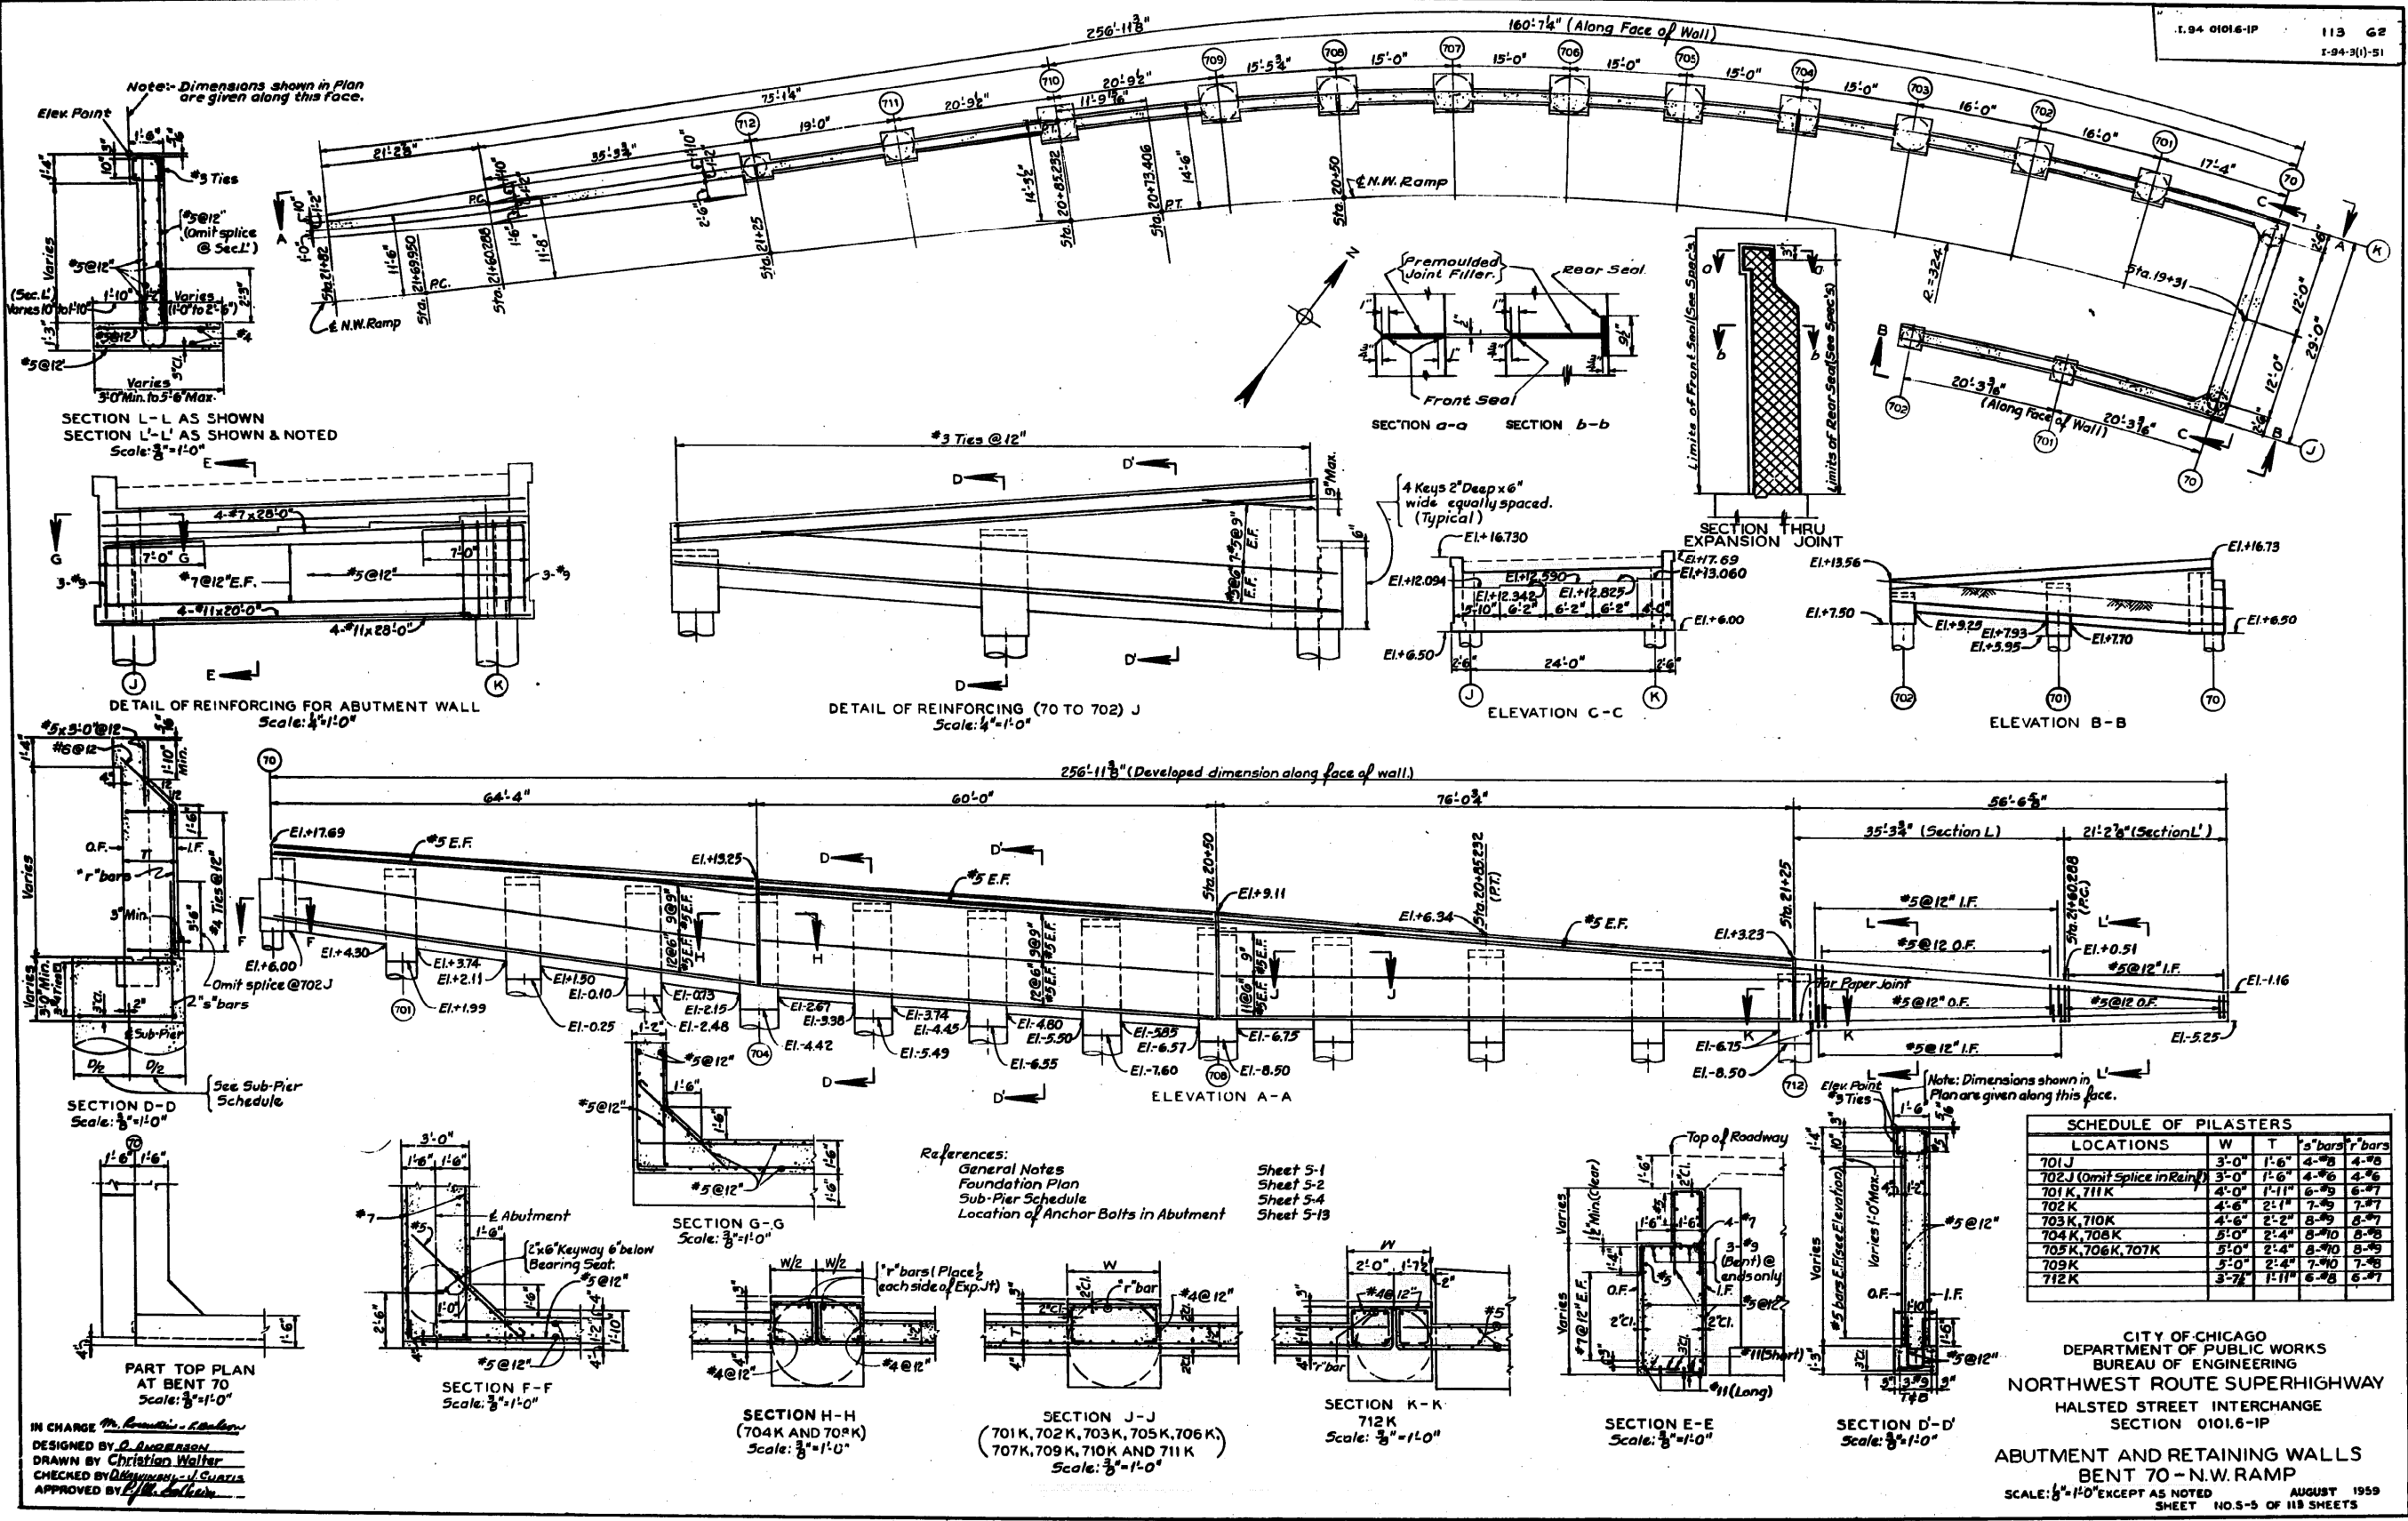

IN CHARGE *M. ...*
DESIGNED BY *C. ...*
DRAWN BY *Christian Walter*
CHECKED BY *...*
APPROVED BY *...*

CITY OF CHICAGO
DEPARTMENT OF PUBLIC WORKS
BUREAU OF ENGINEERING
NORTHWEST ROUTE SUPERHIGHWAY
HALSTED STREET INTERCHANGE
SECTION 0101.6-1P
ABUTMENT AND RETAINING WALLS
BENT 70 - N.W. RAMP
SCALE: 3/8"=1'-0" EXCEPT AS NOTED
AUGUST 1959
SHEET NO. 5 OF 113 SHEETS

FILE PATH = C:\Projects\114-0425 - 60W28 Structure\114-0425-60W28-Str-Built-10.dgn



D160W28-sht-AS-BUILT-10.dgn
USER NAME = ayeungh
PLOT SCALE = 1.0000 / in.
PLOT DATE = 4/25/2014

DESIGNED -
DRAWN -
CHECKED -
DATE - 04/28/14

REVISED -
REVISED -
REVISED -
REVISED -

STATE OF ILLINOIS
DEPARTMENT OF TRANSPORTATION

EXISTING AS-BUILTS
SN 016-2449 & SN 016-2451
SCALE: NTS
SHEET 10 OF 48 SHEETS
STA. TO STA.

F.A.I. RTE.	SECTION	COUNTY	TOTAL SHEETS	SHEET NO.
90/94/290	2013-010R	COOK	747	480
CONTRACT NO. 60W28				
ILLINOIS FED. AID PROJECT				