


FOR INFORMATION ONLY

ROUTE NO.	SECTION	COUNTY	SHEET
F.A.I. 94	D101.6-1P	COOK	113 76
FD ROAD DIST. No.	BLAND	NO. 1	I-94-3(1)-51

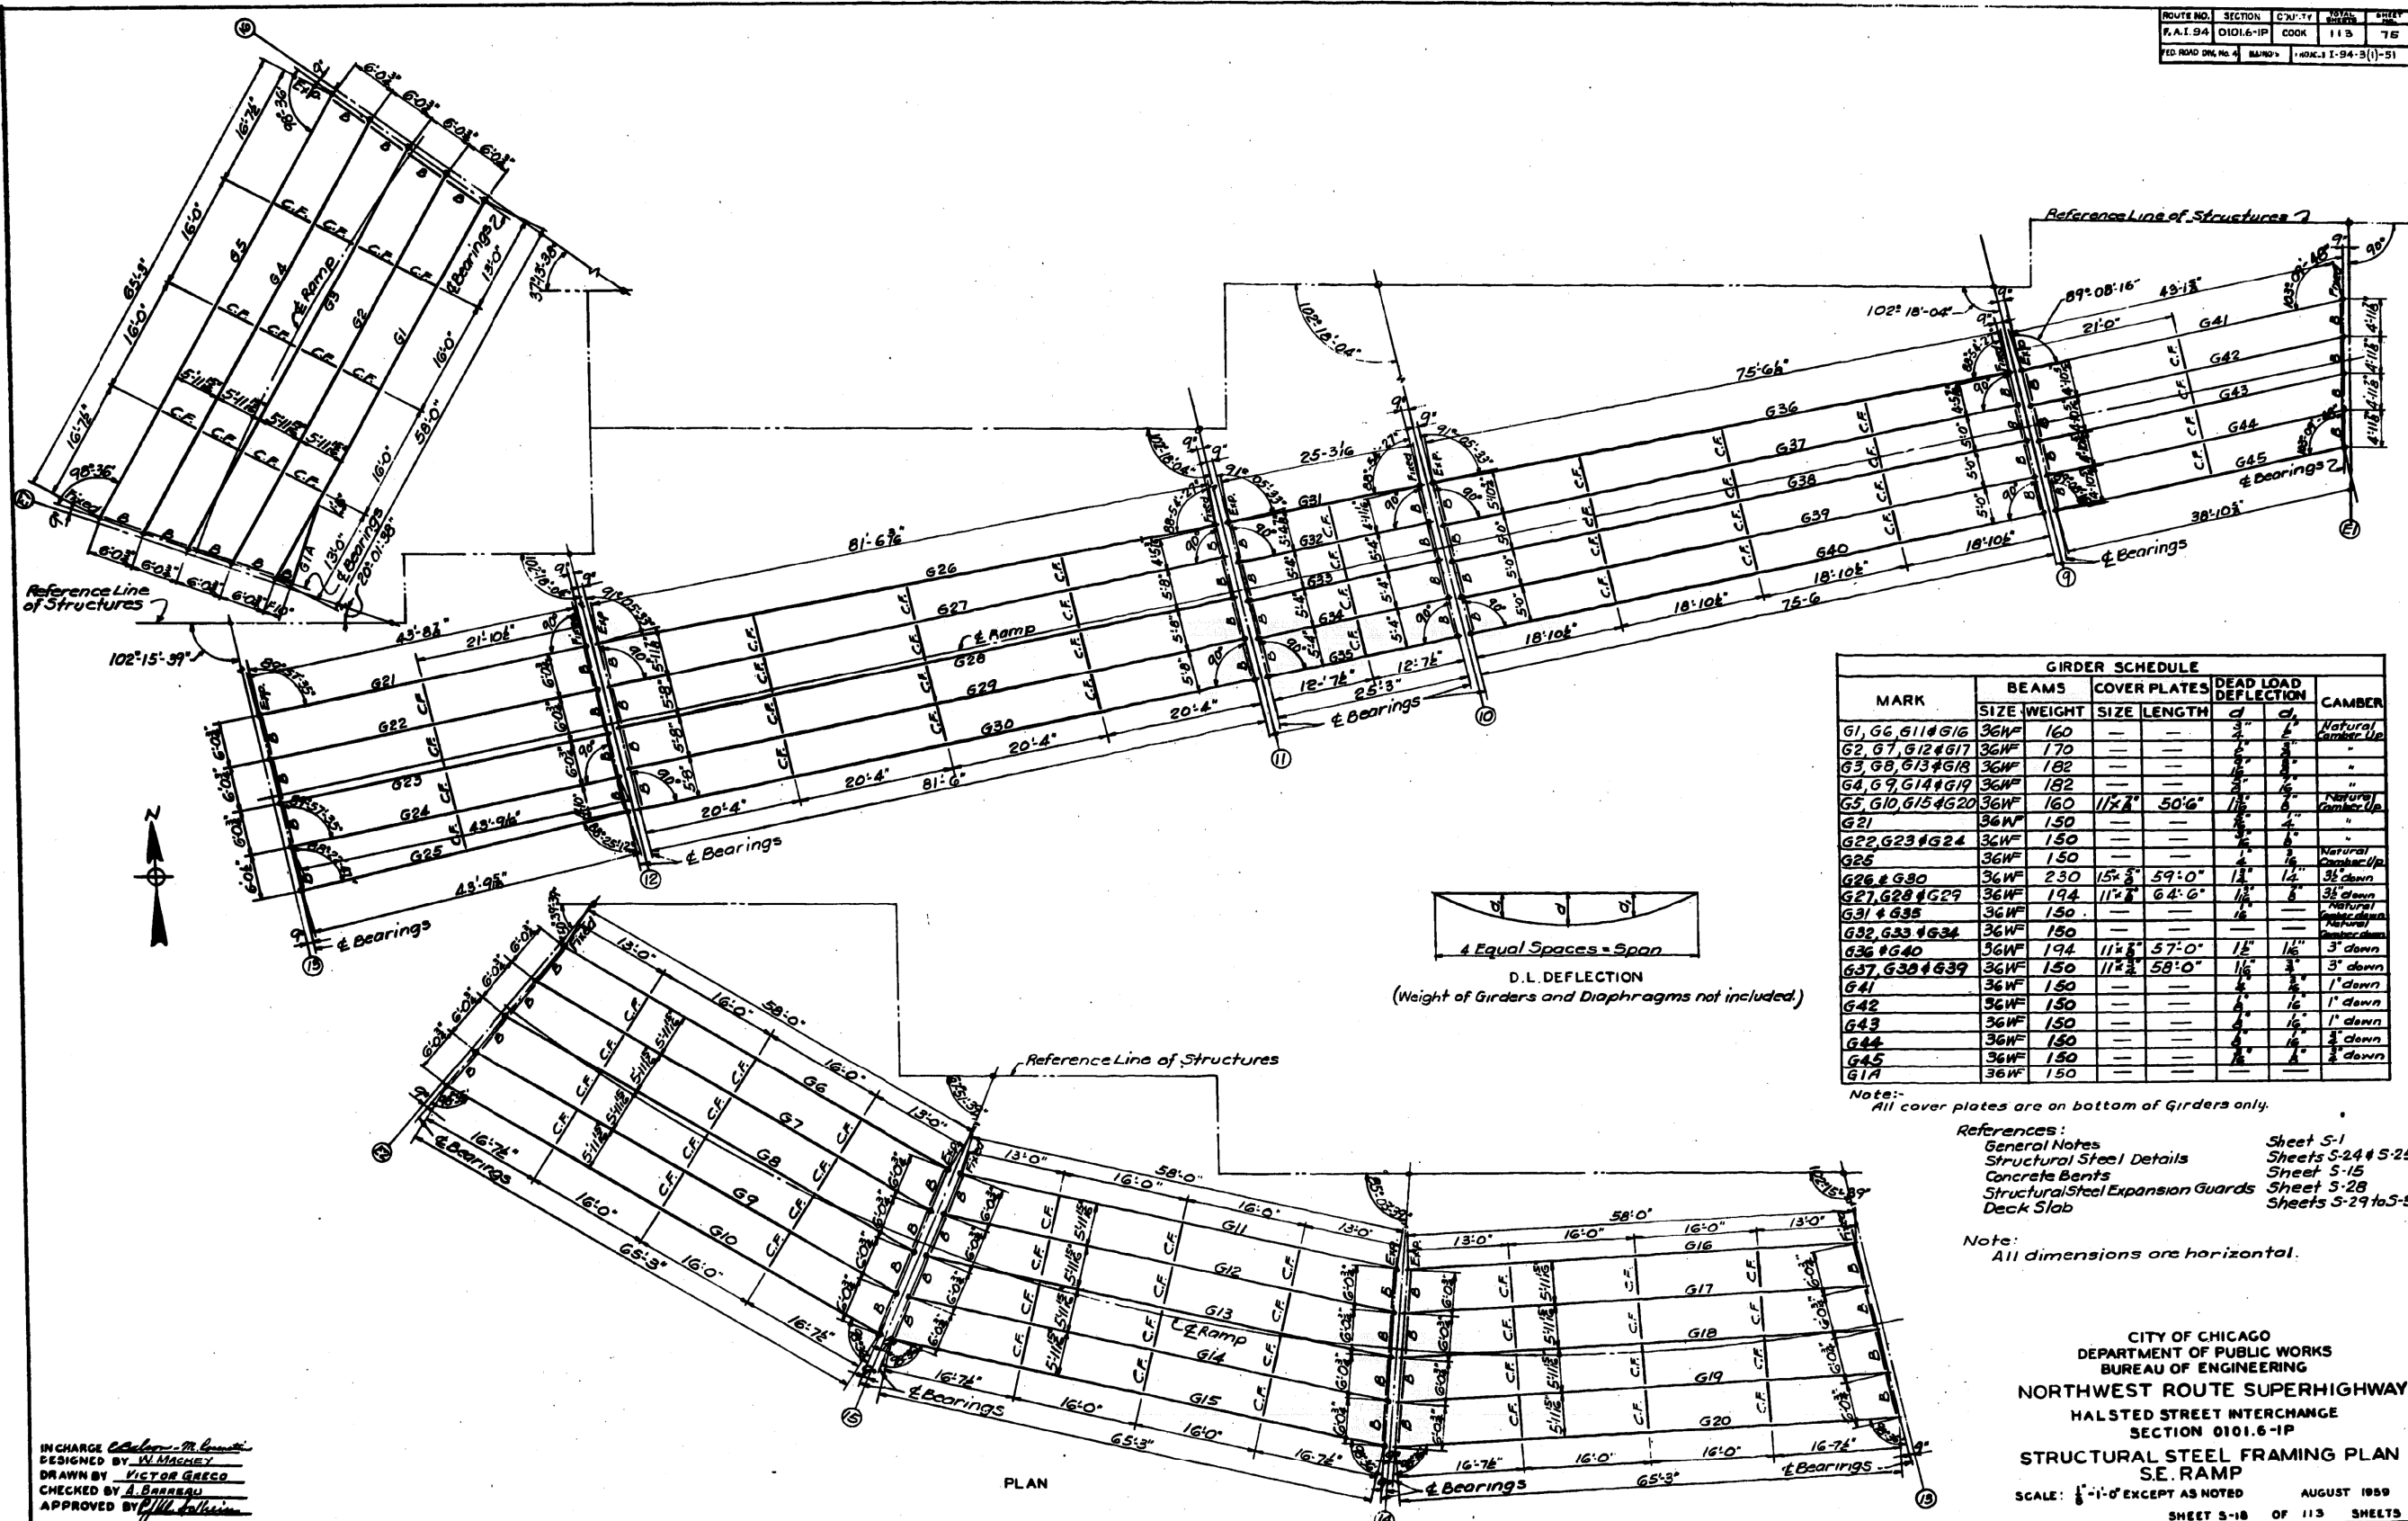

MARK	BEAMS		COVER PLATES		DEAD LOAD DEFLECTION		CAMBER
	SIZE	WEIGHT	SIZE	LENGTH	d	e	
G1, G6, G11 & G16	36WF	160	—	—	3/4"	1/4"	Natural Camber Up
G2, G7, G12 & G17	36WF	170	—	—	3/4"	1/4"	"
G3, G8, G13 & G18	36WF	182	—	—	3/4"	1/4"	"
G4, G9, G14 & G19	36WF	182	—	—	3/4"	1/4"	"
G5, G10, G15 & G20	36WF	160	11 1/2"	50'-6"	1/2"	1/4"	Natural Camber Up
G21	36WF	150	—	—	3/4"	1/4"	"
G22, G23 & G24	36WF	150	—	—	3/4"	1/4"	"
G25	36WF	150	—	—	3/4"	1/4"	Natural Camber Up
G26 & G30	36WF	230	15'-3"	59'-0"	1 1/2"	1/4"	3/8" down
G27, G28 & G29	36WF	194	11'-8"	64'-0"	1 1/2"	1/4"	3/8" down
G31 & G35	36WF	150	—	—	1 1/2"	1/4"	Natural Camber Up
G32, G33 & G34	36WF	150	—	—	1 1/2"	1/4"	Natural Camber Up
G36 & G40	36WF	194	11'-8"	57'-0"	1 1/2"	1/4"	3" down
G37, G38 & G39	36WF	150	11'-8"	58'-0"	1 1/2"	1/4"	3" down
G41	36WF	150	—	—	1 1/2"	1/4"	1" down
G42	36WF	150	—	—	1 1/2"	1/4"	1" down
G43	36WF	150	—	—	1 1/2"	1/4"	1" down
G44	36WF	150	—	—	1 1/2"	1/4"	1" down
G45	36WF	150	—	—	1 1/2"	1/4"	1" down
G1A	36WF	150	—	—	—	—	—

Note: All cover plates are on bottom of Girders only.

References:
 General Notes
 Structural Steel Details
 Concrete Bents
 Structural Steel Expansion Guards
 Deck Slab

Sheet S-1
 Sheets S-24 & S-25
 Sheet S-15
 Sheet S-28
 Sheets S-29 to S-31

Note: All dimensions are horizontal.

CITY OF CHICAGO
 DEPARTMENT OF PUBLIC WORKS
 BUREAU OF ENGINEERING
 NORTHWEST ROUTE SUPERHIGHWAY
 HALSTED STREET INTERCHANGE
 SECTION 0101.6-1P
 STRUCTURAL STEEL FRAMING PLAN
 S.E. RAMP
 SCALE: 1/8" = 1'-0" EXCEPT AS NOTED
 AUGUST 1999
 SHEET S-18 OF 113 SHEETS

IN CHARGE: *Victor M. Greco*
 DESIGNED BY: W. MAGNEY
 DRAWN BY: VICTOR GRECO
 CHECKED BY: A. BARREQU
 APPROVED BY: *Victor M. Greco*

FILE PATH = C:\Projects\14-0425 - 60W28 Structure\14-0425 - 60W28 Structure\14-0425 - sht-AS-BUILT-23.dgn



D160W28-sht-AS-BUILT-23.dgn
 USER NAME = auyeungh
 PLOT SCALE = 1:80000 / 1" = 100'-0"
 PLOT DATE = 4/25/2014

DESIGNED -
 DRAWN -
 CHECKED -
 DATE - 04/28/14

REVISED -
 REVISED -
 REVISED -
 REVISED -

STATE OF ILLINOIS
 DEPARTMENT OF TRANSPORTATION

EXISTING AS-BUILTS
 SN 016-2449 & SN 016-2451
 SCALE: NTS
 SHEET 23 OF 48 SHEETS
 STA. TO STA.

F.A.I. RTE.	SECTION	COUNTY	TOTAL SHEETS	SHEET NO.
90/94/290	2013-010R	COOK	747	493
CONTRACT NO. 60W28				
ILLINOIS FED. AID PROJECT				