


FOR INFORMATION ONLY

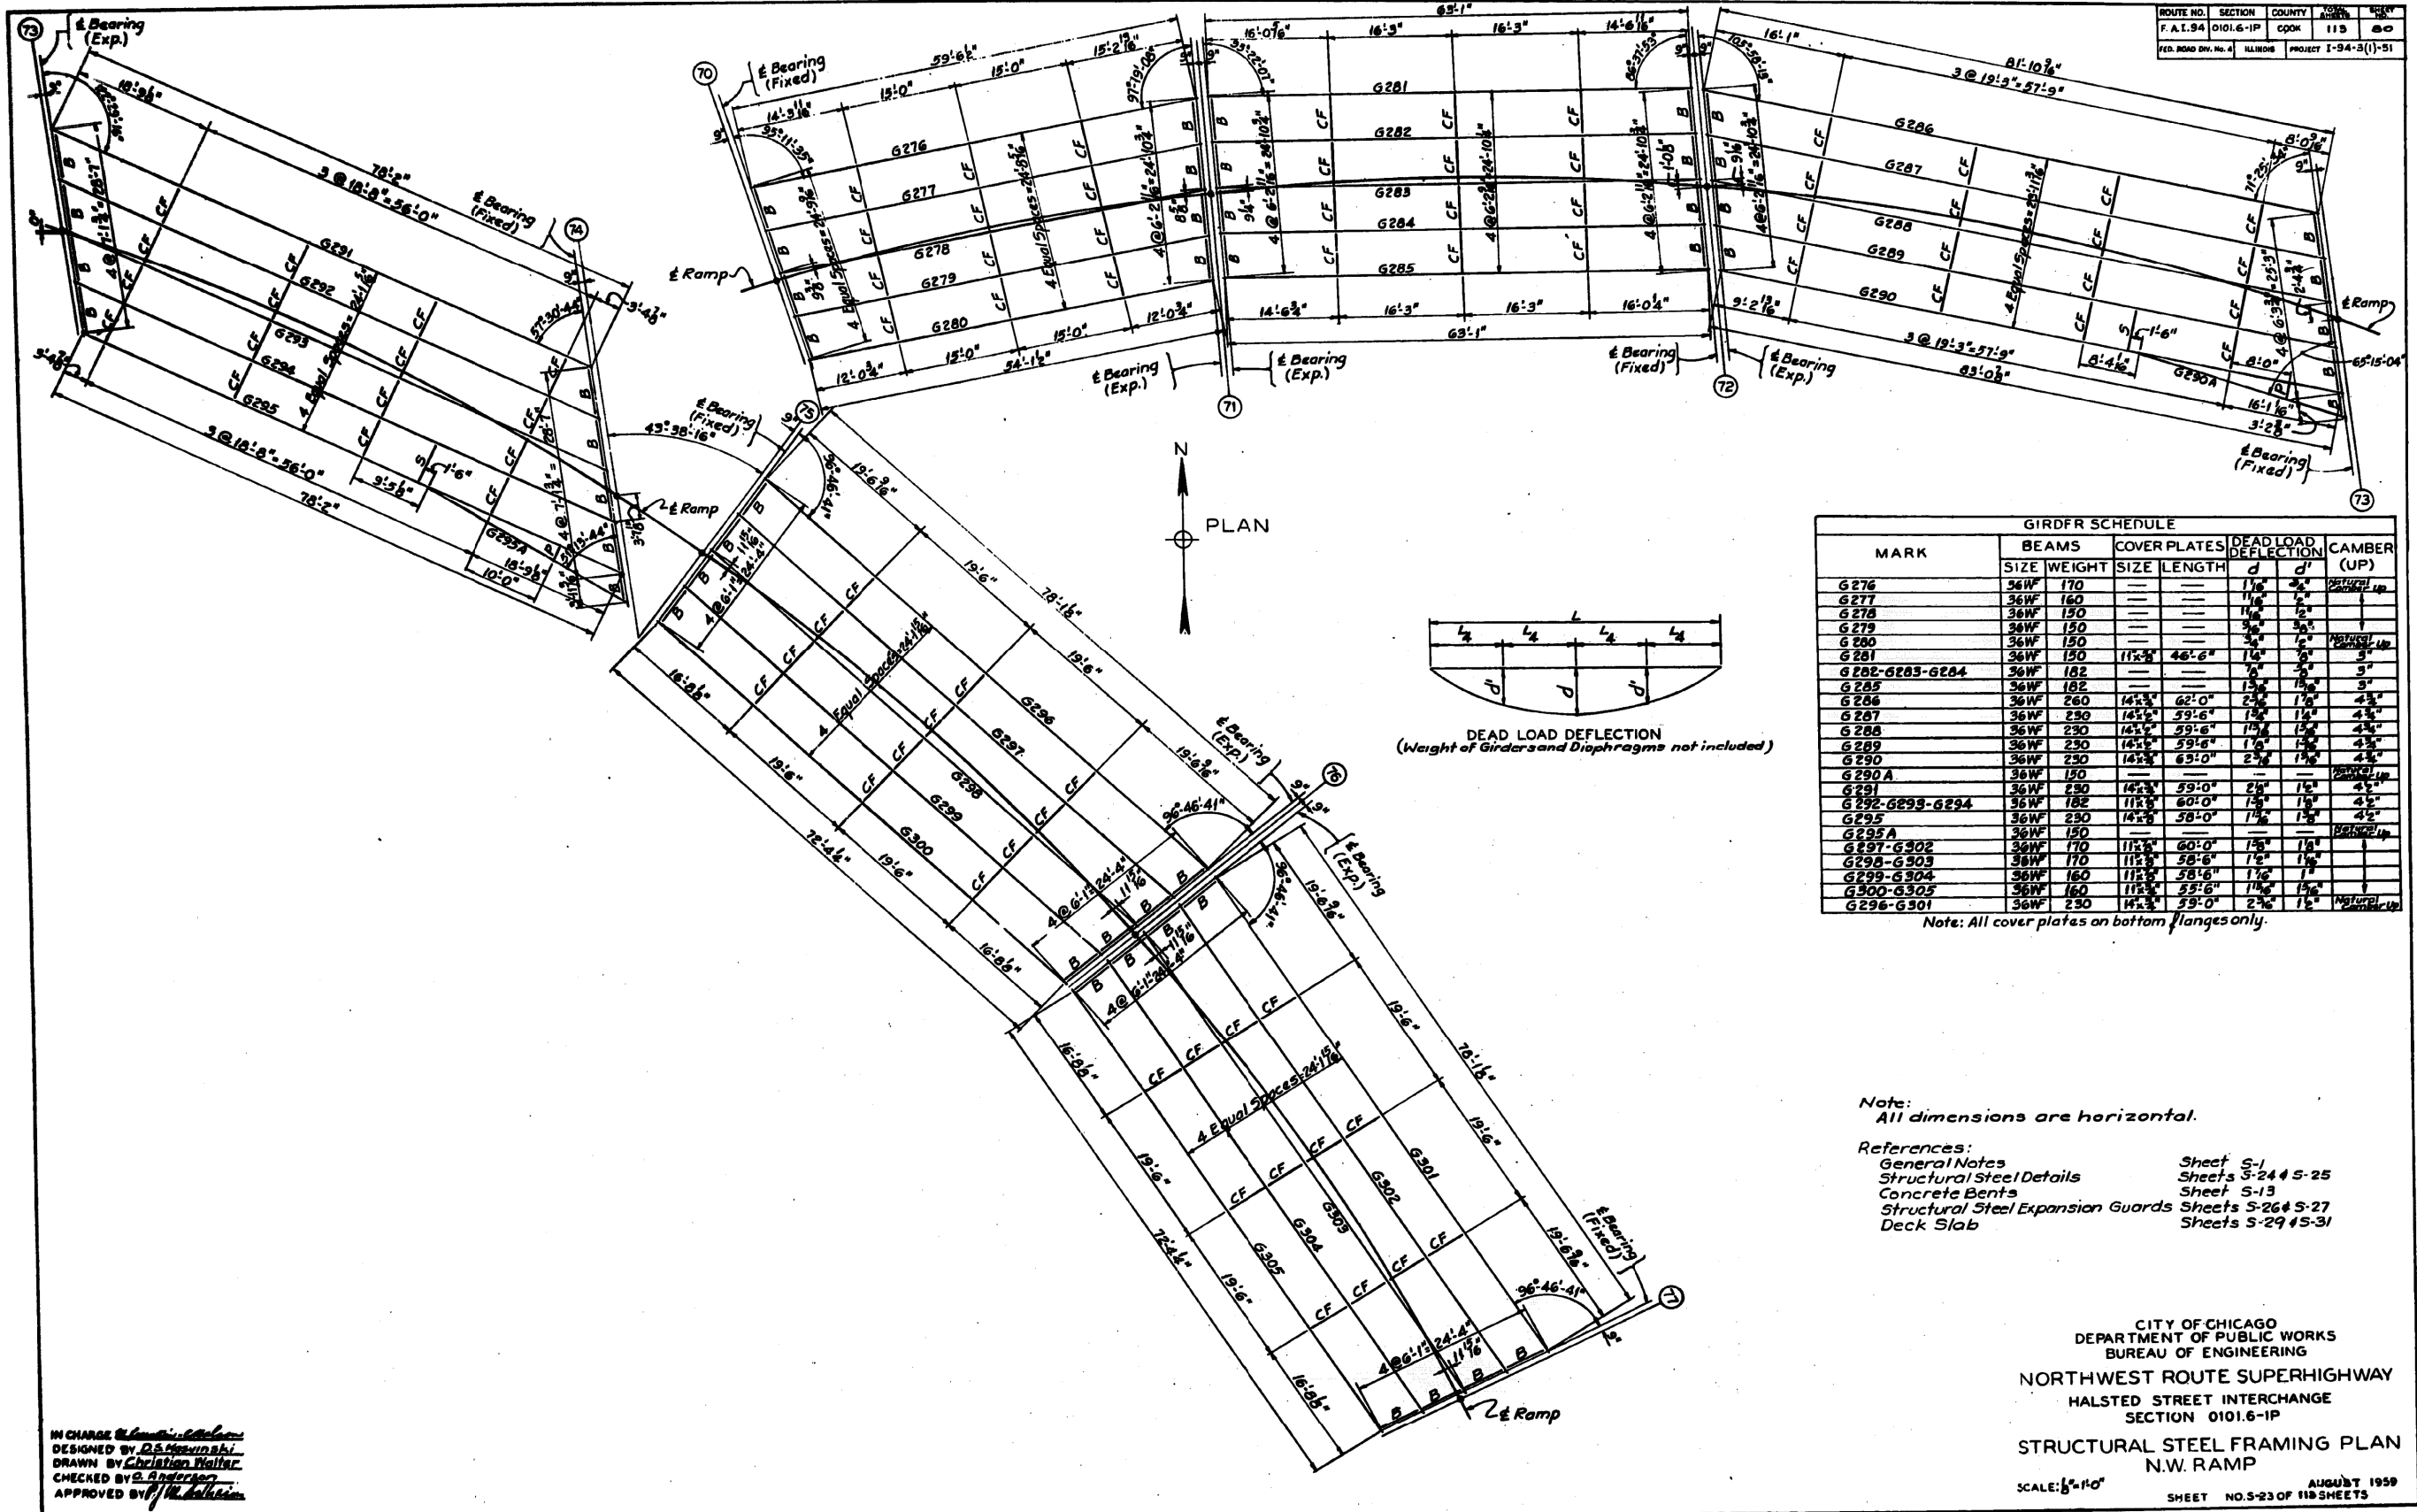

ROUTE NO.	SECTION	COUNTY	POST MILE
F. A. I. 94	0101.6-1P	COOK	113
FED. ROAD DIV. NO. 4	ILLINOIS	PROJECT	I-94-3(1)-51

MARK	BEAMS		COVER PLATES		DEAD LOAD DEFLECTION		CAMBER (UP)
	SIZE	WEIGHT	SIZE	LENGTH	d	d'	
G 276	36WF	170			1 1/2"	2 1/2"	Natural Up
G 277	36WF	160			1 1/2"	2 1/2"	Natural Up
G 278	36WF	150			1 1/2"	2 1/2"	Natural Up
G 279	36WF	150			3/4"	2 1/2"	Natural Up
G 280	36WF	150			3/4"	2 1/2"	Natural Up
G 281	36WF	150	11x3"	46'-6"	1 1/2"	2 1/2"	5"
G 282-G283-G284	36WF	182			7/8"	2 1/2"	5"
G 285	36WF	182			1 1/2"	2 1/2"	5"
G 286	36WF	260	14x3"	62'-0"	2 1/2"	1 1/2"	4 1/2"
G 287	36WF	230	14x3"	59'-6"	1 1/2"	1 1/2"	4 1/2"
G 288	36WF	230	14x3"	59'-6"	1 1/2"	1 1/2"	4 1/2"
G 289	36WF	230	14x3"	59'-6"	1 1/2"	1 1/2"	4 1/2"
G 290	36WF	230	14x3"	63'-0"	2 1/2"	1 1/2"	4 1/2"
G 290 A	36WF	190					Natural Up
G 291	36WF	230	14x3"	59'-0"	2 1/2"	1 1/2"	4 1/2"
G 292-G293-G294	36WF	182	11x3"	60'-0"	1 1/2"	1 1/2"	4 1/2"
G 295	36WF	230	14x3"	58'-0"	1 1/2"	1 1/2"	4 1/2"
G 295 A	36WF	150					Natural Up
G 297-G302	36WF	170	11x3"	60'-0"	1 1/2"	1 1/2"	1"
G 298-G303	36WF	170	11x3"	58'-6"	1 1/2"	1 1/2"	1"
G 299-G304	36WF	160	11x3"	58'-6"	1 1/2"	1 1/2"	1"
G 300-G305	36WF	160	11x3"	59'-6"	1 1/2"	1 1/2"	1"
G 296-G301	36WF	230	14x3"	59'-0"	2 1/2"	1 1/2"	Natural Up

Note: All cover plates on bottom flanges only.

Note: All dimensions are horizontal.

- References:
- General Notes Sheet S-1
 - Structural Steel Details Sheets S-24 & S-25
 - Concrete Bents Sheet S-13
 - Structural Steel Expansion Guards Sheets S-26 & S-27
 - Deck Slab Sheets S-29 & S-31

CITY OF CHICAGO
 DEPARTMENT OF PUBLIC WORKS
 BUREAU OF ENGINEERING
 NORTHWEST ROUTE SUPERHIGHWAY
 HALSTED STREET INTERCHANGE
 SECTION 0101.6-1P
 STRUCTURAL STEEL FRAMING PLAN
 N.W. RAMP
 SCALE: 1/8"=1'-0"
 SHEET NO. 5-23 OF 118 SHEETS

IN CHARGE: *[Signature]*
 DESIGNED BY: D.S. [Signature]
 DRAWN BY: Christian Walter
 CHECKED BY: [Signature]
 APPROVED BY: [Signature]

FILE PATH = C:\Project\14-0425 - 60W28 StructBul14-D160W28-sht-AS-BUILT-28.dgn



D160W28-sht-AS-BUILT-28.dgn
 USER NAME = ayeuengh
 PLOT SCALE = 1:8000 / 1"=80'
 PLOT DATE = 4/25/2014

DESIGNED -	REVISED -
DRAWN -	REVISED -
CHECKED -	REVISED -
DATE - 04/28/14	REVISED -

STATE OF ILLINOIS
 DEPARTMENT OF TRANSPORTATION

EXISTING AS-BUILTS
 SN 016-2449 & SN 016-2451
 SCALE: NTS SHEET 28 OF 48 SHEETS STA. TO STA.

F.A.I. RTE.	SECTION	COUNTY	TOTAL SHEETS	SHEET NO.
90/94/290	2013-010R	COOK	747	498
CONTRACT NO. 60W28				
ILLINOIS FED. AID PROJECT				