


# FOR INFORMATION ONLY

ROUTE NO.	SECTION	COUNTY	DATE	SHEET NO.
1.94	0101.6-1P	ILLINOIS	115	88
FILED ROAD DIST. NO. 4				

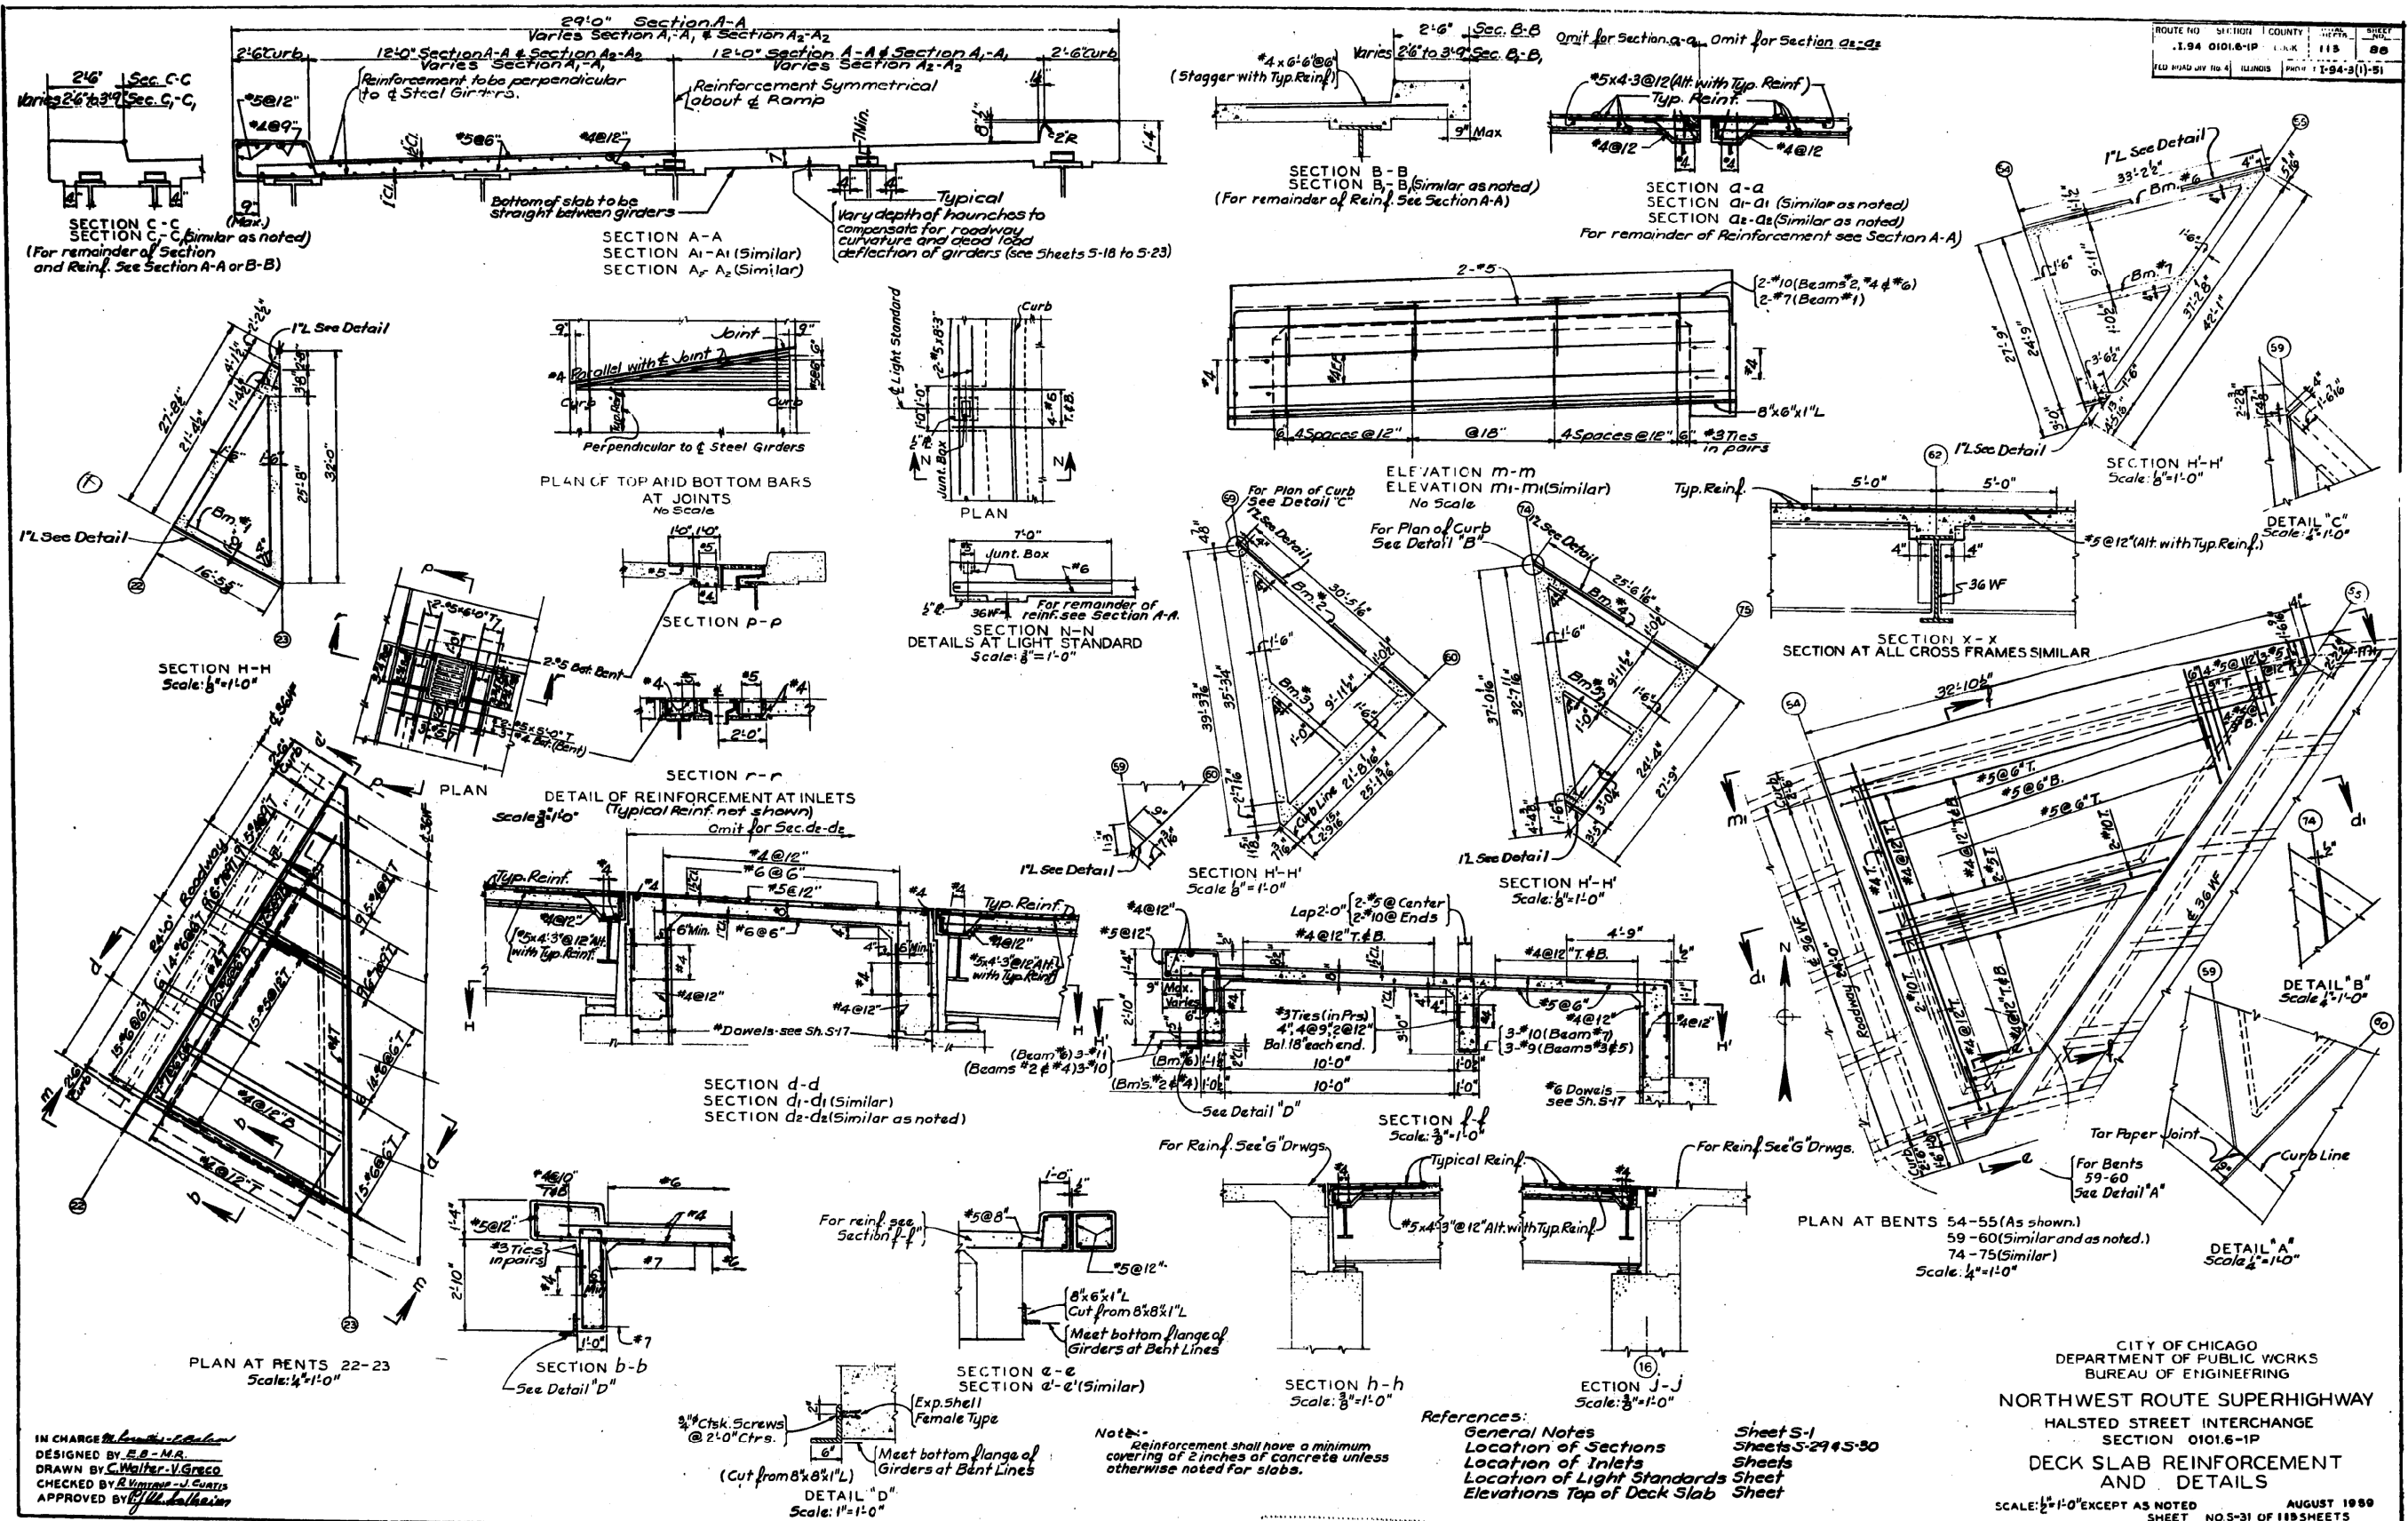

IN CHARGE *[Signature]*  
 DESIGNED BY *[Signature]*  
 DRAWN BY *[Signature]*  
 CHECKED BY *[Signature]*  
 APPROVED BY *[Signature]*

Note: Reinforcement shall have a minimum covering of 2 inches of concrete unless otherwise noted for slabs.

References:  
 General Notes  
 Location of Sections  
 Location of Inlets  
 Location of Light Standards  
 Sheet S-1  
 Sheets S-29 & S-30  
 Sheets  
 Elevation of Top of Deck Slab  
 Sheet

CITY OF CHICAGO  
 DEPARTMENT OF PUBLIC WORKS  
 BUREAU OF ENGINEERING  
 NORTHWEST ROUTE SUPERHIGHWAY  
 HALSTED STREET INTERCHANGE  
 SECTION 0101.6-1P  
 DECK SLAB REINFORCEMENT  
 AND DETAILS  
 SCALE: 1/2"=1'-0" EXCEPT AS NOTED  
 AUGUST 1989  
 SHEET NO. S-31 OF 119 SHEETS

FILE PATH = C:\Projects\114-0425 - 60W28-Structure\114-0425 - 60W28-Structure\AS-BUILT-36.dgn



D160W28-sht-AS-BUILT-36.dgn	DESIGNED -	REVISED -
USER NAME = auyeuongh	DRAWN -	REVISED -
PLOT SCALE = 1.0000 / in.	CHECKED -	REVISED -
PLOT DATE = 4/25/2014	DATE - 04/28/14	REVISED -

STATE OF ILLINOIS  
 DEPARTMENT OF TRANSPORTATION

EXISTING AS-BUILTS  
 SN 016-2449 & SN 016-2451

SCALE: NTS SHEET 36 OF 48 SHEETS STA. TO STA.

F.A.I. RTE.	SECTION	COUNTY	TOTAL SHEETS	SHEET NO.
90/94/290	2013-010R	COOK	747	506
CONTRACT NO. 60W28				

ILLINOIS FED. AID PROJECT