
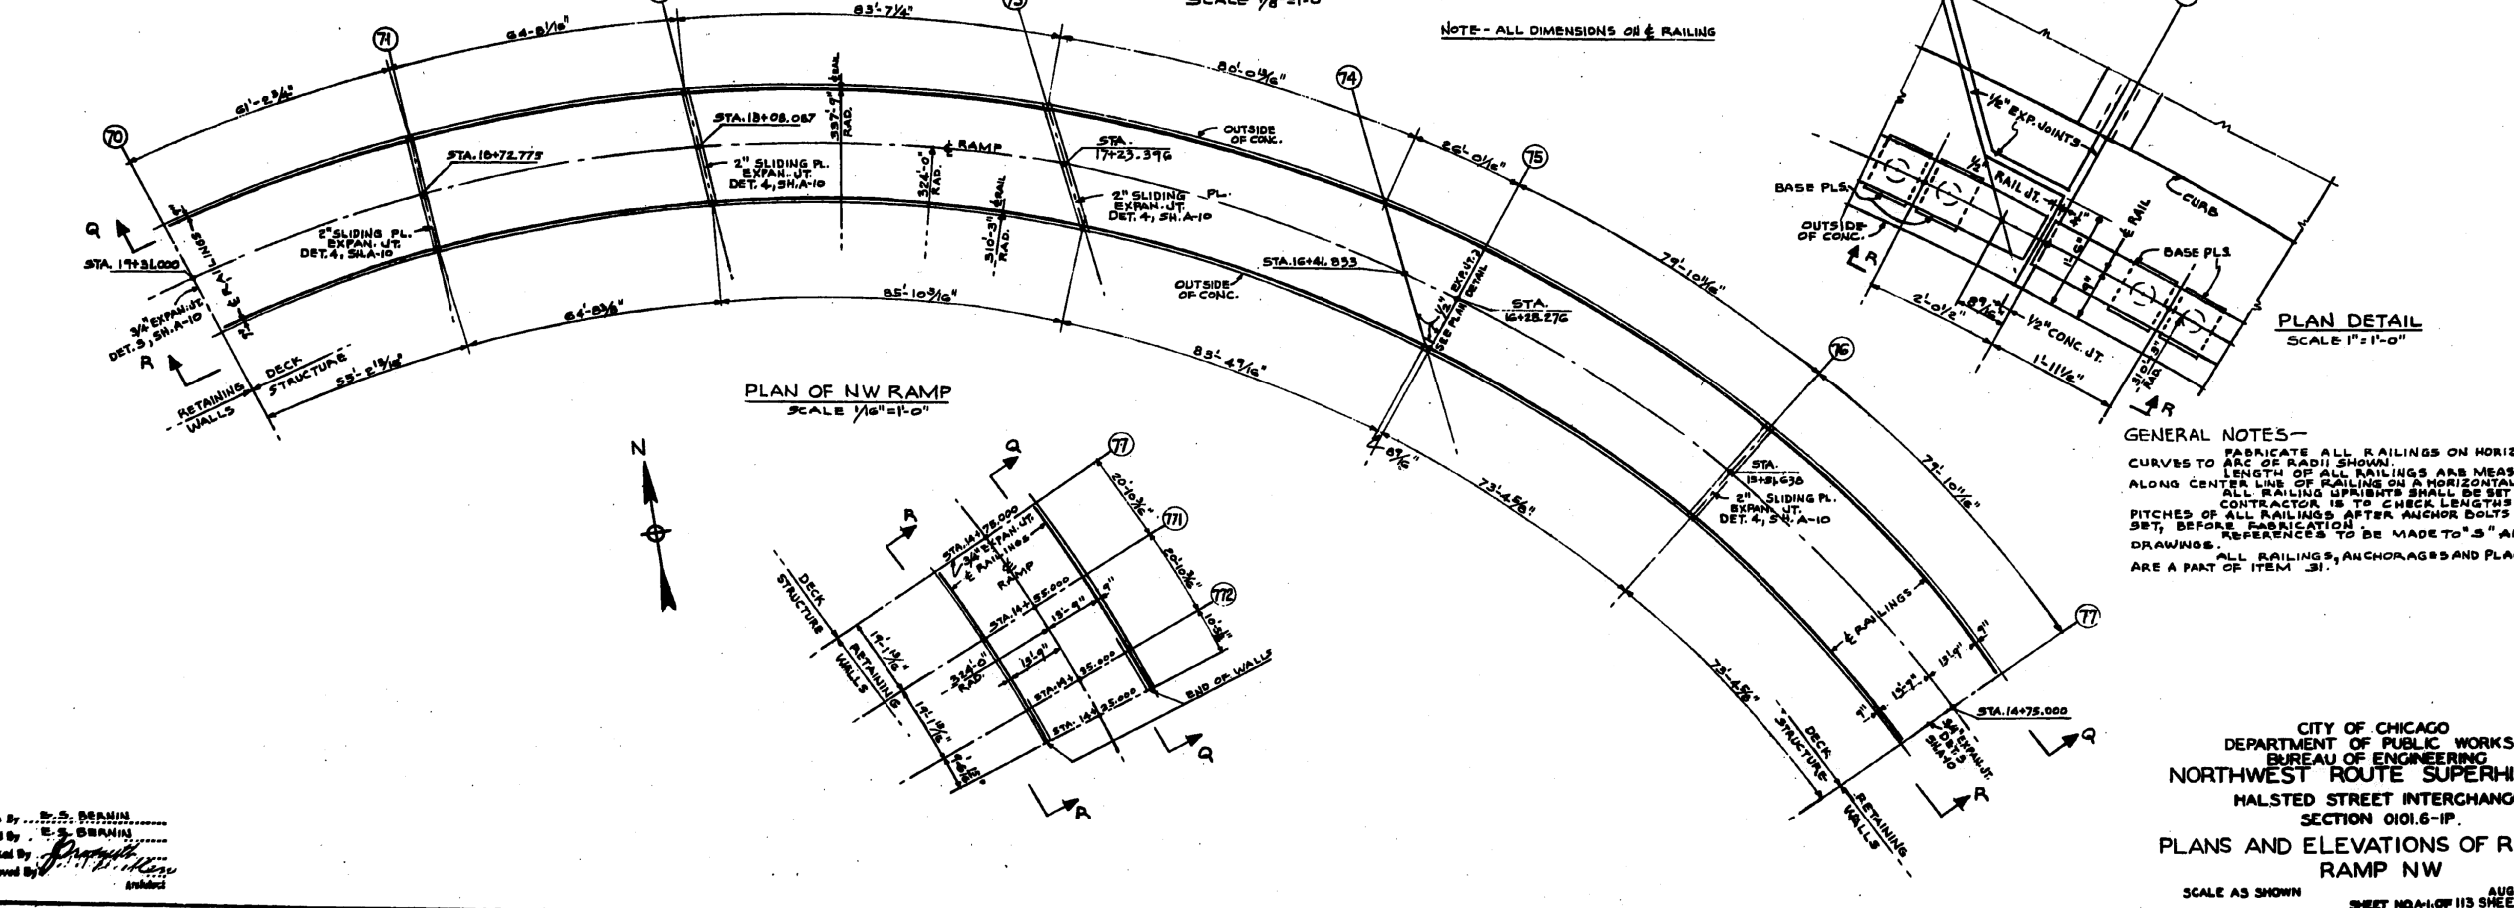


FOR INFORMATION ONLY

ROUTE NO.	SECTION	COUNTY	SHEET	TOTAL SHEETS
F. A. I. 94	0101.6-1P	COOK	113	96
RD ROAD DIST. No. 4	ILLINOIS	PROJECT I-55-3(1)-5		

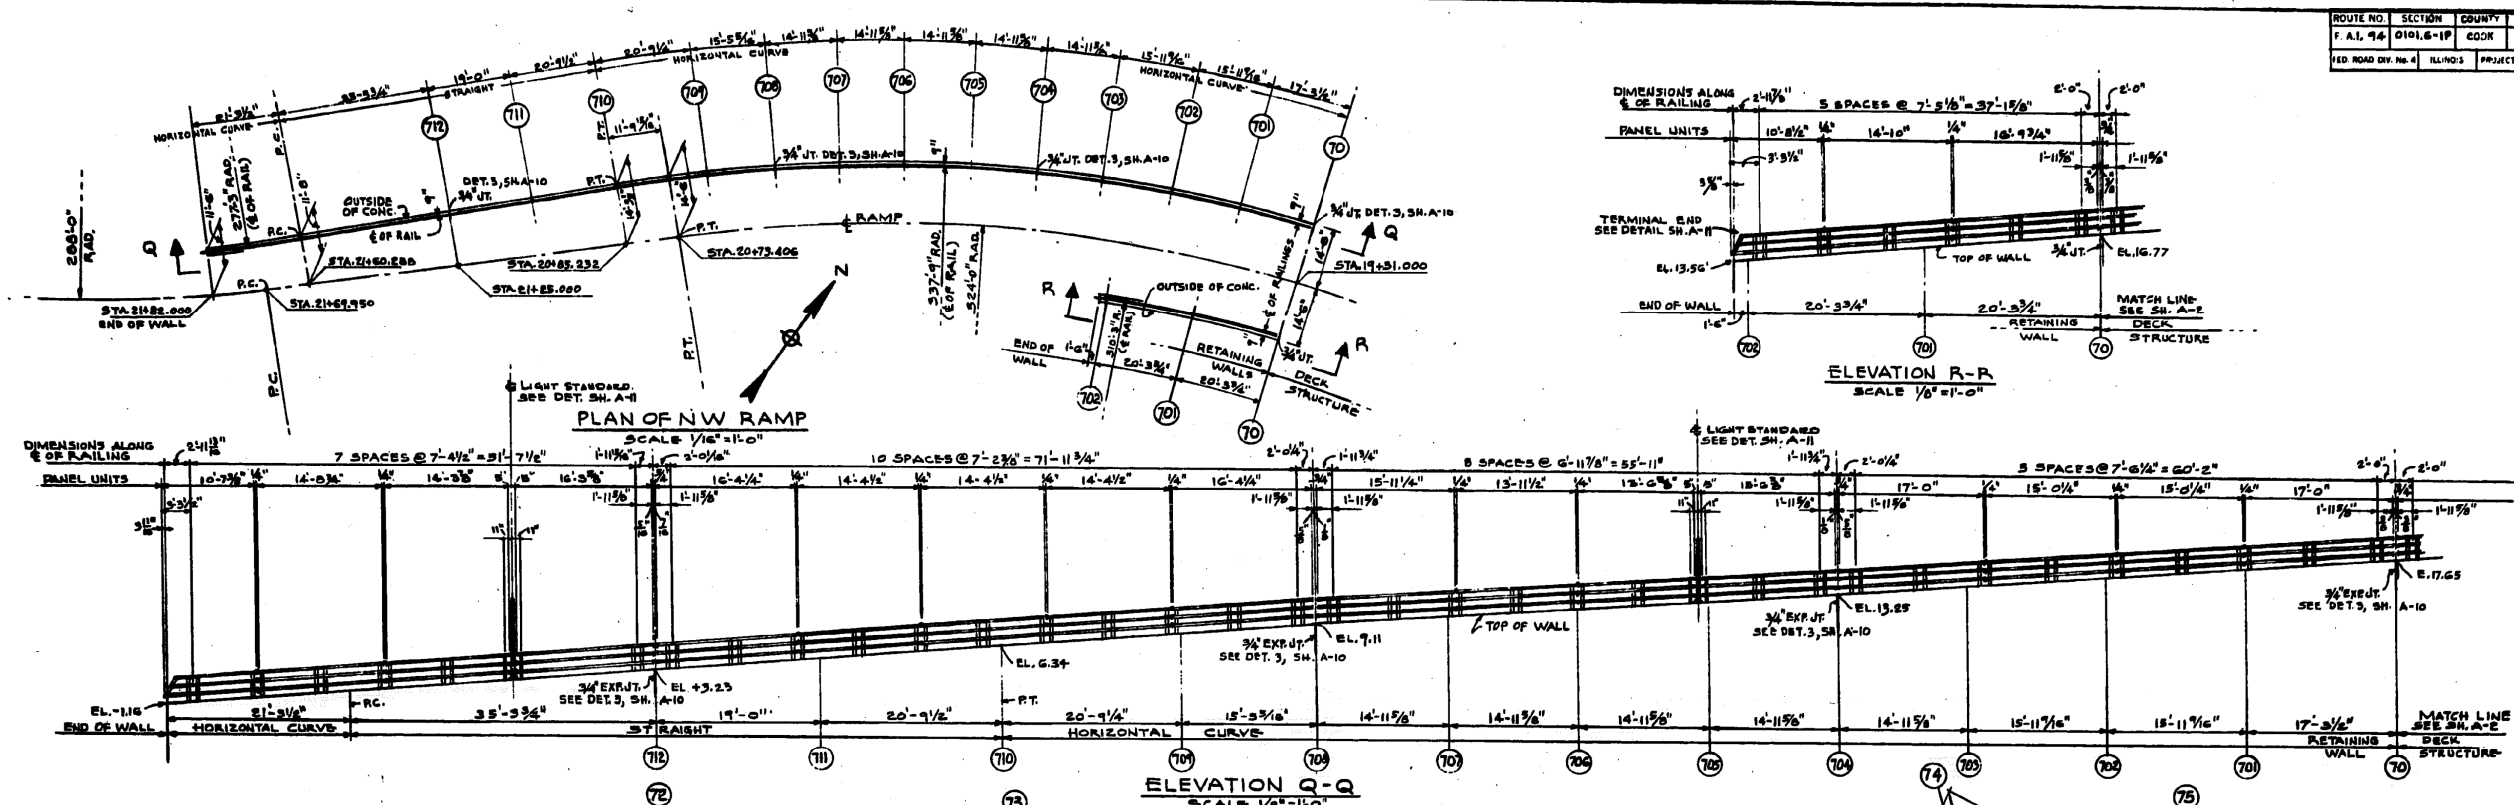

Drawn By: S. S. BRANNIN
 Traced By: S. S. BRANNIN
 Checked By: [Signature]
 Approved By: [Signature]

CITY OF CHICAGO
 DEPARTMENT OF PUBLIC WORKS
 BUREAU OF ENGINEERING
 NORTHWEST ROUTE SUPERHIGHWAY
 HALSTED STREET INTERCHANGE
 SECTION 0101.6-1P
 PLANS AND ELEVATIONS OF RAILINGS
 RAMP NW
 SCALE AS SHOWN
 SHEET NO. 41 OF 113 SHEETS
 AUGUST 1959

FILE PATH = C:\Projects\14-0425 - 60W28-Structure\14-0425-60W28-Structure\14-0425-60W28-Structure\AS-BUILT-37.dgn



D160W28-sht-AS-BUILT-37.dgn
 USER NAME = auyeungh
 PLOT SCALE = 1:8000 / in.
 PLOT DATE = 4/25/2014

DESIGNED -	REVISED -
DRAWN -	REVISED -
CHECKED -	REVISED -
DATE - 04/28/14	REVISED -

STATE OF ILLINOIS
 DEPARTMENT OF TRANSPORTATION

EXISTING AS-BUILTS
 SN 016-2449 & SN 016-2451

SCALE: NTS SHEET 37 OF 48 SHEETS STA. TO STA.

F.A.I. RTE.	SECTION	COUNTY	TOTAL SHEETS	SHEET NO.
90/94/290	2013-010R	COOK	747	507
CONTRACT NO. 60W28				
ILLINOIS FED. AID PROJECT				