


# FOR INFORMATION ONLY

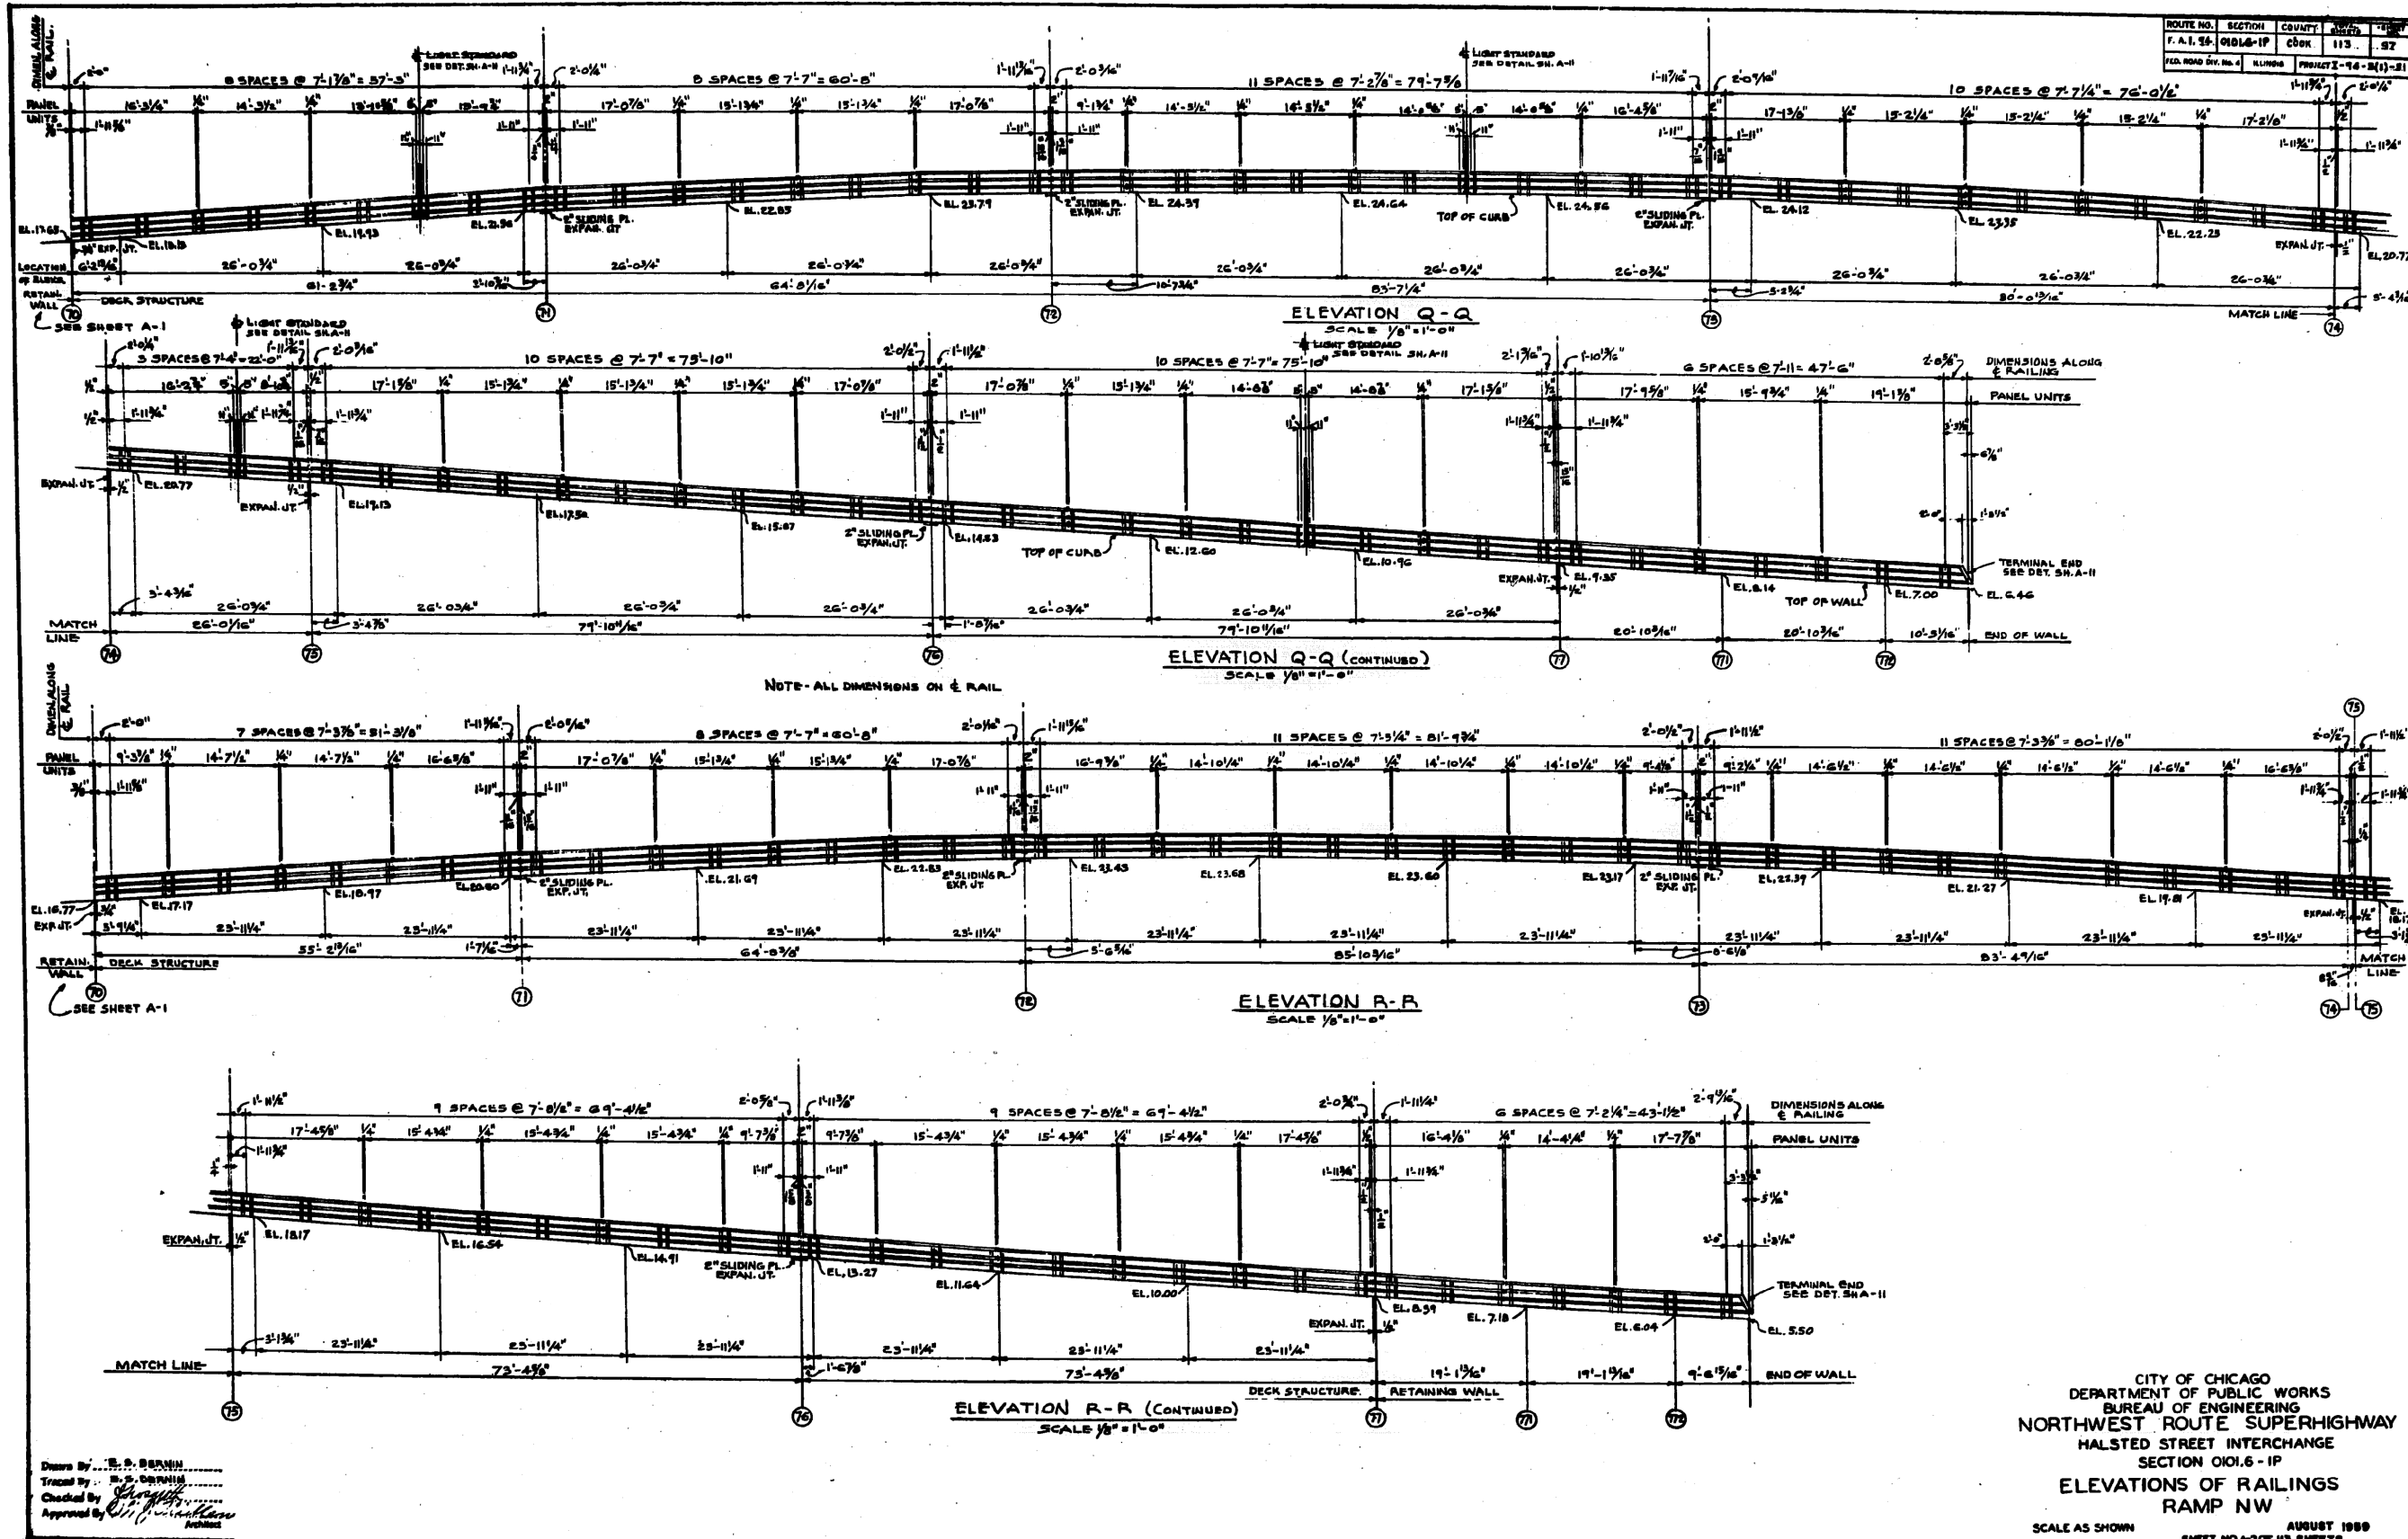

CITY OF CHICAGO  
 DEPARTMENT OF PUBLIC WORKS  
 BUREAU OF ENGINEERING  
 NORTHWEST ROUTE SUPERHIGHWAY  
 HALSTED STREET INTERCHANGE  
 SECTION 0101.6-1P  
**ELEVATIONS OF RAILINGS  
 RAMP NW**  
 SCALE AS SHOWN      AUGUST 1999  
 SHEET NO. 2 OF 13 SHEETS

Drawn By: E. S. BERNINI  
 Traced By: E. S. BERNINI  
 Checked By: [Signature]  
 Approved By: [Signature]

FILE PATH = C:\Projects\14-0425 - 60W28 Structure\14-0425-AS-BUILT-38.dgn



D:\60W28-sht-AS-BUILT-38.dgn  
 USER NAME = auyoung  
 PLOT SCALE = 1:8000 / 1" = 80'  
 PLOT DATE = 4/25/2014

DESIGNED -	REVISED -
DRAWN -	REVISED -
CHECKED -	REVISED -
DATE - 04/28/14	REVISED -

STATE OF ILLINOIS  
 DEPARTMENT OF TRANSPORTATION

EXISTING AS-BUILTS  
 SN 016-2449 & SN 016-2451

SCALE: NTS      SHEET 38 OF 48 SHEETS      STA.      TO STA.

F.A.I. RTE.	SECTION	COUNTY	TOTAL SHEETS	SHEET NO.
90/94/290	2013-010R	COOK	747	508
CONTRACT NO. 60W28				
ILLINOIS FED. AID PROJECT				