


FOR INFORMATION ONLY

ROUTE NO.	SECTION	COUNTY	SHEET
F.A.I. 94	0101.6-IP	COOK	113
FED ROAD DIST NO. 4	ILLINOIS	PROJECT I-94-S(1)-81	108

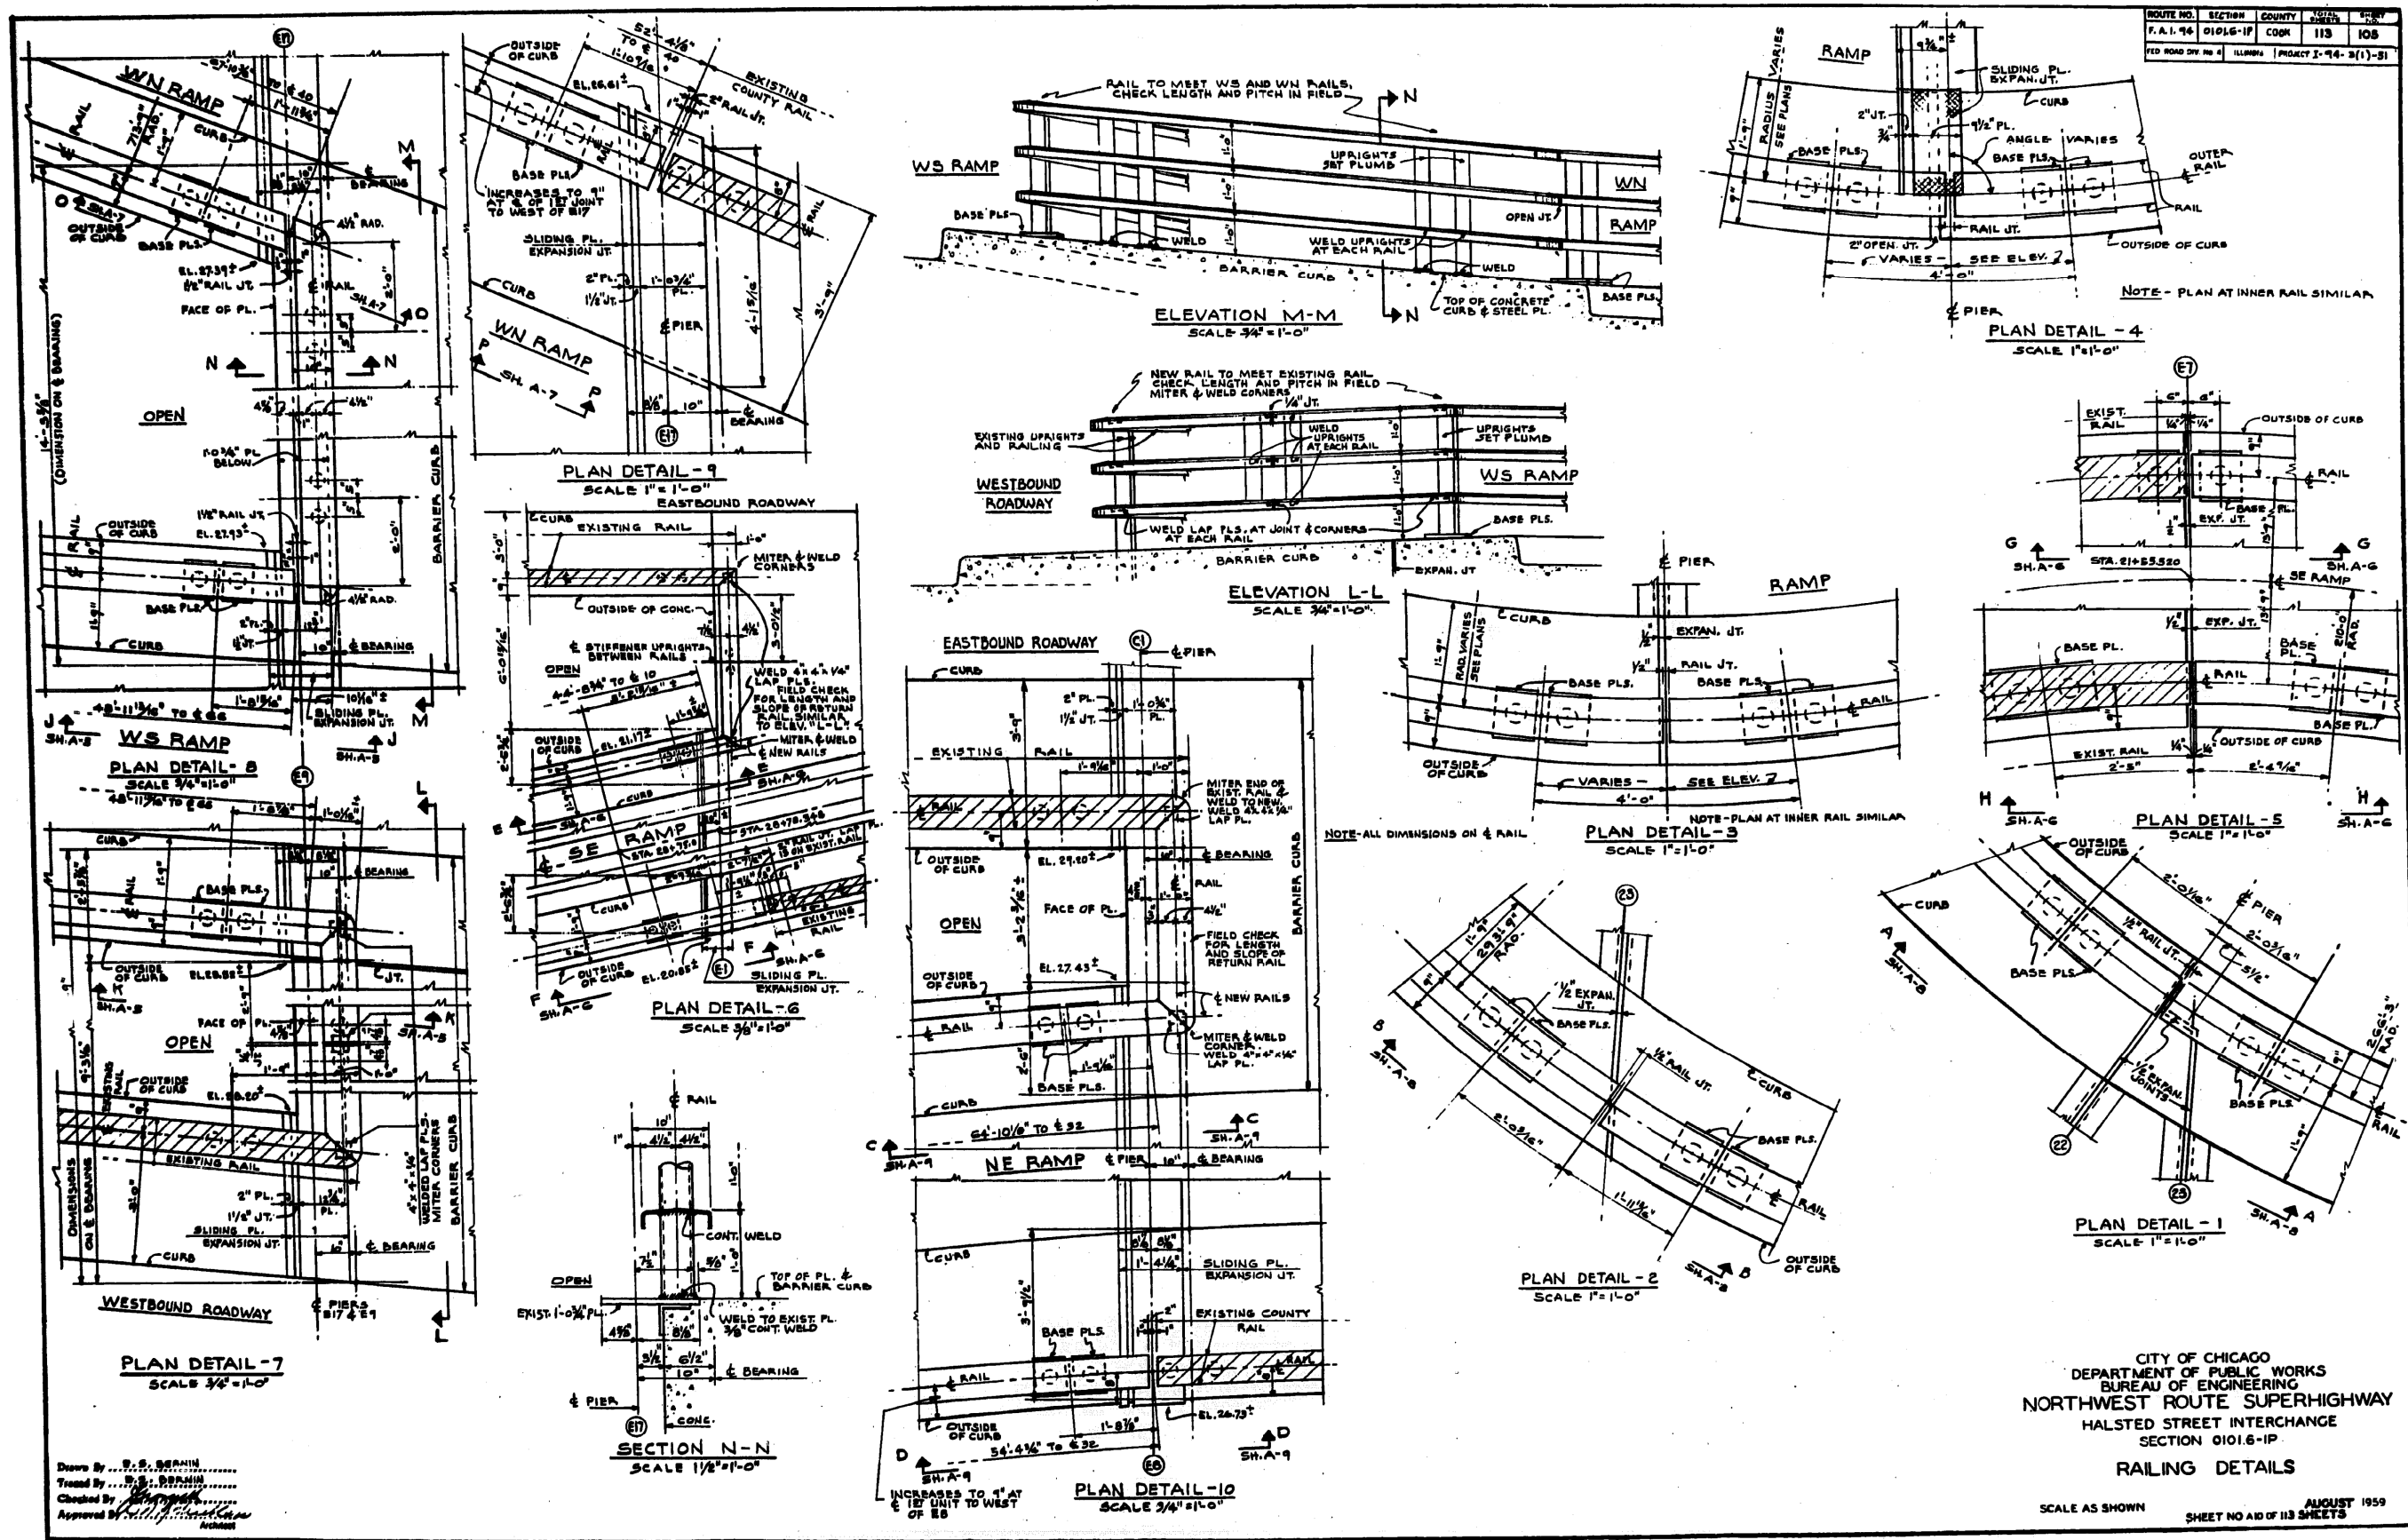

Drawn By: S.S. BERANIN
 Traced By: S.S. BERANIN
 Checked By: [Signature]
 Approved By: [Signature]

CITY OF CHICAGO
 DEPARTMENT OF PUBLIC WORKS
 BUREAU OF ENGINEERING
 NORTHWEST ROUTE SUPERHIGHWAY
 HALSTED STREET INTERCHANGE
 SECTION 0101.6-IP
RAILING DETAILS

SCALE AS SHOWN
 AUGUST 1959
 SHEET NO. 46 OF 48 SHEETS

FILE PATH = C:\Project\14-0425 - 60W28-Structure\14-0425-60W28-Structure\AS-BUILT-46.dgn



D160W28-sht-AS-BUILT-46.dgn
 USER NAME = auyeuongh
 PLOT SCALE = 1.0000 / in.
 PLOT DATE = 4/25/2014

DESIGNED	REVISED
DRAWN	REVISED
CHECKED	REVISED
DATE	REVISED

STATE OF ILLINOIS
 DEPARTMENT OF TRANSPORTATION

EXISTING AS-BUILTS
 SN 016-2449 & SN 016-2451
 SCALE: NTS
 SHEET 46 OF 48 SHEETS
 STA. TO STA.

F.A.I. RTE.	SECTION	COUNTY	TOTAL SHEETS	SHEET NO.
90/94/290	2013-010R	COOK	747	516
CONTRACT NO. 60W28				
ILLINOIS FED. AID PROJECT				