
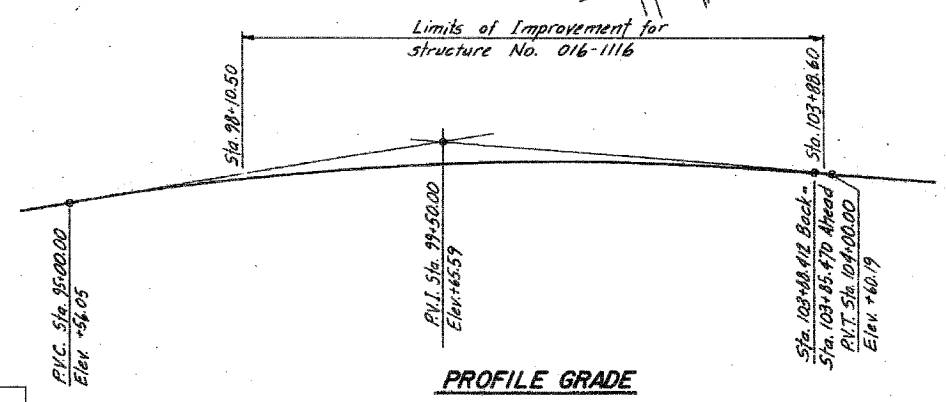
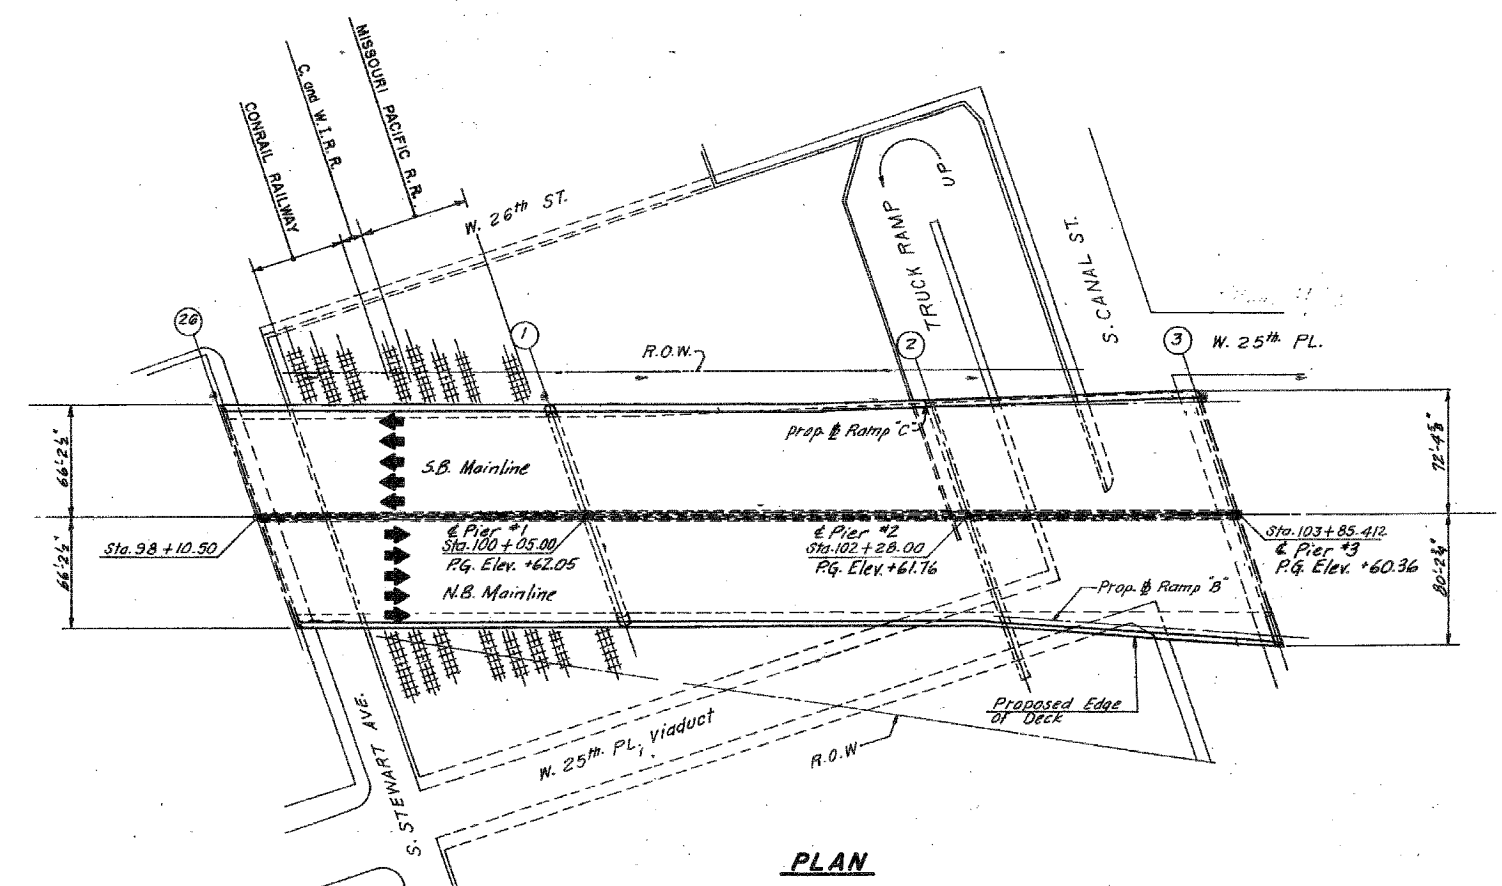


F.A.I.	SECTION	COUNTY	TOTAL SHEETS	SHEET NO.
94/90	2005-008F	COOK	93	8
STA.		TO STA.		
FED. ROAD DIST. NO.		ILLINOIS	FED. AID PROJECT	
62919				

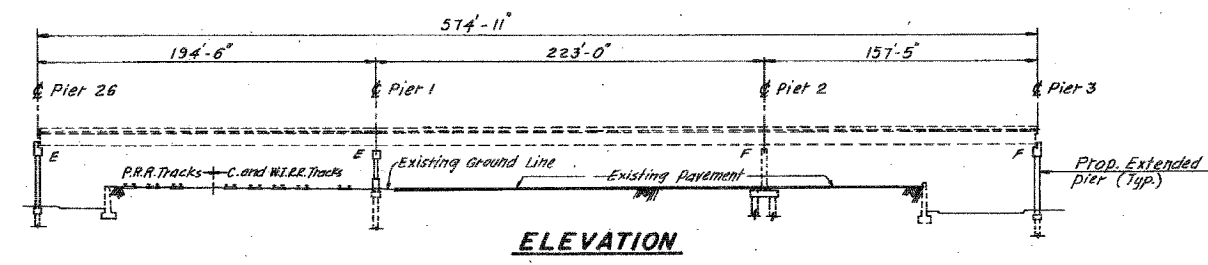

BOWMAN, BARRETT & ASSOCIATES INC.
CONSULTING ENGINEERS
104 EAST RANDOLPH STREET SUITE 2650 CHICAGO, ILLINOIS 60601
JOB NO. 440

Note: This sheet created from original 1988-89 reconstruction as-builts. These are provided for general reference to structure number, span lengths, etc. Work Items for this contract are identified on the partial framing plans and detail sheets that follow.

REVISIONS	
NAME	DATE

ILLINOIS DEPARTMENT OF TRANSPORTATION
F.A.I. 94/90 (DAN RYAN EXPRESSWAY)
FABRICATION CONTRACT
NB DAN RYAN ELEVATED BRIDGE
REPAIR FROM 15TH TO 28TH STREETS
GENERAL PLAN AND ELEVATION SN 016-1116

SCALE: NTS
DATE: 5/23/2005

DRAWN BY: BDC
CHECKED BY: BLU

5/23/2005 9:27:59 AM