


62307

F. A. RTE	SECTION	COUNTY	TOTAL SHEETS	SHEET NO.
99/34	*	COOK	37	26
STA. 204+60	TO STA. 212+05			
PER. ROAD DIST. NO. 1		ILLINOIS	FED. AID PROJECTS	
* 2004-067L				



NOTE: CONTRACTOR IS TO CONTACT ALL UTILITY COMPANIES TO VERIFY EXACT LOCATION OF UNDERGROUND UTILITIES PRIOR TO START OF CONSTRUCTION WORK. MOVE FOUNDATIONS AND CONDUIT RUNS ACCORDINGLY.

MATCH LINE
STATION 204+60
SEE SHEET 04-014

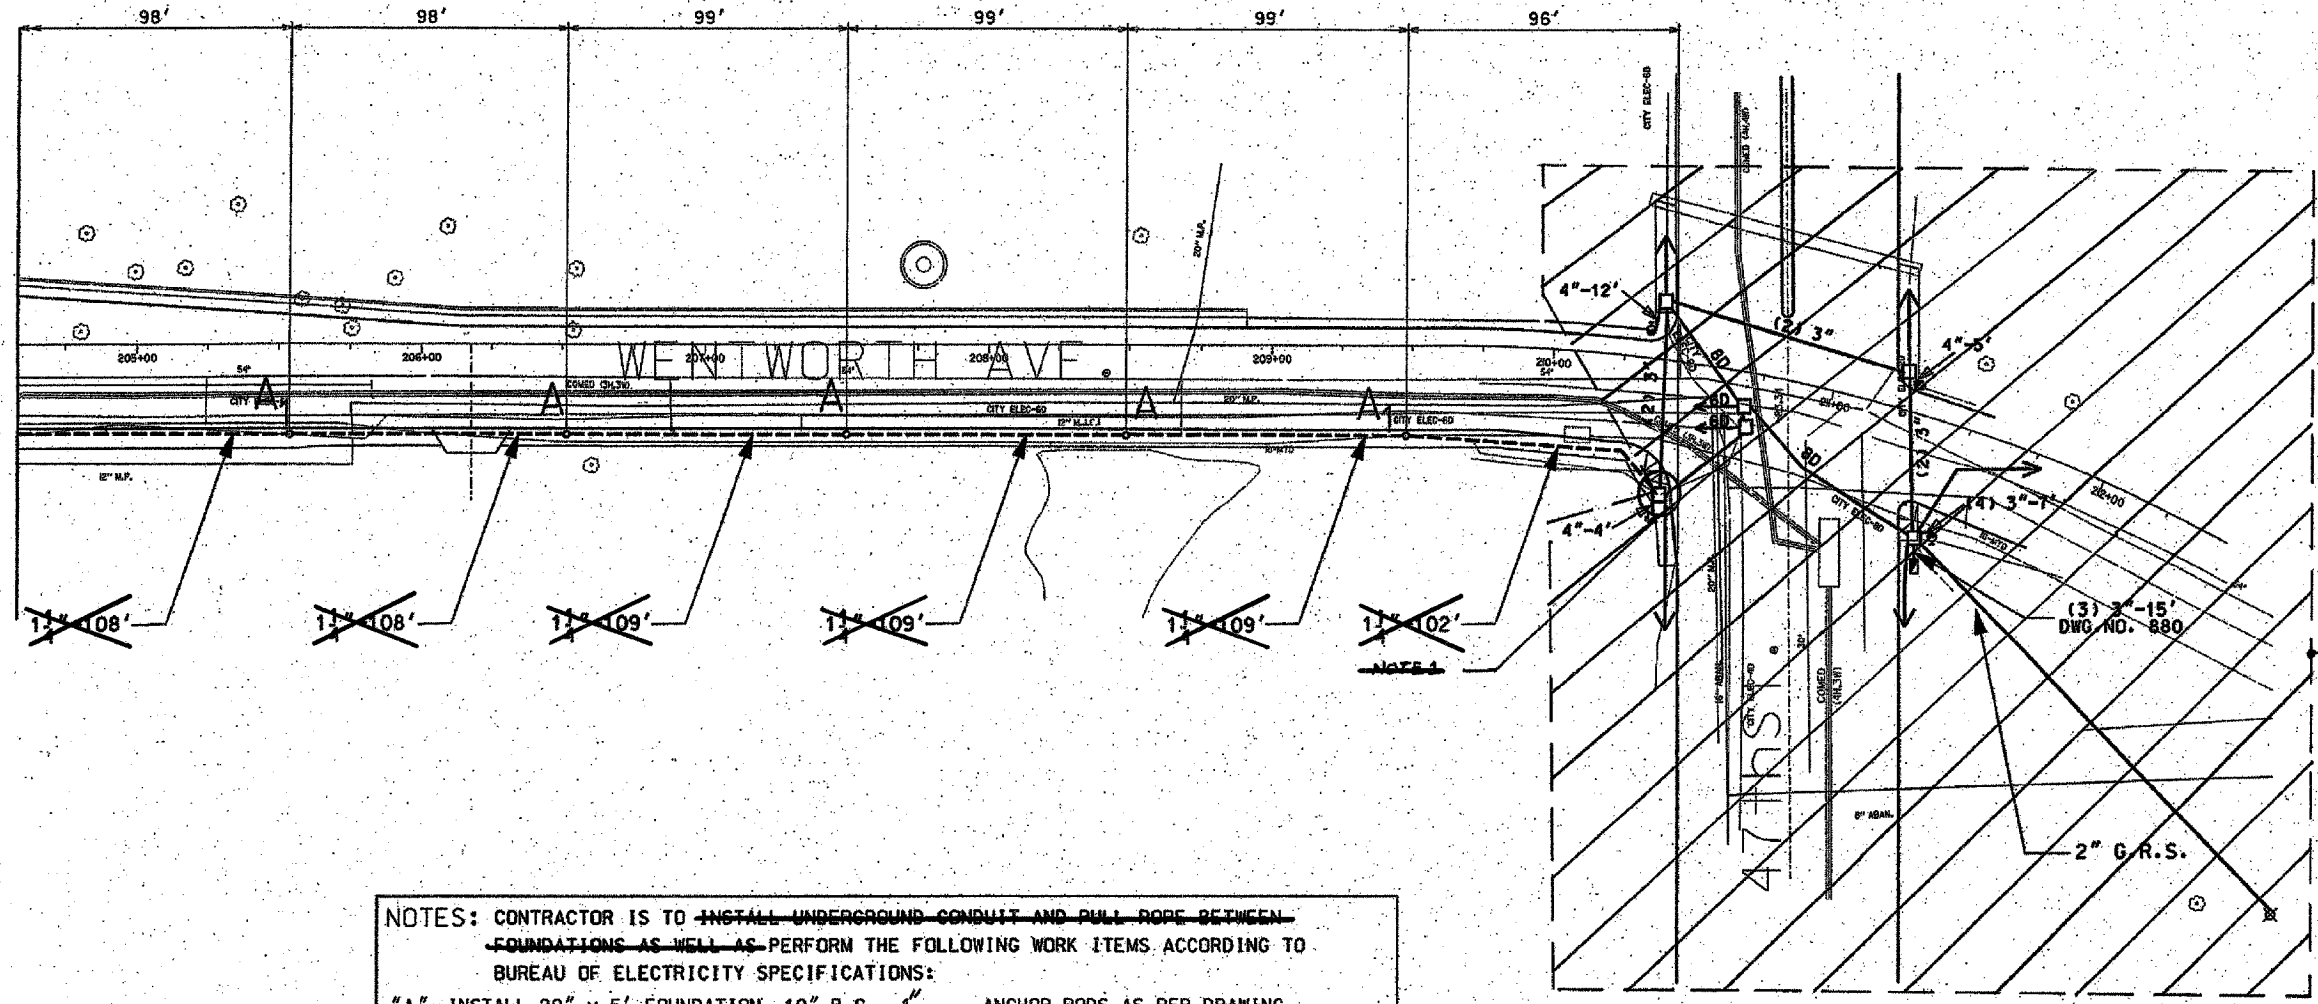

NOTES: CONTRACTOR IS TO ~~INSTALL UNDERGROUND CONDUIT AND PULL ROPE BETWEEN FOUNDATIONS AS WELL AS~~ PERFORM THE FOLLOWING WORK ITEMS ACCORDING TO BUREAU OF ELECTRICITY SPECIFICATIONS:
 "A" - INSTALL 20" x 5' FOUNDATION, 10" B.C., 1" ANCHOR RODS AS PER DRAWING NO. 565, FLUSH IN CONCRETE SIDEWALK, 2' OFF FACE OF CURB, UNLESS NOTED OTHERWISE.
 "A1" - INSTALL 20" x 5' OFFSET FOUNDATION, 10" B.C., 1" ANCHOR RODS SIMILAR AS PER DRAWING NO. 937; 2' OFF FACE OF CURB, UNLESS NOTED OTHERWISE. BUILD FOUNDATION FLUSH WITH SIDEWALK.
 "B" - INSTALL 30" HANDHOLE AS PER DRAWING NO. 867 WITH 24" FRAME AND COVER.

~~1 1/2" DIRECT BORED CONDUIT SCHEDULE #80 AS PER IDOT ARTICLE 940-02~~
 CONCRETE FOUNDATION - 5' x 20", 10" B.C., 1" ANCHOR RODS
 OFFSET CONCRETE FOUNDATION - 5' x 20", 10" B.C., 1" ANCHOR RODS

~~FOR INSTALLATION PLAN SEE SHEET 04-023~~
~~FOR REMOVAL PLAN SEE SHEET 04-029~~

FOR BIDDING AND CONSTRUCTION
 SEE GENERAL NOTES 26 AND 27
 ON SHEET 2.

NOTES:
 1. ~~ROUTE PROPOSED CONDUIT ROUTE~~
 EXISTING MAW-HOLE AS SHOWN. DRESS THE EXISTING MAW-HOLE AND INSTALL PROPOSED CONDUIT THROUGH MAW-HOLE WALL. SEE DRAWING 30E FOR DETAILS.

CITY OF CHICAGO
 DEPT. OF STREETS AND SANITATION
 BUREAU OF ELECTRICITY
 DIVISION OF ELECTRICAL ENGINEERING

DRAFTSMAN P.R.S./ B.T.G.	CHIEF DRAFTSMAN ROBERT CARTER	ENGINEER P.R.S./ B.T.G.
SUPERVISING ENGINEER	ELEC. DESIGN ENGR.	
ENGINEER OF ELECTRICITY		DWG. NO. 04-015
GEN'L SUPT. OF ELECTRICITY		
DEPUTY COMMISSIONER		
SIZE: 22" x 36"	SCALE: 1"=30'	DATE: 1/20/04
ILLINOIS DEPARTMENT OF TRANSPORTATION F.A.I. 90/94 (DAN RYAN EXPRESSWAY) 57th St. TO 47th St. (FRONTAGE ROADS)		
STREET LIGHTING UNDERGROUND CONDUIT FACILITIES		
SCALE: 1" = 30'		DRAWN BY: B.T.G.
DATE: February 11, 2005		CHECKED BY: O.L.

REVISIONS	
NAME	DATE